


I, ROGER ALLEN PERRY, BEING DULY SWORN AND ADOPTED TO PRACTICE AS A CIVIL ENGINEER IN THE STATE OF COLORADO DO HEREBY STATE THAT WE HAVE MADE ON-SITE OBSERVATIONS DURING CONSTRUCTION OF THE SEWER AND WATER LINES SHOWN ON THIS DRAWING, PREPARED FROM DATA OBTAINED BY COLORADO WEST SURVEYING COMPANY, AND THAT TO THE BEST OF MY INFORMATION, KNOWLEDGE AND BELIEF THE WATERLINE HAS BEEN CONSTRUCTED ACCORDING TO THE CITY OF GRAND JUNCTION STANDARDS AND REQUIREMENTS, AND THAT INFORMATION INTO THE EXISTING MAIN BY WORKING FROM EXISTING PER LINE OF PIPE DIAMETER FOR THE 15" MAIN PER DAY.

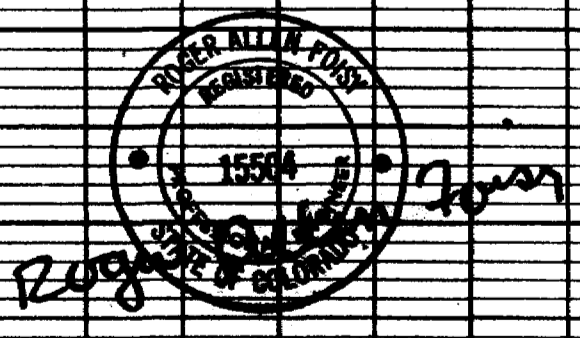

1-7-83

DESIGNED BY:	DATE:	STATION TO STA. SCALE:	NO.   DATE   REVISION   BY
DRAWN BY:	DATE:	VERT. HORIZ.	SEWER & WATER AS BUILT
<b>COLORADO WEST ENGINEERING</b> CONSULTING CIVIL ENGINEERS 835 COLORADO AVE. GRAND JUNCTION, COLO. 81501 (303) 245-2767			WELLINGTON COURT WELLINGTON TOWNHOMES
			DES. DR. J.A. CK. DATE 1/83 SHEET 1 OF 1