
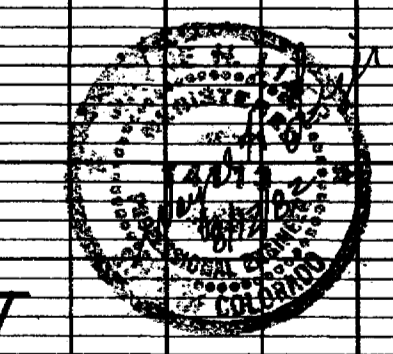


General Notes:
City of Grand Junction Sewer
Specifications Shall Apply

Quantities INSTALLED
412' of 8 inch Sewer Line
1 Drop Manhole
1 Standard Manhole

NOTE: STUB SOUTHEASTERLY IN DIRECTION NOT PLACED YET. DIRECTION AND PLACEMENT TO BE DETERMINED BY CONTRACTORS FOR NEW BUILDING UNDER CONSTRUCTION ON VALLEY FEDERAL PROPERTY.

GENERAL NOTES:
THIS SUBDIVISION IS SERVED BY CITY OF GRAND JUNCTION SANITATION DISTRICT.
THIS IS TO CERTIFY THAT THE SYSTEM INFILTRATION DOES NOT EXCEED 200 GALLONS PER INCH DIAMETER PER MILE OF LENGTH PER DAY FIELD INSPECTED AUGUST 6, 1982

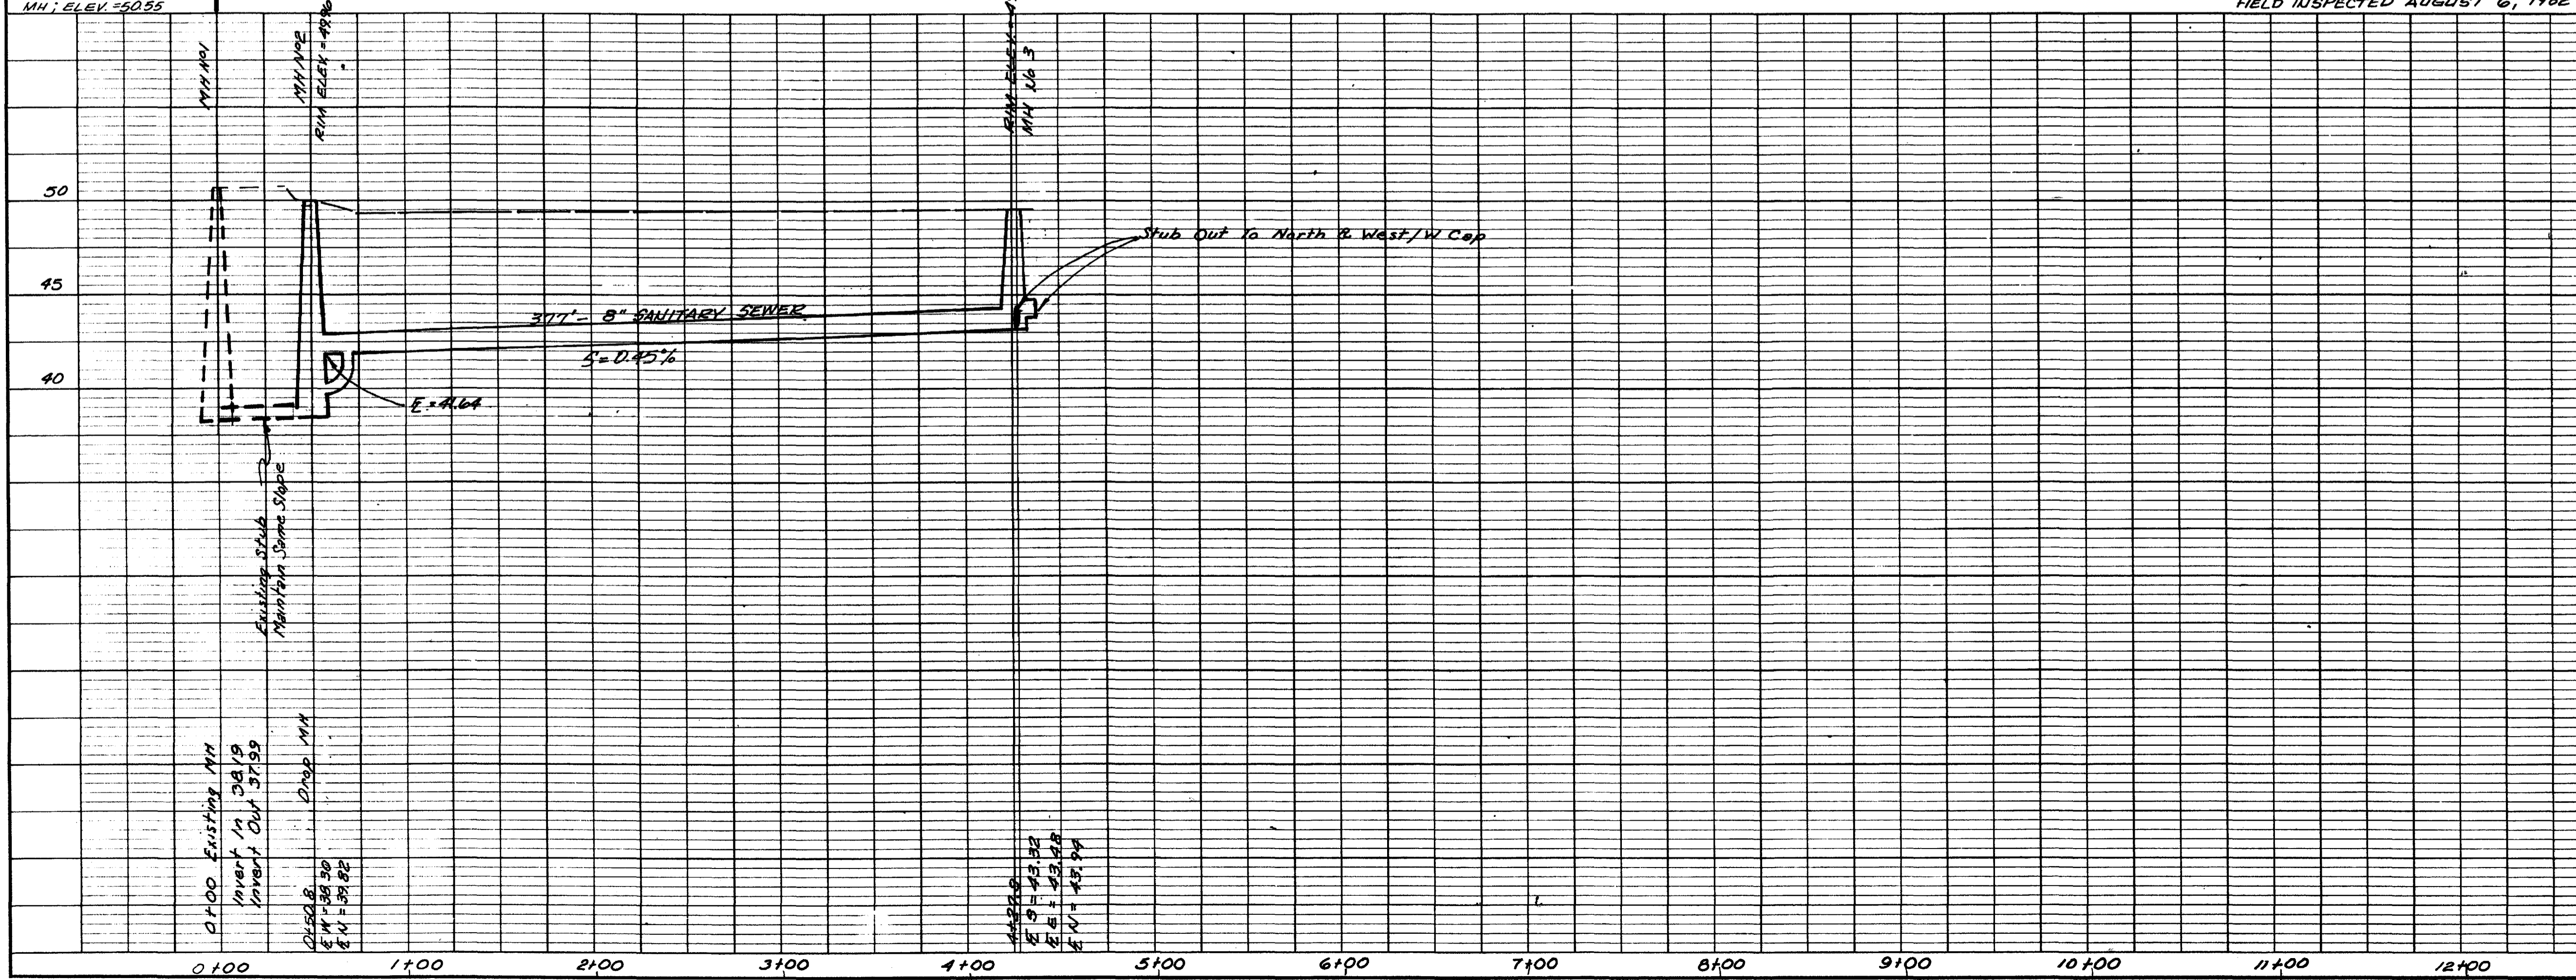

AS-BUILT
DURHAM CENTER
GRAND JUNCTION, COLO.
SEWER PLAN & PROFILE
GENERAL CONSTRUCTION NOTES

W. H. LIZER & ASSOCIATES
ENGINEERING & SURVEYING
576 25 ROAD, UNIT 8-241123
GRAND JUNCTION, COLORADO