


NOTE: RIM ELEVATIONS TEMPORARY UNTIL STREET CONSTRUCTION IS COMPLETED

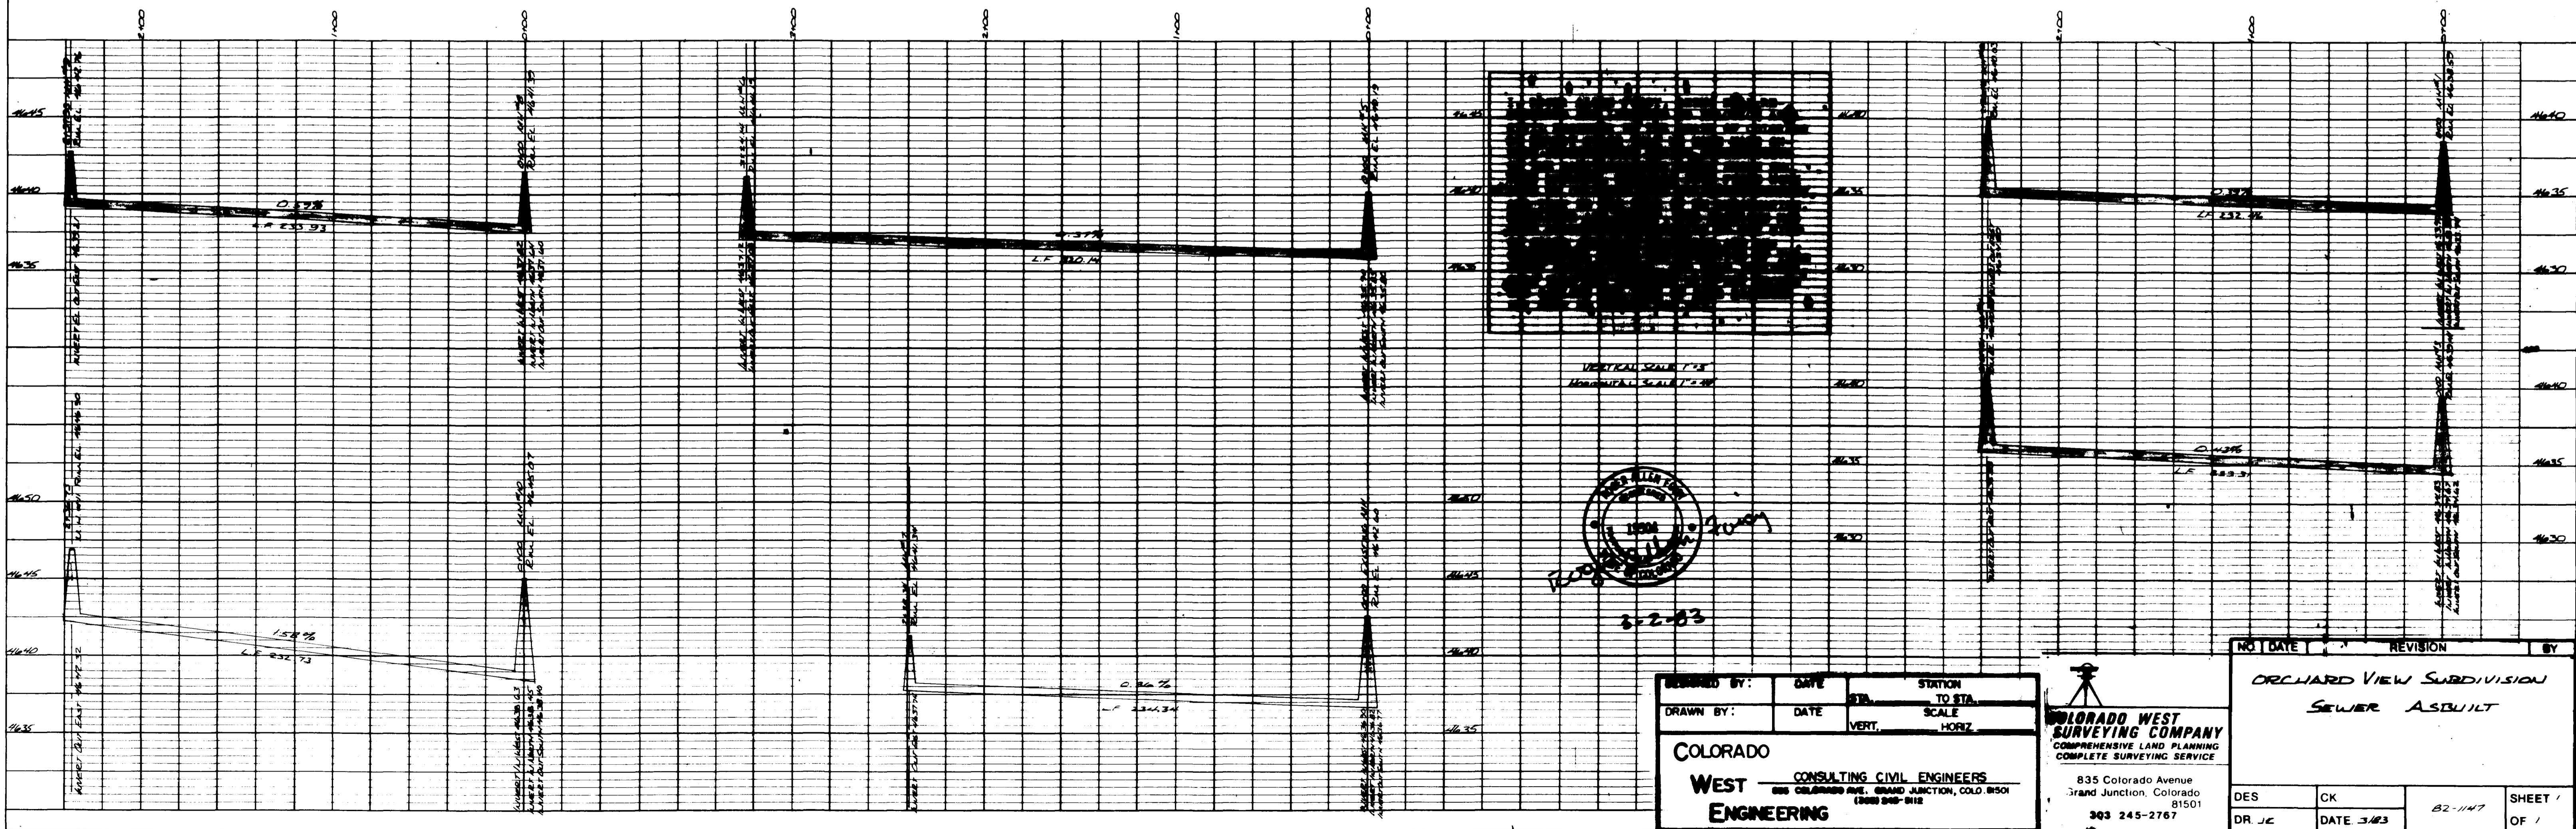

DESIGNED BY: _____ DATE _____ STATION TO STA. _____
 DRAWN BY: _____ DATE _____ VERT. SCALE _____ HORIZ. SCALE _____

COLORADO WEST ENGINEERING
 CONSULTING CIVIL ENGINEERS
 605 COLORADO AVE., GRAND JUNCTION, COLO. 81501
 (970) 245-2767

COLORADO WEST SURVEYING COMPANY
 COMPREHENSIVE LAND PLANNING
 COMPLETE SURVEYING SERVICE

835 Colorado Avenue
 Grand Junction, Colorado 81501
 970 245-2767

NO.	DATE	REVISION	BY

ORCHARD VIEW SUBDIVISION
SEWER ASBUILT

DES	CK	82-1147	SHEET 1 OF 1
DR JK	DATE 3/83		