
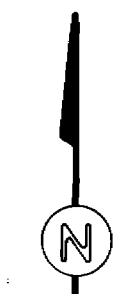


**As Built Quantities**  
 Manholes 5 ea.  
 8" Main 1,276.26 ft.  
 4" Service Lines 822 ft.

**Notes**  
 1. Infiltration meets the requirements of the City of Grand Junction Sanitary Sewer Specifications.  
 2. Ends of service lines are marked with 2"x4" posts painted red above ground line.  
 3. Invert elevations are at center of manhole. Grade is uniform through manholes.


30 1/4 ROAD

MH #1  
 RIM EL. 4626.95  
 I.E. 4618.03  
 I.C. 4618.03

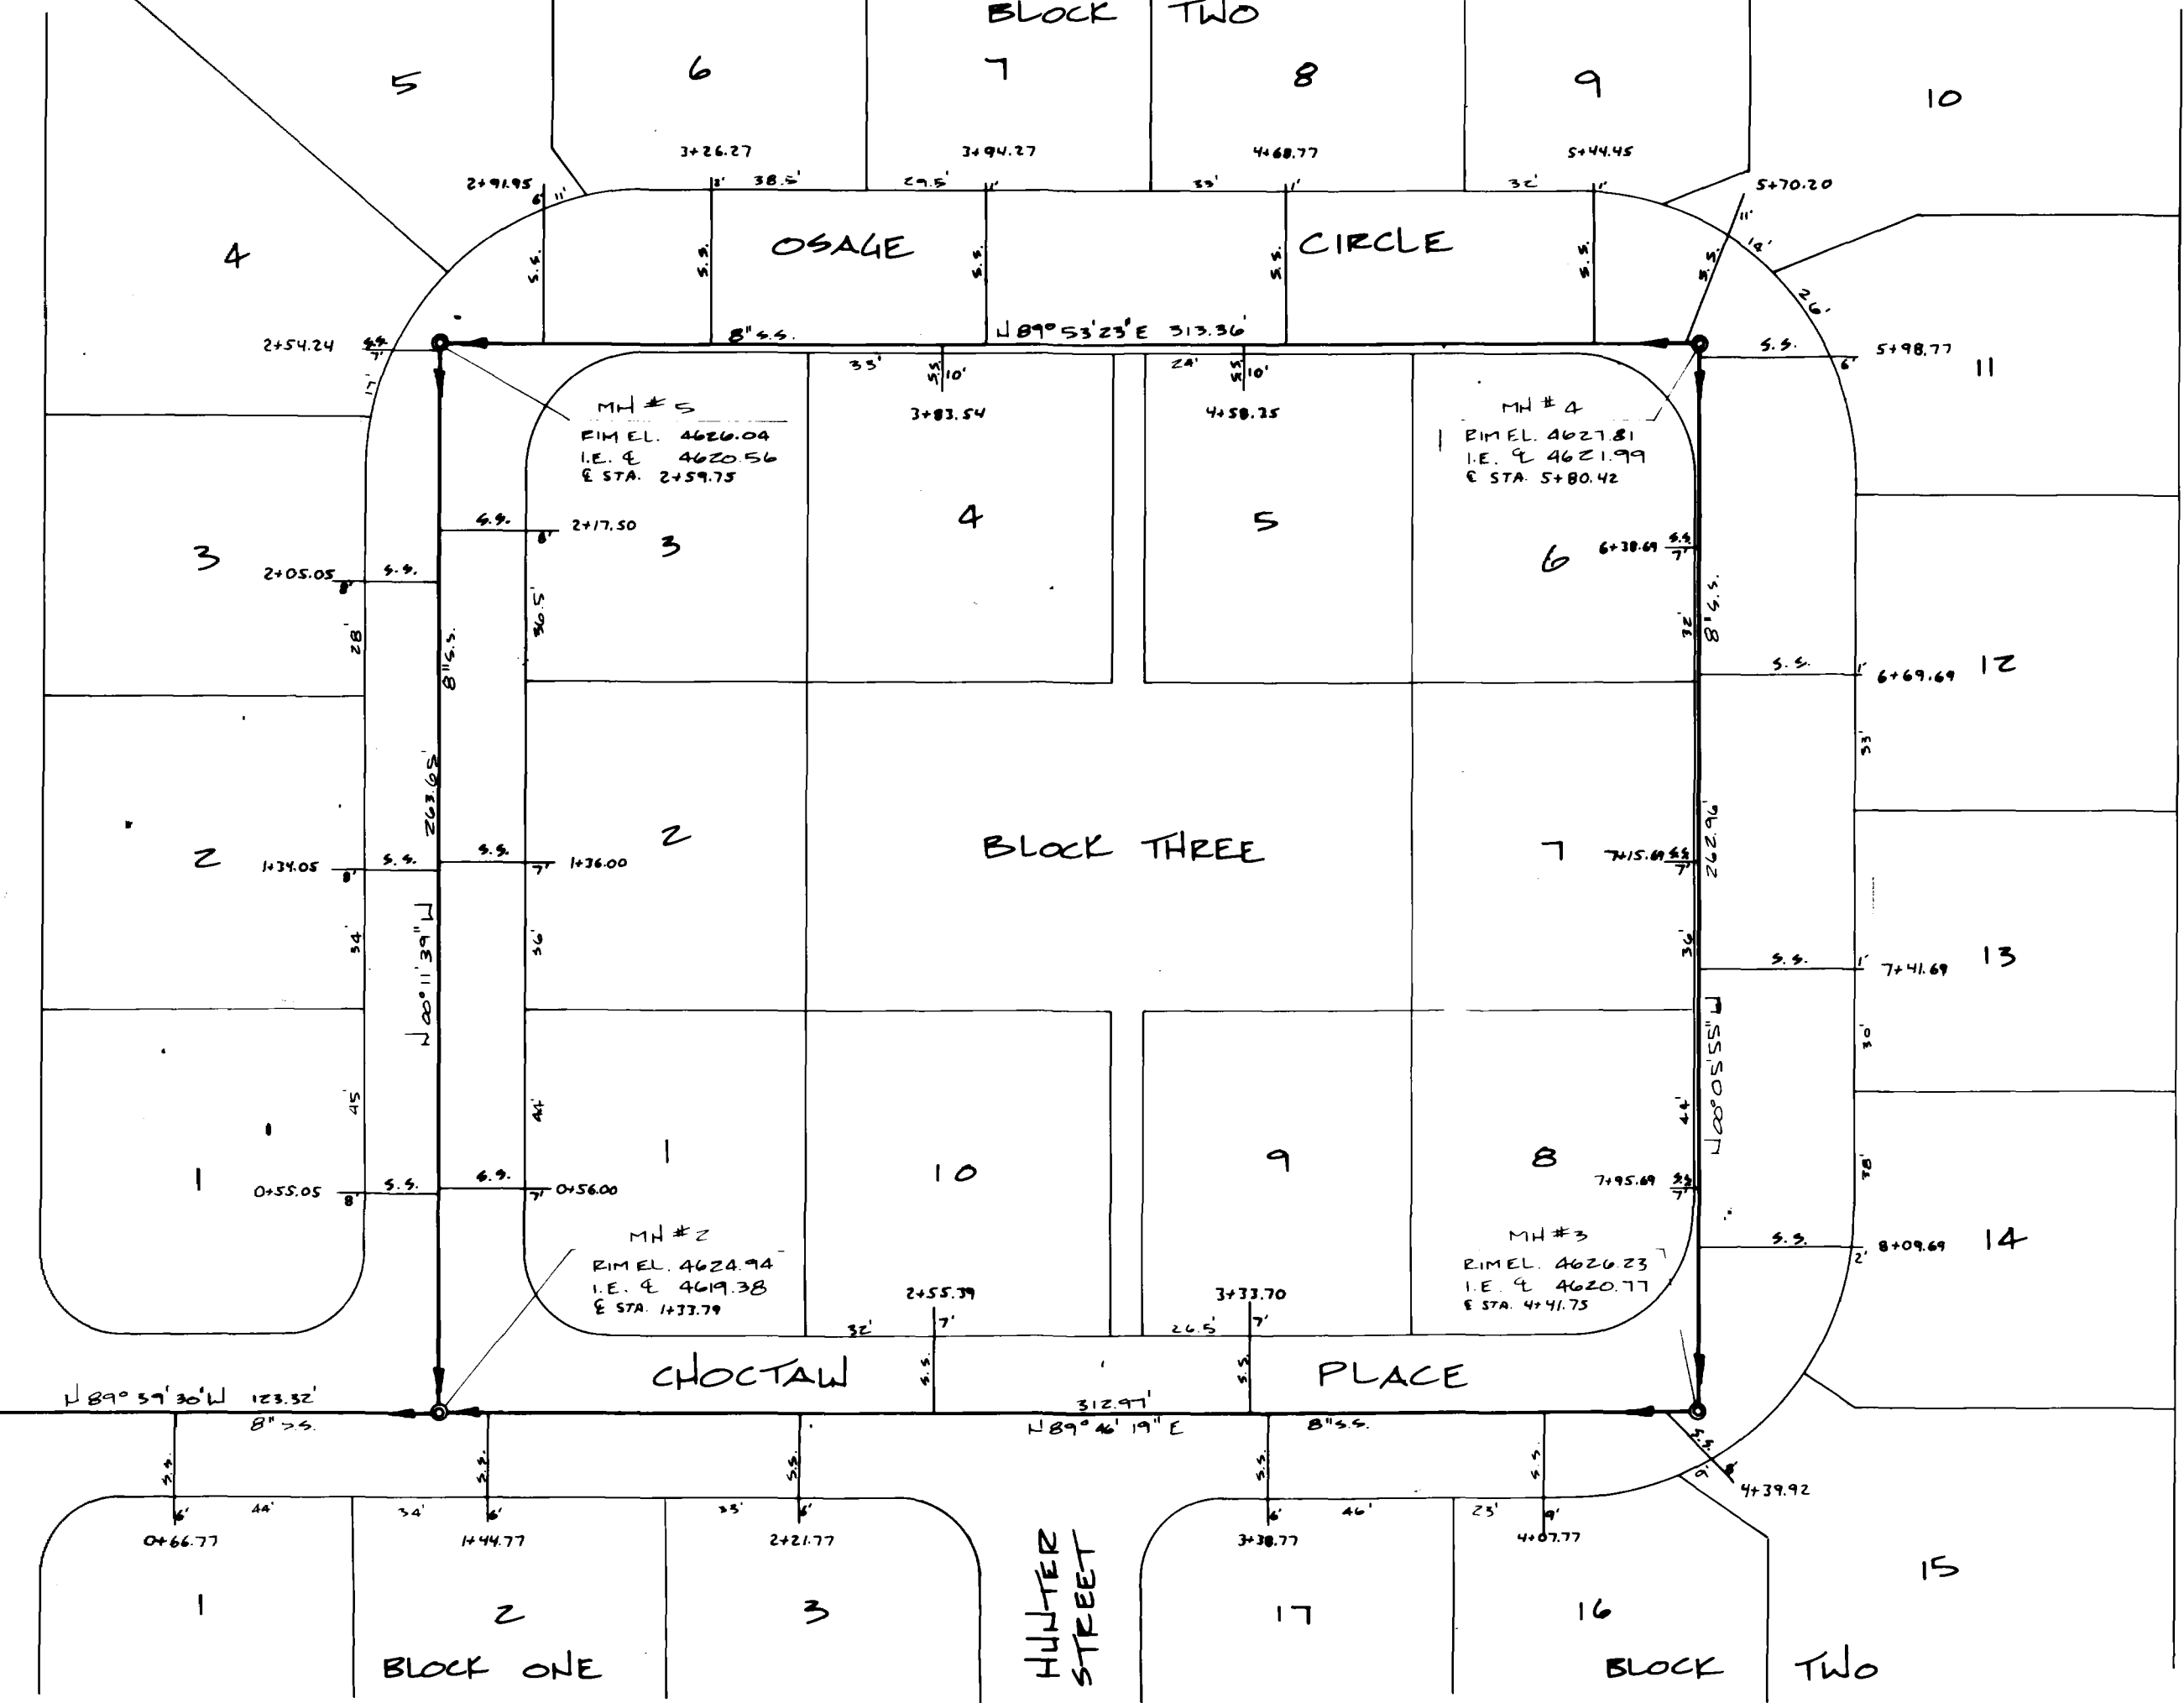

SCALE:  
 HORIZ: 1" = 40'  
 VERT: 1" = 5'

Ronald R. Zombrecht

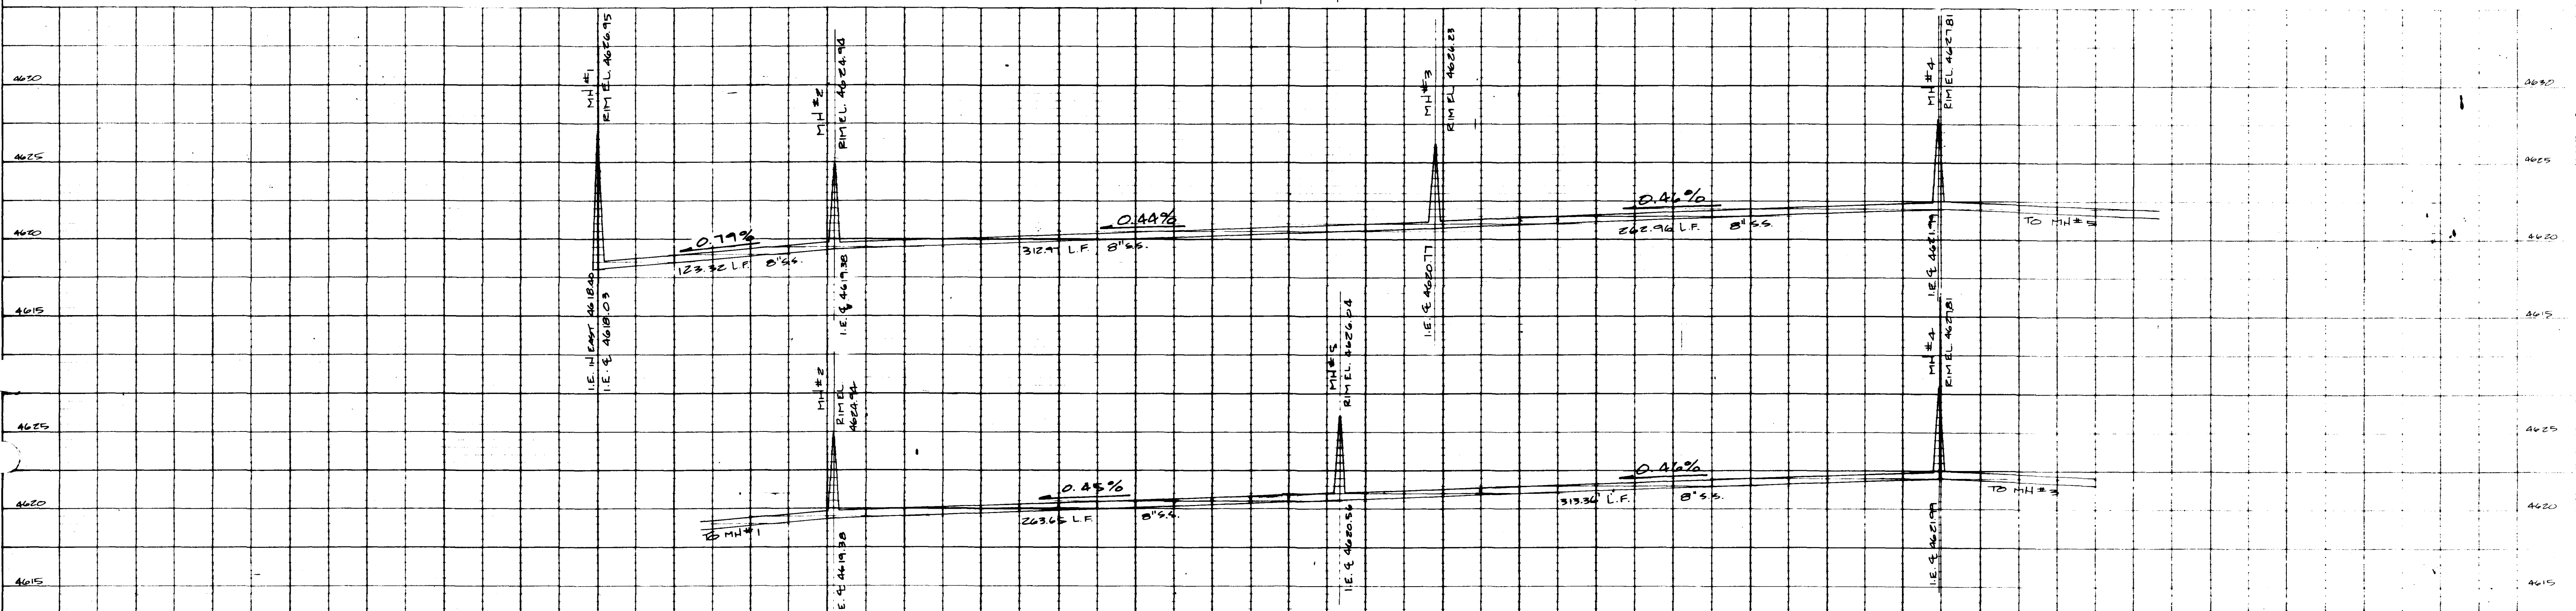

**CW COLORADO WEST ASSOCIATES INC.**  
 ENGINEERING SURVEYING PLANNING  
 303 245-2767  
 835 COLORADO AVENUE GRAND JUNCTION, COLORADO 81501

NO	DATE	REVISION	BY

**CHEROKEE VILLAGE WEST SEWER AS-BUILTS**

DES	CK	JOB NO 83-1160	SHEET 1
DR J		DATE 8/83	OF 1
		COUNTY FILE NO 02-83	