


SCALE: 1" = 60' HORZ.
1" = 5' VERT.

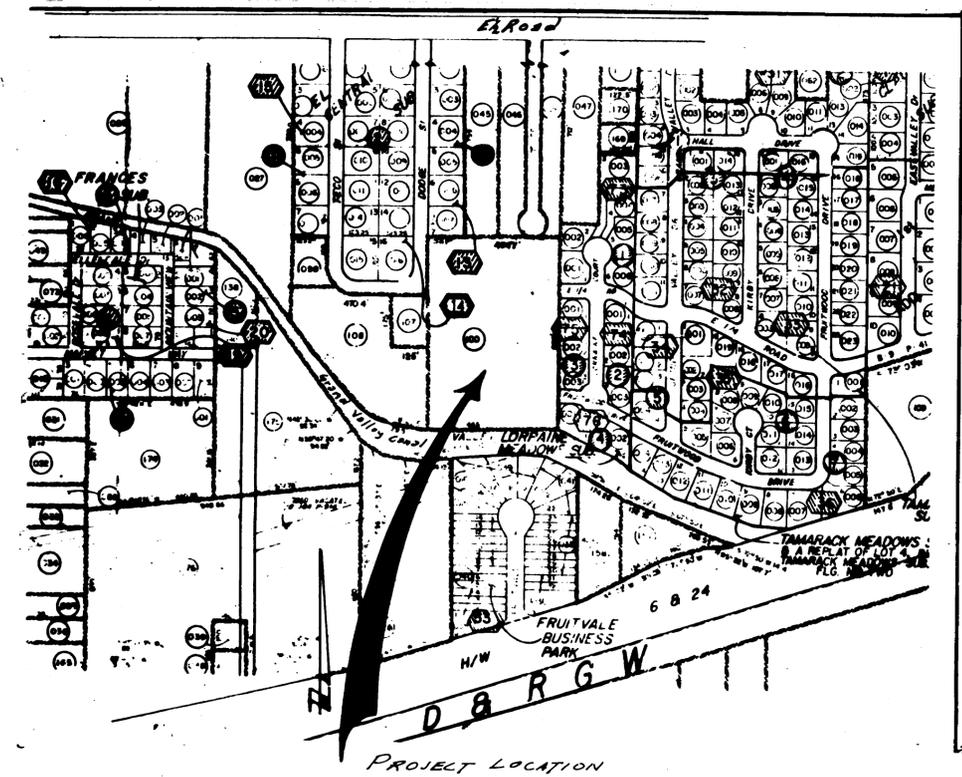

GENERAL NOTES

- THE FOLLOWING SPECIFICATIONS ARE MADE A PART OF THIS CONTRACT
1. ALL CURRENT MESA COUNTY STREET SPECIFICATIONS SHALL APPLY.
 2. NO ROAD CUTS WILL BE MADE AFTER PLACEMENT OF ASPHALT WITHOUT APPROVAL OF MESA COUNTY DEPARTMENT OF STREETS.
 3. MANHOLE RIMS TO BE BROUGHT TO GRADE BY PAVING CONTRACTOR AFTER PAVEMENT IS PLACED.
 4. CONTRACTOR IS RESPONSIBLE FOR LOCATING & PROTECTING UNDERGROUND UTILITIES.
 5. SEWER CONTRACTOR TO BRING MANHOLES UP TO BOTTOM OF SUBBASE.
 6. THIS SUBDIVISION IS SERVED BY CENTRAL GRAND VALLEY SANITATION DISTRICT.
 7. BENCH MARK: NAIL IN POWER POLE AT GRAND VALLEY DRIVE AND E 1/2 ROAD, NORTH SIDE ELEV = 4680.26

Sewer Notes: ①


1. CENTRAL GRAND VALLEY SANITATION DISTRICT SPECIFICATIONS SHALL APPLY.
2. SERVICES TO BE STUBBED 10 FEET INTO PROPERTY.
3. SEWER & WATER SEPARATIONS IS A MINIMUM OF 10'.

QUANTITIES: ②

8" SANITARY SEWER	1894 LIN. FT.
4" SERVICE LINE	1065 LIN. FT.
SHALLOW MANHOLES	5 EACH
STANDARD MANHOLE	3 EACH
8" PVC CAP	2 EACH
SERVICE CONNECTIONS	31 EACH

LEGEND:

→ INDICATES DIRECTION OF FLOW

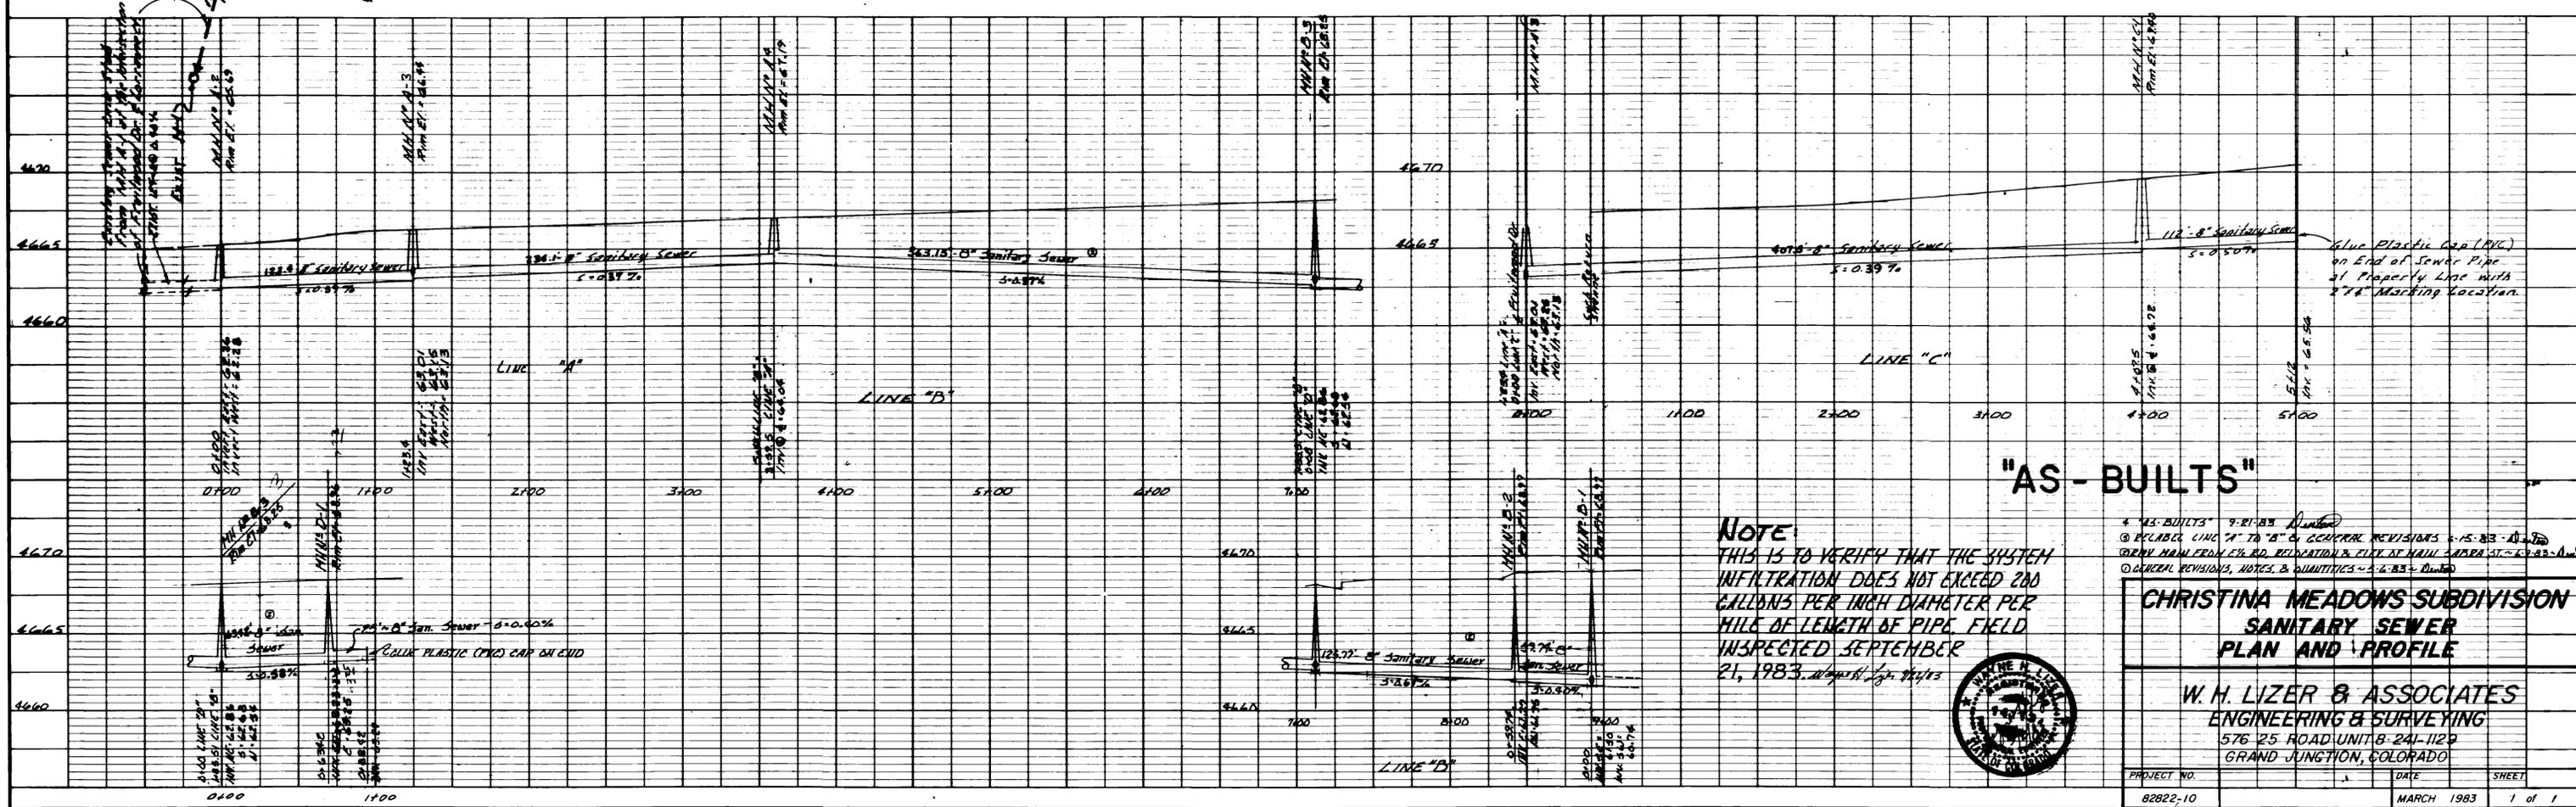

"AS-BUILTS"

NOTE
THIS IS TO VERIFY THAT THE SYSTEM INFILTRATION DOES NOT EXCEED 200 GALLONS PER INCH DIAMETER PER HILL OF LENGTH OF PIPE FIELD INSPECTED SEPTEMBER 21, 1983. *W. H. Lizer*

CHRISTINA MEADOWS SUBDIVISION
SANITARY SEWER
PLAN AND PROFILE

W. H. LIZER & ASSOCIATES
ENGINEERING & SURVEYING
576 25 ROAD UNIT B 241-1129
GRAND JUNCTION, COLORADO