
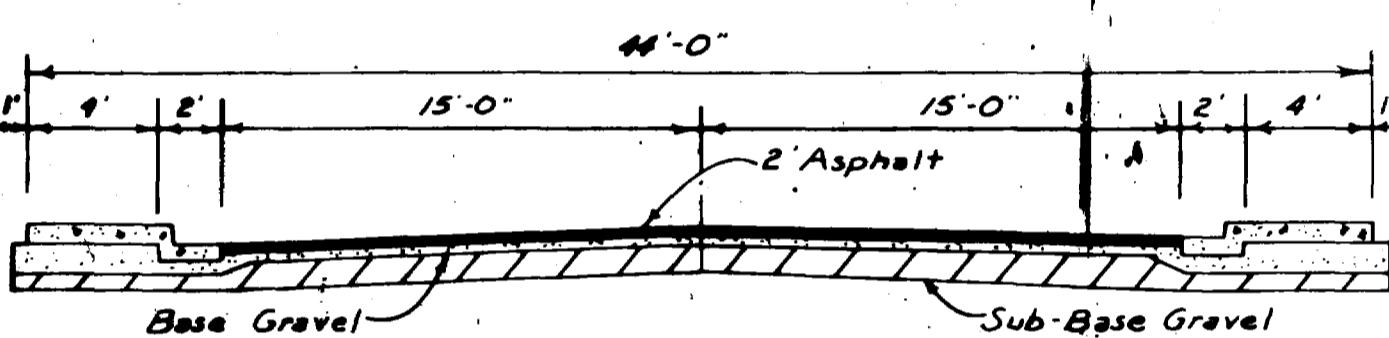
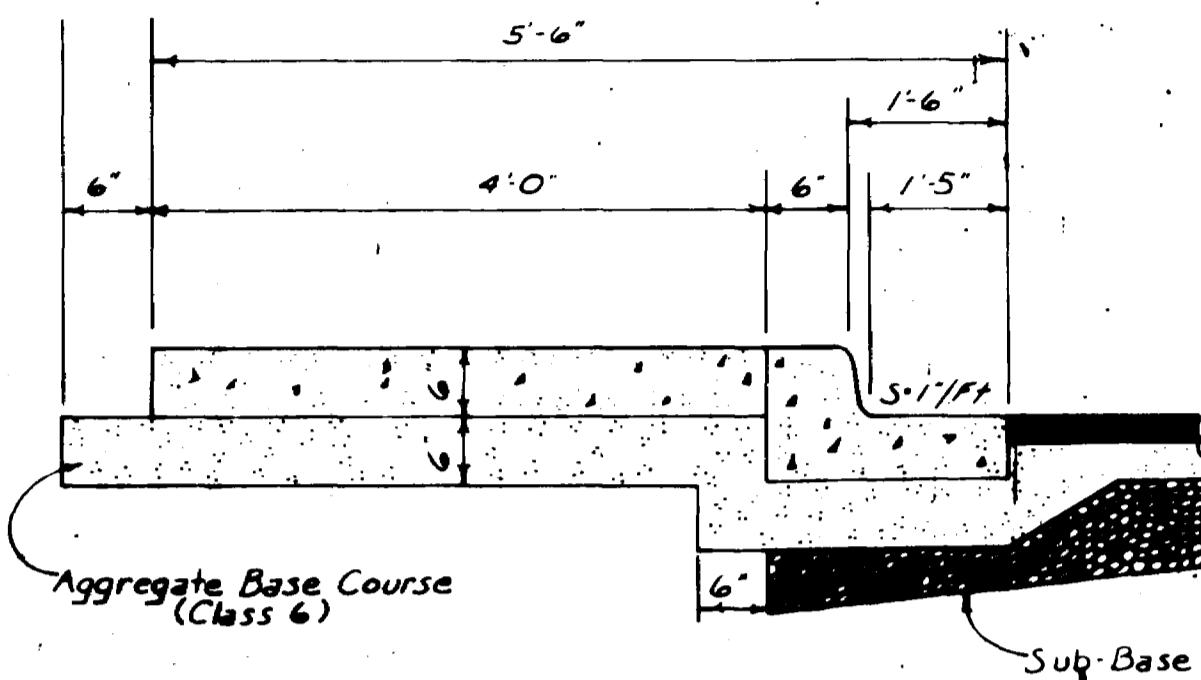


GENERAL NOTES

THE FOLLOWING SPECIFICATIONS ARE MADE A PART OF THIS CONTRACT

- ALL CURRENT MESA COUNTY STREET SPECIFICATIONS SHALL APPLY
- NO ROAD CUTS WILL BE MADE AFTER PLACEMENT OF ASPHALT WITHOUT APPROVAL OF MESA COUNTY DEPARTMENT OF STREETS.
- MANHOLE RAMPS TO BE BROUGHT TO GRADE BY PAVING CONTRACTOR AFTER PAVEMENT IS PLACED
- CONTRACTOR IS RESPONSIBLE FOR LOCATING & PROTECTING UNDERGROUND UTILITIES
- SEWER CONTRACTOR TO BRING MANHOLES UP TO BOTTOM OF SUBBASE.
- FINISH GRADES ARE SHOWN TO BACK SIDEWALK.
- ALL STATIONING IS TO SURVEY LINE.

Scale 1"=40'

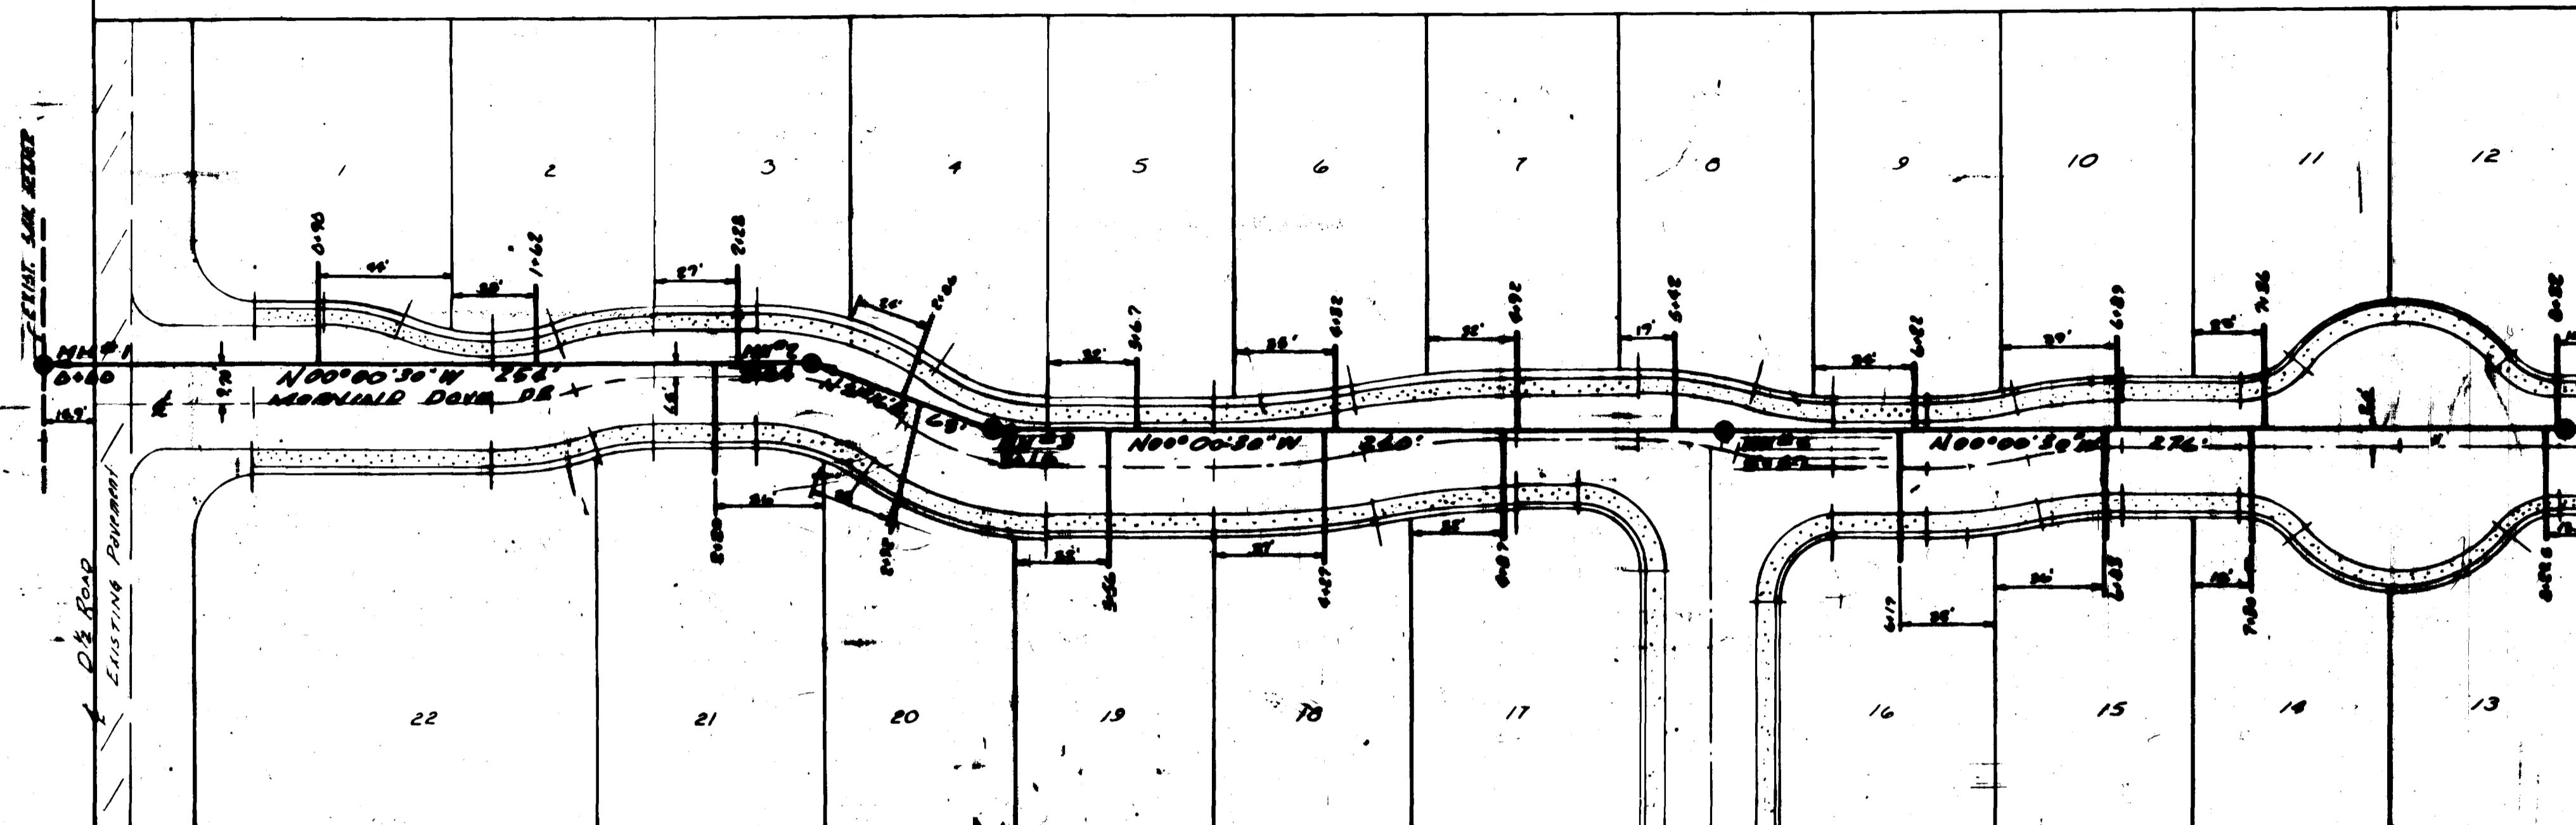

Typical 44' Street Section

GENERAL NOTES:

1. THIS SUBDIVISION IS SERVED BY CENTRAL GRAND VALLEY SANITATION DISTRICT.
2. THIS IS TO VERIFY THAT THE SYSTEM INFILTRATION DOES NOT EXCEED 200 GALLONS PER INCH DIAMETER PER MILE OF LENGTH OF PIPE FIELD INSPECTED APRIL 6, 1983
3. 8" PVC ASTM 3034D SEWER PIPE INSTALLED.

"AS-BUILT"

TOPAZ SUBDIVISION
SEWER PLAN & PROFILE



W.H. LIZER & ASSOCIATES
ENGINEERING & SURVEYING
576 25 ROAD, UNIT B 291-1129
GRAND JUNCTION, COLORADO

PROJECT NO.	DATE	HEET
82 768 8	OCT 1982	