

ROBERT ALLEN FOWLER, BEING DULY
LICENSED TO PRACTICE AS A CIVIL ENGINEER IN THE
STATE OF COLORADO, DO HEREBY
SITE ORGANIZATIONAL SURVEYS AND
BOUNDARY SURVEYS LINES, HIGHWAY
PREPARED BY COLORADO DIVISION
THAT TO THE BEST OF MY KNOWLEDGE
AND BELIEF, THE SURVEYS ARE
ACCURATE TO THE BEST OF COLORADO
AND DIVISION DIVISION WITH THE
EXCEPTIONS OF THE SURVEY
NOT EXCEED 200 FEET IN LENGTH
PER VALE OF SURVEY LINE DATE.





CWA COLORADO WEST
ASSOCIATES INC.

NC
ENGINEERING
SURVEYING
PLANNING
303 245-2767

AS-BUILTS
HIGHLINE ESTATES

835 COLORADO AVENUE
GRAND JUNCTION, COLORADO 81501

DES	CK	JOB NO	SHEET Z
DRD	DATE 9/83	COUNTY FILE NO	OF Z

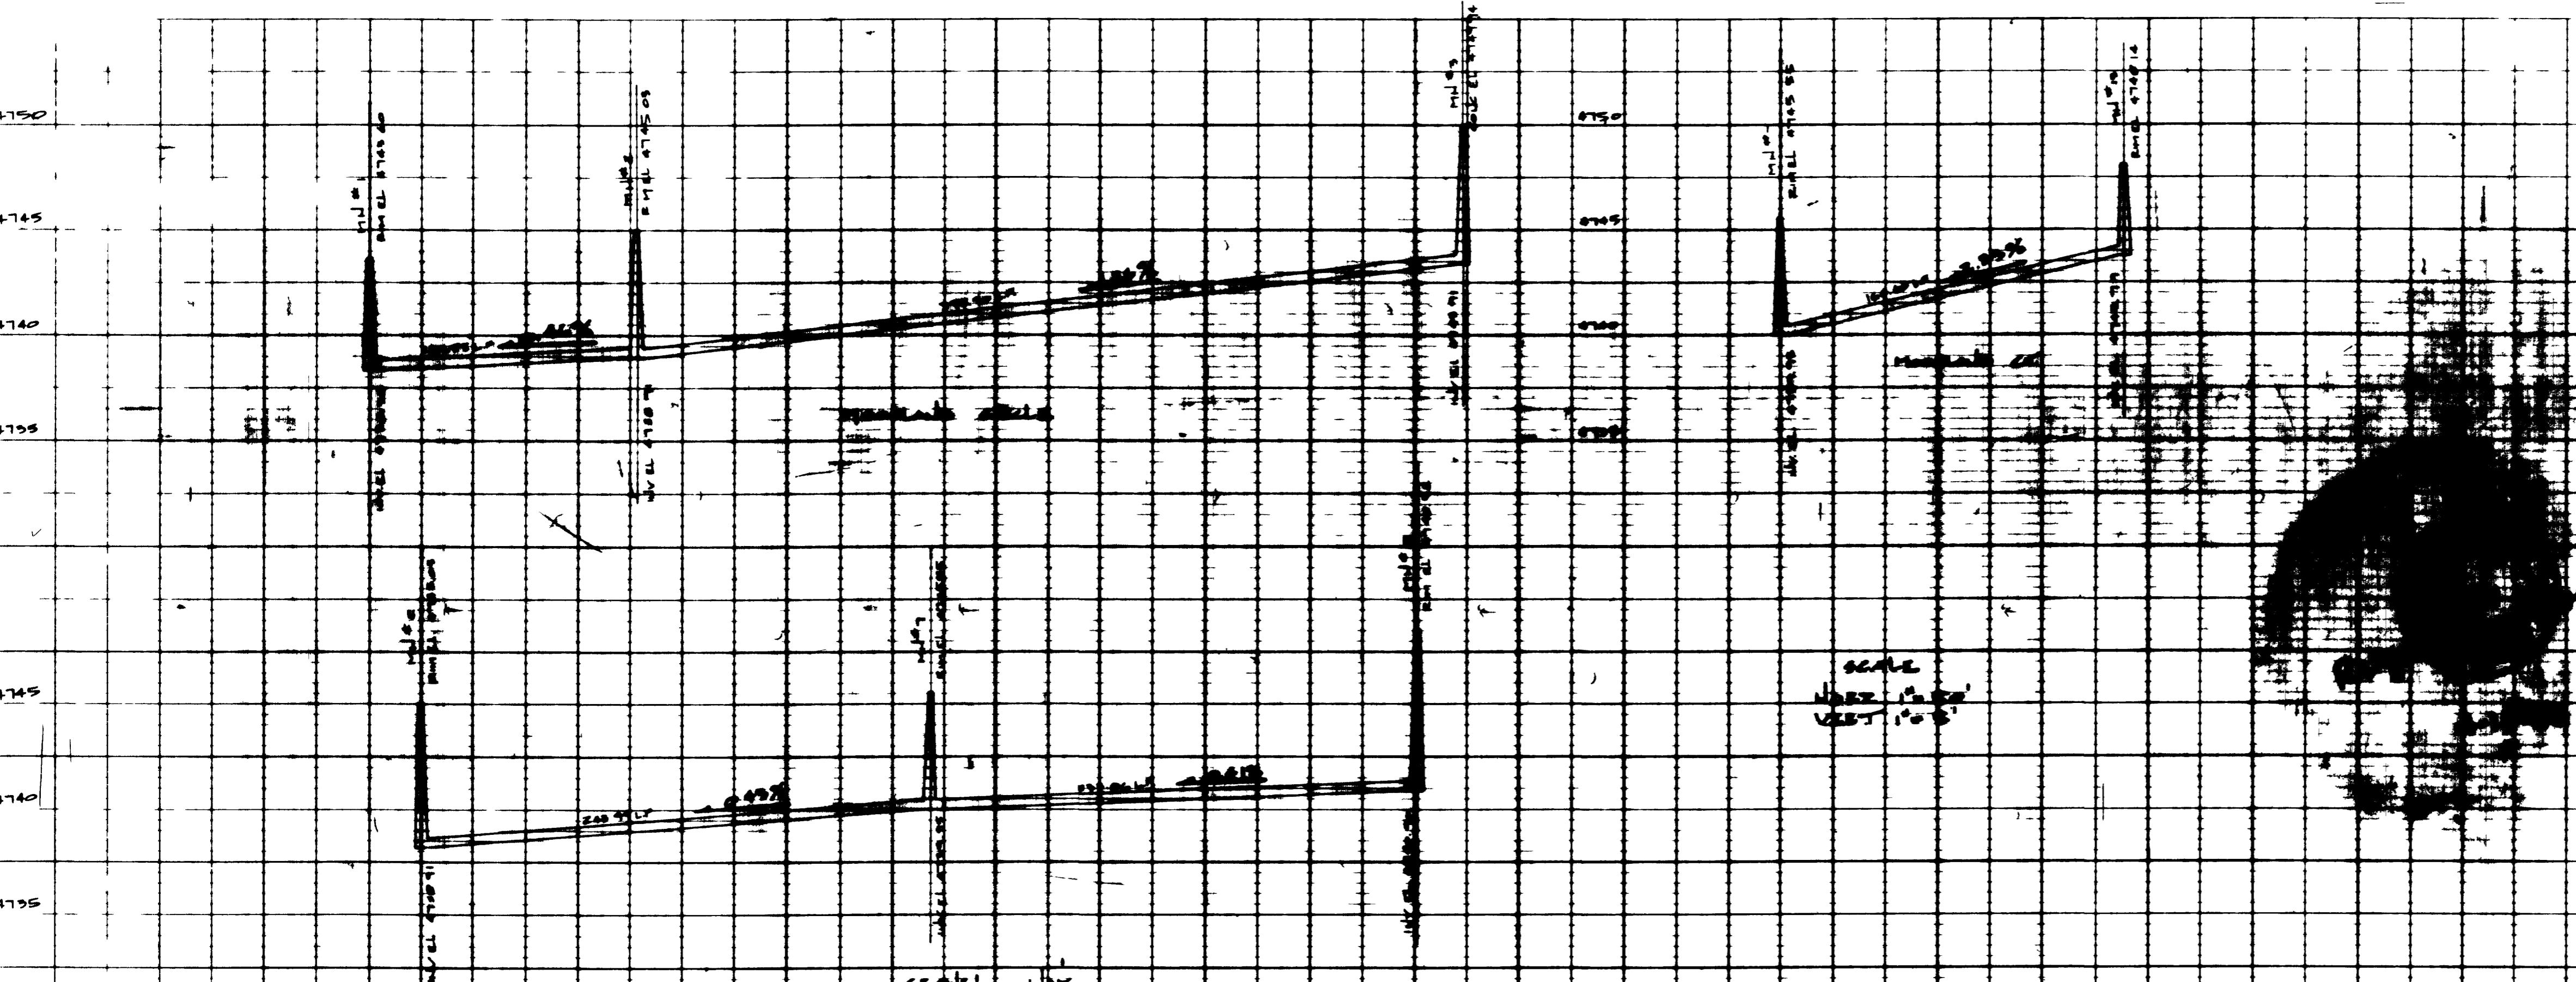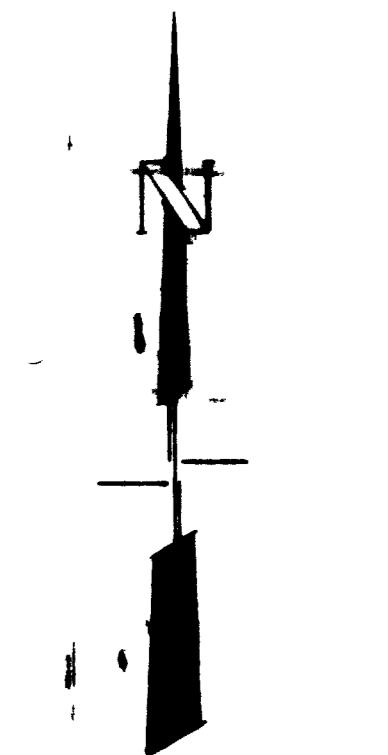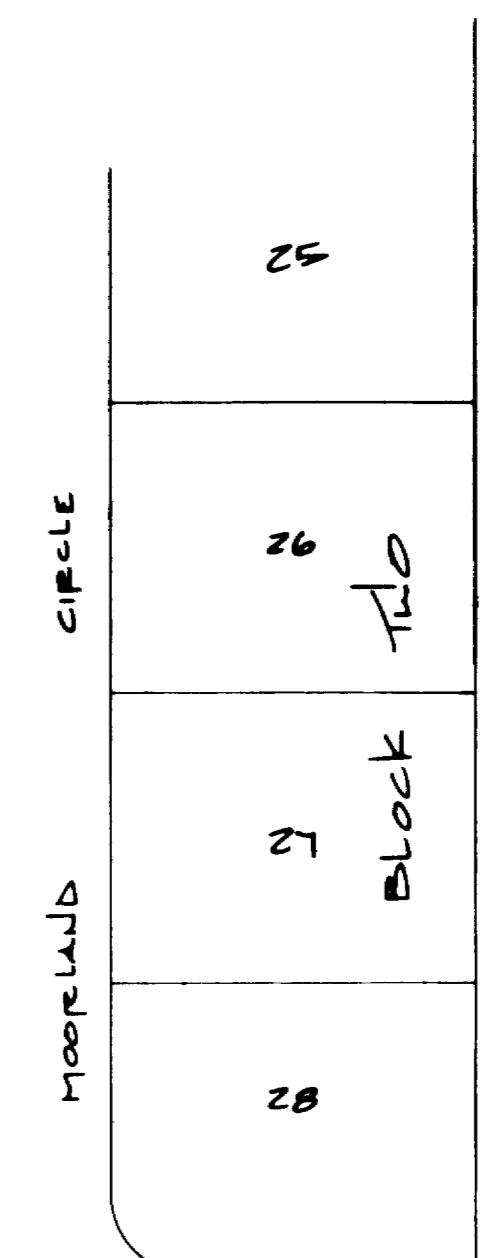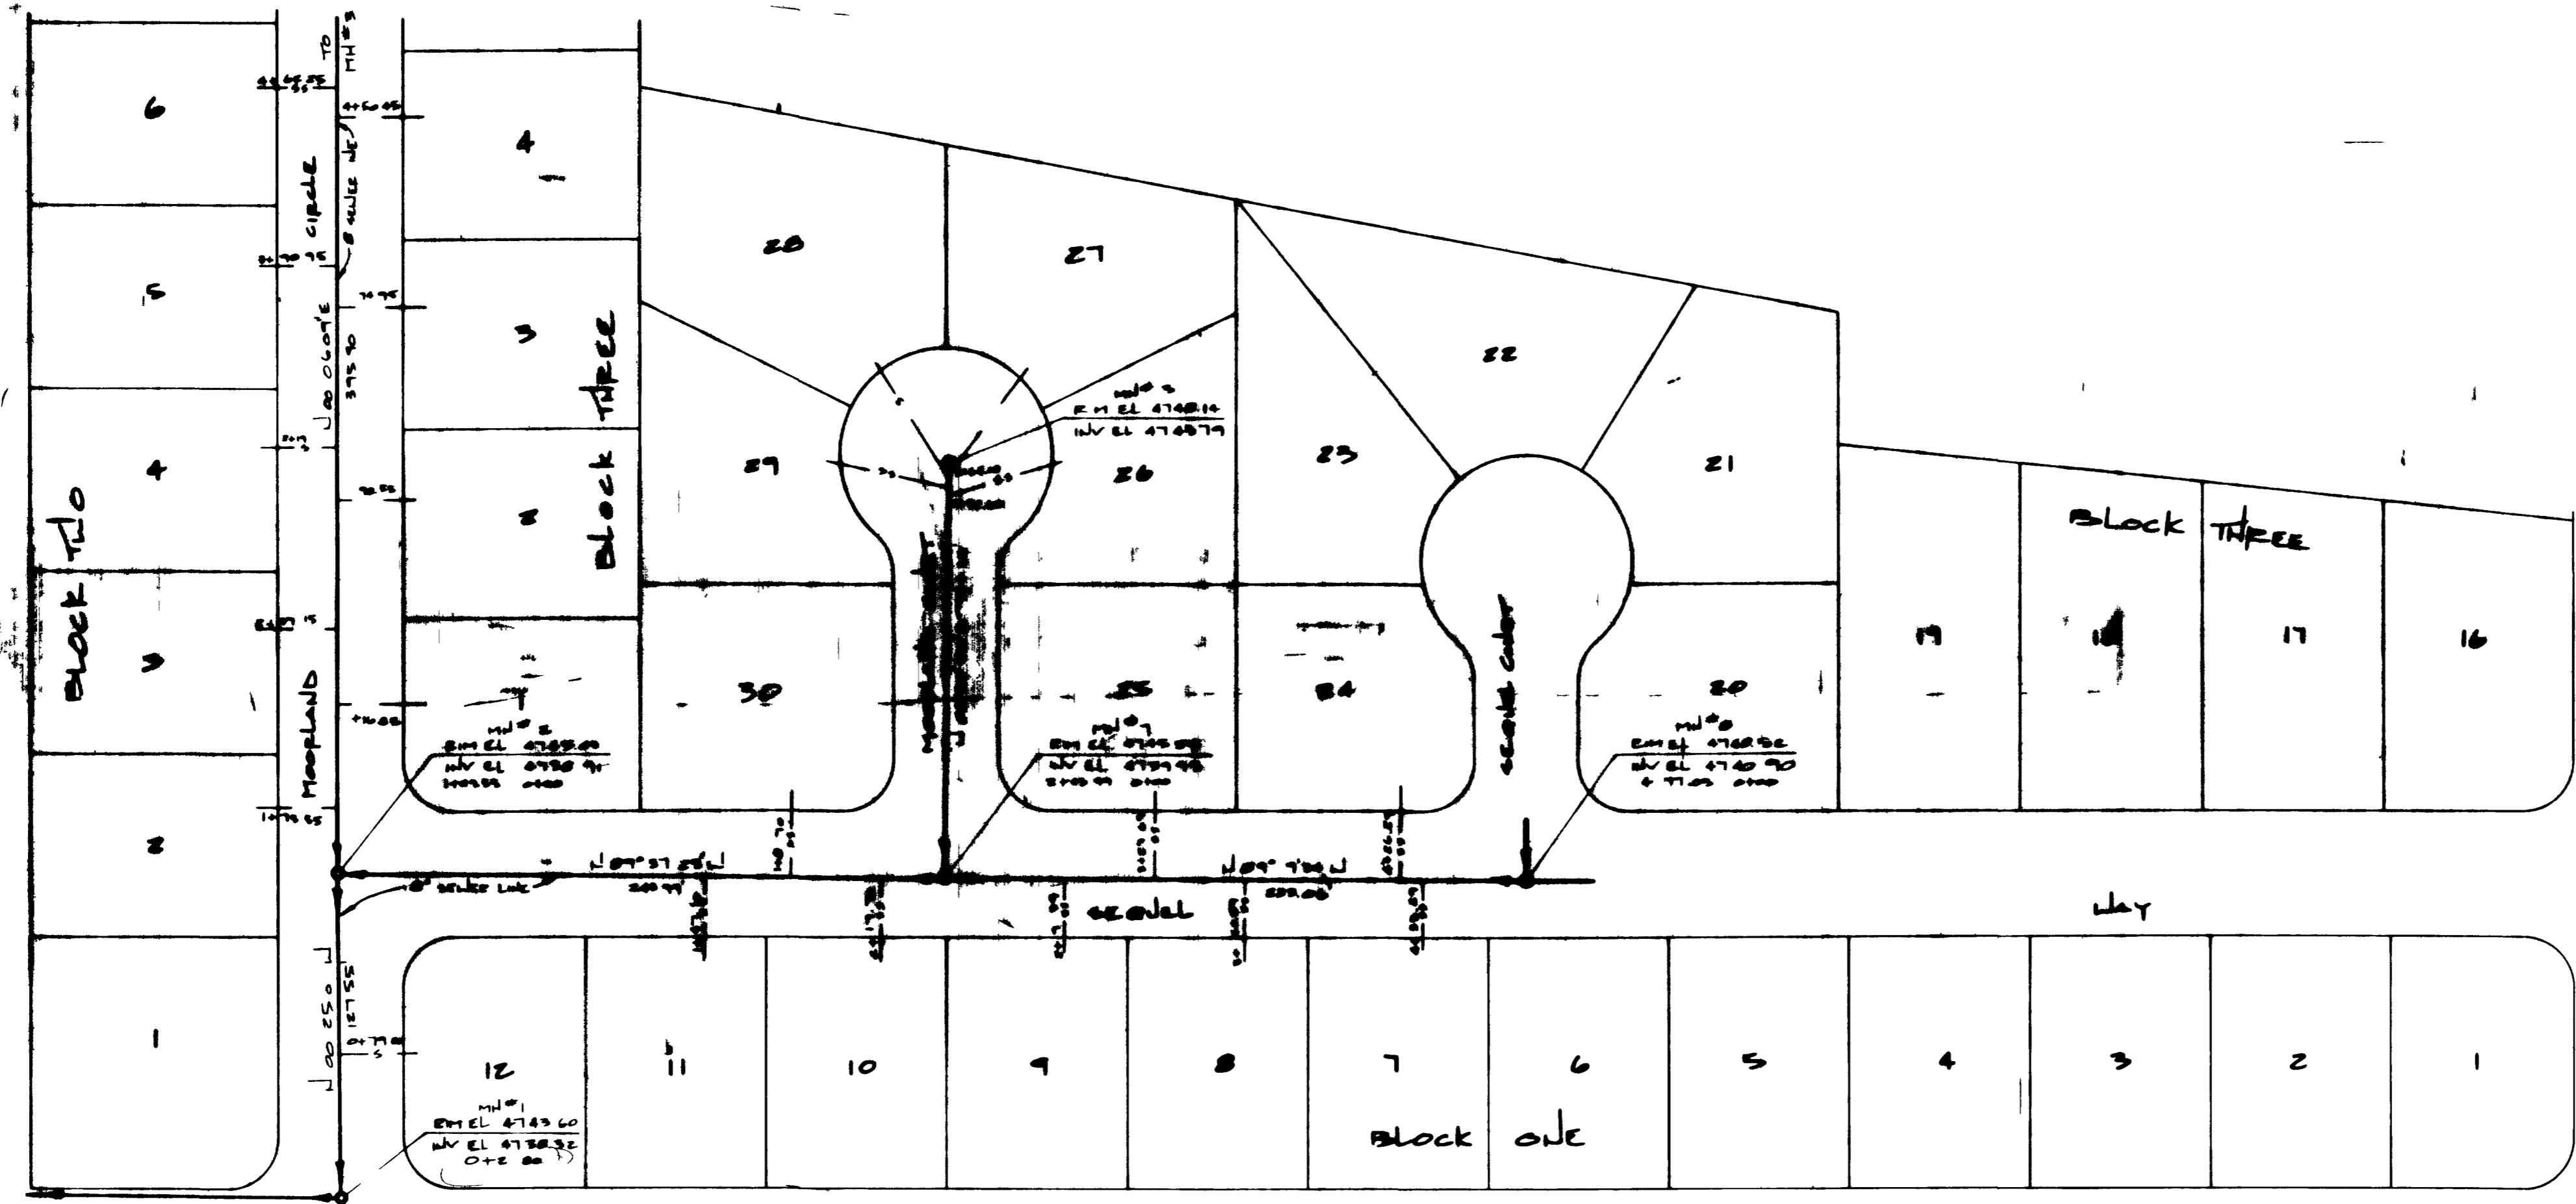

NO DATE REVISION BY

CWA COLORADO WEST ASSOCIATES INC.
ENGINEERING SURVEYING PLANNING
303 245 2767
835 COLORADO AVENUE
GRAND JUNCTION COLORADO 81501

DES	CK	JOB NO	SHEET 1
DR 1/83	DATE 4/83	COUNTY FILE NO	OF 2

AS - BUILTS
HIGHLINE ESTATES