


This drawing prepared under my direct supervision.

HOWARD A. PAUL
REGISTERED PROFESSIONAL ENGINEER
Colorado License #110-1932
1982

SCALE

1" = 20' Horiz.
1" = 5' Vert.

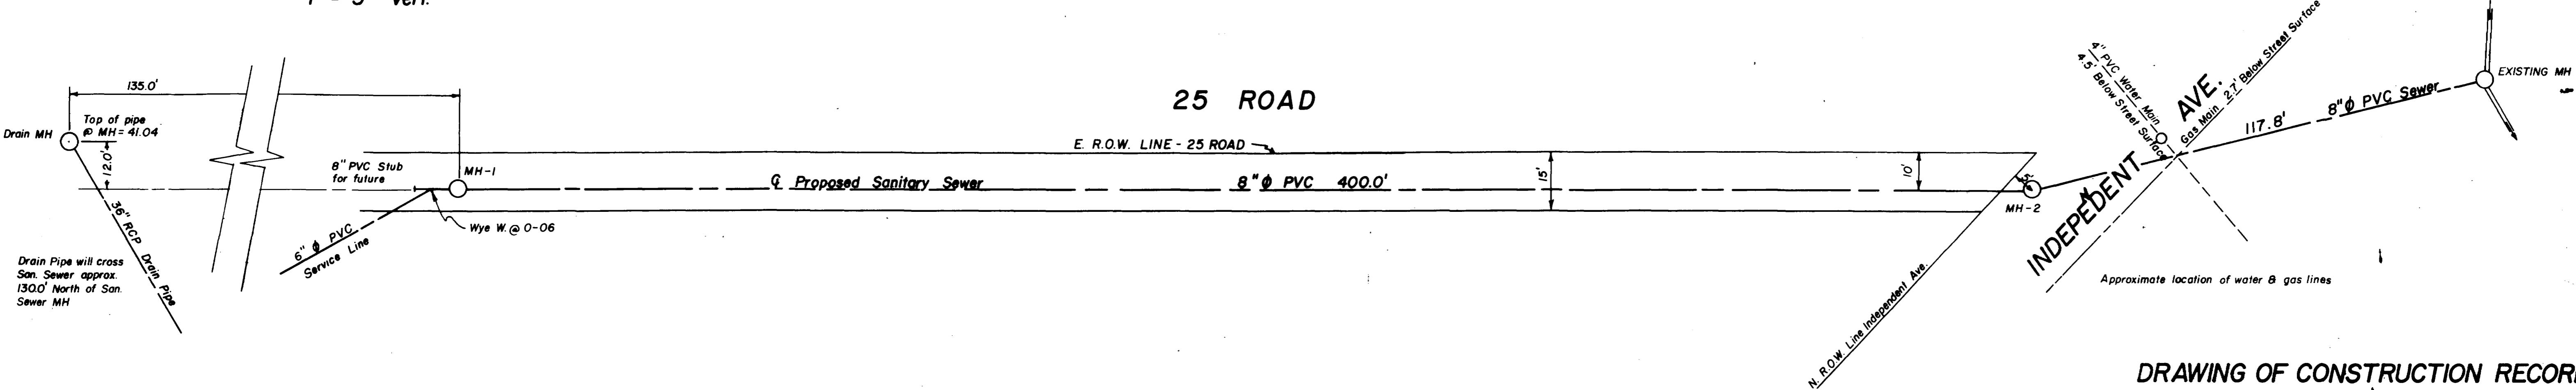

DRAWING OF CONSTRUCTION RECORDS

3/28/83

