


- GENERAL NOTES:**
1. CONSTRUCT 100' OF 8" SANITARY SEWER LINE AND MANHOLE BY CITY CREWS.
 2. INSTALL 3, 4" SERVICE LINES AS SHOWN.
 3. REPLACE AND COMPACT TRENCH TO WITHIN 8" FROM SURFACE.
 4. PLACE AND COMPACT 8" OF CLASS 6 (3/4") BASE COURSE FROM TOP OF BACKFILL TO SURFACE.
 5. PAVEMENT REPLACEMENT BY OTHERS.

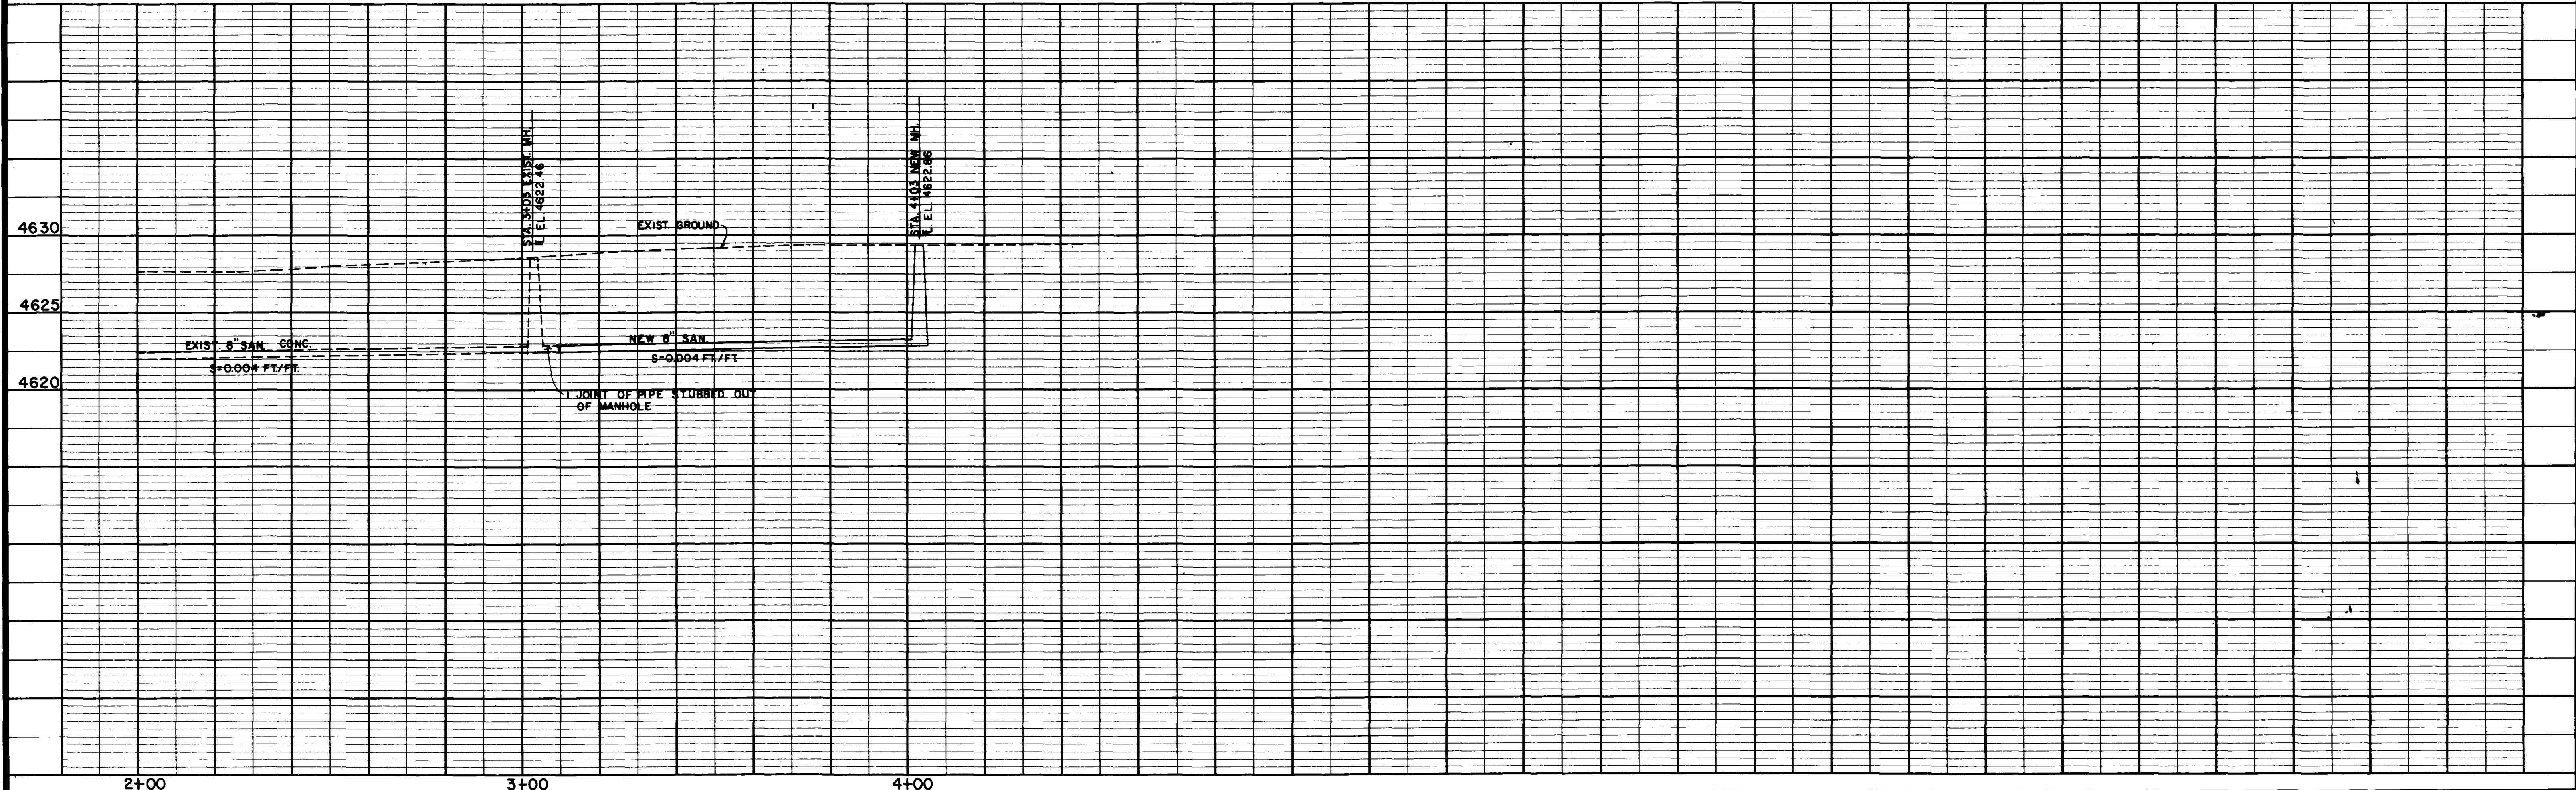

REVISION Δ As Built	DATE 7/23/84	DRAWN BY T.A.B.	DATE 5/10/83
REVISION Δ		CHECKED BY	DATE
REVISION Δ		APPROVED BY J.D.N.	DATE 5/10/83
REVISION Δ		FIELD BOOK NO. II	PAGE 179

DEPARTMENT OF PUBLIC WORKS AND UTILITIES
ENGINEERING DIVISION
CITY OF GRAND JUNCTION, COLORADO

ASPEN STREET
SANITARY SEWER EXTENSION

SHEET NO. 1
OF 1
FILE NO. 02-389