


SCALE: 1" = 20'

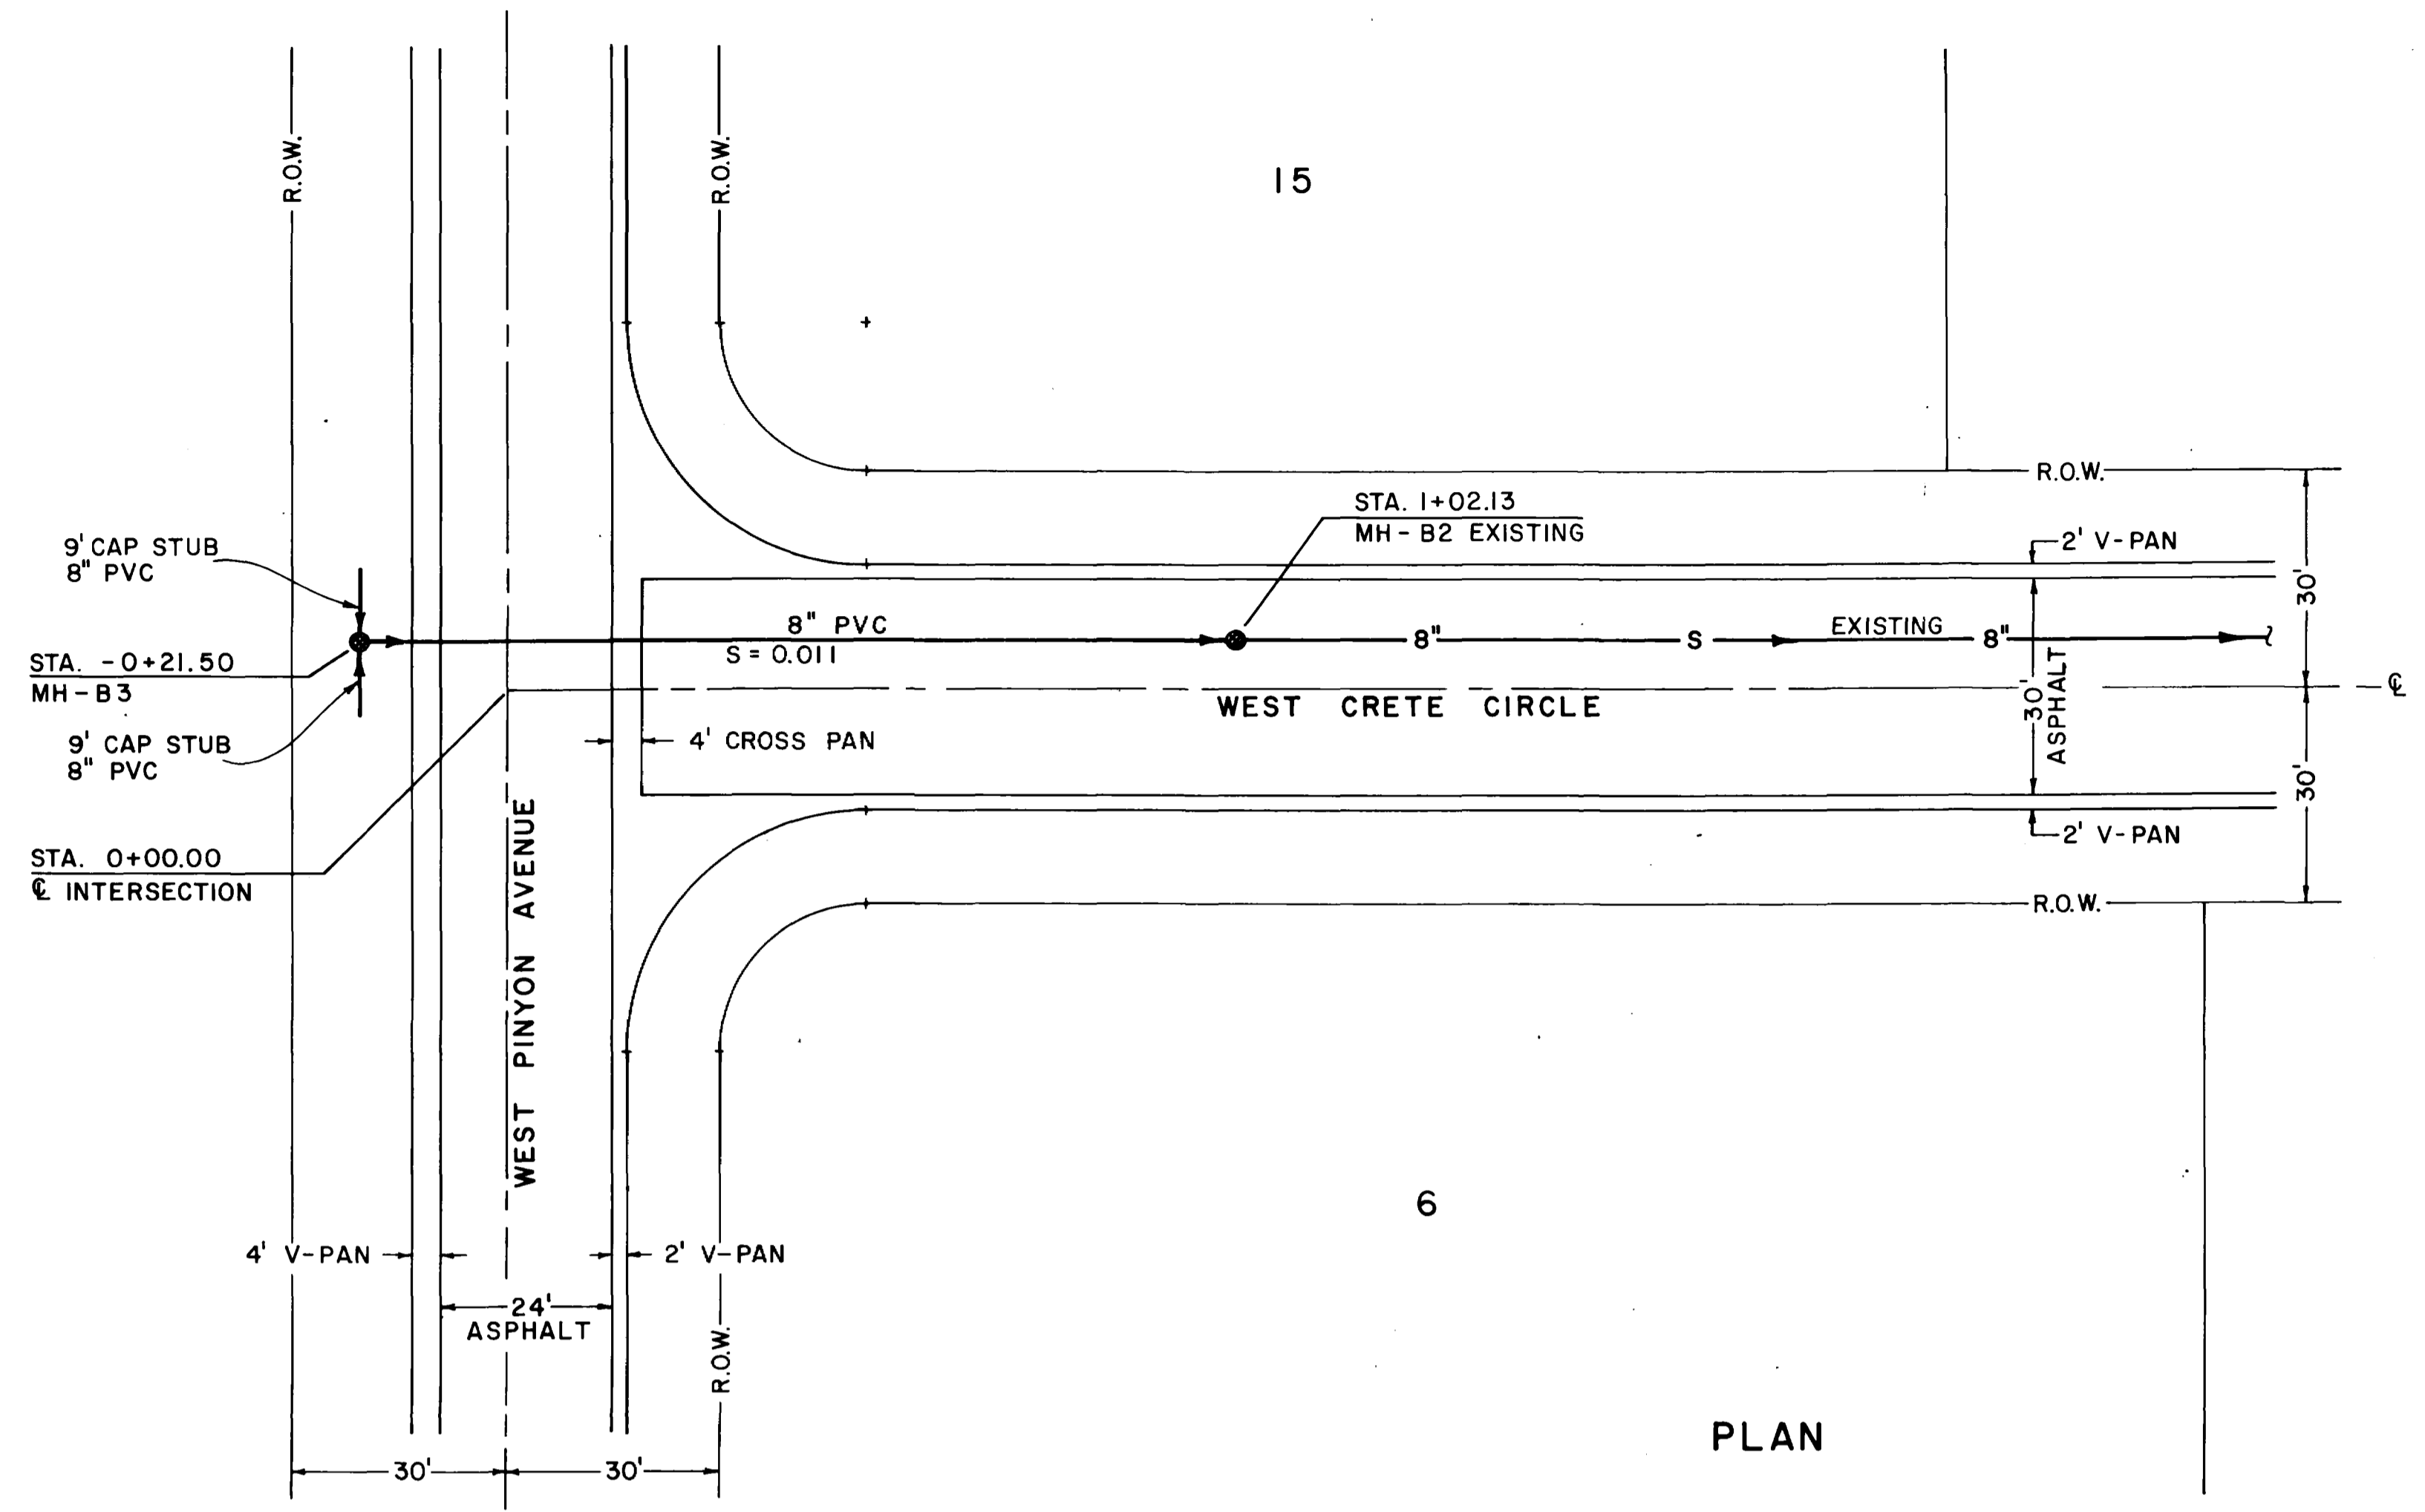


NOTES:

THE INFILTRATION FOR THIS SANITARY SEWER SYSTEM DOES NOT EXCEED 200 GPD / INCH DIA. / MILE.

ALL STATIONS REFER TO ℄ STATIONS

ALL SEWER DISTANCES ON PLAN VIEW ARE ℄ MANHOLE TO ℄ MANHOLE, ALL SEWER DISTANCES ON PROFILE VIEW ARE INSIDE MANHOLE WALL TO INSIDE MANHOLE WALL.

SEE COLORADO WEST SURVEYING COMPANY SEWER AS-BUILT DWG. NO. 1012 FOR MINERVA PARK FOR ADDITIONAL INFORMATION, STATION, AND ELEVATION DATUM

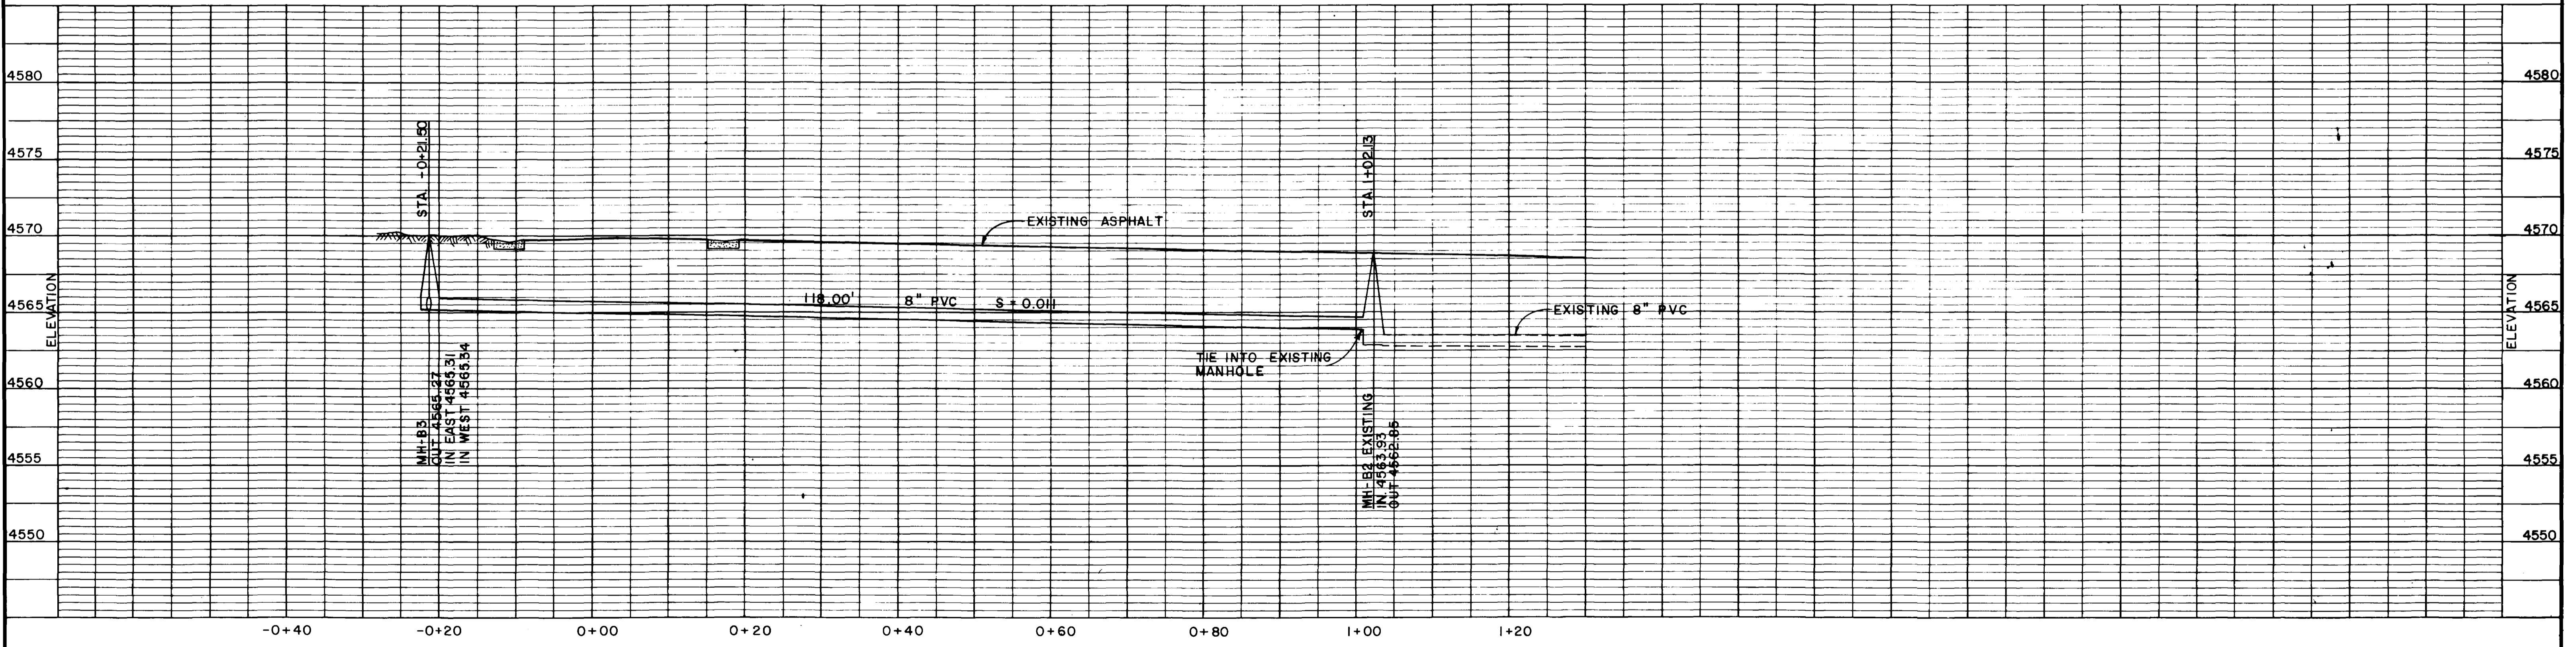

PROFILE
SCALE: HORIZ.: 1" = 10'
VERT.: 1" = 5'



SEWER AS-BUILT

WESTERN CONSULTING ENGINEERS AND SURVEYORS
2150 Hwy. 6 & 50, Grand Junction, CO 81505 • 303-942-6882

CITY OF GRAND JUNCTION, COLORADO

**MINERVA PARK
SEWER PLAN**

MESA COUNTY, COLORADO

DESIGN S.W.V. DRAWN D.L.H. CHECKED T.R.M.
DATE 4 / 27 / 84 DWG. NO. 1-98-1105