


NOTES: INFILTRATION DOES NOT EXCEED 200 GALLONS PER INCH OF PIPE DIAMETER PER MILE PER DAY.

LIFT STATION HAS BEEN ABANDONED AND REPLACED AS MANHOLE.

SEE WESTERN ENGINEERS, INC. AS-BUILT DWGS. NO. 796-9A B 796-9B FOR LINE A.

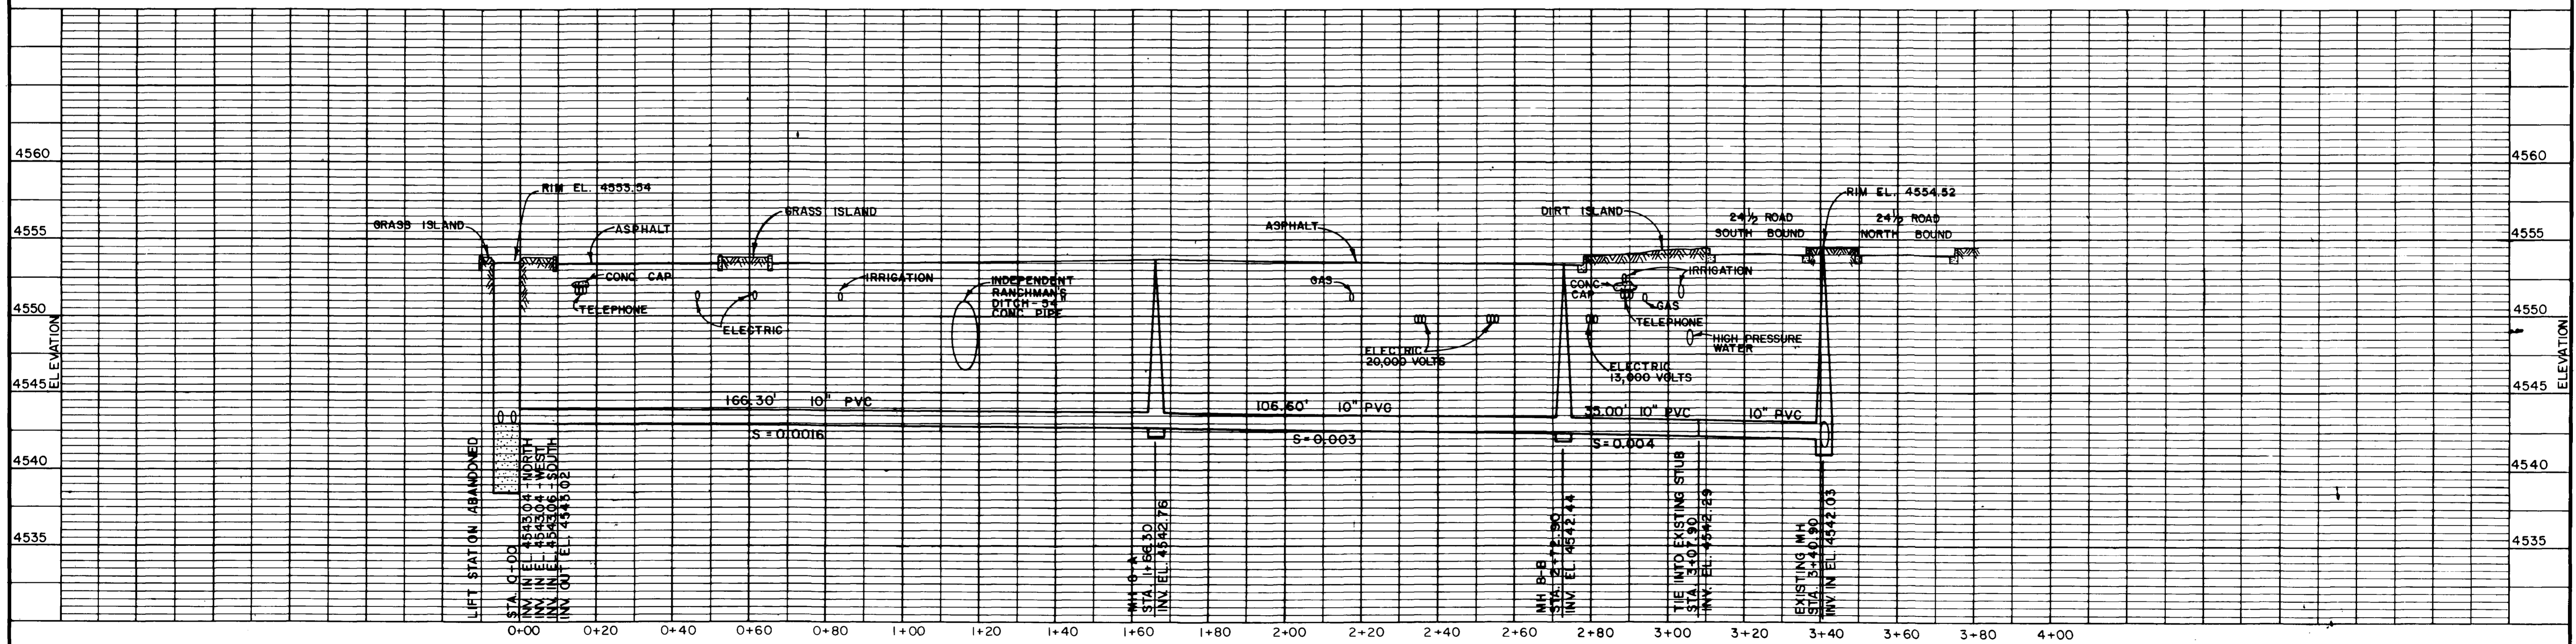

SEWER AS-BUILT

**WESTERN** CONSULTING ENGINEERS/LAND SURVEYORS  
2150 Hwy. 4 & 50 Grand Junction CO 81505 • 303242-0202

GENERAL GROWTH PROPERTIES  
MESA MALL  
LINE C  
CONNECTION TO THE  
24 1/2 ROAD SEWER MAIN  
CITY OF GRAND JUNCTION  
MESA COUNTY, COLORADO

DESIGN	S.W.V.	DRAWN	R.W.G.	CHECKED	T.K.H.
DATE	6/7/84	DWG NO.	1010-796-29		