

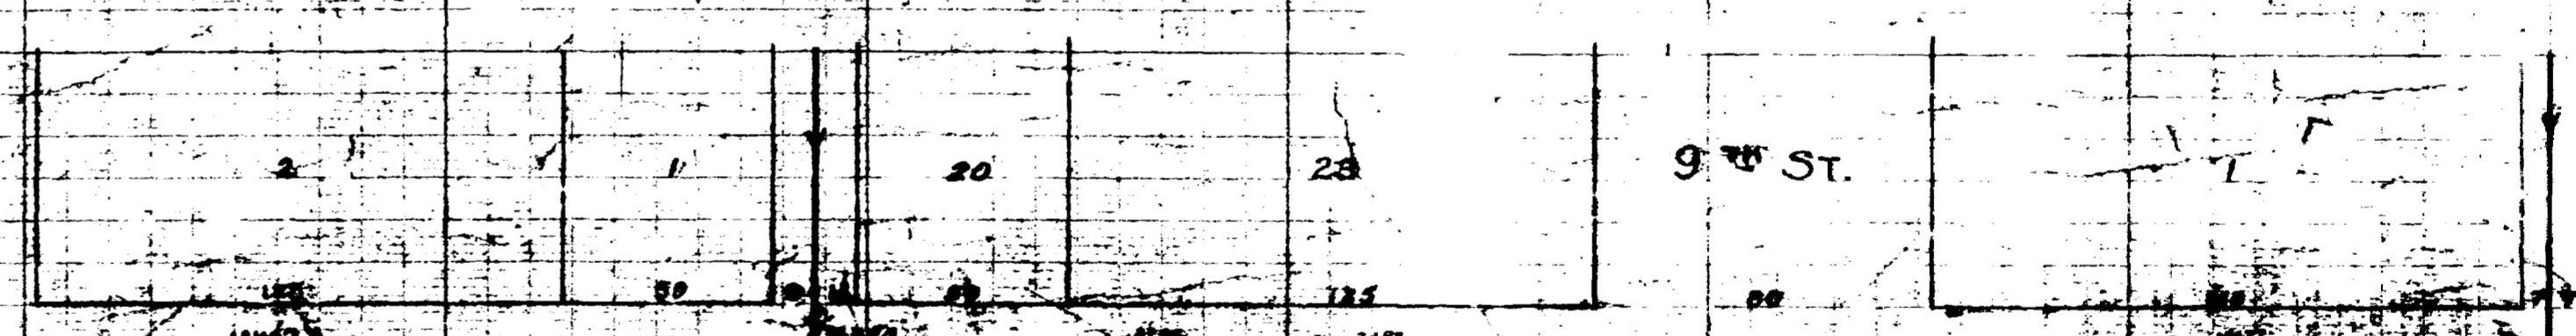
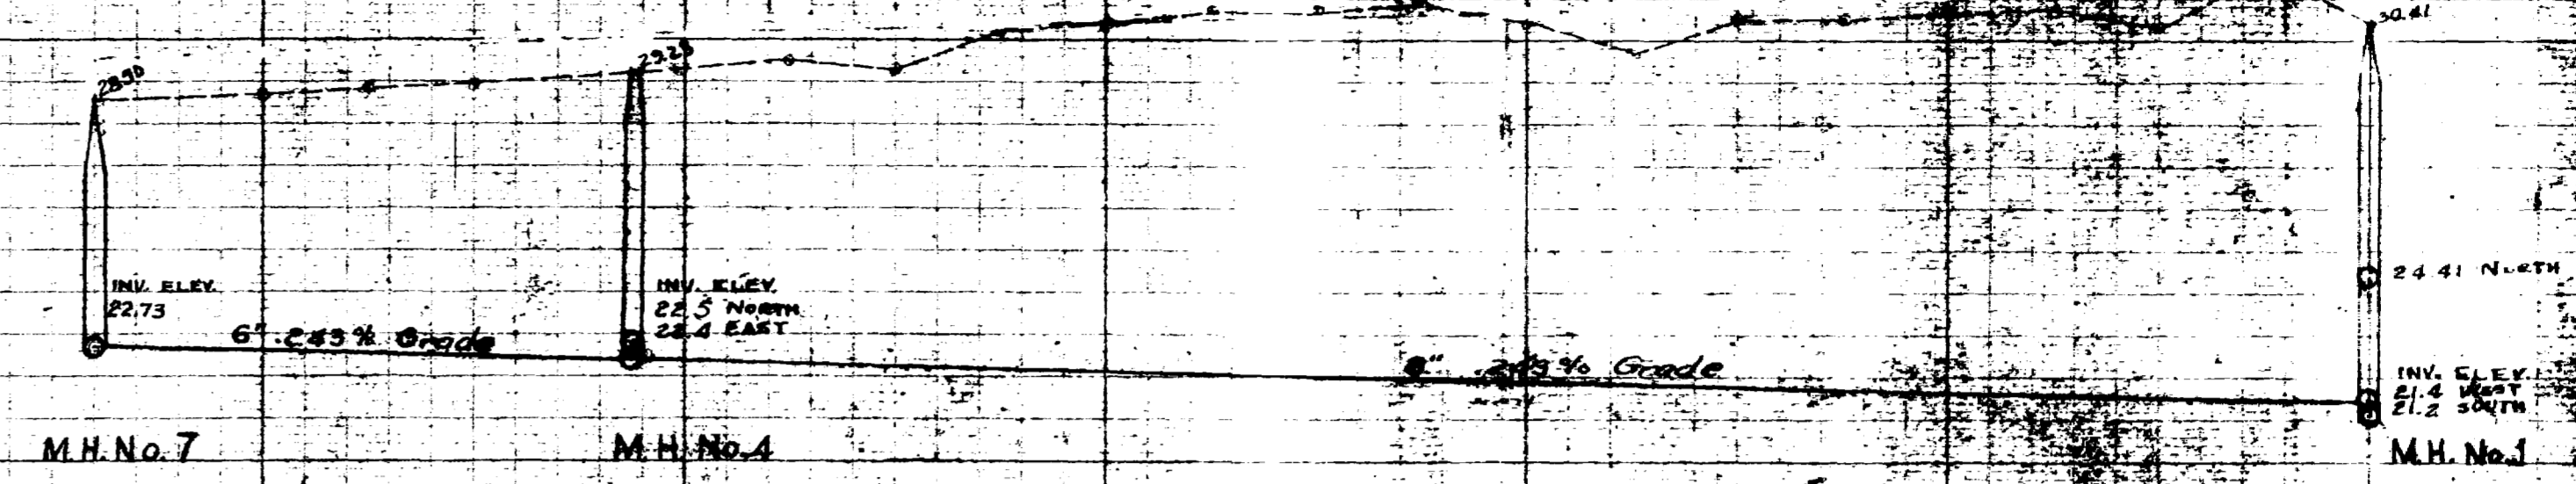
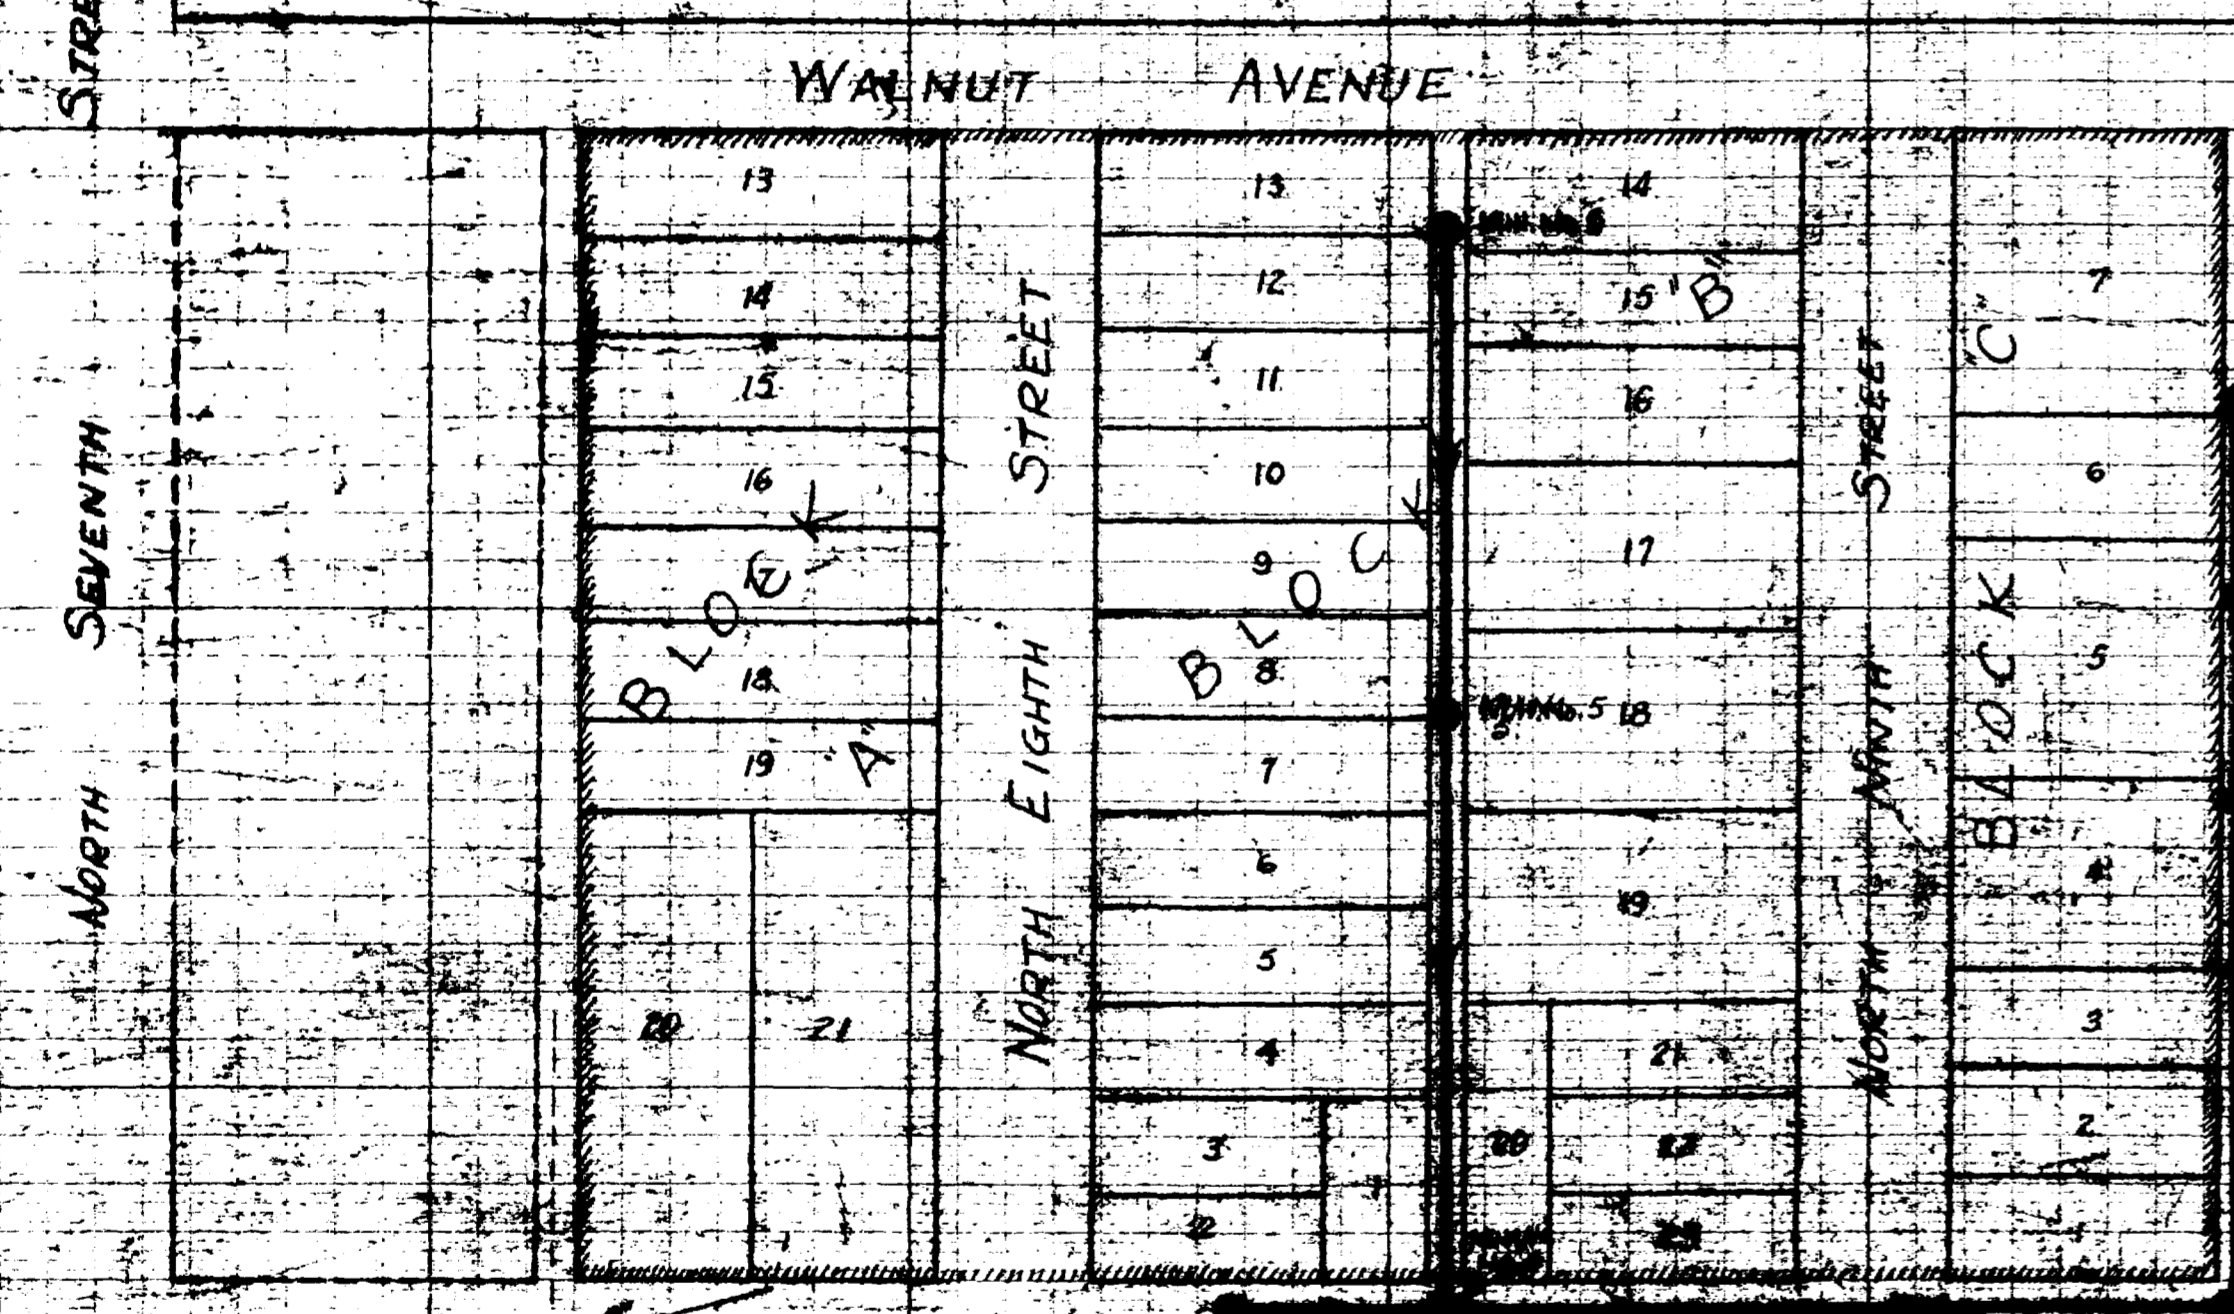




SANITARY SEWER DIST. 14

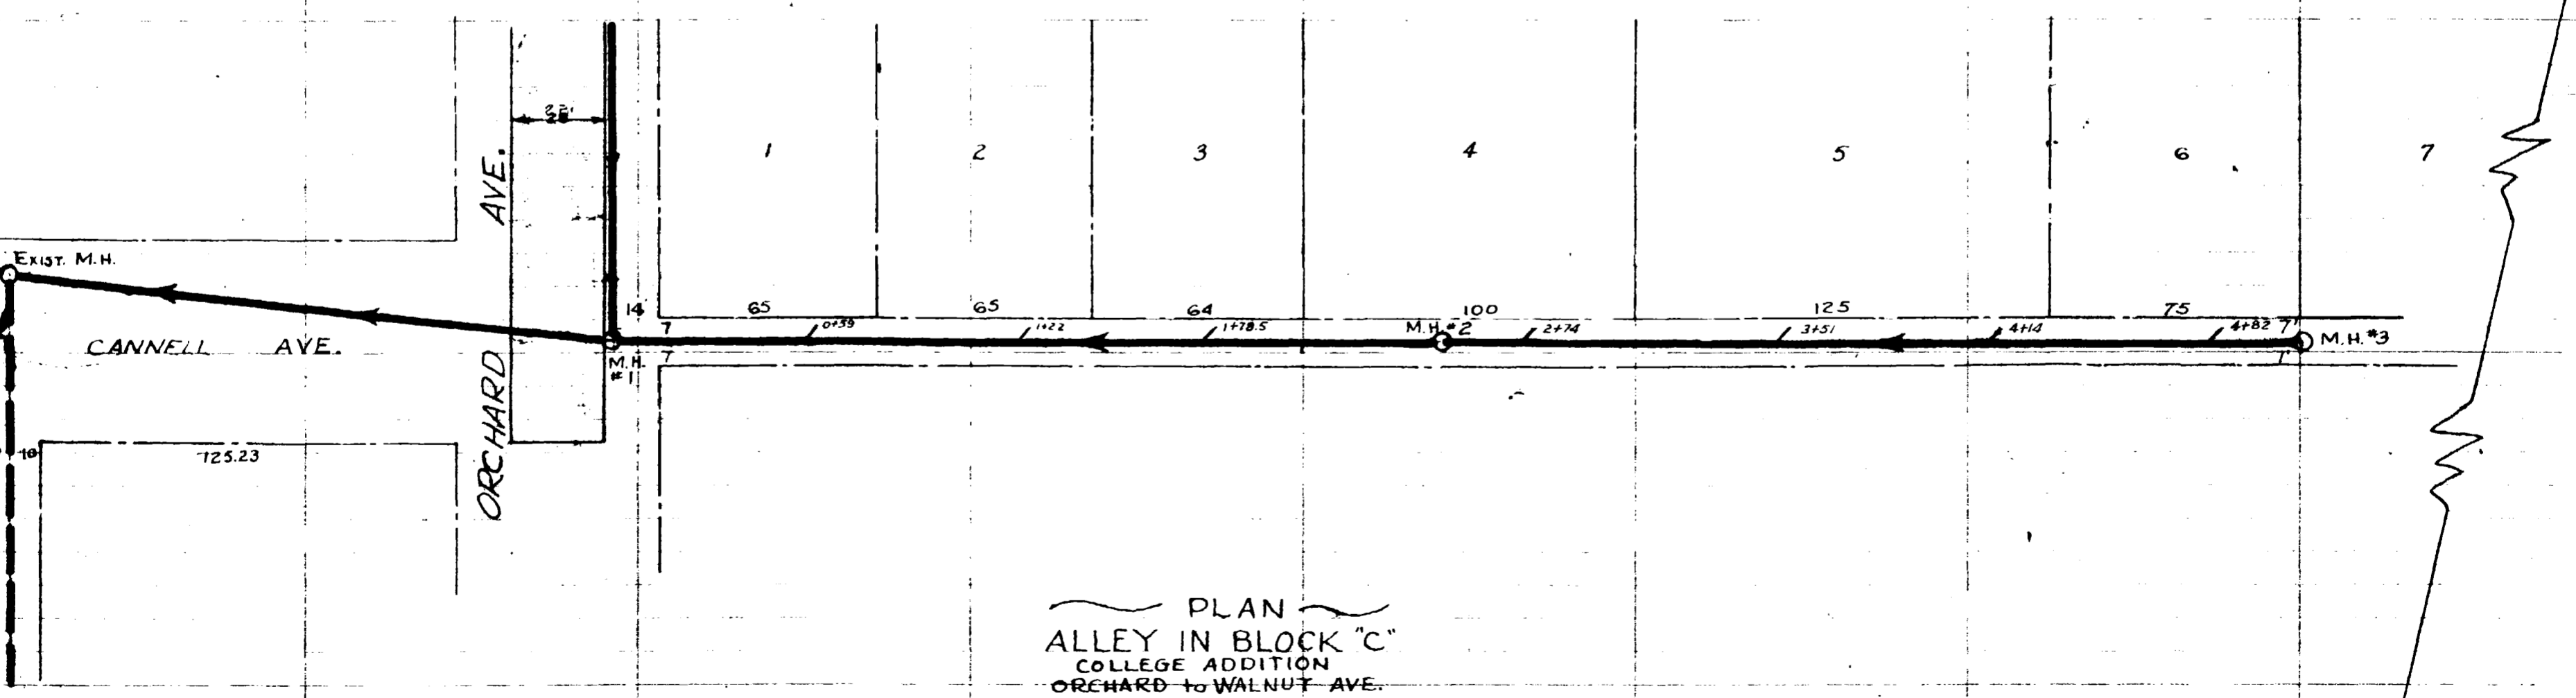

PLAN
ORCHARD AVENUE
8TH STREET - CANNELL AVE.
SCALE 1" = 40'
Sanitary Sewer as Constructed
1929

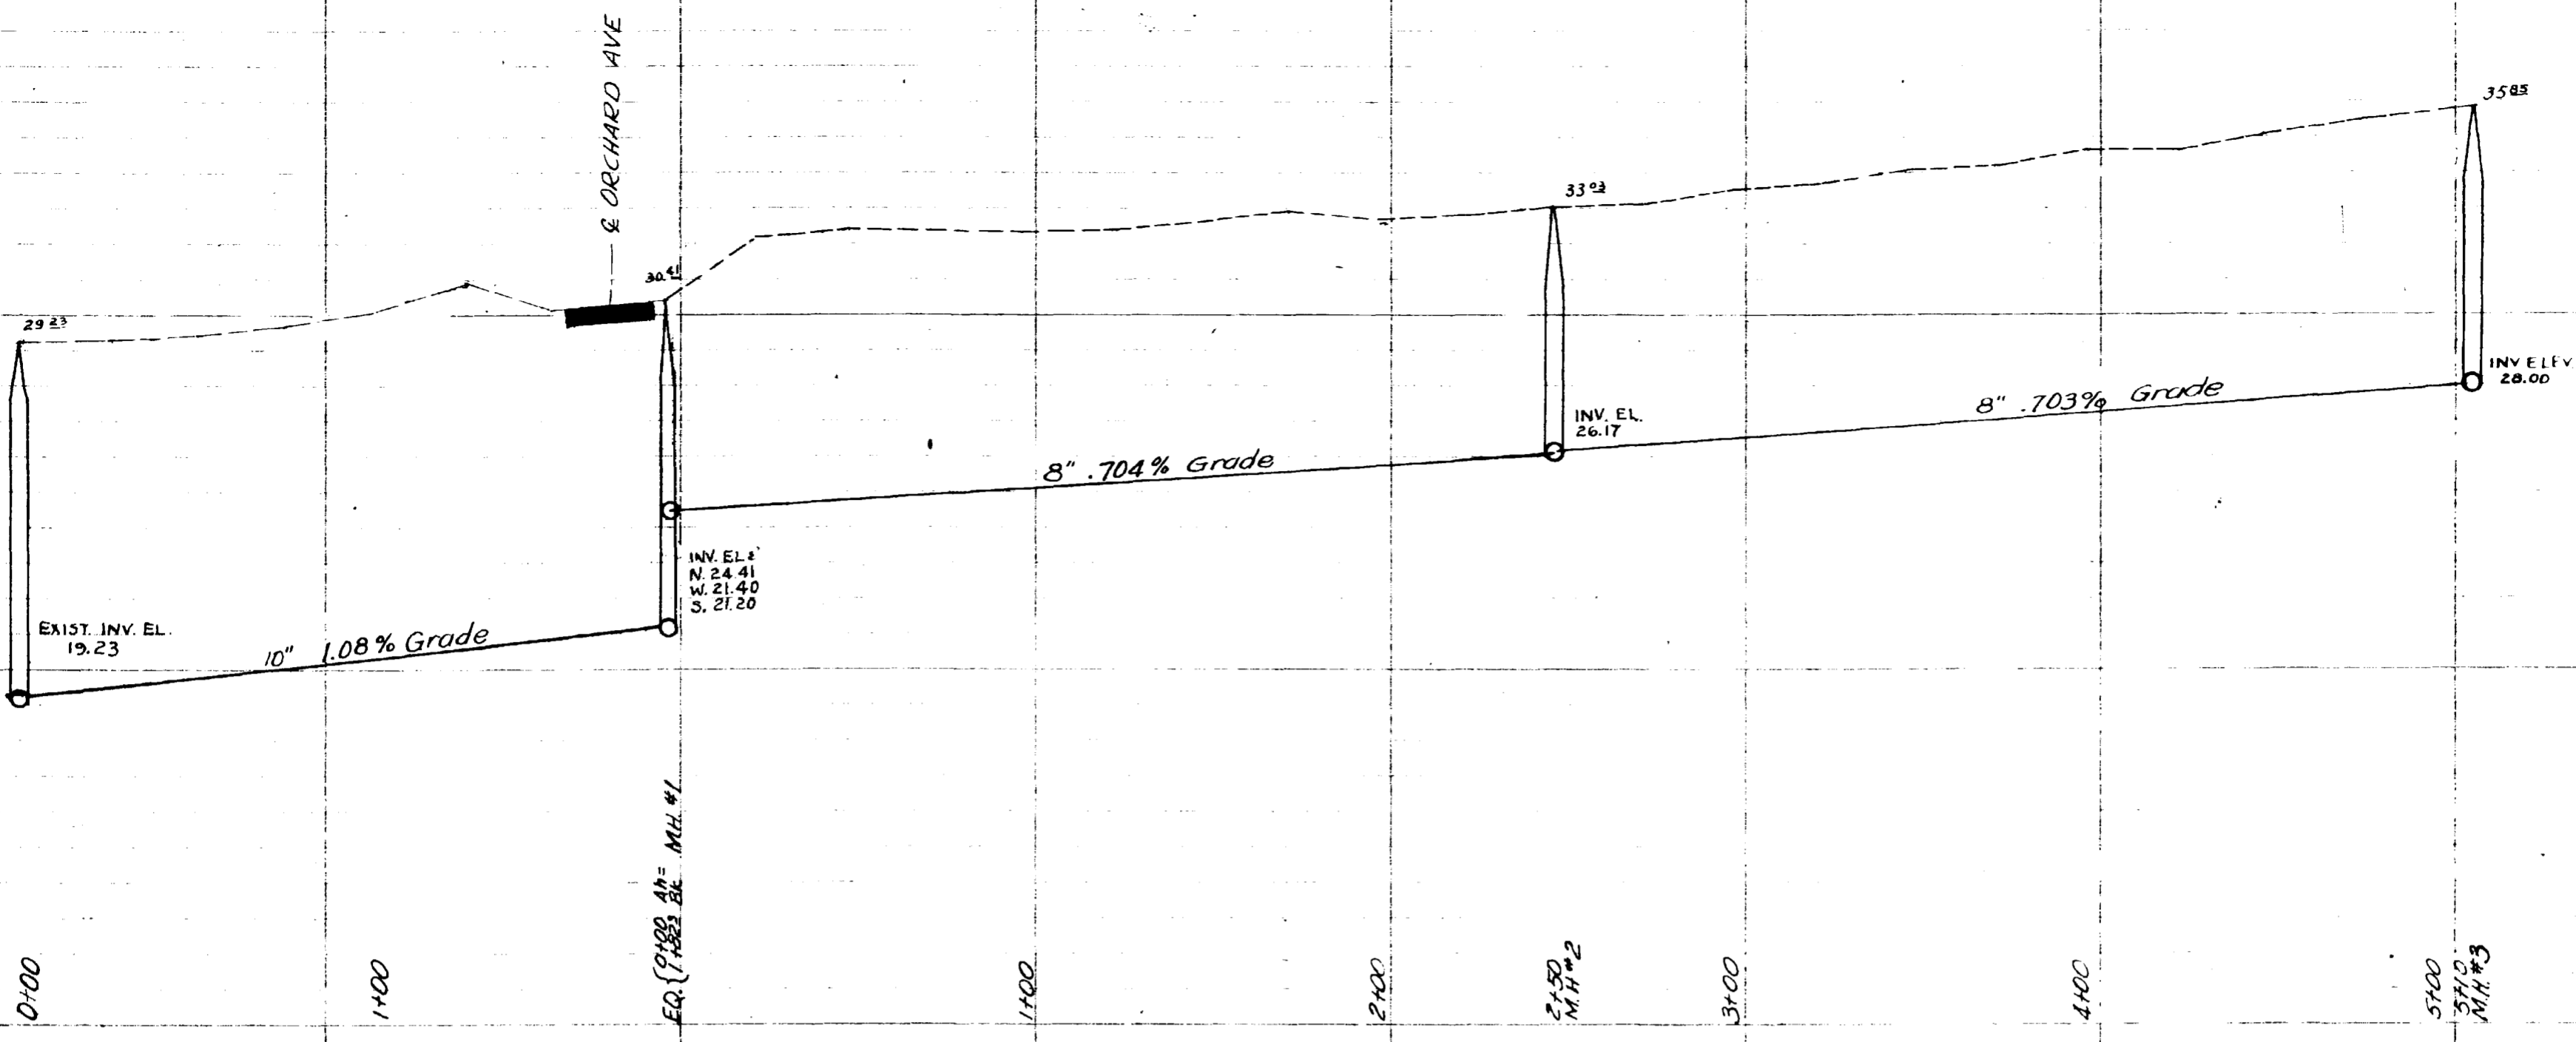

PLAN
 ALLEY IN BLOCK "C"
 COLLEGE ADDITION
 ORCHARD TO WALNUT AVE.
 SCALE: 1" = 40'
 Sanitary Sewer as Const.

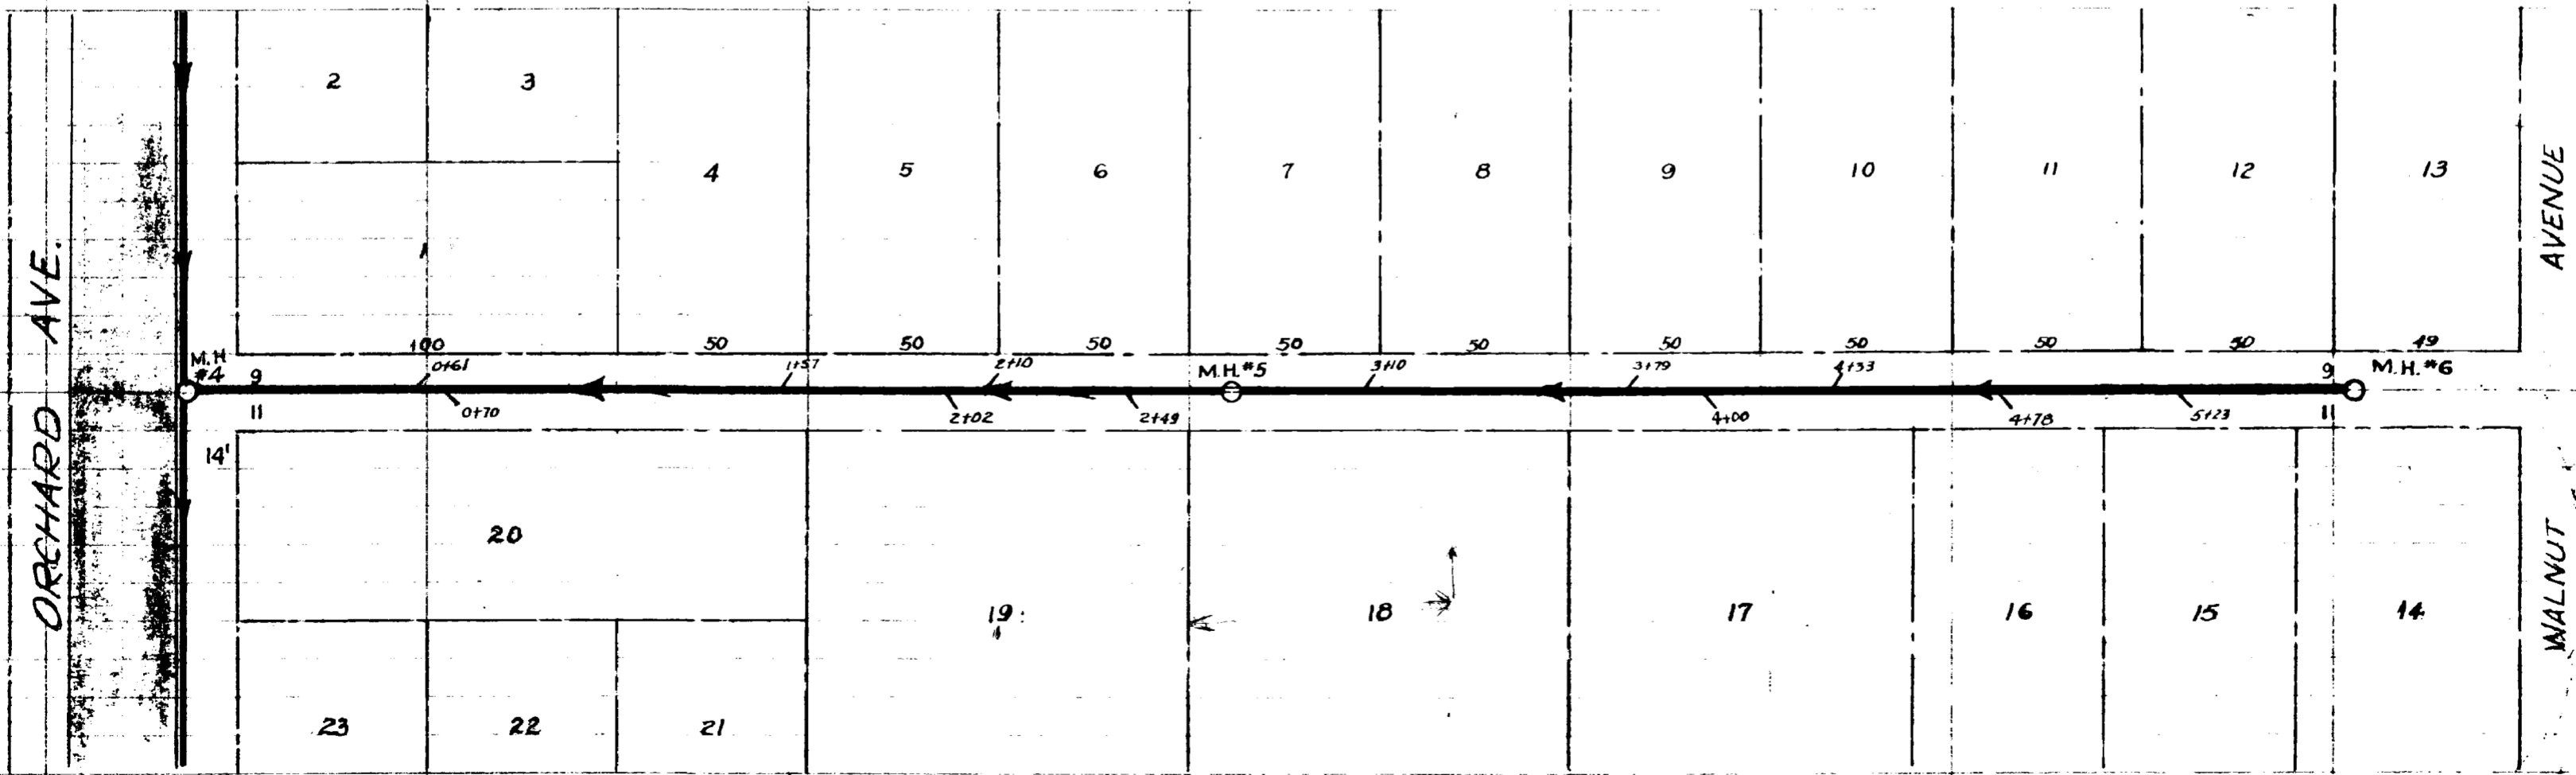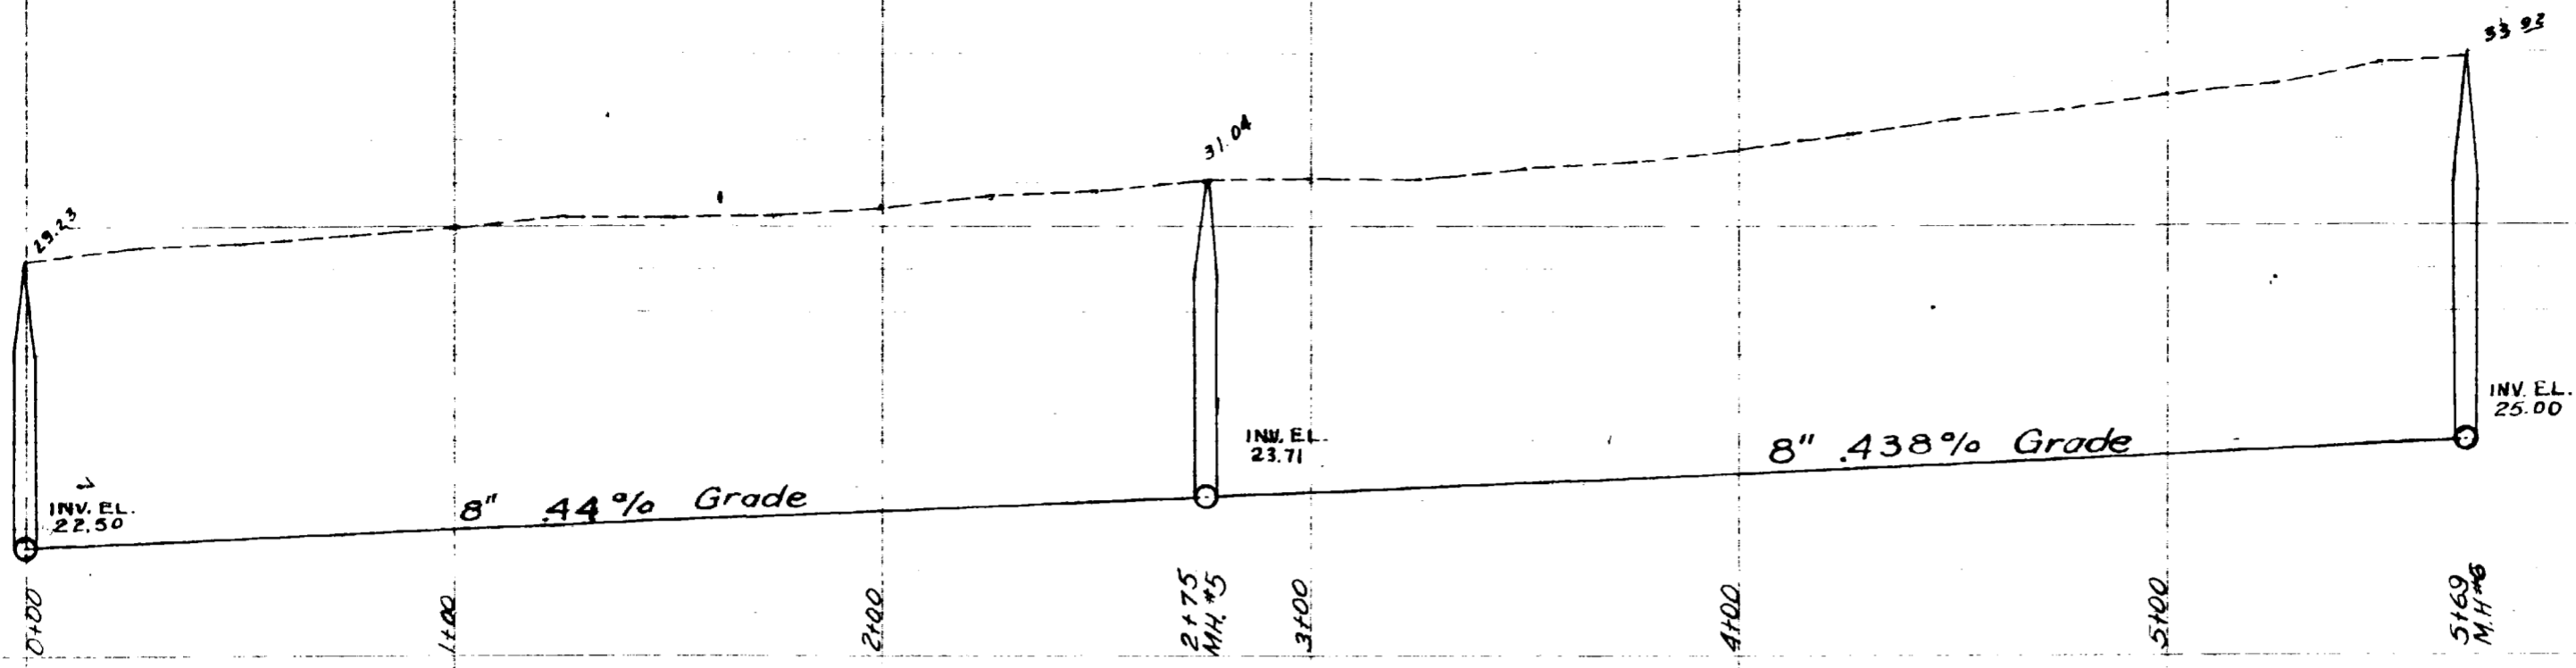

PLAN
ALLEY IN BLOCK "B"
COLLEGE ADDITION, ORCHARD
TO WALNUT AVENUES
SCALE 1"=40'

