


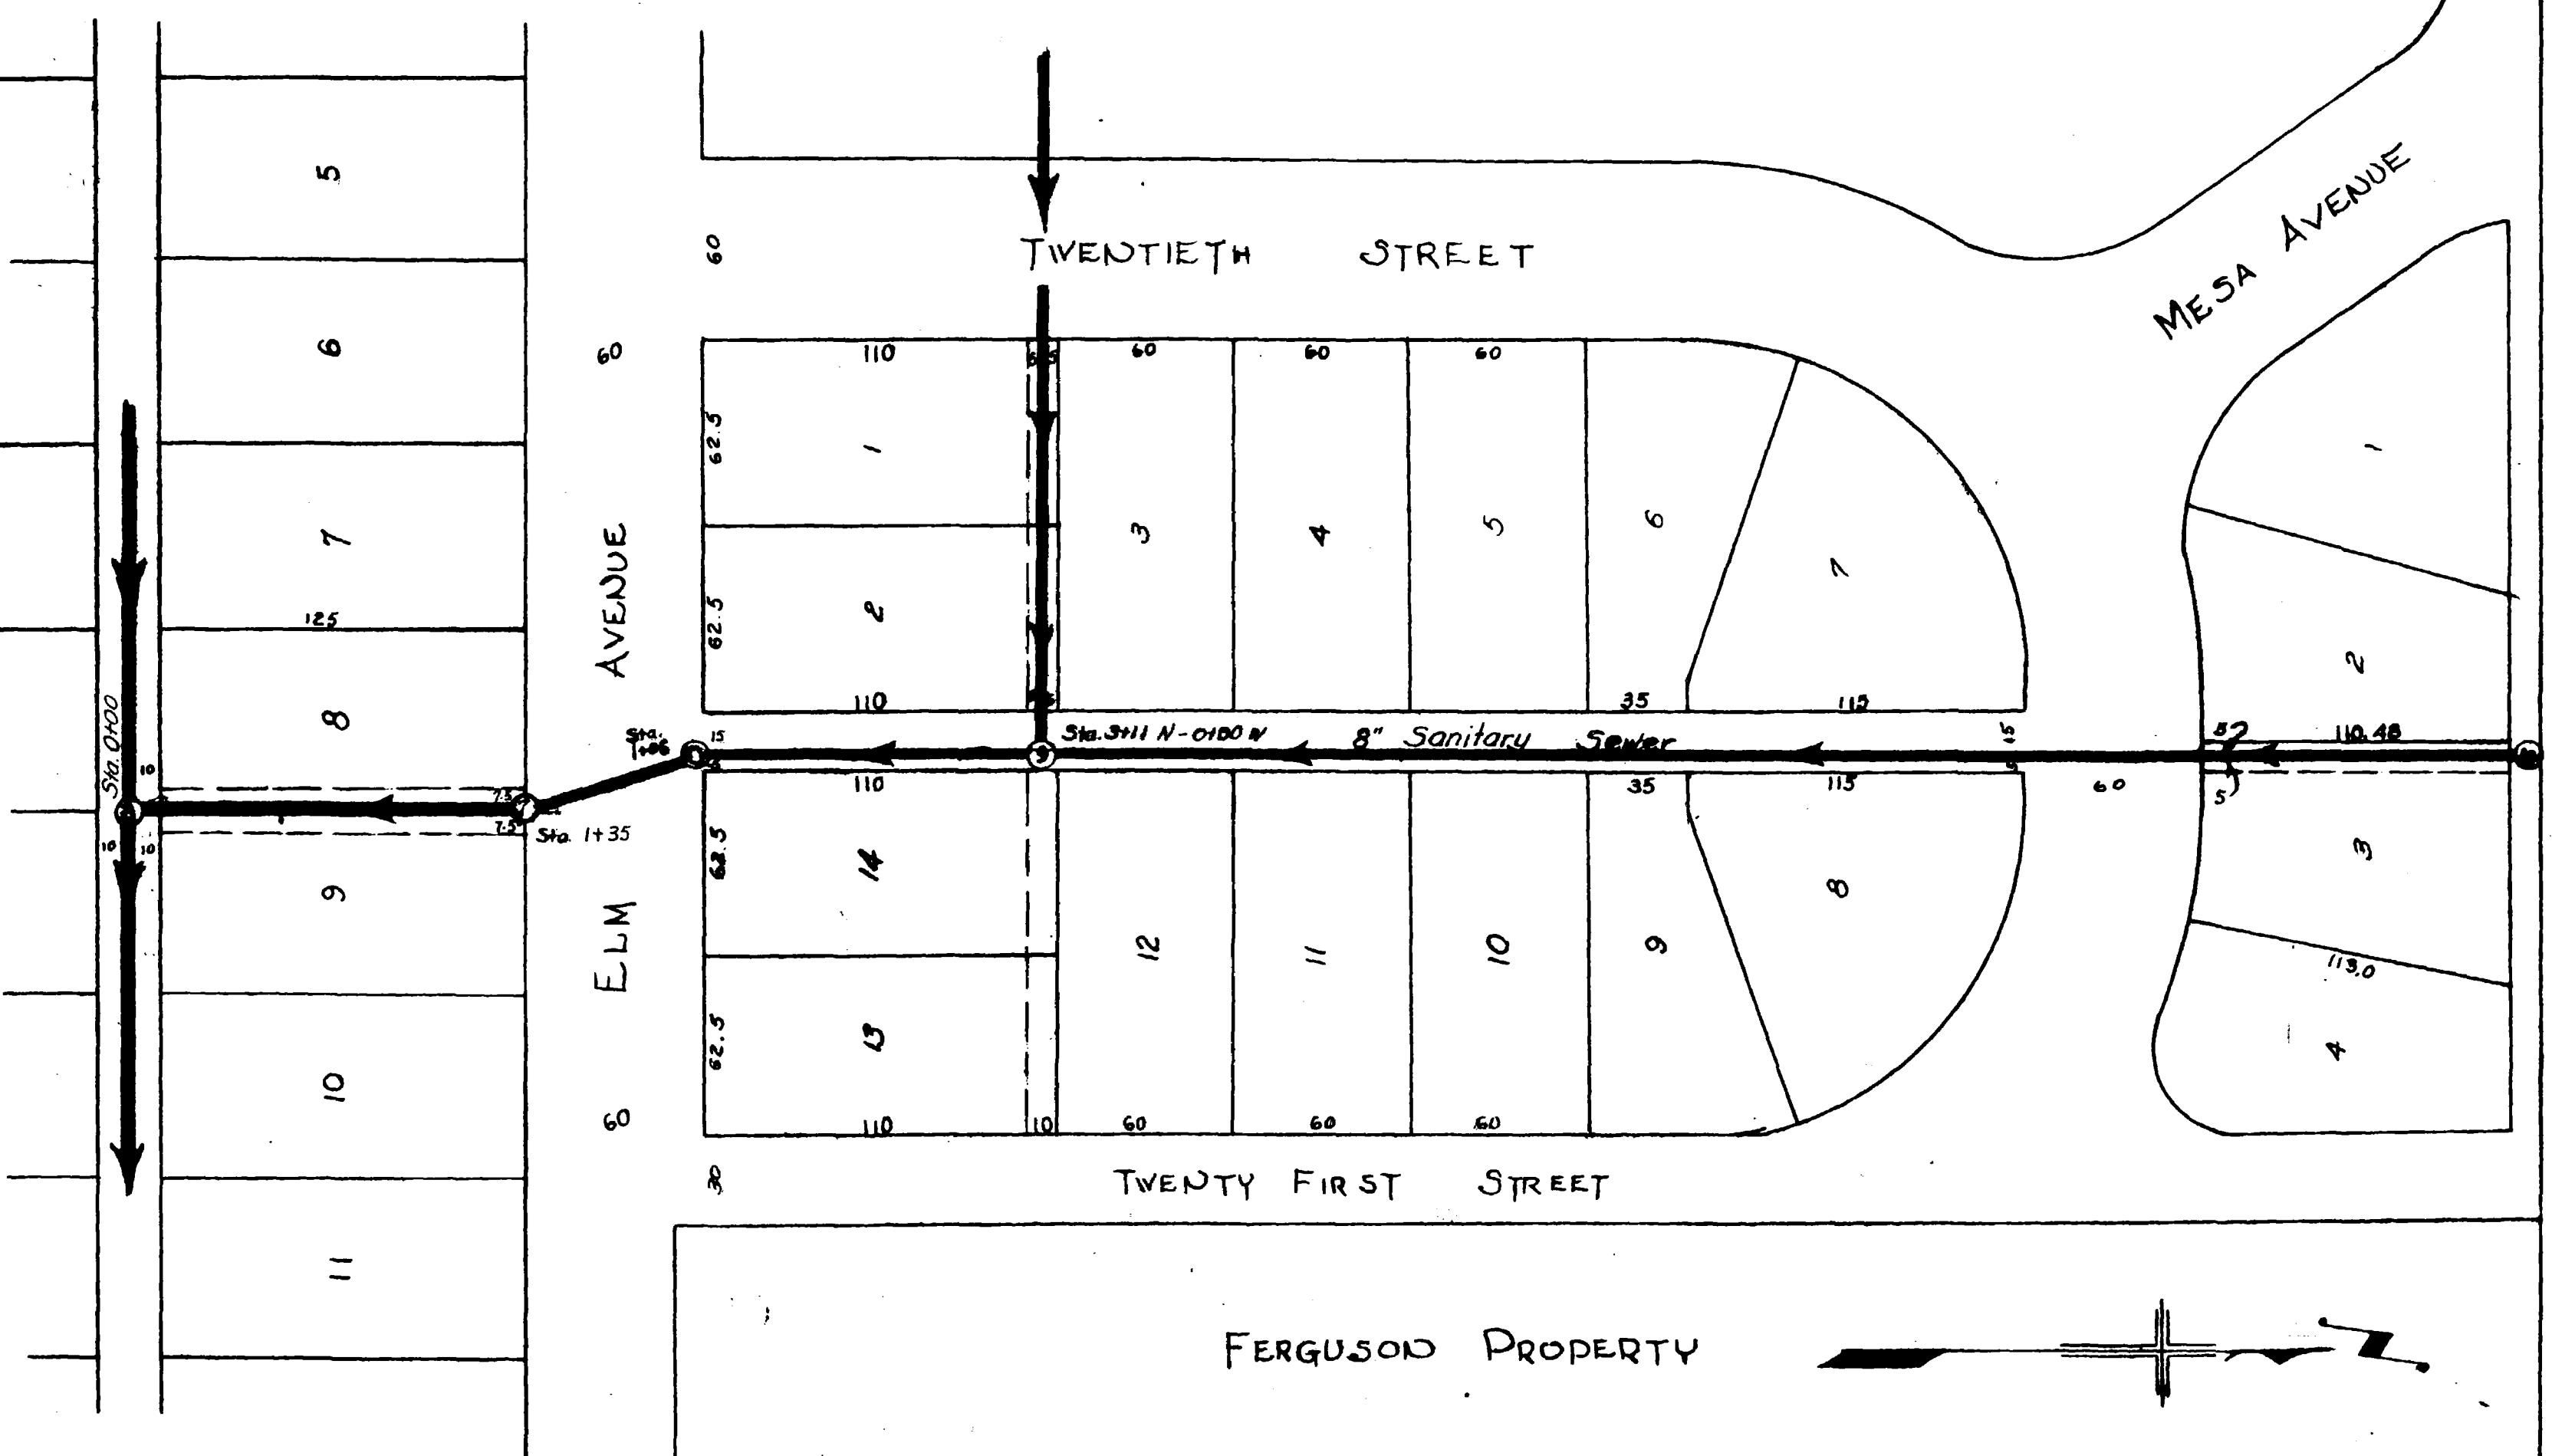


SANITARY SEWER DIST. NO. 12

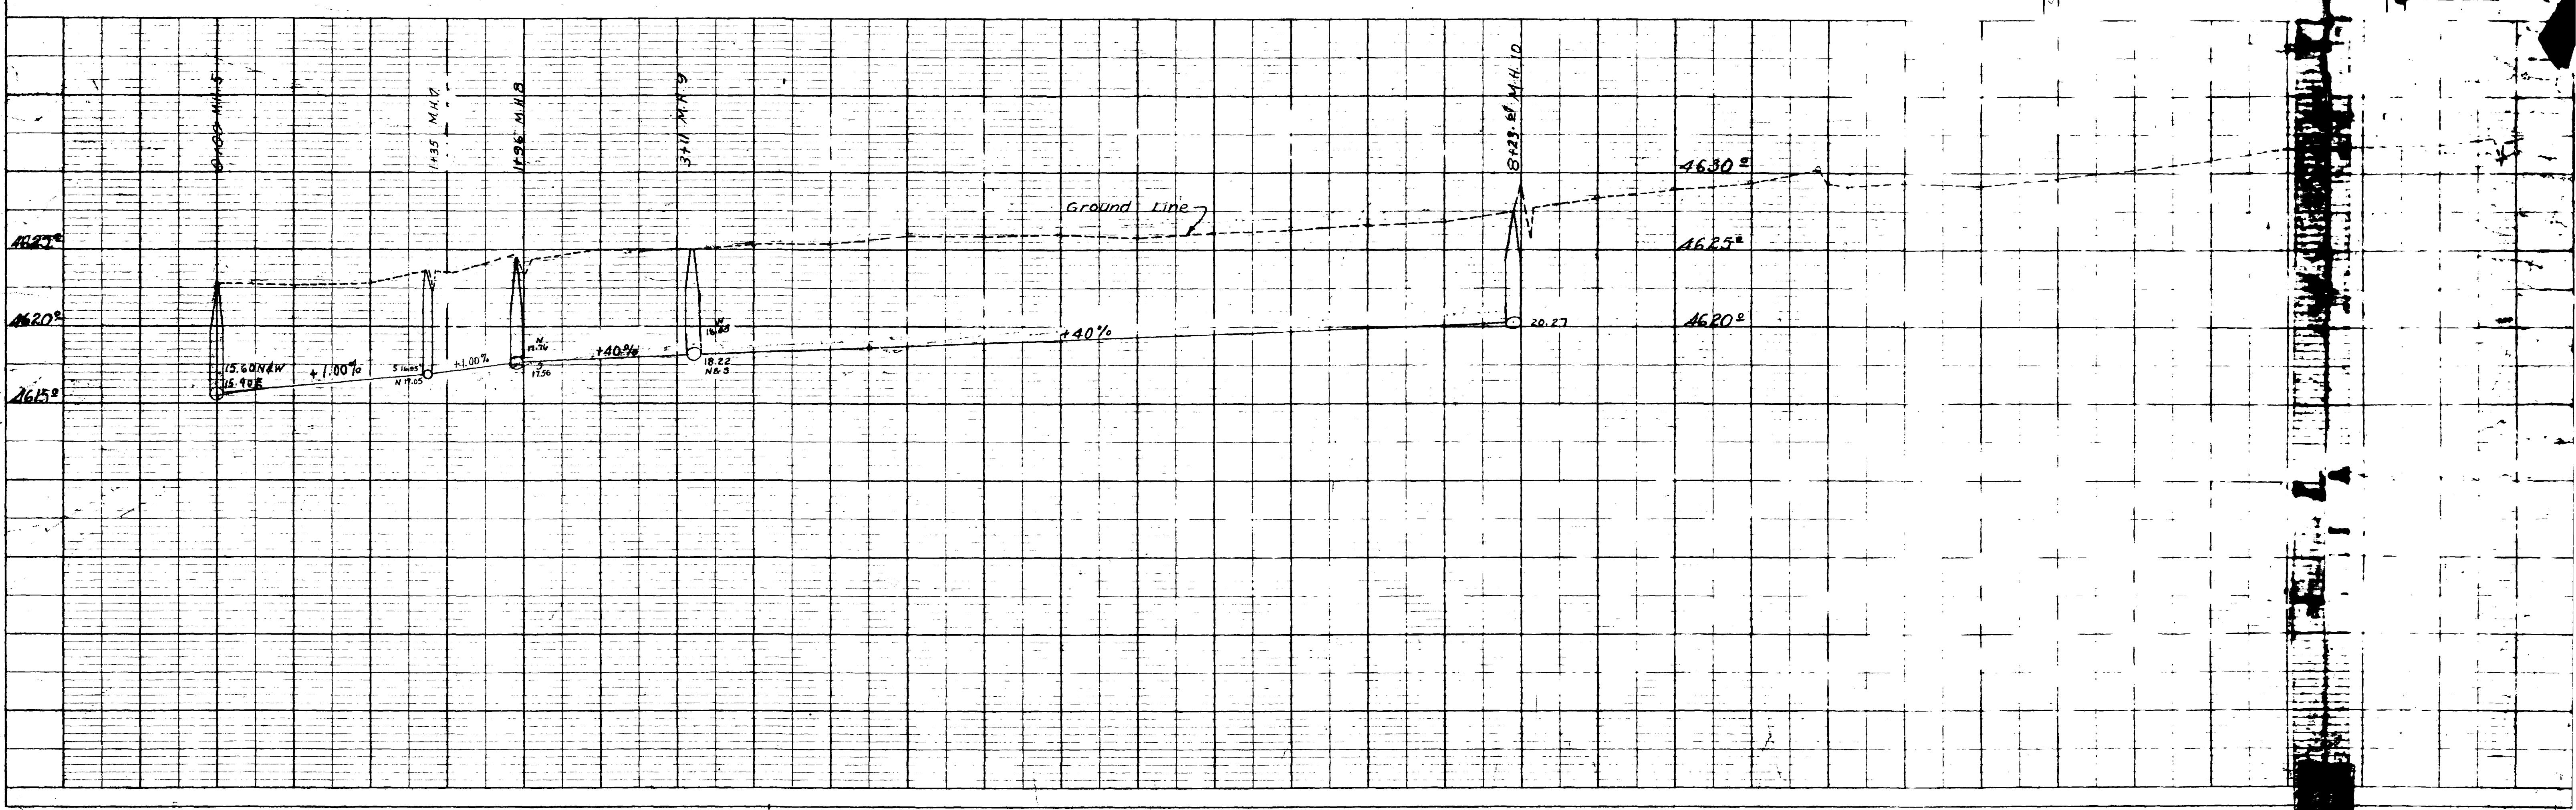


GOTT PRIOR

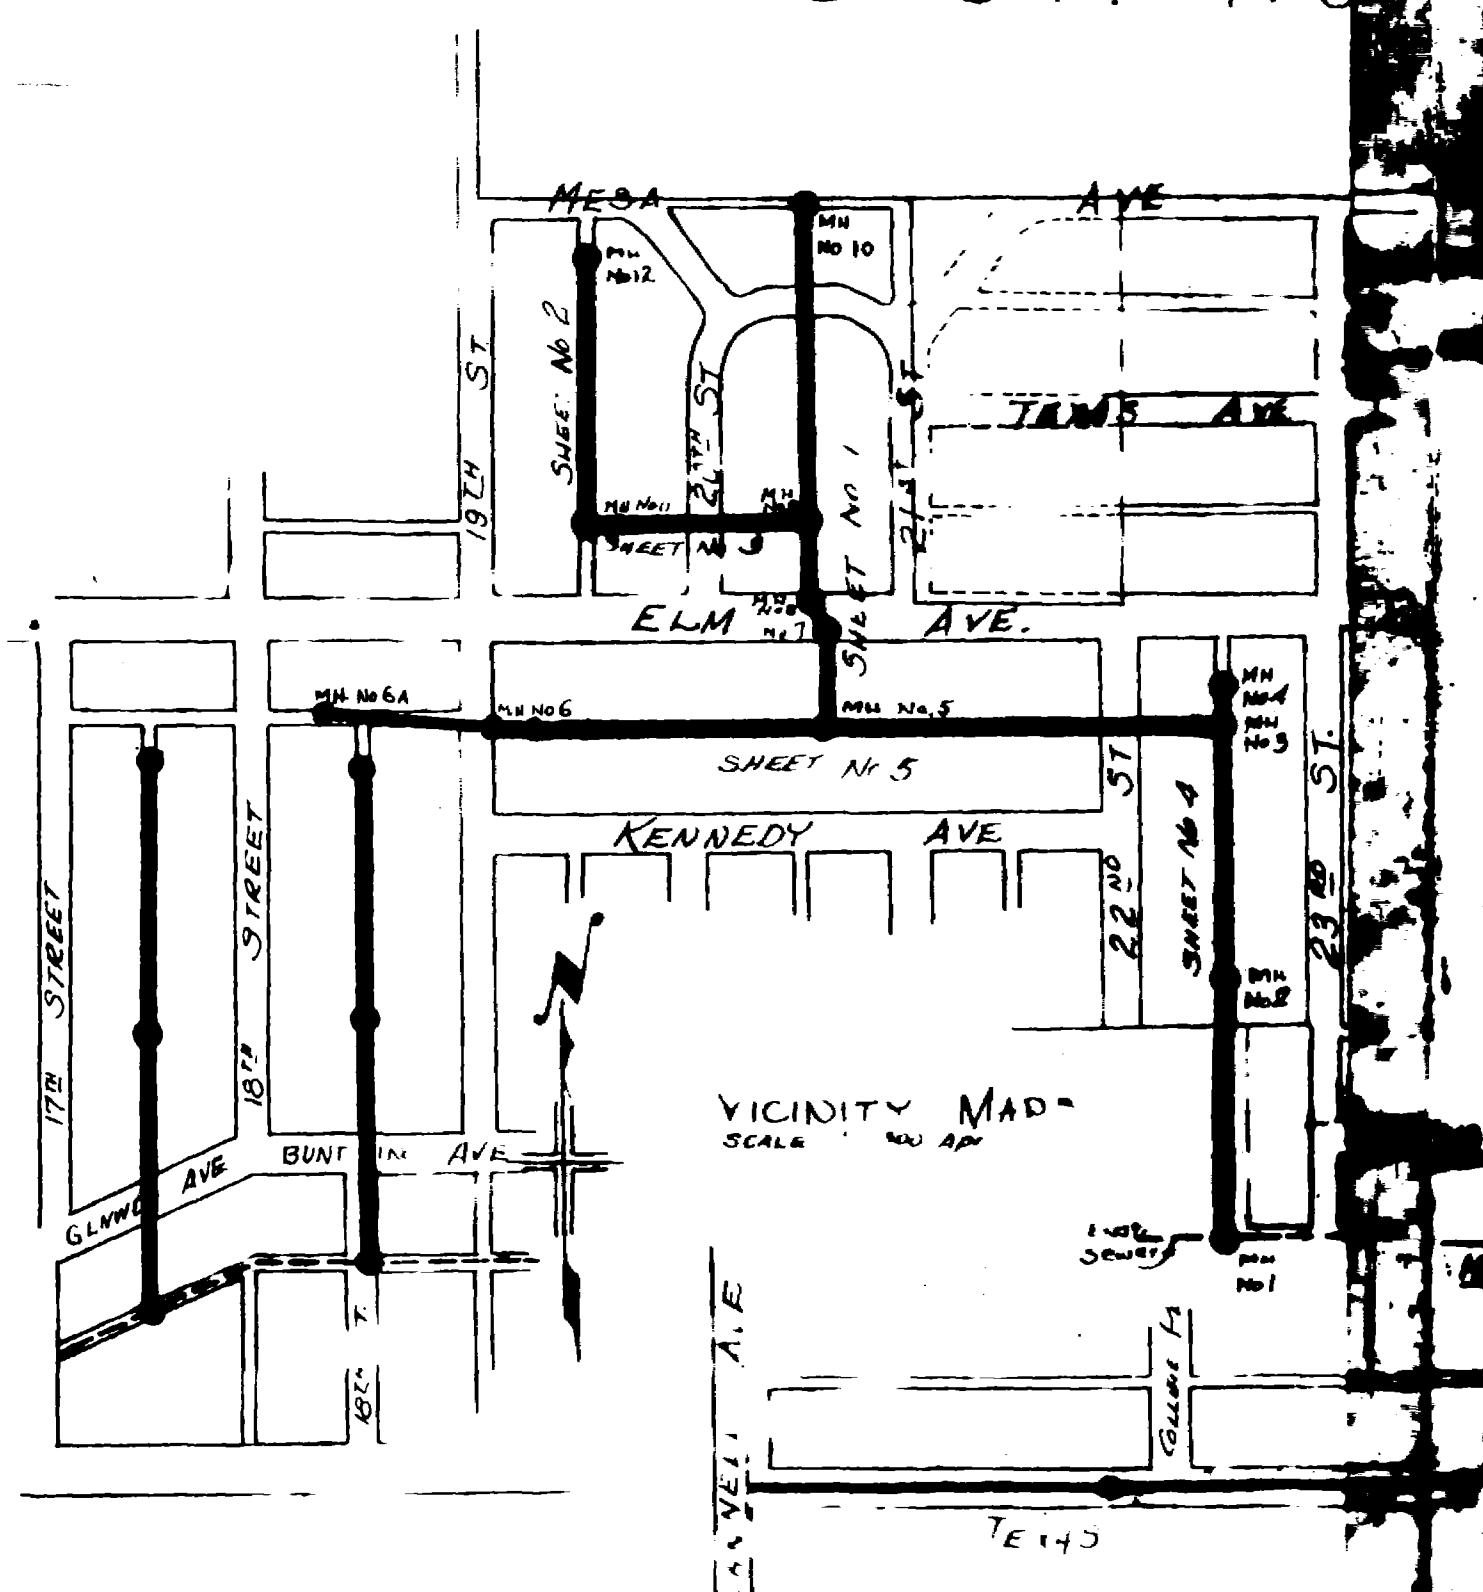


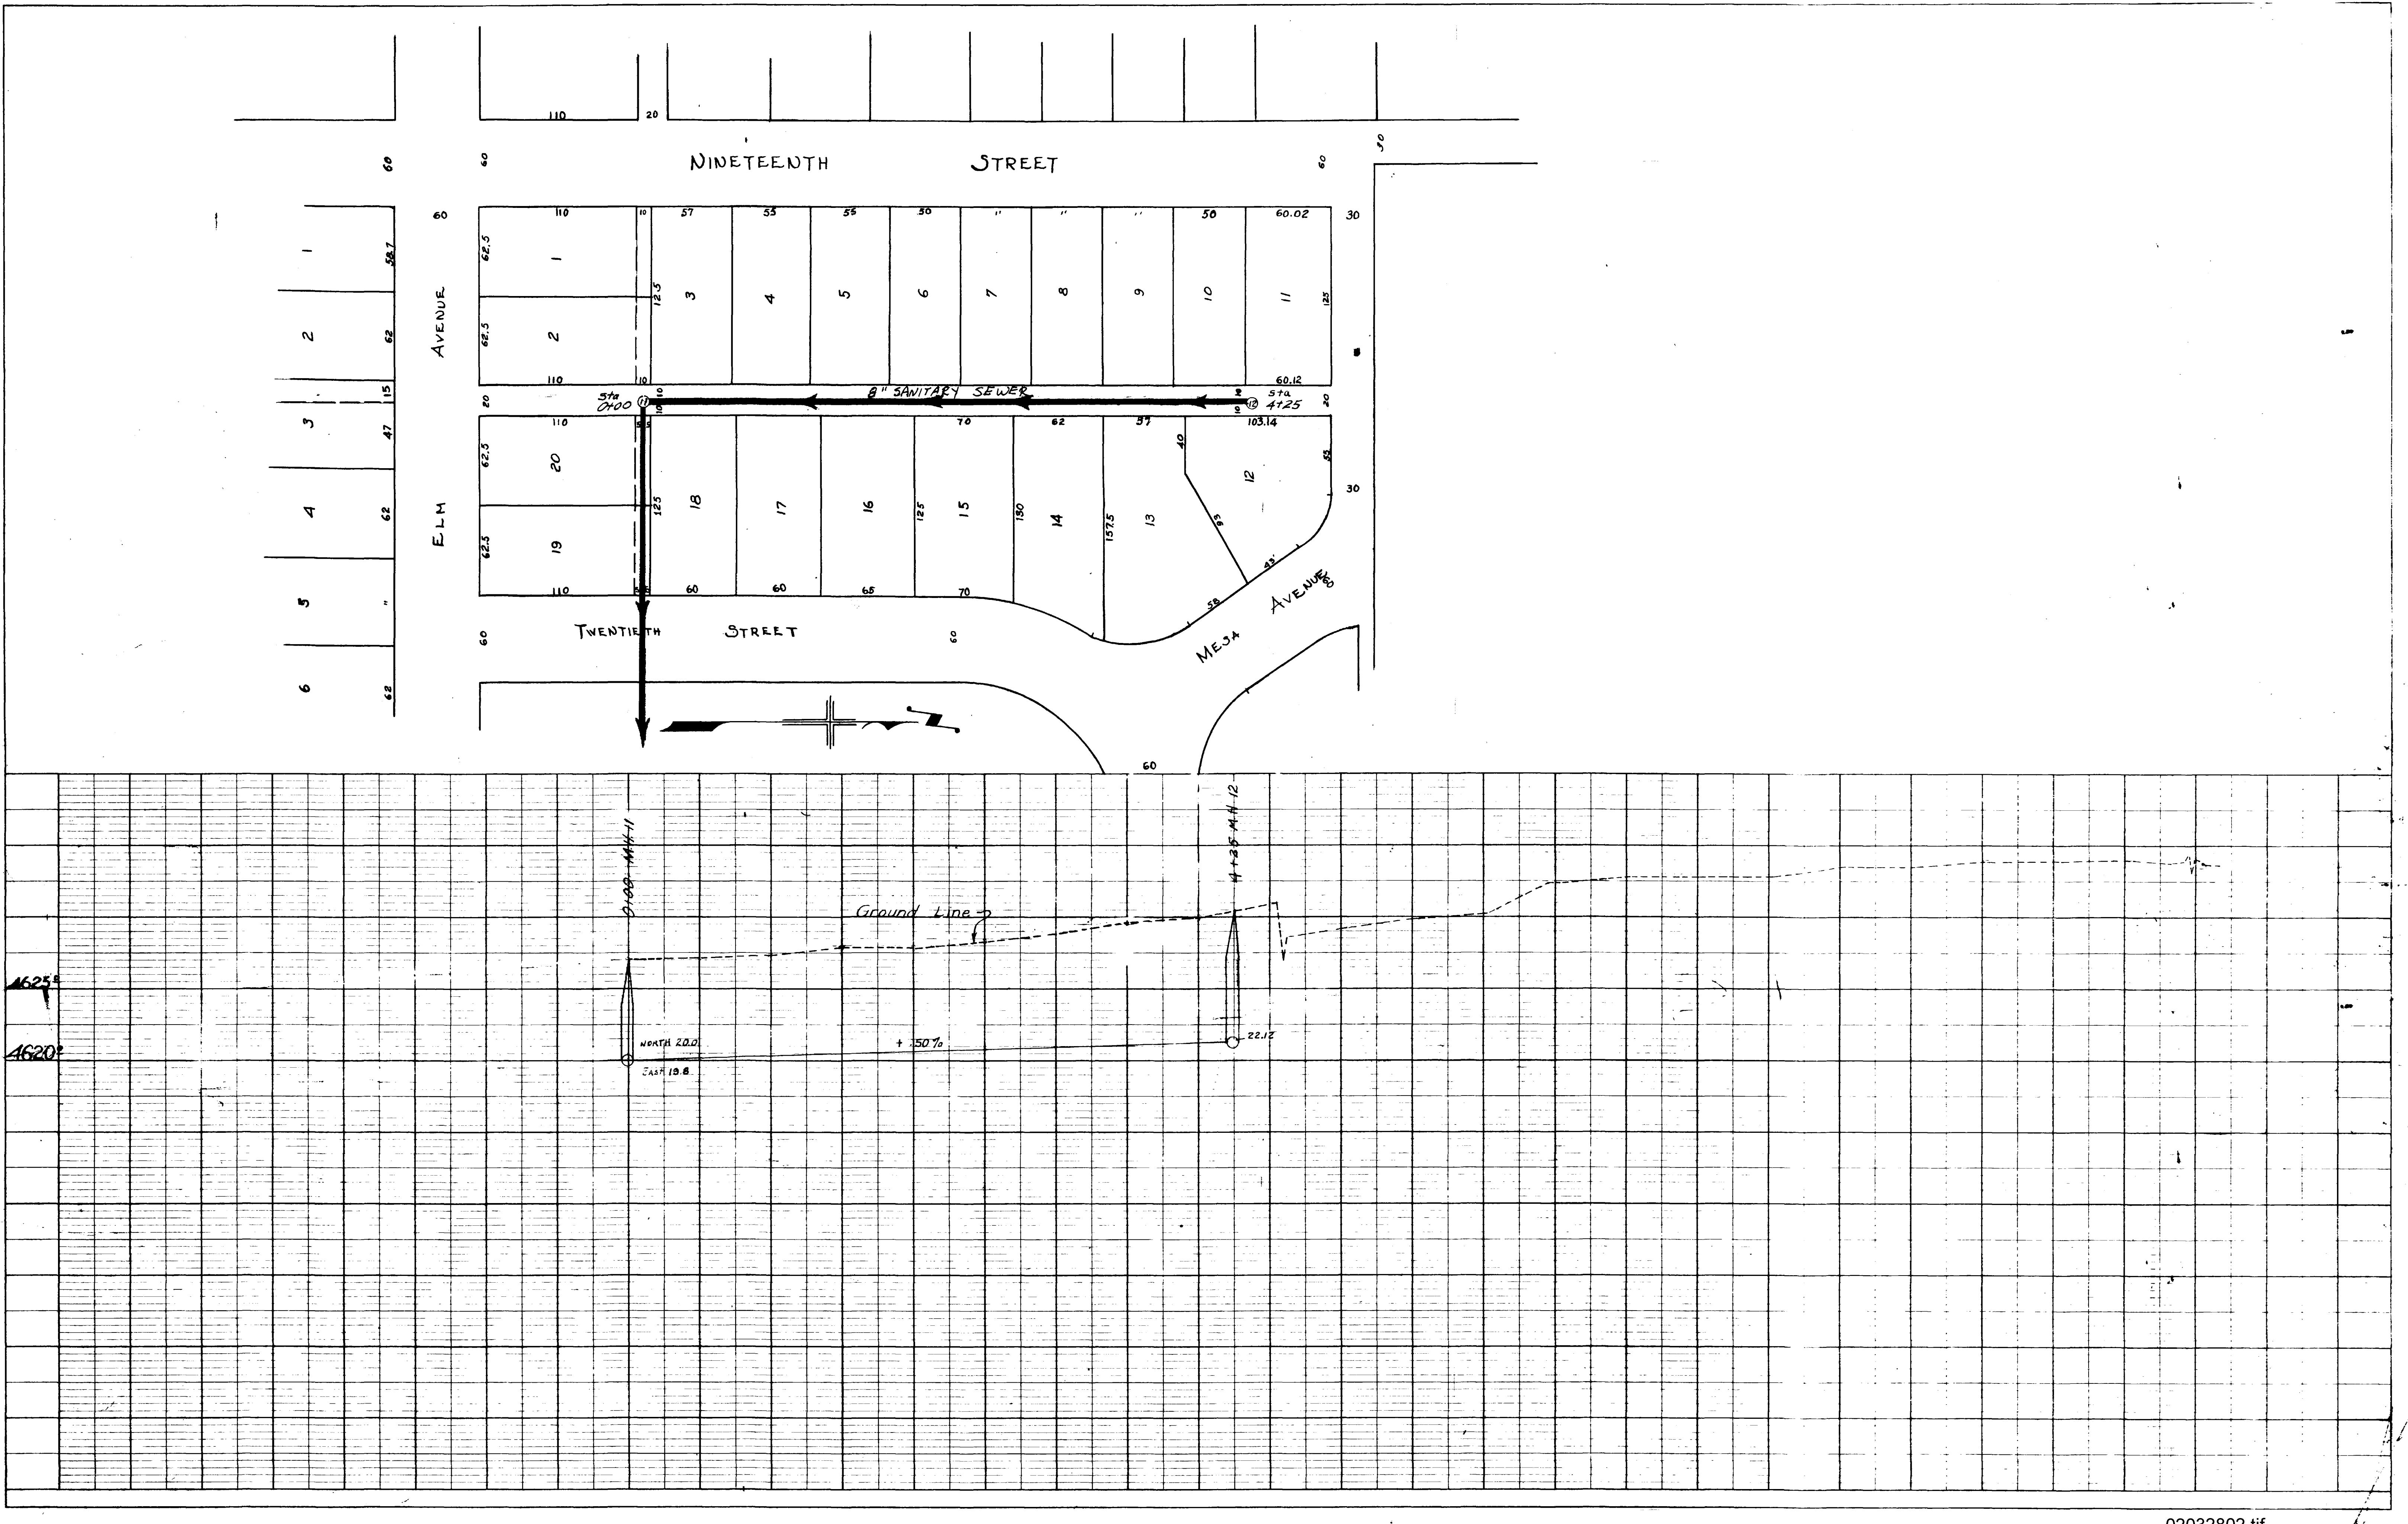


NINETEENTH STREET

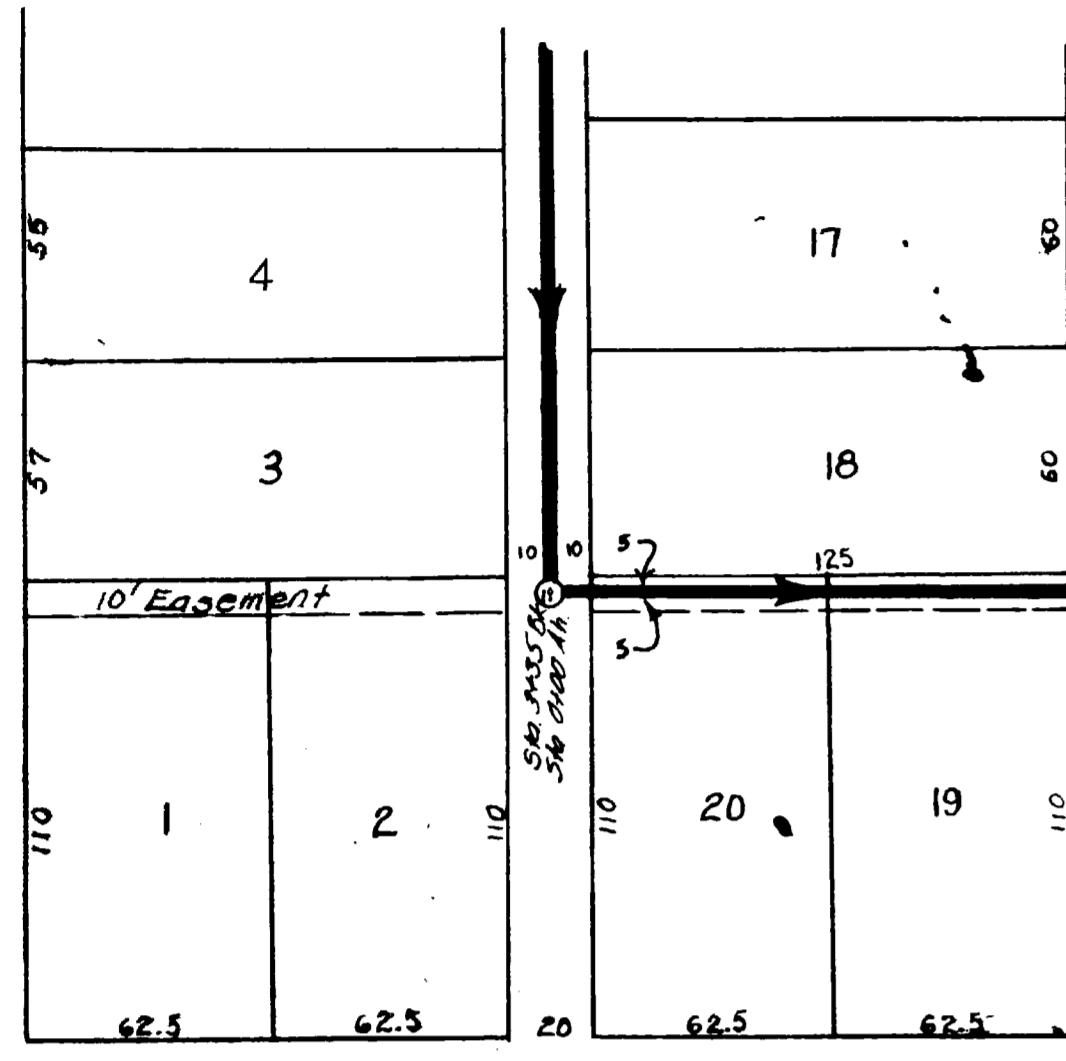


TWENTIETH STREET

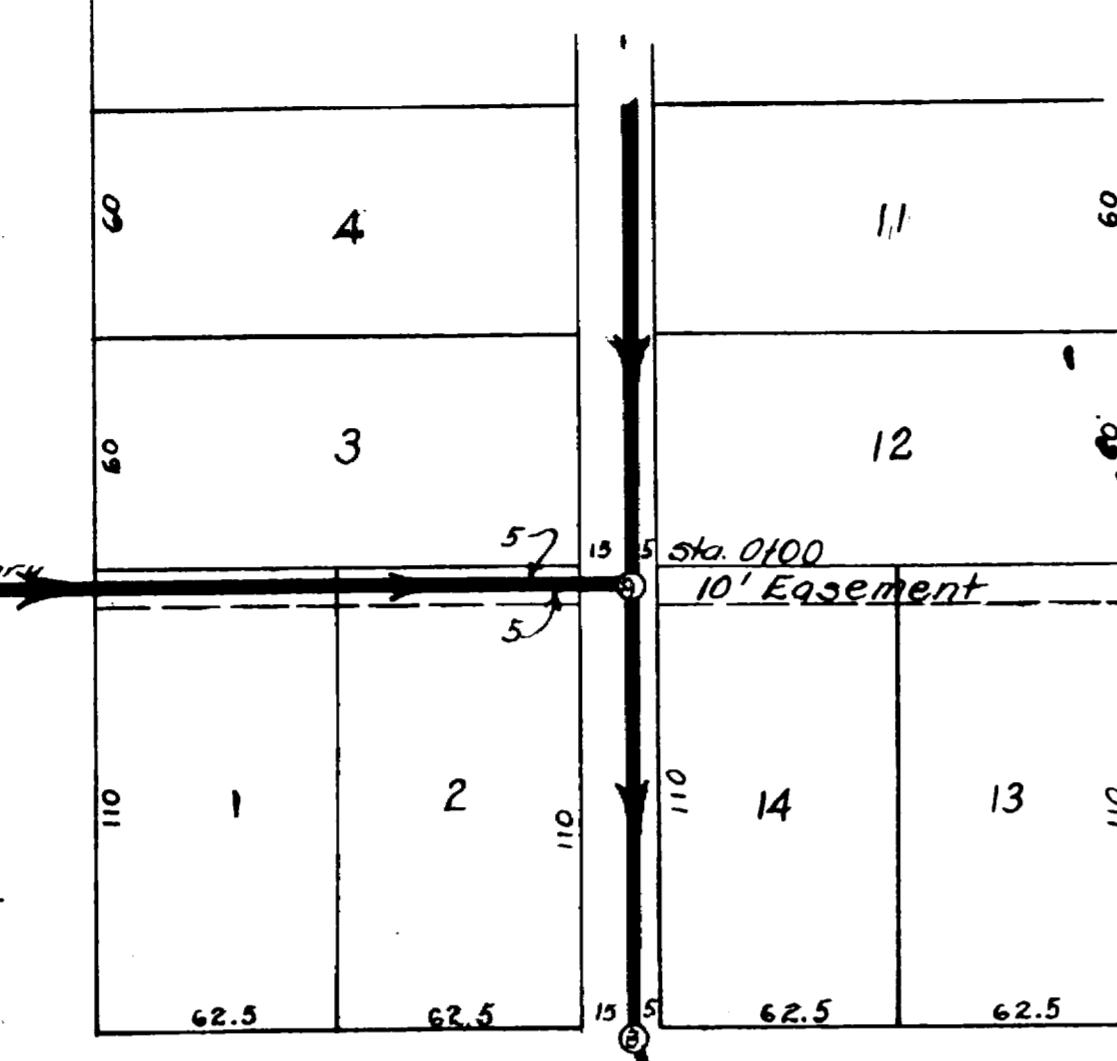



TWENTY FIRST STREET


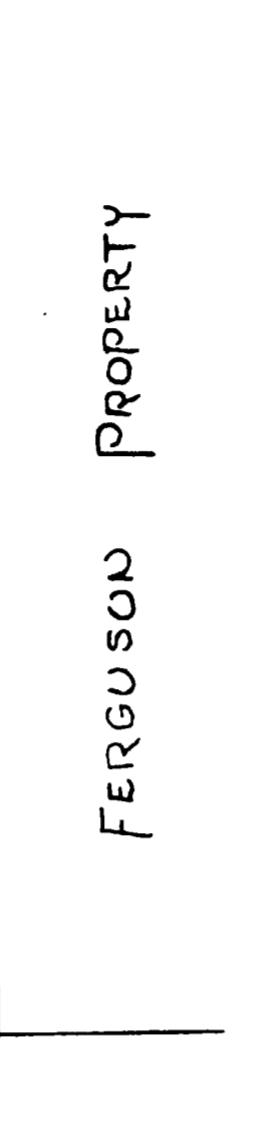



FERGUSON PROPERTY

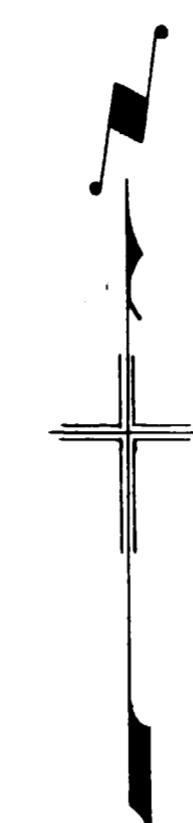


ELM AVENUE

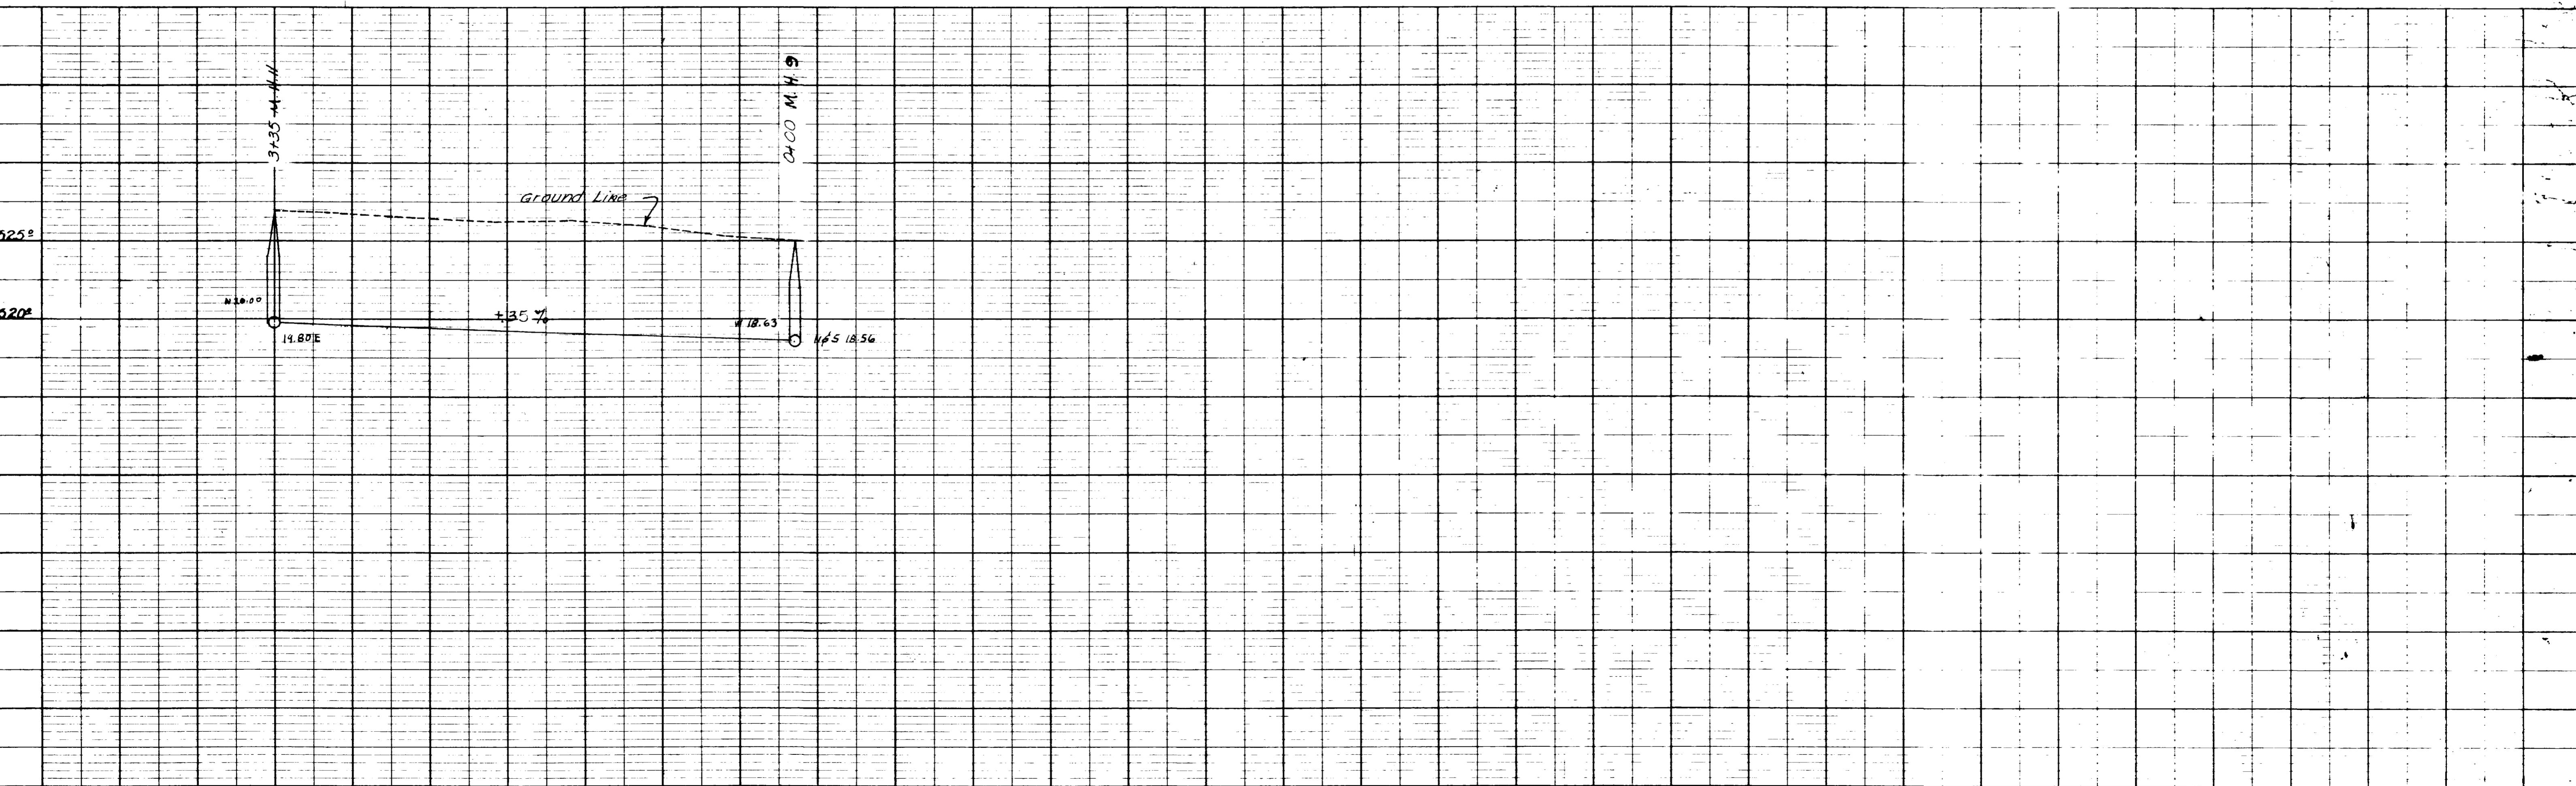
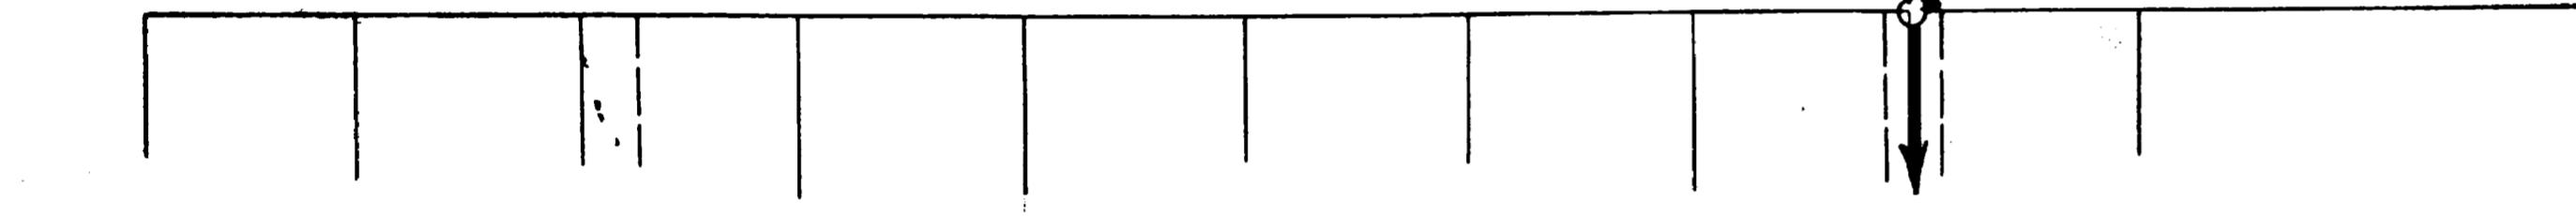


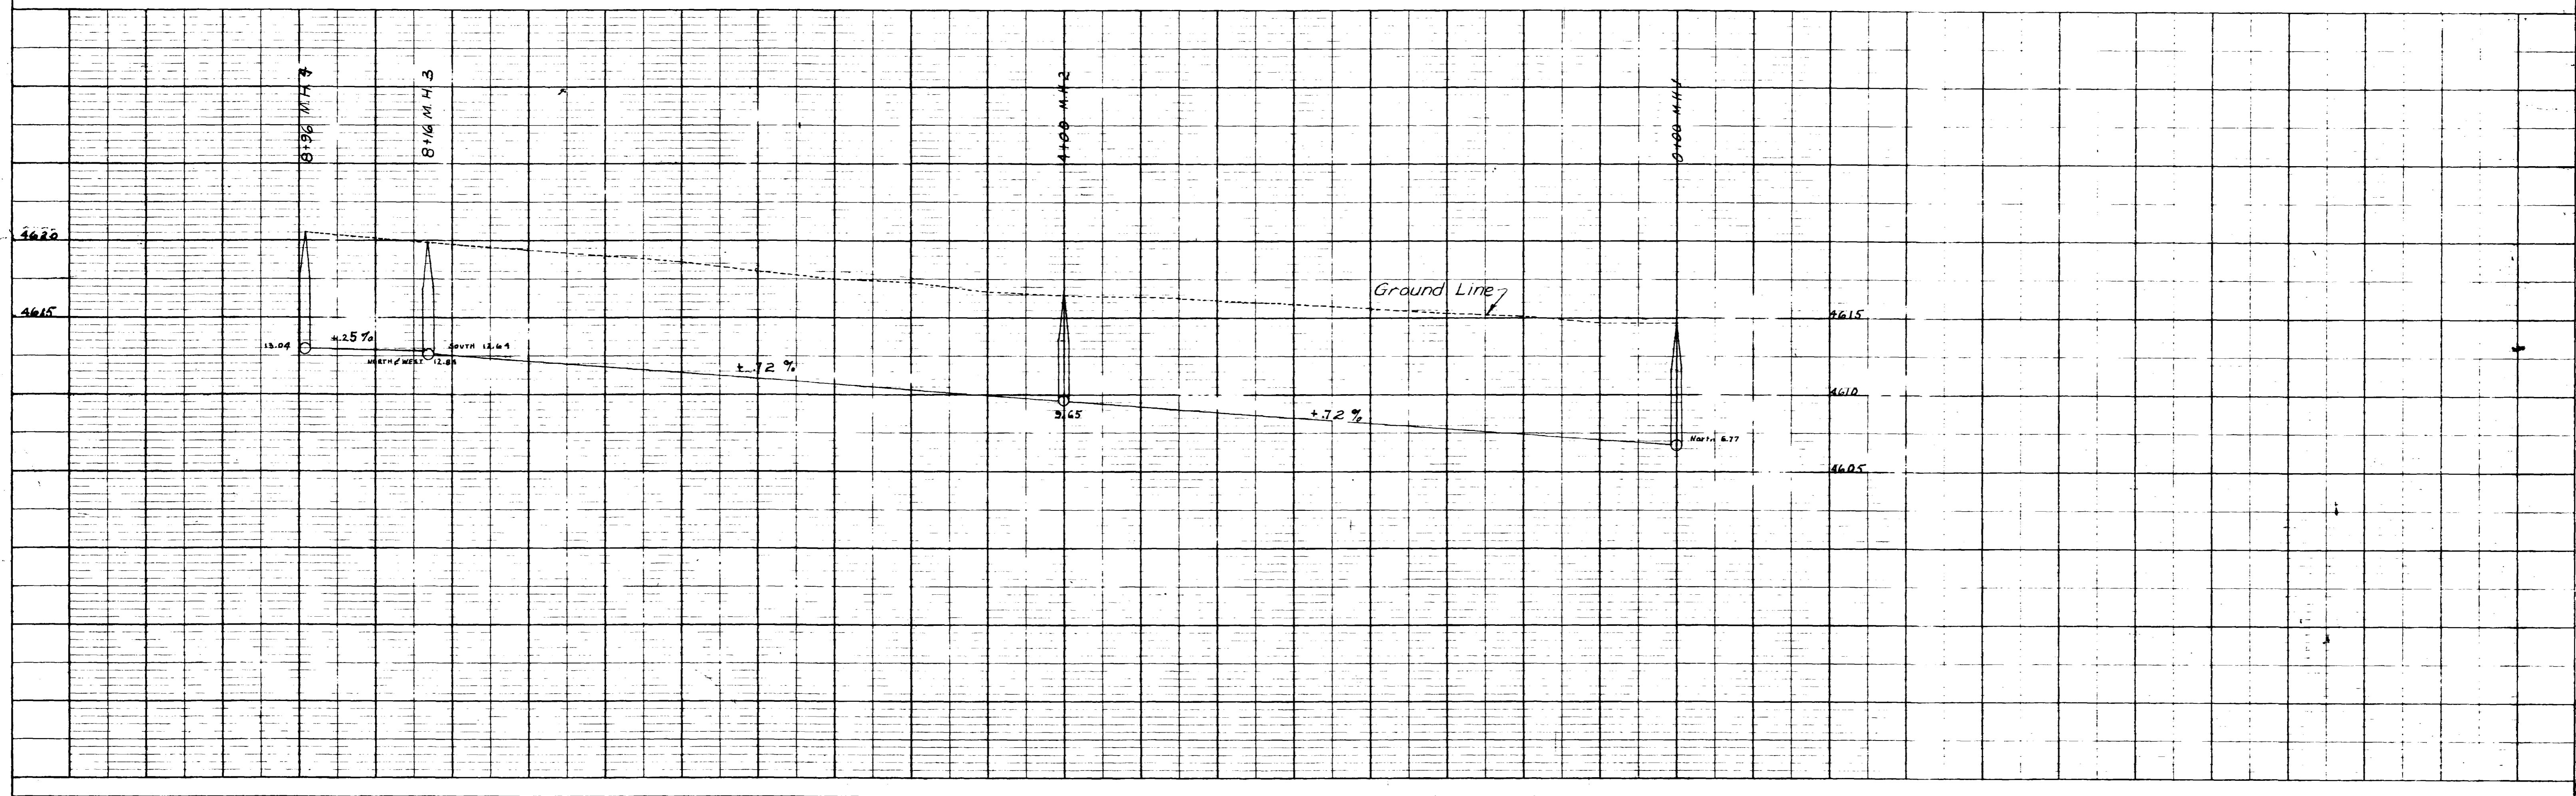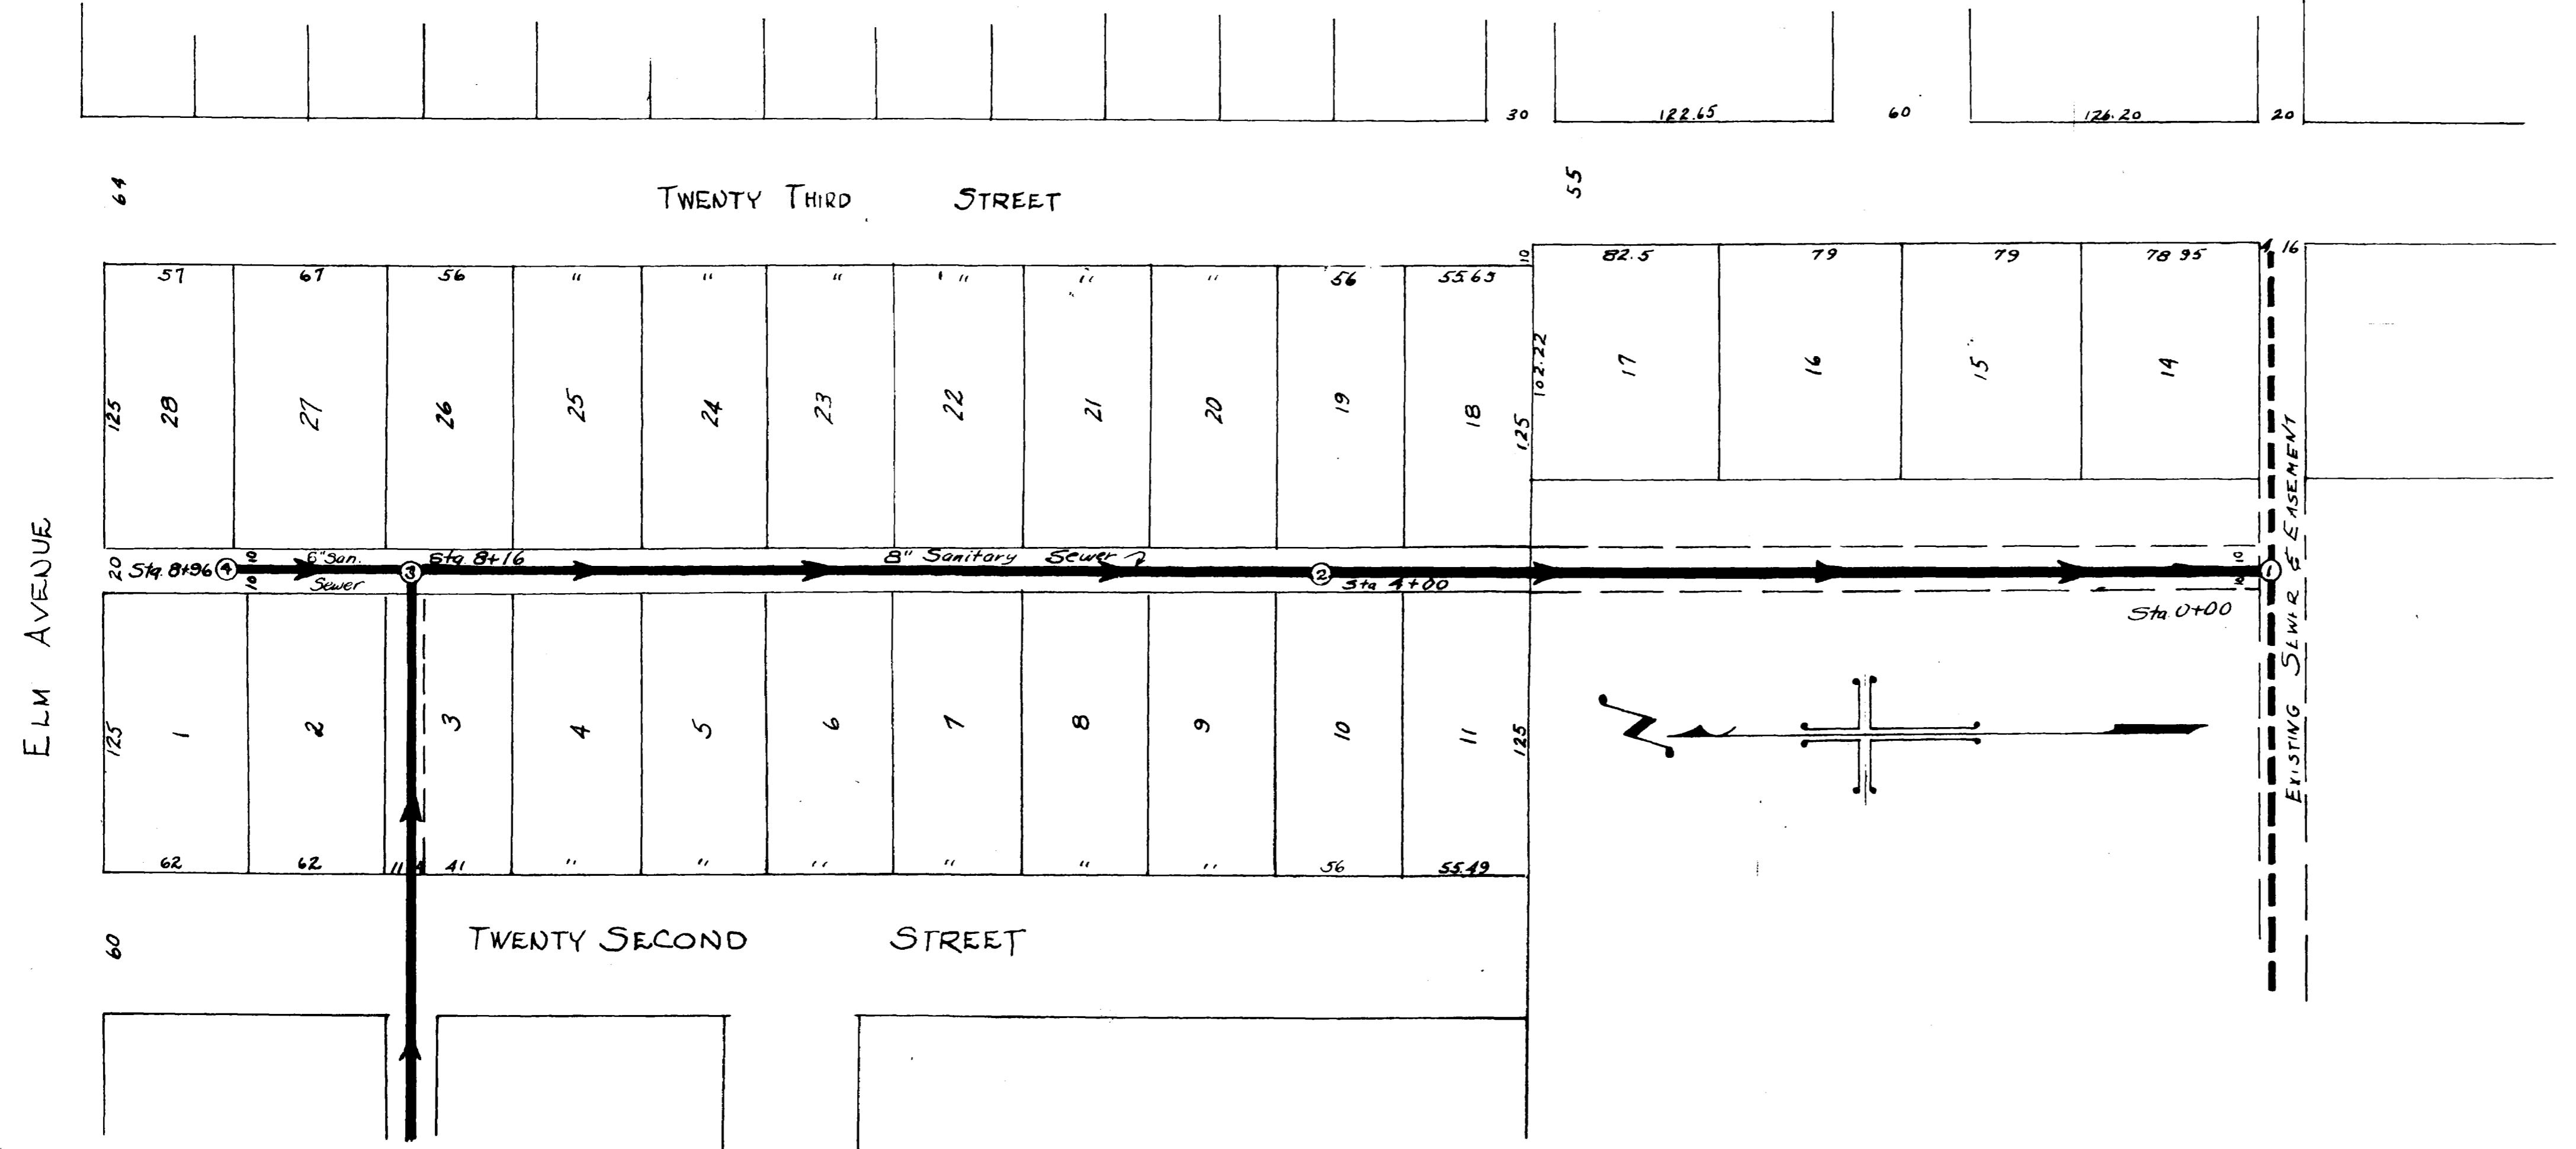


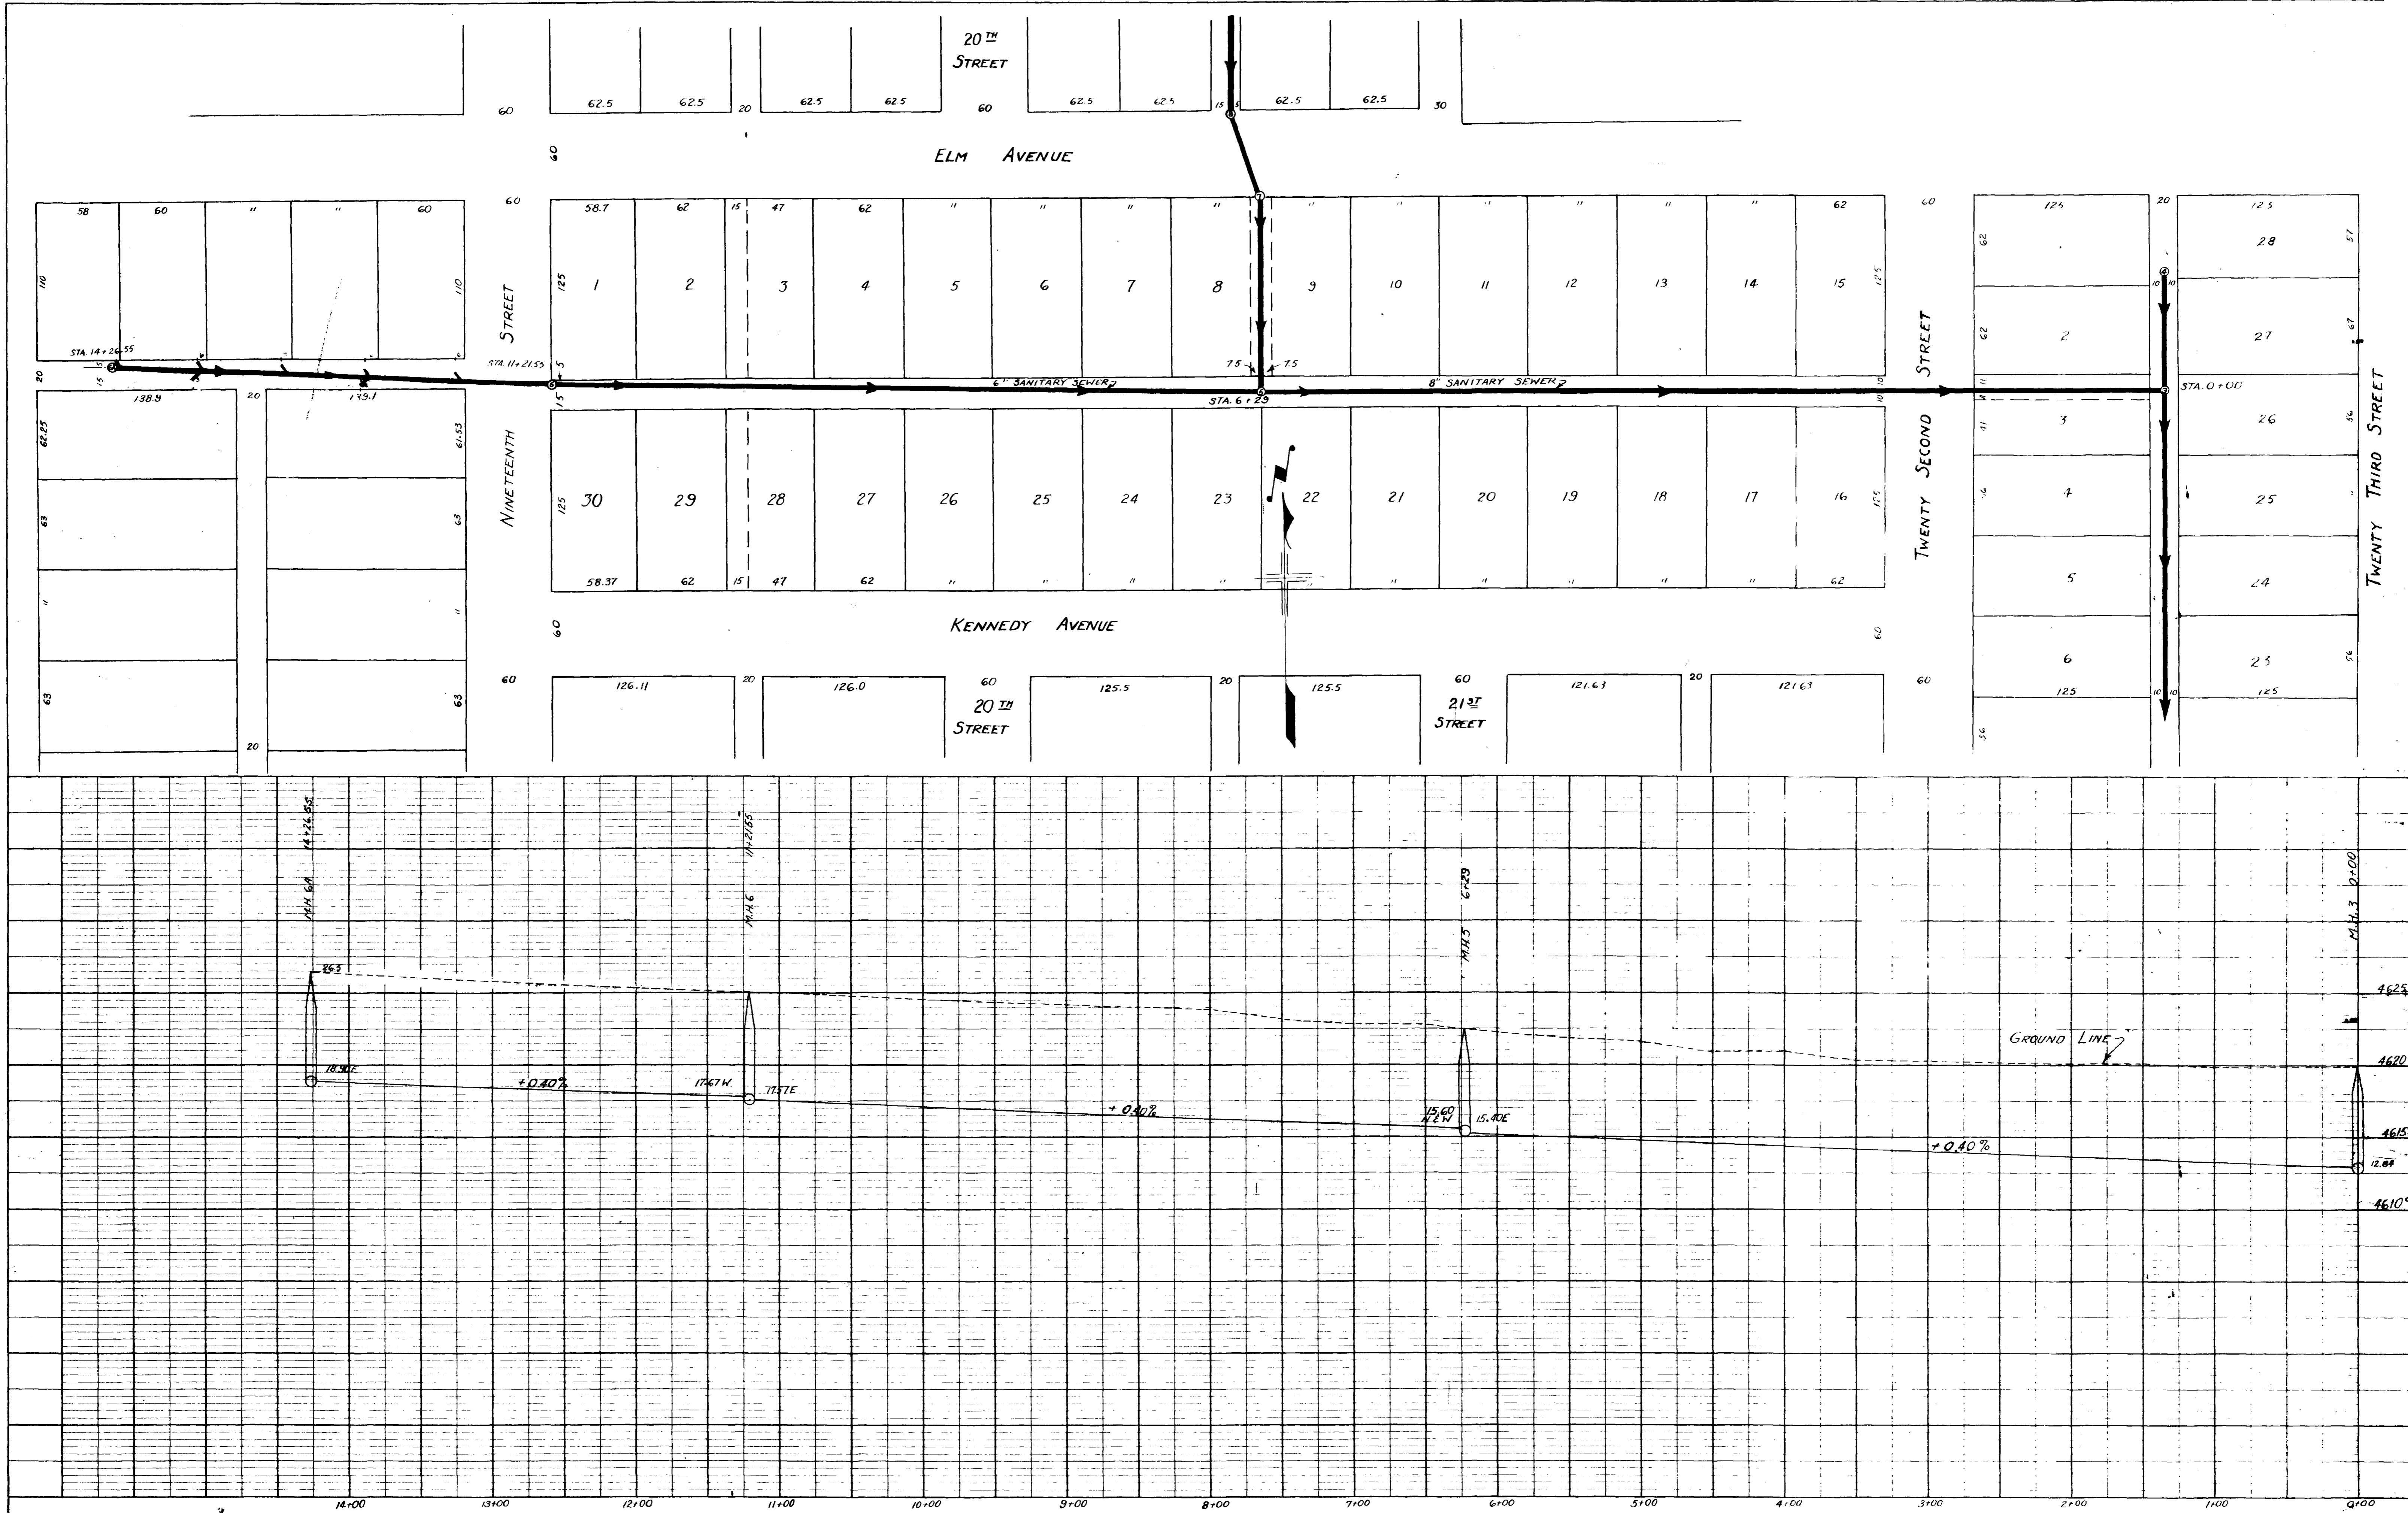




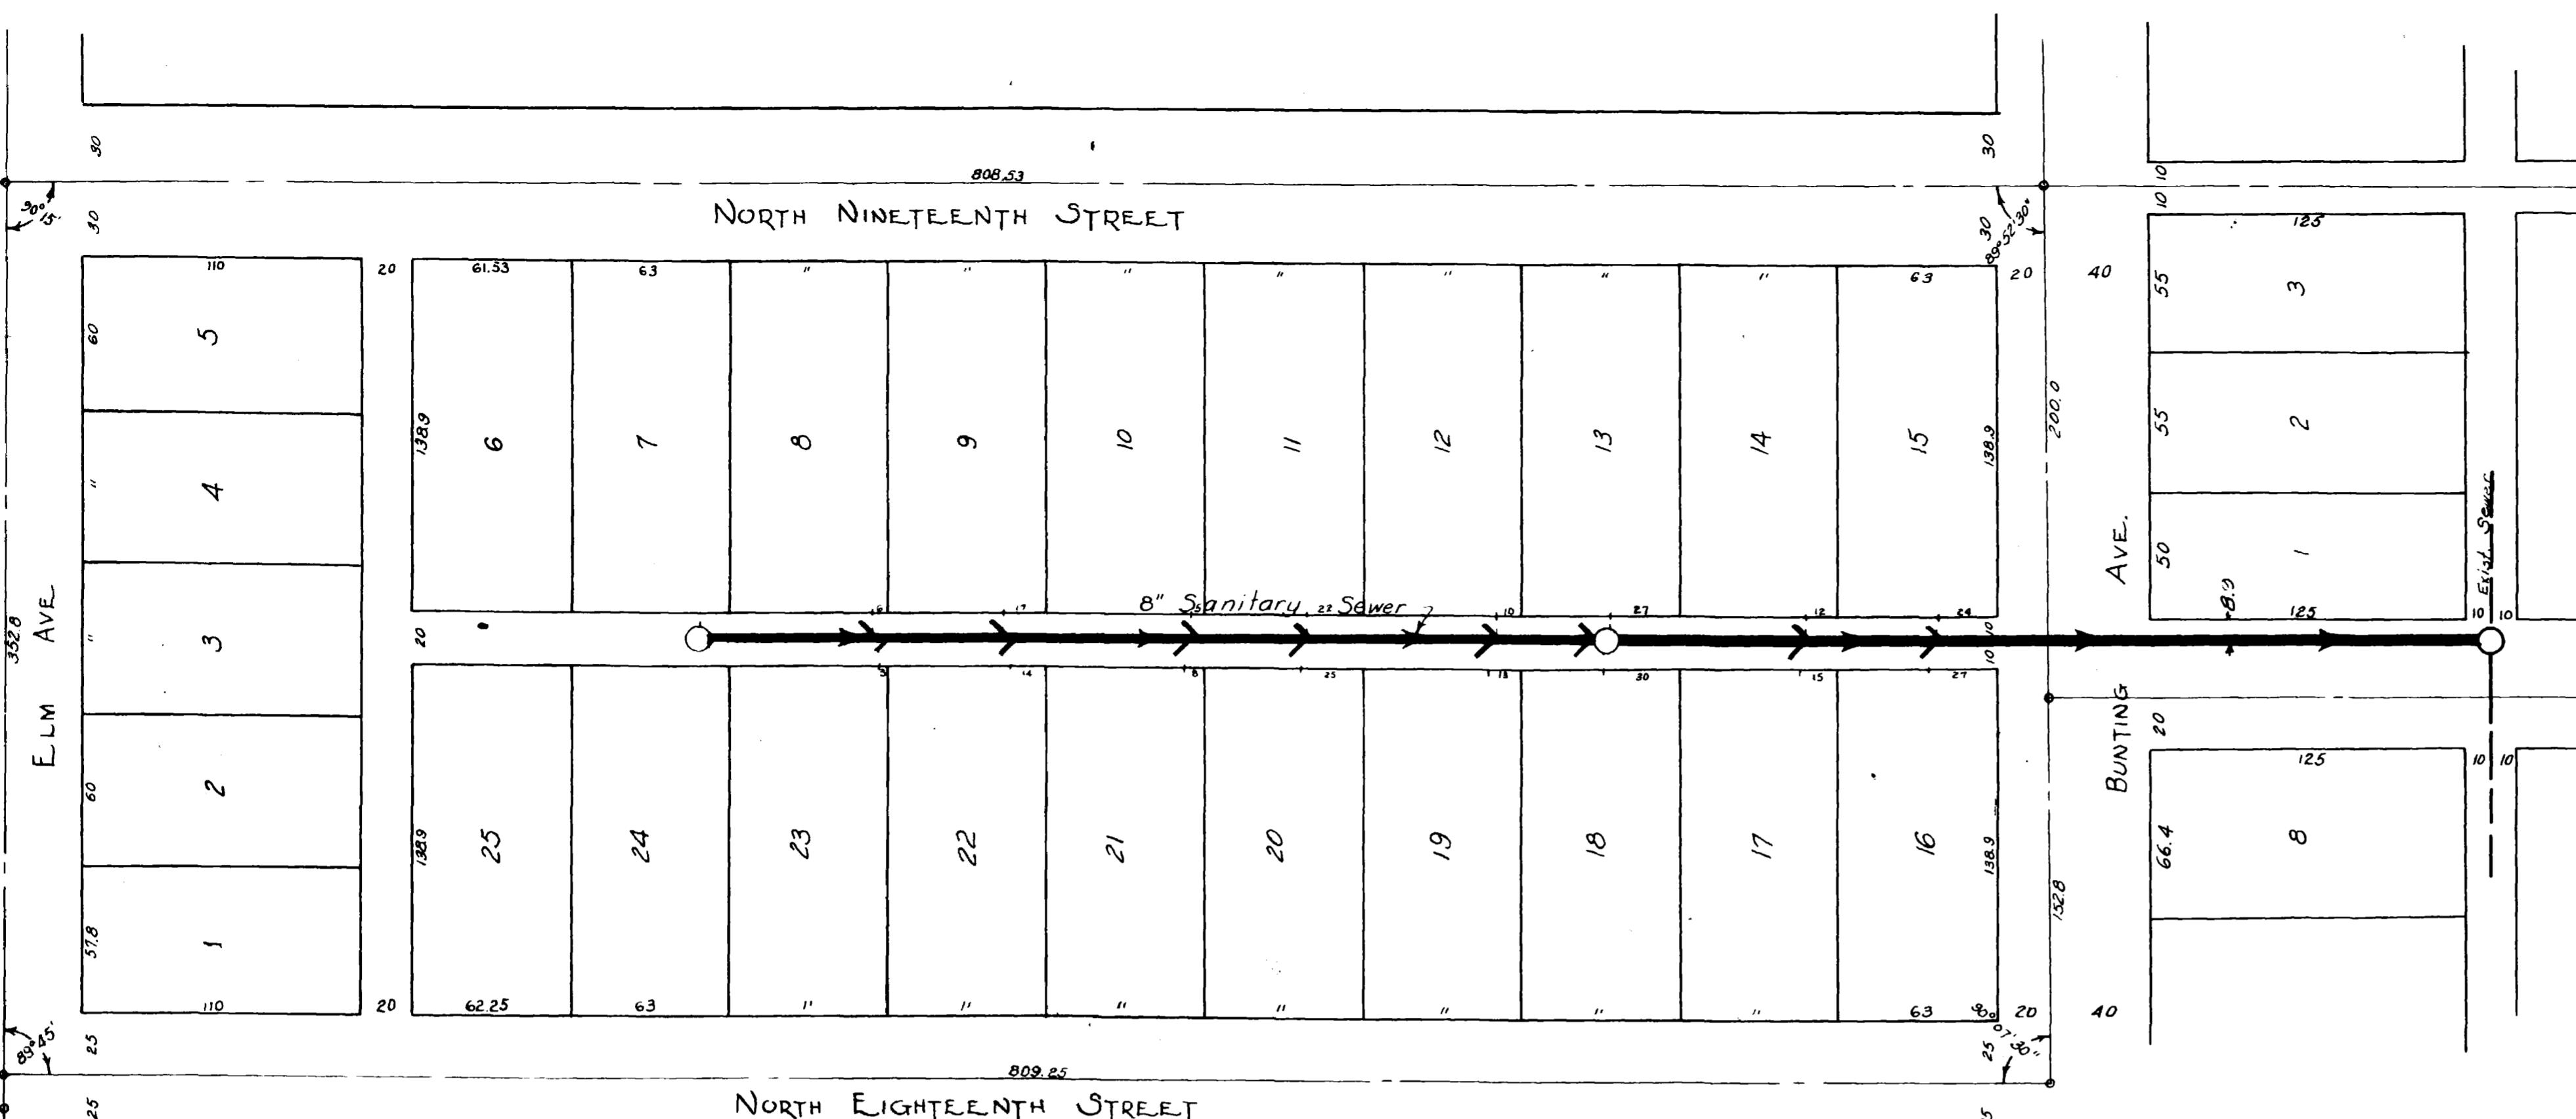



DELETED - SEE SHEET 5

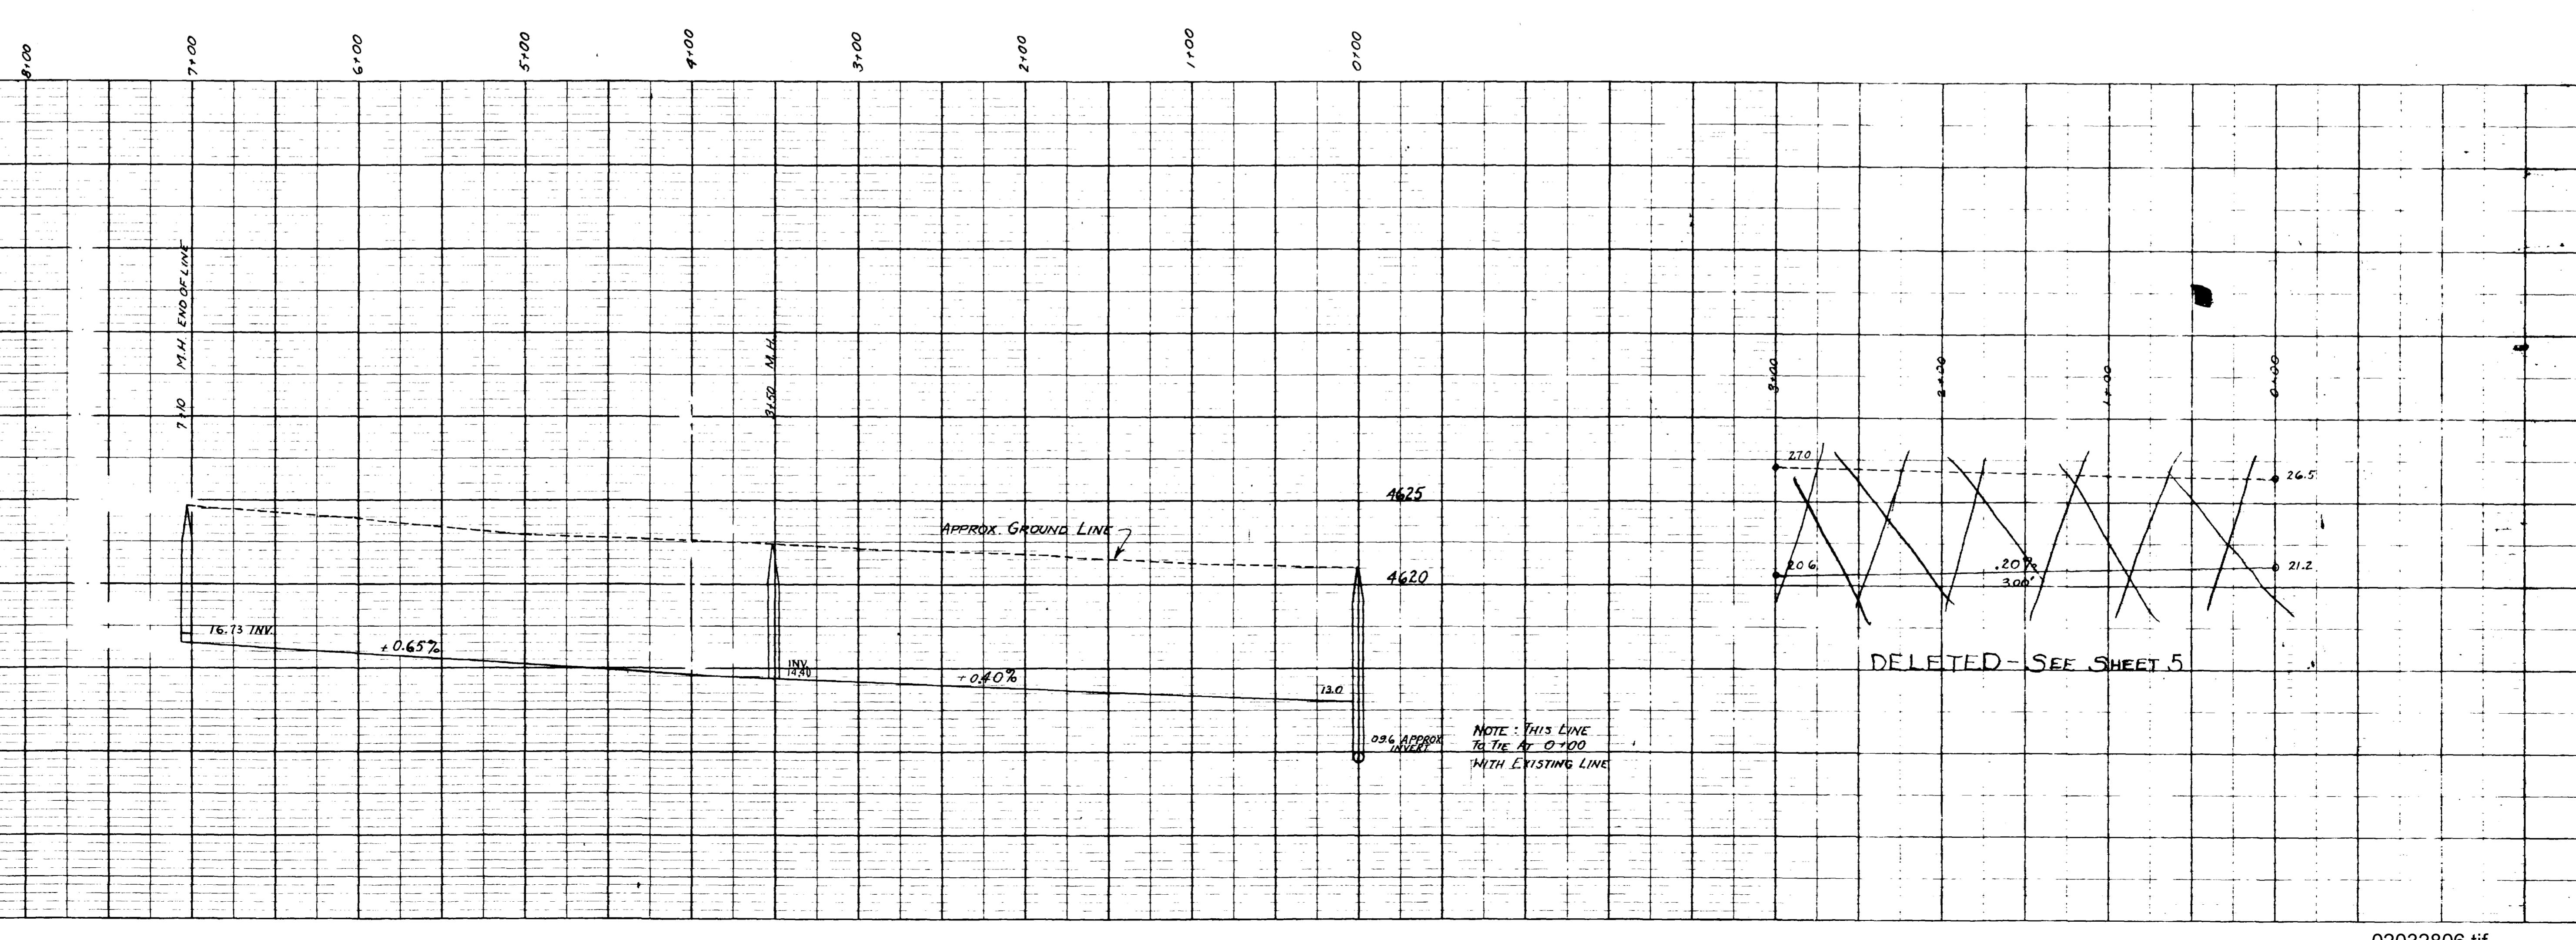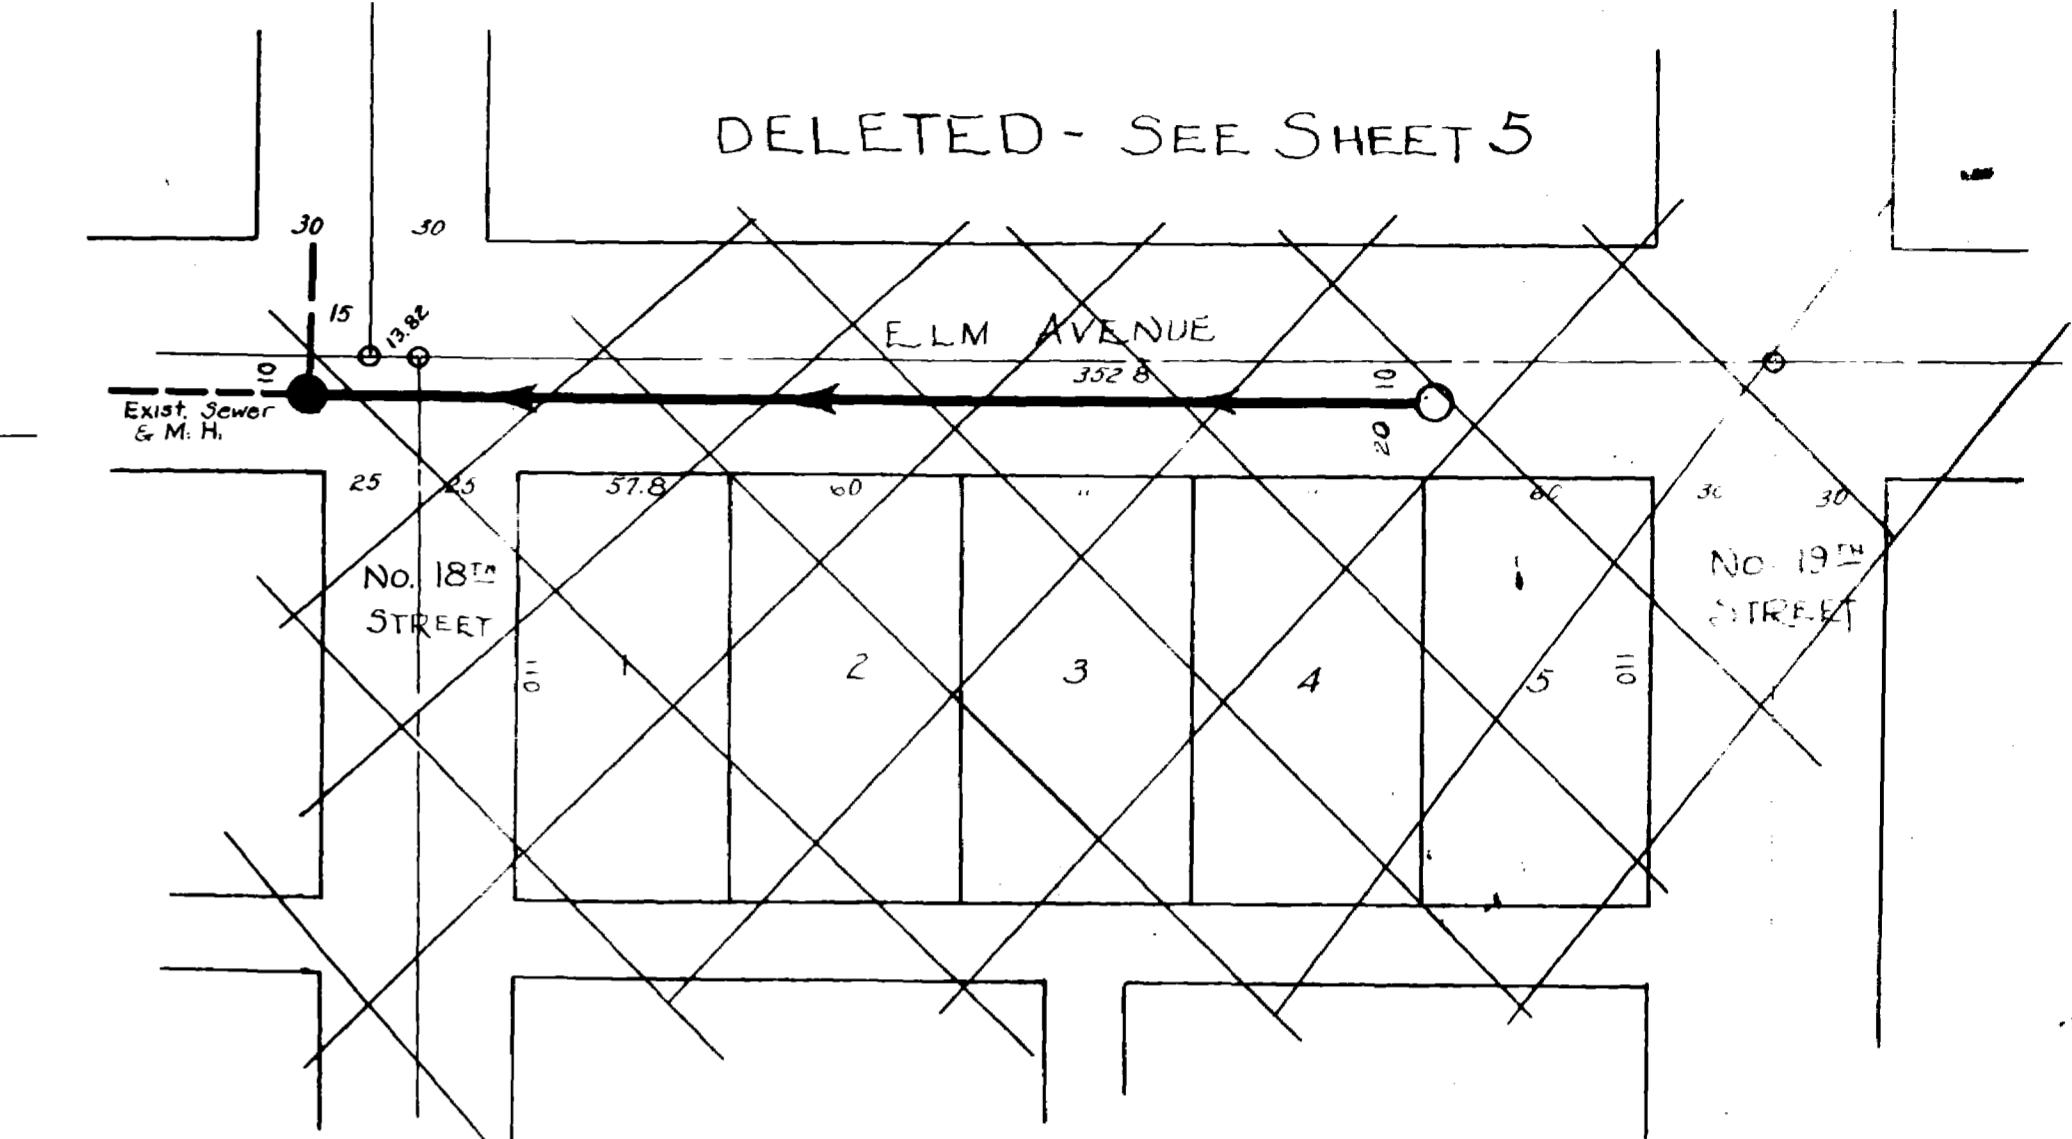

~~DELETED - SEE SHEET 5~~

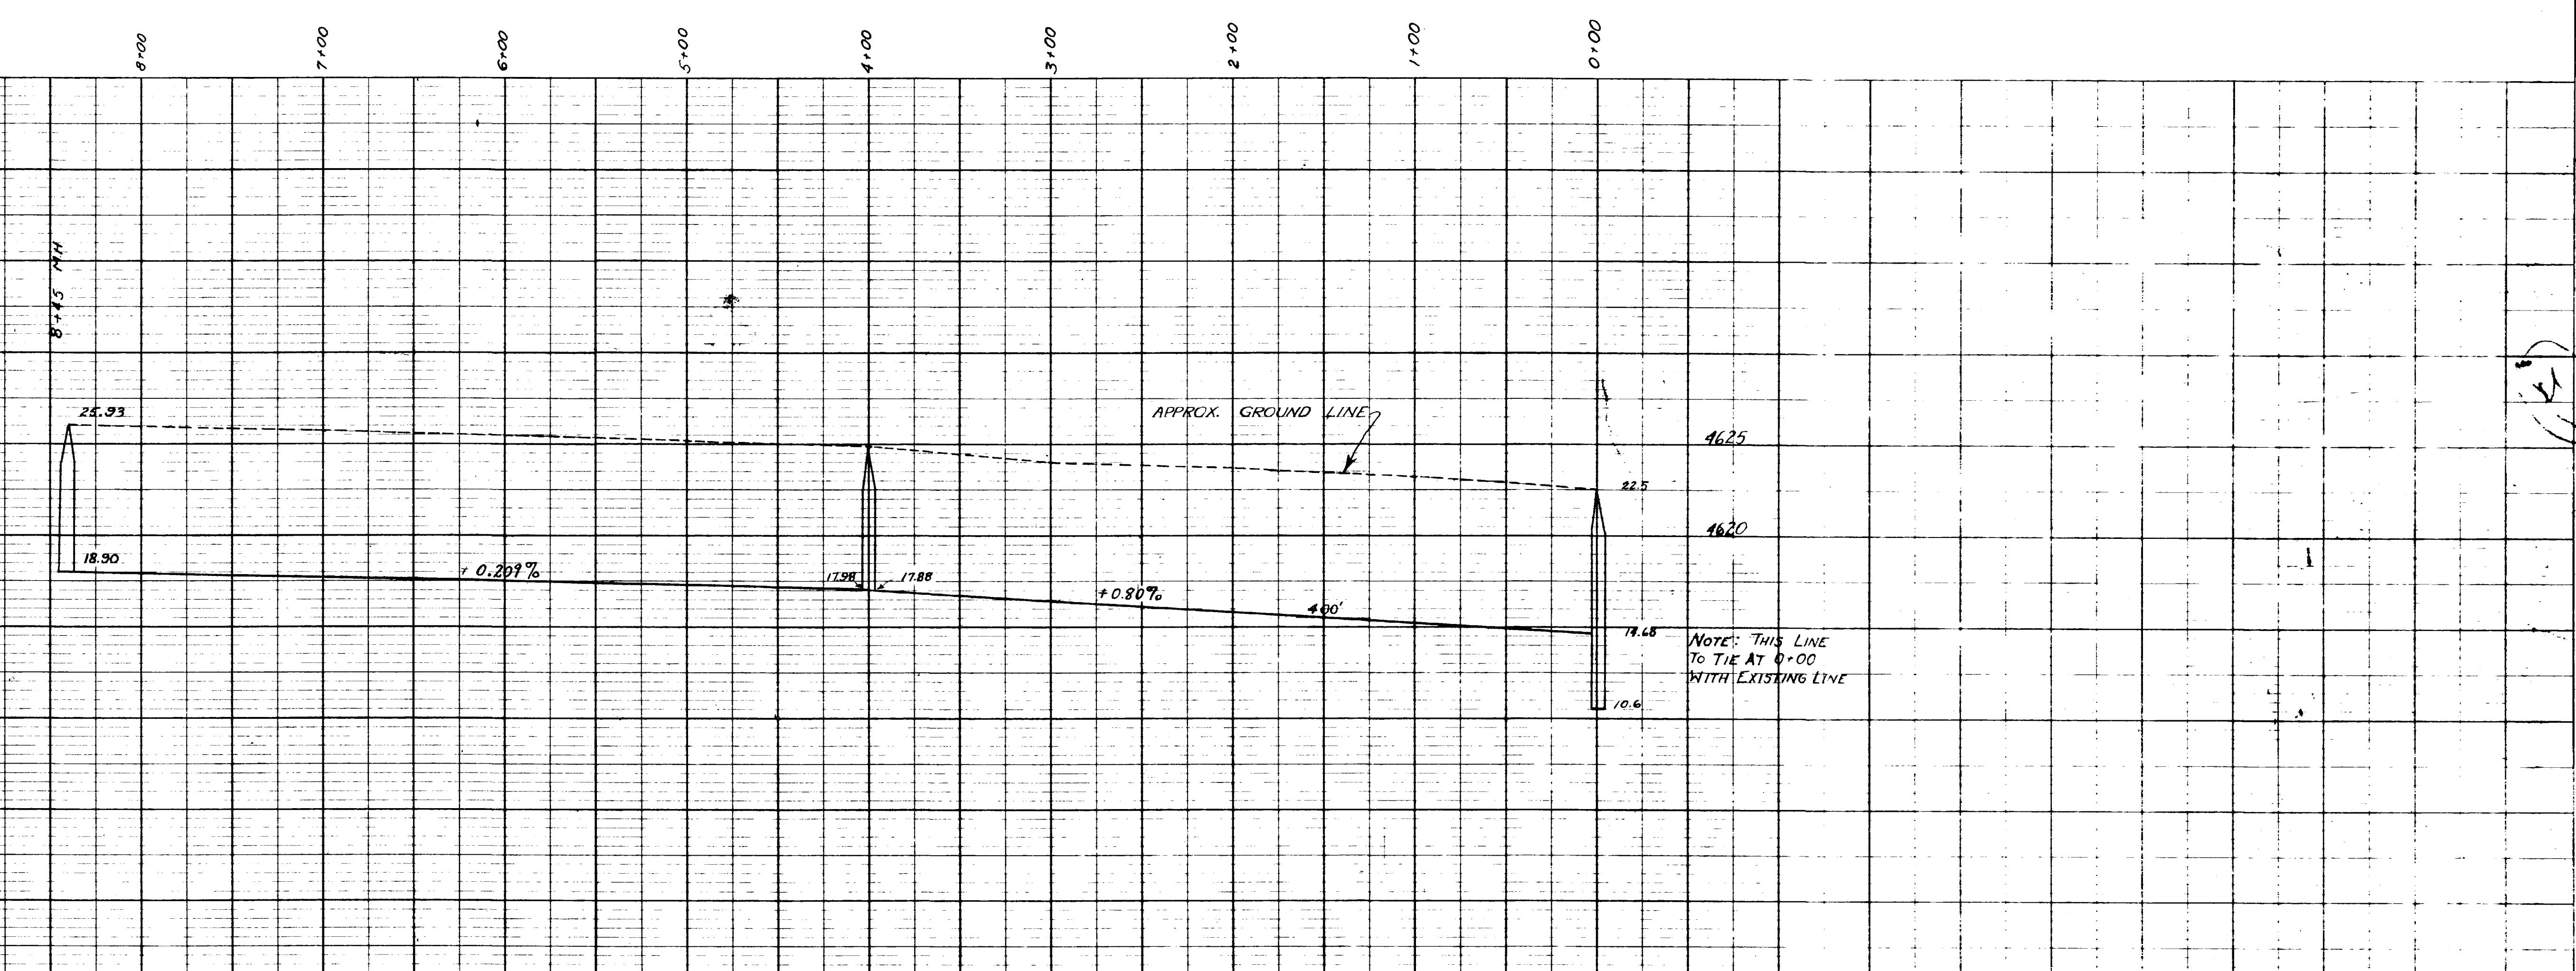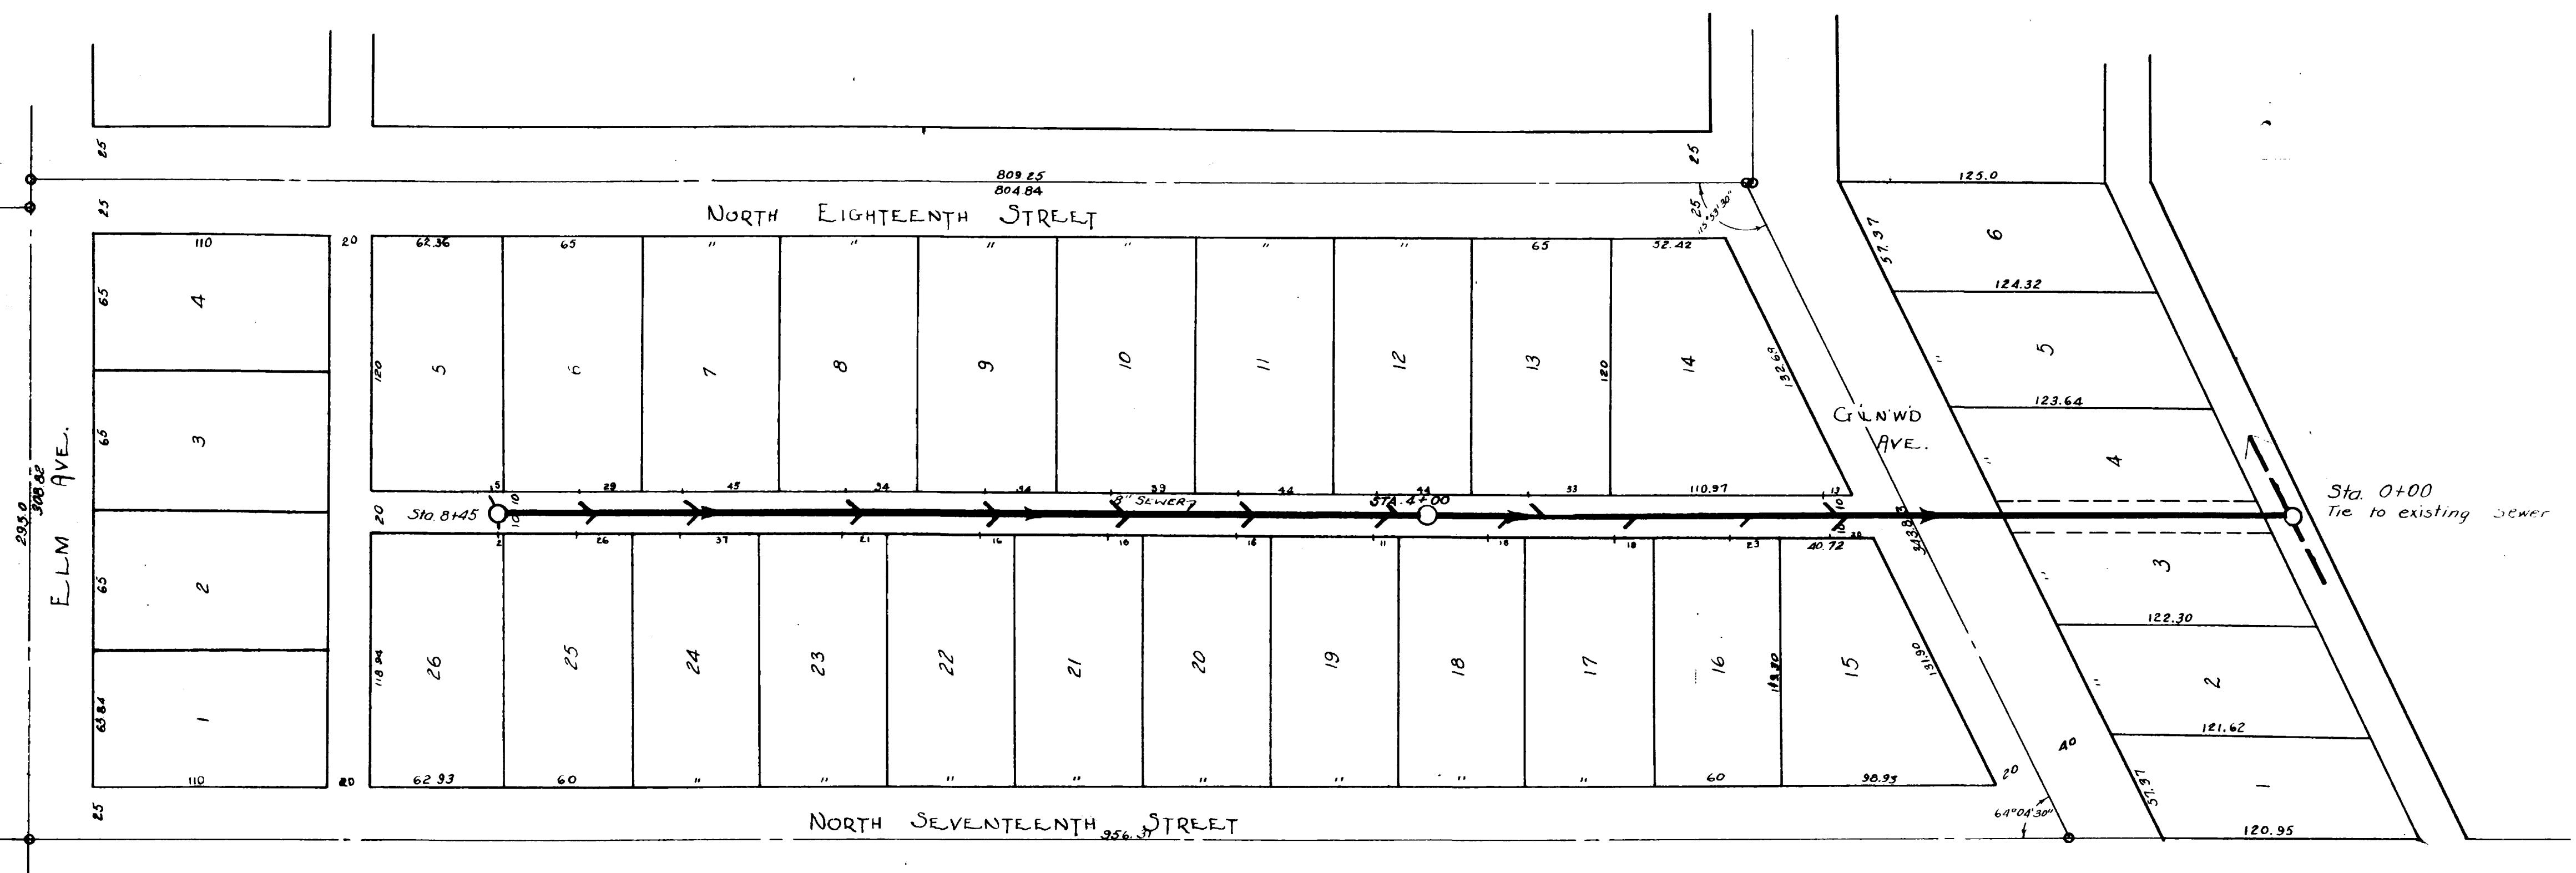

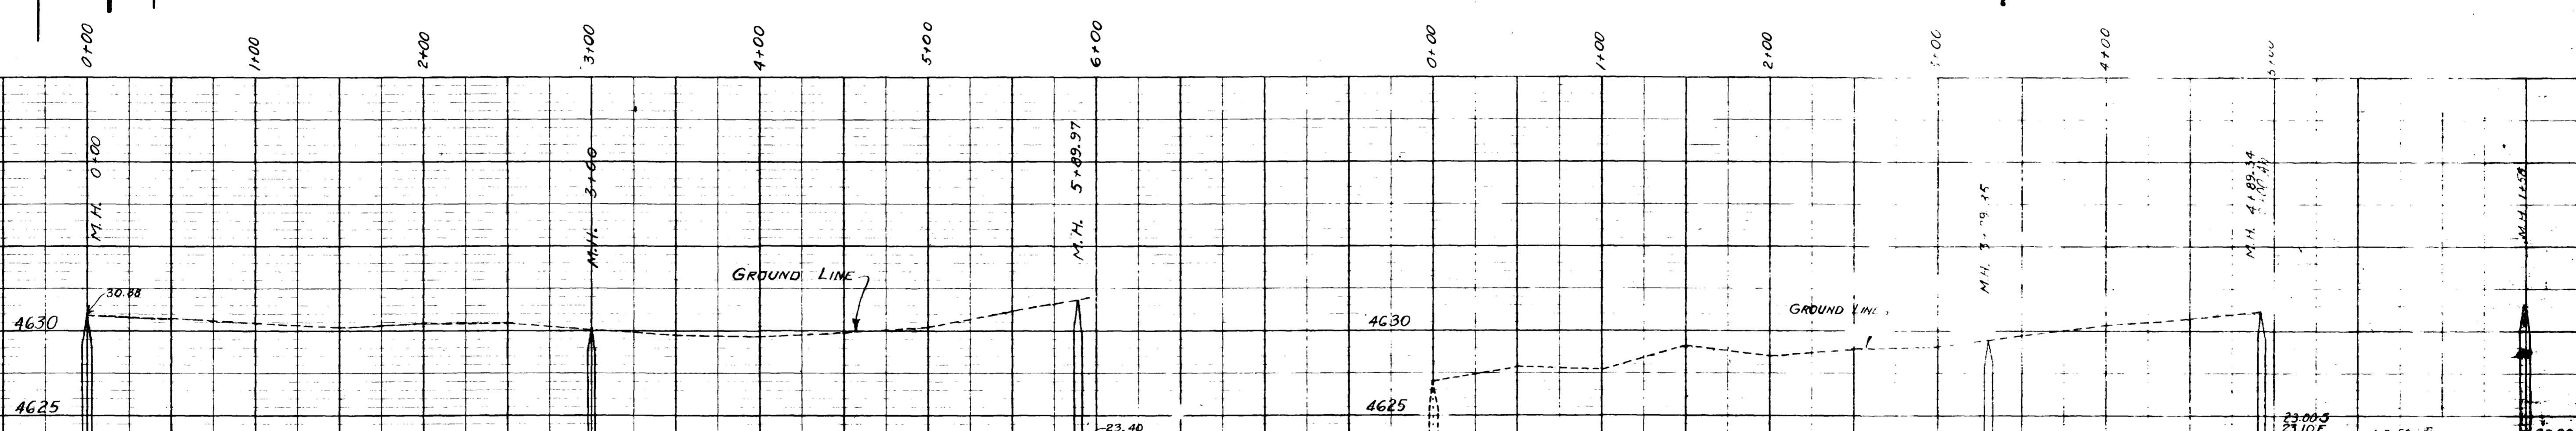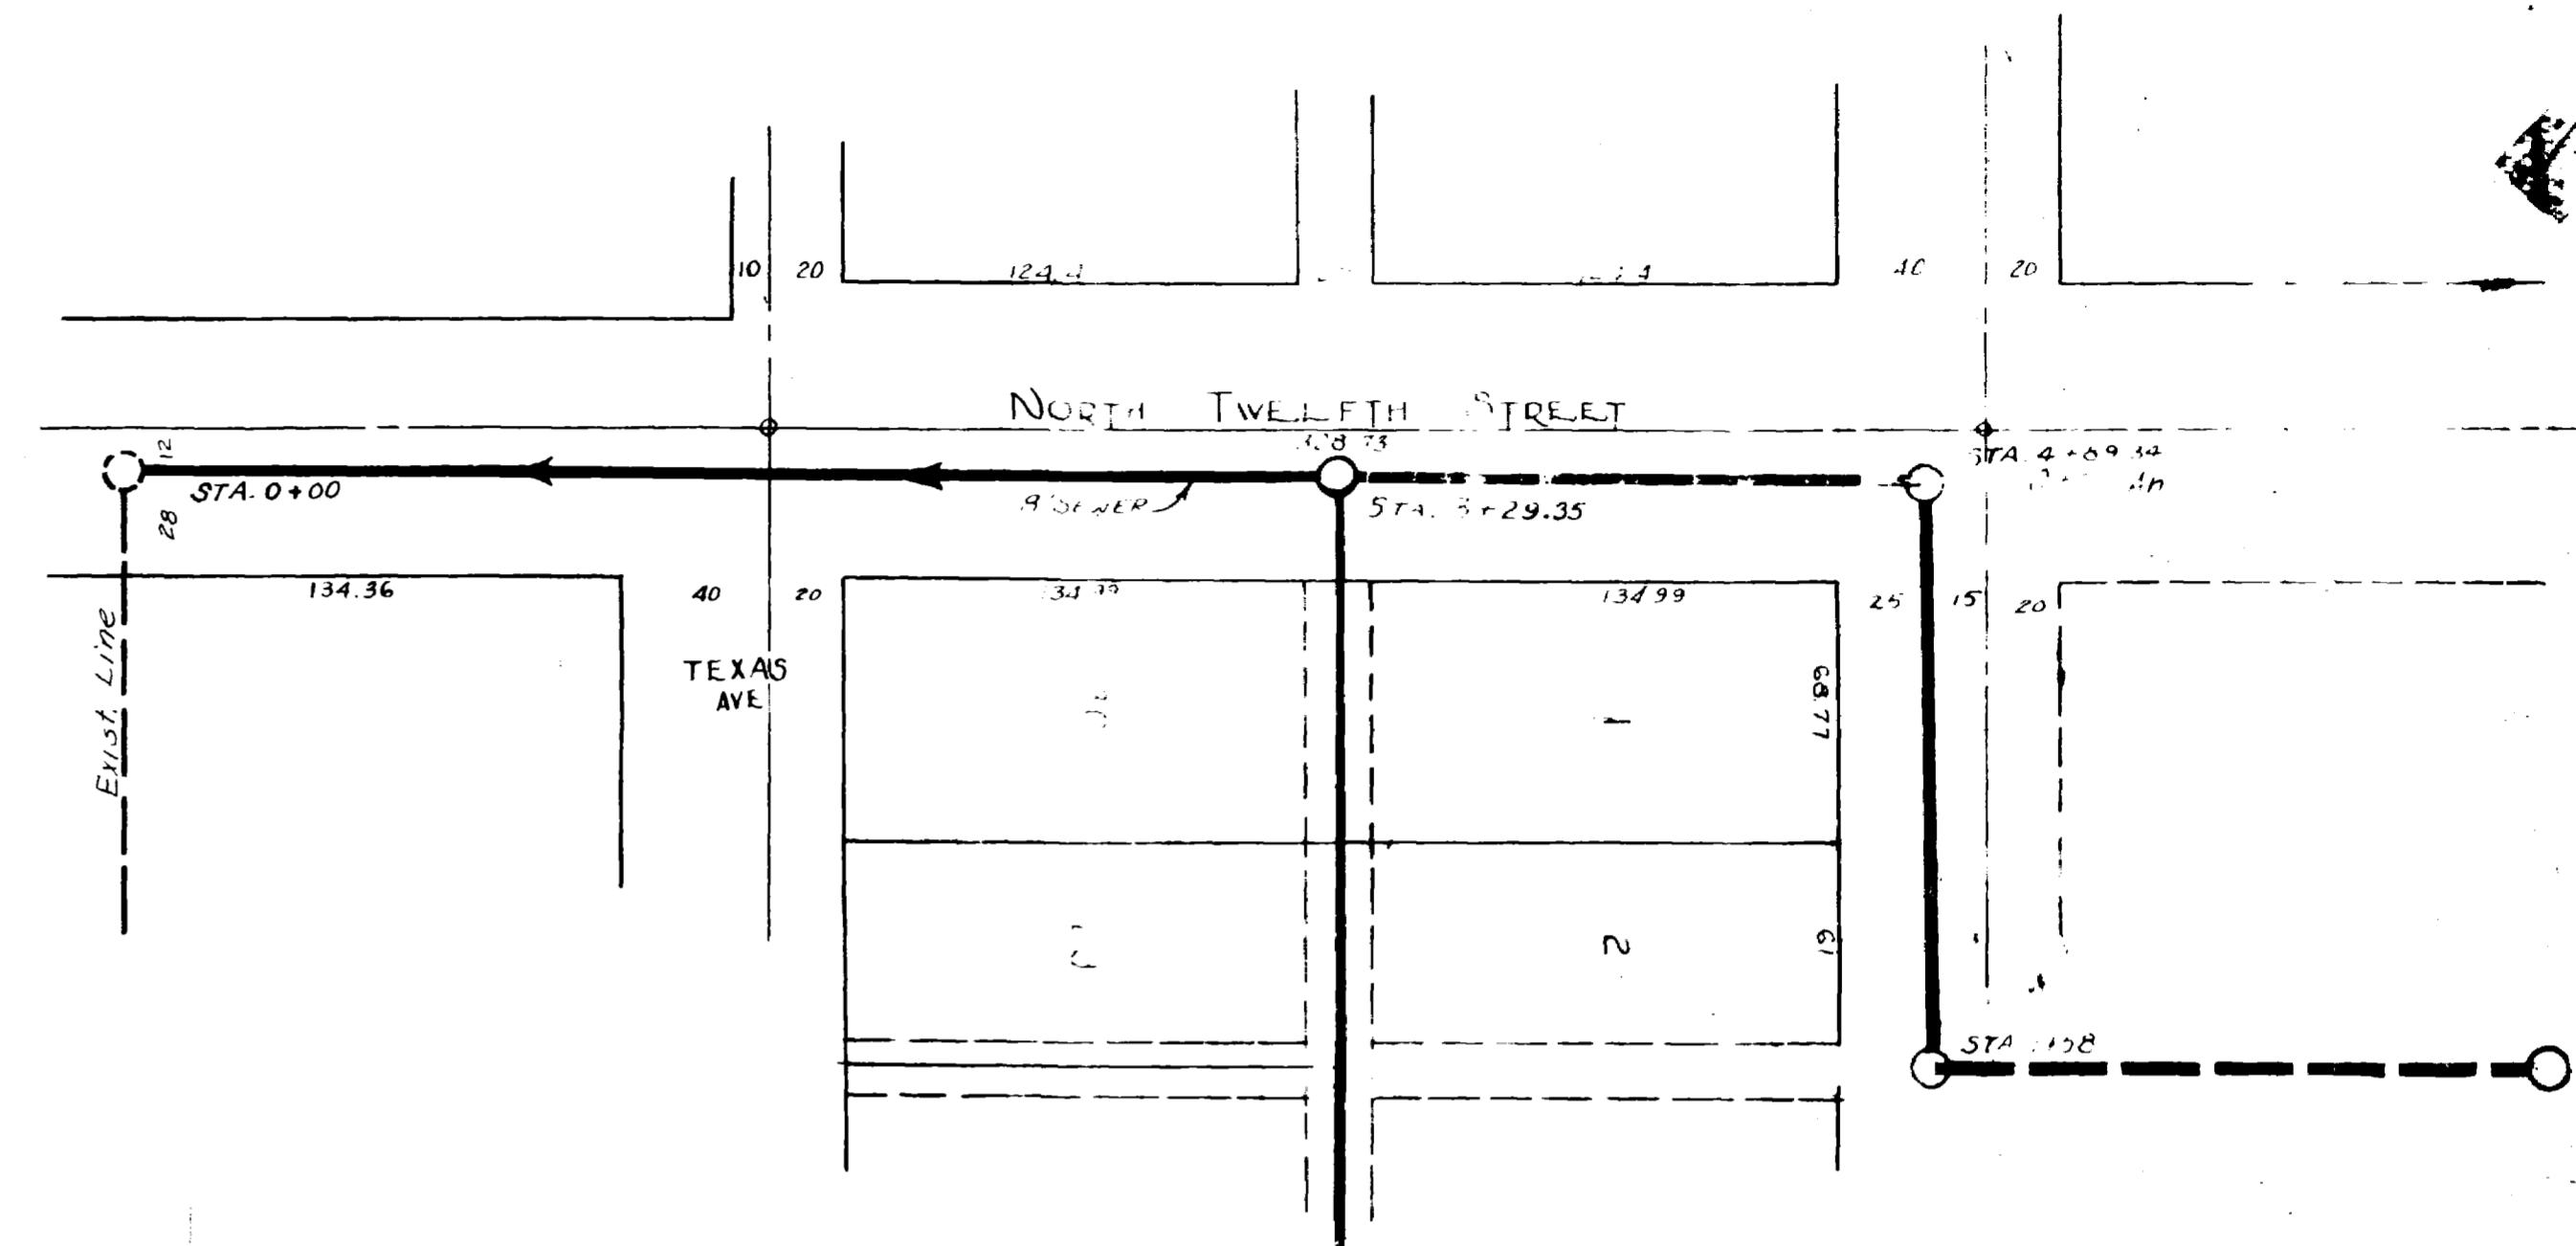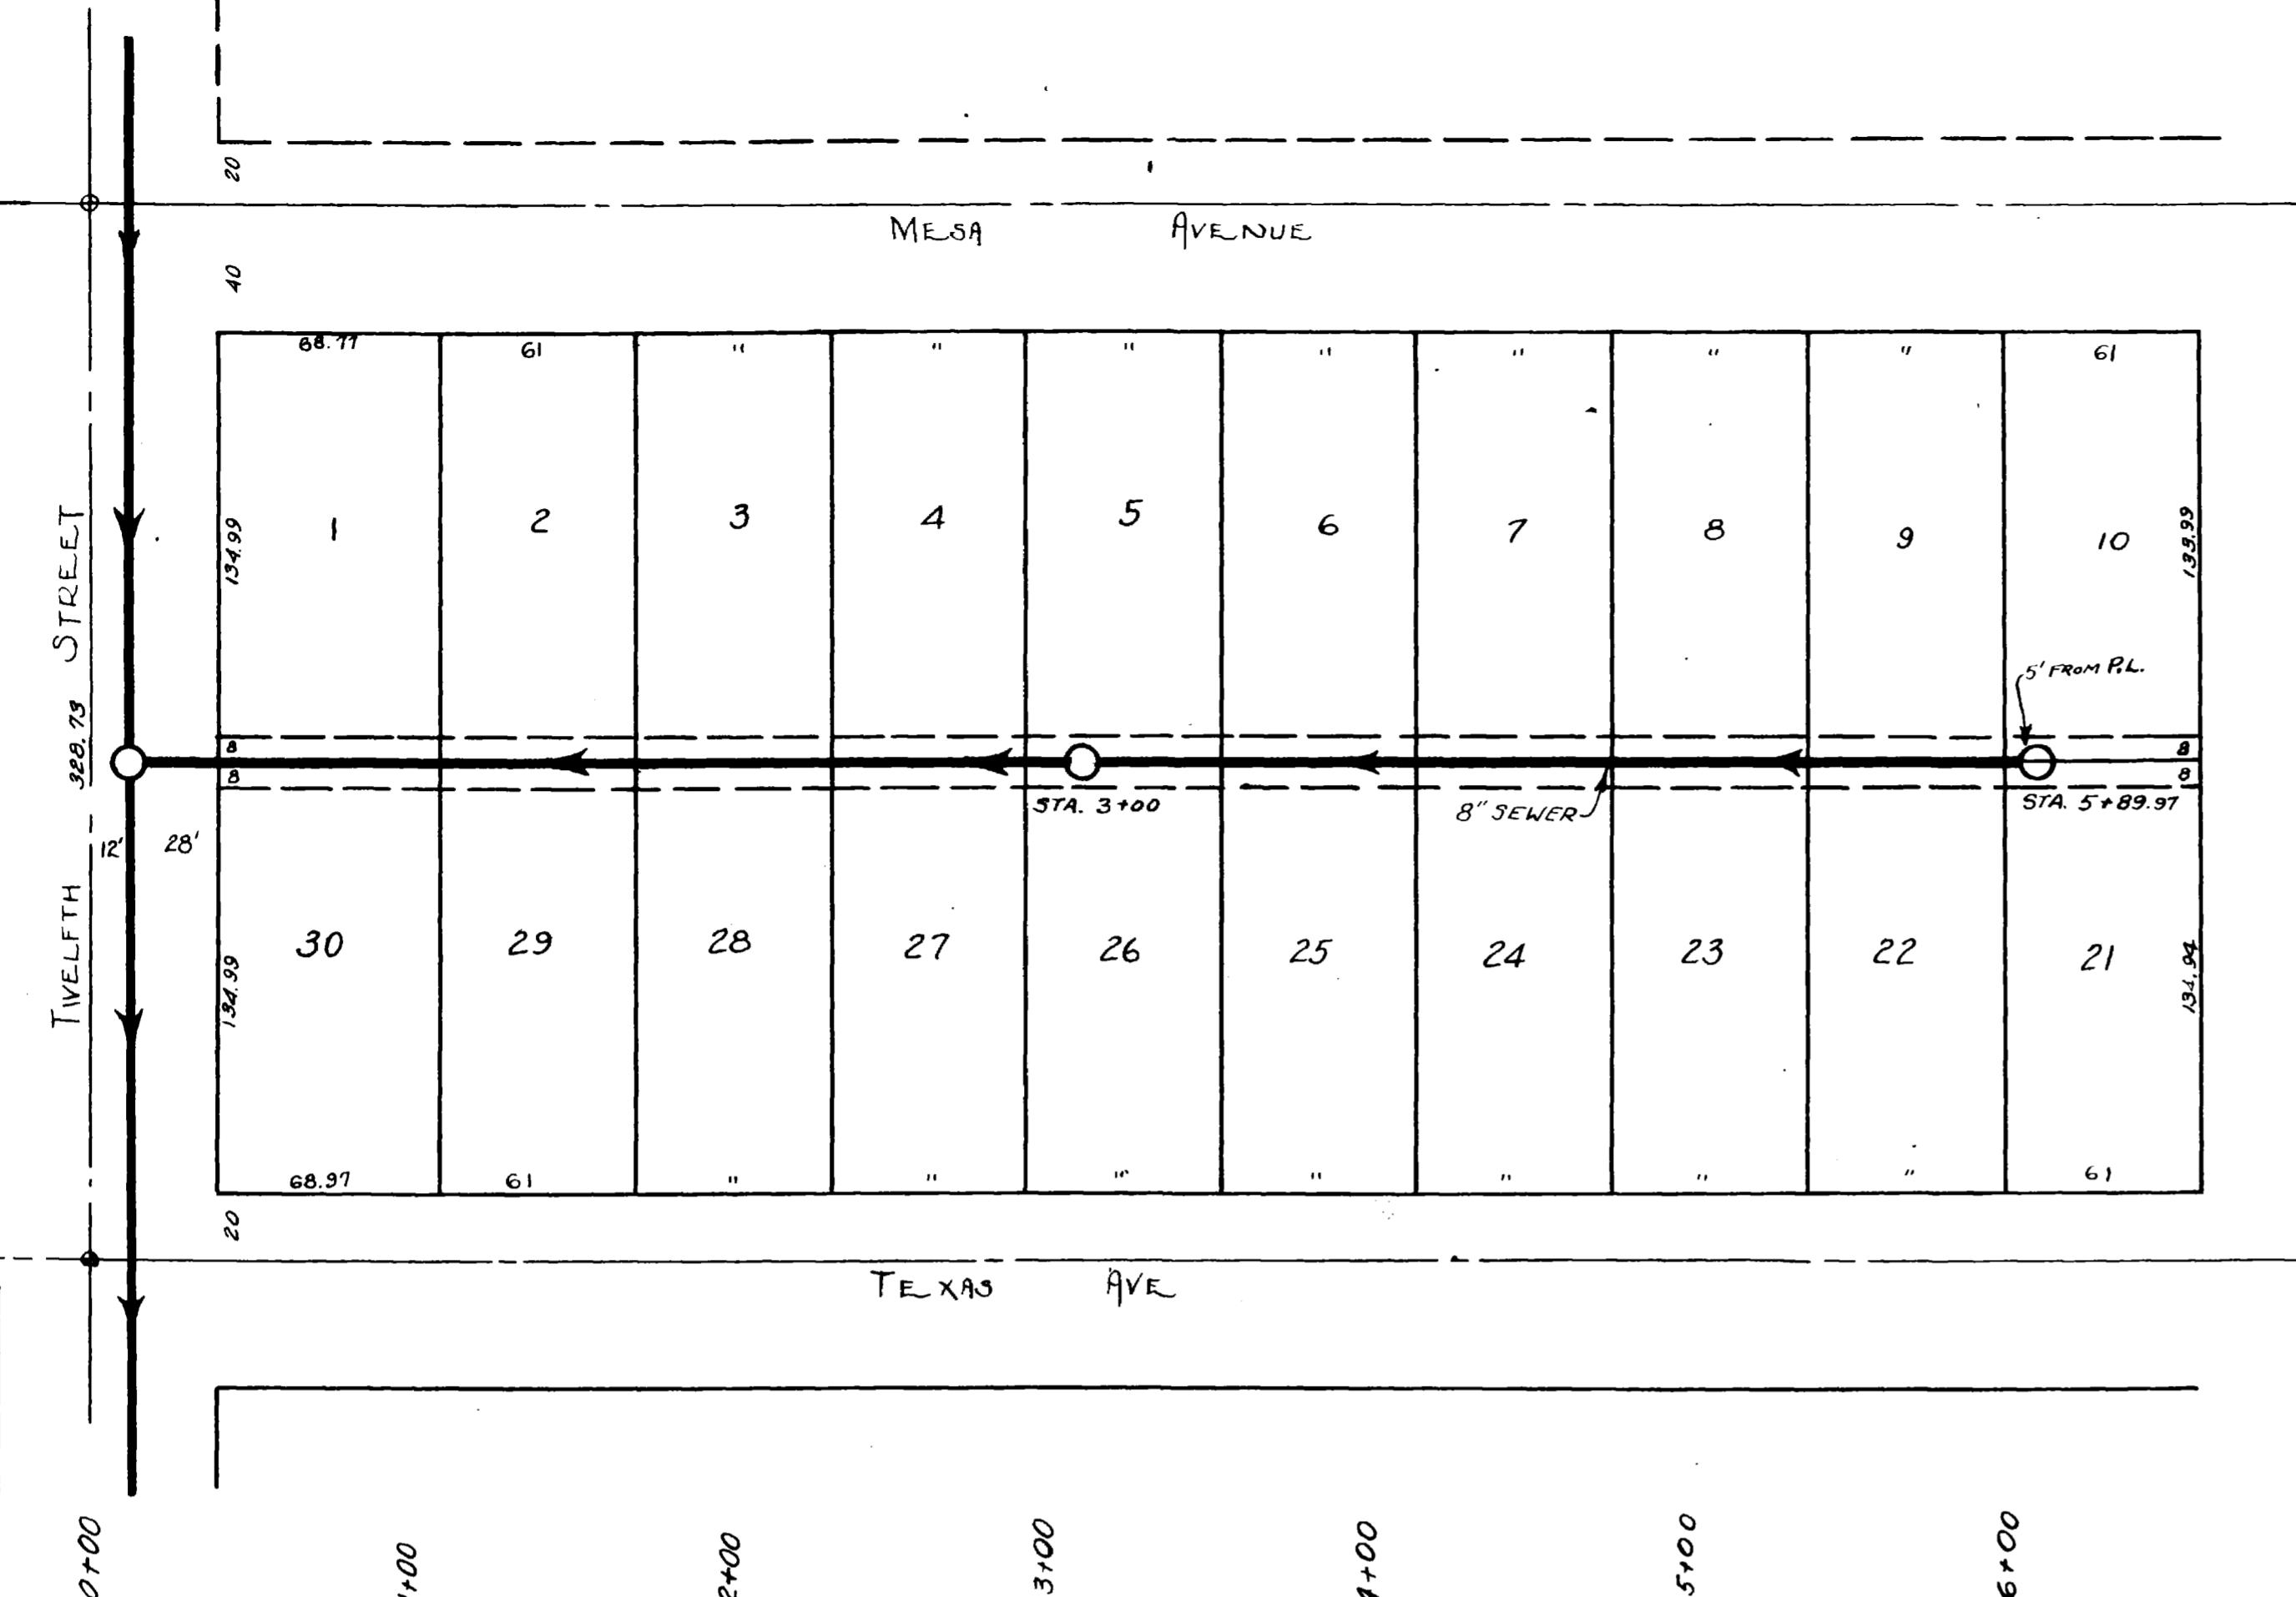

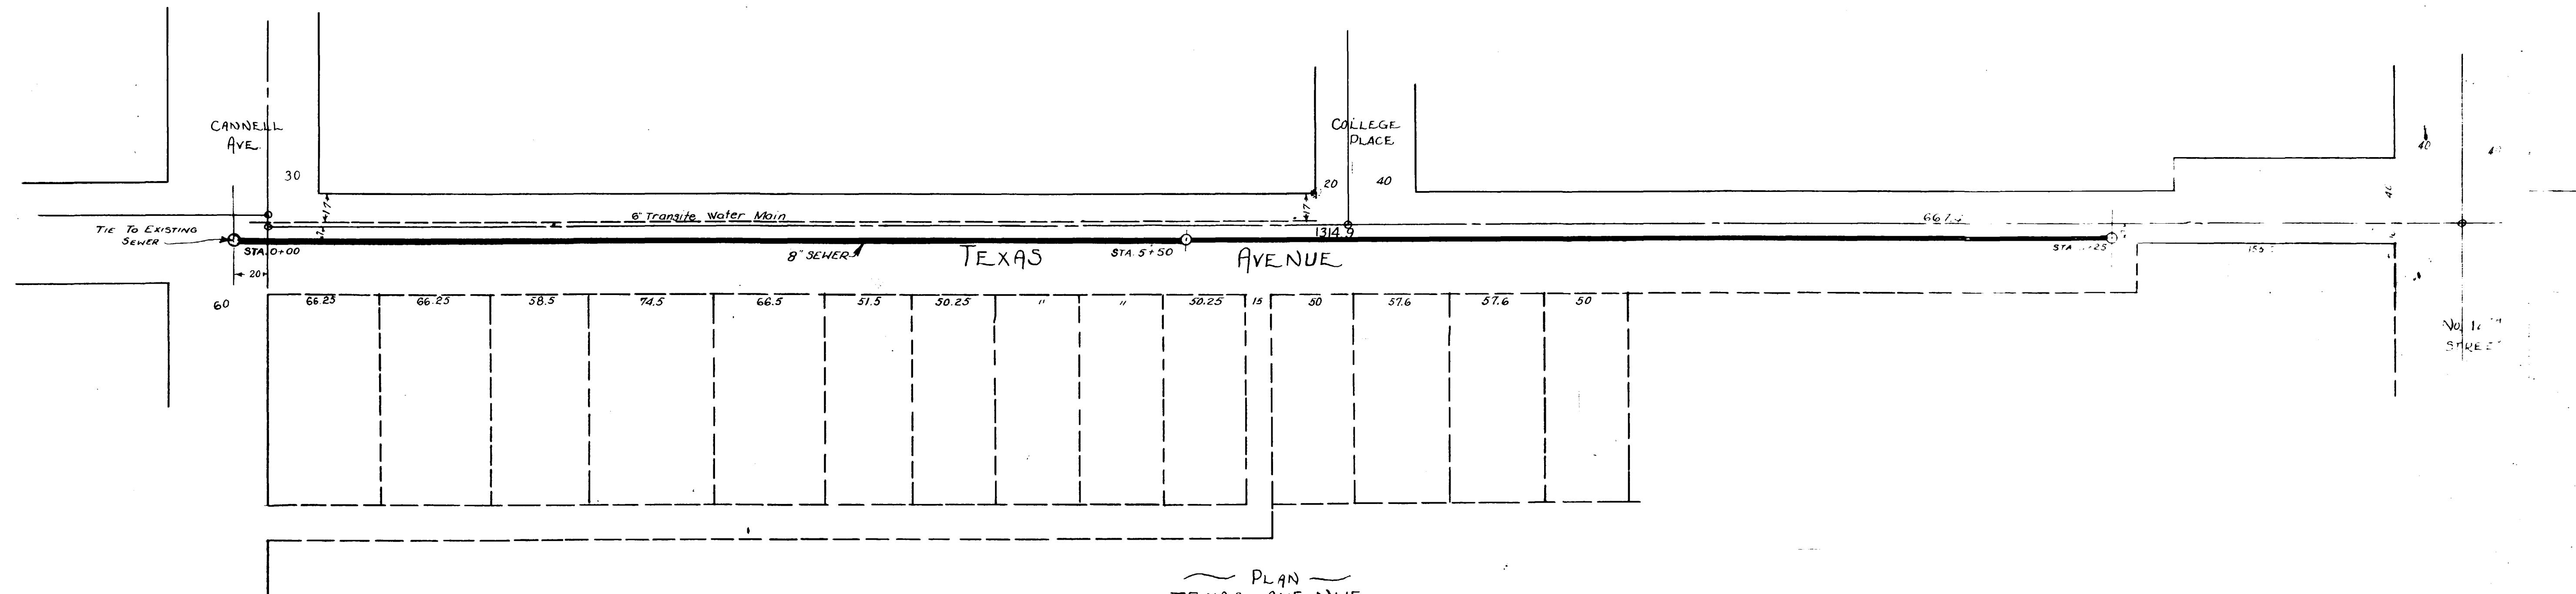

PLAN
TEXAS AVENUE
CANNELL AVE to 12th ST.
SCALE: 1"-50'

