

- LEGEND**
- RT RING TITE
 - FL FLANGE
 - TH THREADED
 - MSE MACHINED EACH END
 - MANHOLE
 - SANITARY SEWER LINE
 - WATER LINE (SIZE AS NOTED)
 - ⊕ FIRE HYDRANT
 - VALVE
 - ⊙ WATER METER

NOTES:

- SEWER LATERALS TO LOTS 1-6 REQUIRE 10' LONG CONCRETE ENCASUREMENTS @ WATERLINE CROSSINGS.

CONTRACTOR'S CERTIFICATE

THIS IS AN ACCURATE REPRESENTATION OF THE PHASE I WATER & SEWER MAINLINES, SERVICES AND RELATED APPURTENANCES AS THEY WERE INSTALLED BY LYLE STATES CONSTRUCTION, INC.

Lyle States Construction, Inc. 12/21/84
 LYLE STATES CONSTRUCTION, INC. DATE
Lyle States

INFILTRATION CERTIFICATE


THIS IS TO CERTIFY THAT BECK, SHRUM & ASSOCIATES, INC. REVIEWED THE PHASE I SEWER SYSTEM AND FOUND THAT THE GROUND WATER INFILTRATION DID NOT EXCEED THE MAXIMUM ALLOWABLE RATE AS DETAILED IN THE CITY OF GRAND JUNCTION CONSTRUCTION SPECIFICATIONS.

James P. Beck 11/30/84
 BECK, SHRUM & ASSOCIATES, INC. DATE

PROJECT RECORD
 DRAWING - PHASE I


SCALE: As Shown	PROJECT NUMBER: K 1502	SHEET NUMBER: 8 of 16
TIARA RADO SOUTH, Fil. No. 1		
WATER & SANITARY SEWER PLANS		
BECK, SHRUM and ASSOCIATES, INC. GRAND JUNCTION, COLORADO 81501 Engineers (303) 243-1227 planners		
REVISIONS	DATE	REMARKS
Δ	11/30/84	PROJECT RECORD DWG
BY	TPB	
DRWN BY	WJC	
DATE	10/6/83	

"A" LINE

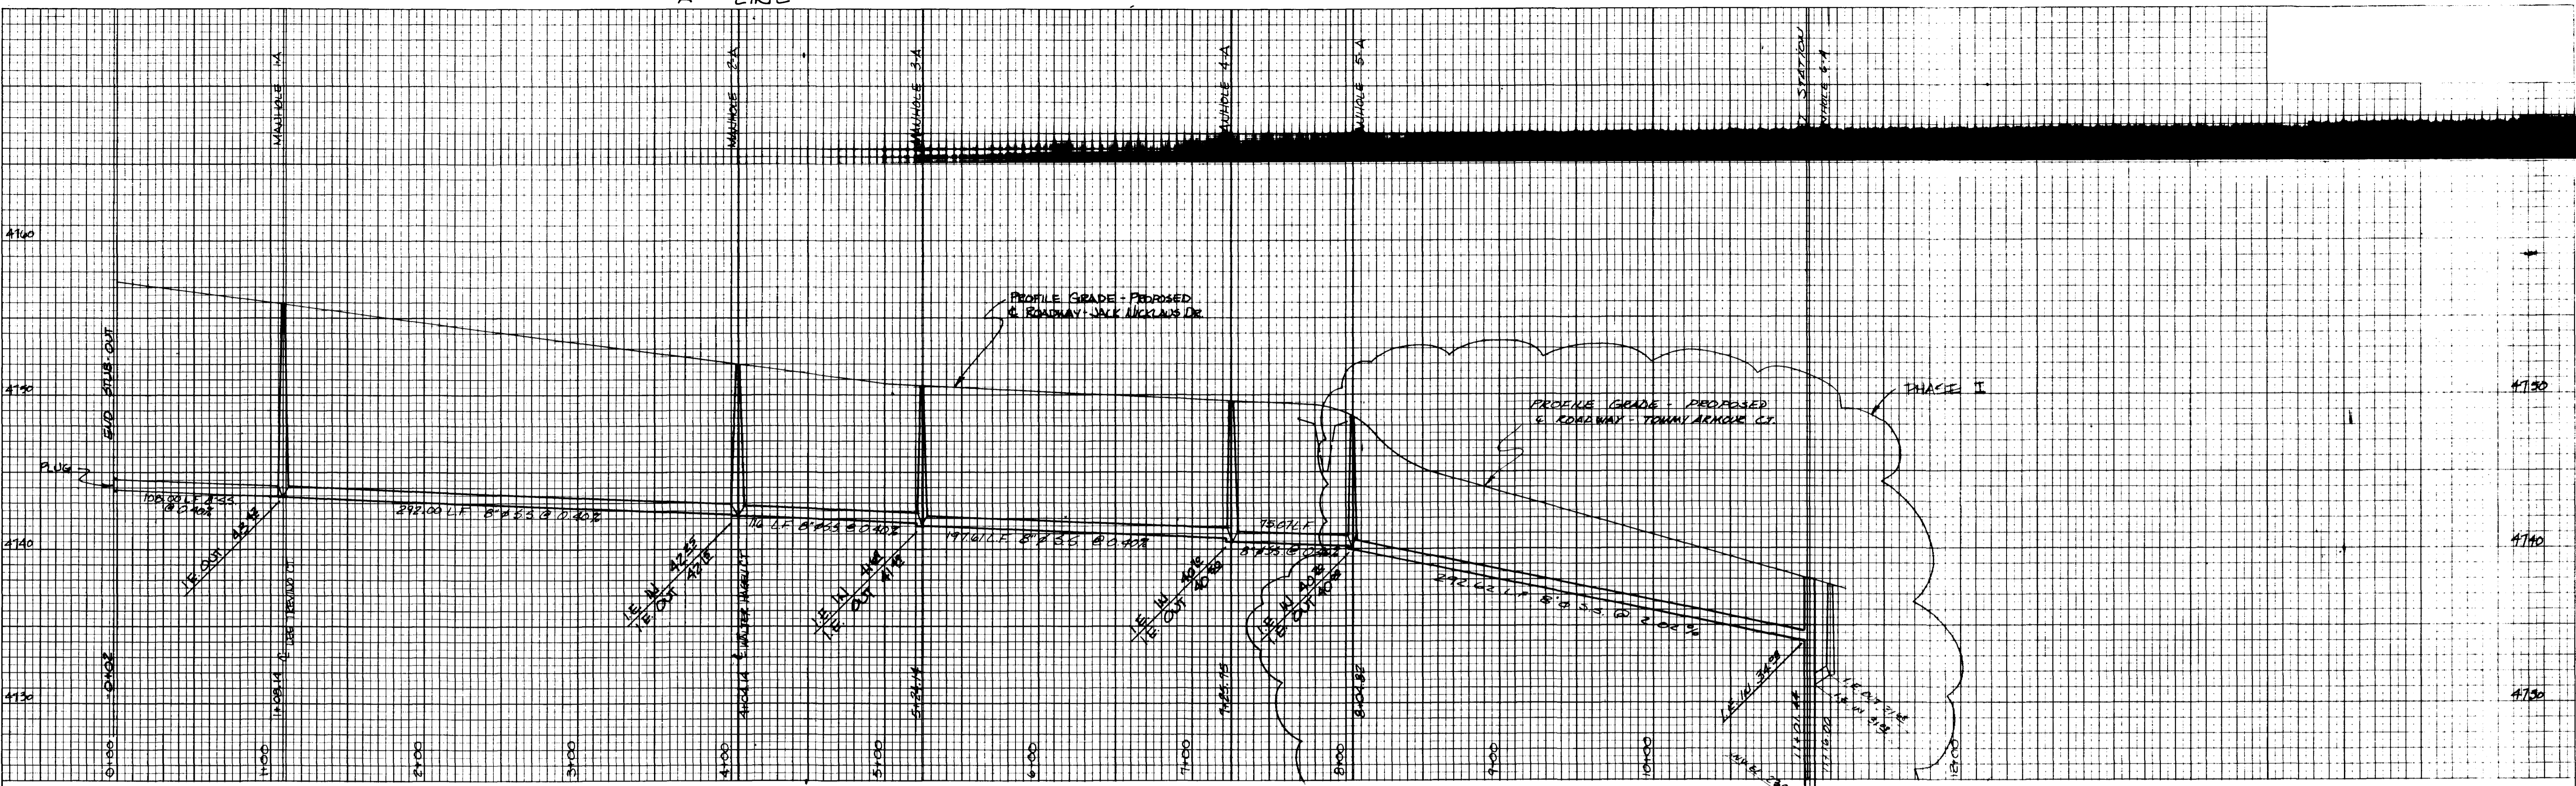

"1-A" LINE

"2-A" LINE

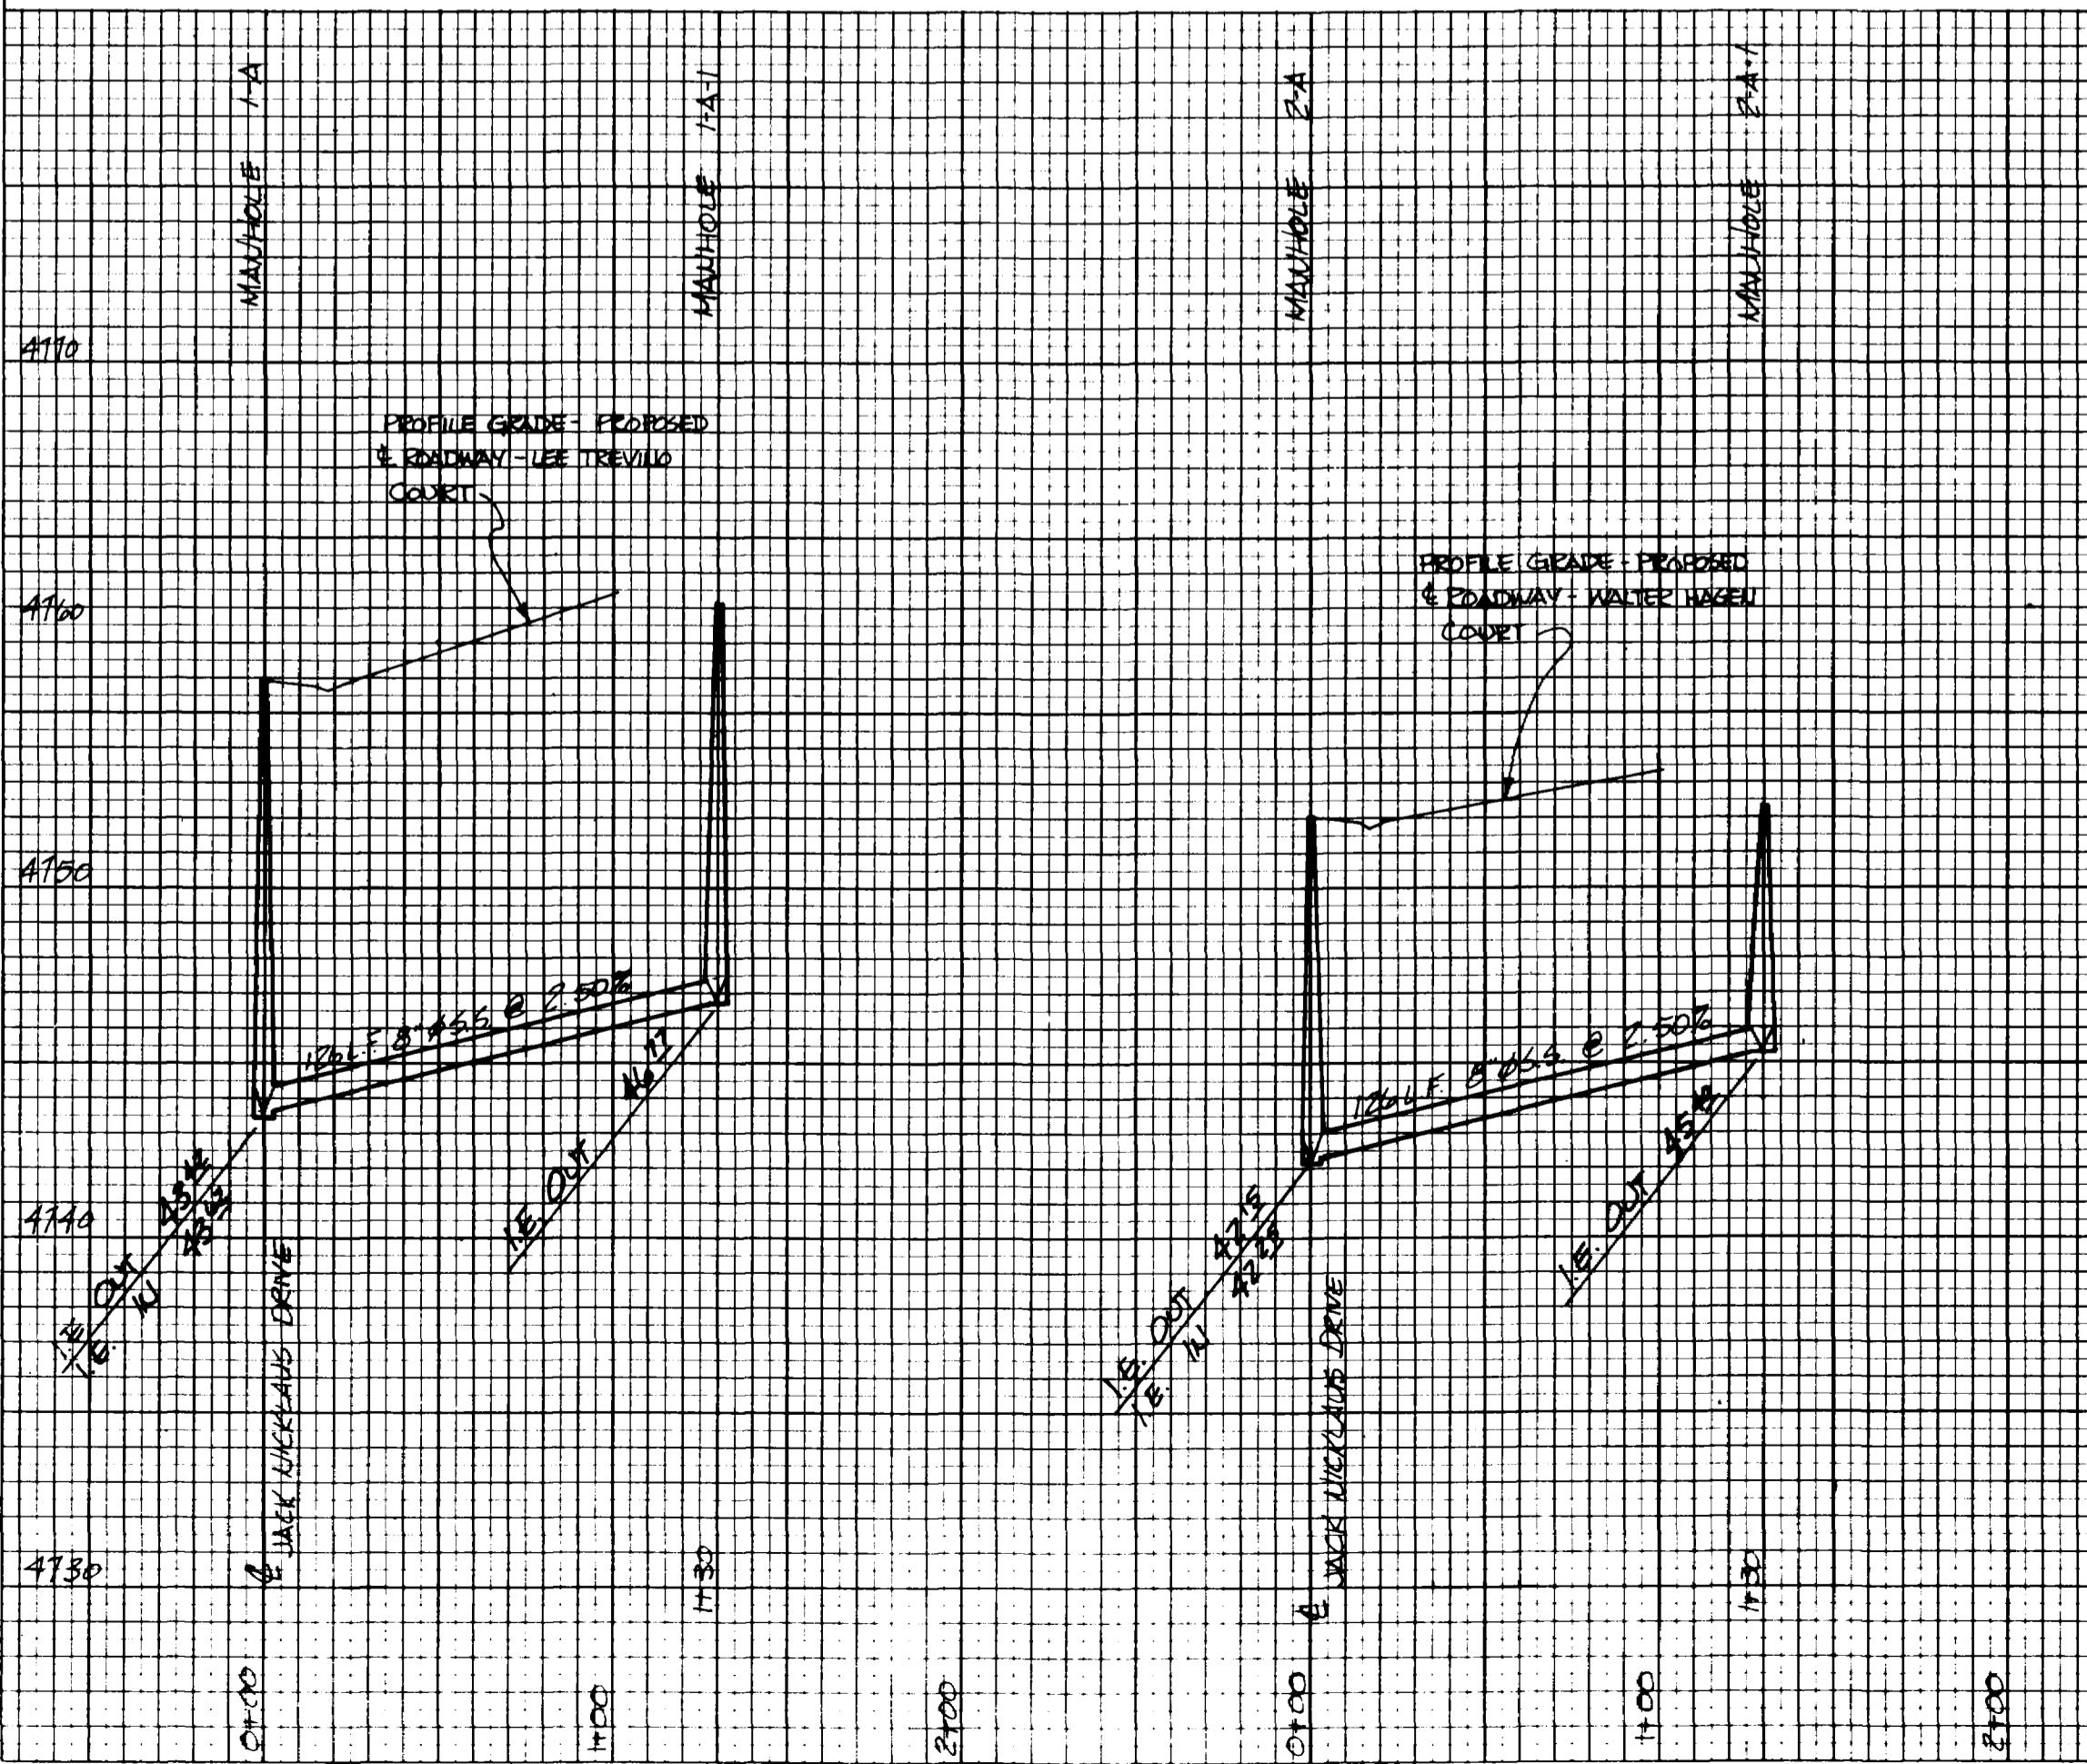

CONTRACTOR'S CERTIFICATE
 THIS IS AN ACCURATE REPRESENTATION OF THE PHASE I SEWER MAINLINE AND MANHOLES AS THEY WERE INSTALLED BY LYLE STATES CONSTRUCTION, INC.
 [Signature]
 LYLE STATES CONSTRUCTION, INC. DATE: 10/14/14

PROJECT RECORD
 DRAWING - PHASE I

SAUNITARY SEWER PROFILE
 TIARA RADO SOUTH - FIL. No. 1
 BECK, SHRUM and ASSOCIATES, INC.
 PUFFERBELL EAST, 215 PITKIN, SUITE 203
 GRAND JUNCTION, COLORADO 81501
 (303) 243-1227
 engineers