
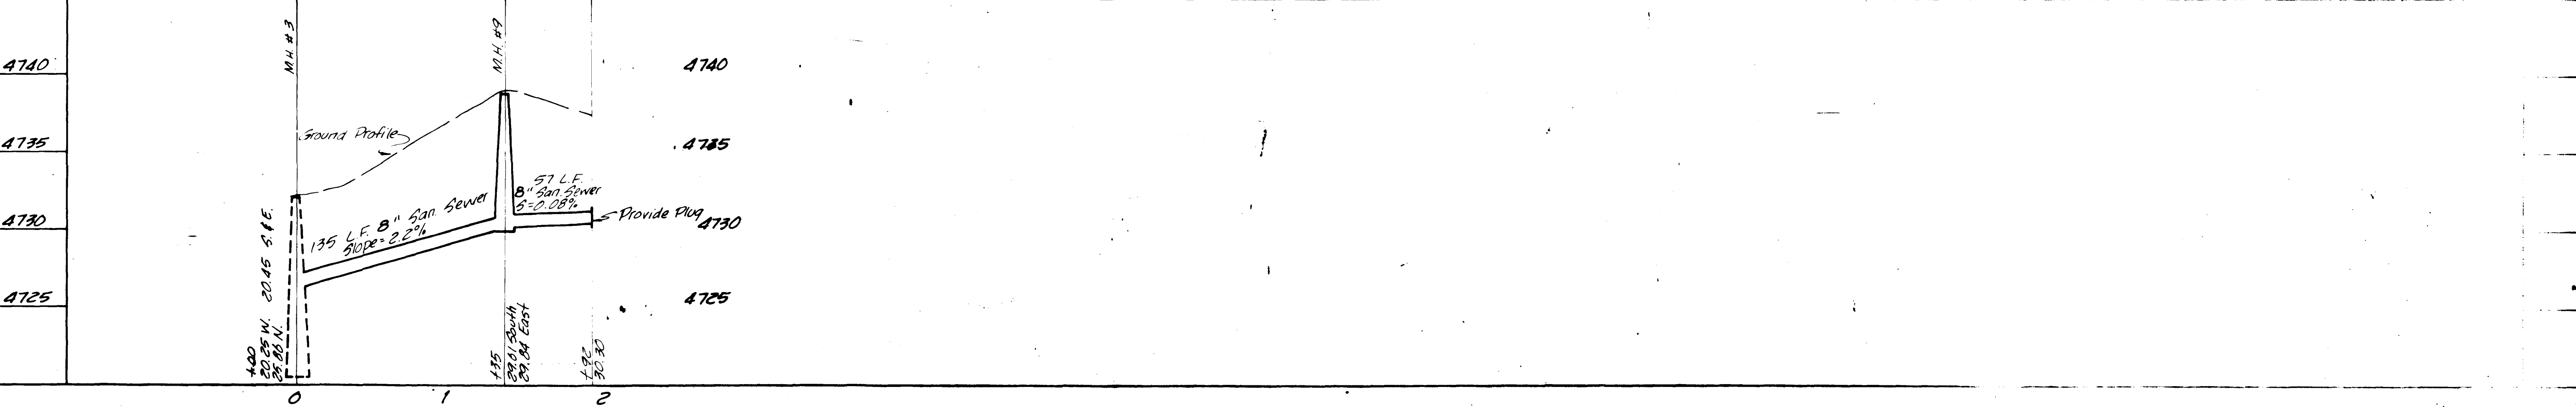
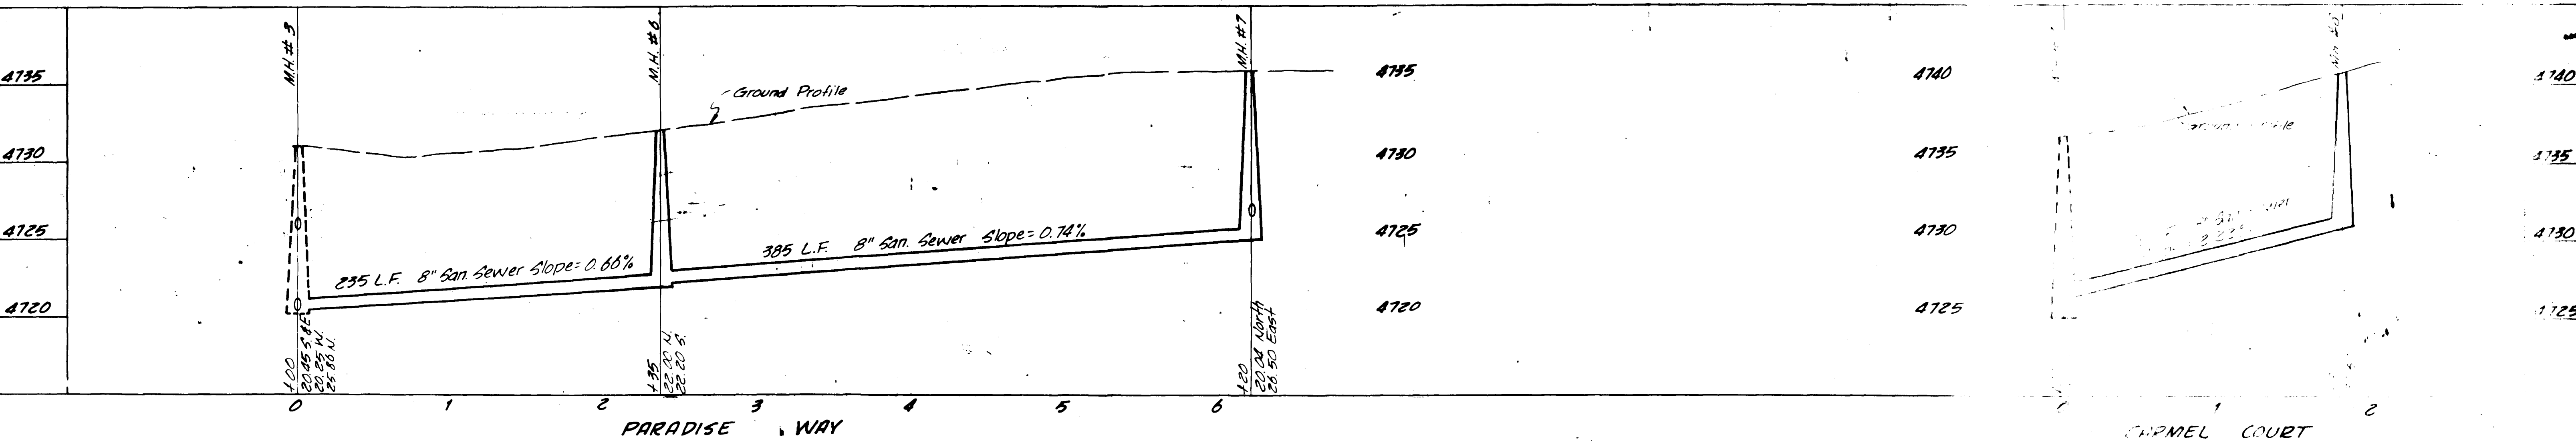


AS BUILT

1	RTZ	1/24	AS BUILT	DATE	Sept. 1973	DRAWN BY	JRL	CHECKED BY	MJC	PROJECT	RTZ	CONTRACT	NO. 1	PROJECT NO.	47P	DATE	11-100	SCALE	1"=100'	PROJECT	MILES SUBDIVISION	MAP NO. THR	SANITARY SEWER PLAN
---	-----	------	----------	------	------------	----------	-----	------------	-----	---------	-----	----------	-------	-------------	-----	------	--------	-------	---------	---------	-------------------	-------------	---------------------

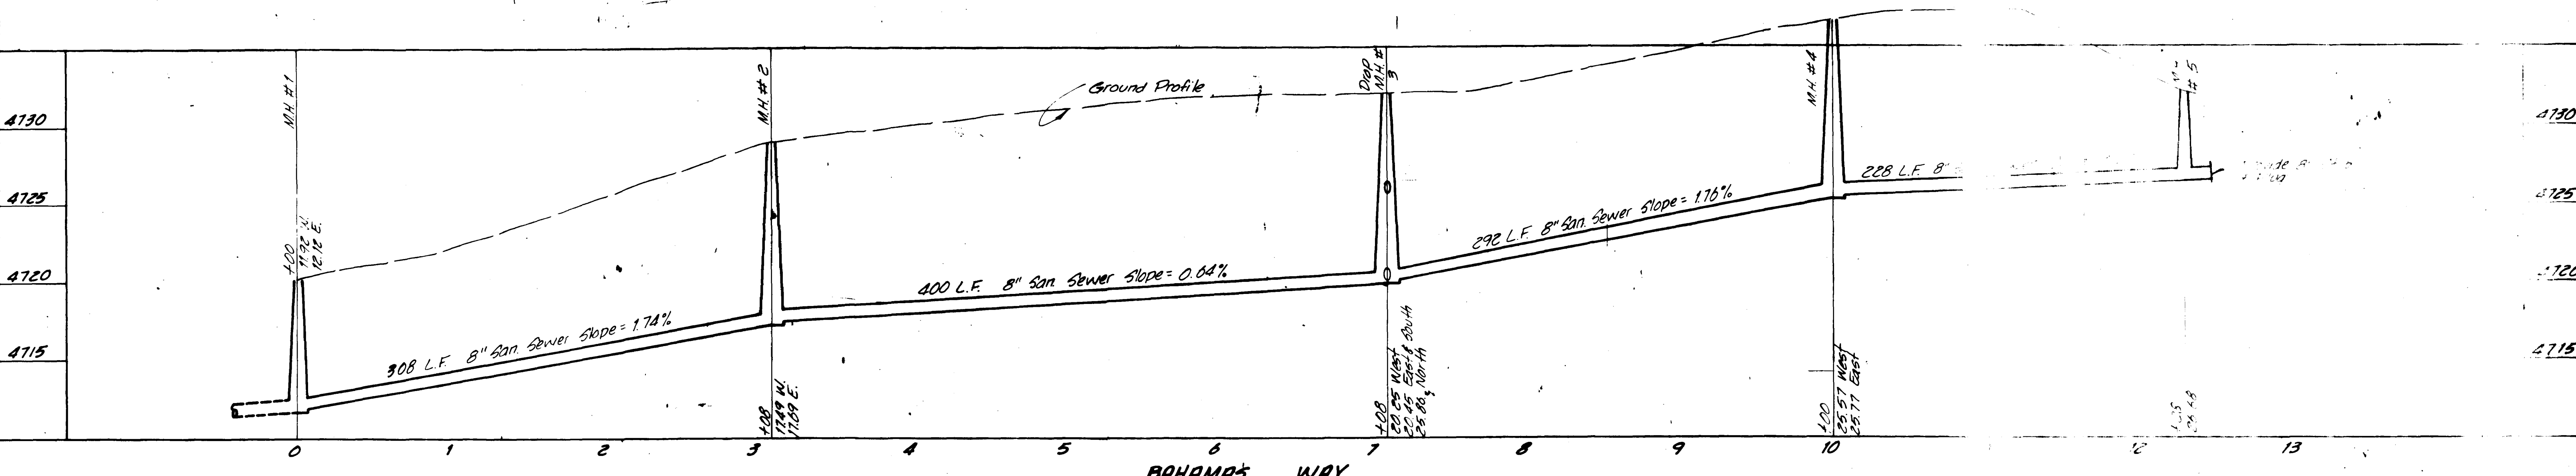

NO.	BY	DATE	APPROVED	NO.	BY	DATE	APPROVED	NO.	BY	DATE	APPROVED	NO.	BY	DATE	APPROVED

DATE	SEPT, 1973	DESIGNED BY	T.R.L.	DEPT. HEAD	J.T.P.
SCALE	1"=5' Vert. 1"=50' Horiz.	PROJECT ENG.	R.L.A.	CONST. REP.	N.H.P.A.
		PROJECT MGR.	J.T.P.		

ENGINEERS	NELSON - HALEY - PATTERSON AND QUIRK	PARADISE HILLS SUBDIVISION
CONSULTANTS	ENGINEERING CONSULTANTS	FILING No. THREE
	GRAND JUNCTION	COLORADO

SANITARY SEWER PROFILE		2
------------------------	--	---