

SUNBURST COURT


CALC : $1'' = 20'$ HGT.
 $1'' = 5'$ VERT.



sent from center onto "as built" 3/10/04

SEWARD ASBURY'S

MR. MTE	REVISION	BY	
COLORADO WEST ASSOCIATES INC.	SOLAR HORIZONS VILLAGE		
Engineering Surveying Planning	<u>SUNBURST COURT</u> STREET, WATER, & SEWER PLAN & PROFILE		
NC 303 209-2787	MR. MTE	REVISION	
200 COLORADO AVENUE	EX-100	JOB NO. 00-1100	Sheet 1


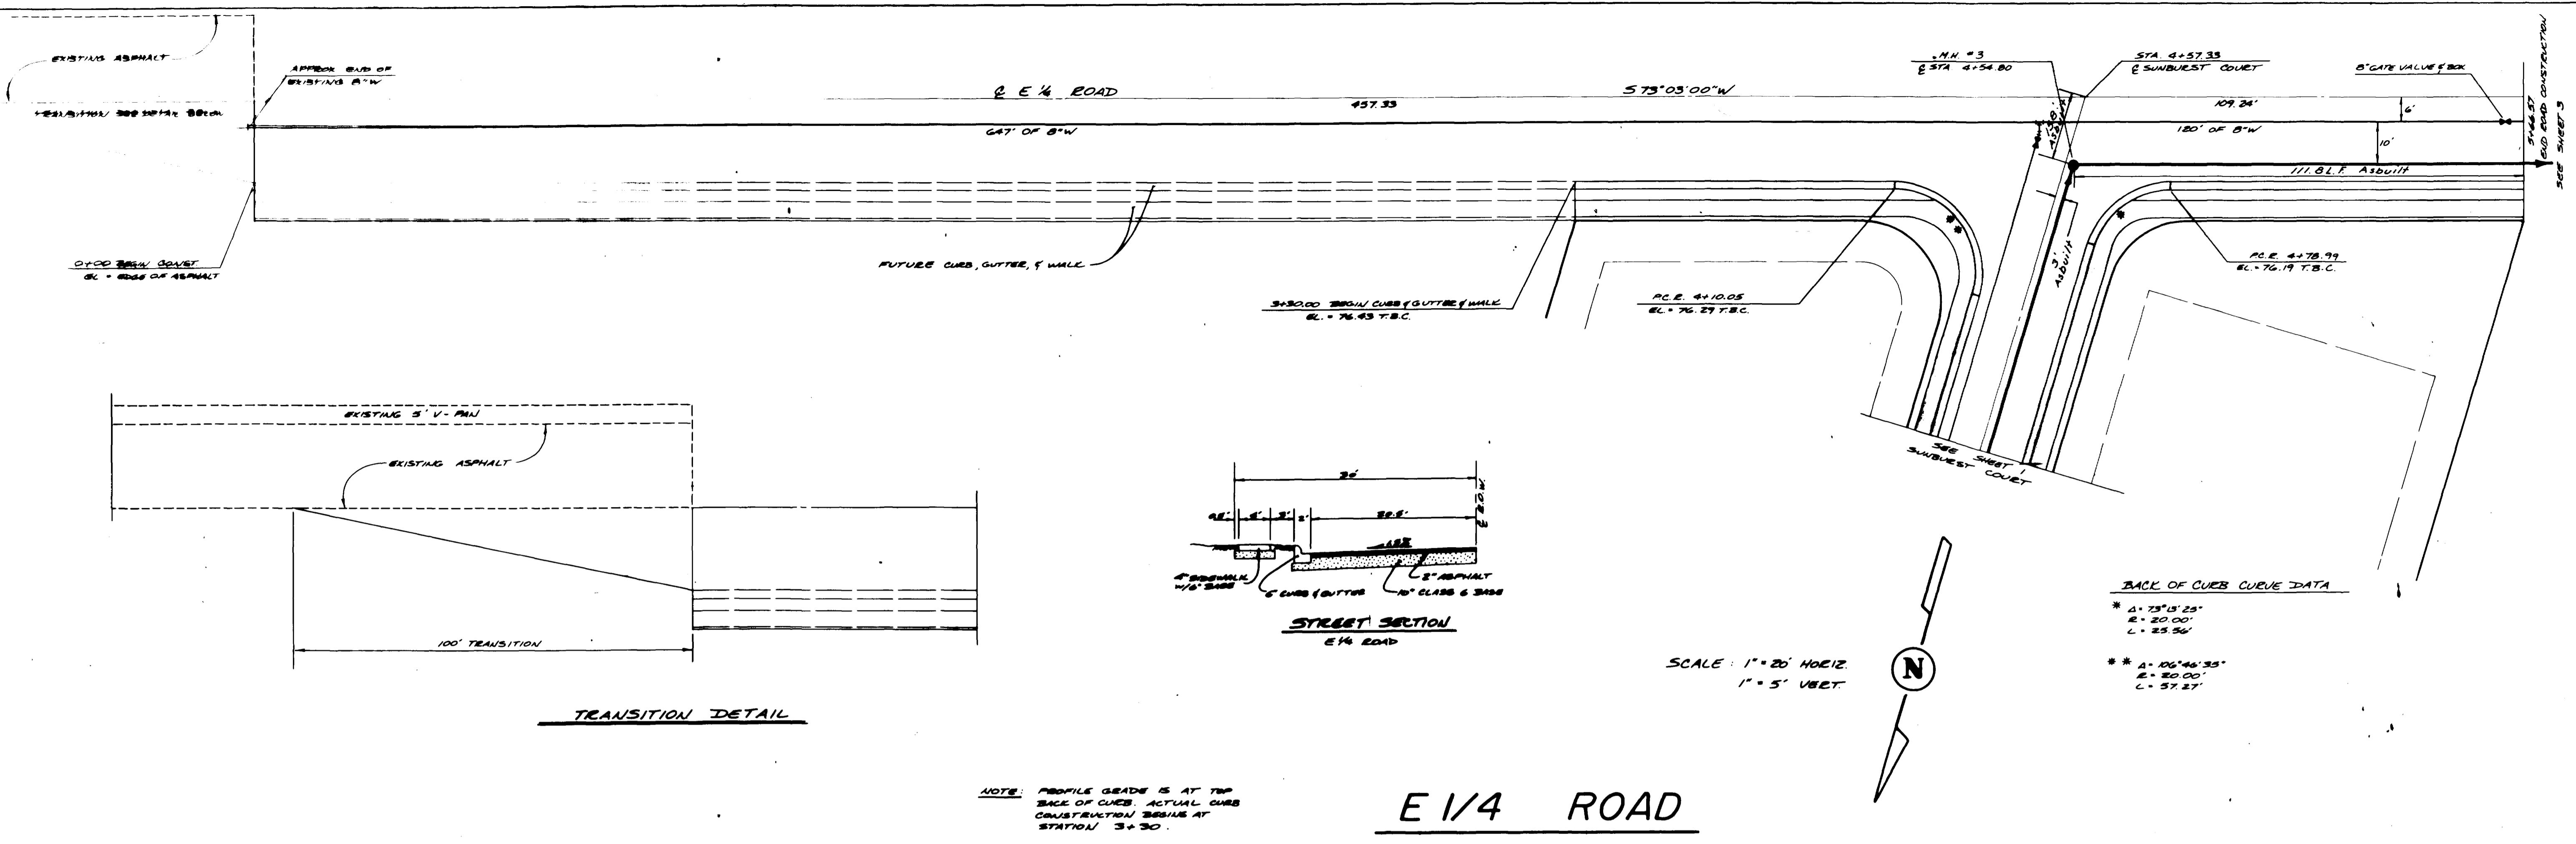


E 1/4 ROAD

NOTE: PROFILE GRADE IS AT TOP
BACK OF CURB. ACTUAL CURB
CONSTRUCTION BEGINS AT
STATION 3+30.


SWIRASBULLS

CWA COLORADO WEST ASSOCIATES INC. Nc ENGINEERING SURVEYING PLANNING 300 245-2787	NO. DATE	REVISION	BY
	<u>SOLAR HORIZONS VILLAGE</u> <u>E 1/4 ROAD</u> STREET, WATER, & SEWER PLAN & PROFILE		

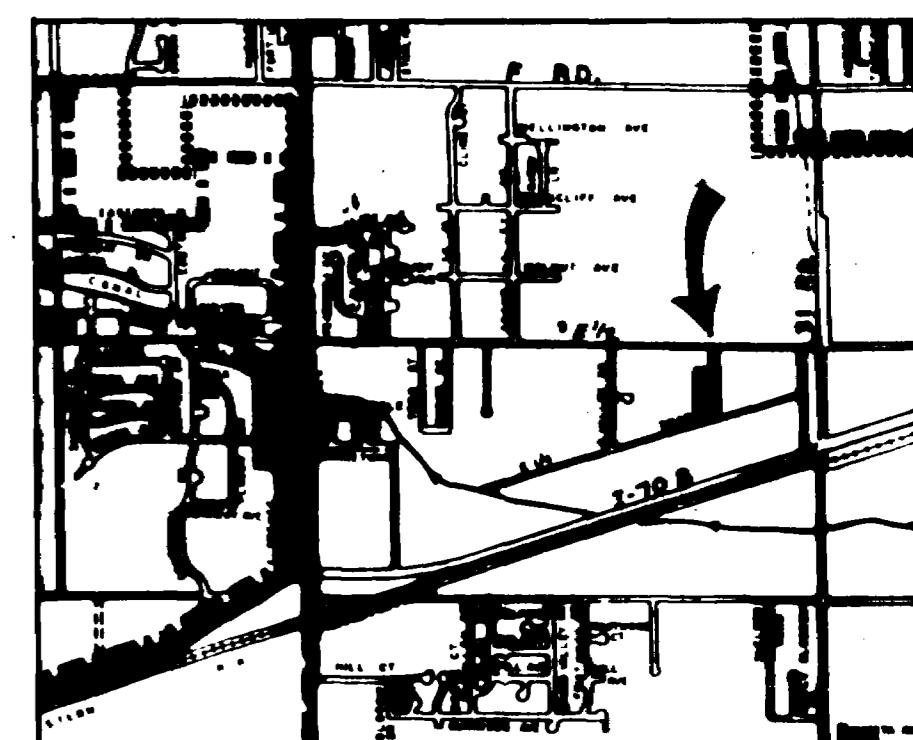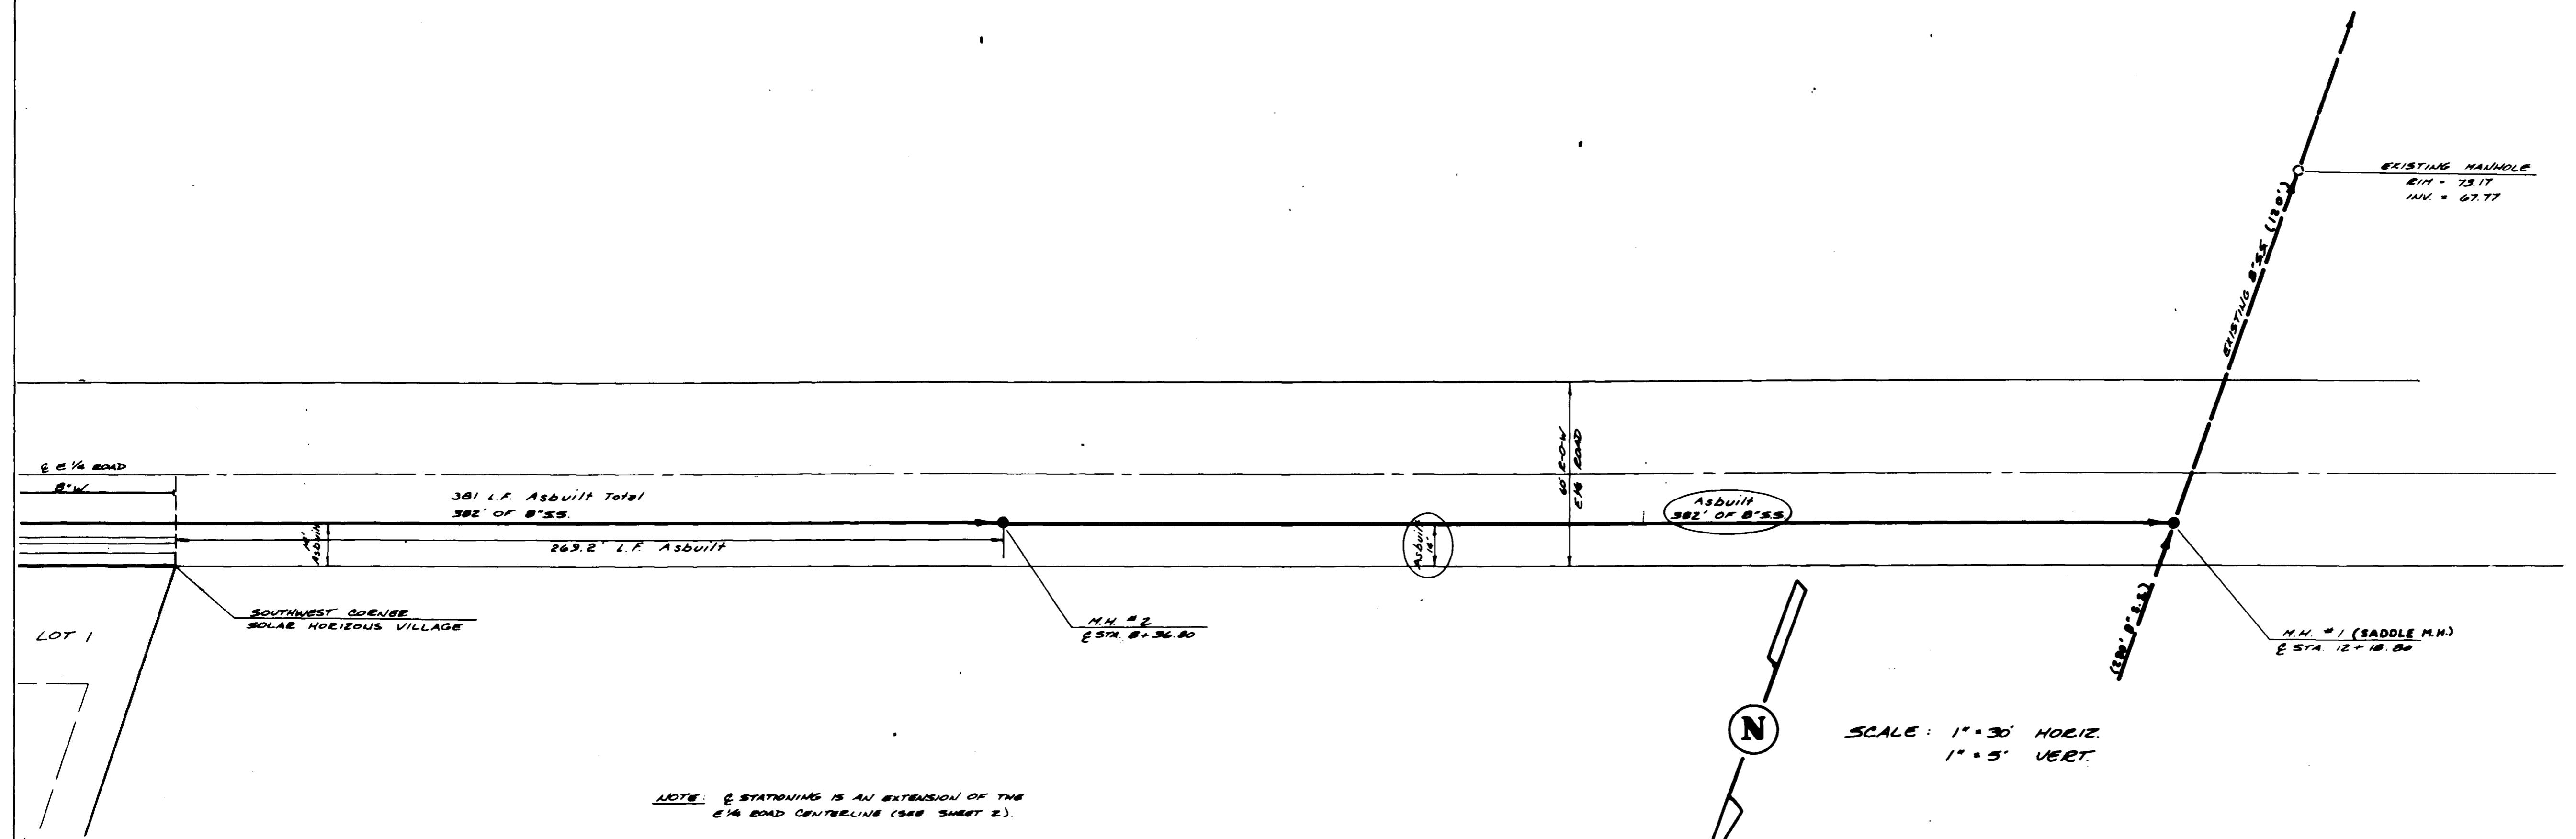

E 1/4 ROAD

NOTE: E STATIONING IS AN EXTENSION OF THE
E 1/4 ROAD CENTERLINE (SEE SHEET 2).

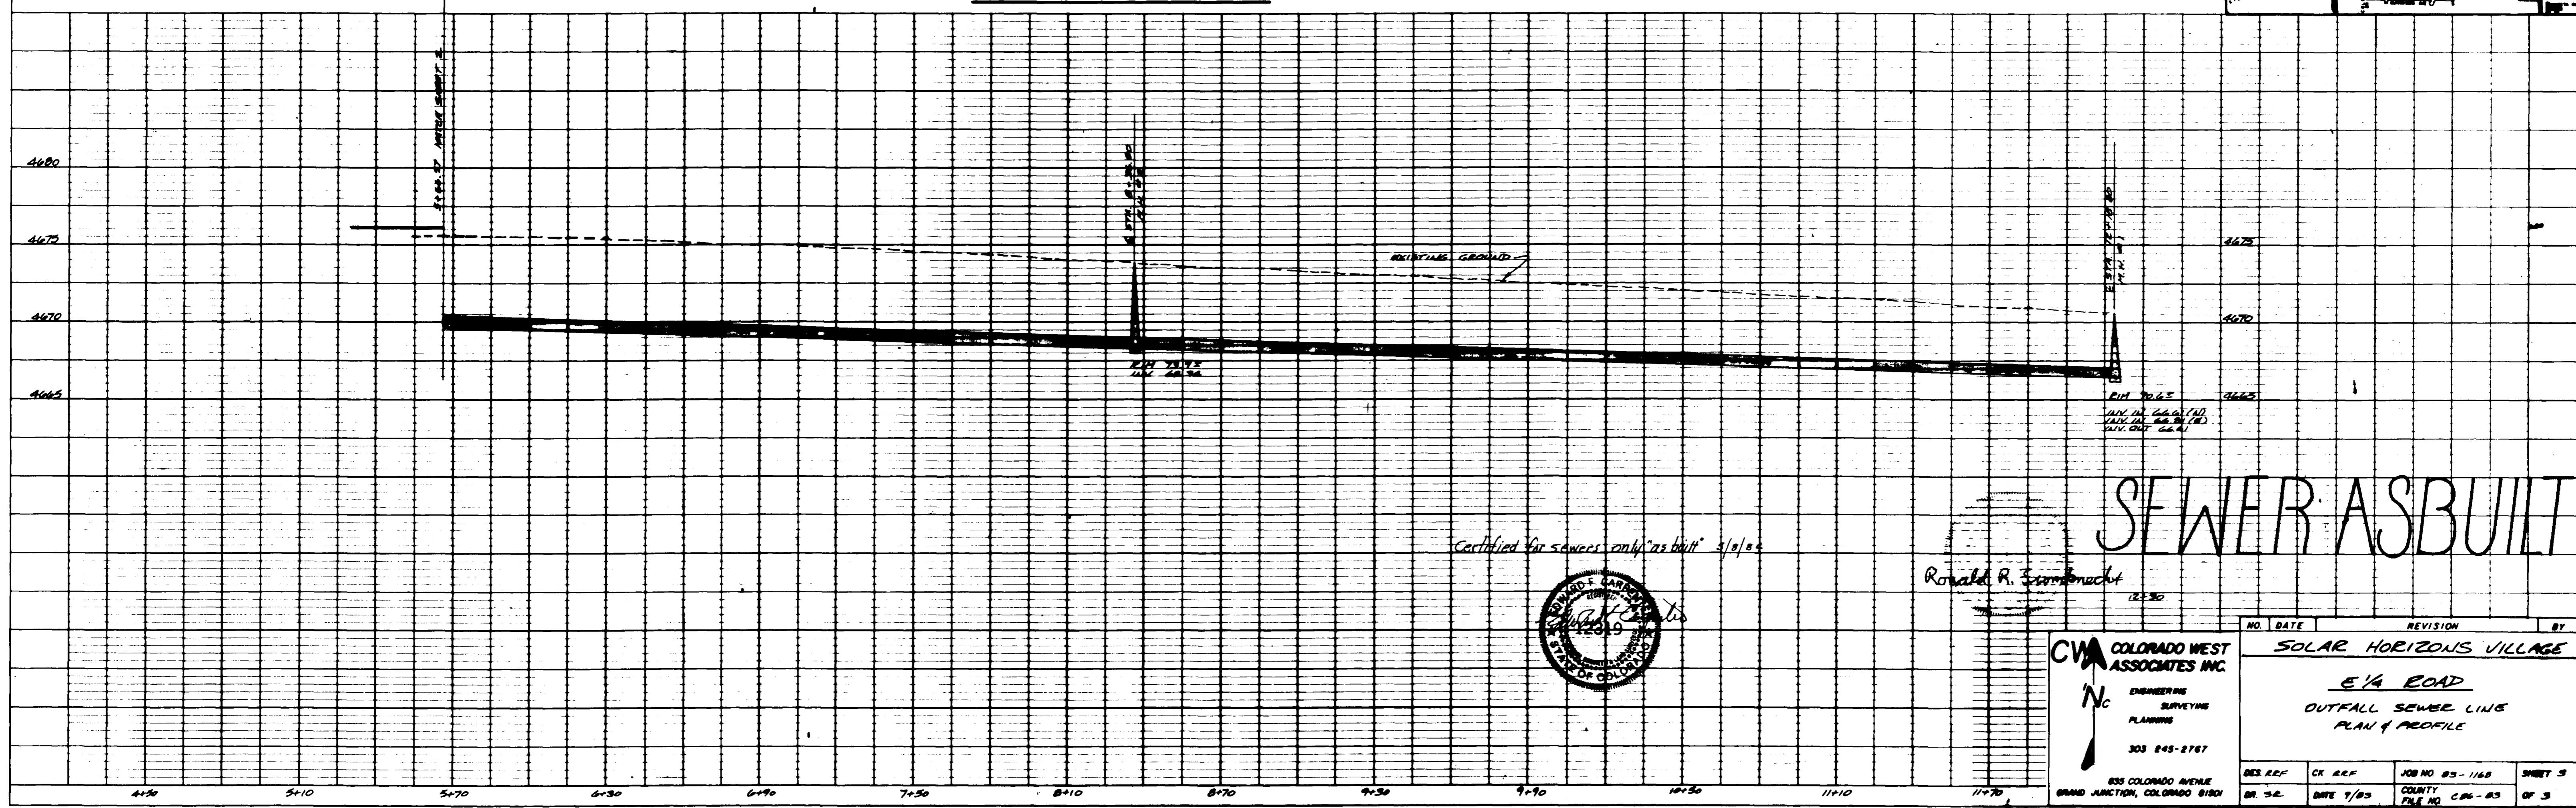

Certified for sewers only "as built" 5/8/

Ronald R. Frommlechner



DATE REVISION BY
SOLAR HORIZONS VILLAGE
E 1/4 ROAD
OUTFALL SEWER LINE
PLAN & PROFILE

CK RRF	JOB NO. 83-1168	SHEET 3
DATE 9/03	COUNTY FILE NO. C06-03	OF 3