





CHERRY PARK PLAZA

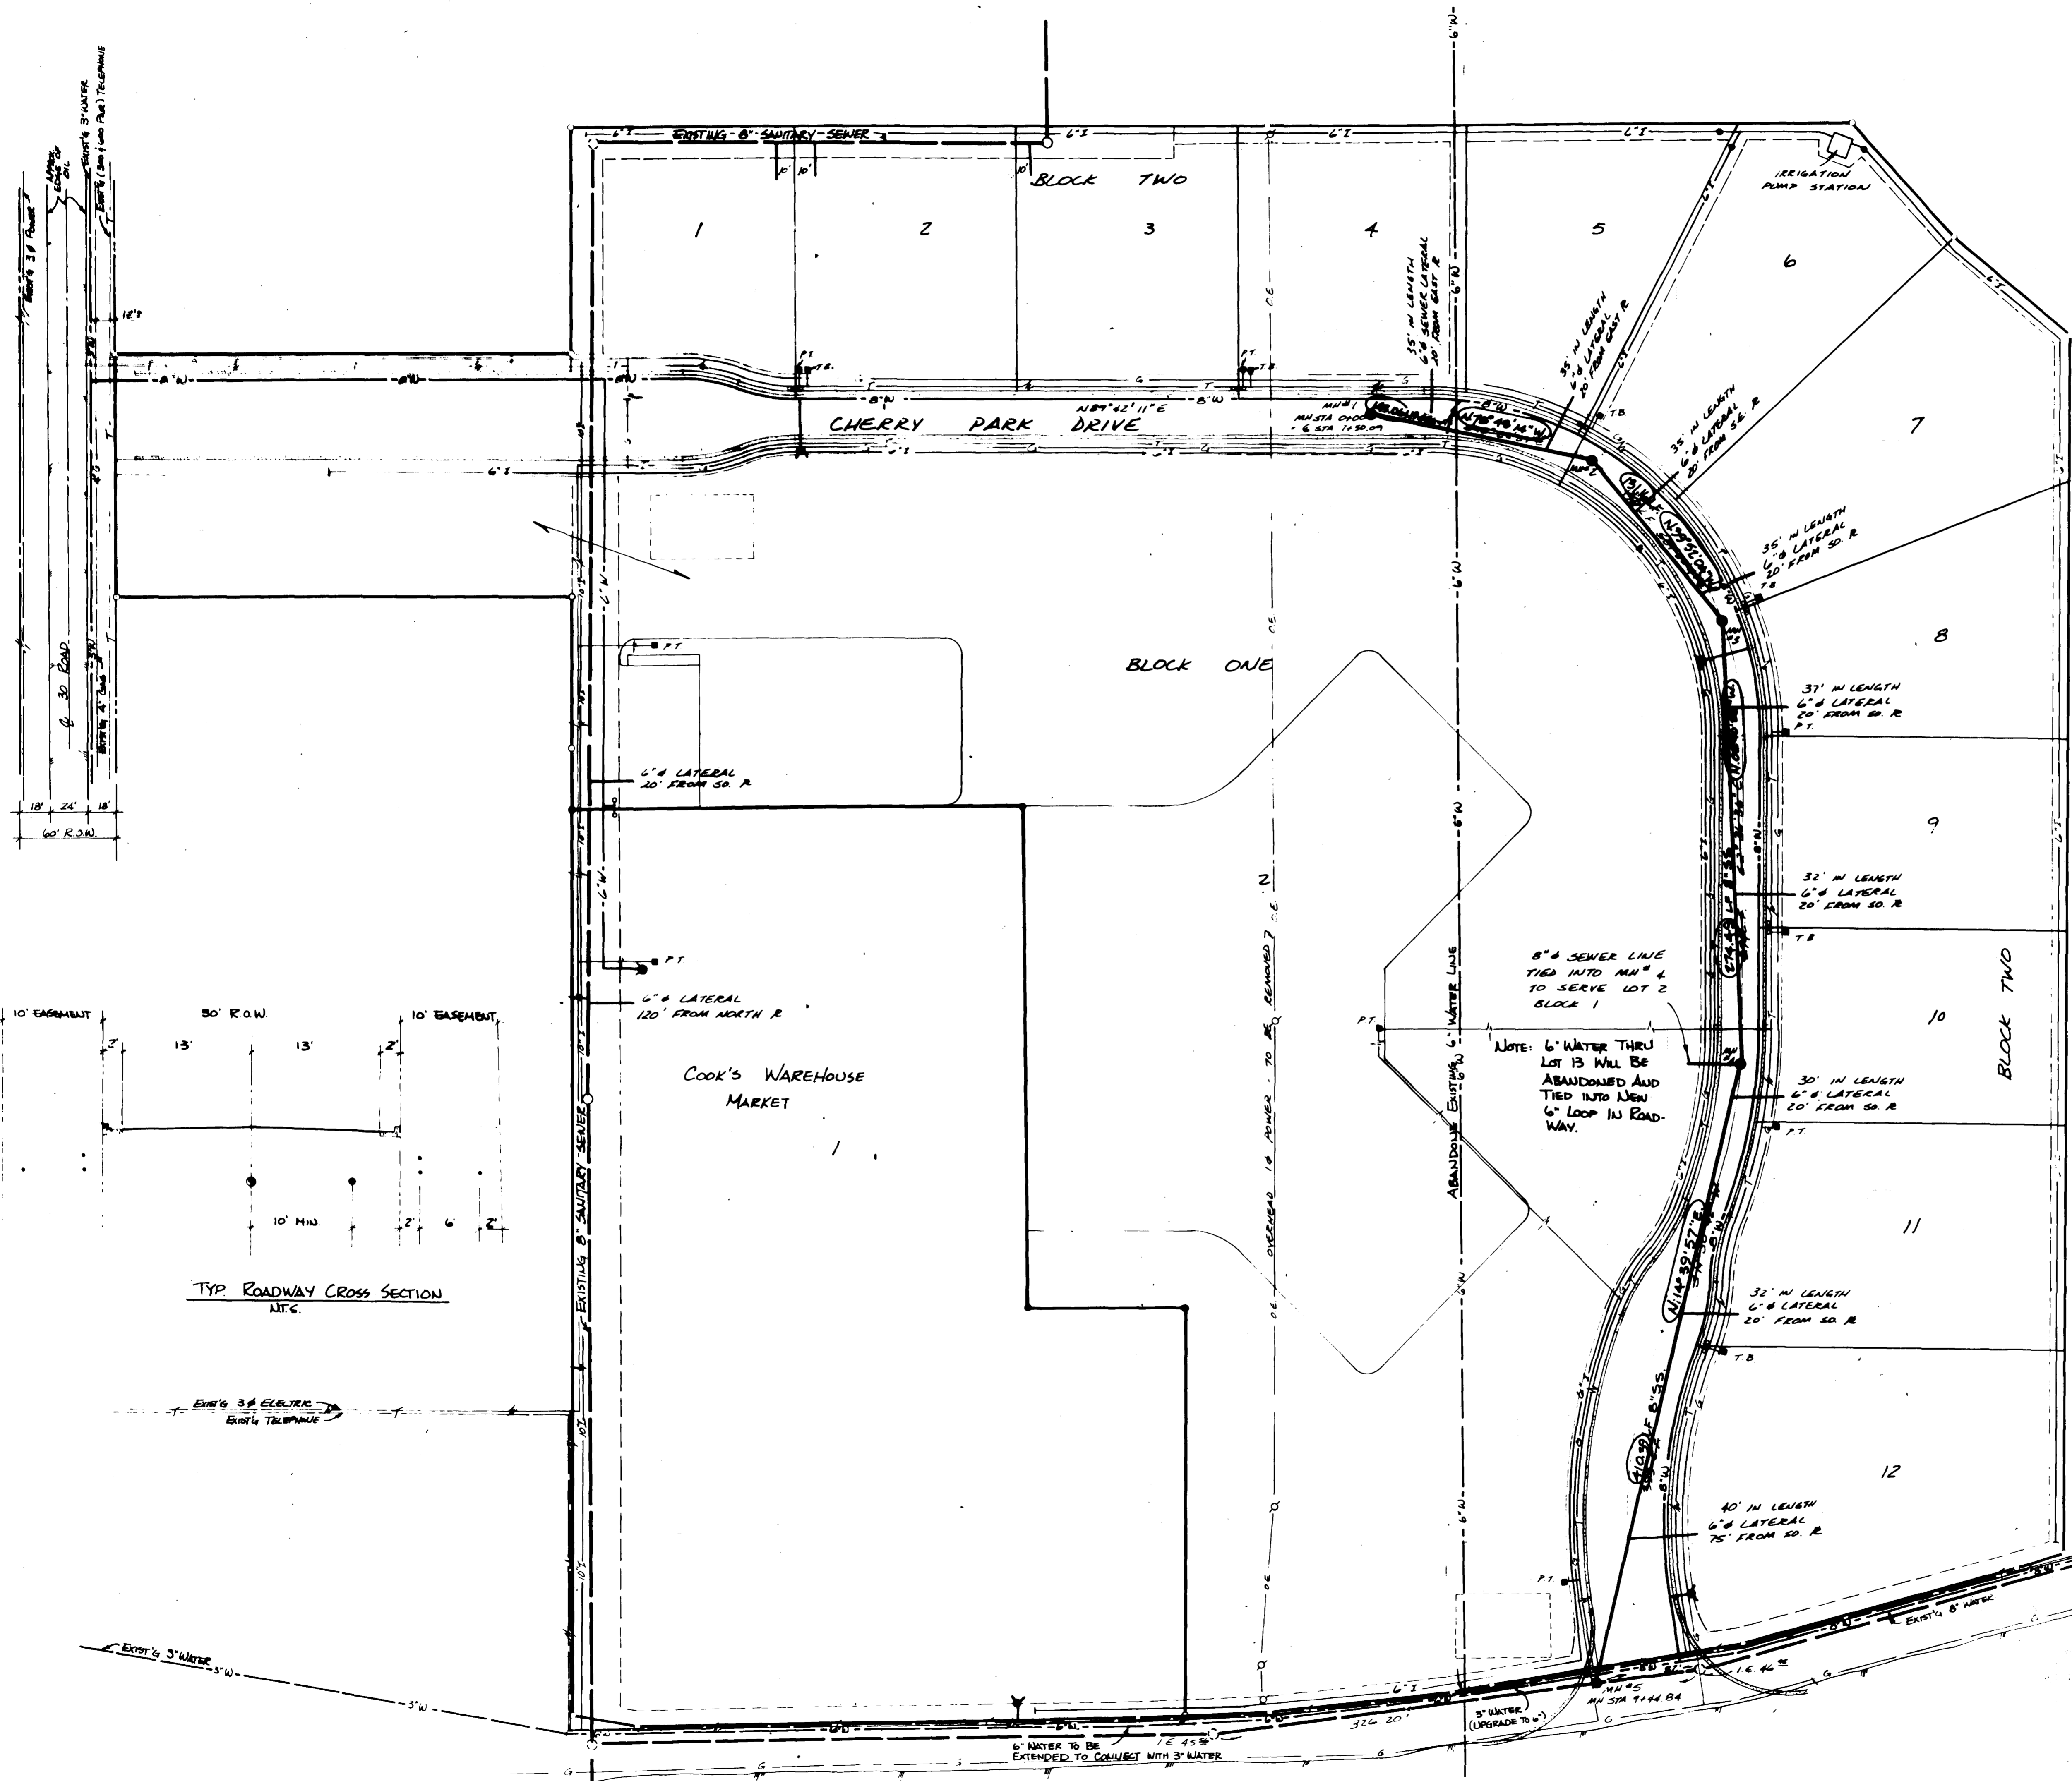


GENERAL NOTES
TIES TO UTILITIES SHOWN ON THIS PLAT ARE APPROXIMATE AND INDICATES PROPOSED LOCATIONS. AFTER ACTUAL PLACEMENT, EACH UTILITY WILL HAVE TO BE CONTACTED FOR LOCATION OF THEIR FACILITIES.
LOT AND EASEMENT GEOMETRICS ARE AS SHOWN ON THE PLAT FOR CHERRY PARK PLAZA.

- LEGEND**
- SANITARY SEWER & MANHOLE
 - WATER: SIZE AS SHOWN & SERVICE
 - FIRE HYDRANT: 6" LINE
 - NATURAL GAS
 - ELECTRIC: POWER TRANSFORMER
 - TELEPHONE & BOX
 - IRRIGATION LINE & SIZE
 - EASEMENT

NOTE: THIS IS TO CERTIFY THAT THE SYSTEM INFILTRATION RATE DOES NOT EXCEED 200 GALLONS PER INCH DIAMETER PER MILE OF LENGTH PER DAY.
○ INDICATES AS BUILT INFORMATION AS OF 6-18-84.

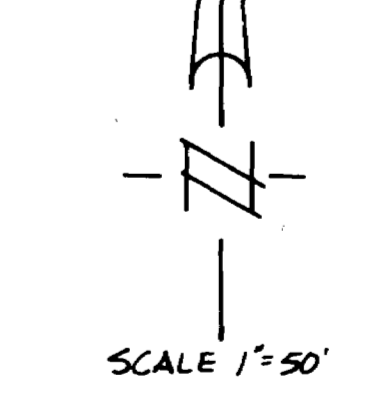

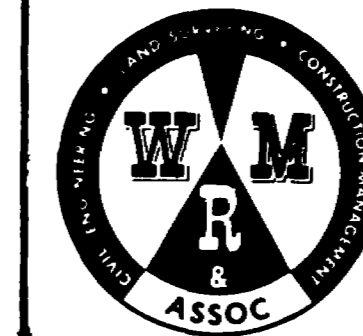

WAYNE M. ROBERTS & ASSOC.

1006 Main St. Grand Junction, CO 81501

Phone (303) 243-1982

CHERRY PARK PLAZA
SANITARY SEWER - AS BUILTS
SHEET 2 OF 2

NOTE: THIS IS TO CERTIFY THAT
THE SYSTEM INFILTRATION RATE
DOES NOT EXCEED 200 GALLONS
PER INCH DIAMETER PER MILE OF
LENGTH PER DAY.

