





SCALE: 1"=40'

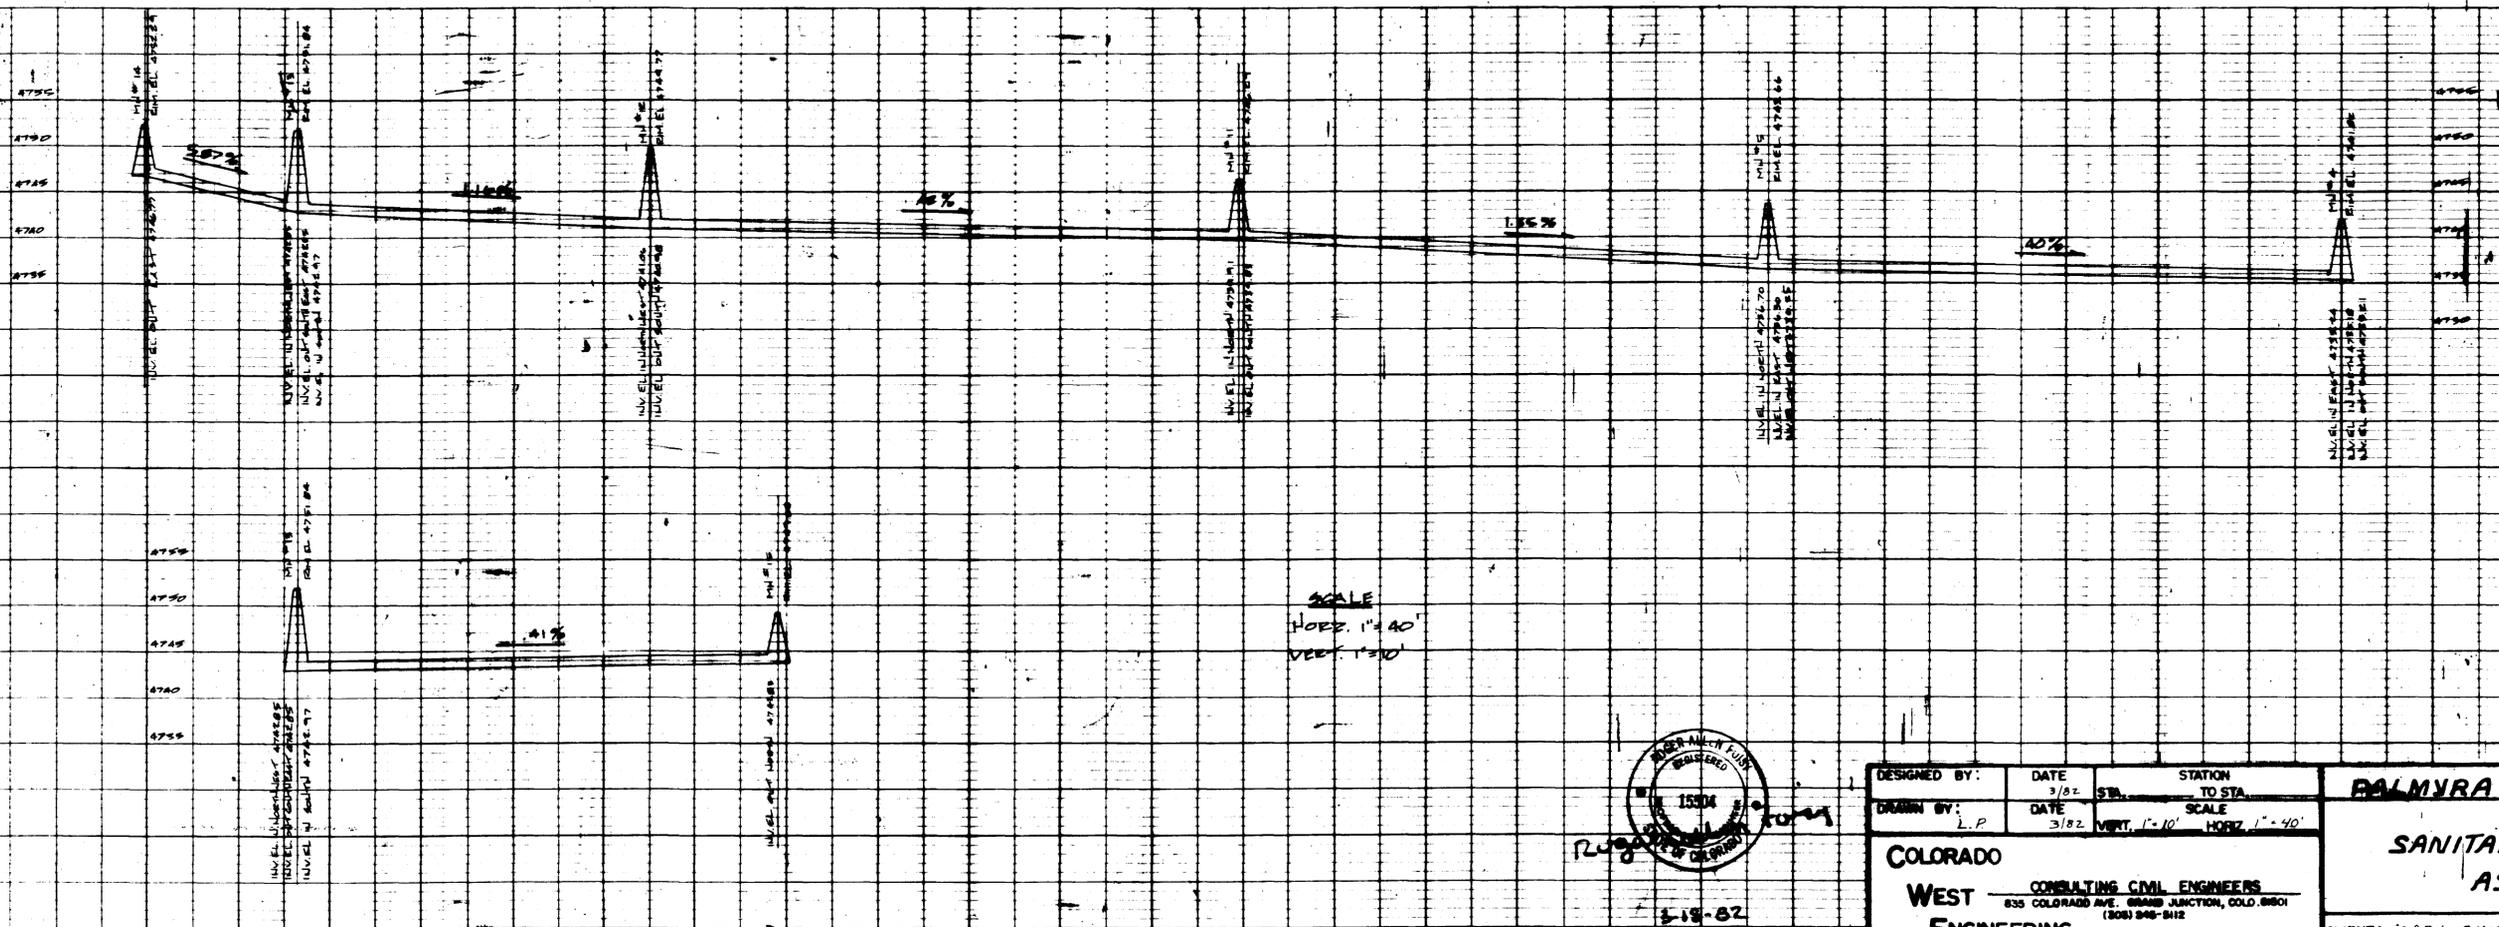

DESIGNED BY:	DATE:	STATION:	TO STA:	<b>BALMYRA SUBDIVISION</b>
DRAWN BY:	DATE:	SCALE:	SCALE:	
L.P.		3/82	VERT. 1"=10'	HORIZ. 1"=40'
<b>COLORADO WEST ENGINEERING</b>				<b>SANITARY SEWER AS-BUILT</b>
CONSULTING CIVIL ENGINEERS 635 COLORADO AVE. GRAND JUNCTION, COLO. 81501 (970) 248-8112				CLIENT: GARY RINDERLE
				JOB NO. 130-1-152

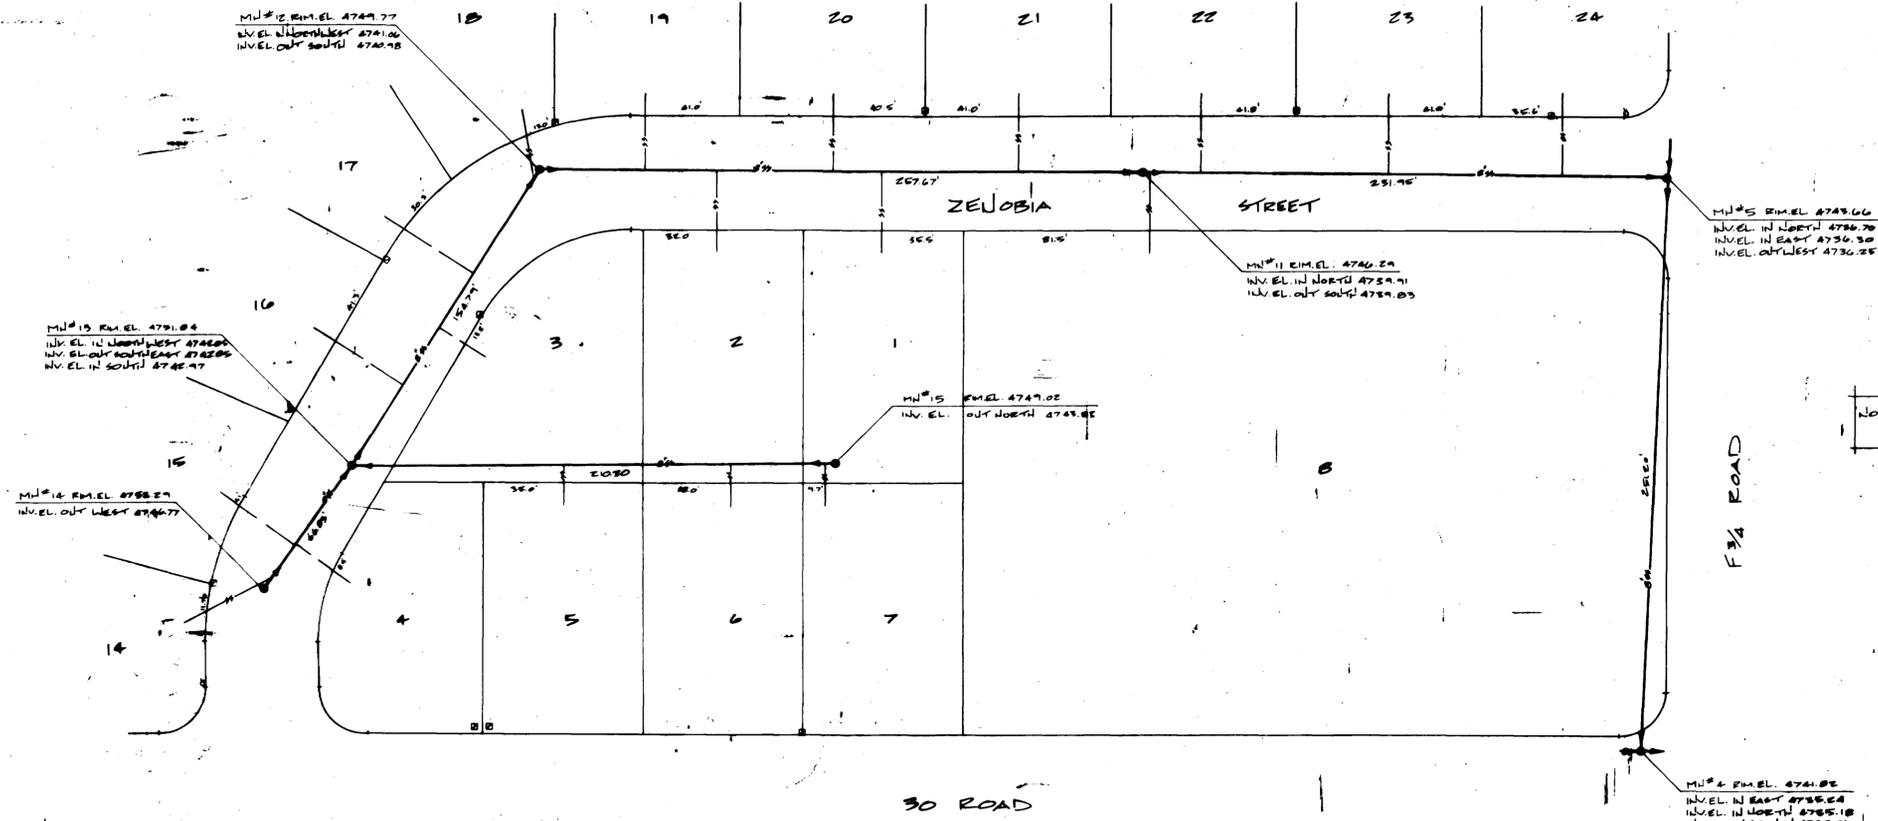