

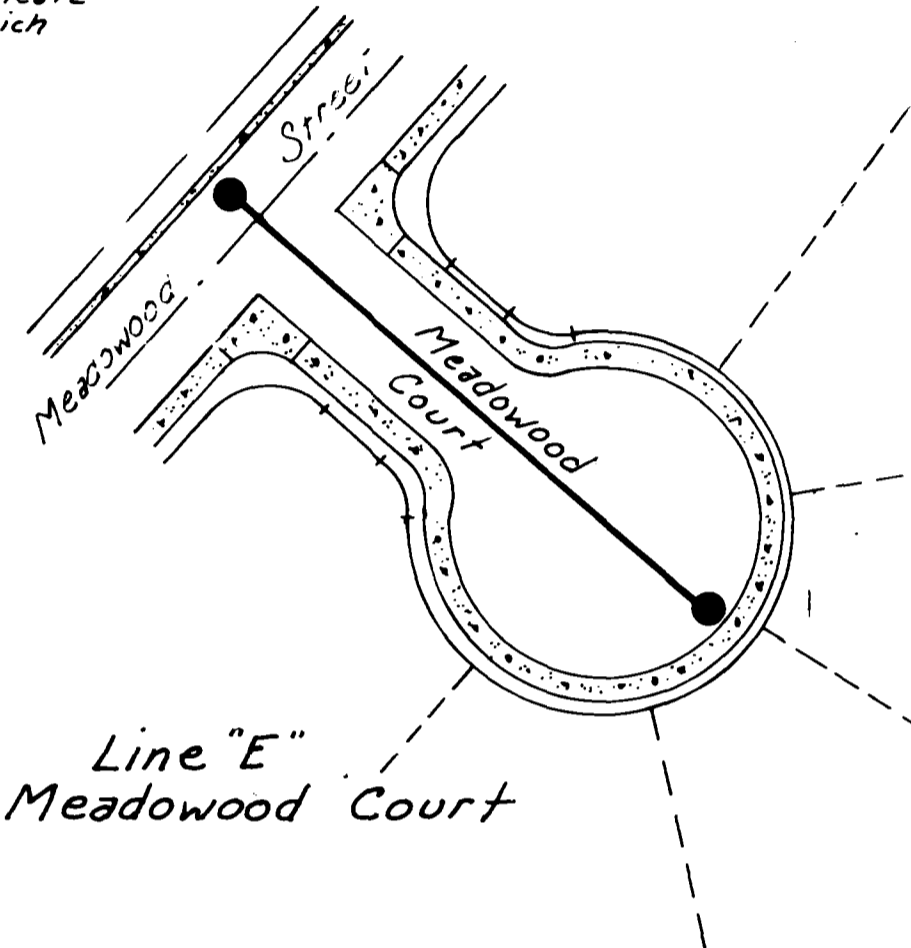


These "As-Built" Plans Refer Only To The 6" & 8" Water Lines & 8" Sewer Line. Locations Shown For The 24" Domestic Water Line Are Approximate. Dashed Lines Indicate Utilities Constructed Previously Which Are Not Part Of These "As-Built's".

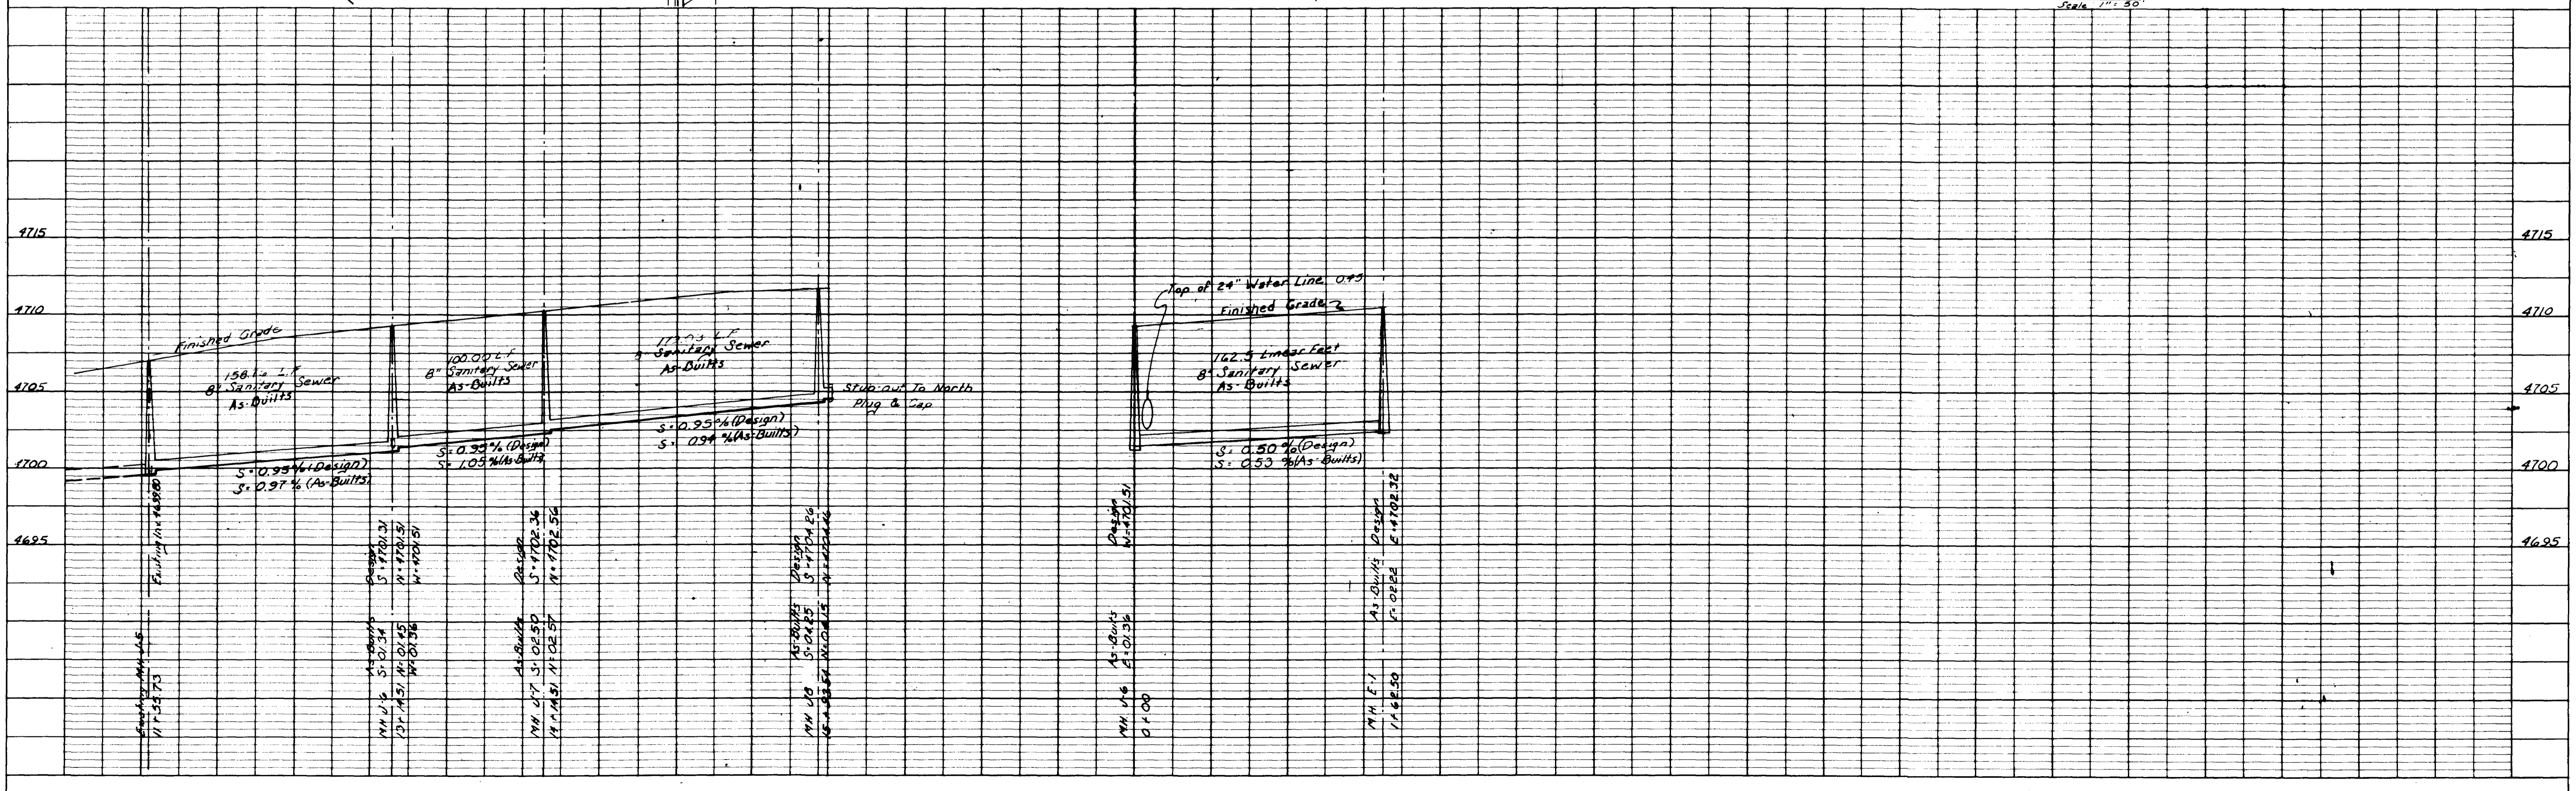

This Is To Certify That Infiltration On The Date Of Test (11/1/83) Did Not Exceed 200 Gal Per Day Per Inch Of Diameter Of Pipe Per Mile Of Sewer Line.

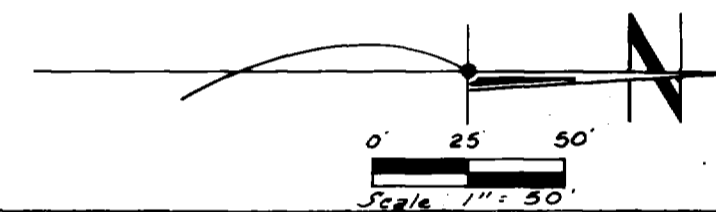

Bell Engineering Company
500 Kalamath Street - Denver Colorado 80204 (303) 629-0165

Job No. _____
Scale 1" = 50'
Revision No. _____
Sheet No. 1

ASPENWOOD SUBDIVISION
SEWER & WATER "AS-BUILTS"

Drawn by _____
Designed by _____
Checked by _____
Date NOV 4, 1983