
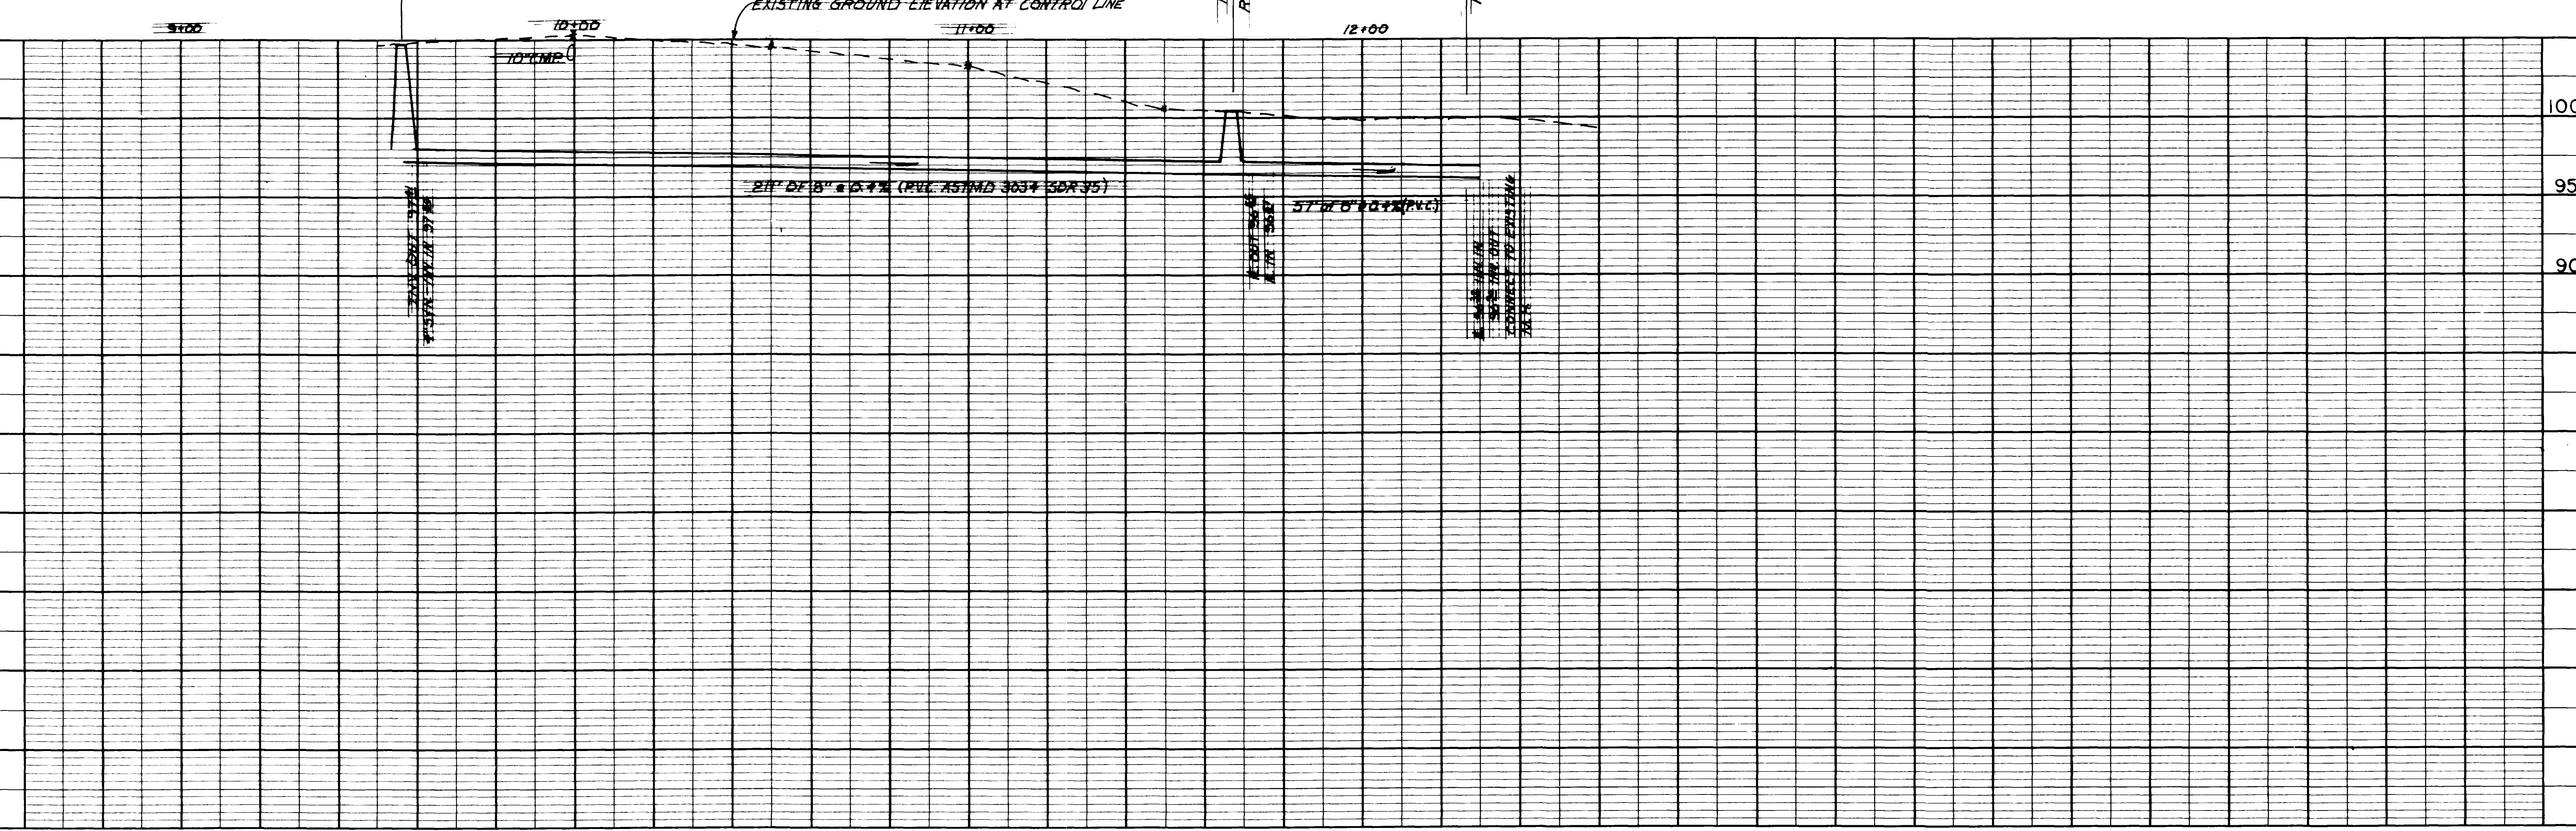
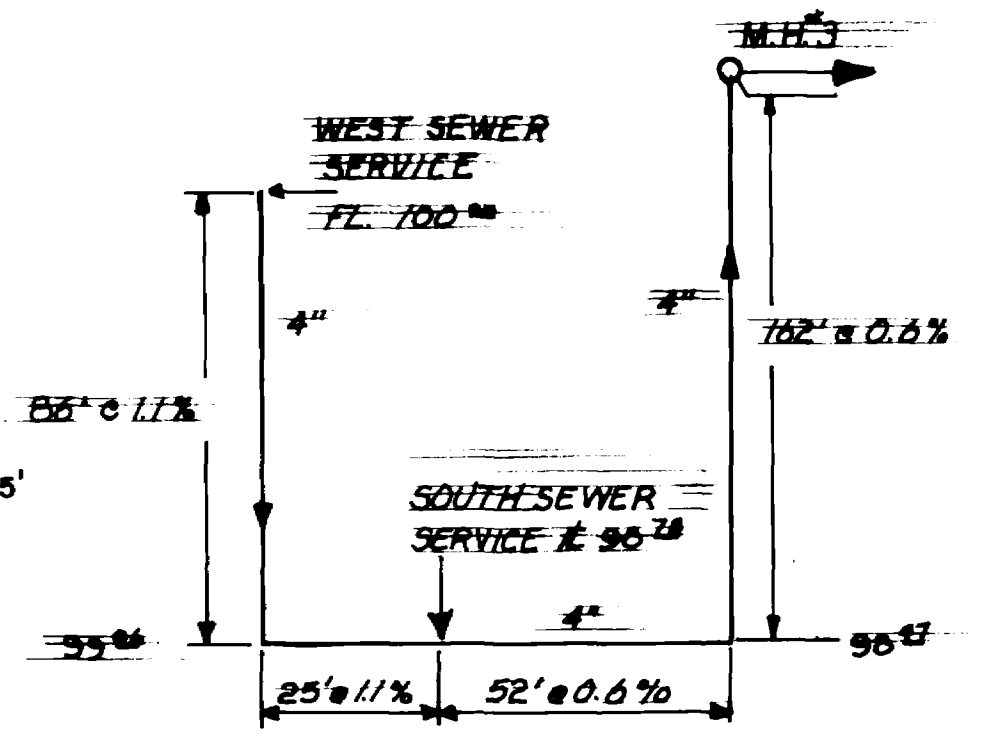


BENCH MARK
 S.W. 6 WESTERLY GATE POST
 HOUSE NO. 674 26 1/2 ROAD
 ELEV. 1027.9

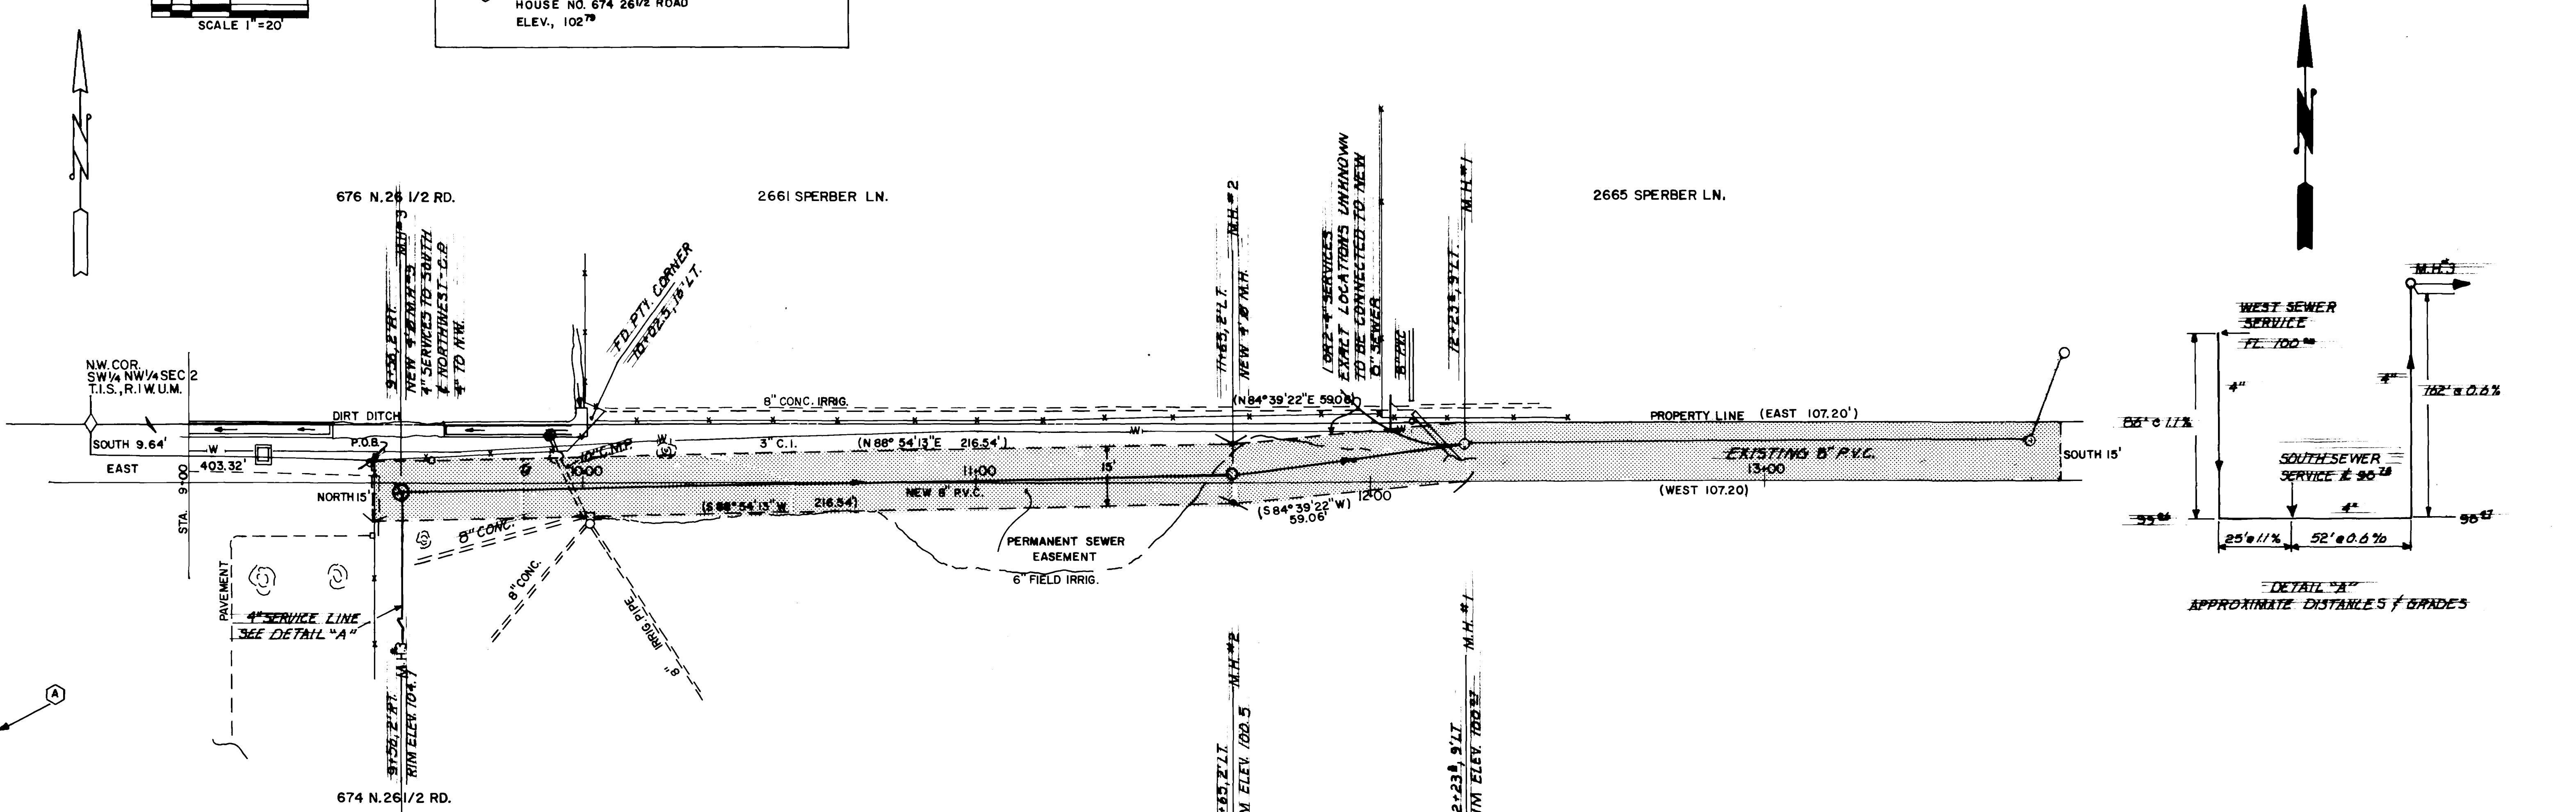

DESCRIPTION	DATE	DRAWN BY STEVE PHILLIPS	DATE 10/88
REVISION Δ		CHECKED BY	DATE
REVISION Δ		APPROVED BY	DATE
REVISION Δ		FIELD BOOK NO.	PAGE

DEPARTMENT OF PUBLIC WORKS AND UTILITIES
ENGINEERING DIVISION
CITY OF GRAND JUNCTION, COLORADO

JAROS SEWER EXTENTION - 1988
 902-37001-501562-880032

SHEET NO. _____
 OF _____
 FILE NO. _____