


Note: Improvements constructed in accordance with City Standards. Drawings ST-1 & ST-2.

PLAN
Scale: 1" = 50'

AS-BUILT CONTRACTOR: STAN McFARLAND INSTALLED: 6/78	WESTERN ENGINEERS, INC. McFARLAND ESTATES FIRST ADDITION SEWER <small>CITY OF GRAND JUNCTION, MESA COUNTY, COLORADO</small> <small>ENGINEERED T.K.H. DRAWN M.J.G. CHECKED</small> <small>DATE: 9/8/78 GRAND JUNCTION, COLORADO DRAWING 7505-305-04</small>
---	--

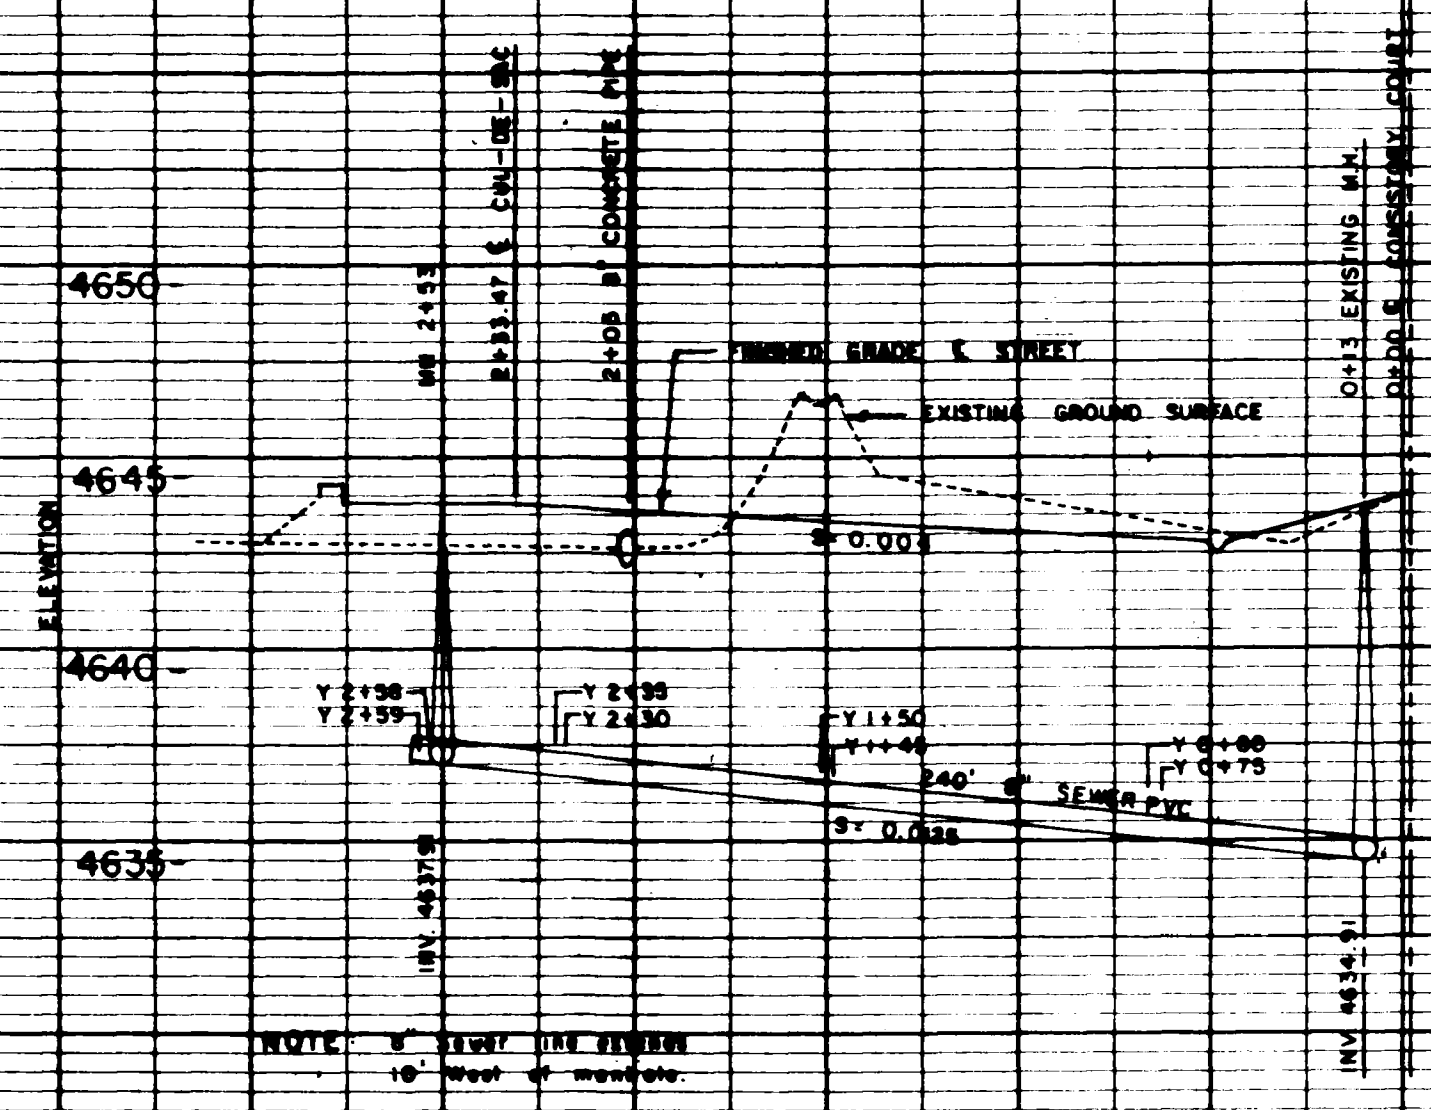

NOTE: 8" SEWER LINE RUNS 10' WEST OF MANHOLE.

PROFILE
SCALE: HORIZONTAL = 1" = 50'
VERTICAL = 1" = 5'