



"AS BUILT"
12-10-92

SANITARY SEWER MAIN AND PROFILE BROOKWOOD SUBDIVISION BRET DRIVE (FORMERLY LA PORTE AVENUE) GRAND JUNCTION, COLORADO	
W. H. LIZER & ASSOCIATES ENGINEERING & SURVEYING 576 25 ROAD UNIT 8 241-1129 GRAND JUNCTION, COLORADO 81505	

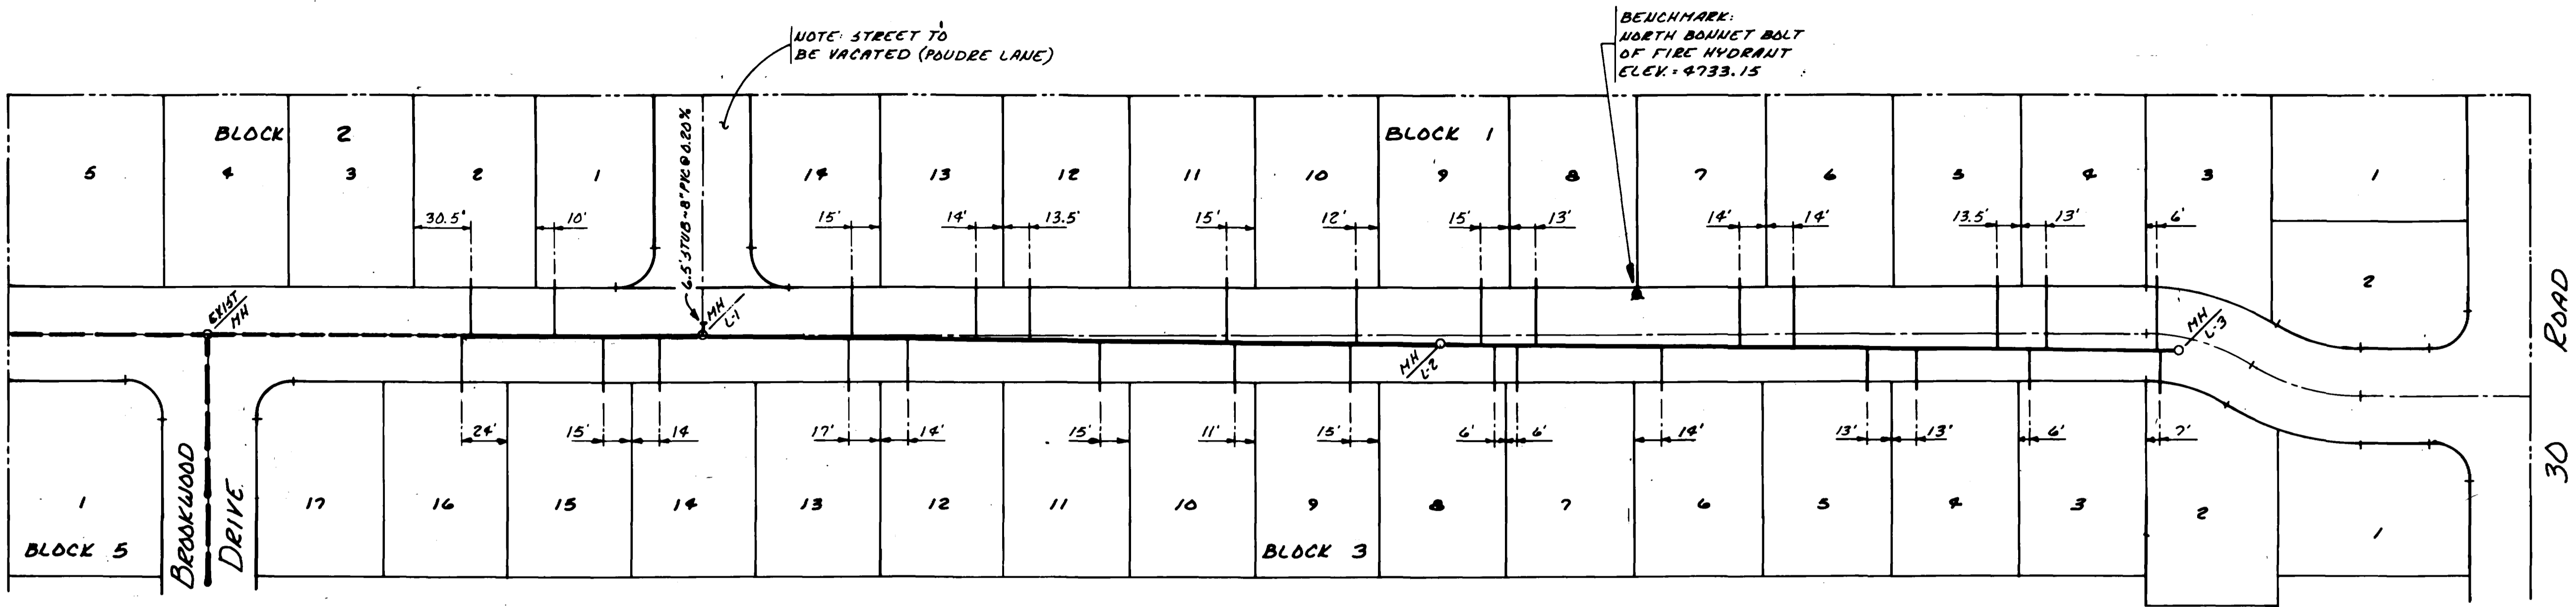


NOTE: ALL SERVICES STUB 5' INSIDE PROPERTY LINE

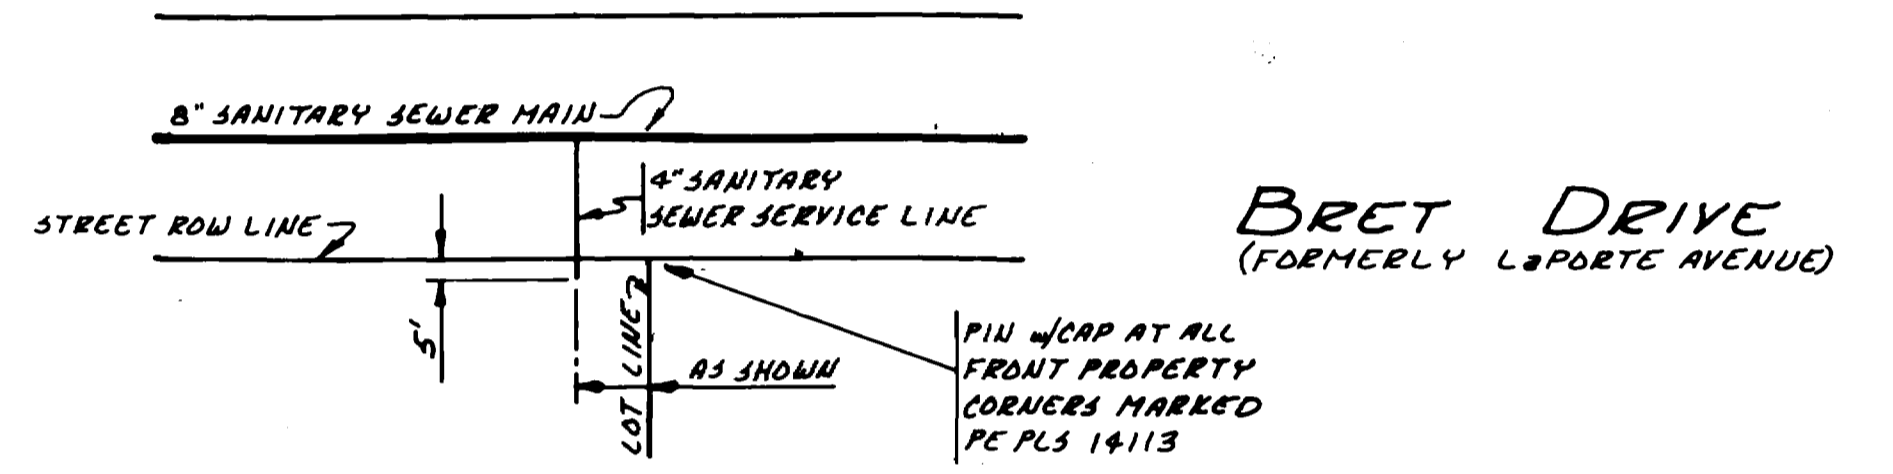

DETAIL
TYPICAL SERVICE LINE STUB TO LOT
NOT TO SCALE

W.H. Lizer
12/10/92

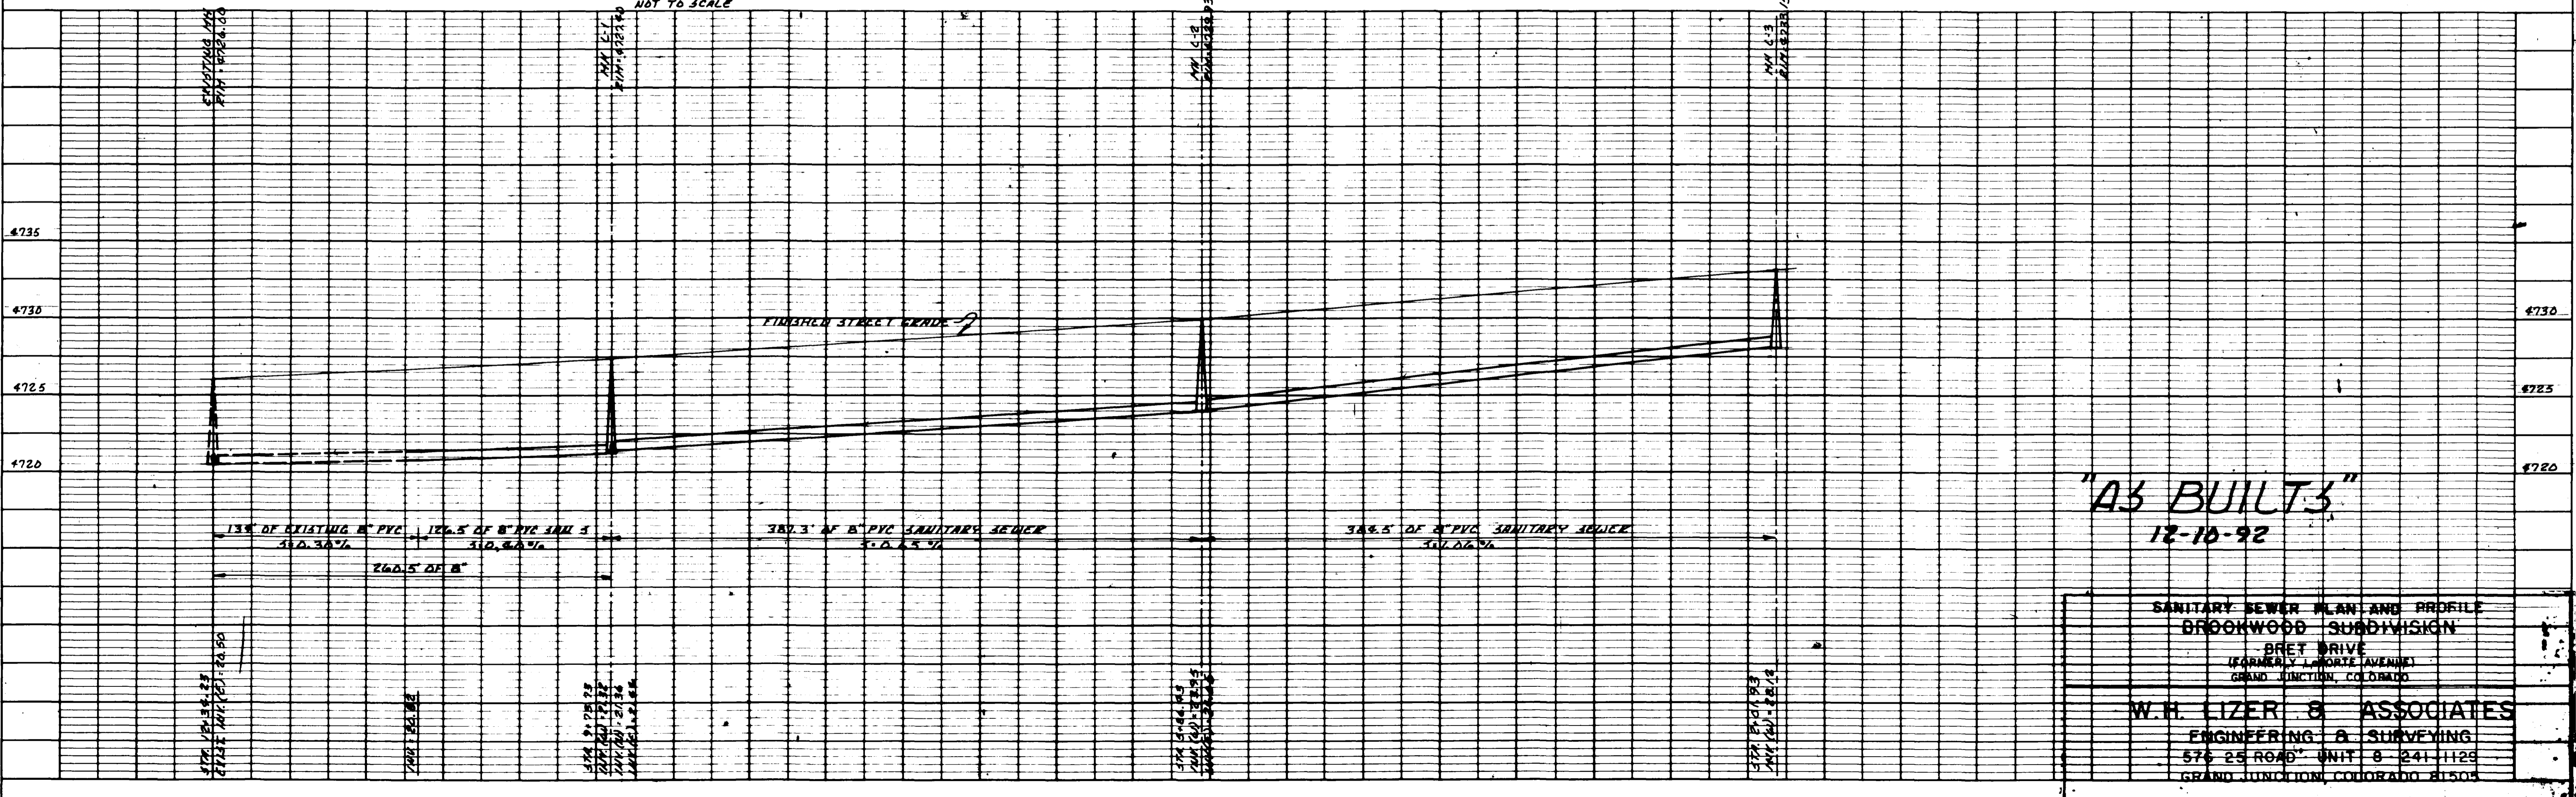

"AS BUILT"
12-10-92

SANITARY SEWER PLAN AND PROFILE	
BROOKWOOD SUBDIVISION	
BRET DRIVE (FORMERLY L'PORTE AVENUE) GRAND JUNCTION, COLORADO	
W.H. LIZER & ASSOCIATES	
ENGINEERING & SURVEYING	
576 25 ROAD UNIT 8 241-1129	
GRAND JUNCTION, COLORADO 81505	