


400' 200' 0' 400'
SCALE: 1" = 400'

LEGEND

- Manhole and Line
- Central Grand Valley Outfall
- Lamphole
- Slub
- - - Fruitvale San Dist. Boundary
- ||||| Buried Tile
- - - By-passed Line

See Plan Sheet
No. 2 to 5 Incl. for
Outfall Line, M.H.s
101 to 119 Incl.

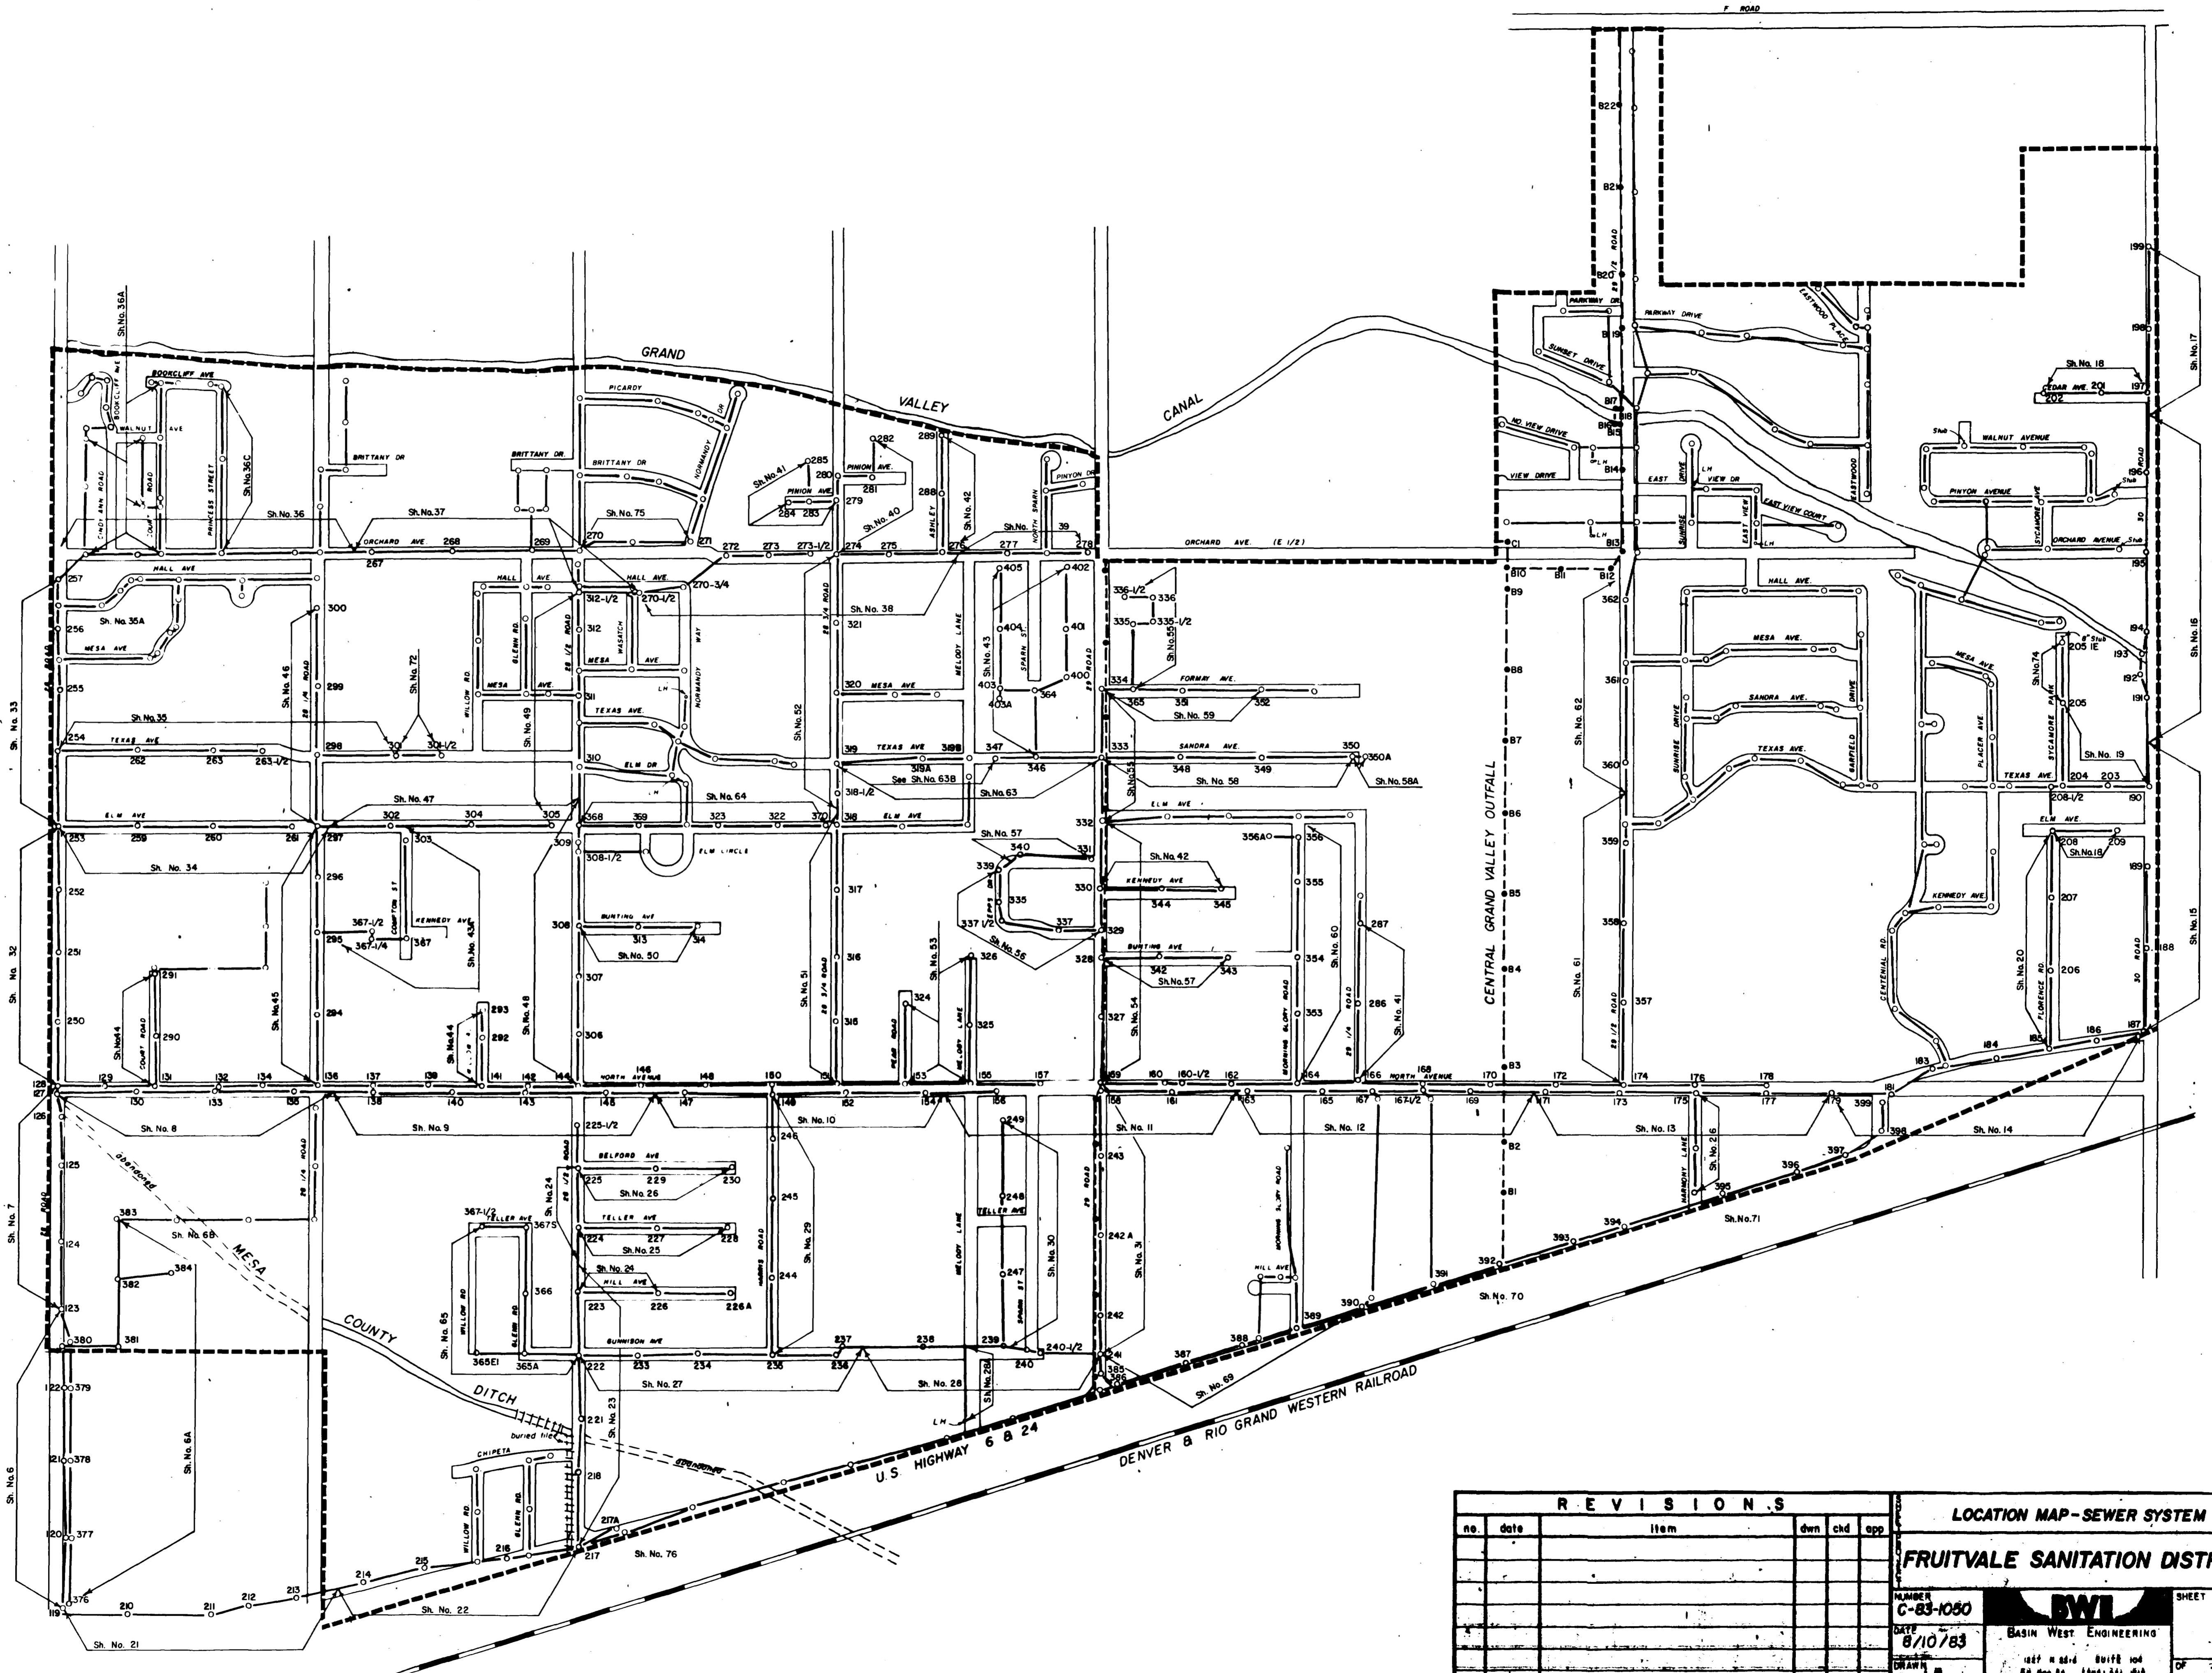

REVISIONS					
no.	date	item	dwg	chd	app

LOCATION MAP - SEWER SYSTEM

FRUITVALE SANITATION DISTRICT


NUMBER
C-83-1080

DATE
8/10/83


DRAWN
J.B.

SHEET
1

BWL
BASIN WEST ENGINEERING
1427 N. 44th Street, Suite 104
PO Box 88, Littleton, CO 80120

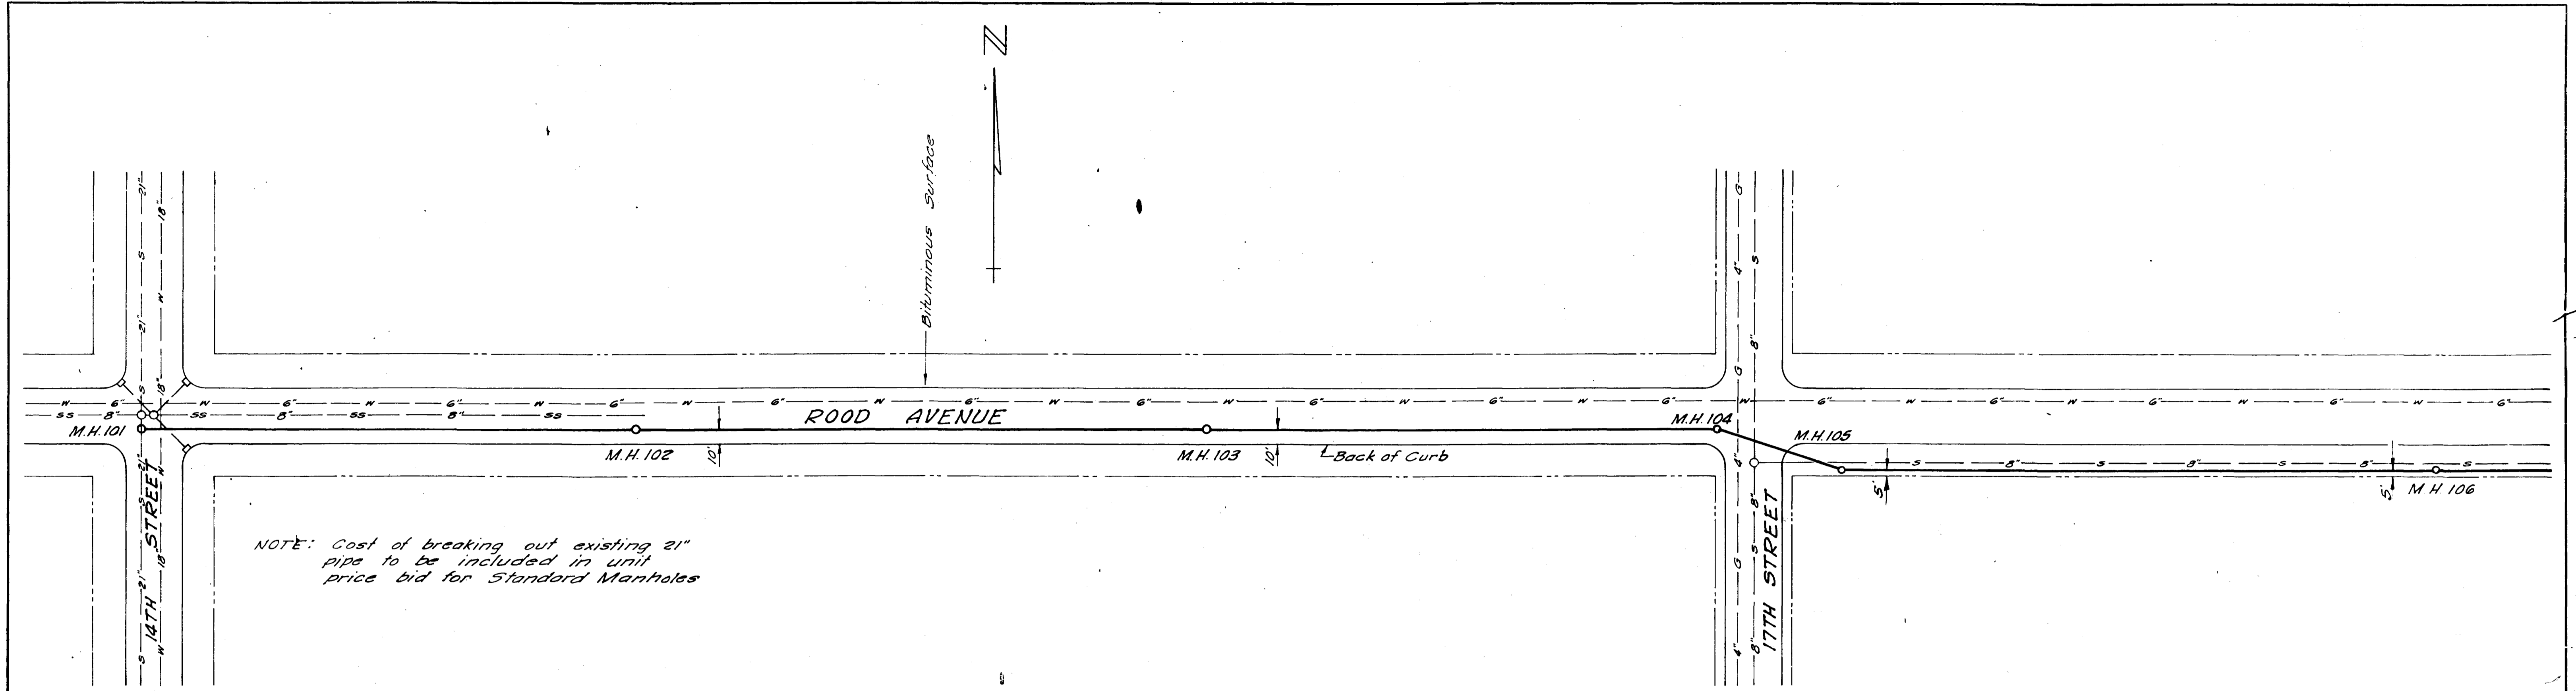

NOTE: Cost of breaking out existing 21" pipe to be included in unit price bid for Standard Manholes

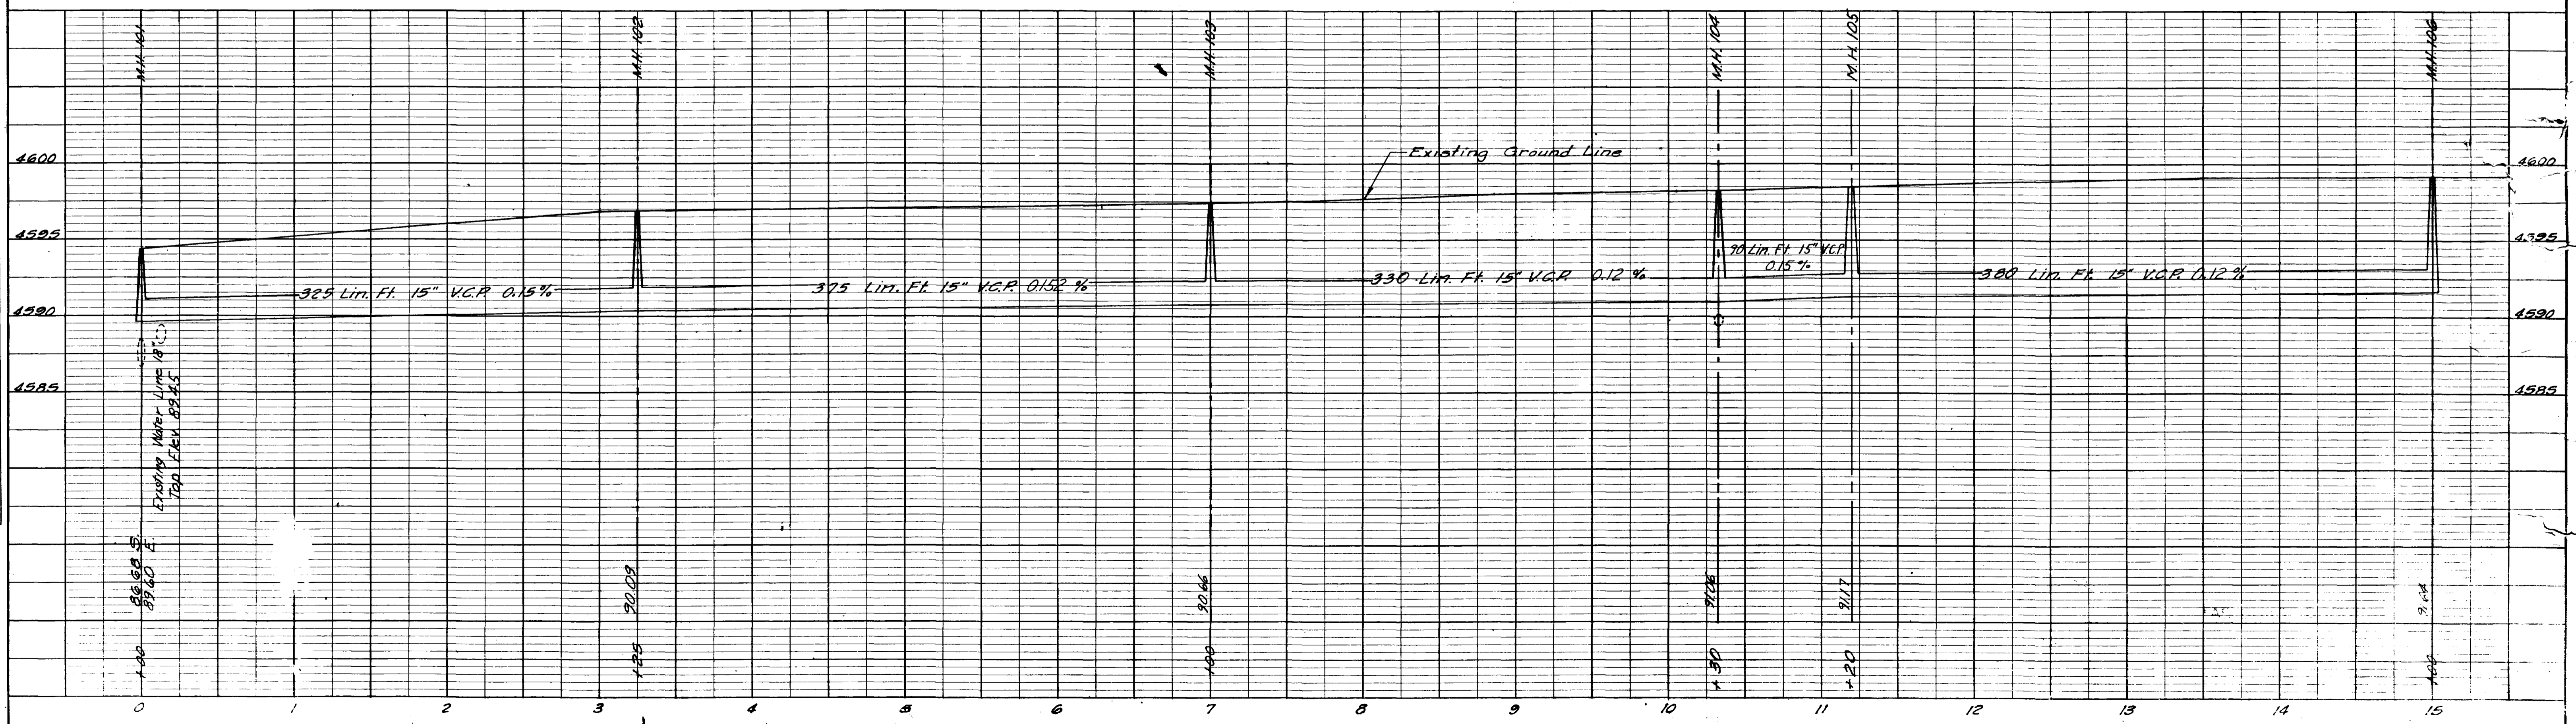



REVISIONS
 2/6 1960 DESCR Grades and Alignment

DATE October 1957
 SCALE 1"=50'
 DRAWN R.C.T.
 CHECKED R.C.T.
 APPROVED [Signature]



HAROLD HOSKINS & ASSOCIATES
 ENGINEERING CONSULTANTS
 GREELEY, COLORADO LINCOLN, NEBRASKA

FRUITVALE, COLORADO
 WATER & SANITATION DISTRICT

OUTFALL LINE - STA. 0+00 TO STA. 15+00

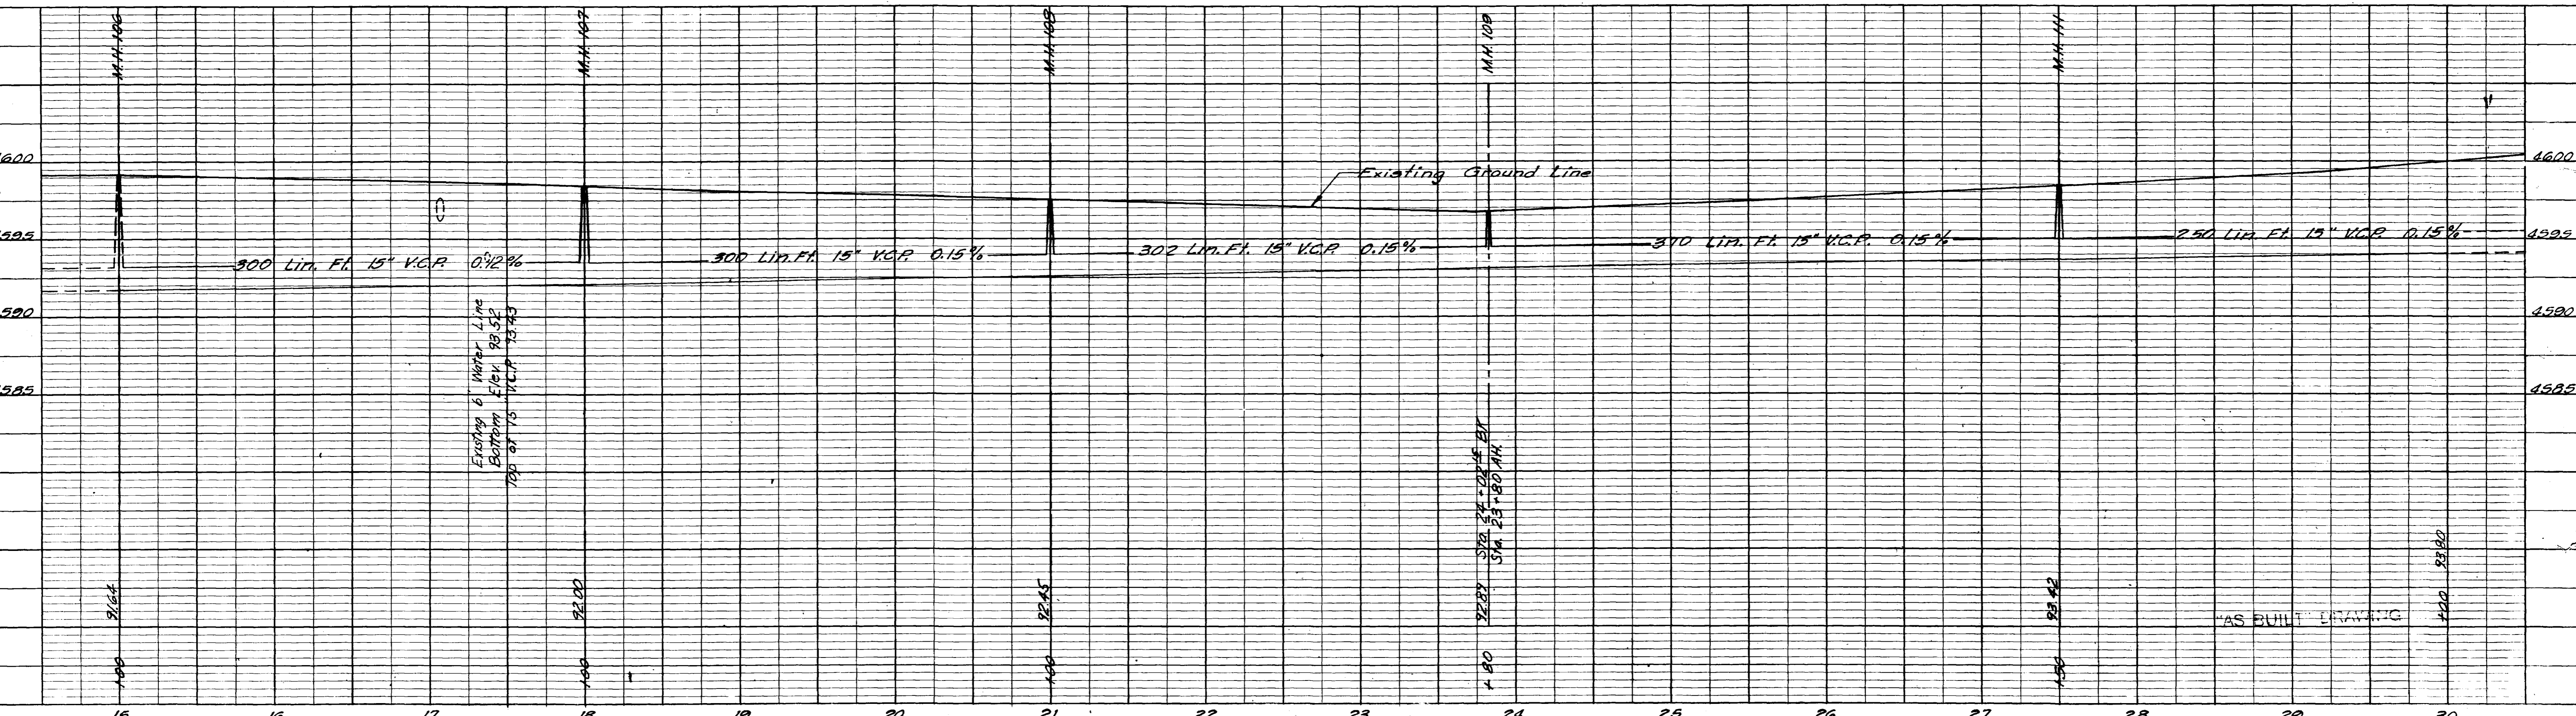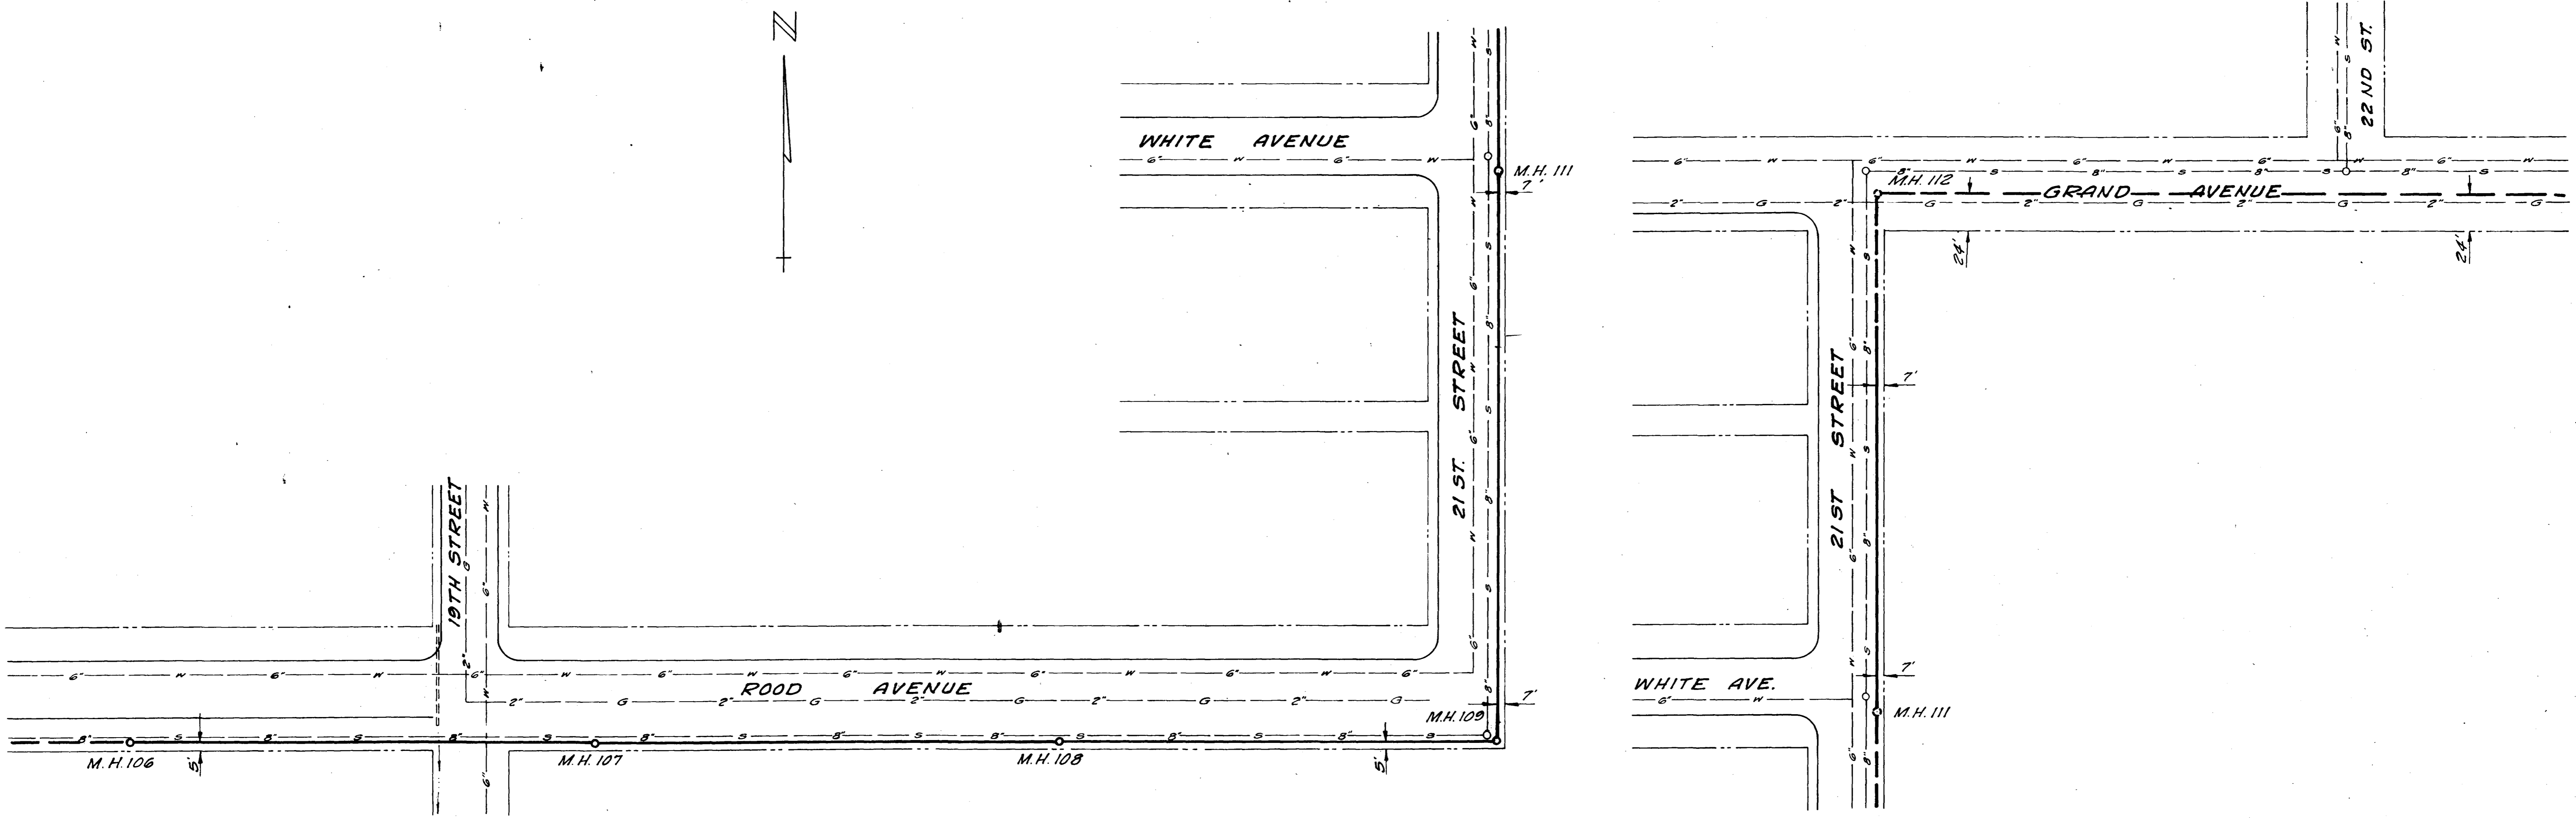

REVISIONS BY R.T. DATE Feb 1960 DESCR Grades and Alignment BY DATE DESCR		DATE October 1957 SCALE 1"=50'	DRAWN D.V.R. CHECKED R.C. [Signature] APPROVED W. [Signature]	JOB NO. G-205 FILE NO. F. B. NO.	HAROLD HOSKINS & ASSOCIATES ENGINEERING CONSULTANTS GREELEY, COLORADO LINCOLN, NEBRASKA	FRUITVALE, COLORADO WATER & SANITATION DISTRICT.	OUTFALL LINE - STA. 15+00 TO STA. 30+00	66 SHEET 3
--------------------------------------------------------------------------------	--	-----------------------------------	---------------------------------------------------------------------	----------------------------------------	----------------------------------------------------------------------------------------------------------	-----------------------------------------------------------------------	------------------------------------------------	---------------

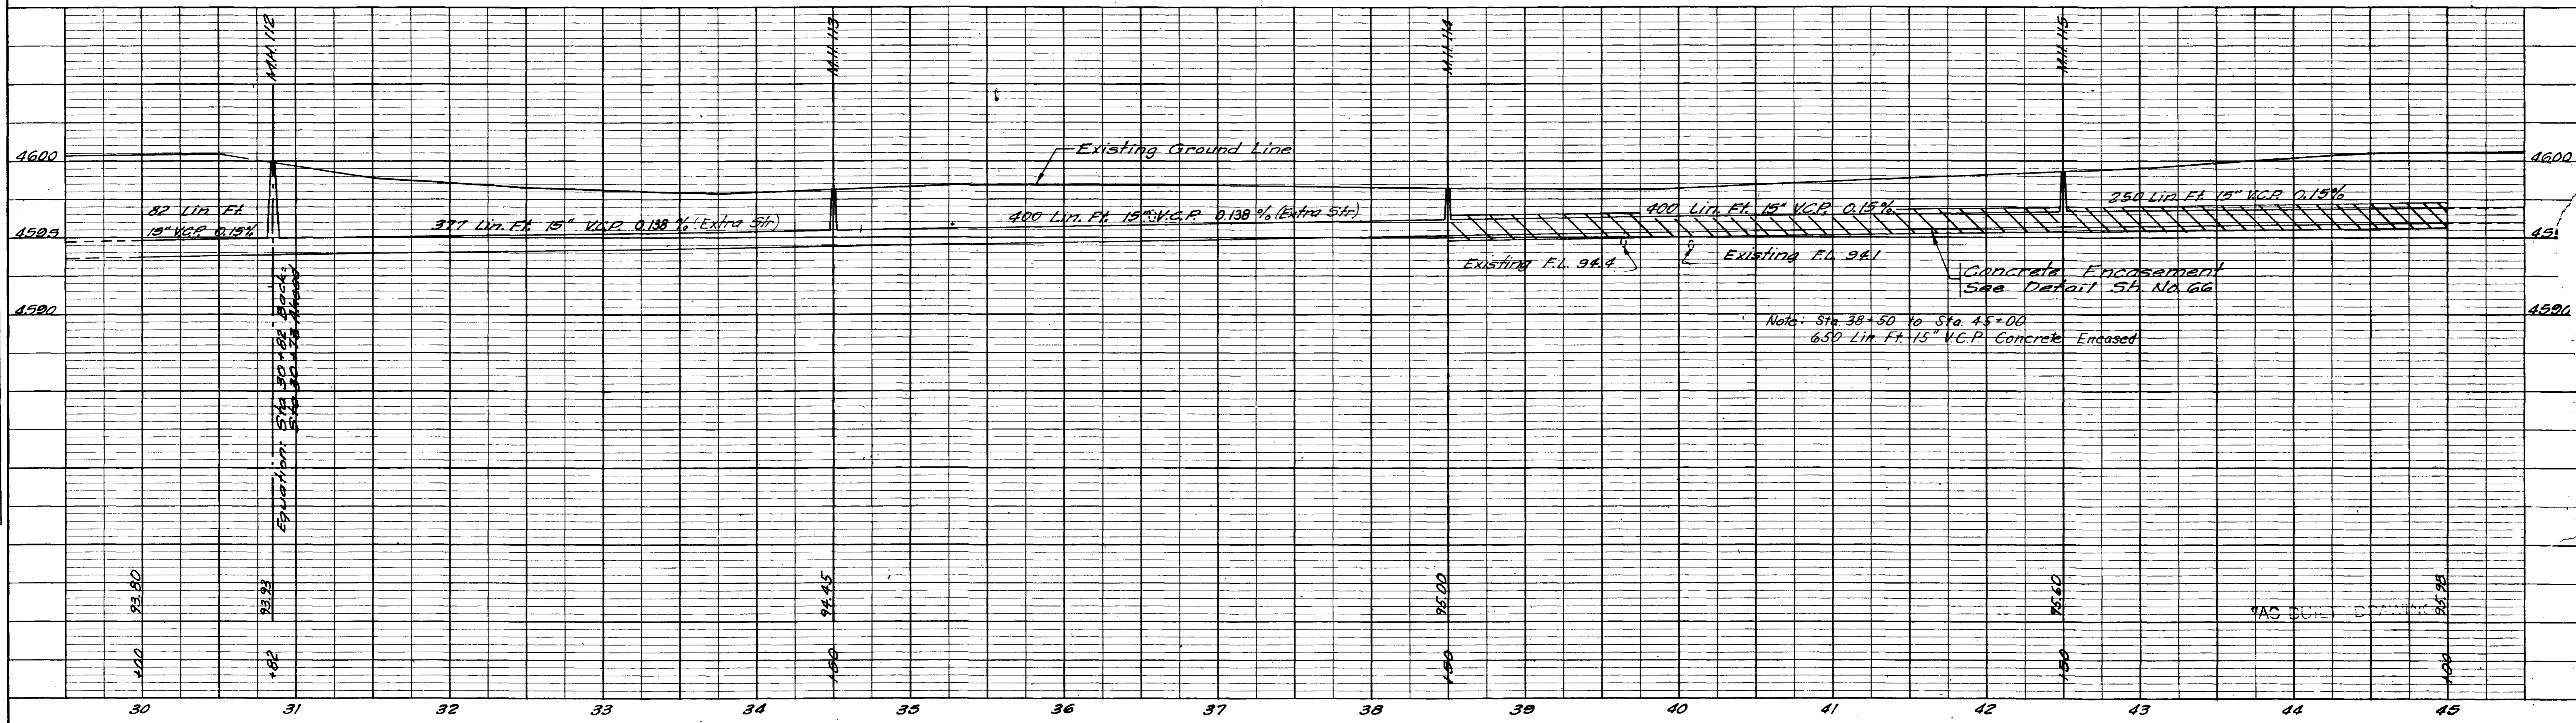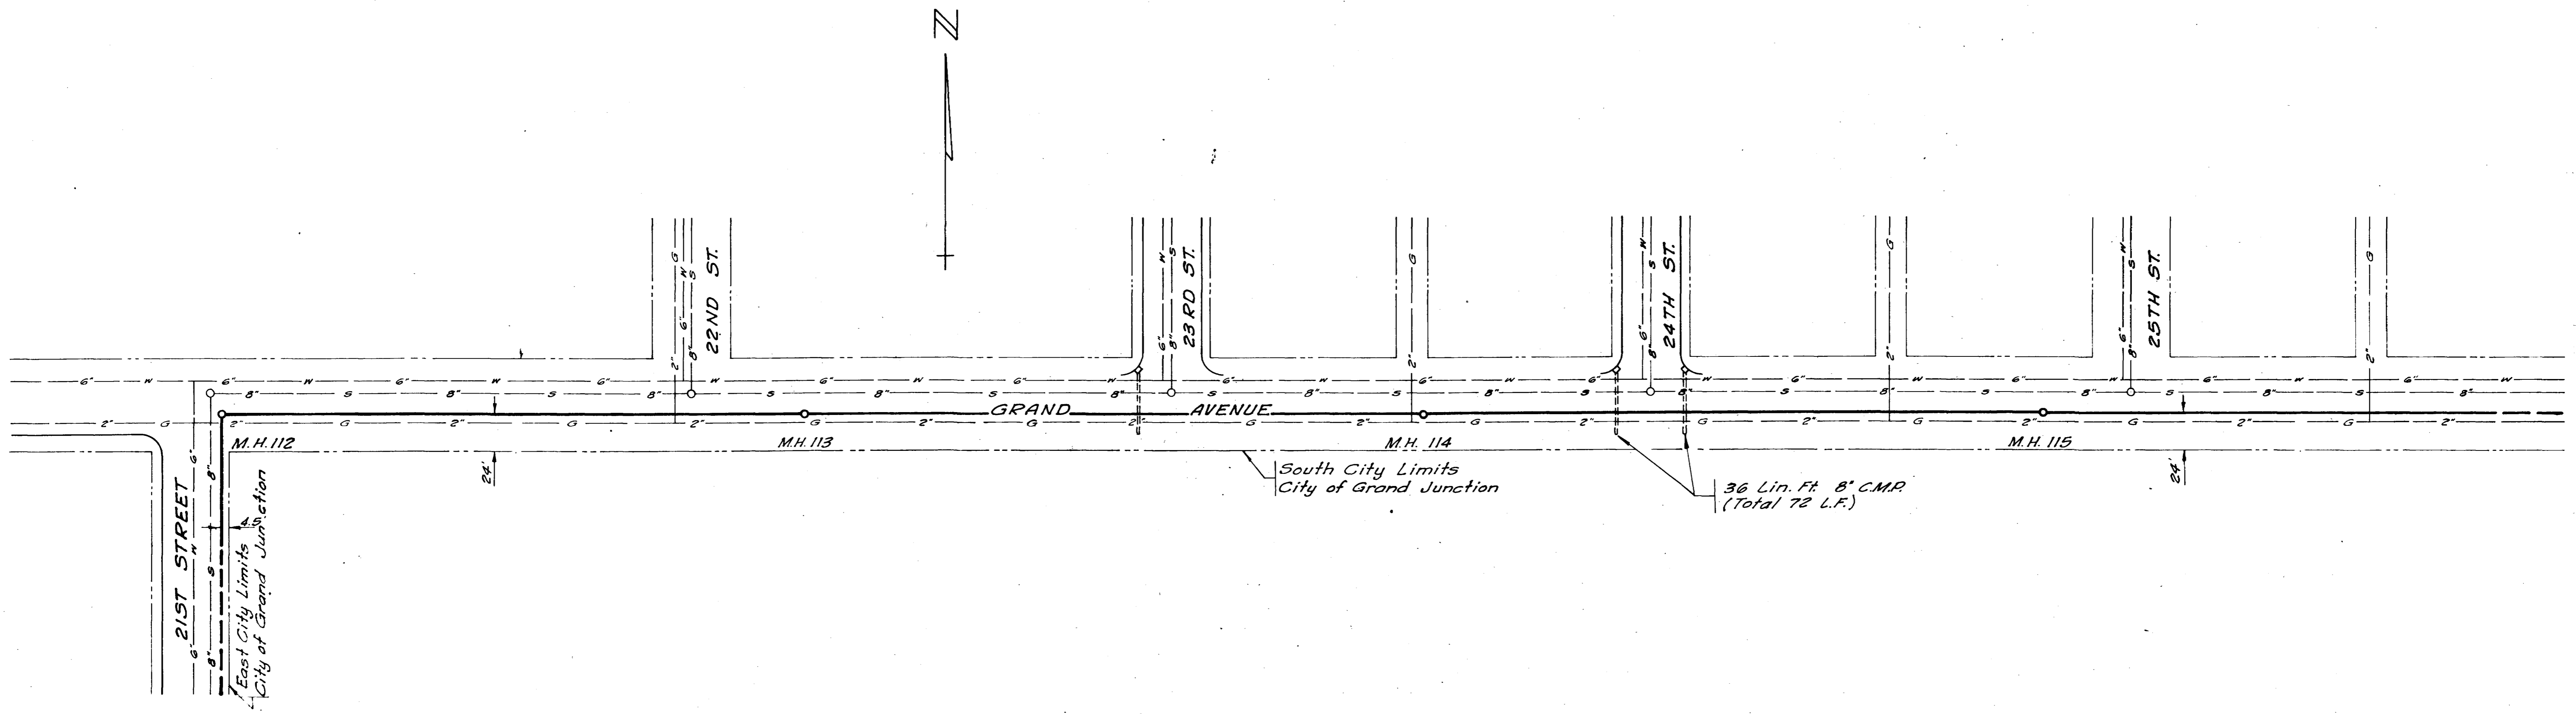



REVISIONS	
BY: R.C.T.	DATE: Feb 1960
DESCR: Grades	

DATE: October 1957	DRAWN: D.V.R.	JOB NO: G-205
SCALE: 1"=50'	CHECKED: R.C.T.	FILE NO:
	APPROVED: [Signature]	F. B. NO:

HAROLD HOSKINS & ASSOCIATES
ENGINEERING CONSULTANTS
GREELEY, COLORADO LINCOLN, NEBRASKA

FRUITVALE, COLORADO
WATER & SANITATION DISTRICT



OUTFALL LINE - STA. 30+00 TO STA. 45+00
66 SHEET NO. 4

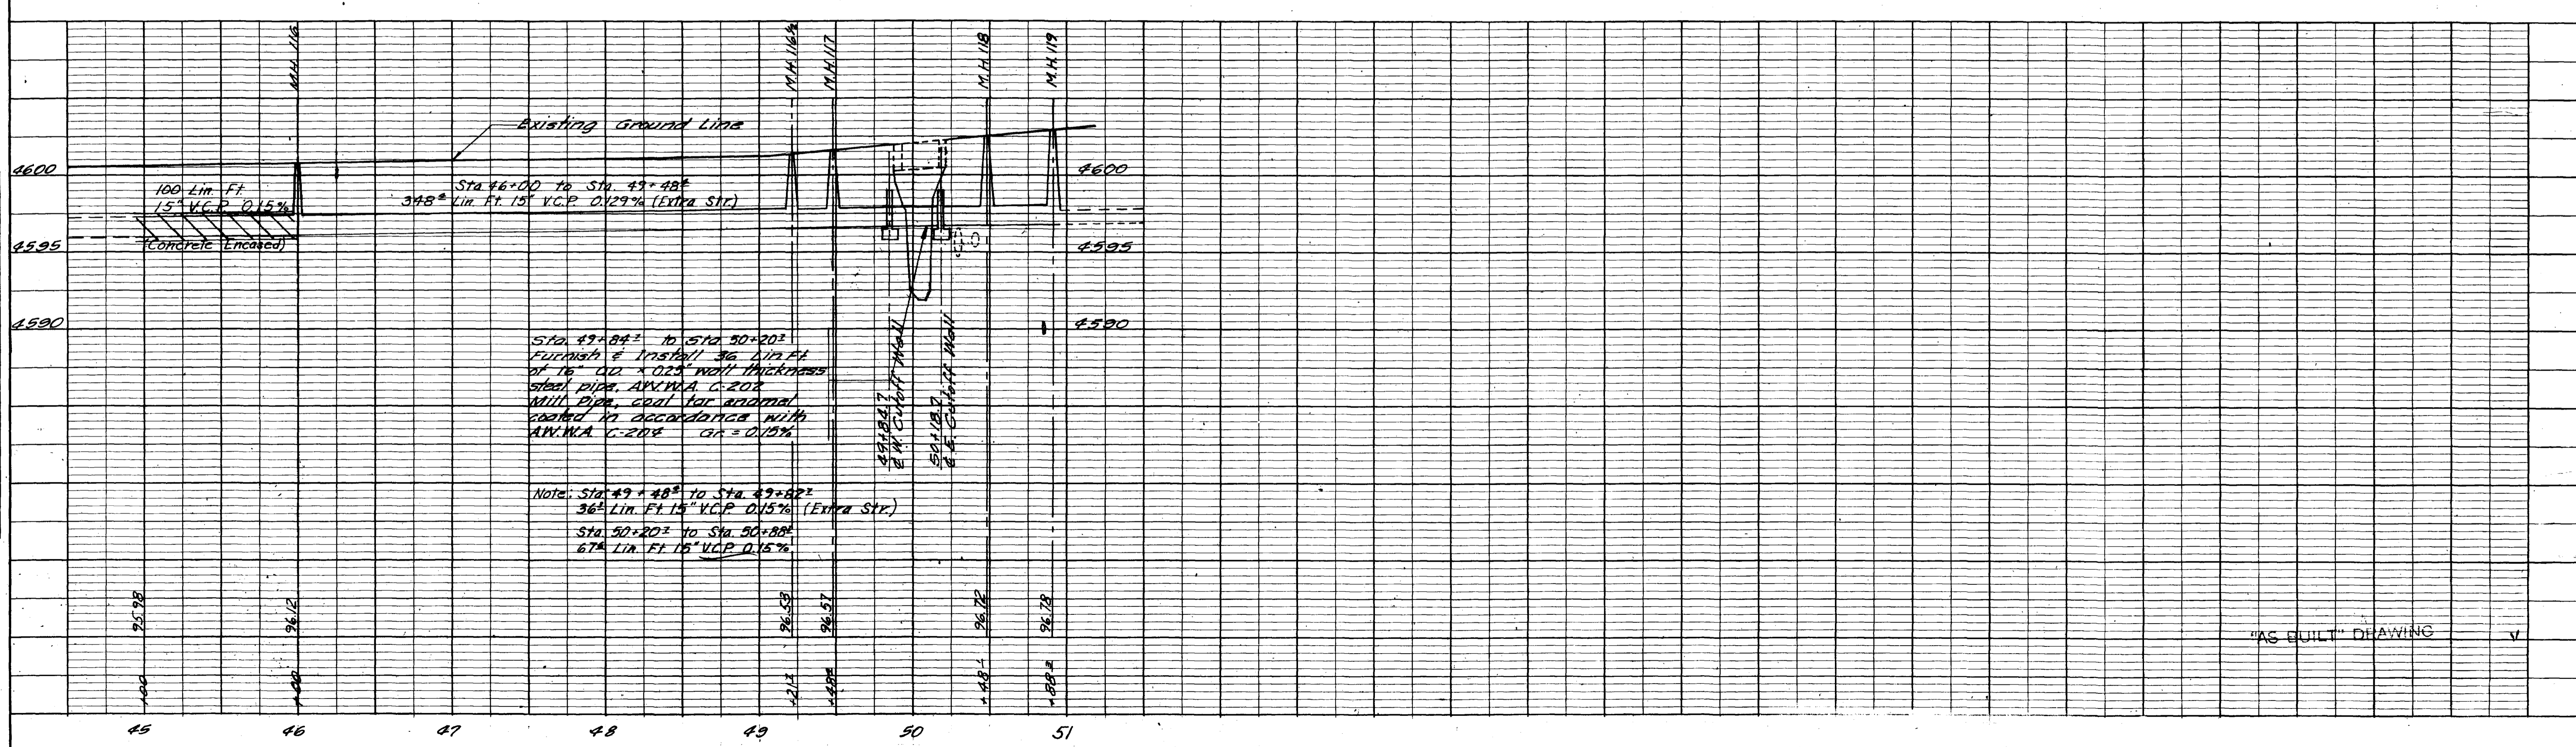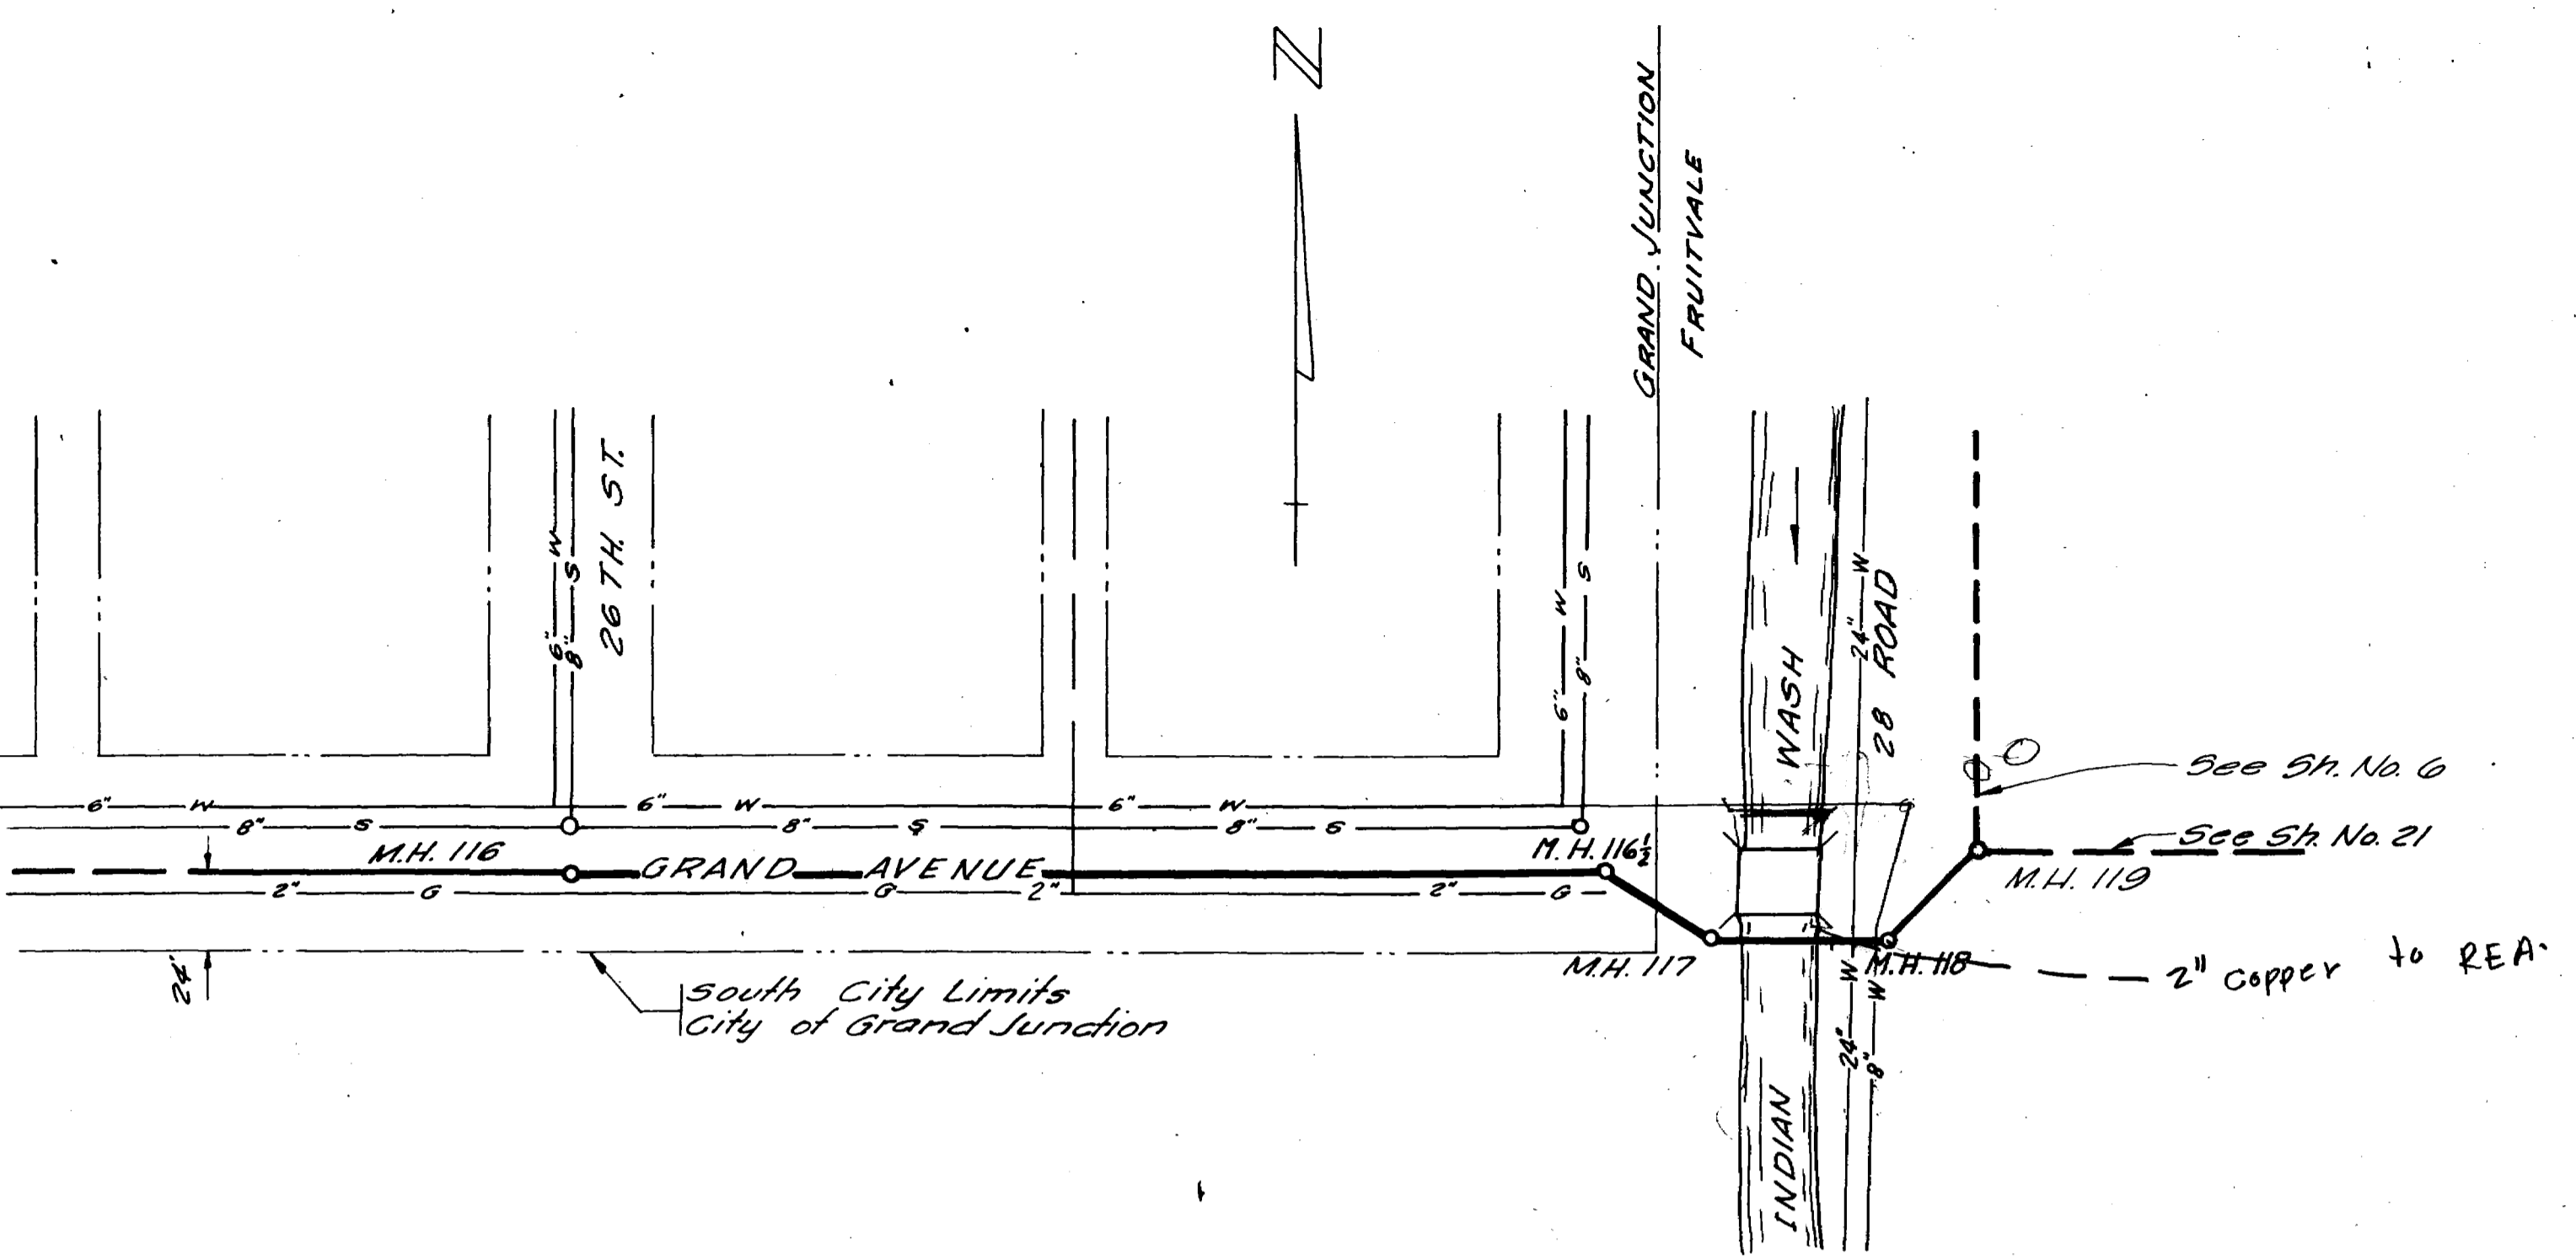

"AS BUILT" DRAWING

REVISIONS BY: RCT DATE: Feb 13 1960 BY: DATE: DESCR: Grades & Alignment BY: DATE: DESCR:		DESIGNED: G.O. CHECKED: RGT APPROVED: [Signature]		JOB NO: G-205 FILE NO: F.B. NO:		HAROLD HOSKINS & ASSOCIATES ENGINEERING CONSULTANTS GREELEY, COLORADO GREAT FALLS, MONTANA LINCOLN, NEBRASKA		FRUITVALE, COLORADO WATER & SANITATION DISTRICT		OUTFALL LINE - STA. 45+00 TO STA. 50+42		66 SHEET NO. 5 SHEETS	
---------------------------------------------------------------------------------------------------	--	---------------------------------------------------------	--	---------------------------------------	--	--------------------------------------------------------------------------------------------------------------------	--	----------------------------------------------------	--	-----------------------------------------	--	--------------------------	--

For Continuation
See Sheet No. 7

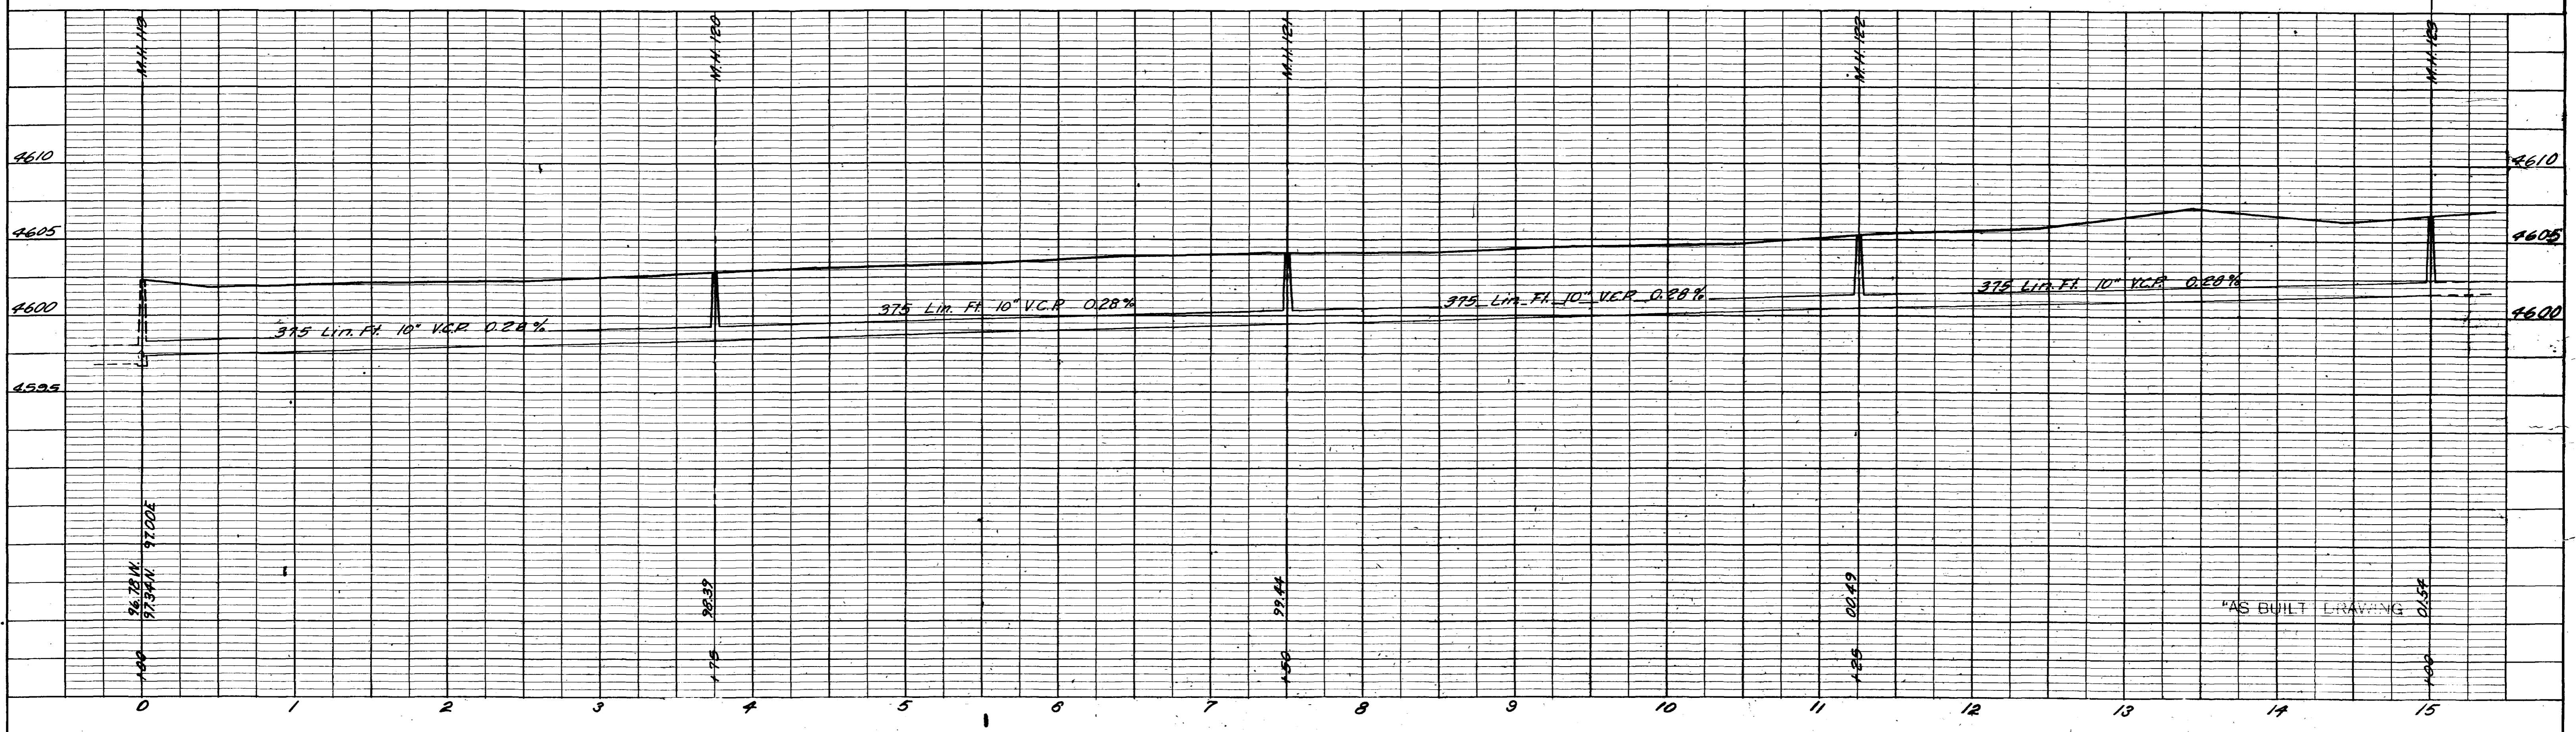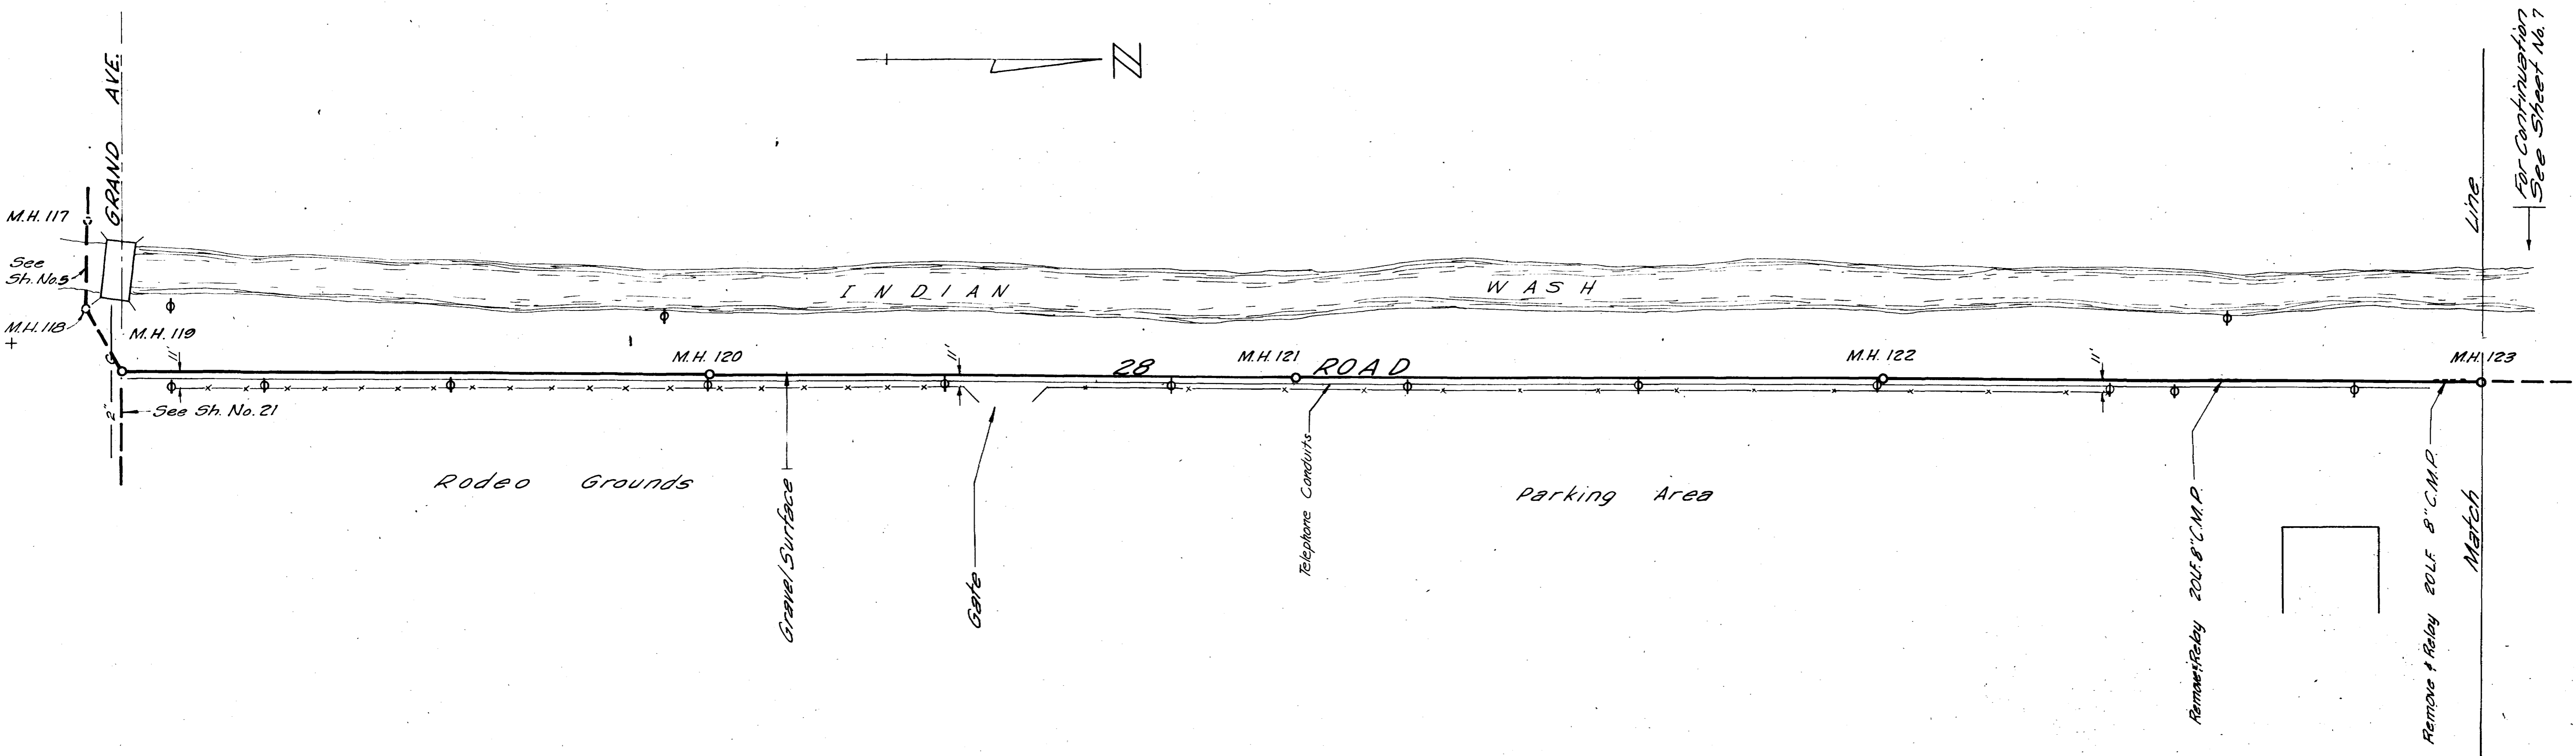

REVISIONS	
BY: R.C.T.	DATE: Feb. 1960
DESCR: Grade and Alignment	
BY: _____	DATE: _____
DESCR: _____	
BY: _____	DATE: _____
DESCR: _____	

DATE: October 1957	DRAWN: D.V.R.	JOB NO: G-205
SCALE: 1"=50'	CHECKED: R.C.T.	FILE NO: _____
APPROVED: [Signature]	F. B. NO: _____	



HAROLD HOSKINS & ASSOCIATES
ENGINEERING CONSULTANTS
GREELEY, COLORADO LINCOLN, NEBRASKA

FRUITVALE, COLORADO
WATER & SANITATION DISTRICT


28 ROAD SOUTH OF NORTH AVENUE
STA 0+00 TO STA 15+00

66 SHEET NO.
6 SHEETS

02081706

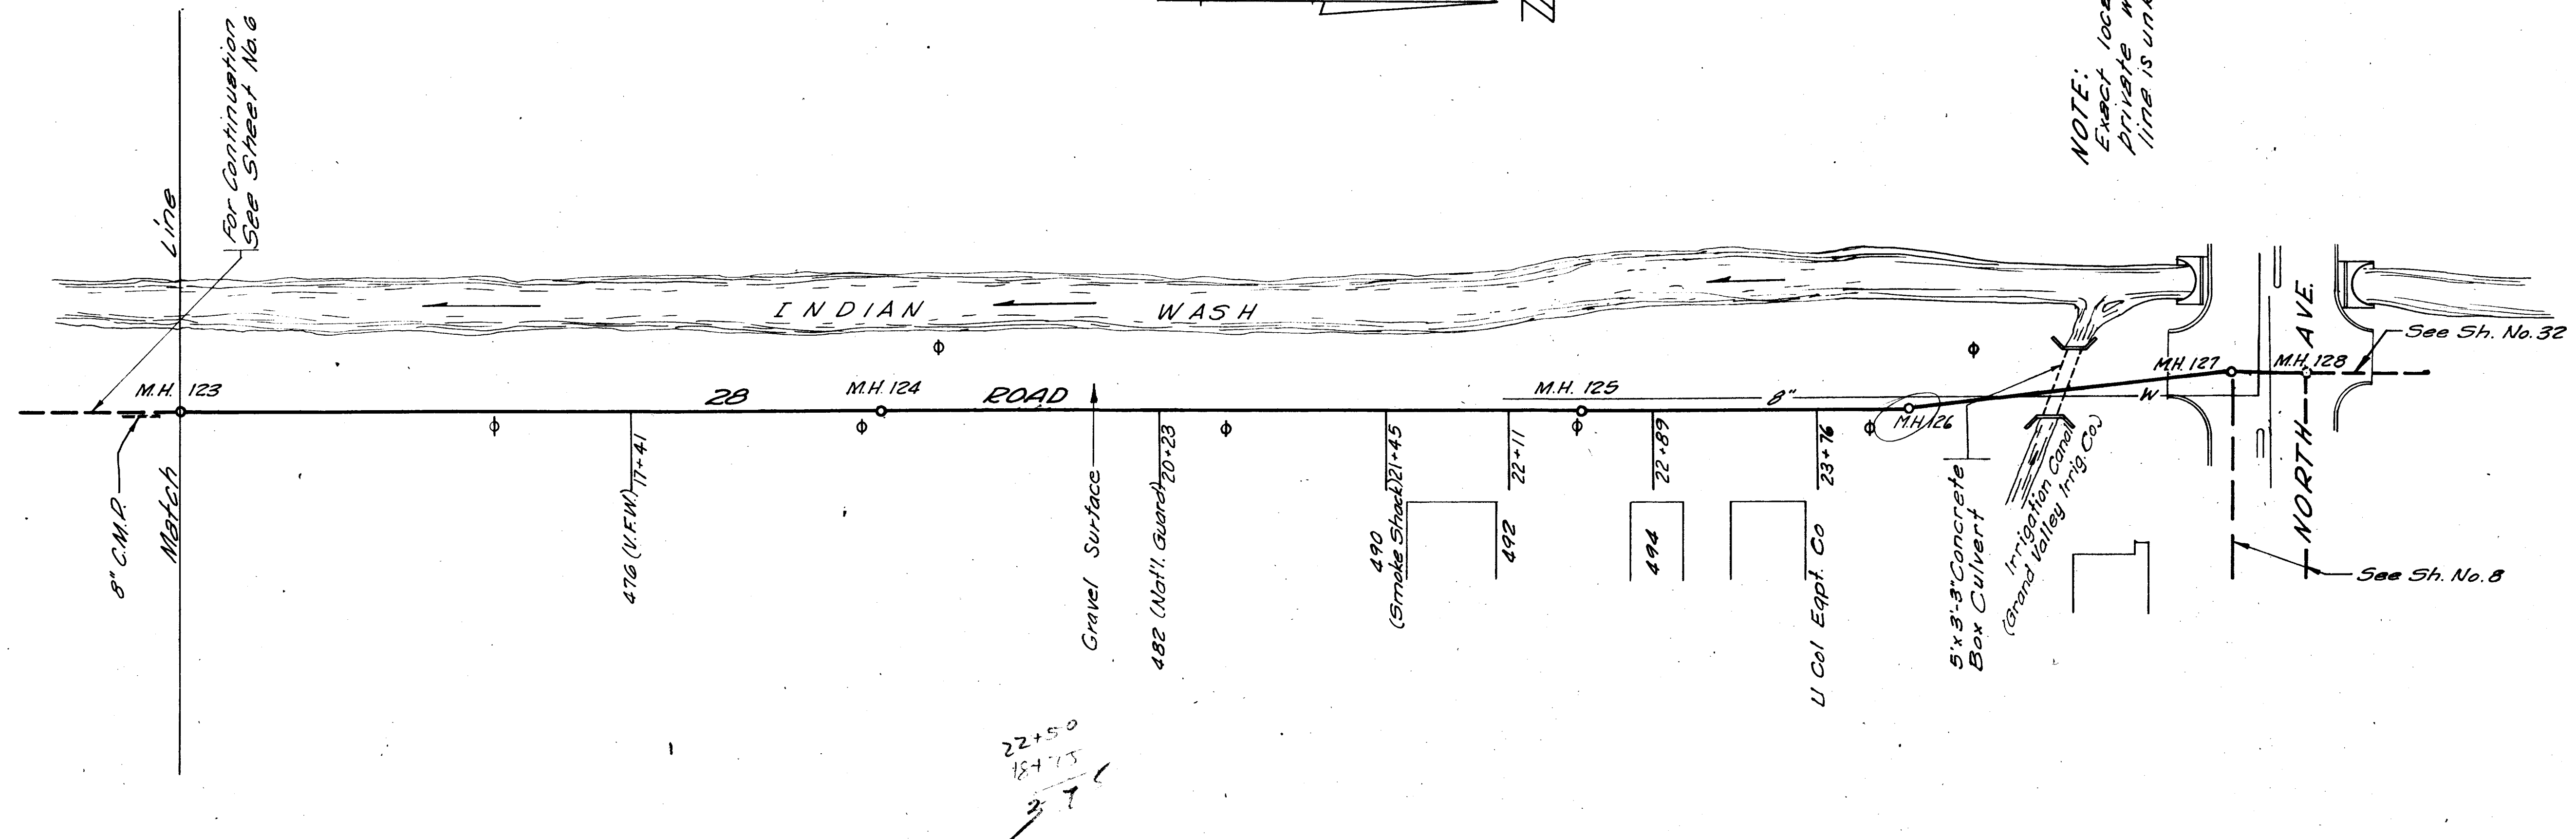
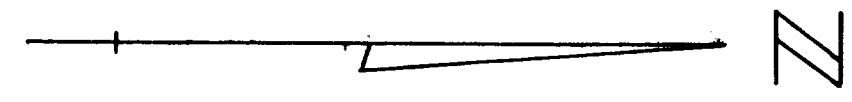


22+50
187.75
3.7

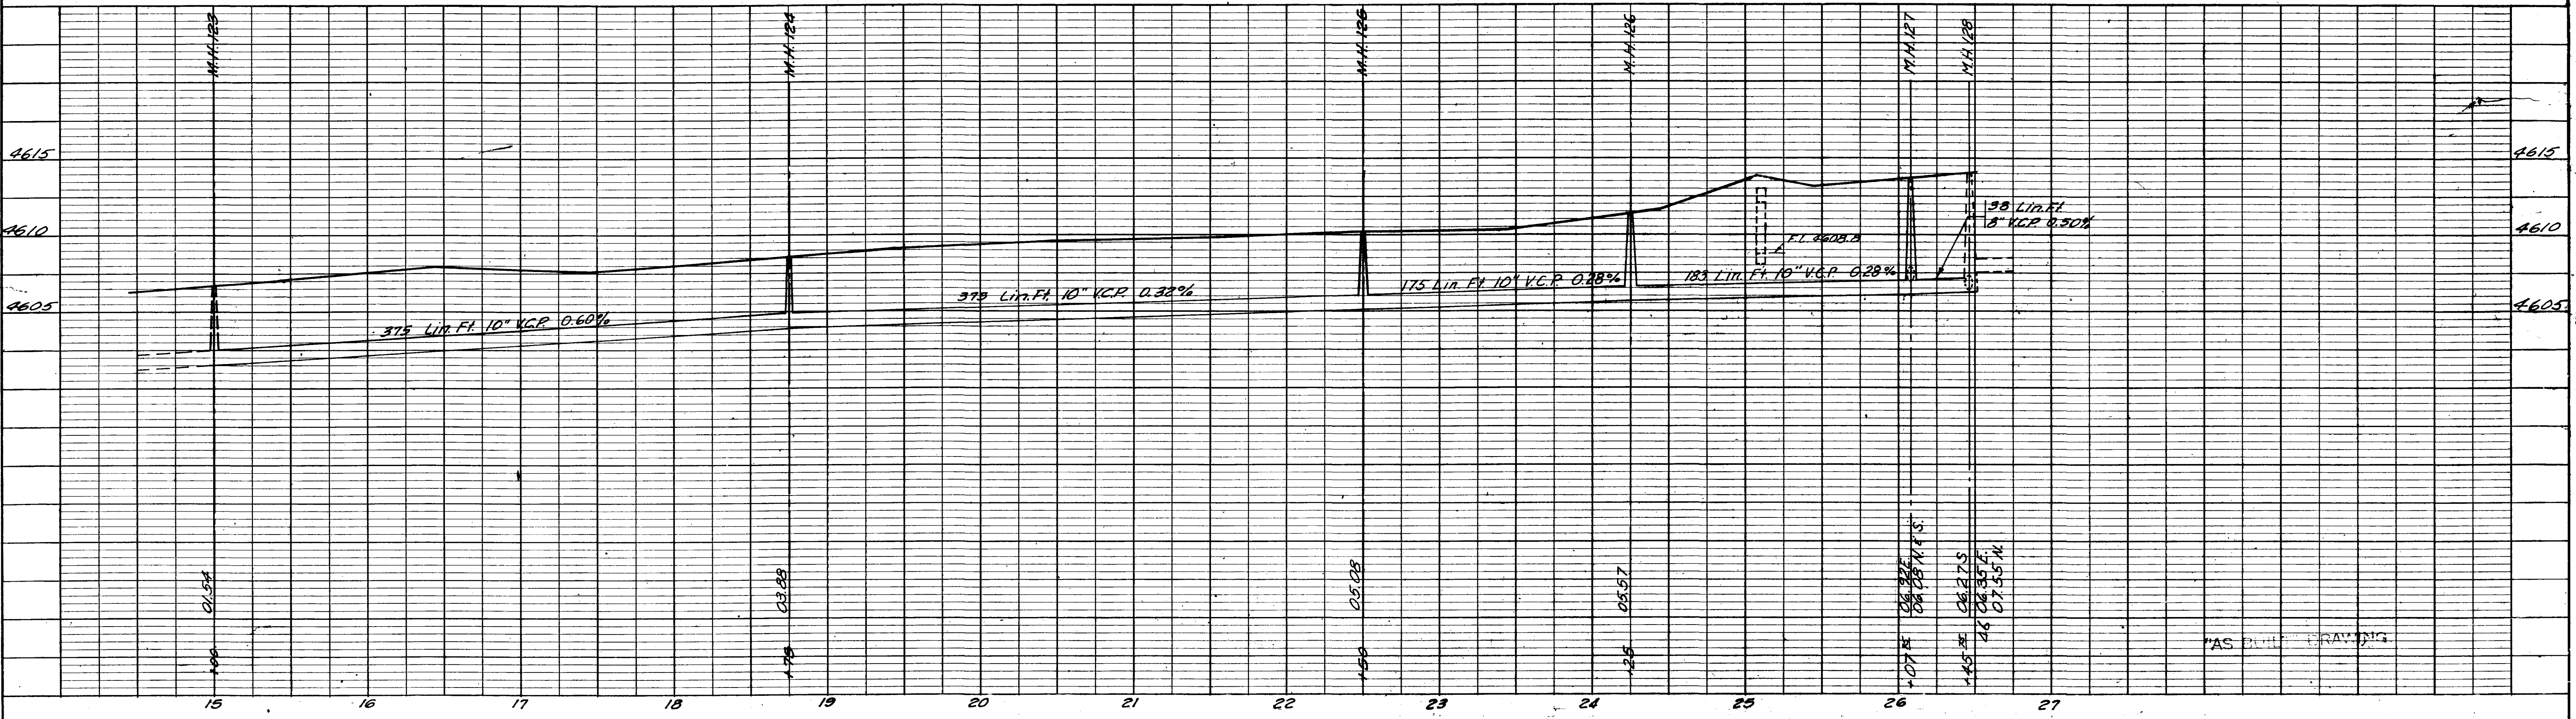

"AS BUILT" DRAWING


02081707

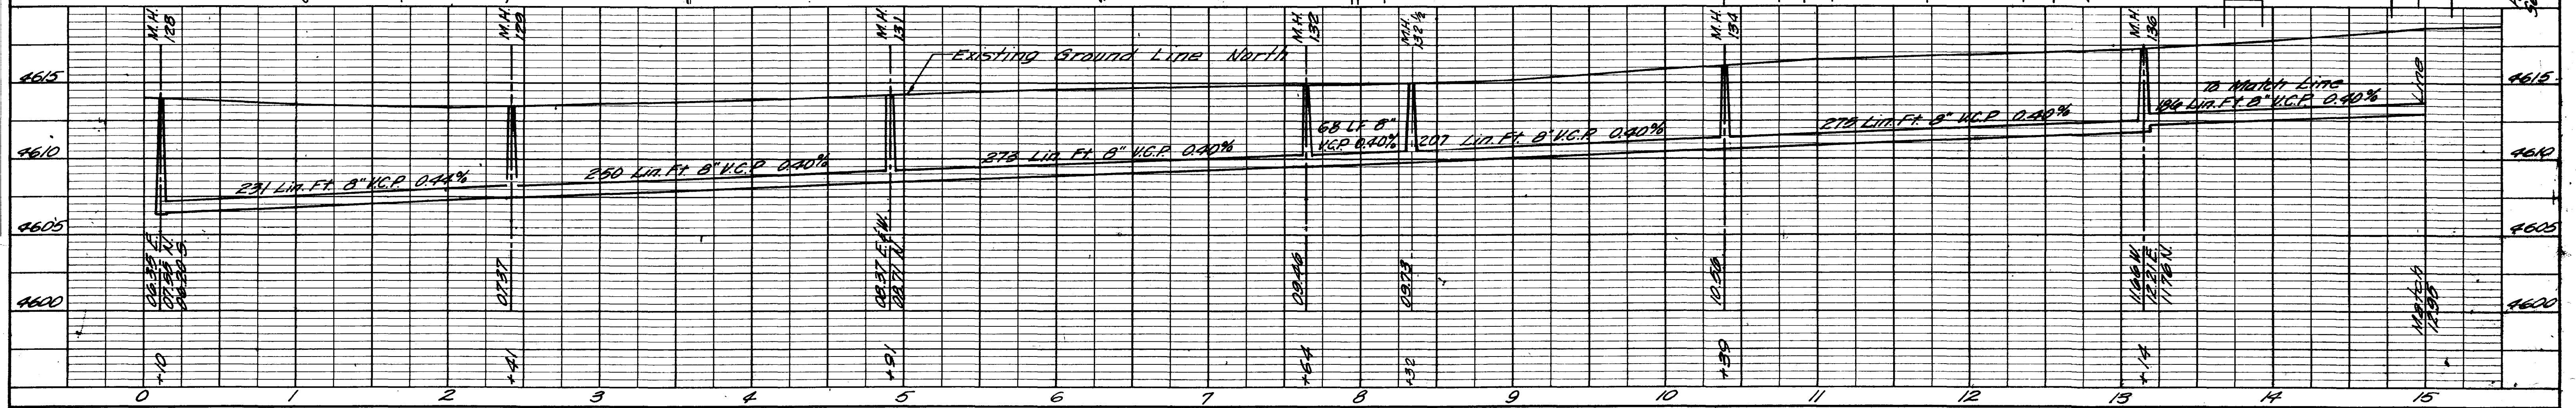
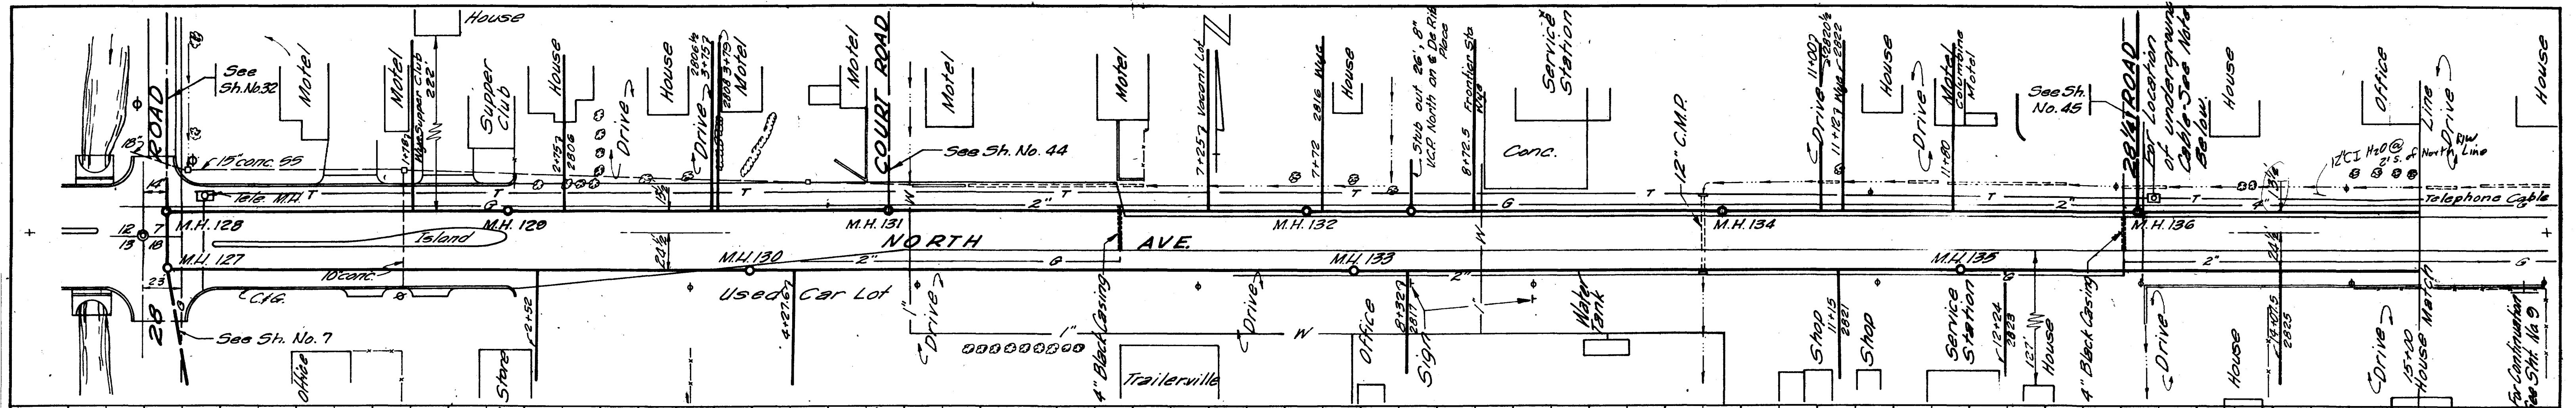


NOTE:
 Special Backfill Reqd. Sta. 0+10 to Sta. 15+00
 (0-5) Trench Depth = 590 Lin. Ft.
 (5-6) Trench Depth = 1960 Lin. Ft.
 (6-7) Trench Depth = 429 Lin. Ft.
 (7-8) Trench Depth = 133 Lin. Ft.


NOTE:
 Telephone cable crosses North Ave along line of east side of 28 1/4 Road. For exact location contact Telephone Co. 749 Road Ave. Grand Junction, Colo.


SEE PLAN VIEW ABOVE

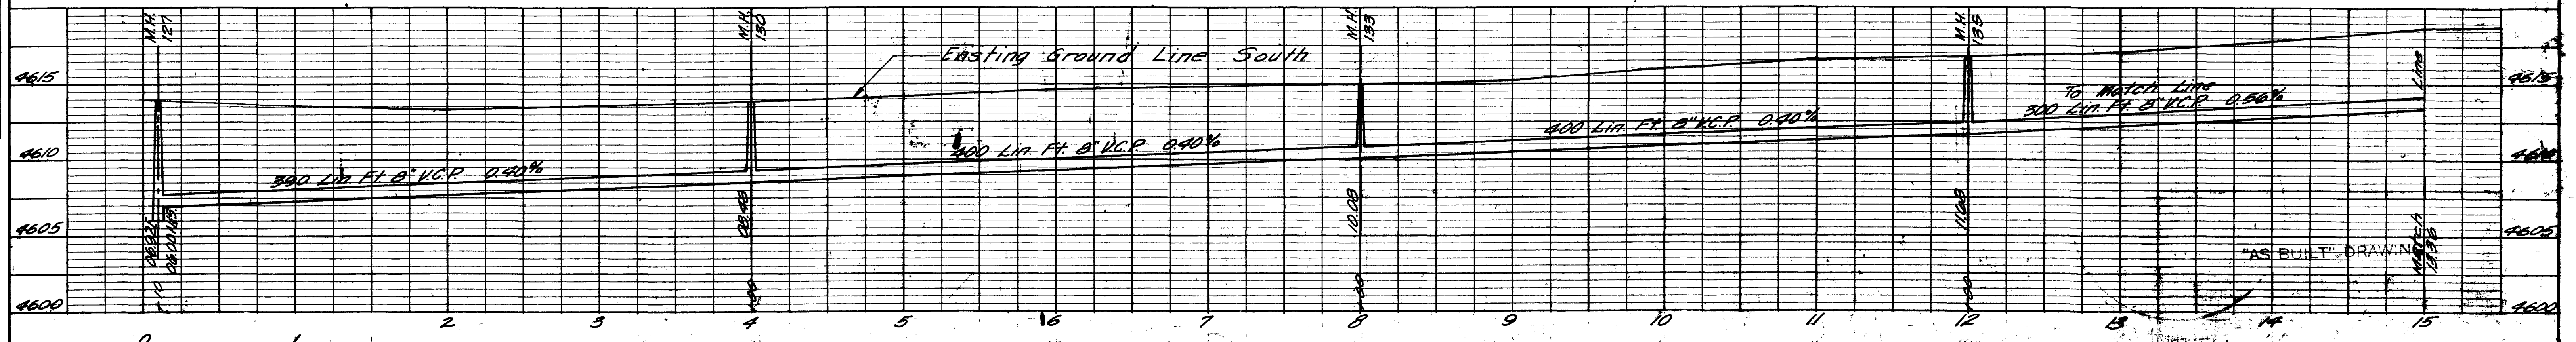

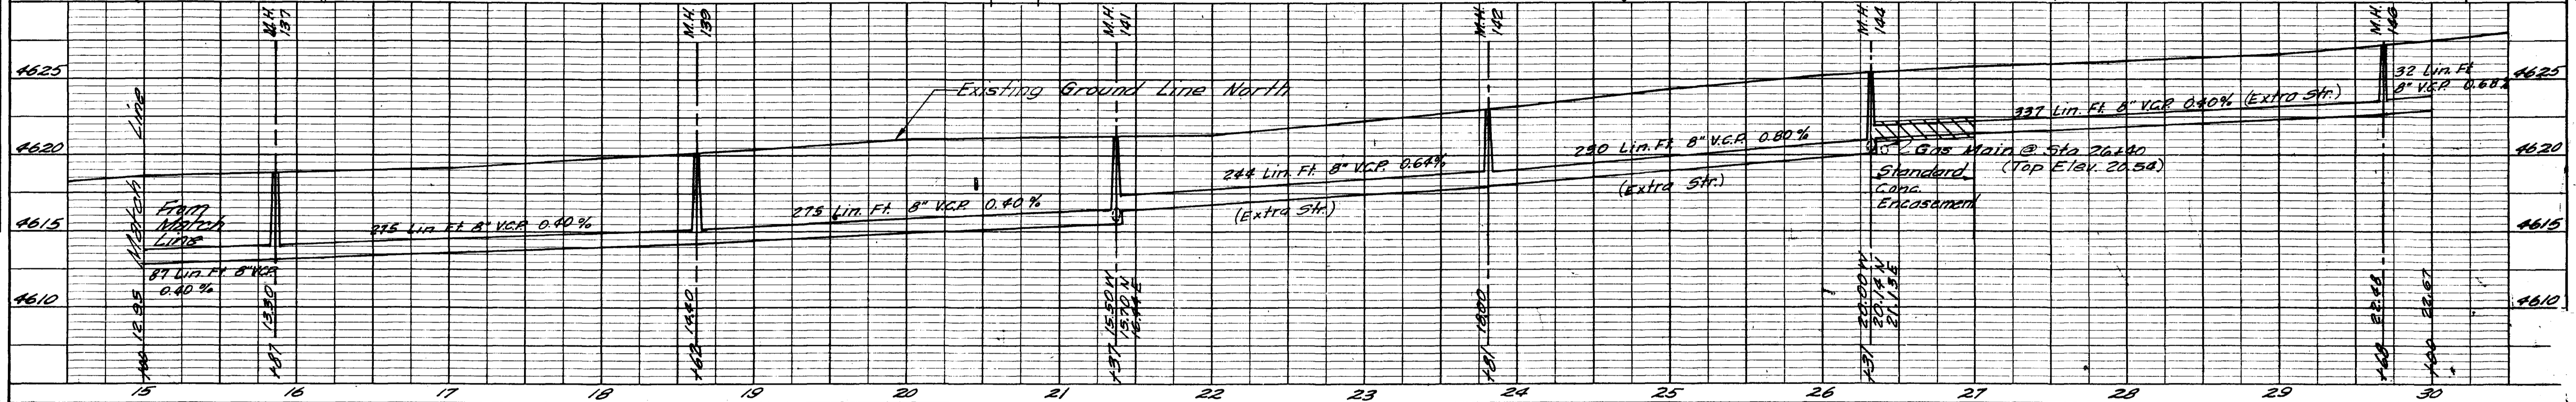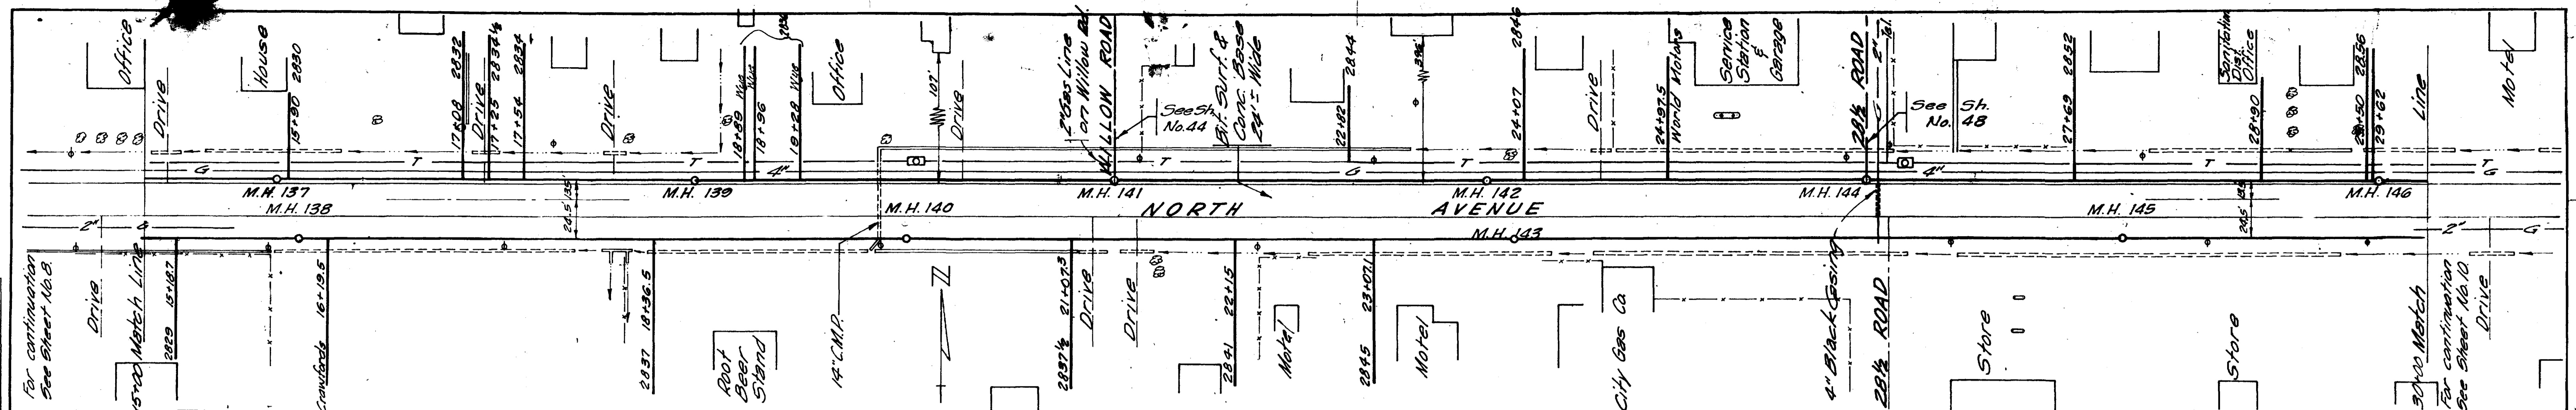


NOTE:
 Special Backfill Req'd. Sta 15+00 to Sta 30+00
 (0-5') Trench depth = 1433 Lin. Ft.
 (5-6') Trench depth = 1573 Lin. Ft.
 (6-7') Trench depth = 90 Lin. Ft.


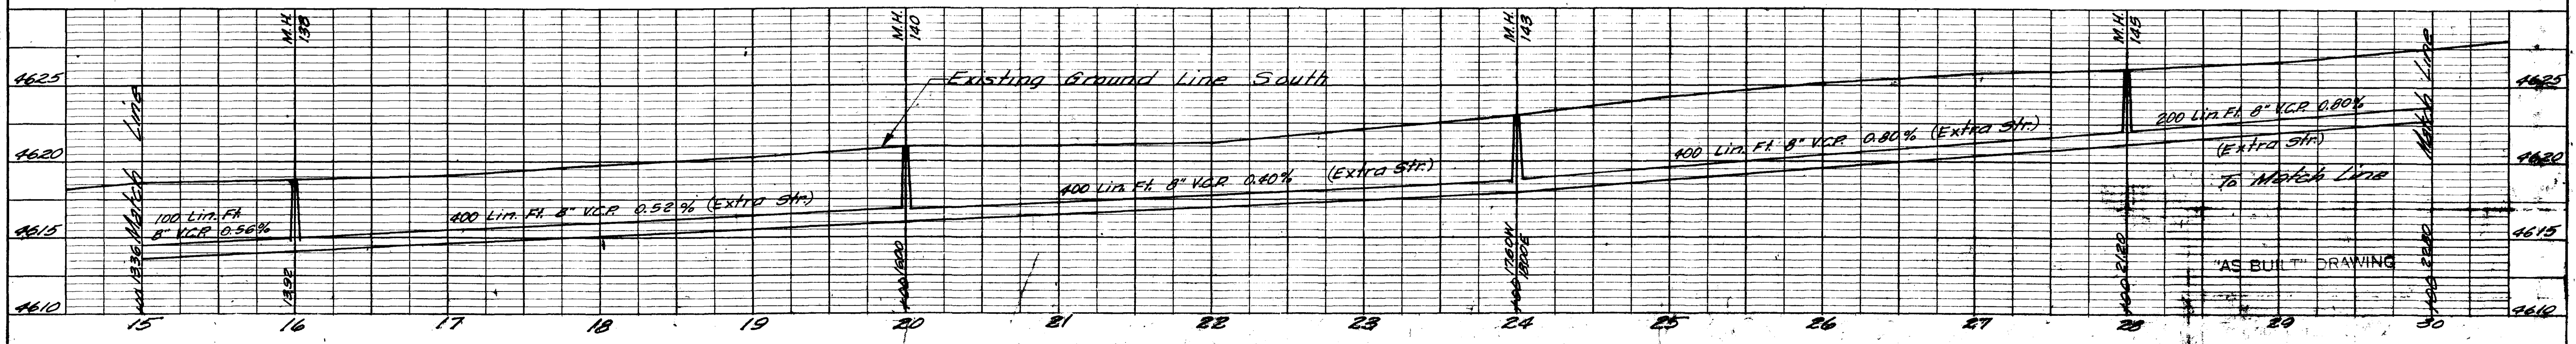


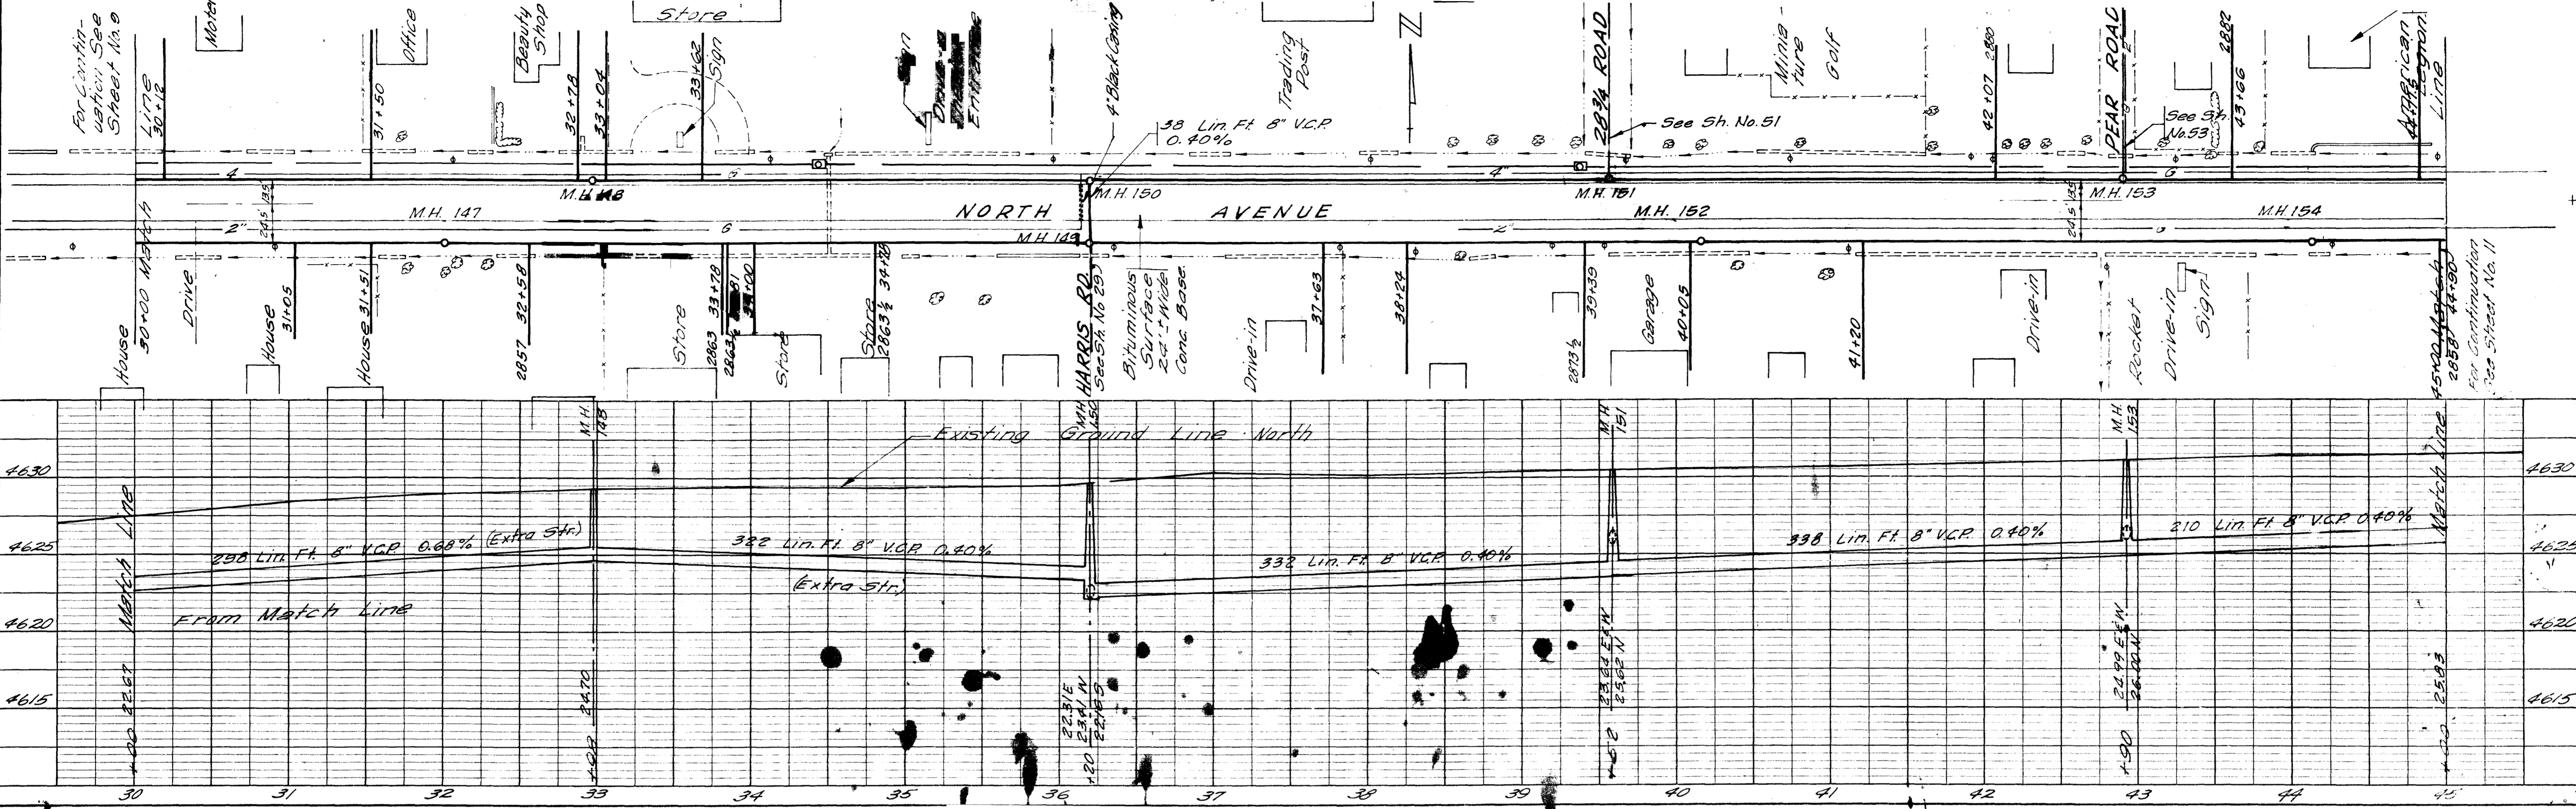

NOTE:
 Special Backfill Req'd. Sta 30+00 to Sta 45+00
 (0-5') Trench Depth = 576 Lin. Ft.
 (5-6') Trench Depth = 976 Lin. Ft.
 (6-7') Trench Depth = 1135 Lin. Ft.
 (7-8') Trench Depth = 419 Lin. Ft.


SEE PLAN VIEW ABOVE

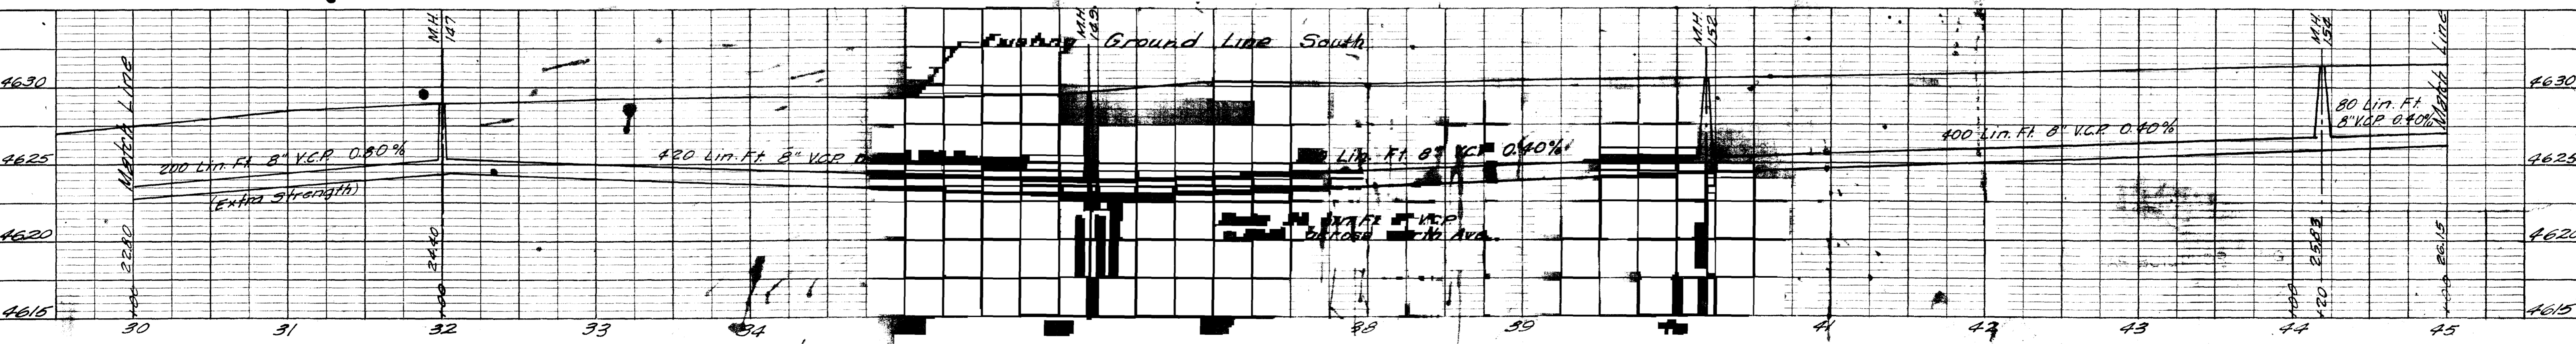

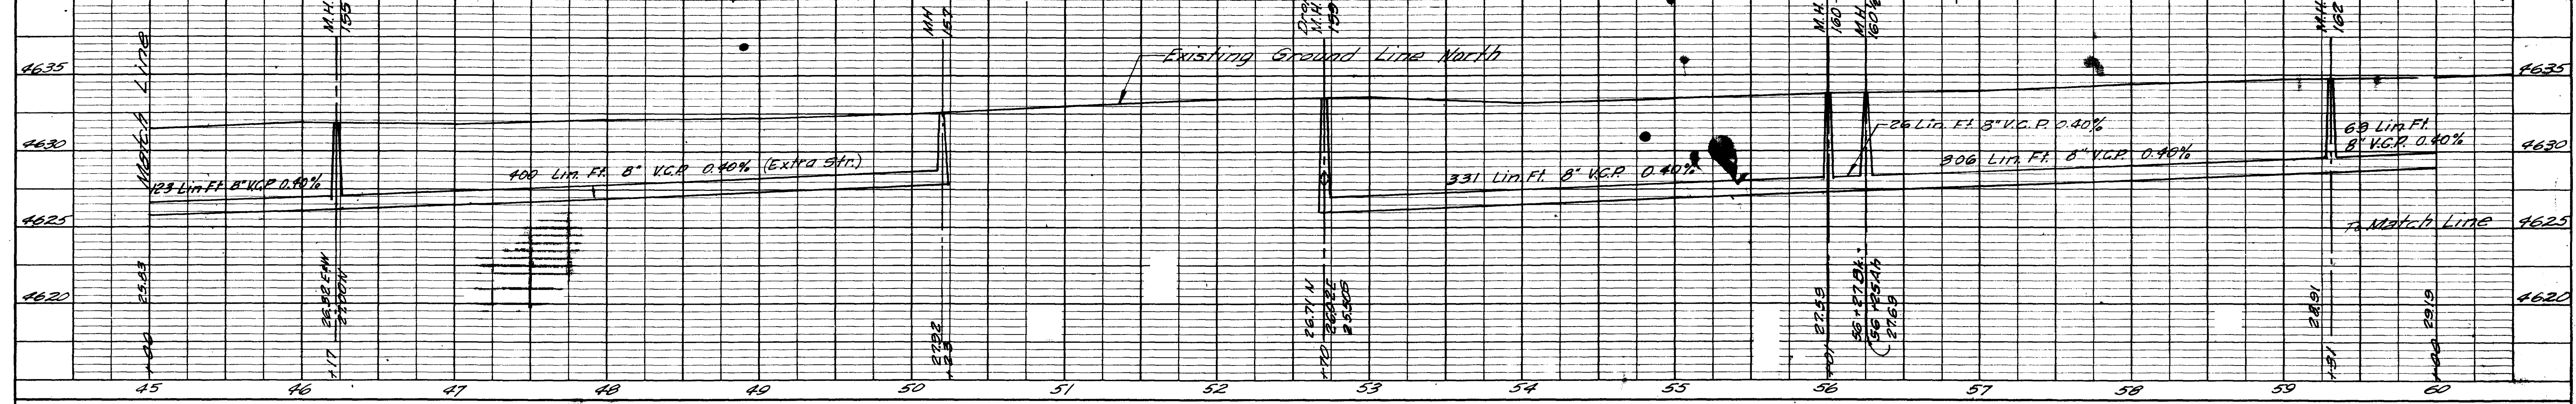
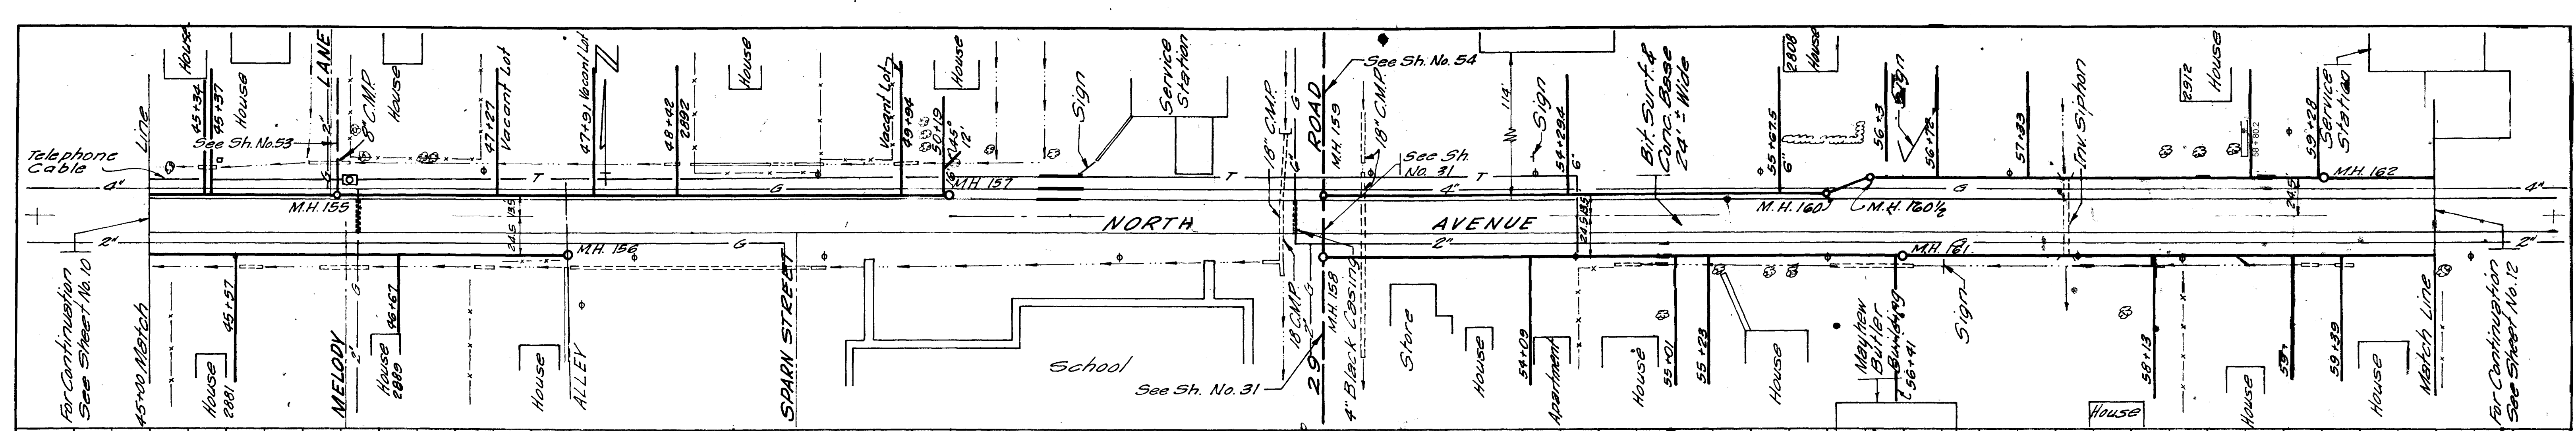


NOTE: Special Backfill Req'd. Sta 45+00 to 60+00
 (0-5') Trench Depth = 324 Lin. Ft.
 (5-6') Trench Depth = 525 Lin. Ft.
 (6-7') Trench Depth = 640 Lin. Ft.
 (7-8') Trench Depth = 131 Lin. Ft.
 (8-9') Trench Depth = 425 Lin. Ft.
 (9-10') Trench Depth = 319 Lin. Ft.



SEE PLAN VIEW ABOVE

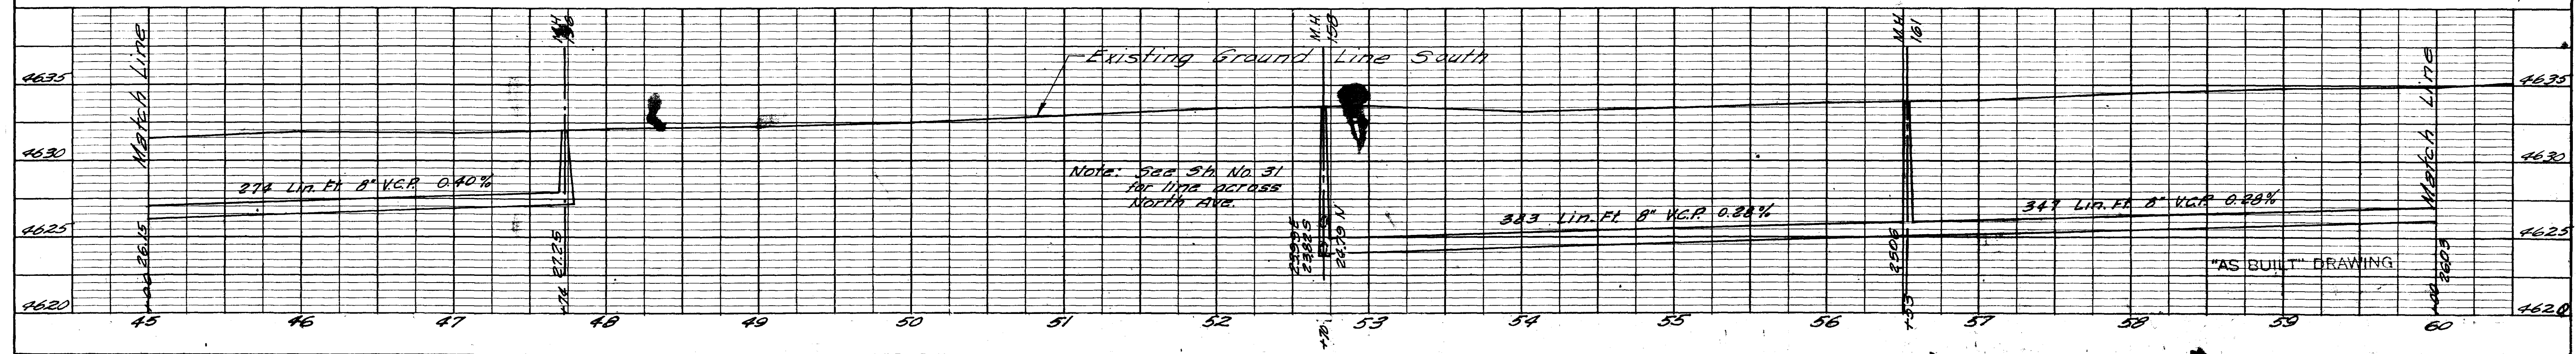


"AS BUILT" DRAWING

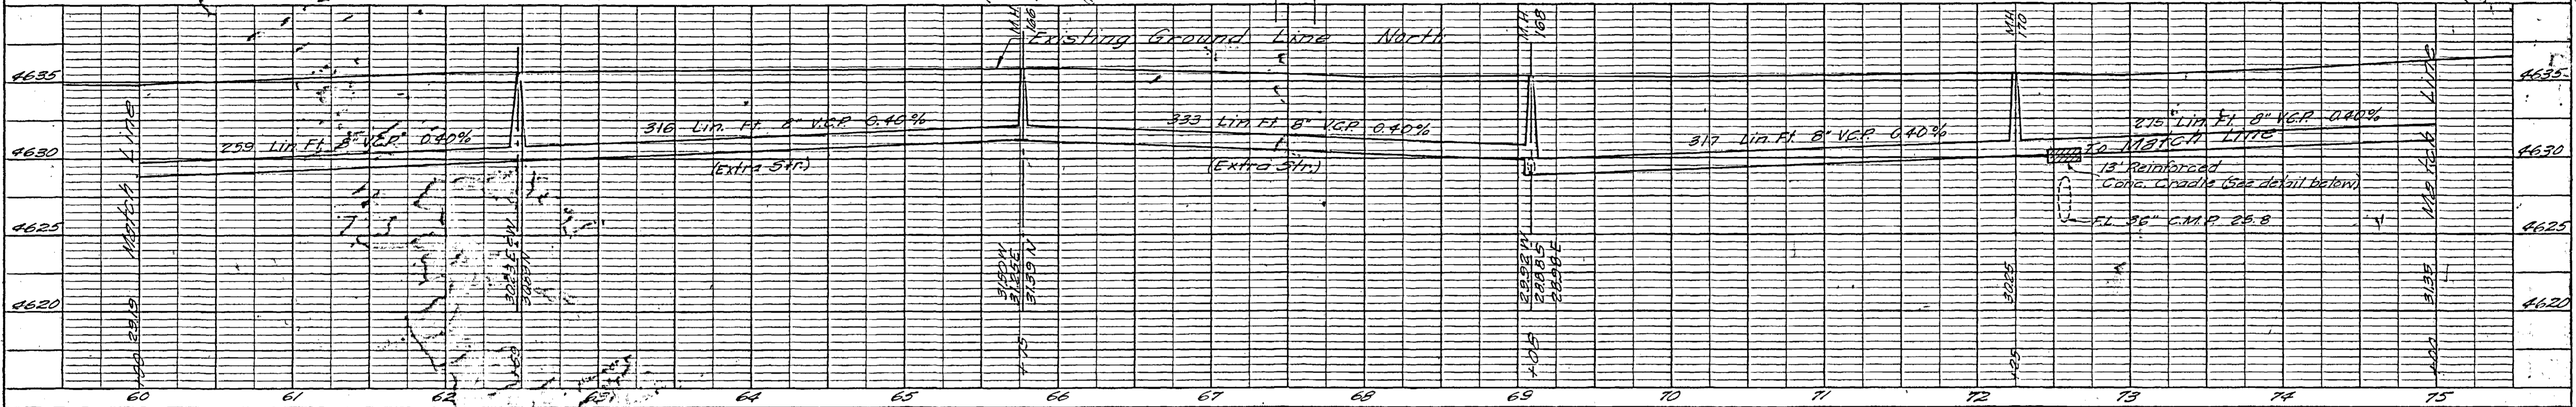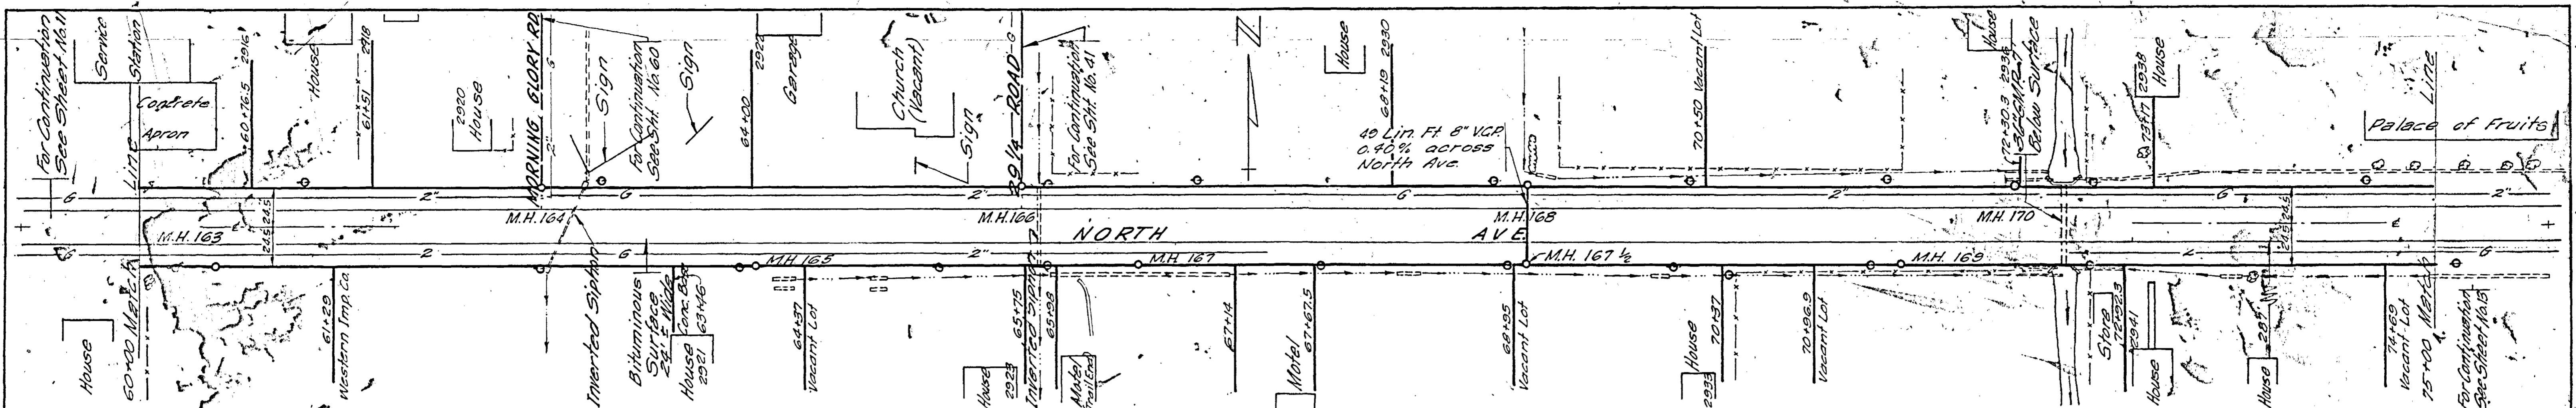

NOTE Special Backfill Road Sta 60+00 to Sta 75+00
 (0-5') Trench Depth = 556 Lin. Ft.
 (5-6') Trench Depth = 1208 Lin. Ft.
 (6-7') Trench Depth = 518 Lin. Ft.
 (7-8') Trench Depth = 115 Lin. Ft.
 (8-9') Trench Depth = 575 Lin. Ft.
 (9-10') Trench Depth = 50 Lin. Ft.

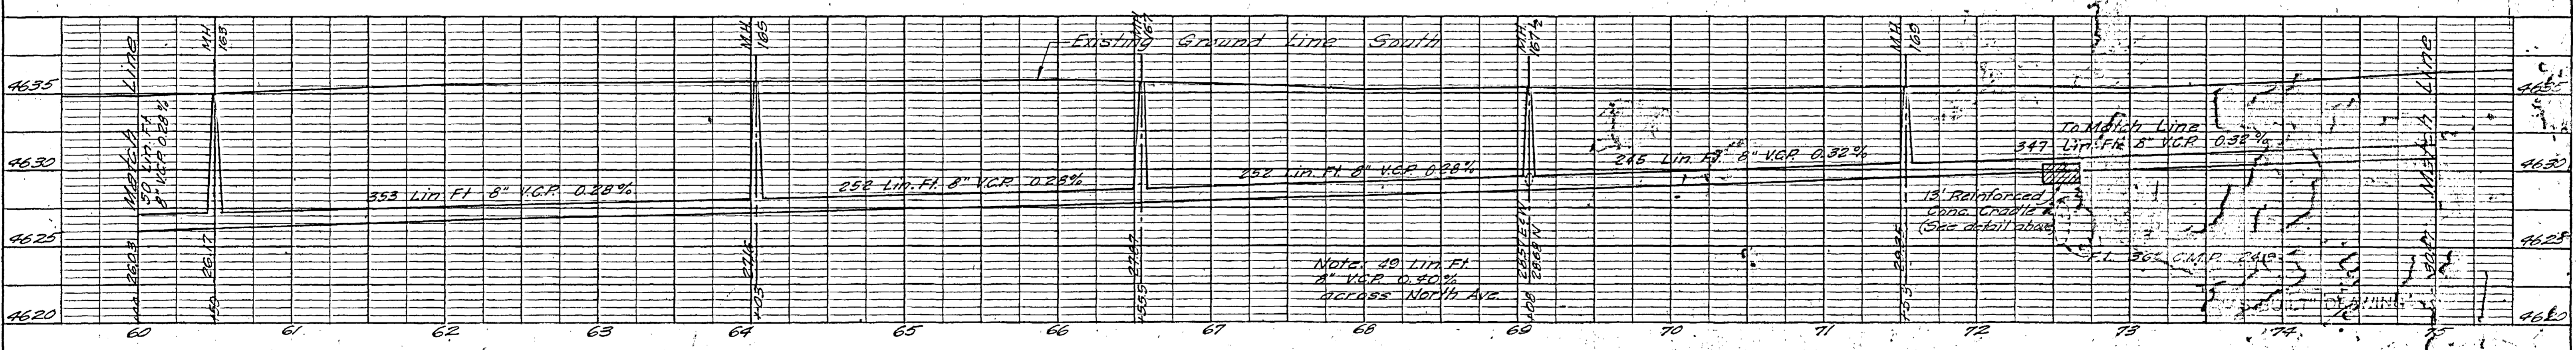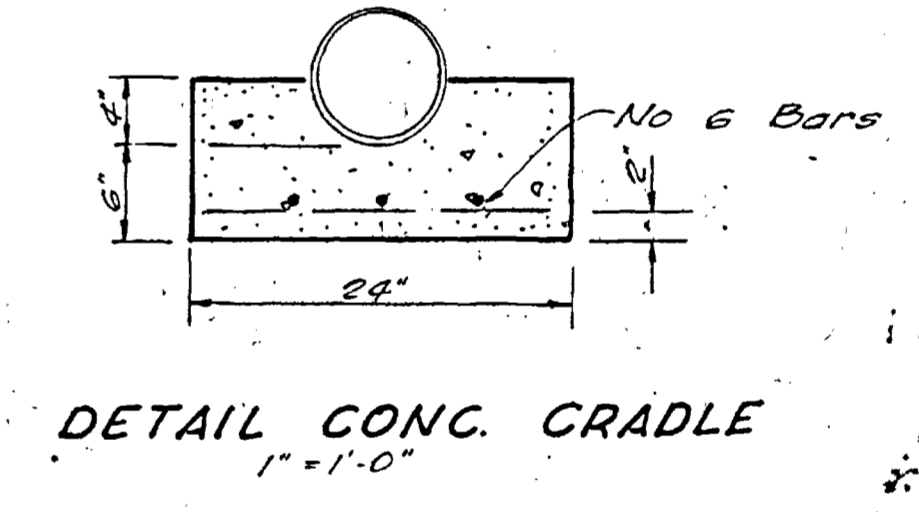


BY <u>B.G.T.</u> DATE <u>Feb 1960</u> DESCR <u>Grade & Alignment</u>	REVISIONS	DATE <u>October 1952</u> DRAWN <u>D.V.R.</u> JOB NO <u>G-205</u>	HAROLD HOSKINS & ASSOCIATES	FRUITVALE, COLORADO	66 SHEET NO
BY _____ DATE _____ DESCR _____		CHECKED <u>B.G.T.</u> FILE NO _____	ENGINEERING CONSULTANTS	WATER & SANITATION DISTRICT	12.
BY _____ DATE _____ DESCR _____		APPROVED _____ F.B. NO _____	GREELEY, COLORADO	LINCOLN, NEBRASKA	

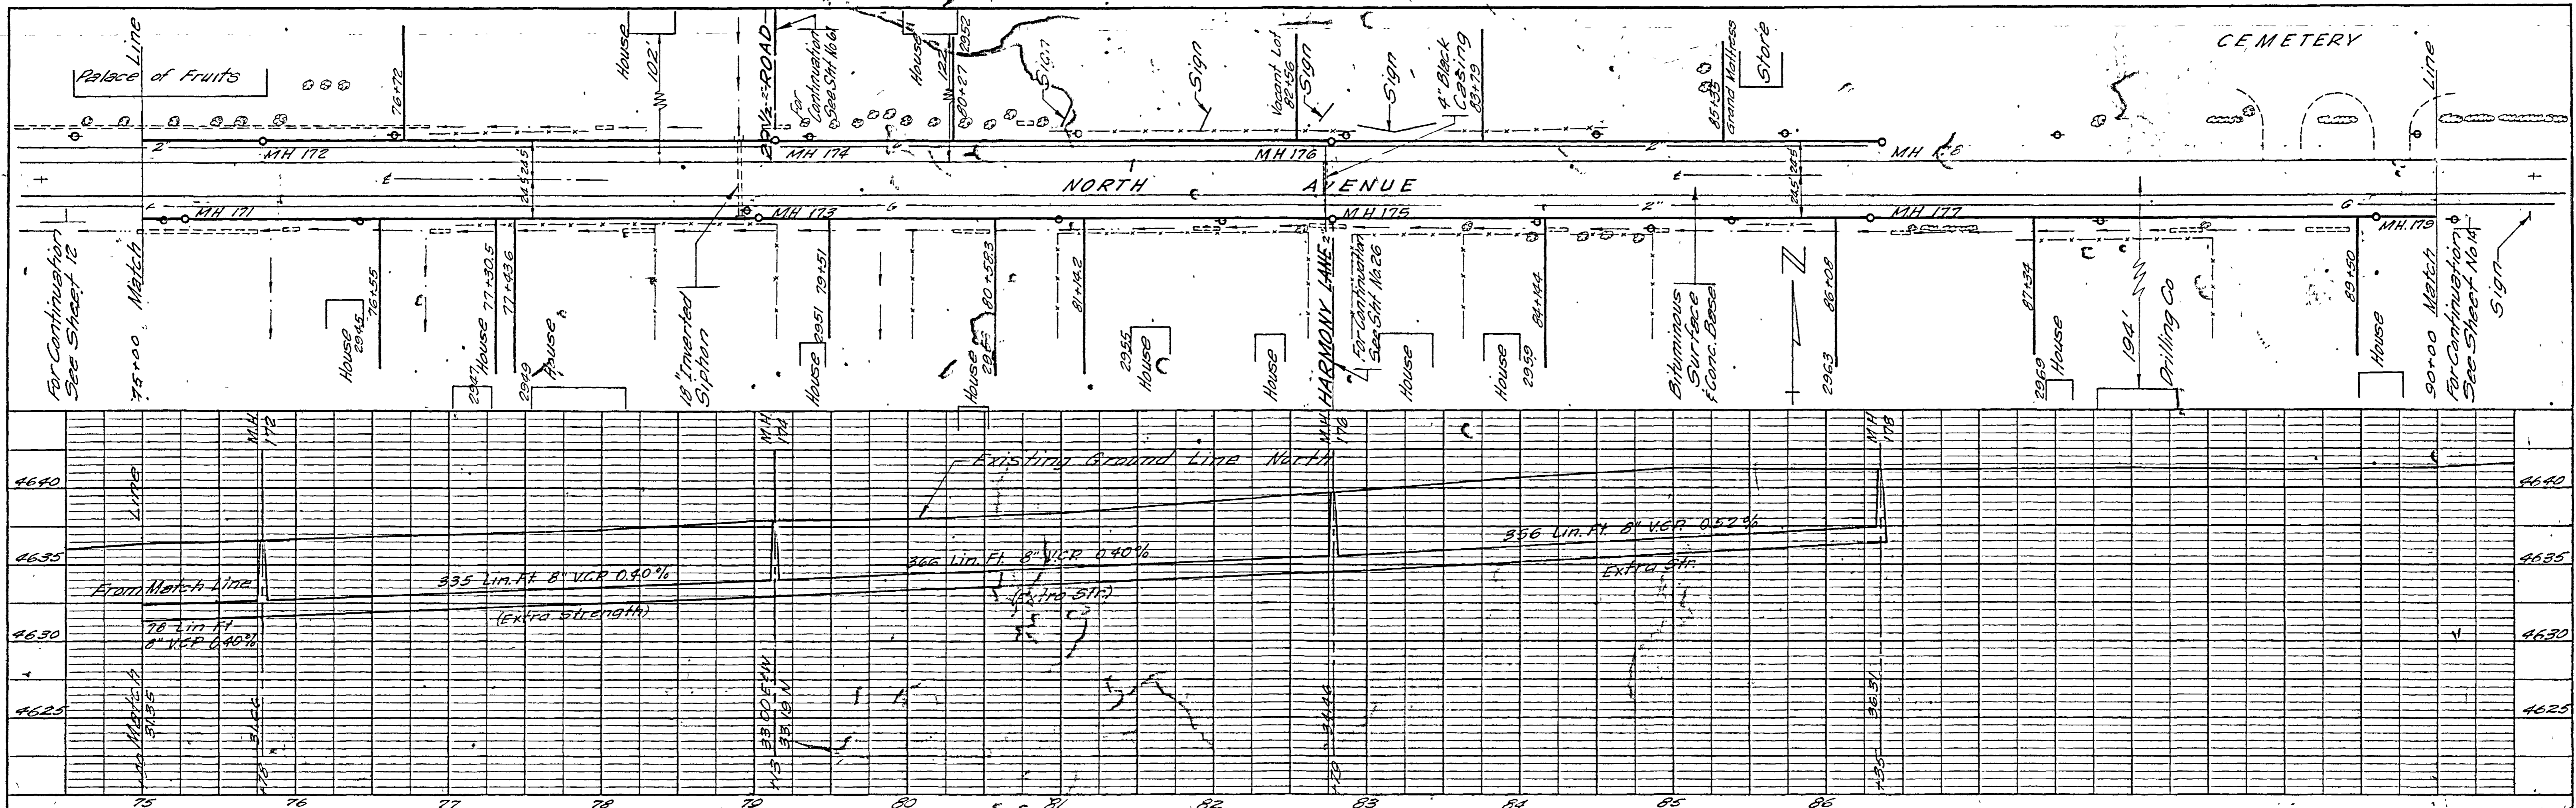

4640
4635
4630
4625

NOTE: Special Backfill Req'd. Sta 75+00 to Sta 90+00
 (0-5') Trench Depth = 740 Lin. Ft.
 (5-6') Trench Depth = 610 Lin. Ft.
 (6-7') Trench Depth = 1115 Lin. Ft.
 (7-8') Trench Depth = 200 Lin. Ft.



SEE PLAN VIEW ABOVE

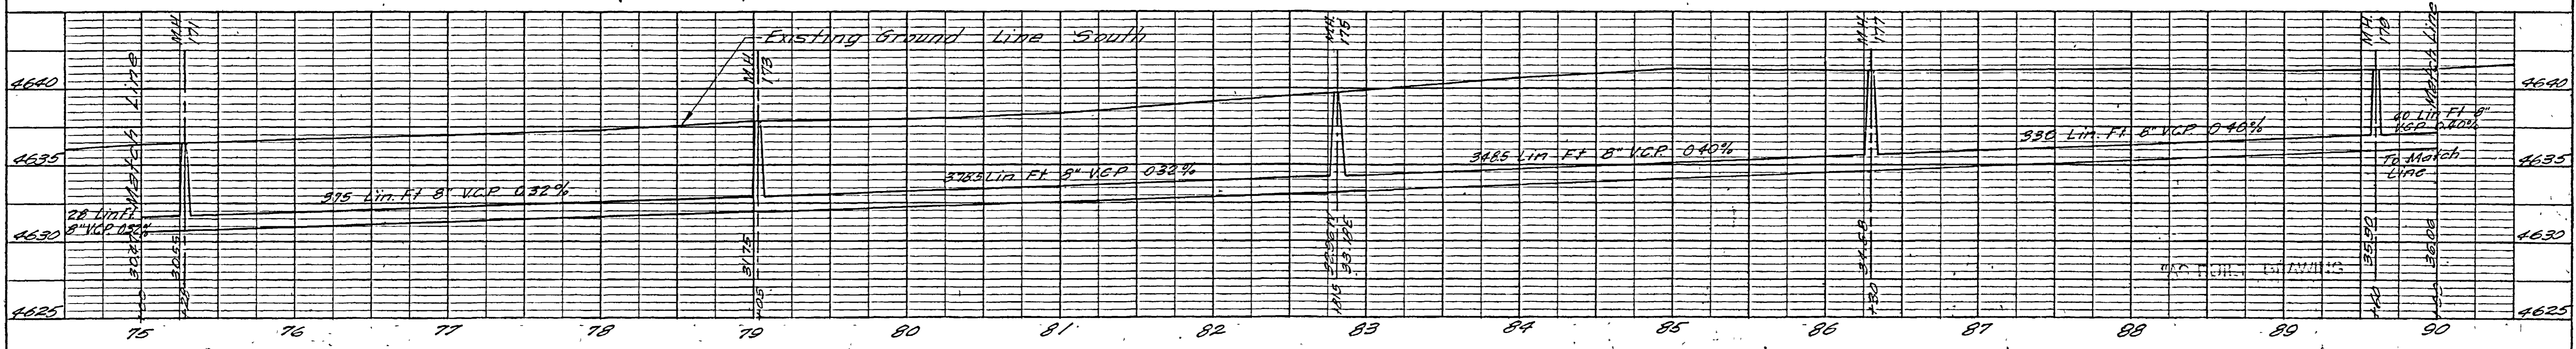



4640
4635
4630
4625

BY <u>RCT</u> DATE <u>Feb. 1960</u> DESCR <u>Grades & Alignment</u>	DATE <u>October 1957</u> DRAWN <u>RJR</u> JOB NO. <u>G-205</u>	HAROLD HOSKINS & ASSOCIATES	FRUITVALE, COLORADO	66 SHEET NO.
BY _____ DATE _____ DESCR _____	SCALE <u>1"=50'</u> CHECKED <u>RCT</u> FILE NO. _____	GREELEY, COLORADO	ENGINEERING CONSULTANTS	SHEETS
	APPROVED <u>[Signature]</u> FB NO. _____	LINCOLN, NEBRASKA	NORTH AVENUE—STA. 75+00 TO STA. 90+00	13

02081713.tif

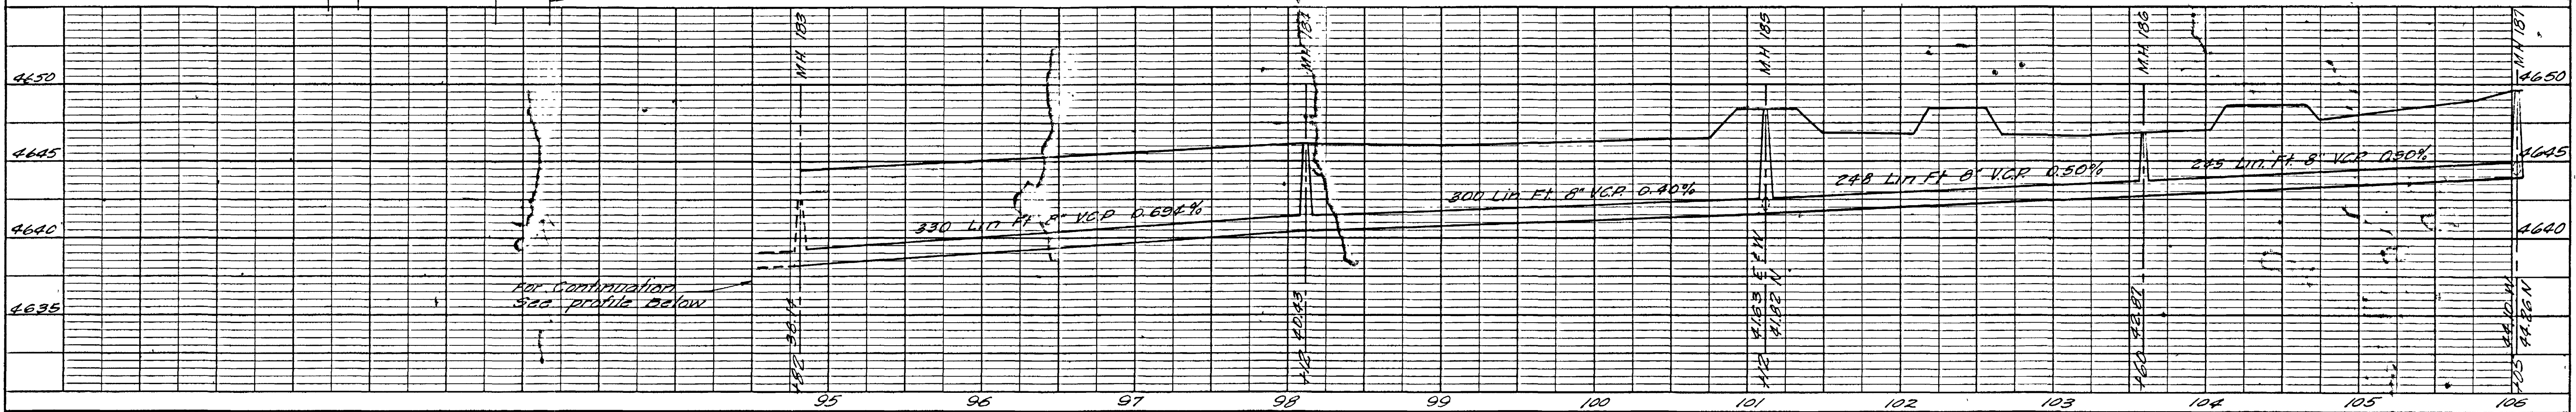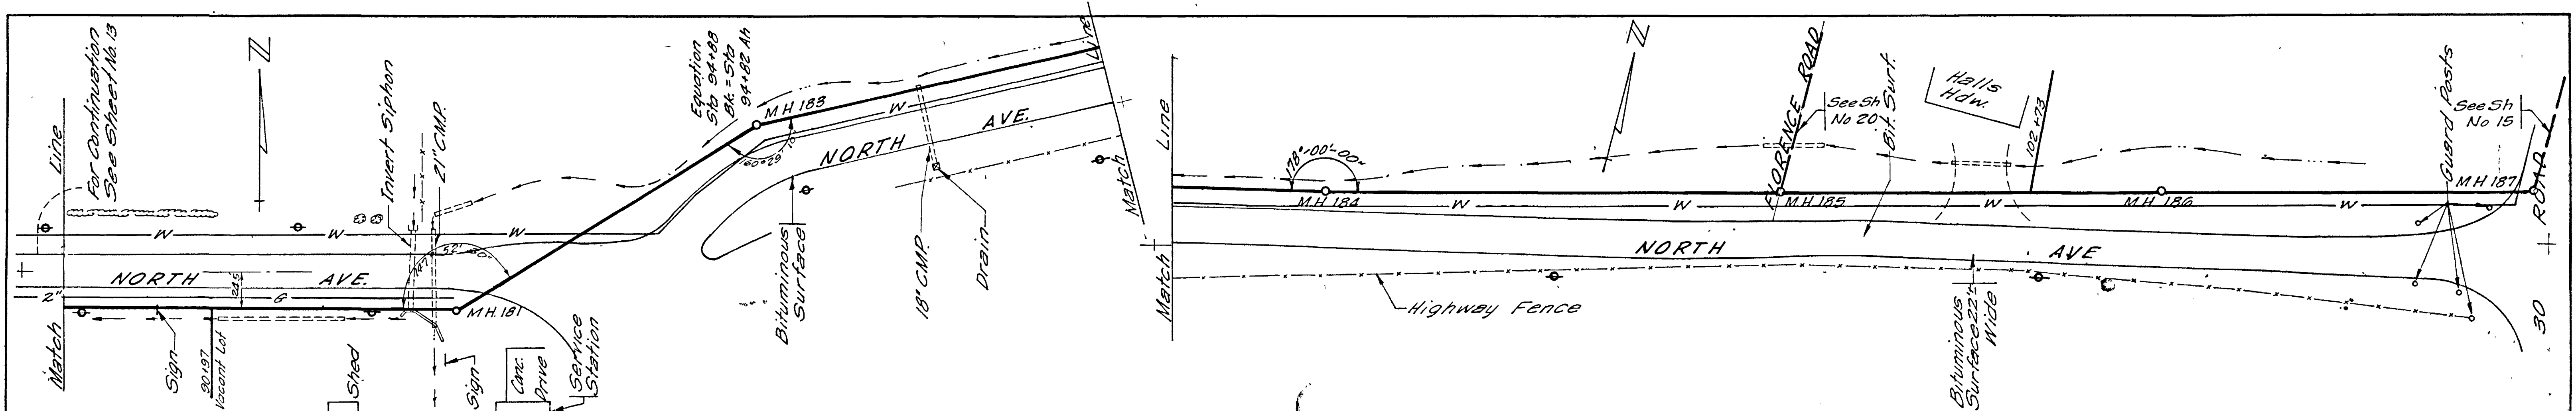


NOTE: Special Backfill Req'd Sta 9+00 to Sta 94+00
 (0'-5") Trench Depth = 30 Lin. Ft.
 (5'-6") Trench Depth = 350 Lin. Ft.

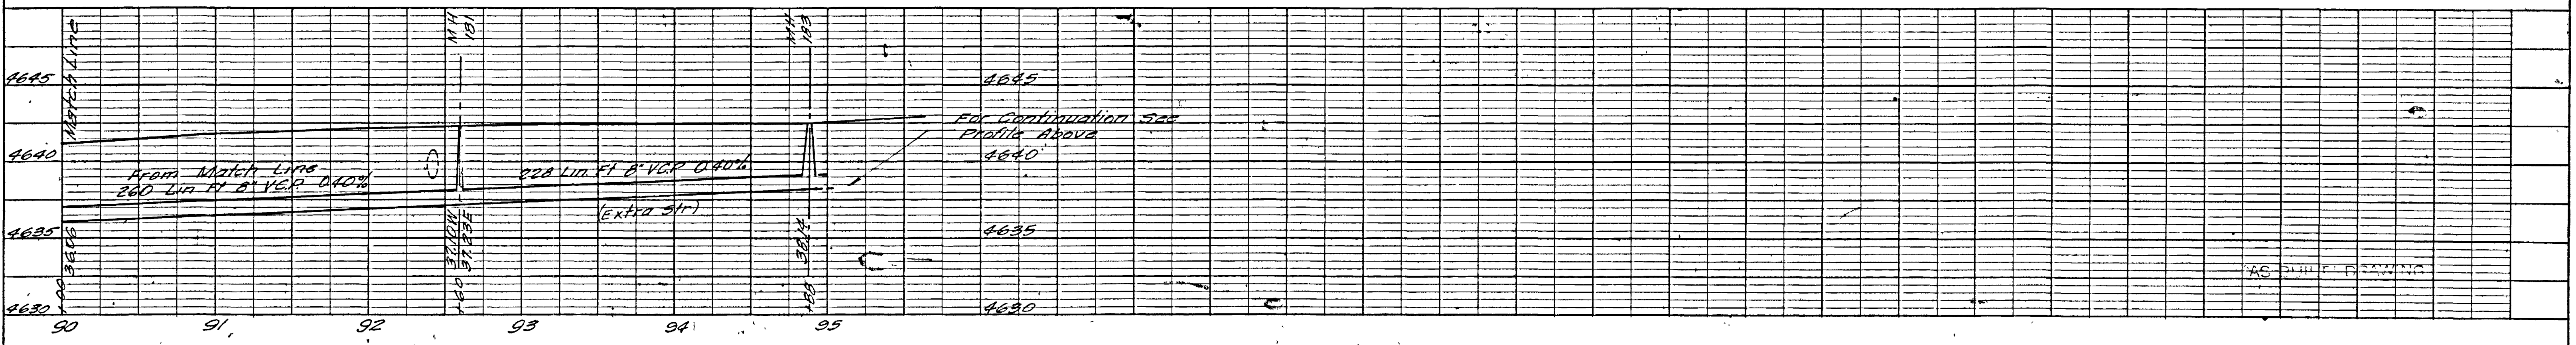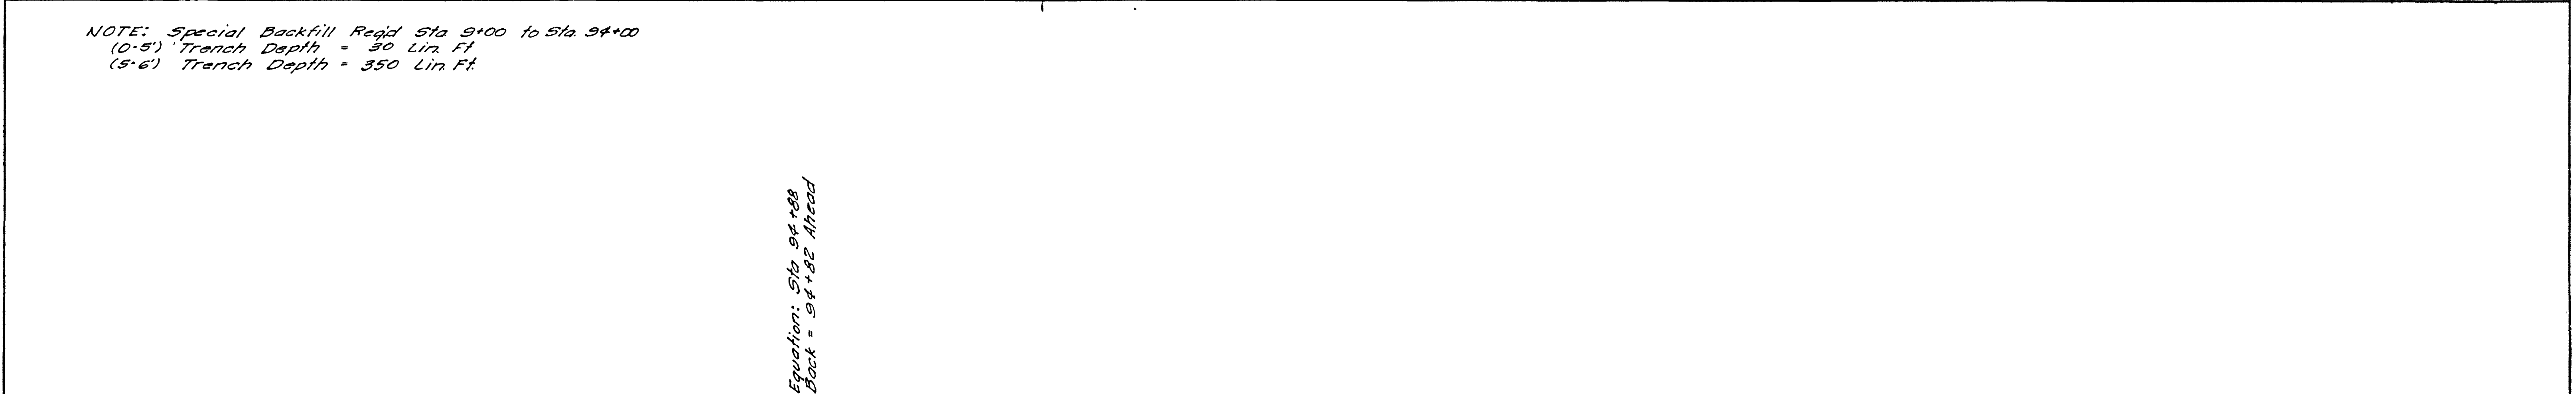


REVISIONS BY R.G.T. DATE Feb. 1960 SCR Grades & Alignment BY DATE DESCR BY DATE DESCR	DATE October 1957 SCALE 1"=50' DRAWN D.W.R. CHECKED R.G.T. APPROVED [Signature]	JOB NO. 22705 FILE NO. F.B. NO.	HAROLD HOSKINS & ASSOCIATES ENGINEERING CONSULTANTS GREELEY, COLORADO LINCOLN, NEBRASKA	FRUITVALE, COLORADO WATER & SANITATION DISTRICT	NORTH AVENUE—STA. 90+00 TO STA. 106+05 66 SHEETS SHEET NO. 14
------------------------------------------------------------------------------------------------	---------------------------------------------------------------------------------------------	---------------------------------------	-----------------------------------------------------------------------------------------------	----------------------------------------------------	---------------------------------------------------------------------



02081714.tif

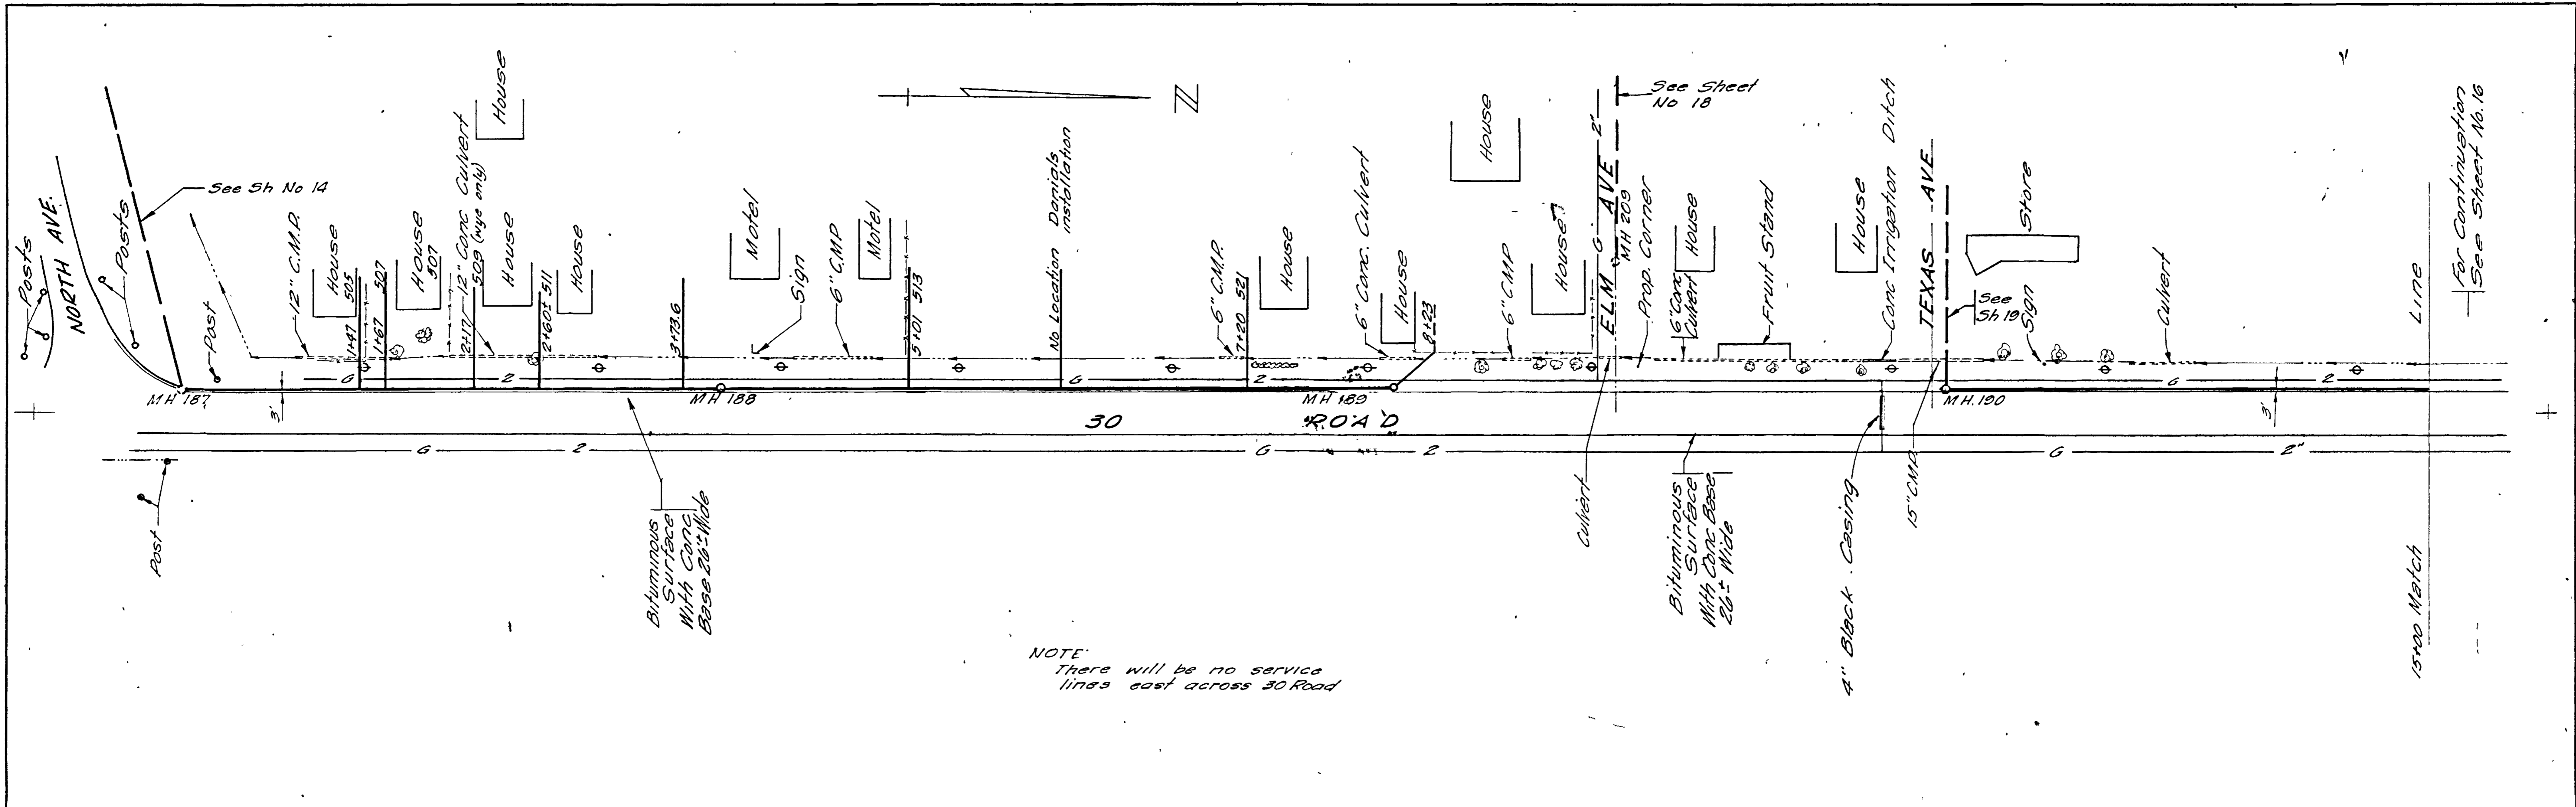



NOTE
There will be no service lines east across 30 Road

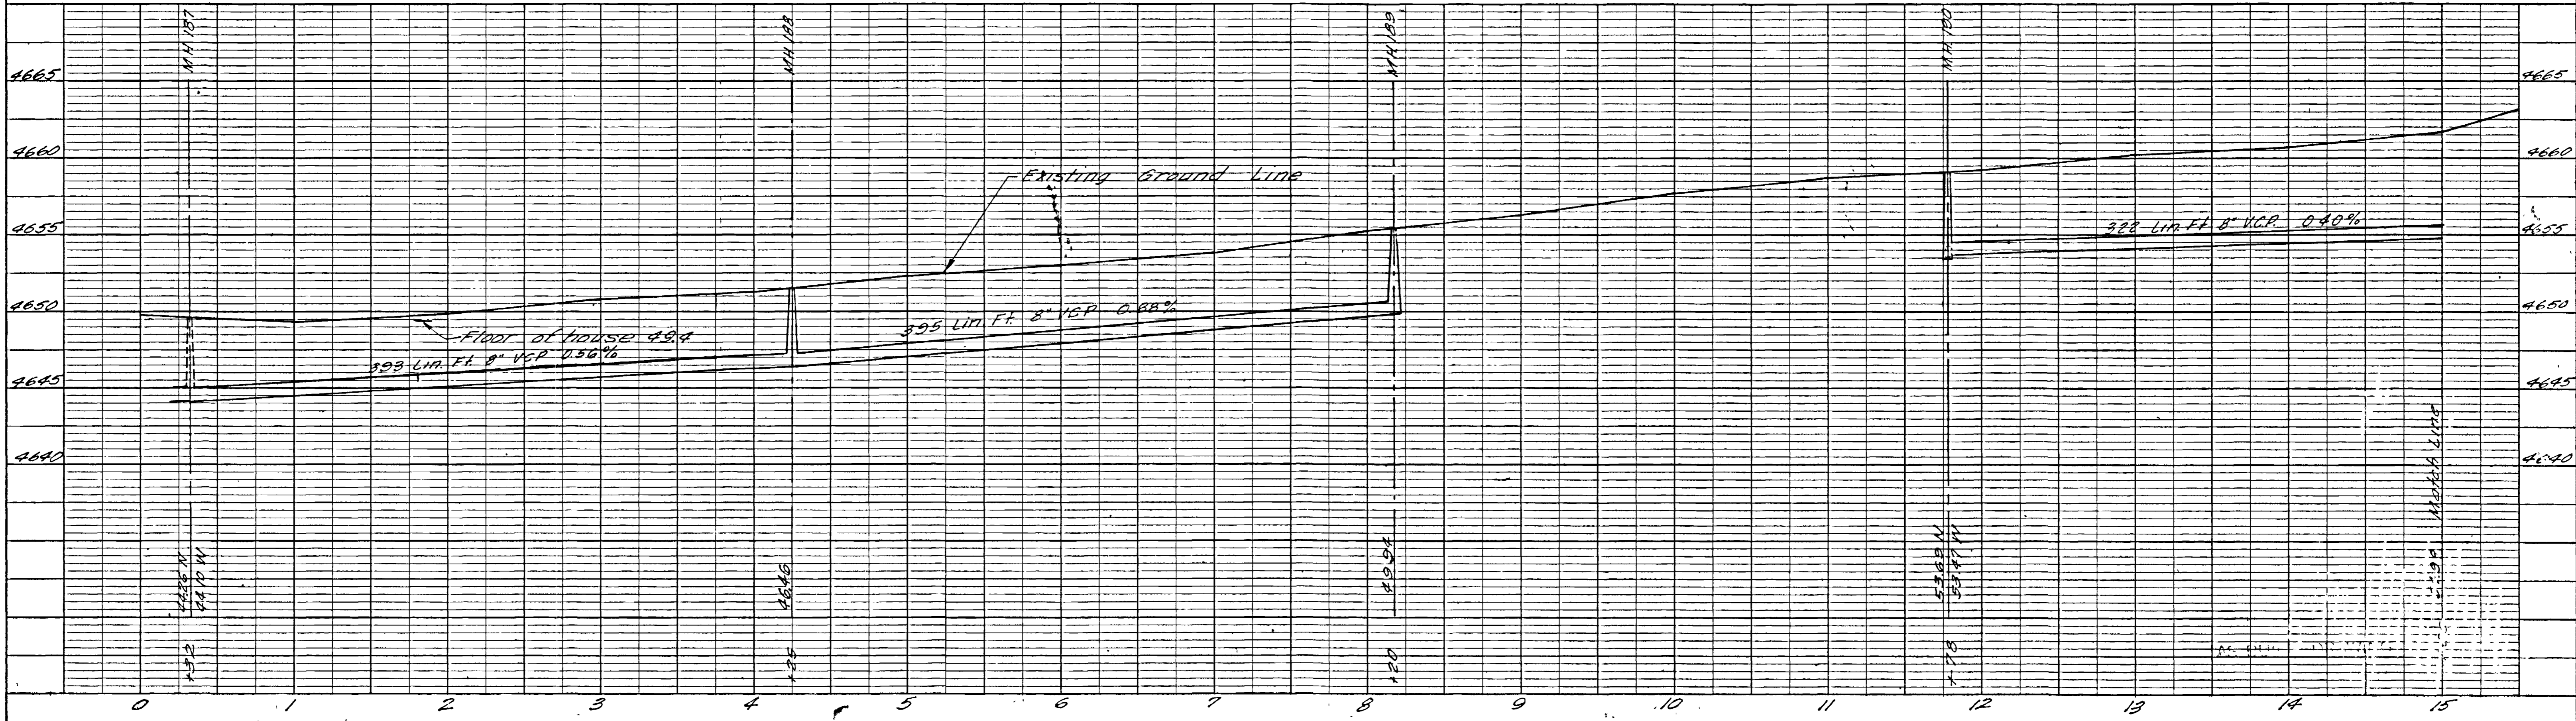




REVISIONS BY: <u>RLT</u> DATE: <u>Feb 1960</u> DESCR: <u>grades</u> BY: _____ DATE: _____ DESCR: _____ BY: _____ DATE: _____ DESCR: _____		DATE: <u>October 1957</u> DRAWN: <u>D.V.R.</u> JOB NO: <u>G-205</u> CHECKED: <u>RLT</u> FILE NO: _____ APPROVED: <u>[Signature]</u> F.B. NO: _____	HAROLD HOSKINS & ASSOCIATES ENGINEERING CONSULTANTS GREELEY, COLORADO LINCOLN, NEBRASKA	FRUITVALE, COLORADO WATER & SANITATION DISTRICT	30 ROAD NORTH OF NORTH AVENUE STA 0+00 TO STA. 15+00	66 SHEET NO SHEETS 15
----------------------------------------------------------------------------------------------------------------------------------------------------	--	----------------------------------------------------------------------------------------------------------------------------------------------------------	----------------------------------------------------------------------------------------------------	----------------------------------------------------	---------------------------------------------------------	--------------------------

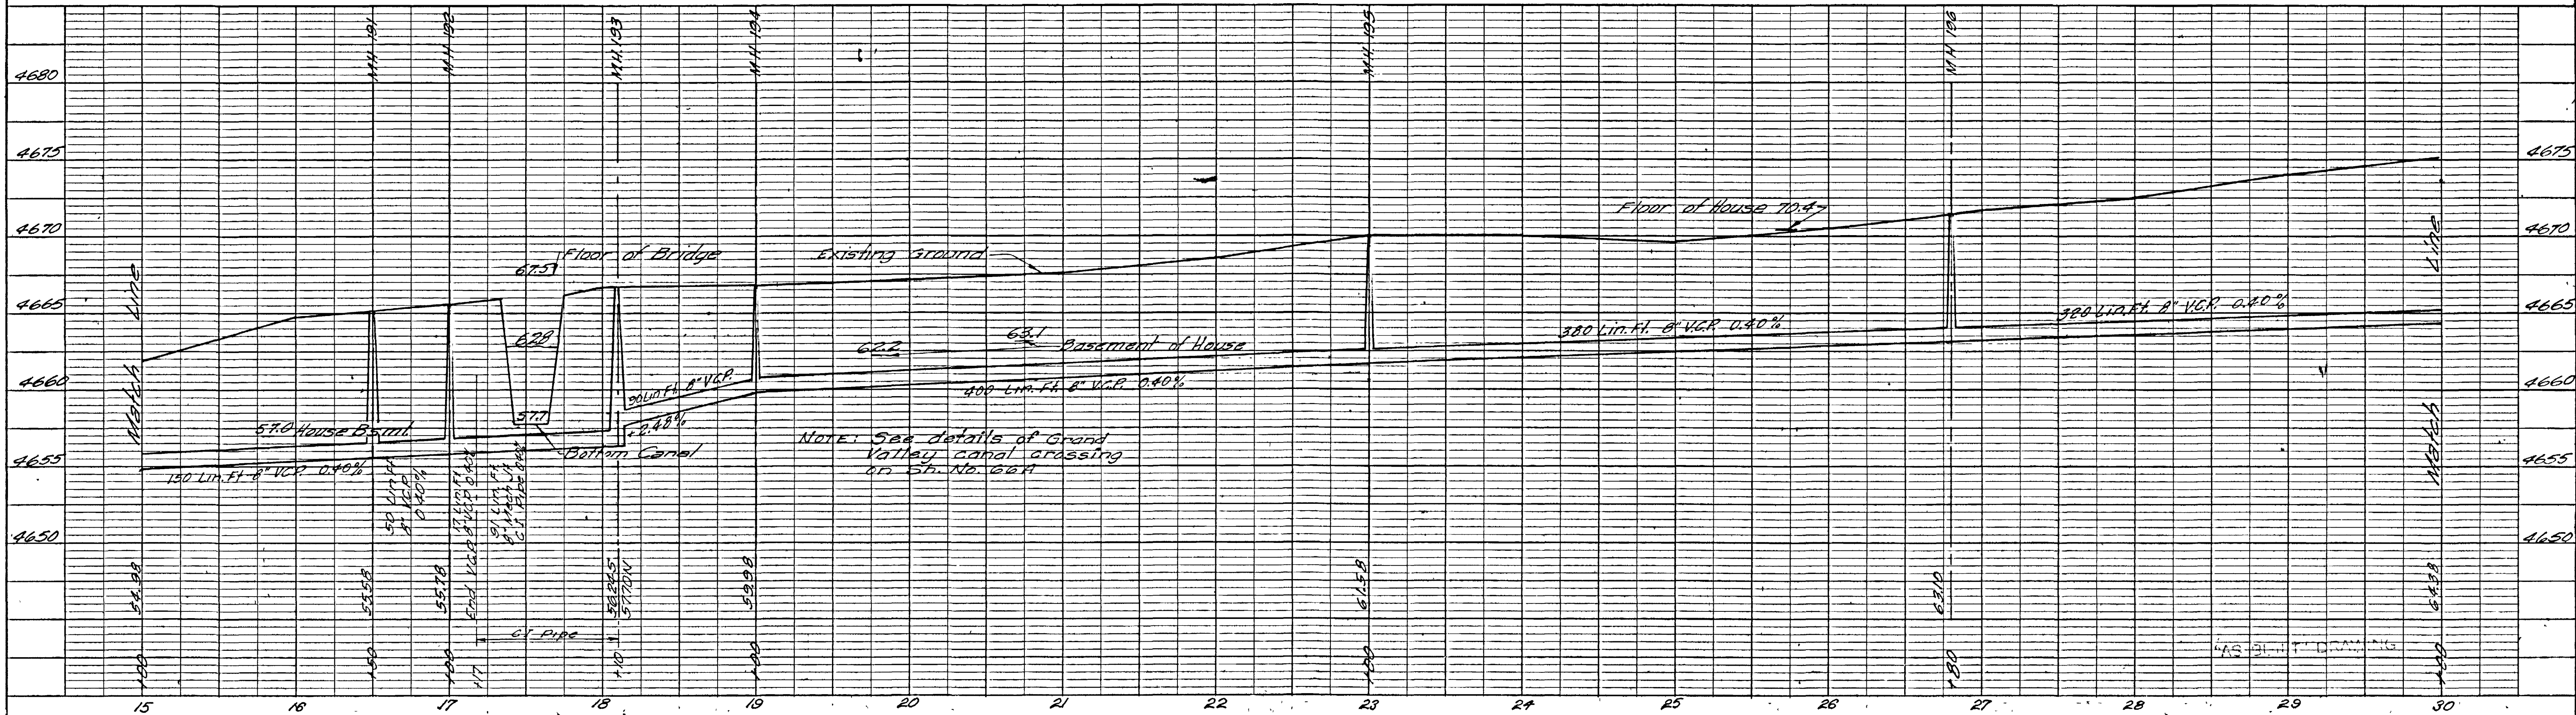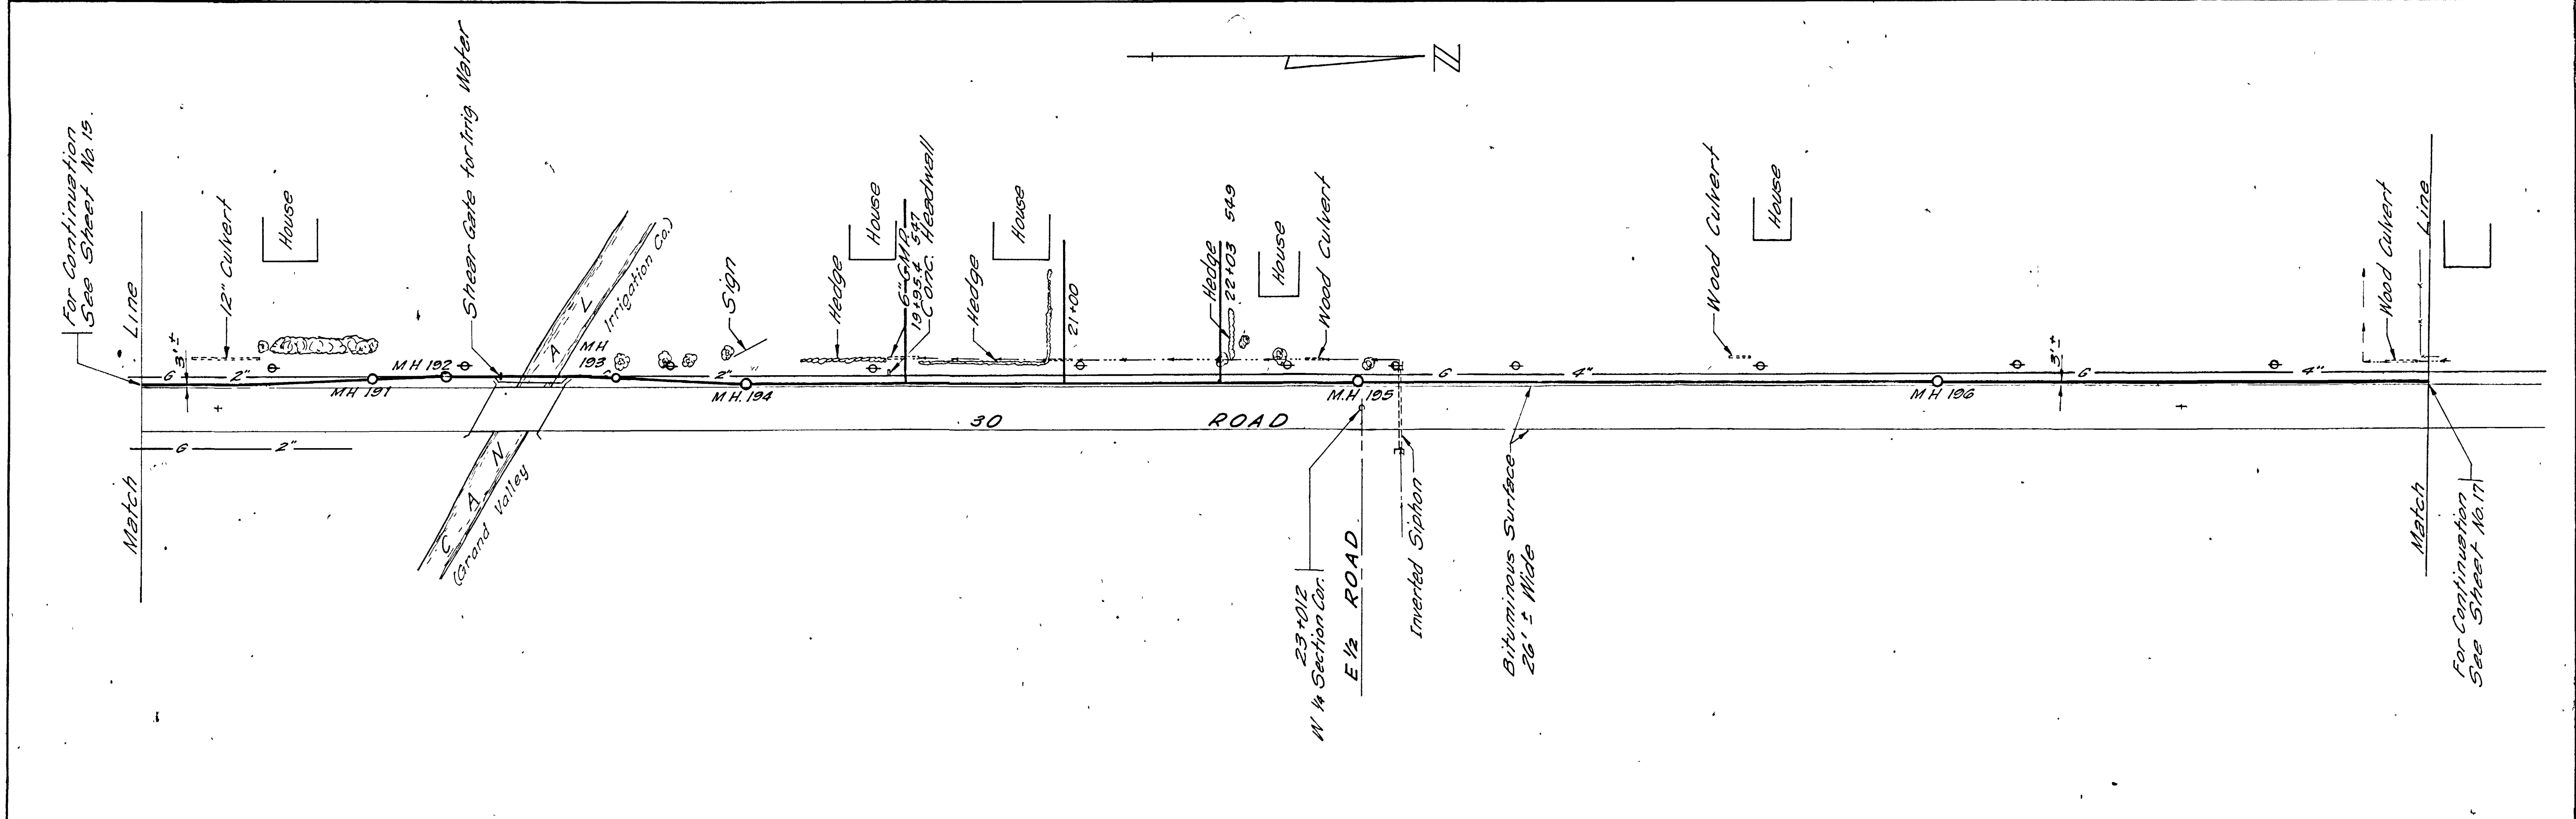

REVISIONS BY: R.G.T. DATE: Feb 1960 DESCR: Grades BY: DATE: DESCR:		DATE: October 1957 DRAWN: R.V.R. JOB NO: G-805 CHECKED: R.G.T. FILE NO: SCALE: 1"=50' APPROVED: [Signature] F.B. NO.:		HAROLD HOSKINS & ASSOCIATES ENGINEERING CONSULTANTS GREELEY, COLORADO LINCOLN, NEBRASKA		FRUITVALE, COLORADO WATER & SANITATION DISTRICT		30 ROAD STA. 15+00 TO STA. 30+00		66 SHEET NO SHEETS 16	
--------------------------------------------------------------------------	--	-----------------------------------------------------------------------------------------------------------------------------	--	-----------------------------------------------------------------------------------------------	--	----------------------------------------------------	--	----------------------------------	--	--------------------------	--


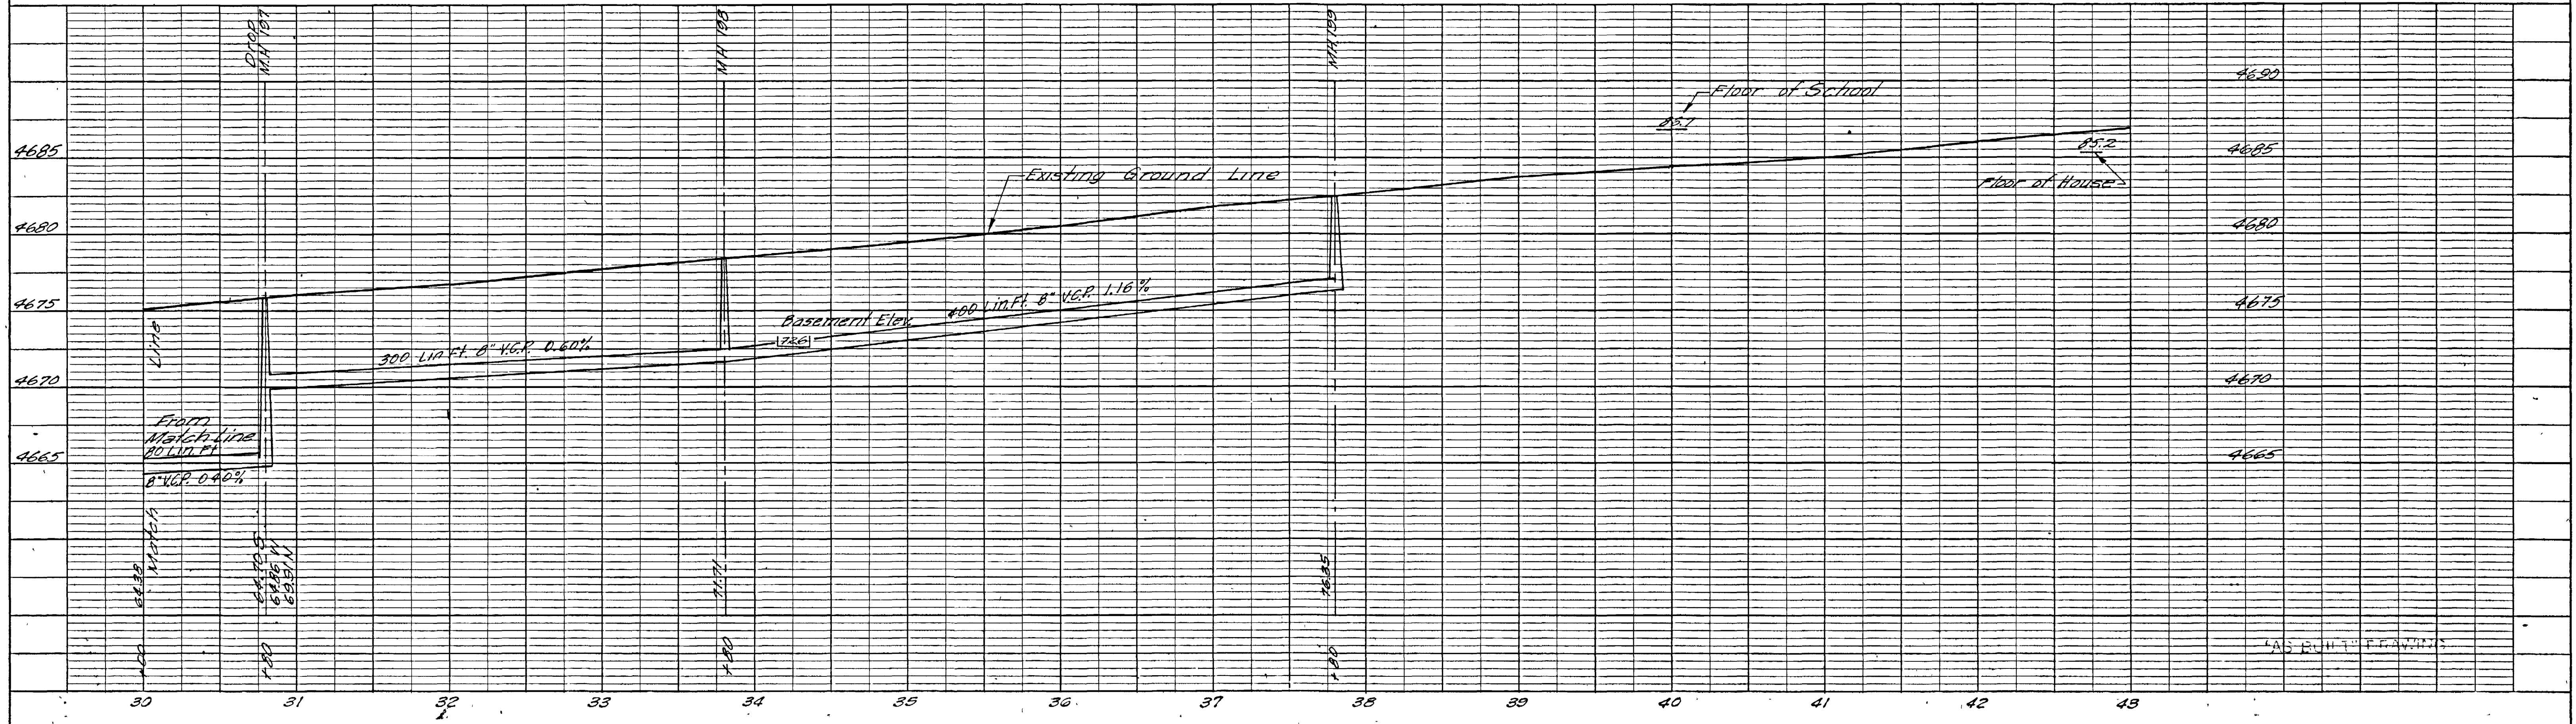
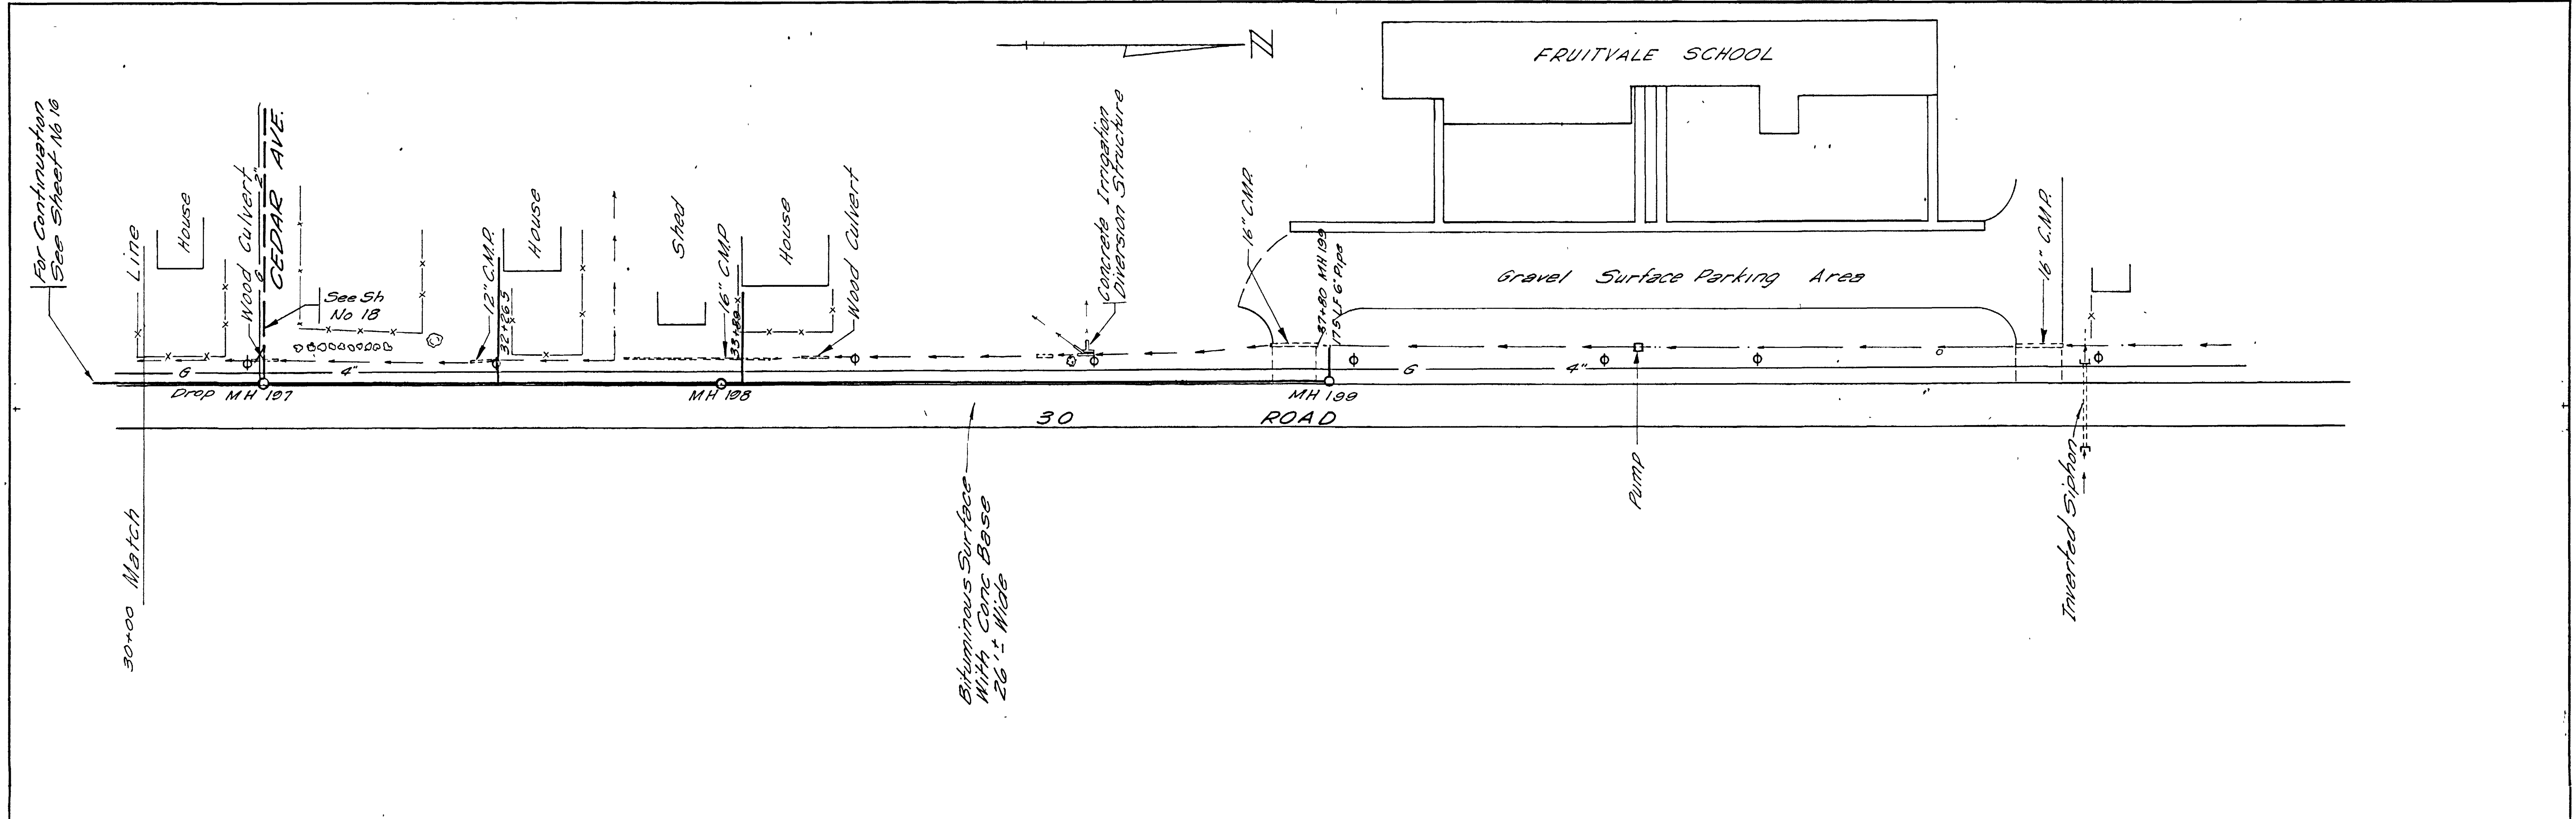


REVISIONS BY: RGT DATE: Feb 1960 DESCR: Grades & Alignment BY: DATE: DESCR:	DATE: October 1957 DRAWN: R.M.R. CHECKED: R.C.T. SCALE: 1/2" = 50' APPROVED: [Signature]	JOB NO: B-206 FILE NO: F.B. NO:	HAROLD HOSKINS & ASSOCIATES ENGINEERING CONSULTANTS GREELEY, COLORADO LINCOLN, NEBRASKA	FRUITVALE, COLORADO WATER & SANITATION DISTRICT	30 ROAD STA. 30+00 TO STA. 40+00	66 SHEET NO SHEETS 17
-----------------------------------------------------------------------------------	------------------------------------------------------------------------------------------------	---------------------------------------	-----------------------------------------------------------------------------------------------	----------------------------------------------------	----------------------------------	--------------------------

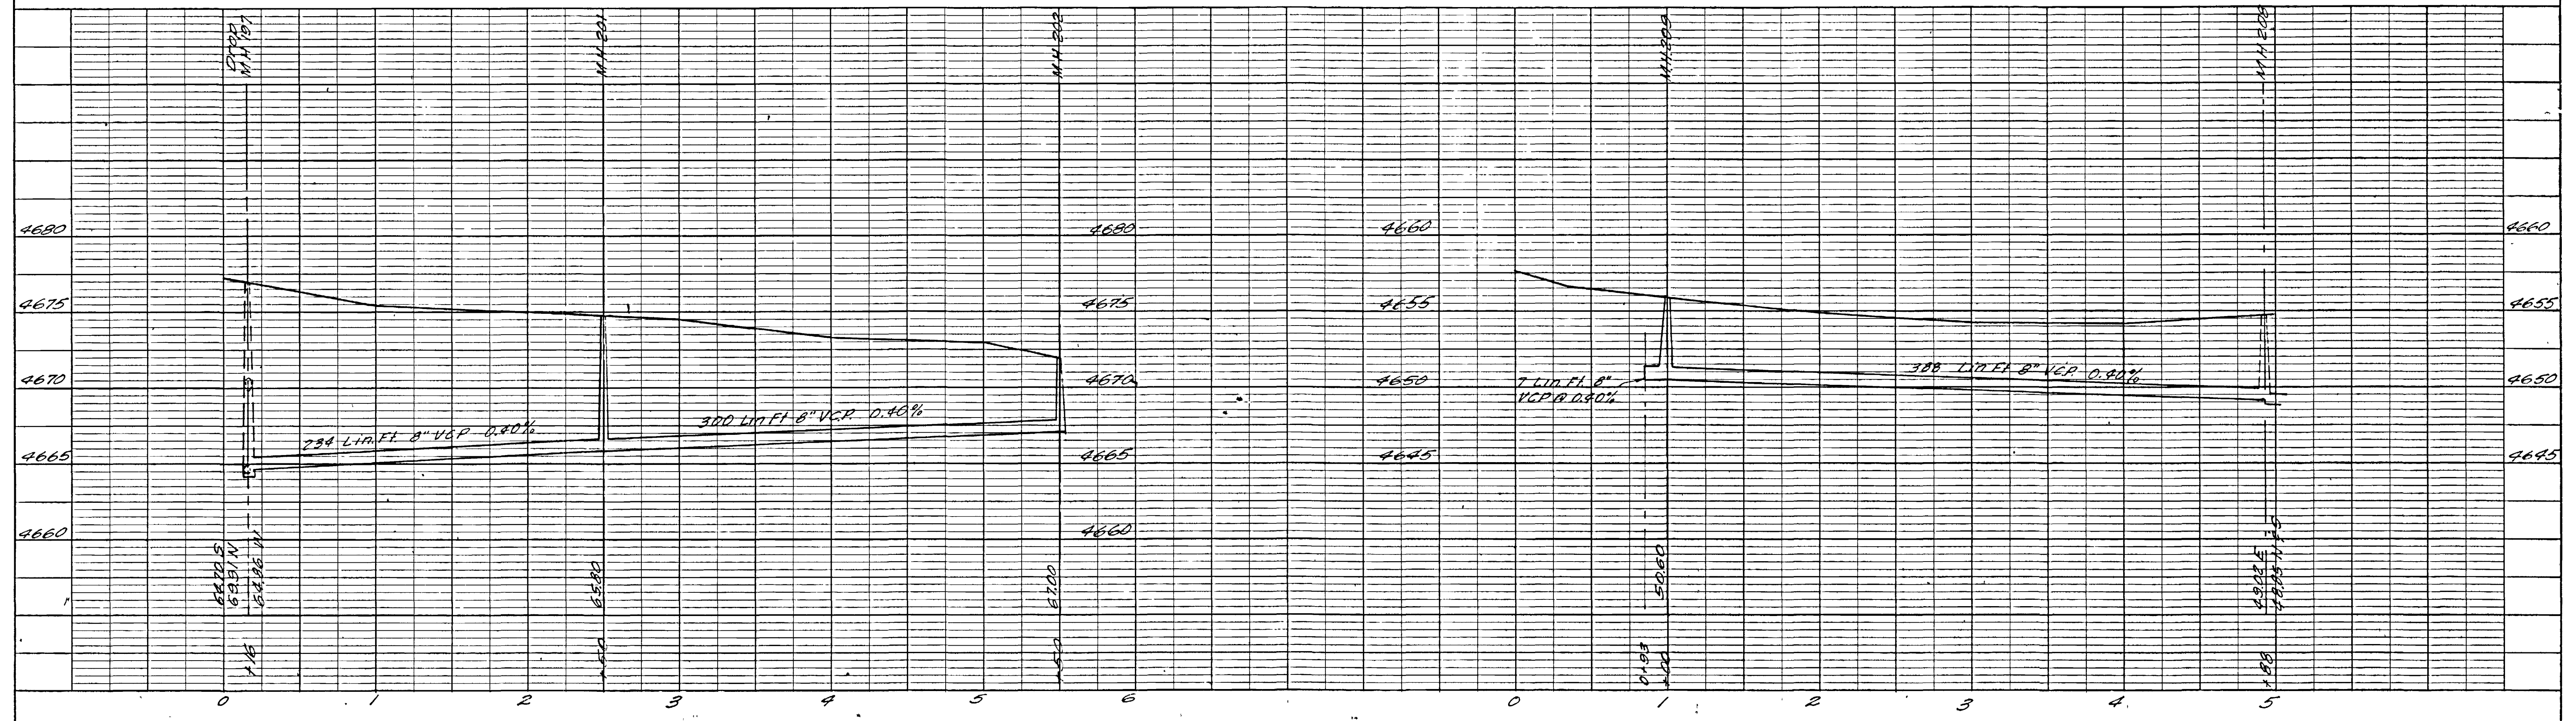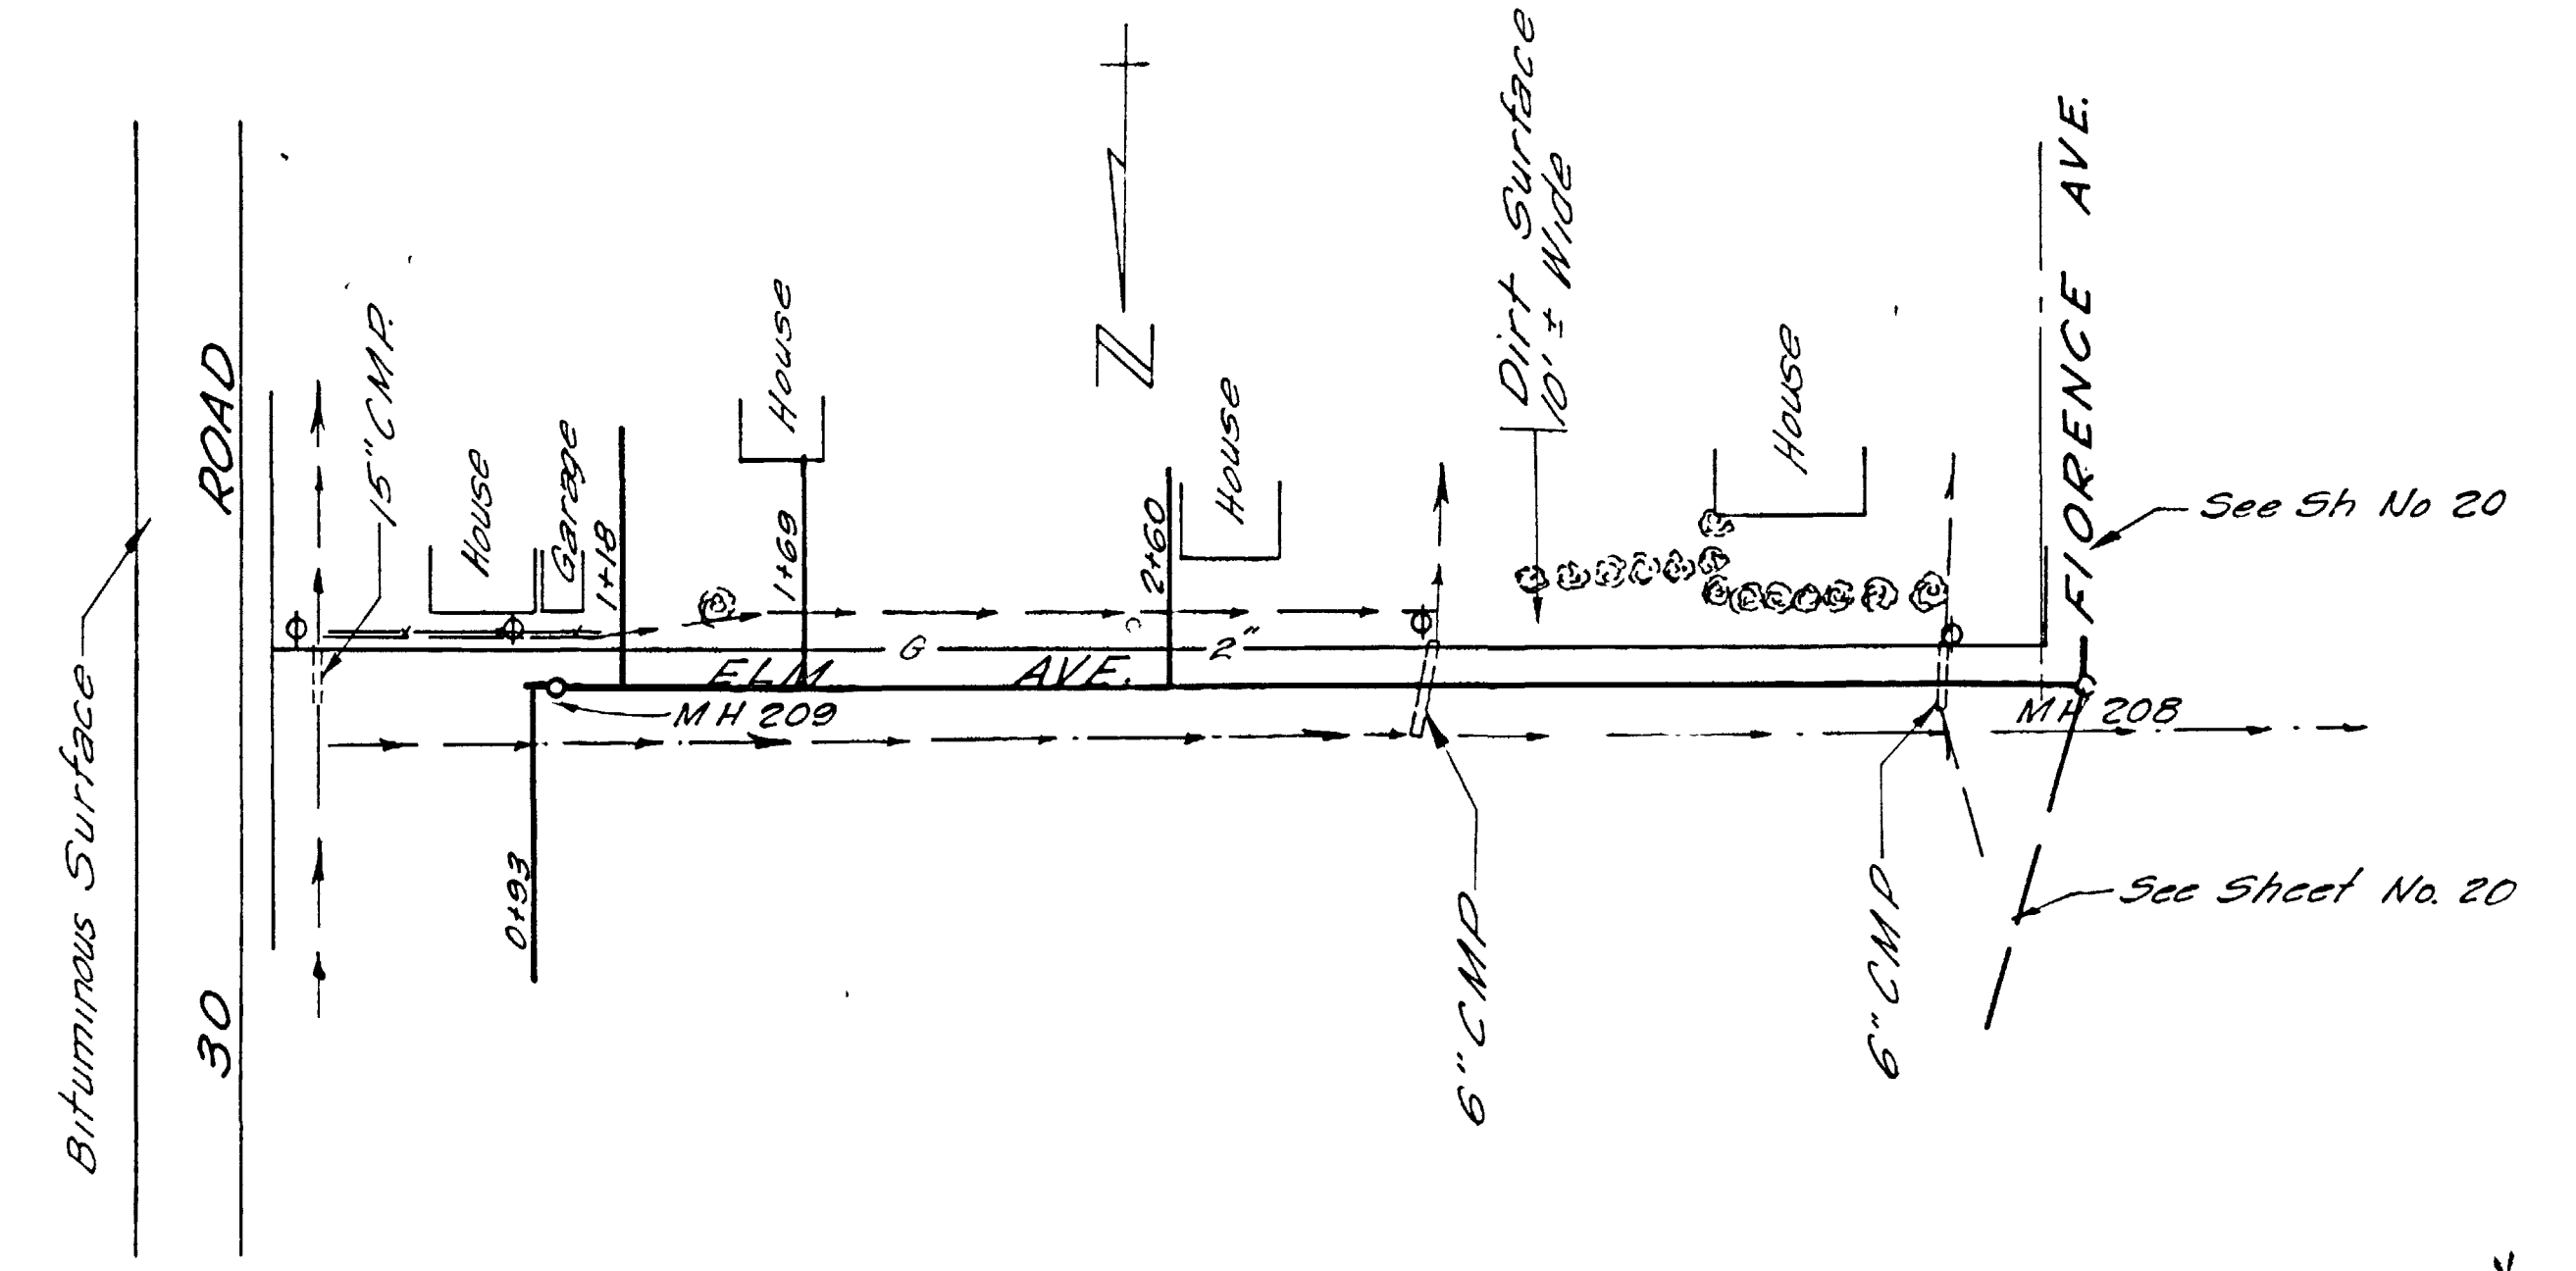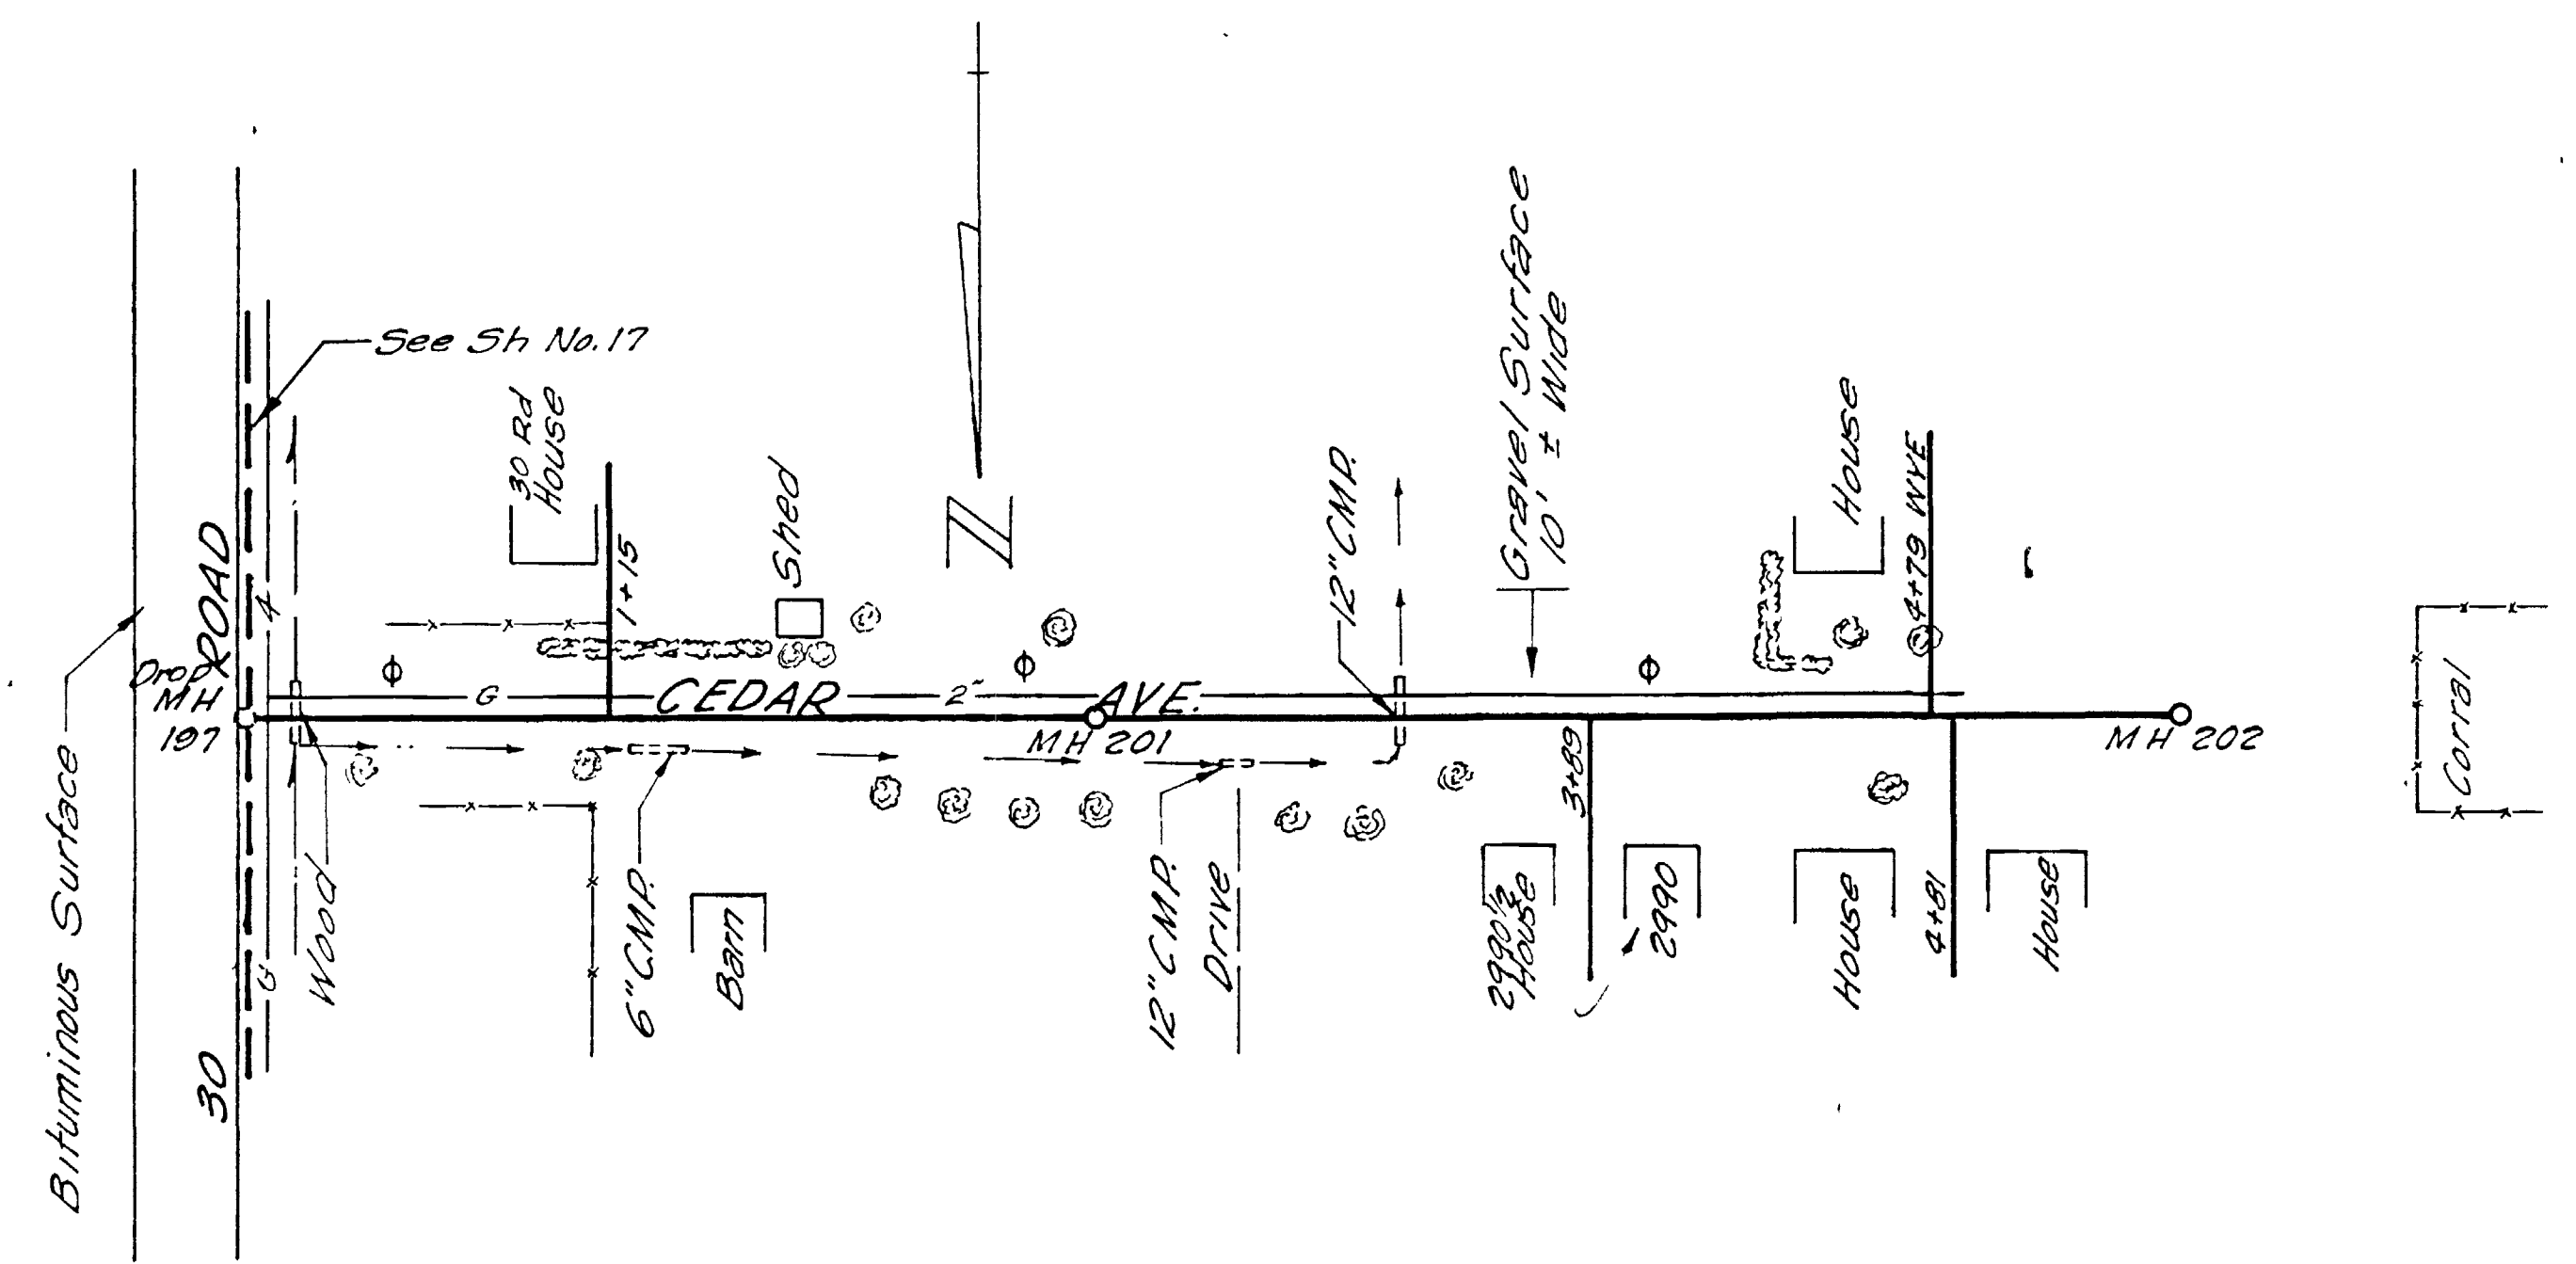

REVISIONS BY: RCT DATE: Feb. 1960 DESC: <i>Grade & Alignment</i>		DATE: <i>October 1957</i> SCALE: <i>Horiz. 1" = 50'</i> <i>Vert. 1" = 5'</i>	DRAWN: <i>DKR</i> CHECKED: <i>RCT</i> APPROVED: <i>[Signature]</i>	JOB NO: <i>6-2225</i> FILE NO: F B NO:	HAROLD HOSKINS & ASSOCIATES ENGINEERING CONSULTANTS GREELEY, COLORADO LINCOLN, NEBRASKA	FRUITVALE, COLORADO WATER & SANITATION DISTRICT	CEDAR AVENUE ELM AVENUE WEST OF 30 ROAD	66 SHEETS SHEET NO. 18
-------------------------------------------------------------------------	--	------------------------------------------------------------------------------------	--------------------------------------------------------------------------	----------------------------------------------	----------------------------------------------------------------------------------------------------	----------------------------------------------------	--------------------------------------------	---------------------------

02081718.tif

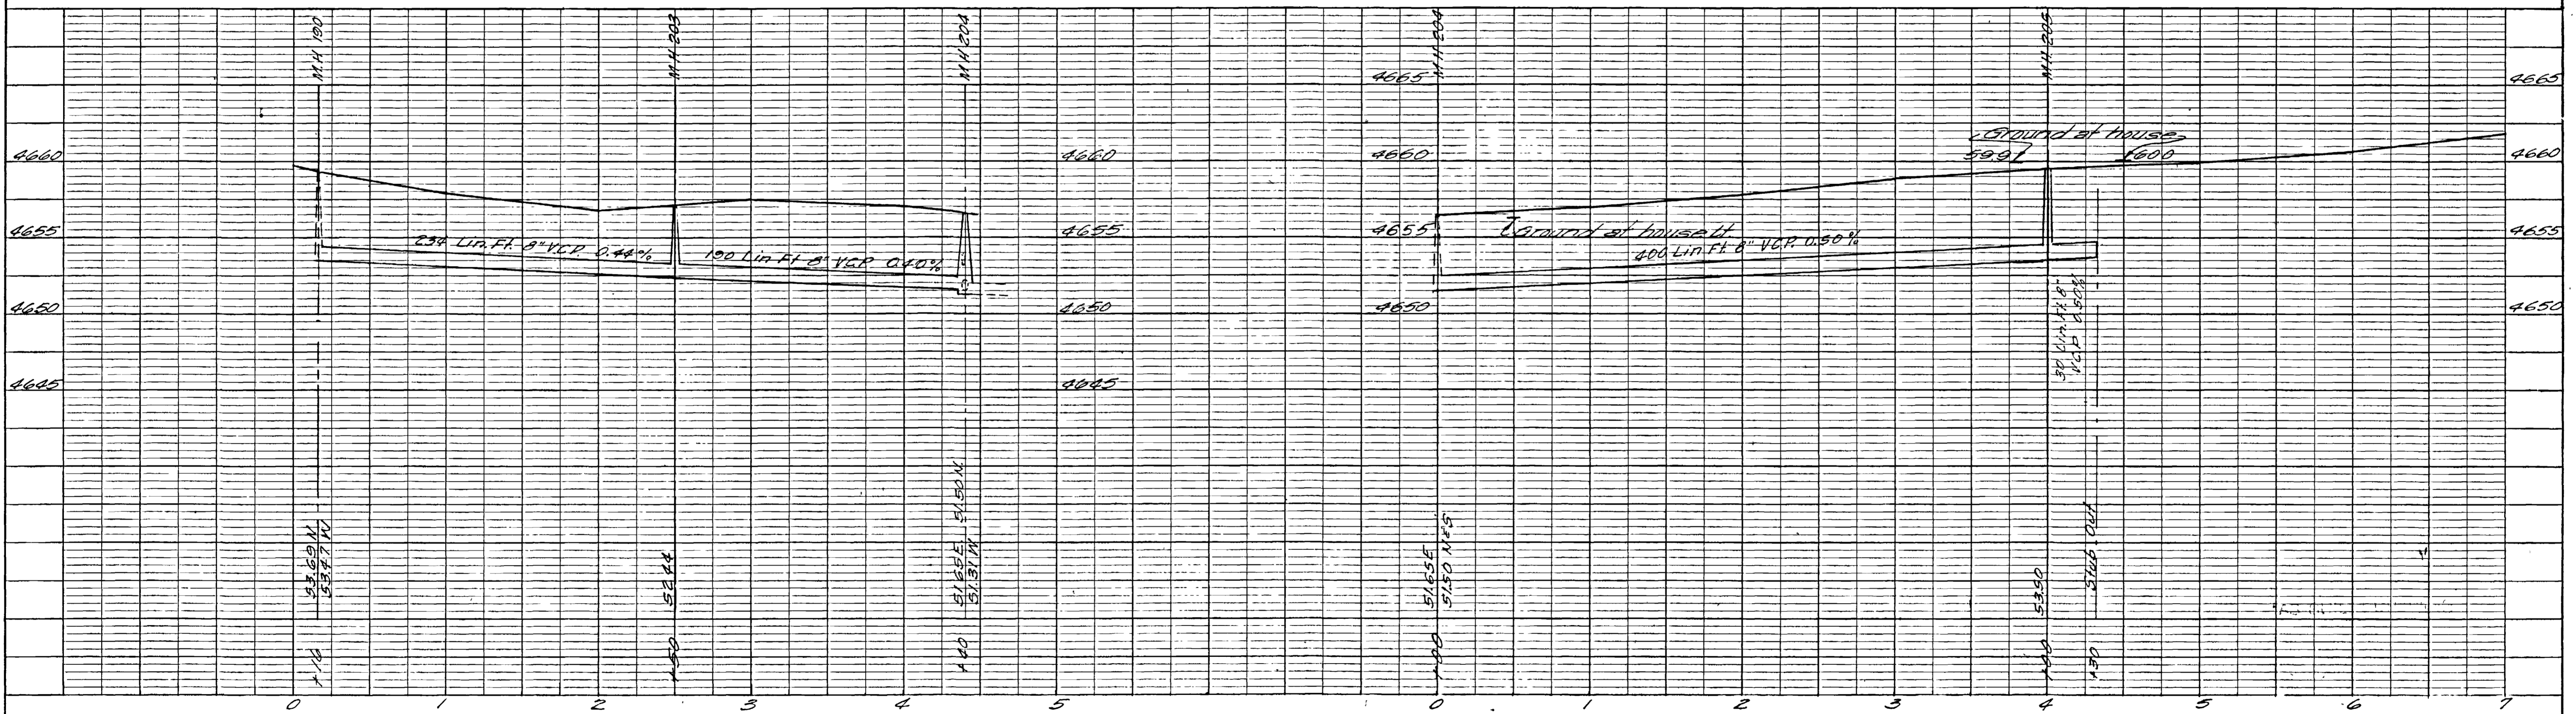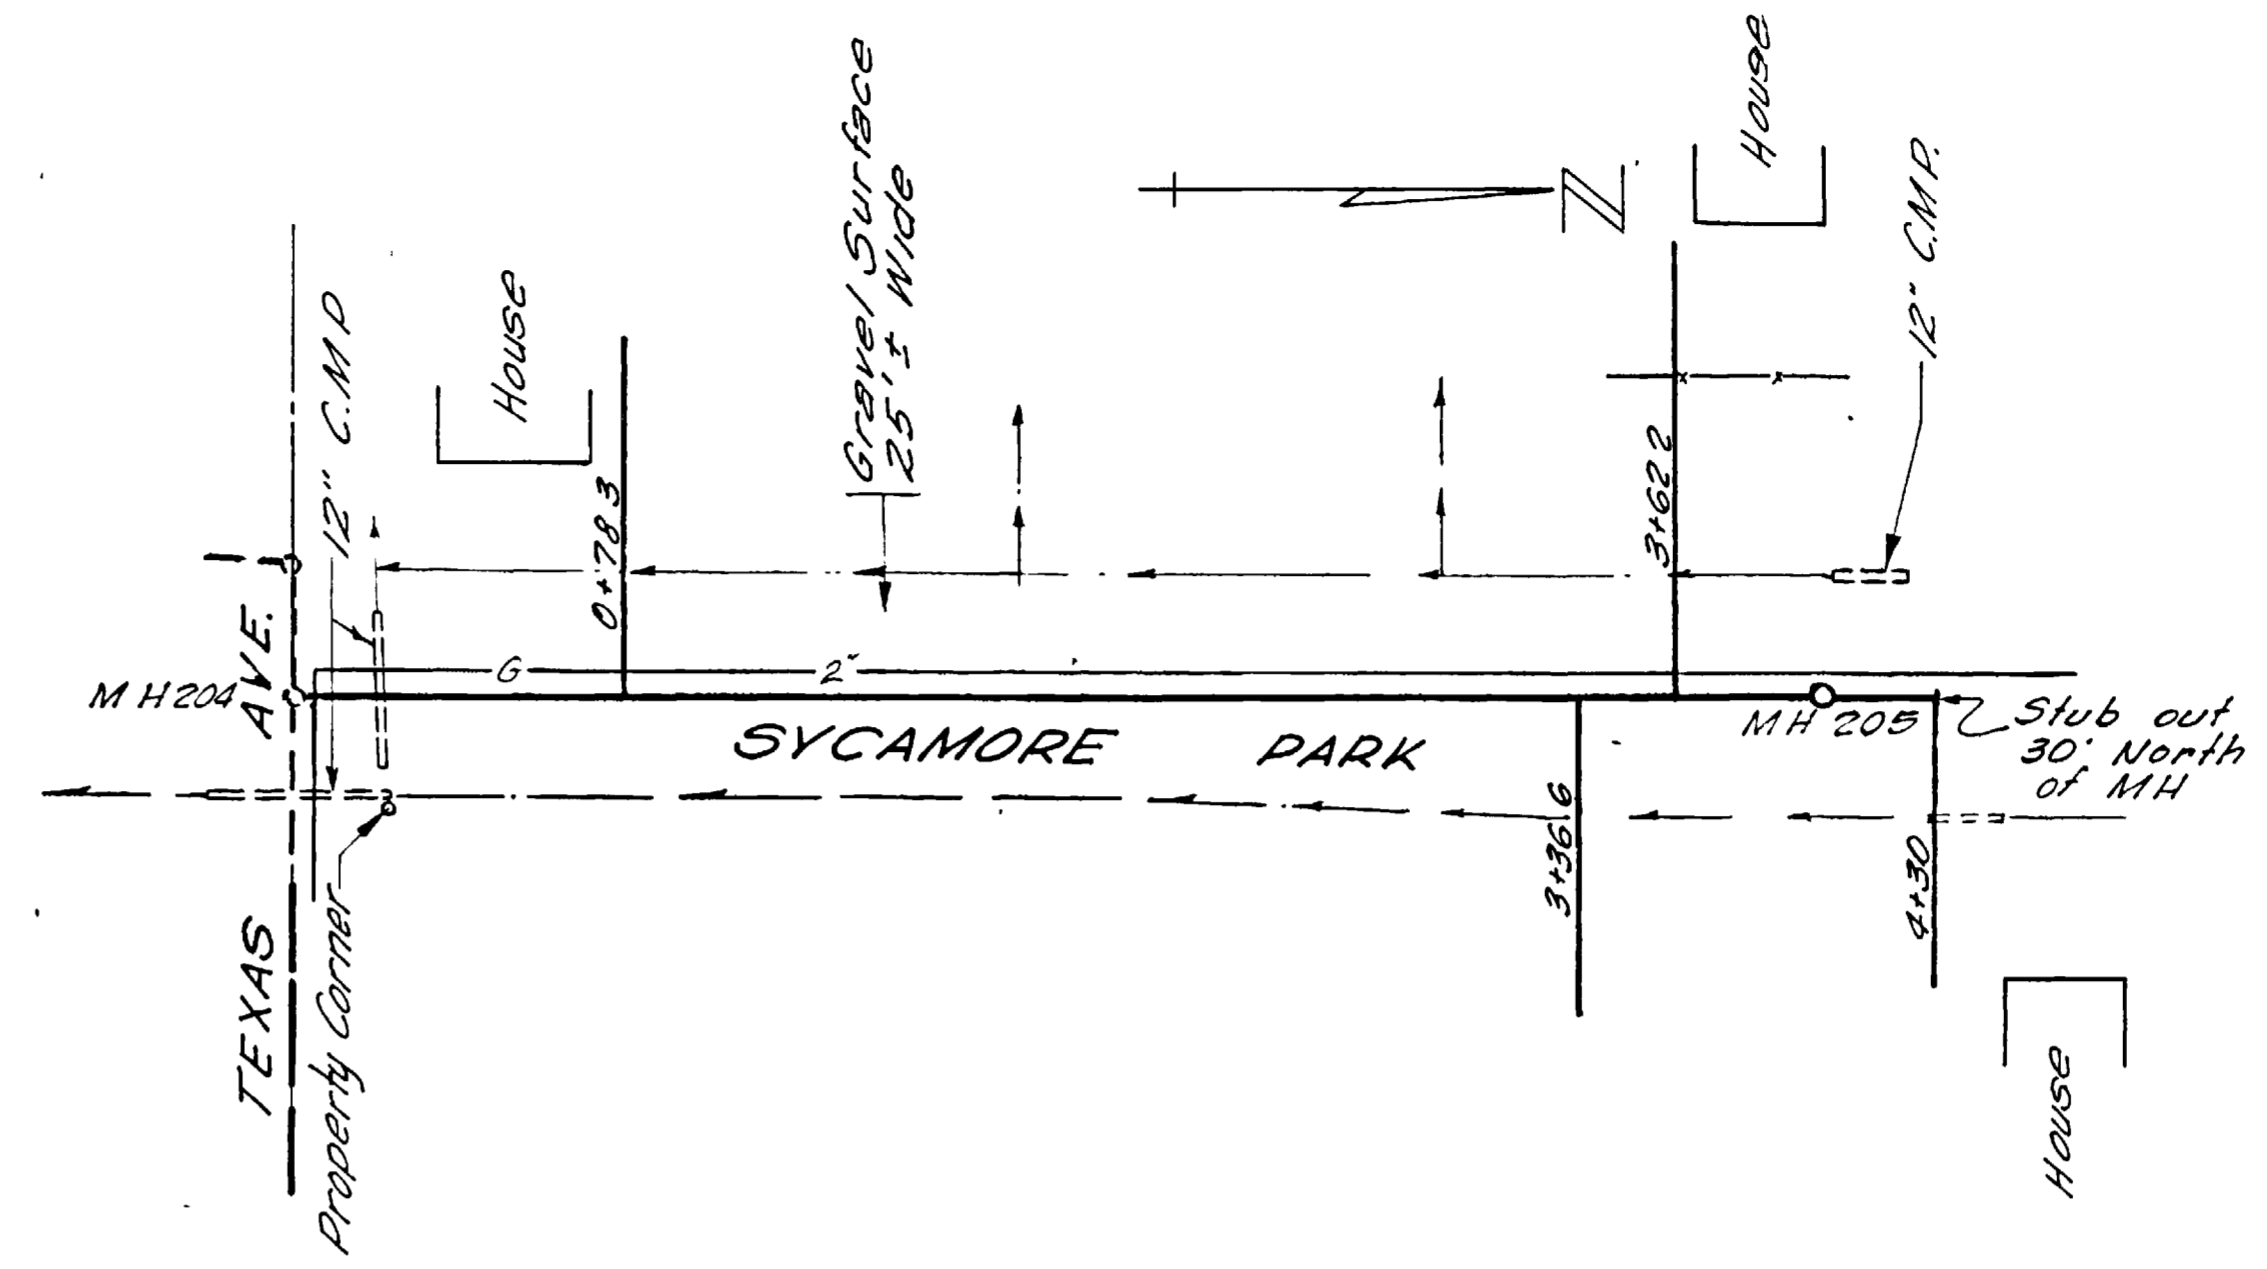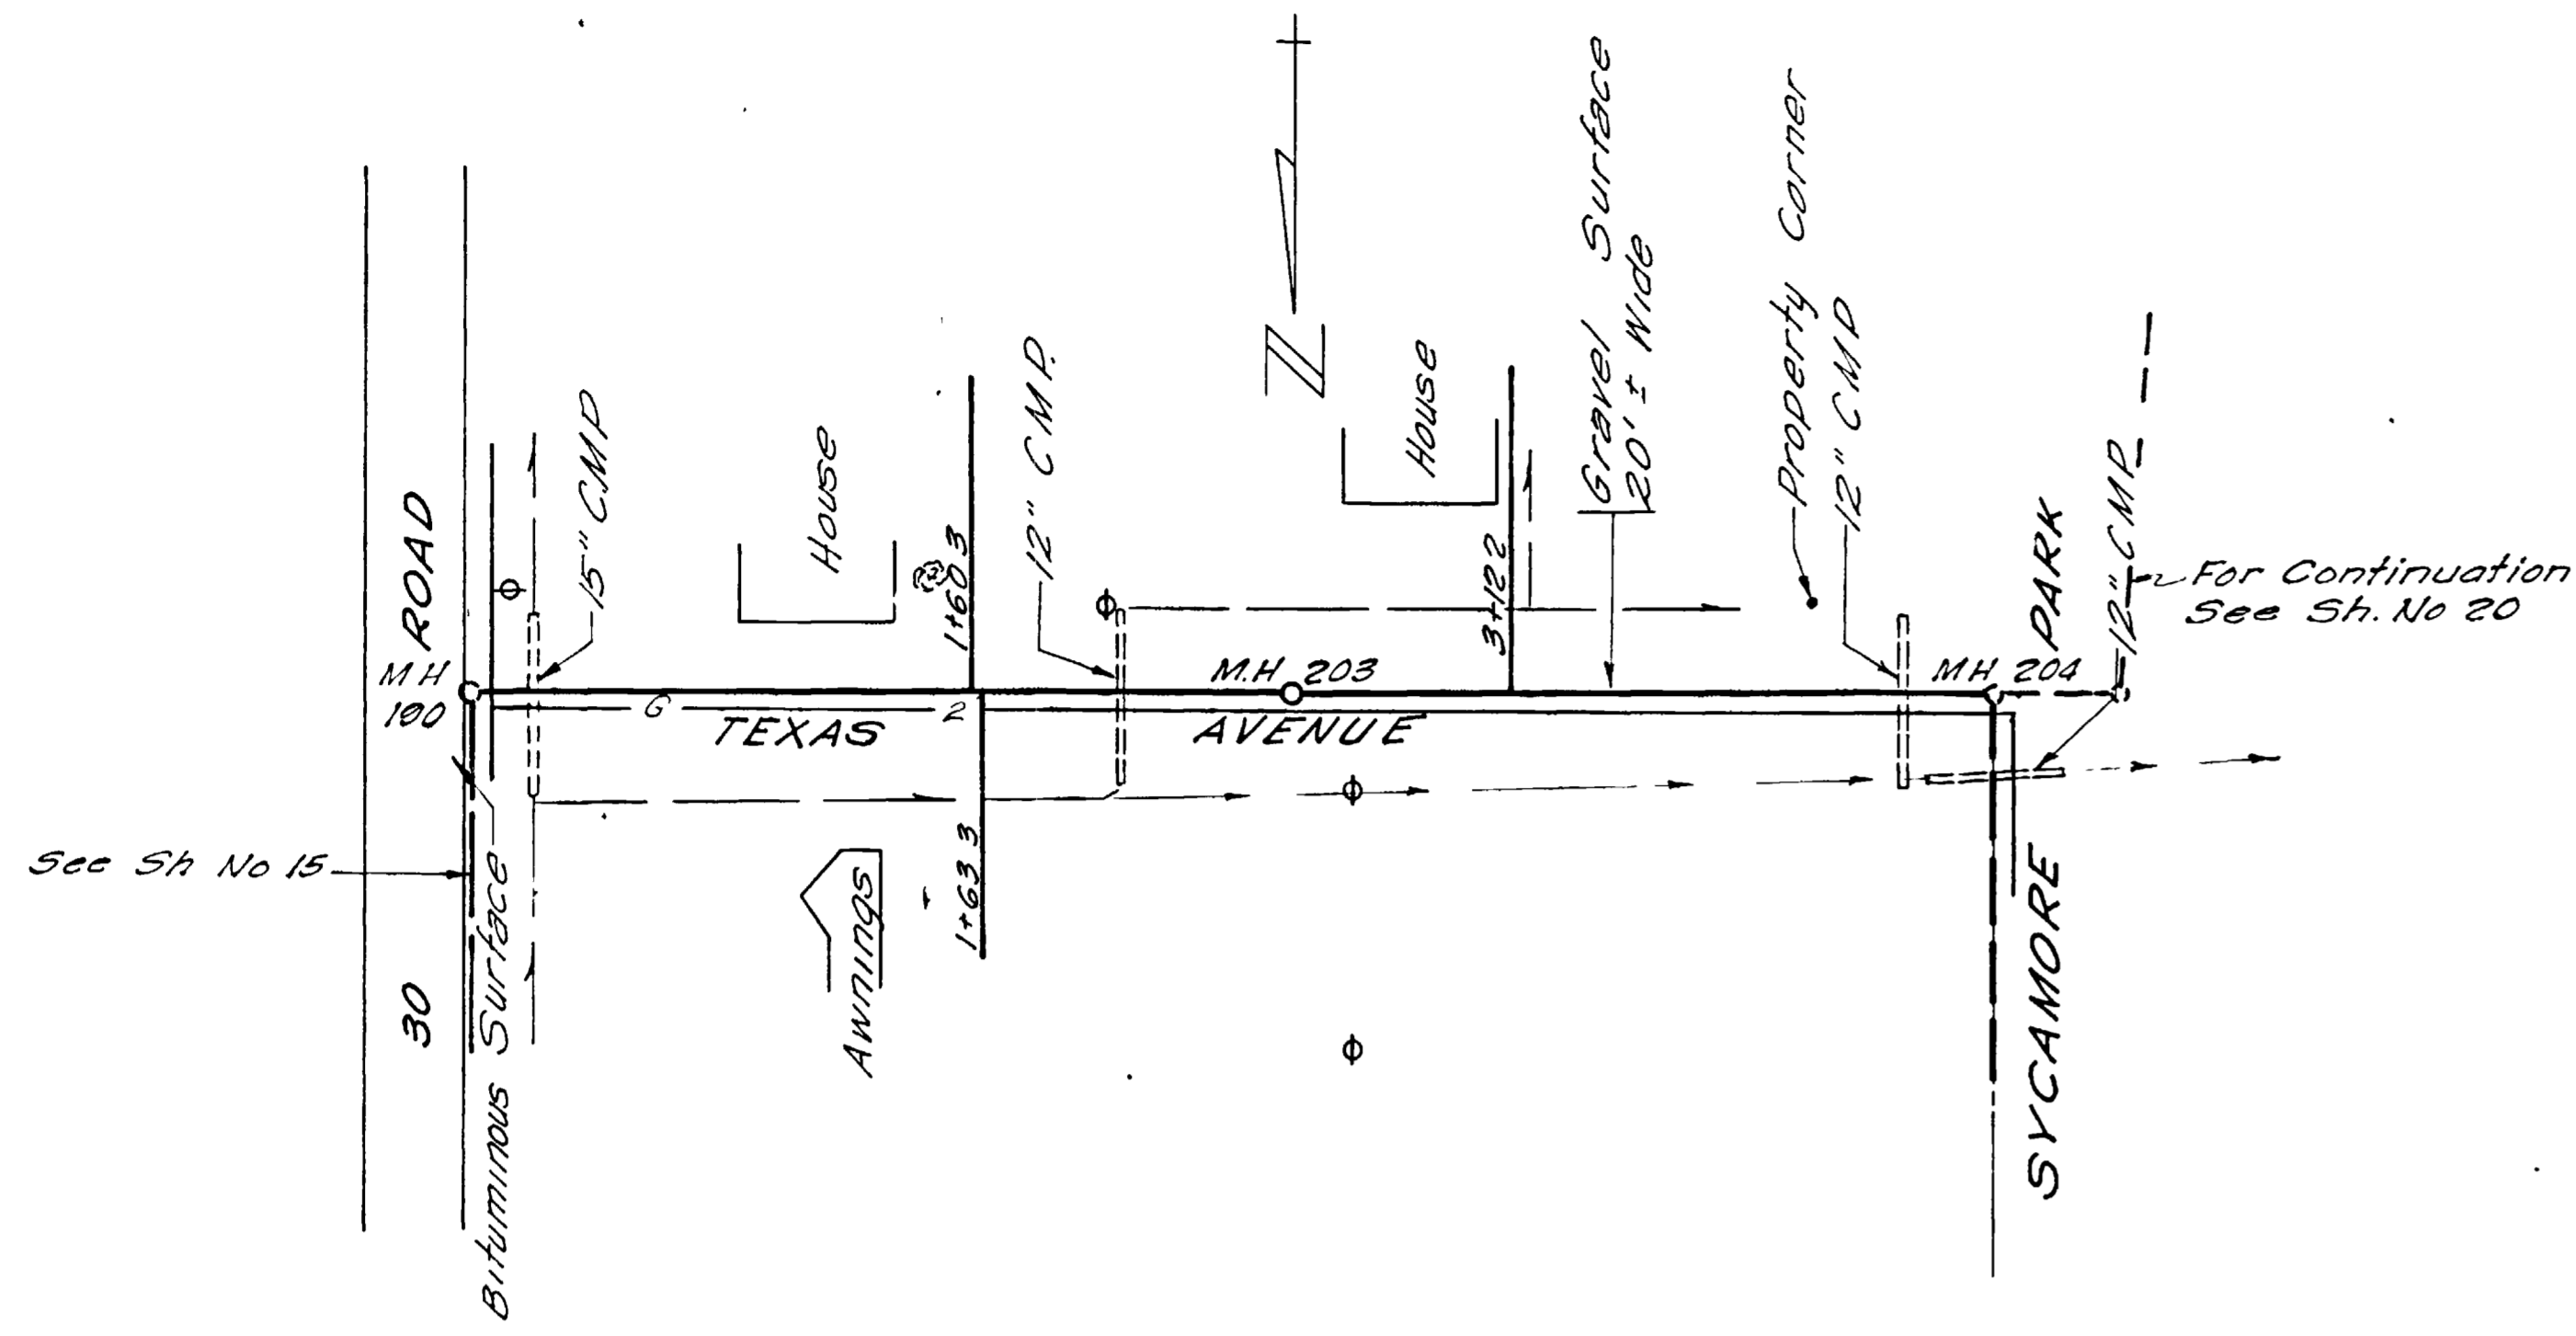

REVISIONS			
BY	DATE	DESCR	
BY	DATE	DESCR	

DATE October 1957 DRAWN D.V.S. JOB NO. G-205
 CHECKED R.C.P. FILE NO.
 APPROVED [Signature] F B NO.



HAROLD HOSKINS & ASSOCIATES
 ENGINEERING CONSULTANTS
 GREELEY, COLORADO LINCOLN, NEBRASKA

FRUITVALE, COLORADO
WATER & SANITATION DISTRICT

TEXAS AVENUE WEST OF 30 ROAD
SYCAMORE PARK

66 SHEET NO
 19 SHEETS



PLATE 1 PLAN PROFILE O P R & E STANDARD

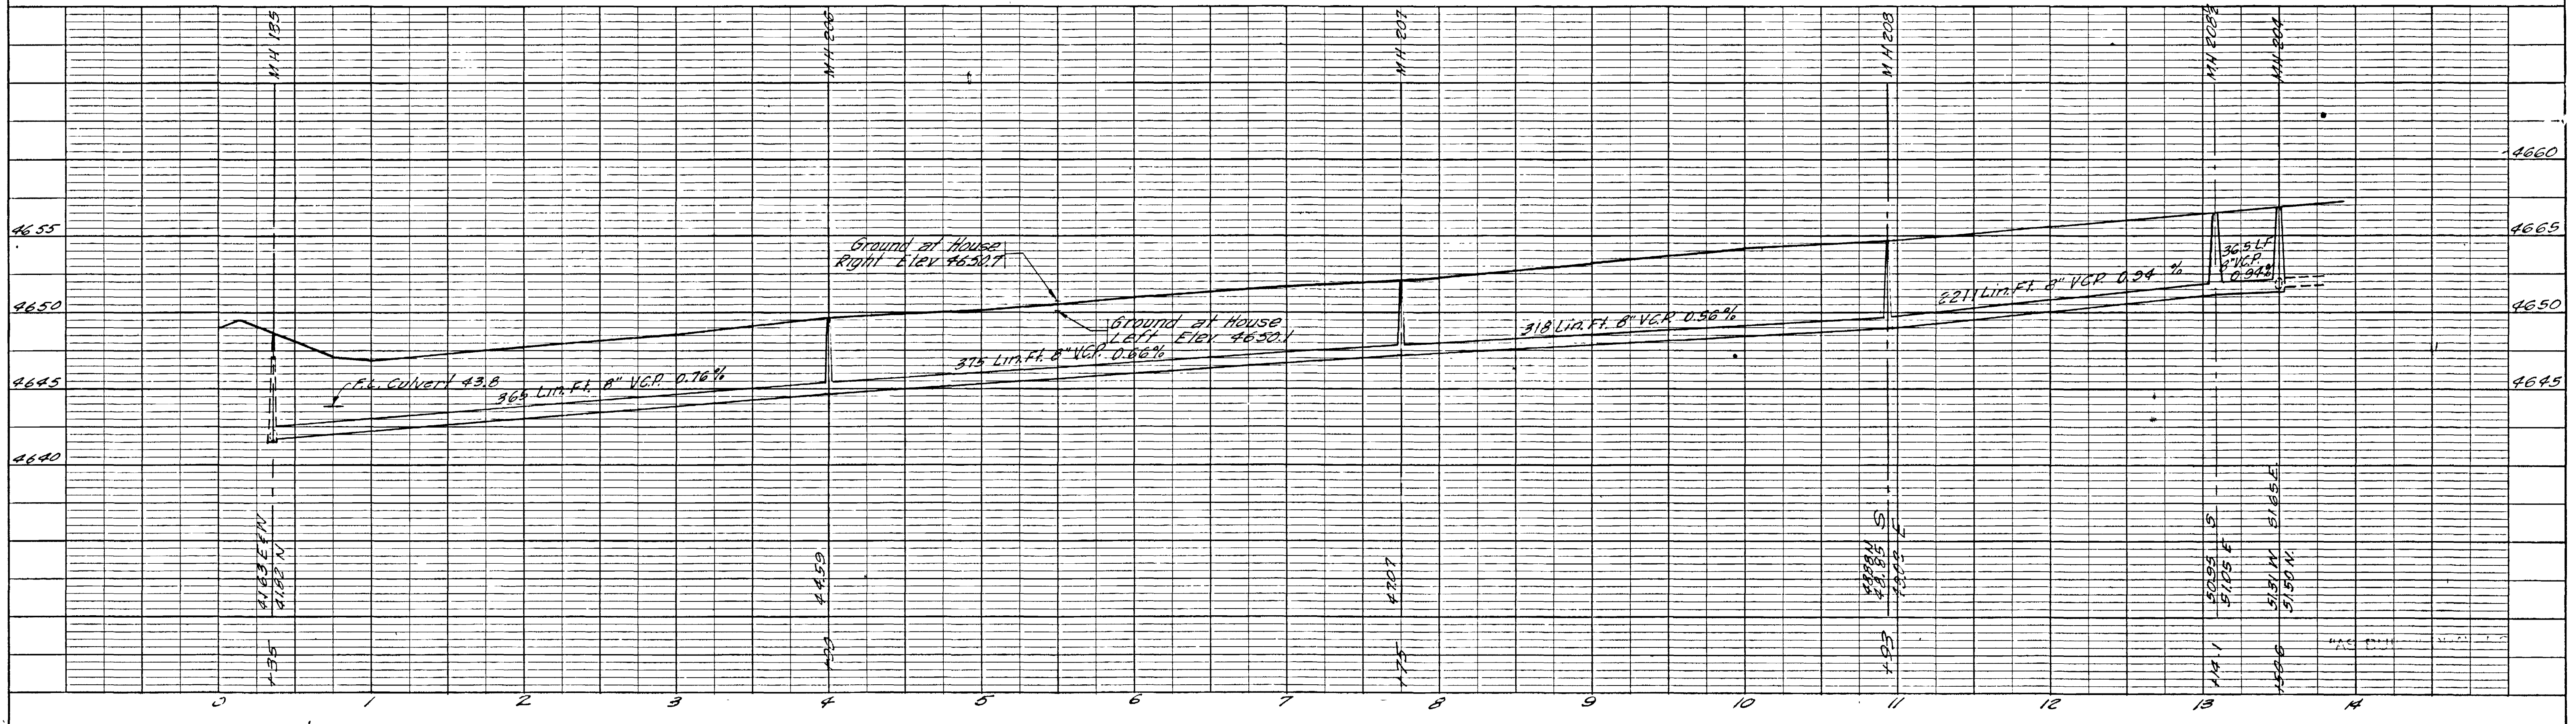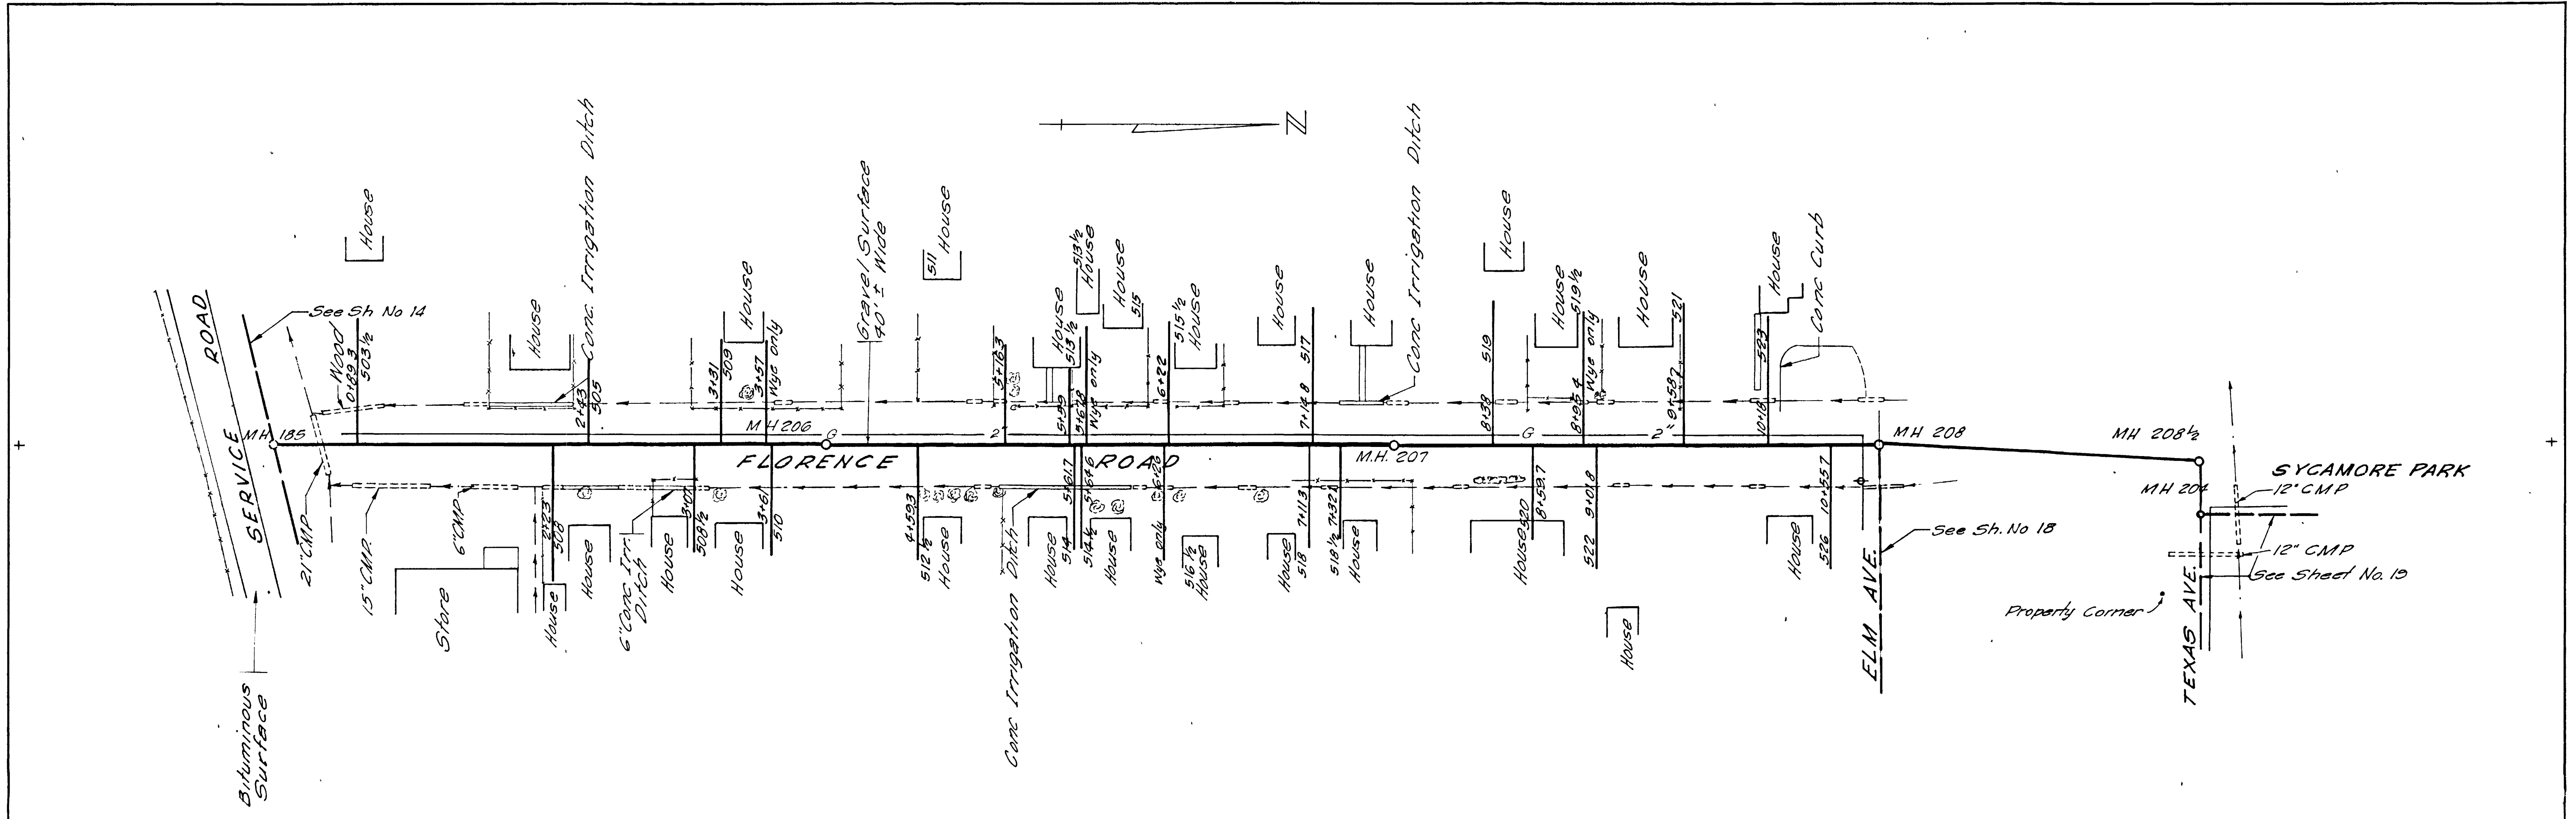

REVISIONS BY: DATE: DESCR:		DATE: October 1957 SCALE: 1"=50'	DRAWN: D.V.R. CHECKED: [Signature] APPROVED: [Signature]	JOB NO: G-205 FILE NO: T & NO:	HAROLD HOSKINS & ASSOCIATES ENGINEERING CONSULTANTS GREELEY, COLORADO	FRUITVALE, COLORADO WATER & SANITATION DISTRICT	FLORENCE ROAD	66 SHEET NO SHEETS 20
-------------------------------	--	-------------------------------------	----------------------------------------------------------------	--------------------------------------	-----------------------------------------------------------------------------	----------------------------------------------------	---------------	--------------------------

PLATE 1-PLAN-PROFILE OF P & R E

02081720.tif

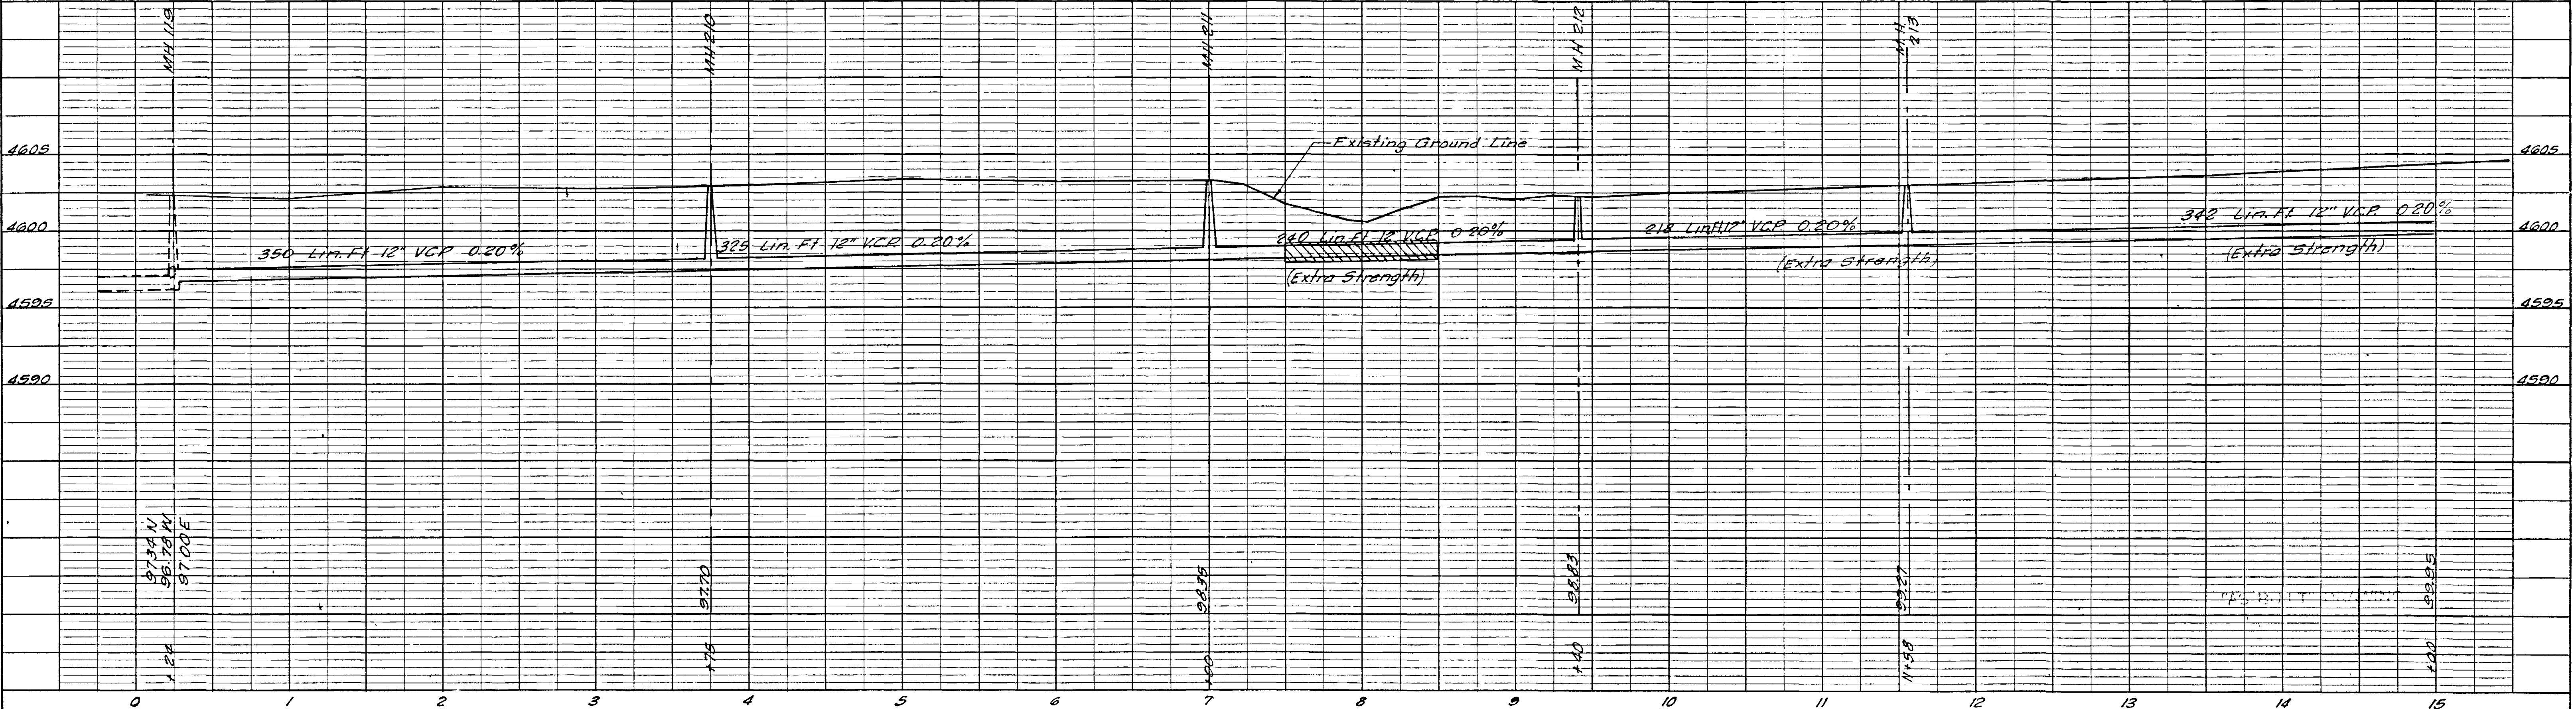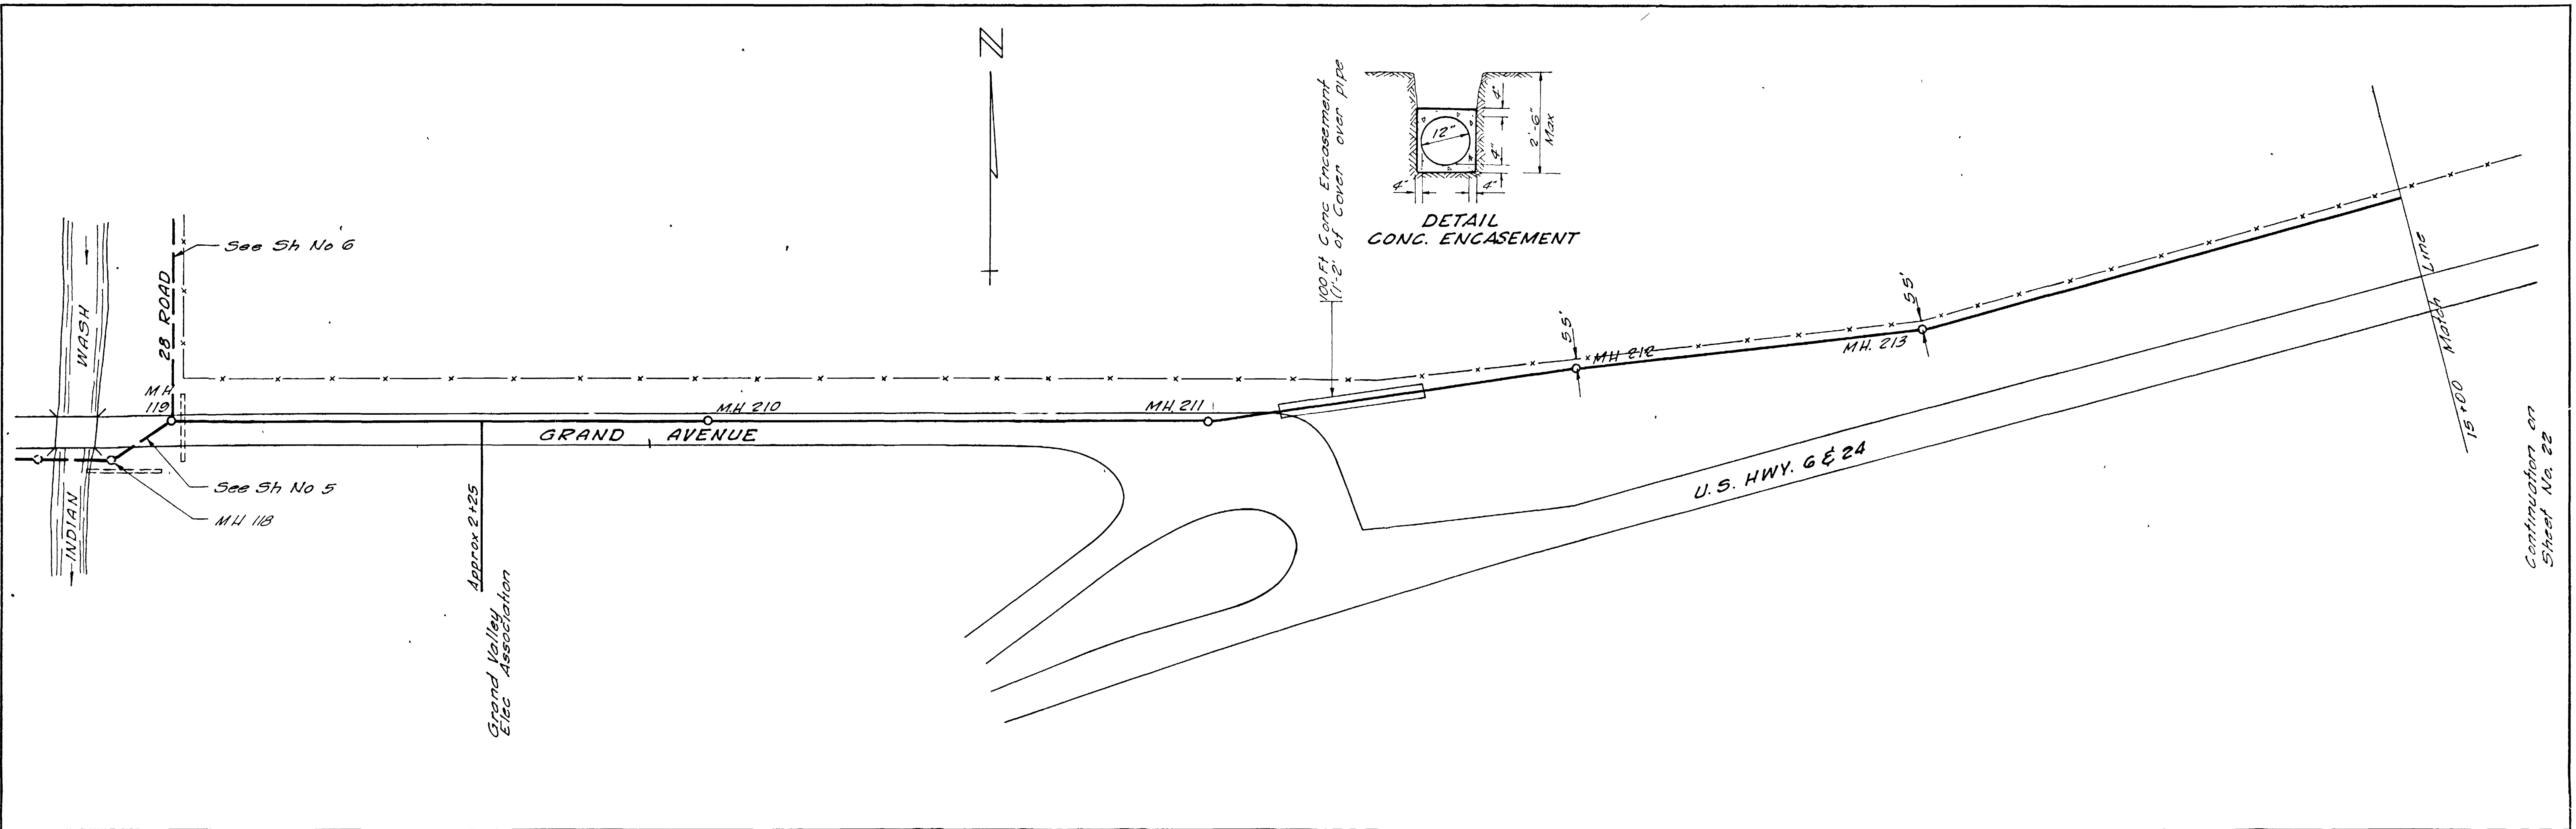


REVISIONS		DATE		DRAWN		JOB NO.		FILE NO.		CHECKED		APPROVED	
BY	DATE	DESCR											
BY	DATE	DESCR											

HAROLD HOSKINS & ASSOCIATES
 ENGINEERING CONSULTANTS
 GREELEY, COLORADO


FRUITVALE, COLORADO
 WATER & SANITATION DISTRICT
 LINCOLN, NEBRASKA

GRAND AVE.- STA. 0+00 TO STA. 15+00


66 SHEET NO
 SHEETS 21

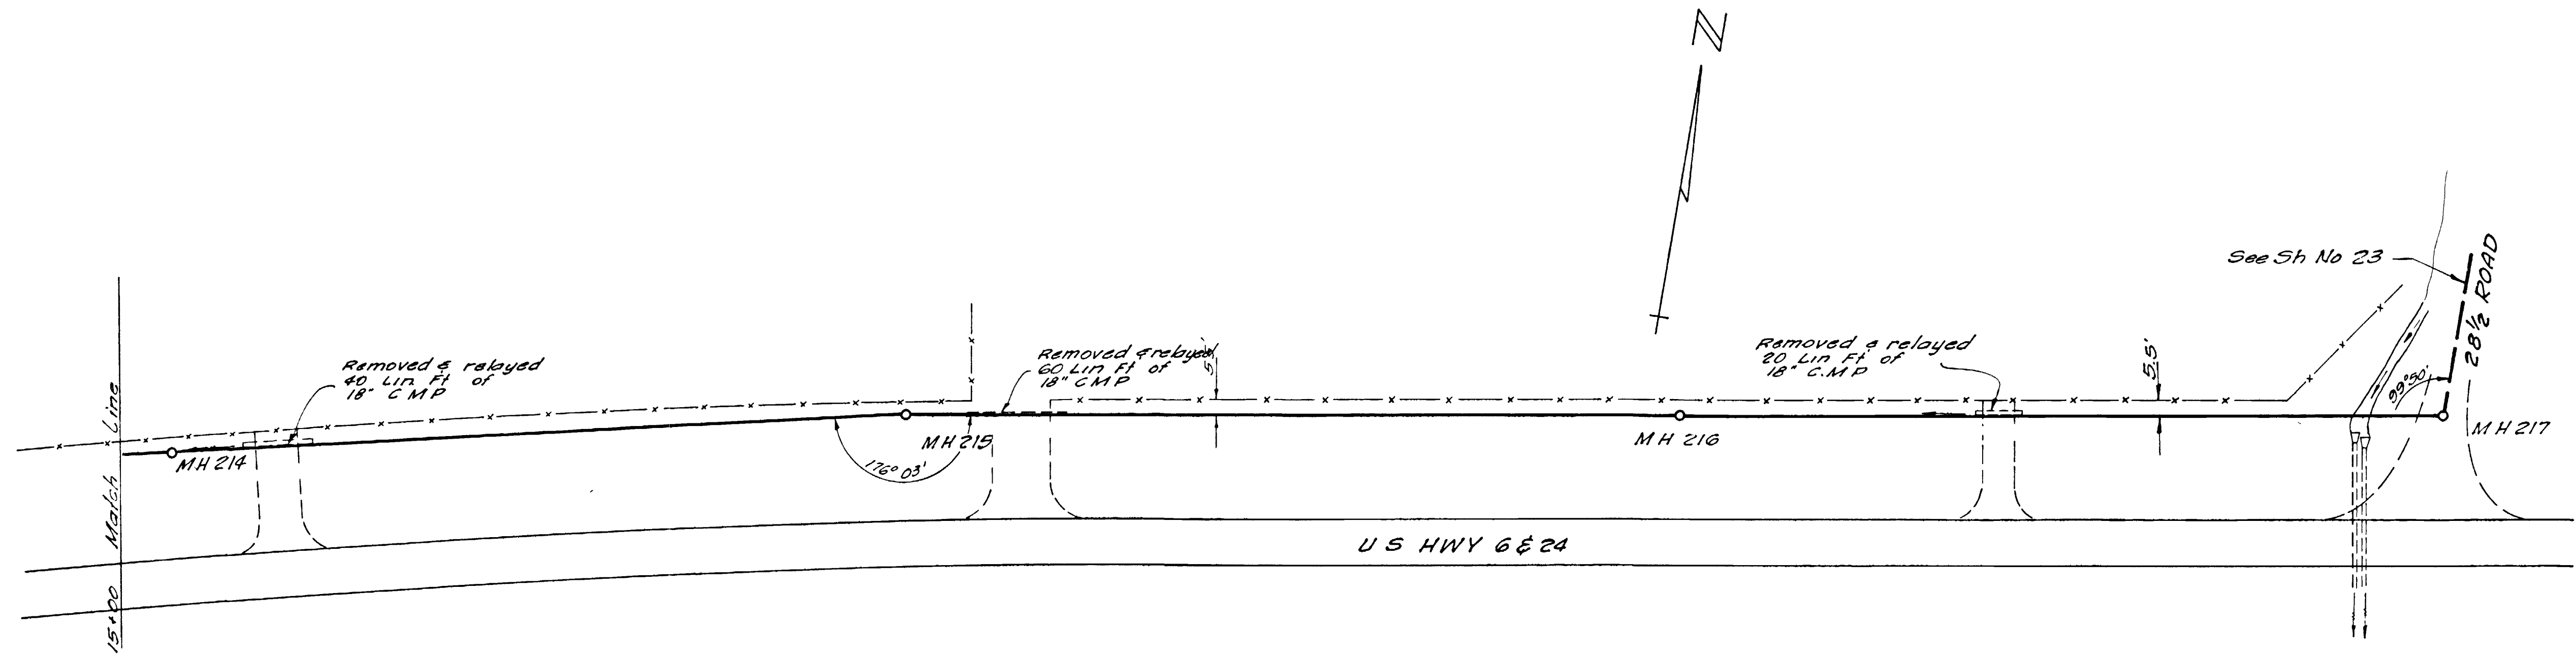


Continuation on Sheet No. 21

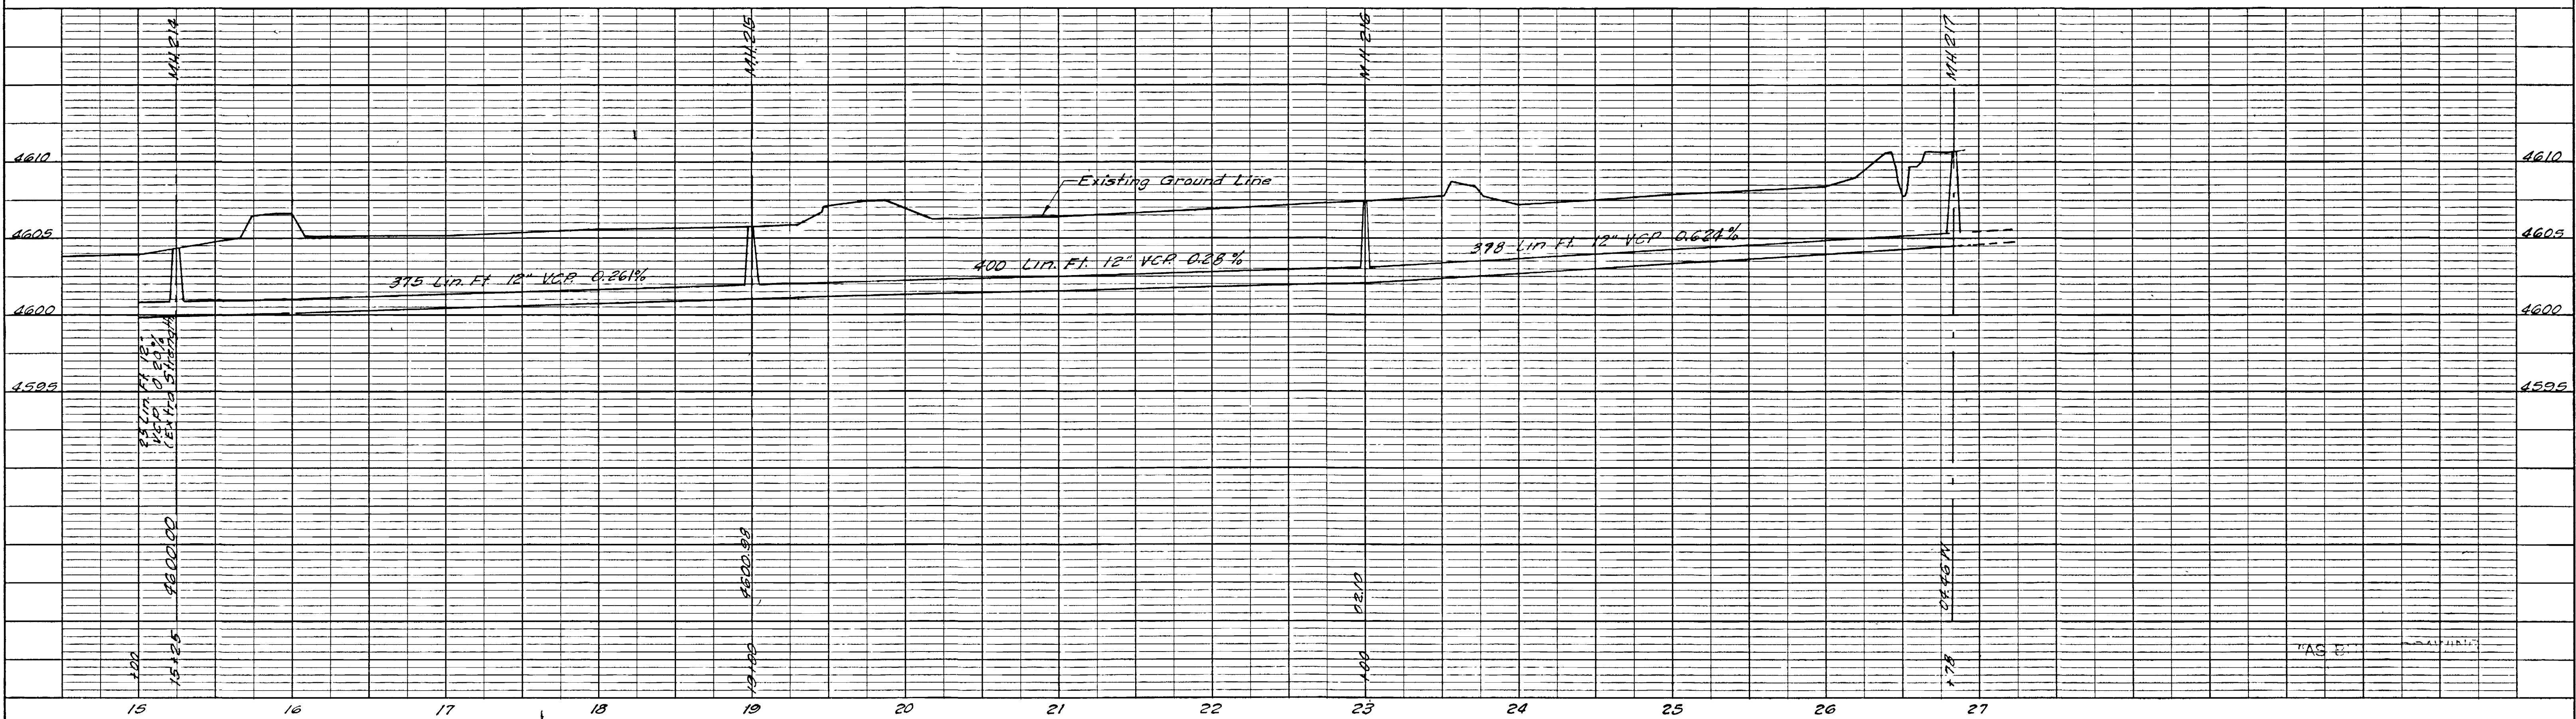

REVISIONS BY: R.C.T. DATE: Feb 1960 DESCR: G-205 BY: DATE: DESCR:		DATE: October 1957 SCALE: 1"=50'	DRAWN: D.V.R. CHECKED: S.C.F. APPROVED: W.P. [Signature]	JOB NO: G-205 FILE NO: F.B. NO:	HAROLD HOSKINS & ASSOCIATES ENGINEERING CONSULTANTS GREELEY, COLORADO	FRUITVALE, COLORADO WATER & SANITATION DISTRICT	GRAND AVE.-STA. 15+00 TO STA. 26+92	66 SHEET NO 22 SHEETS
-------------------------------------------------------------------------	--	-------------------------------------	----------------------------------------------------------------	---------------------------------------	-----------------------------------------------------------------------------	----------------------------------------------------	-------------------------------------	--------------------------

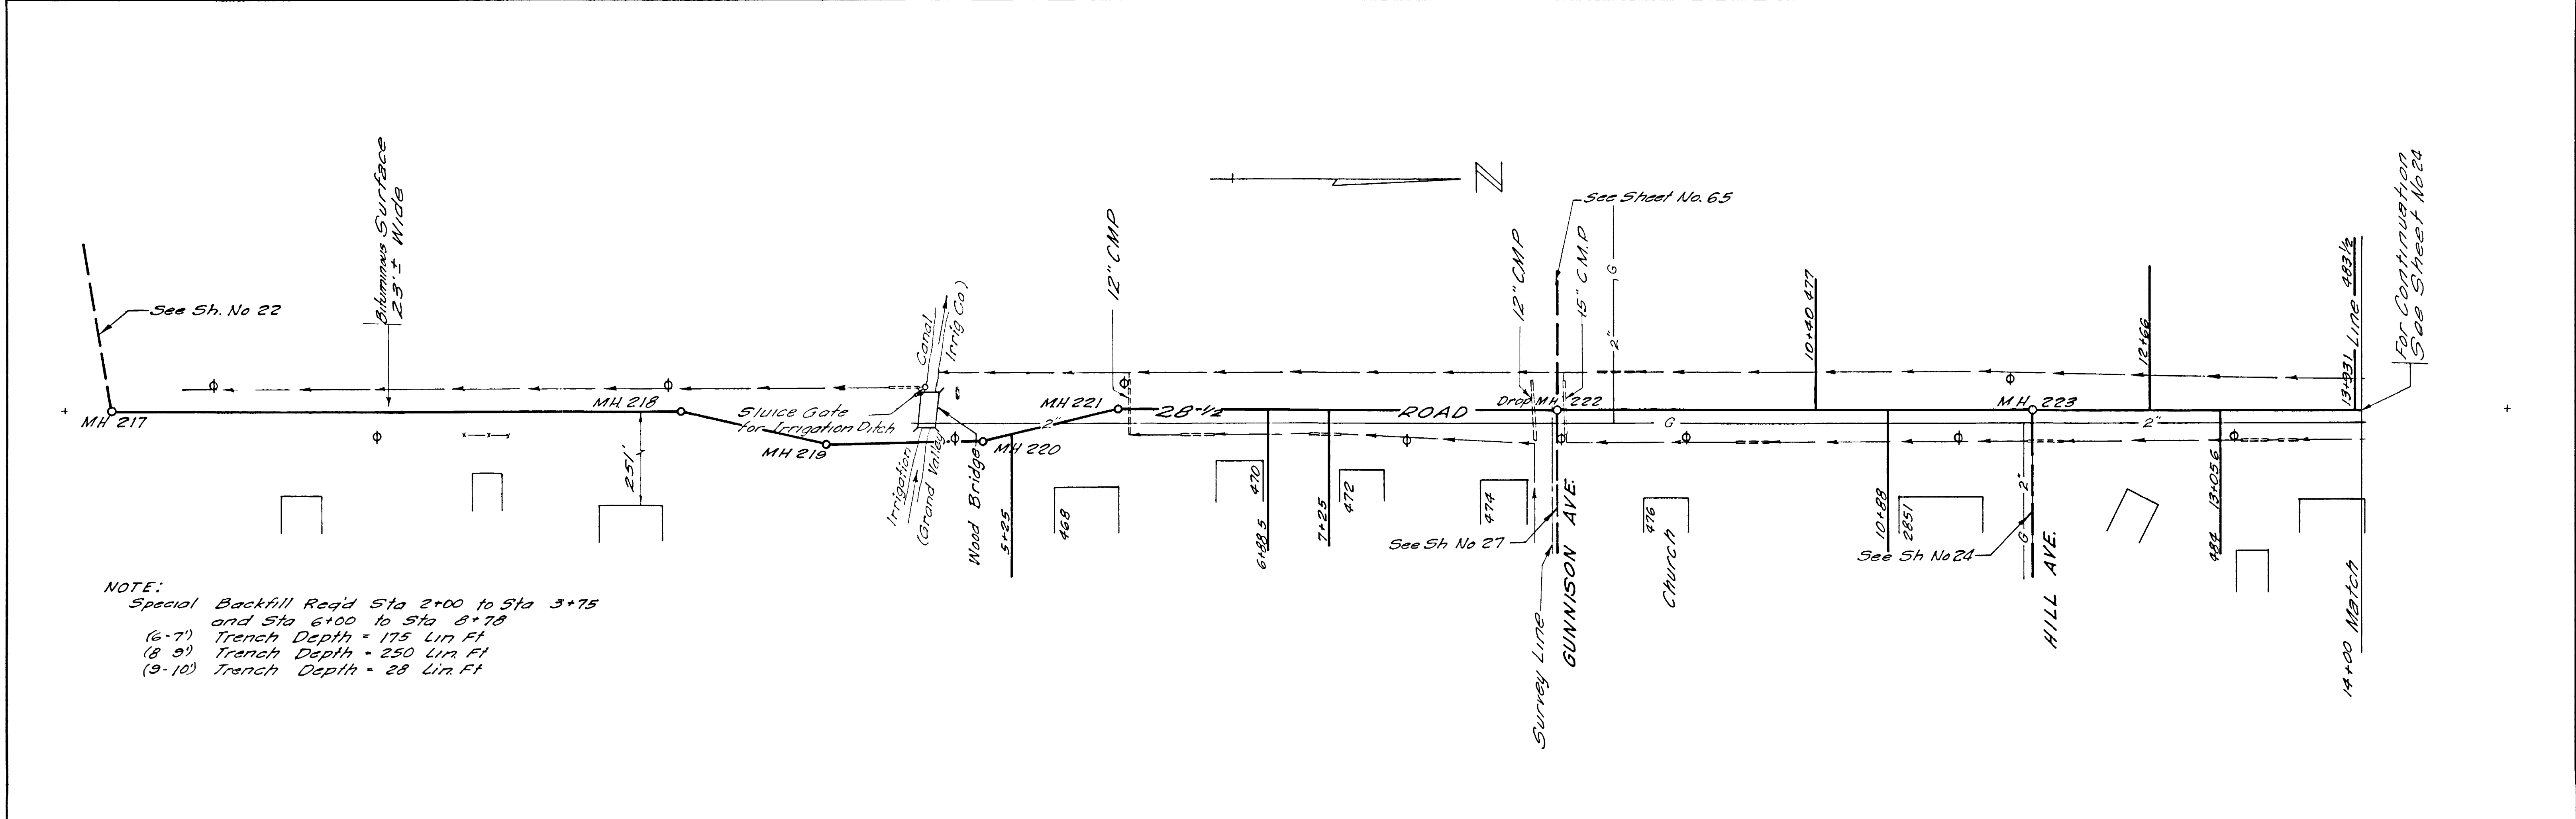

NOTE:
 Special Backfill Req'd Sta 2+00 to Sta 3+75
 and Sta 6+00 to Sta 8+70
 (6-7) Trench Depth = 175 Lin Ft
 (8-9) Trench Depth = 250 Lin Ft
 (9-10) Trench Depth = 28 Lin Ft

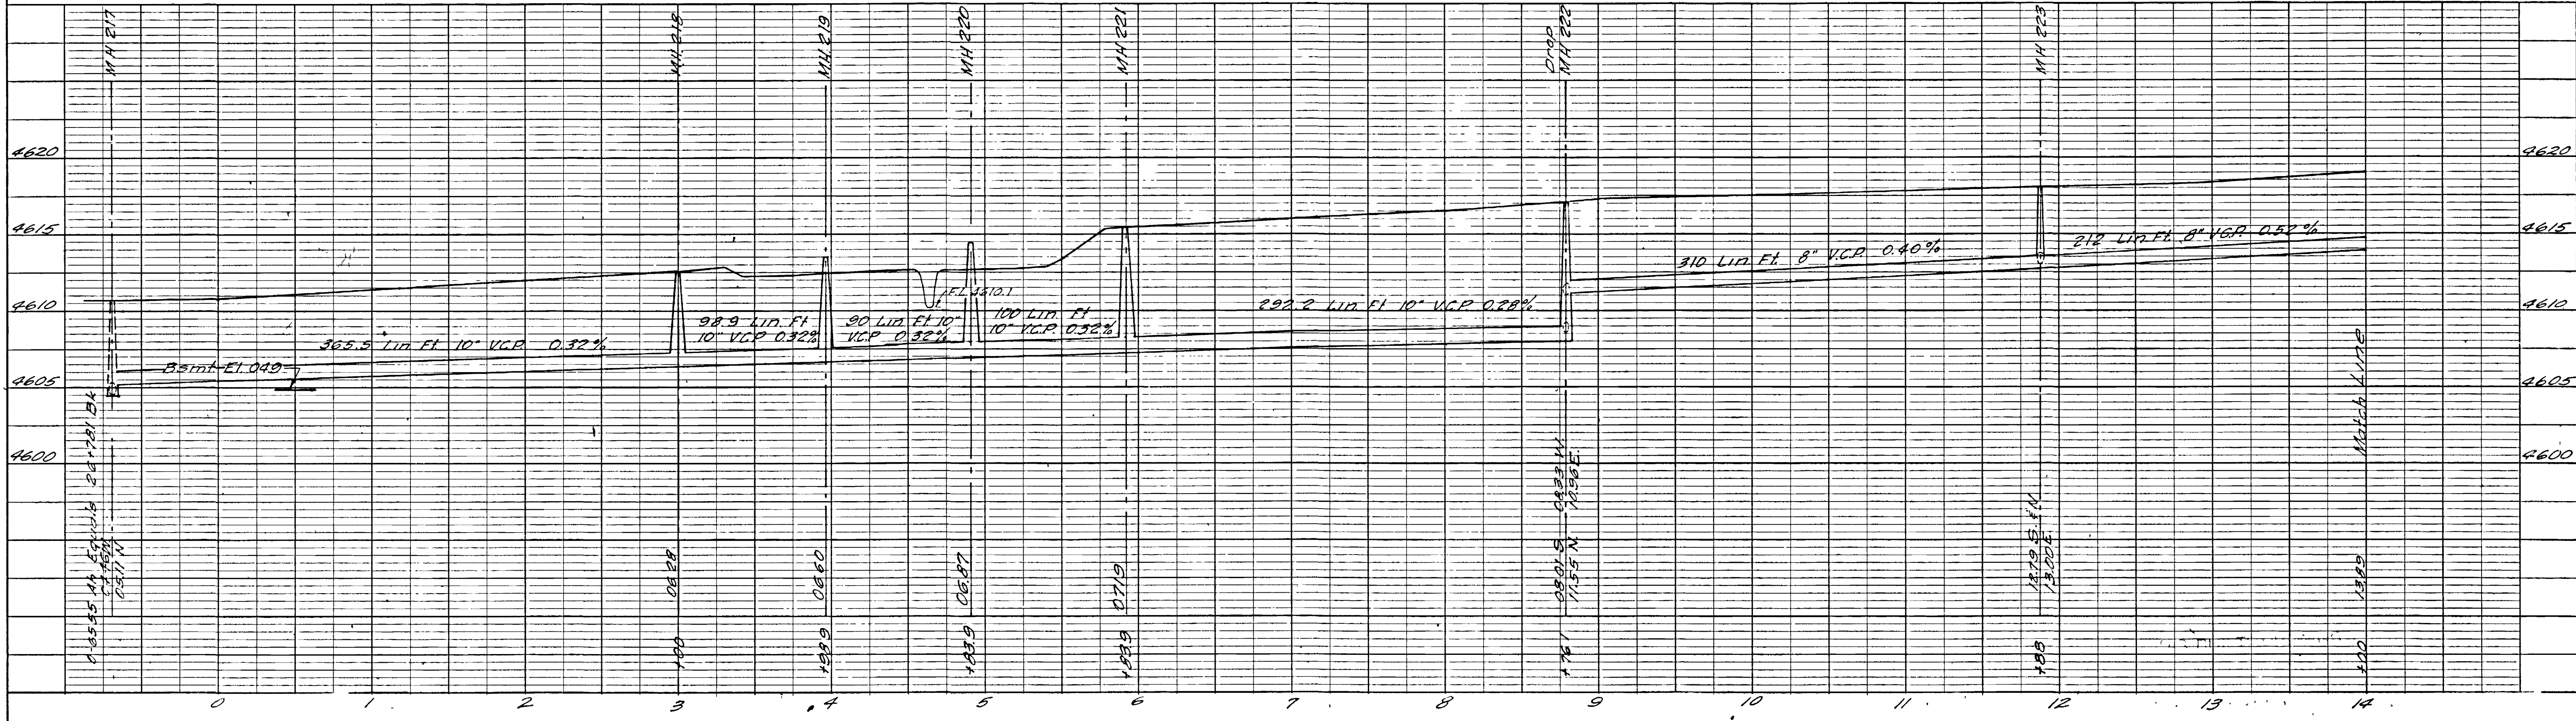

REVISIONS		DATE	BY	DESCR	DATE	BY	DESCR	DATE	BY	DESCR
1	By R.C.T.	Feb 1960		Grades	October 1957	D.V.R.				



HAROLD HOSKINS & ASSOCIATES
 ENGINEERING CONSULTANTS
 GREELEY, COLORADO LINCOLN, NEBRASKA

FRUITVALE, COLORADO
WATER & SANITATION DISTRICT



28 1/2 ROAD SOUTH OF NORTH AVENUE
STA. 0+68.9 TO STA. 14+00

66 SHEET NO
 SHEETS 23




02081723.tif

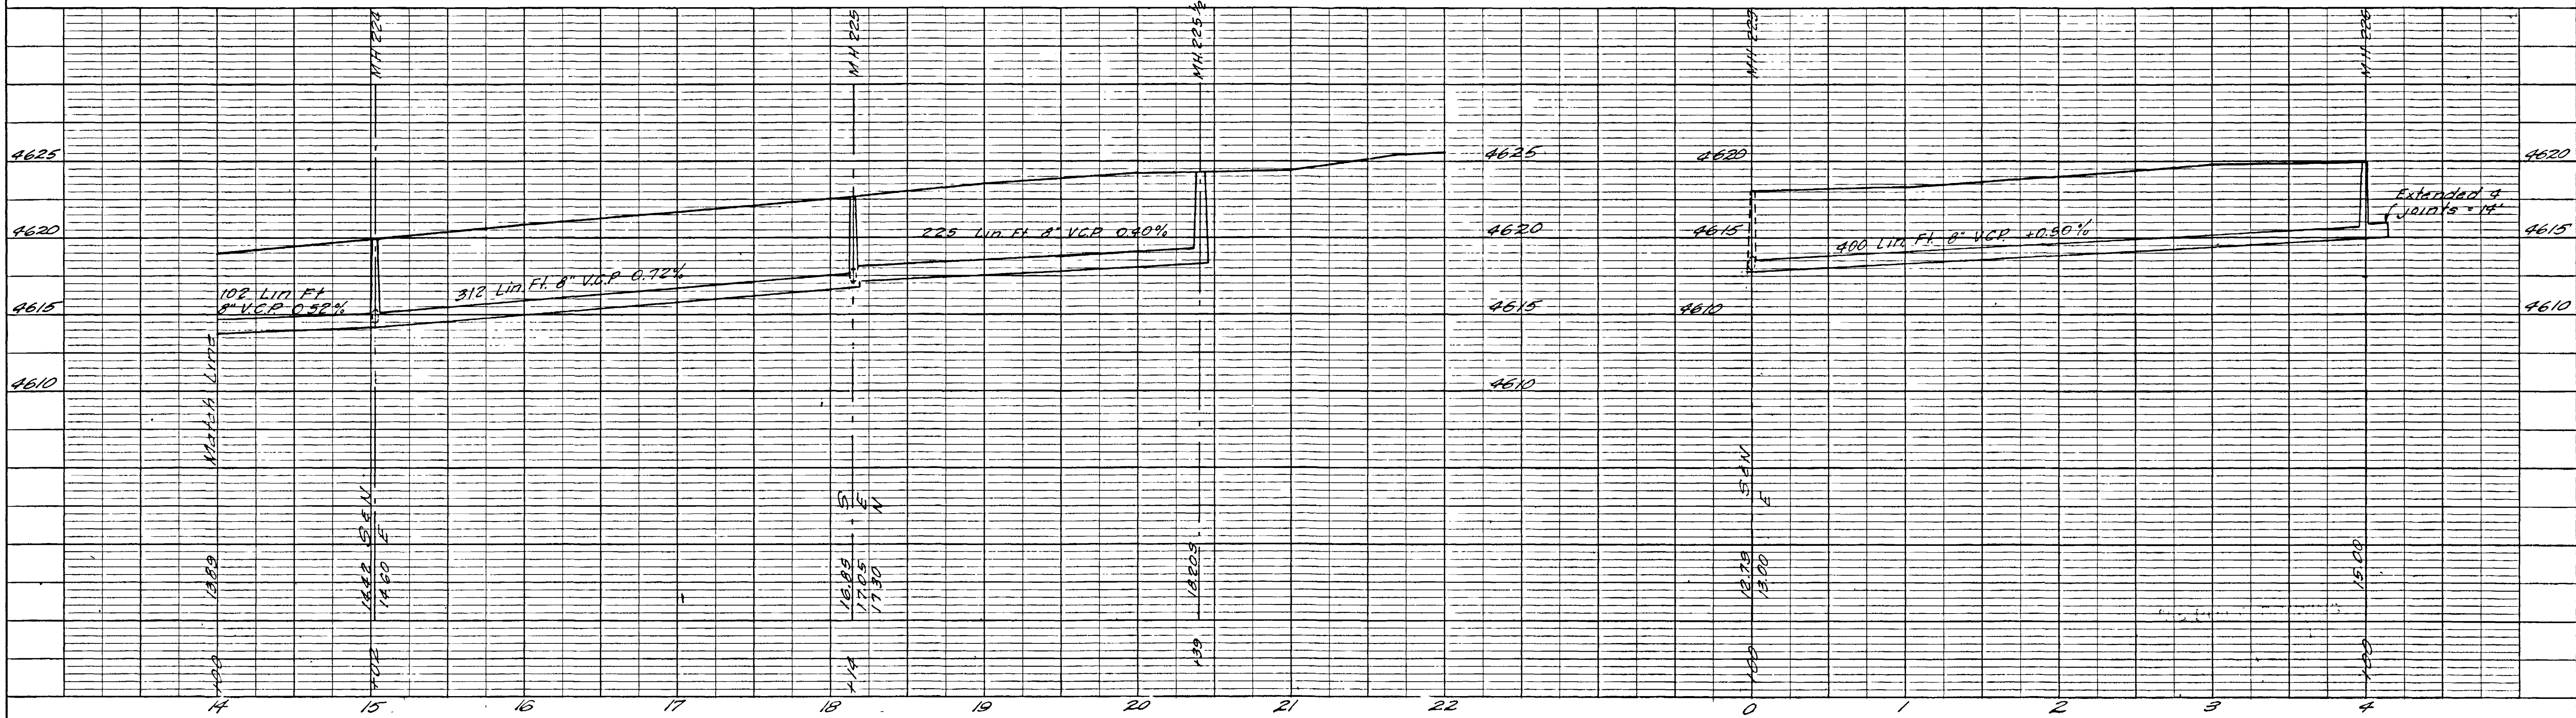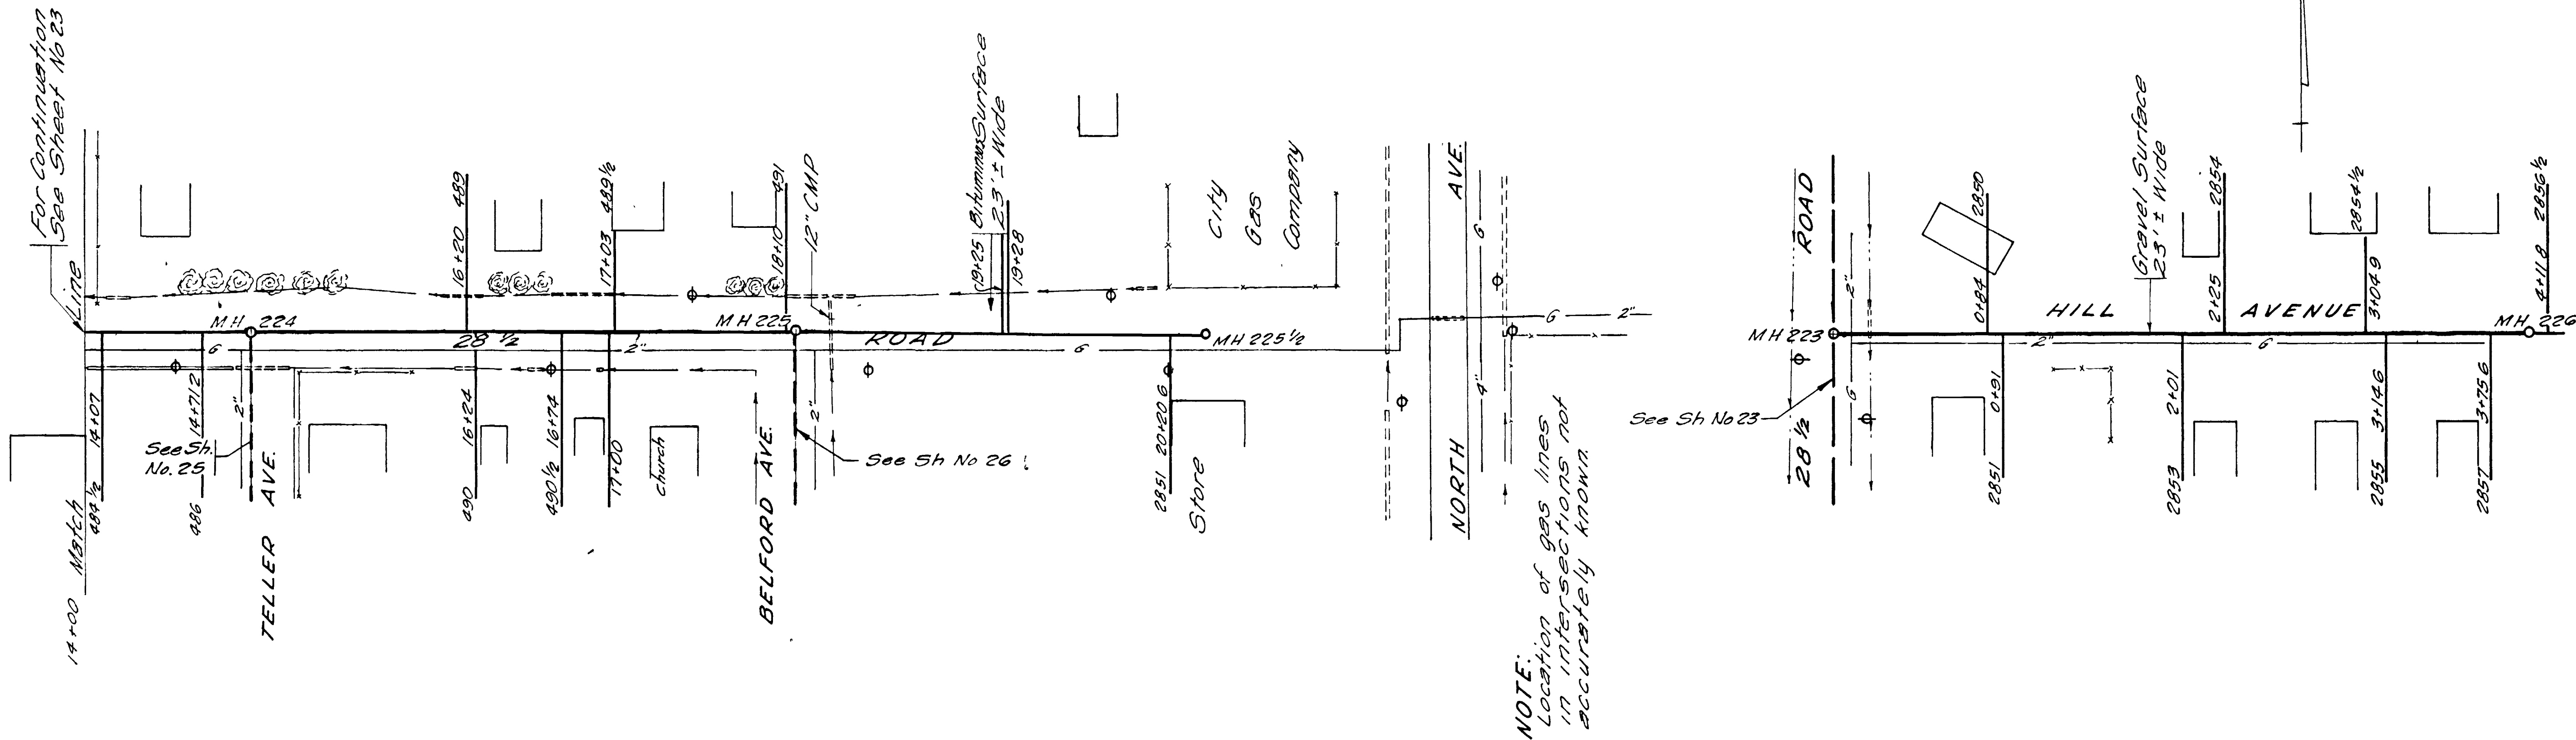

REVISIONS BY: <u>ECG</u> DATE: <u>Feb. 1960</u> DESCR: <u>Grades</u> BY: _____ DATE: _____ DESCR: _____ BY: _____ DATE: _____ DESCR: _____		DATE: <u>October 1957</u> DRAWN: <u>D.V.R.</u> JOB NO: <u>G-205</u> CHECKED: <u>R.P.T.</u> FILE NO: _____ APPROVED: <u>[Signature]</u> F.B. NO: _____		HAROLD HOSKINS & ASSOCIATES ENGINEERING CONSULTANTS GREELEY, COLORADO LINCOLN, NEBRASKA		FRUITVALE, COLORADO WATER & SANITATION DISTRICT		HILL AVENUE 28 1/2 ROAD SOUTH OF NORTH AVENUE		66 SHEETS 24
-----------------------------------------------------------------------------------------------------------------------------------------------------	--	-------------------------------------------------------------------------------------------------------------------------------------------------------------	--	-----------------------------------------------------------------------------------------------	--	----------------------------------------------------	--	--------------------------------------------------	--	-----------------

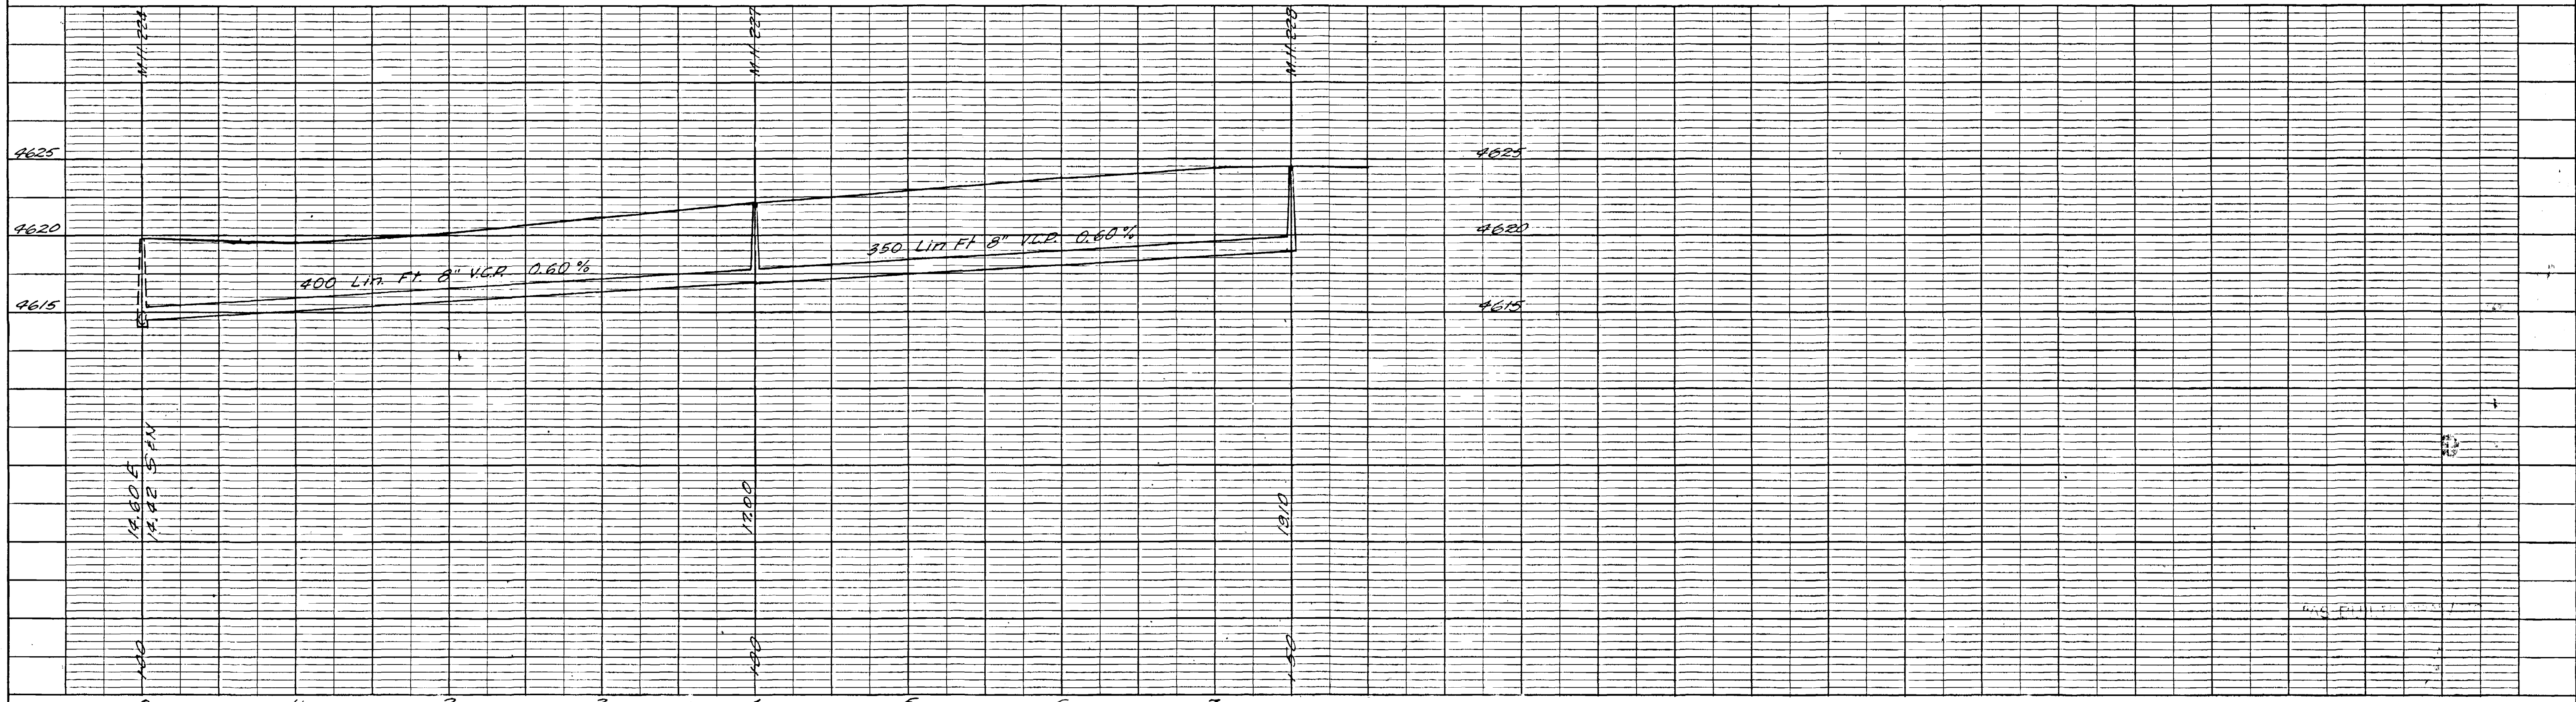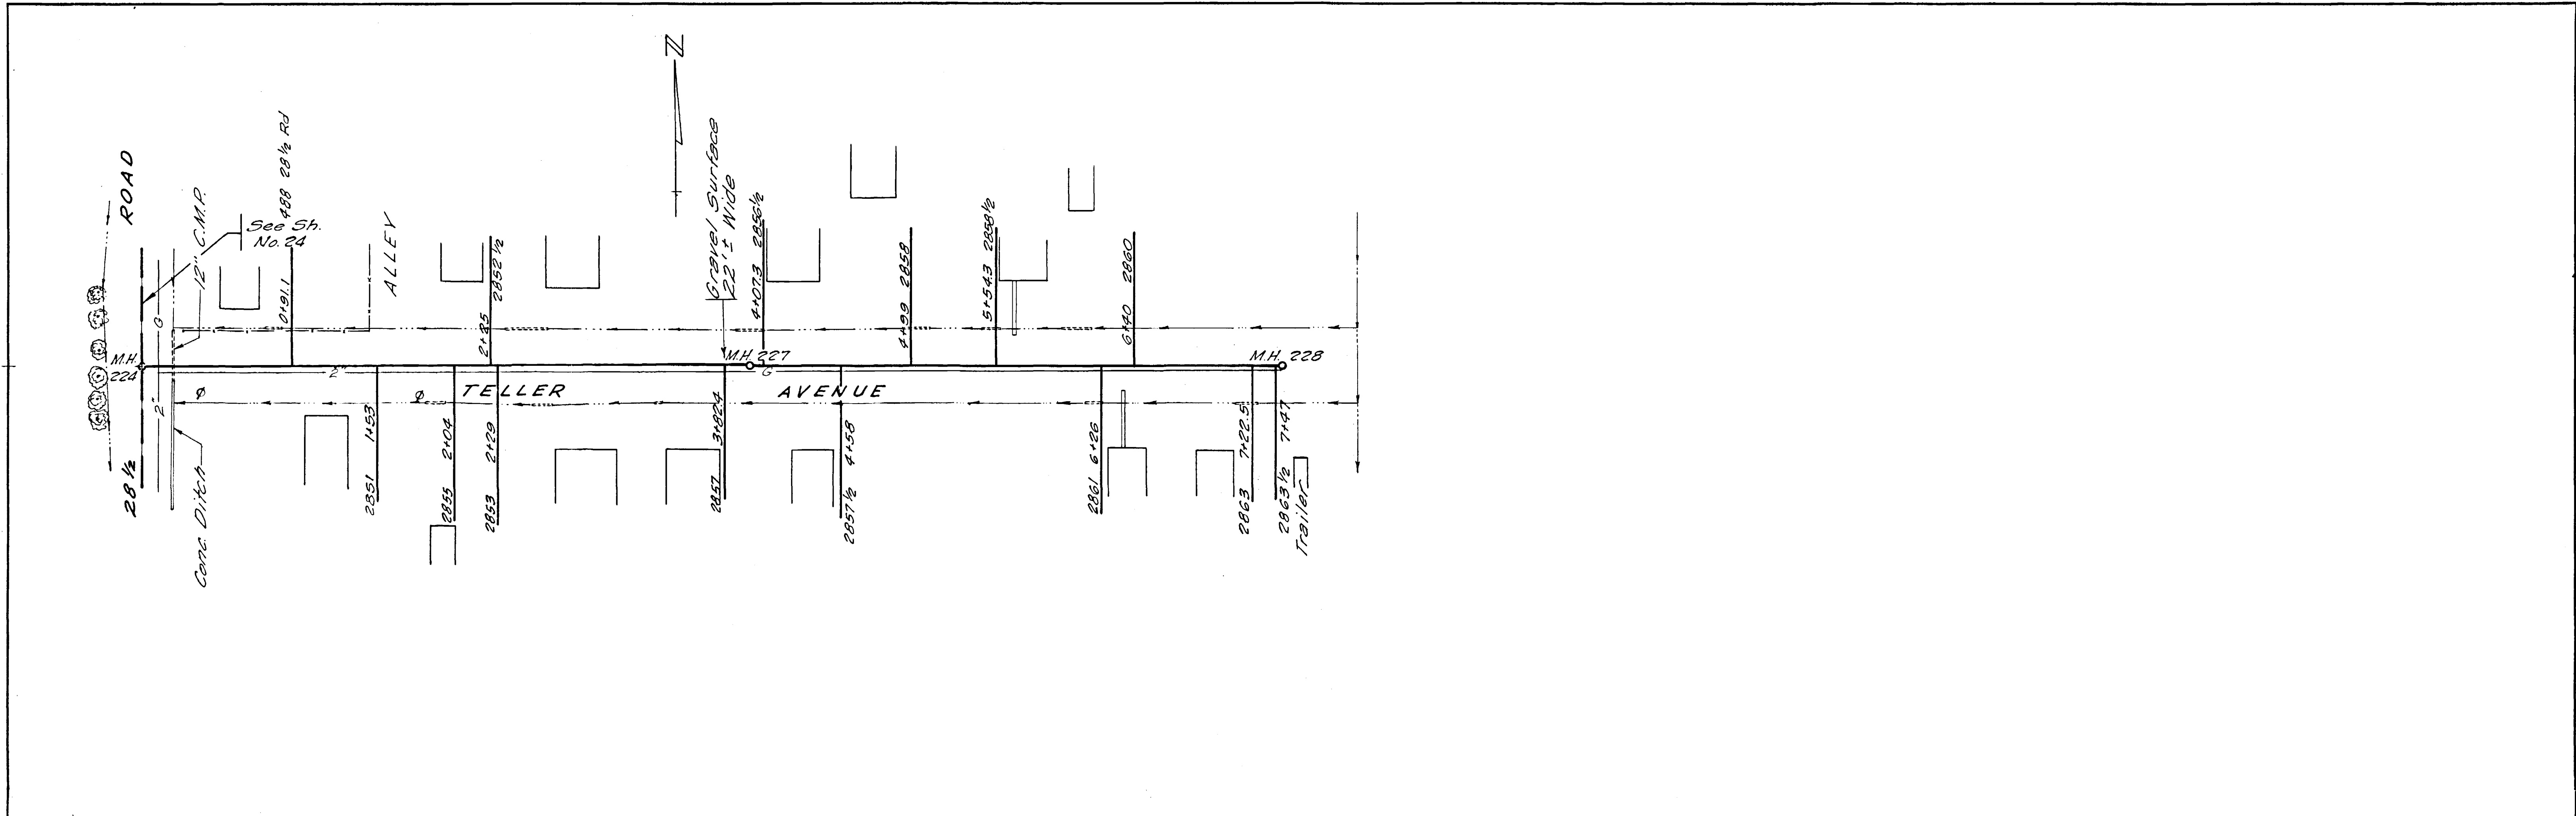

REVISIONS BY: RGT DATE: Feb. 1960 DESCR.: <i>changes</i>		DATE: October 1952 DRAWN: D.V.R. JOB NO: G-205		HAROLD HOSKINS & ASSOCIATES ENGINEERING CONSULTANTS GREELEY, COLORADO LINCOLN, NEBRASKA		FRUITVALE, COLORADO WATER & SANITATION DISTRICT		TELLER AVENUE		66 SHEET No. 25	
BY: DATE: DESCR.:		CHECKED: APPROVED:		FILE NO: F. B. NO:		SCALE: 1"=50'		SHEETS:		SHEETS:	

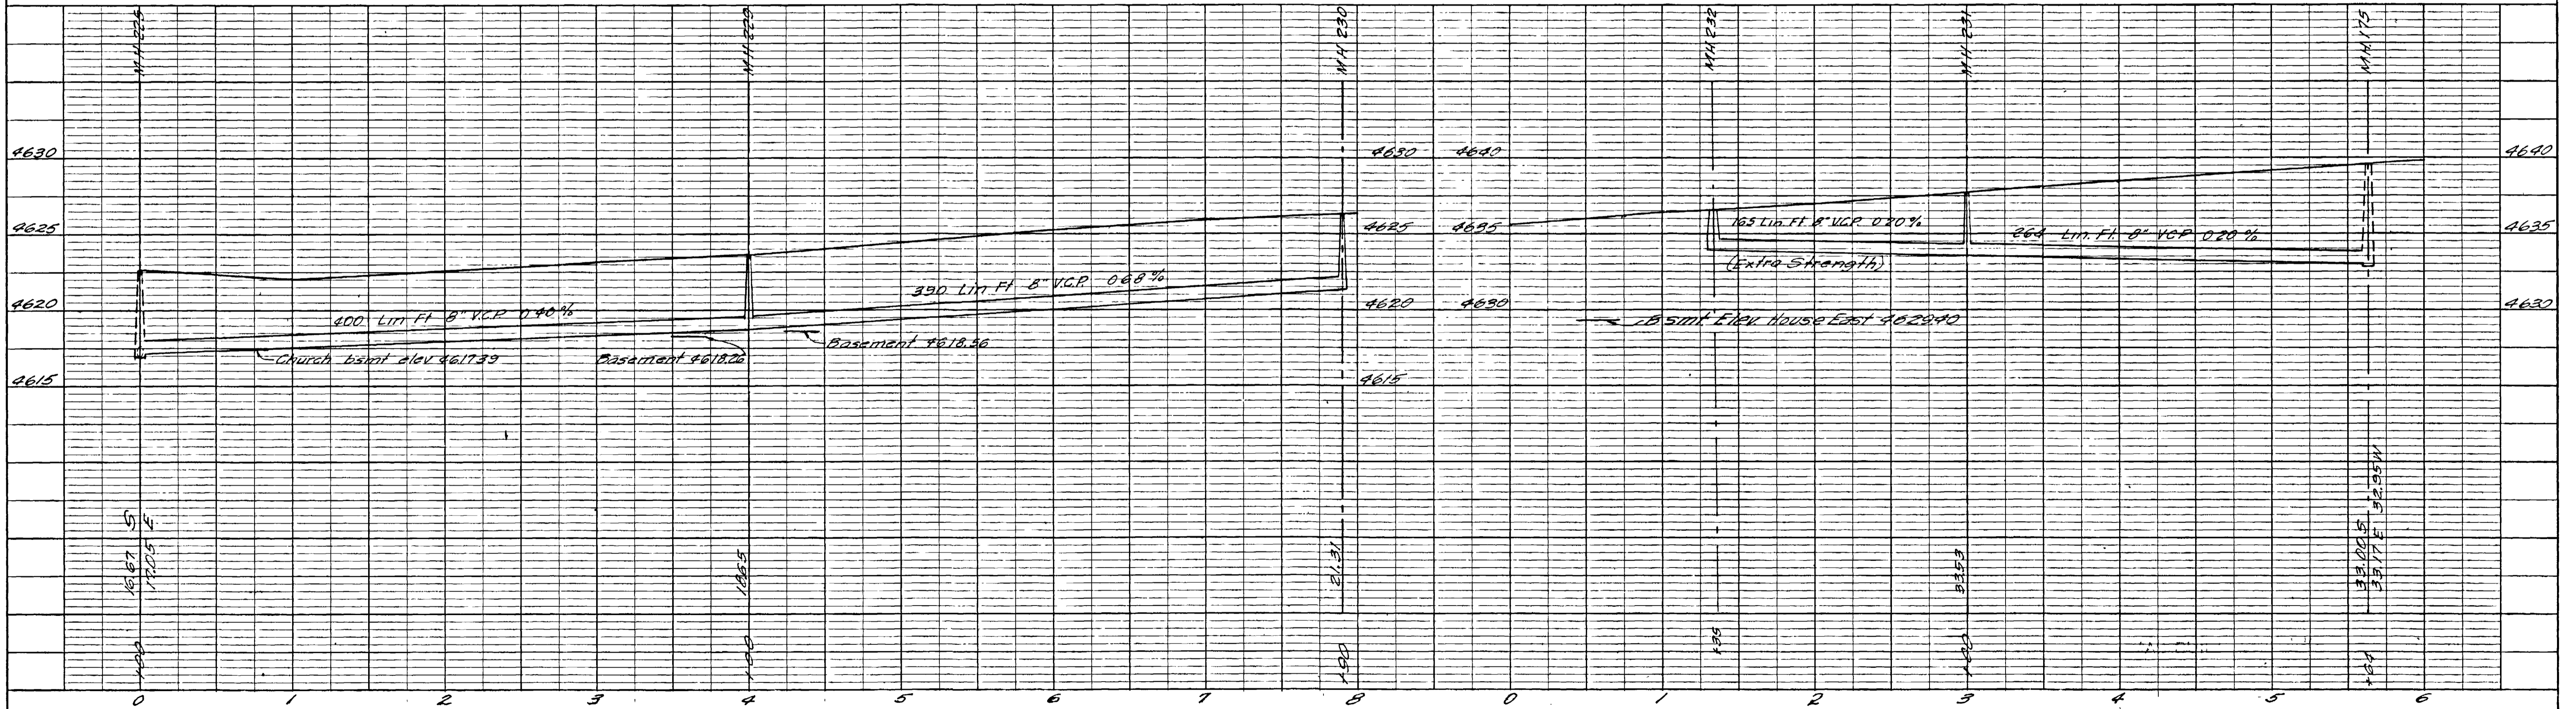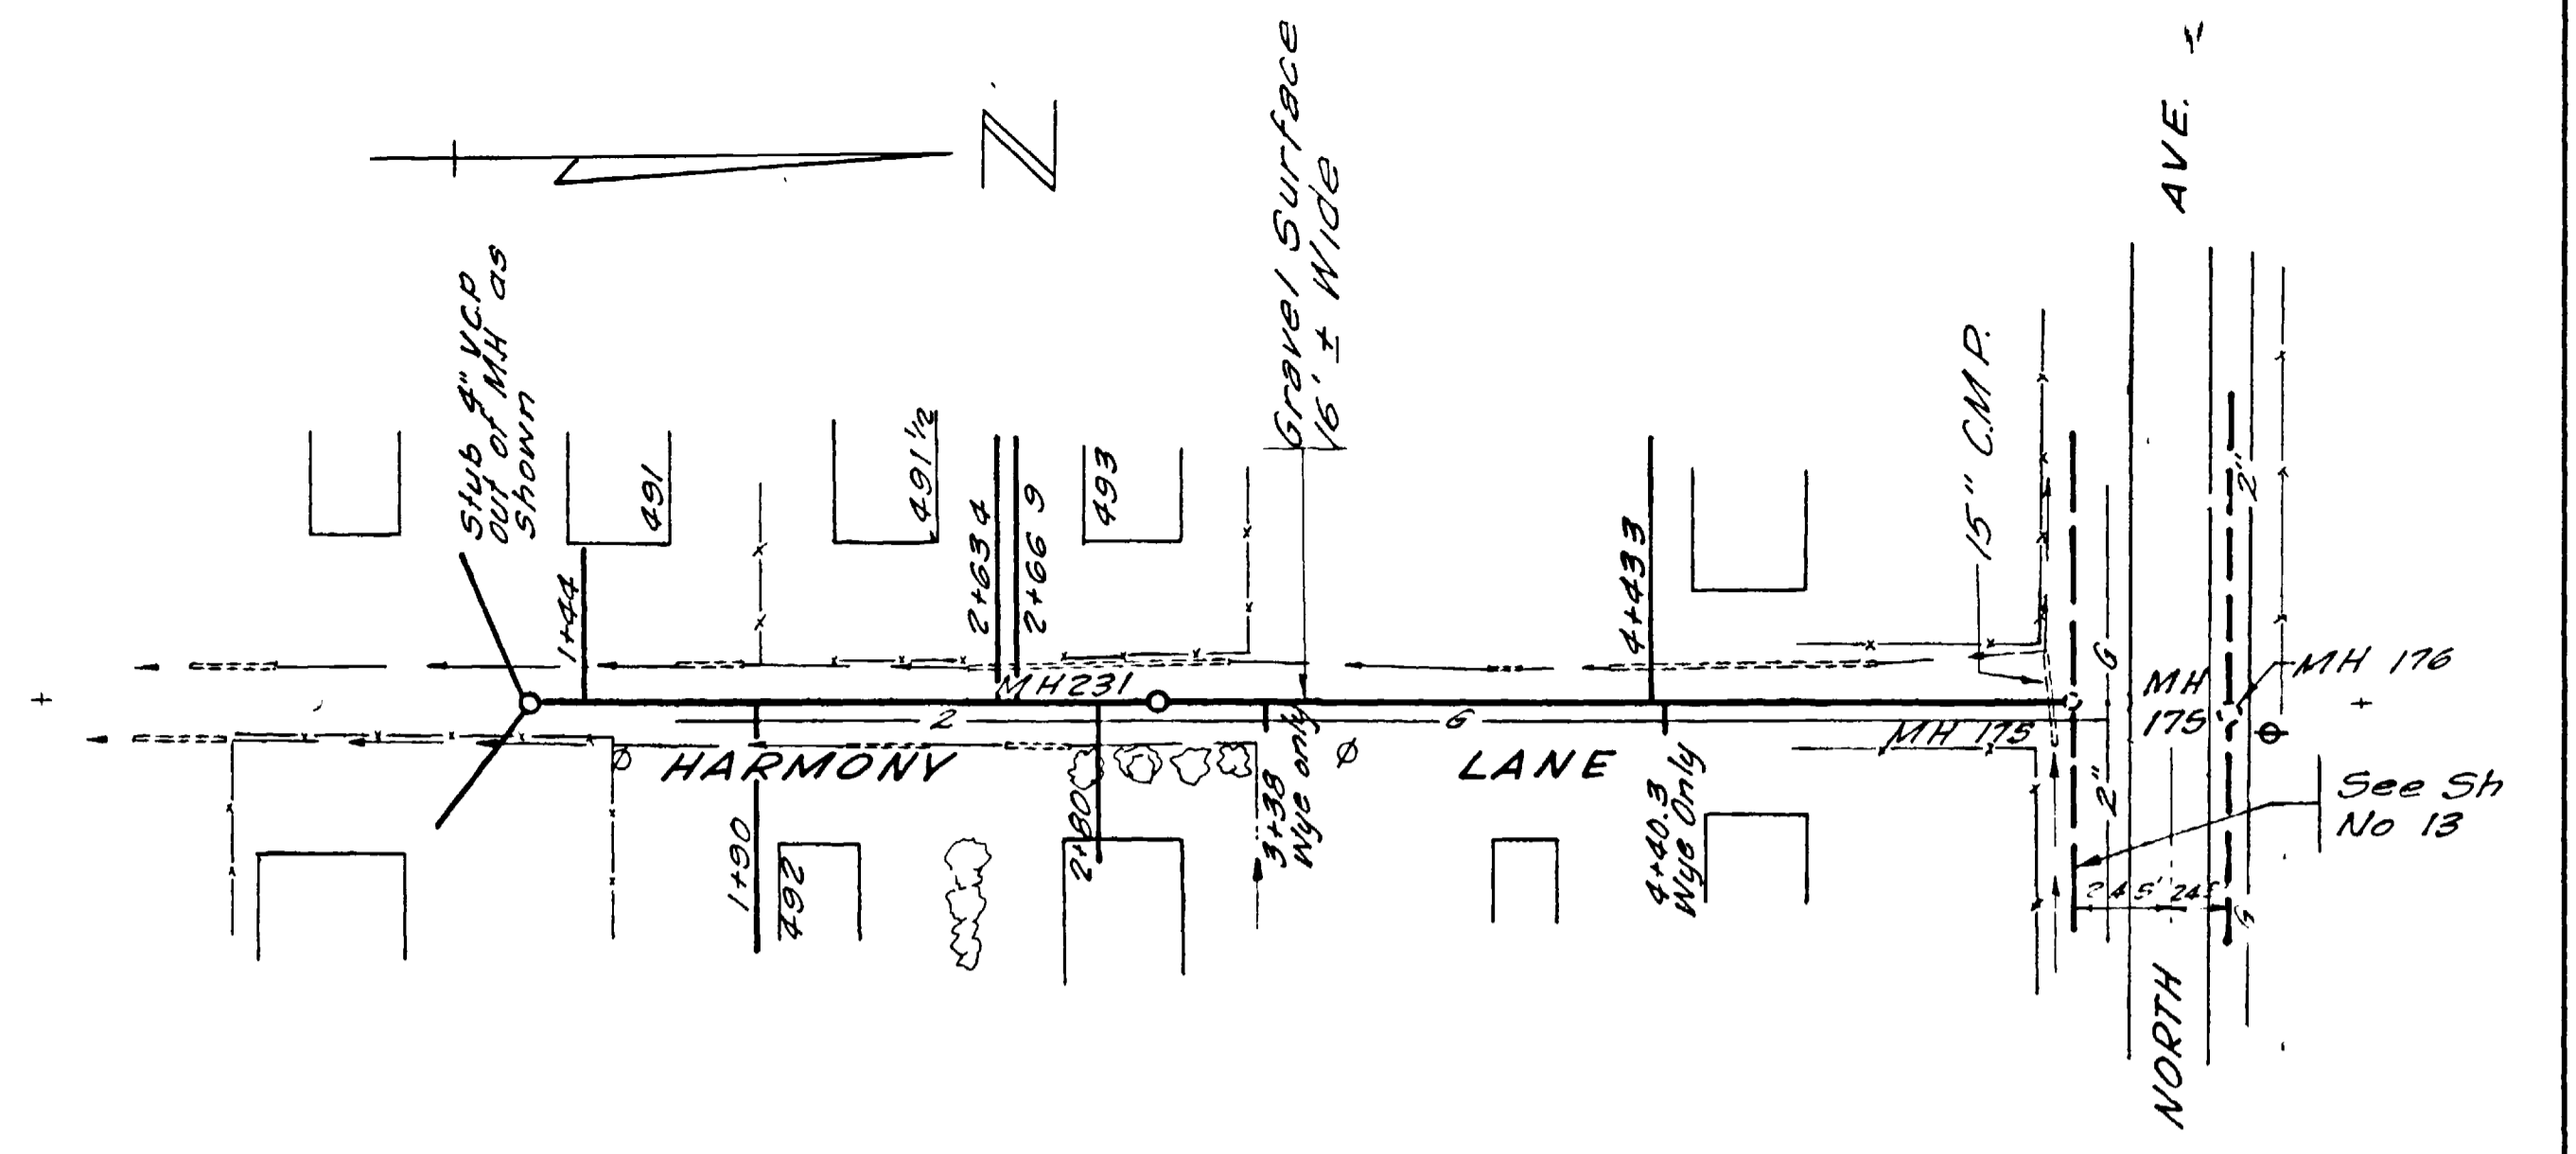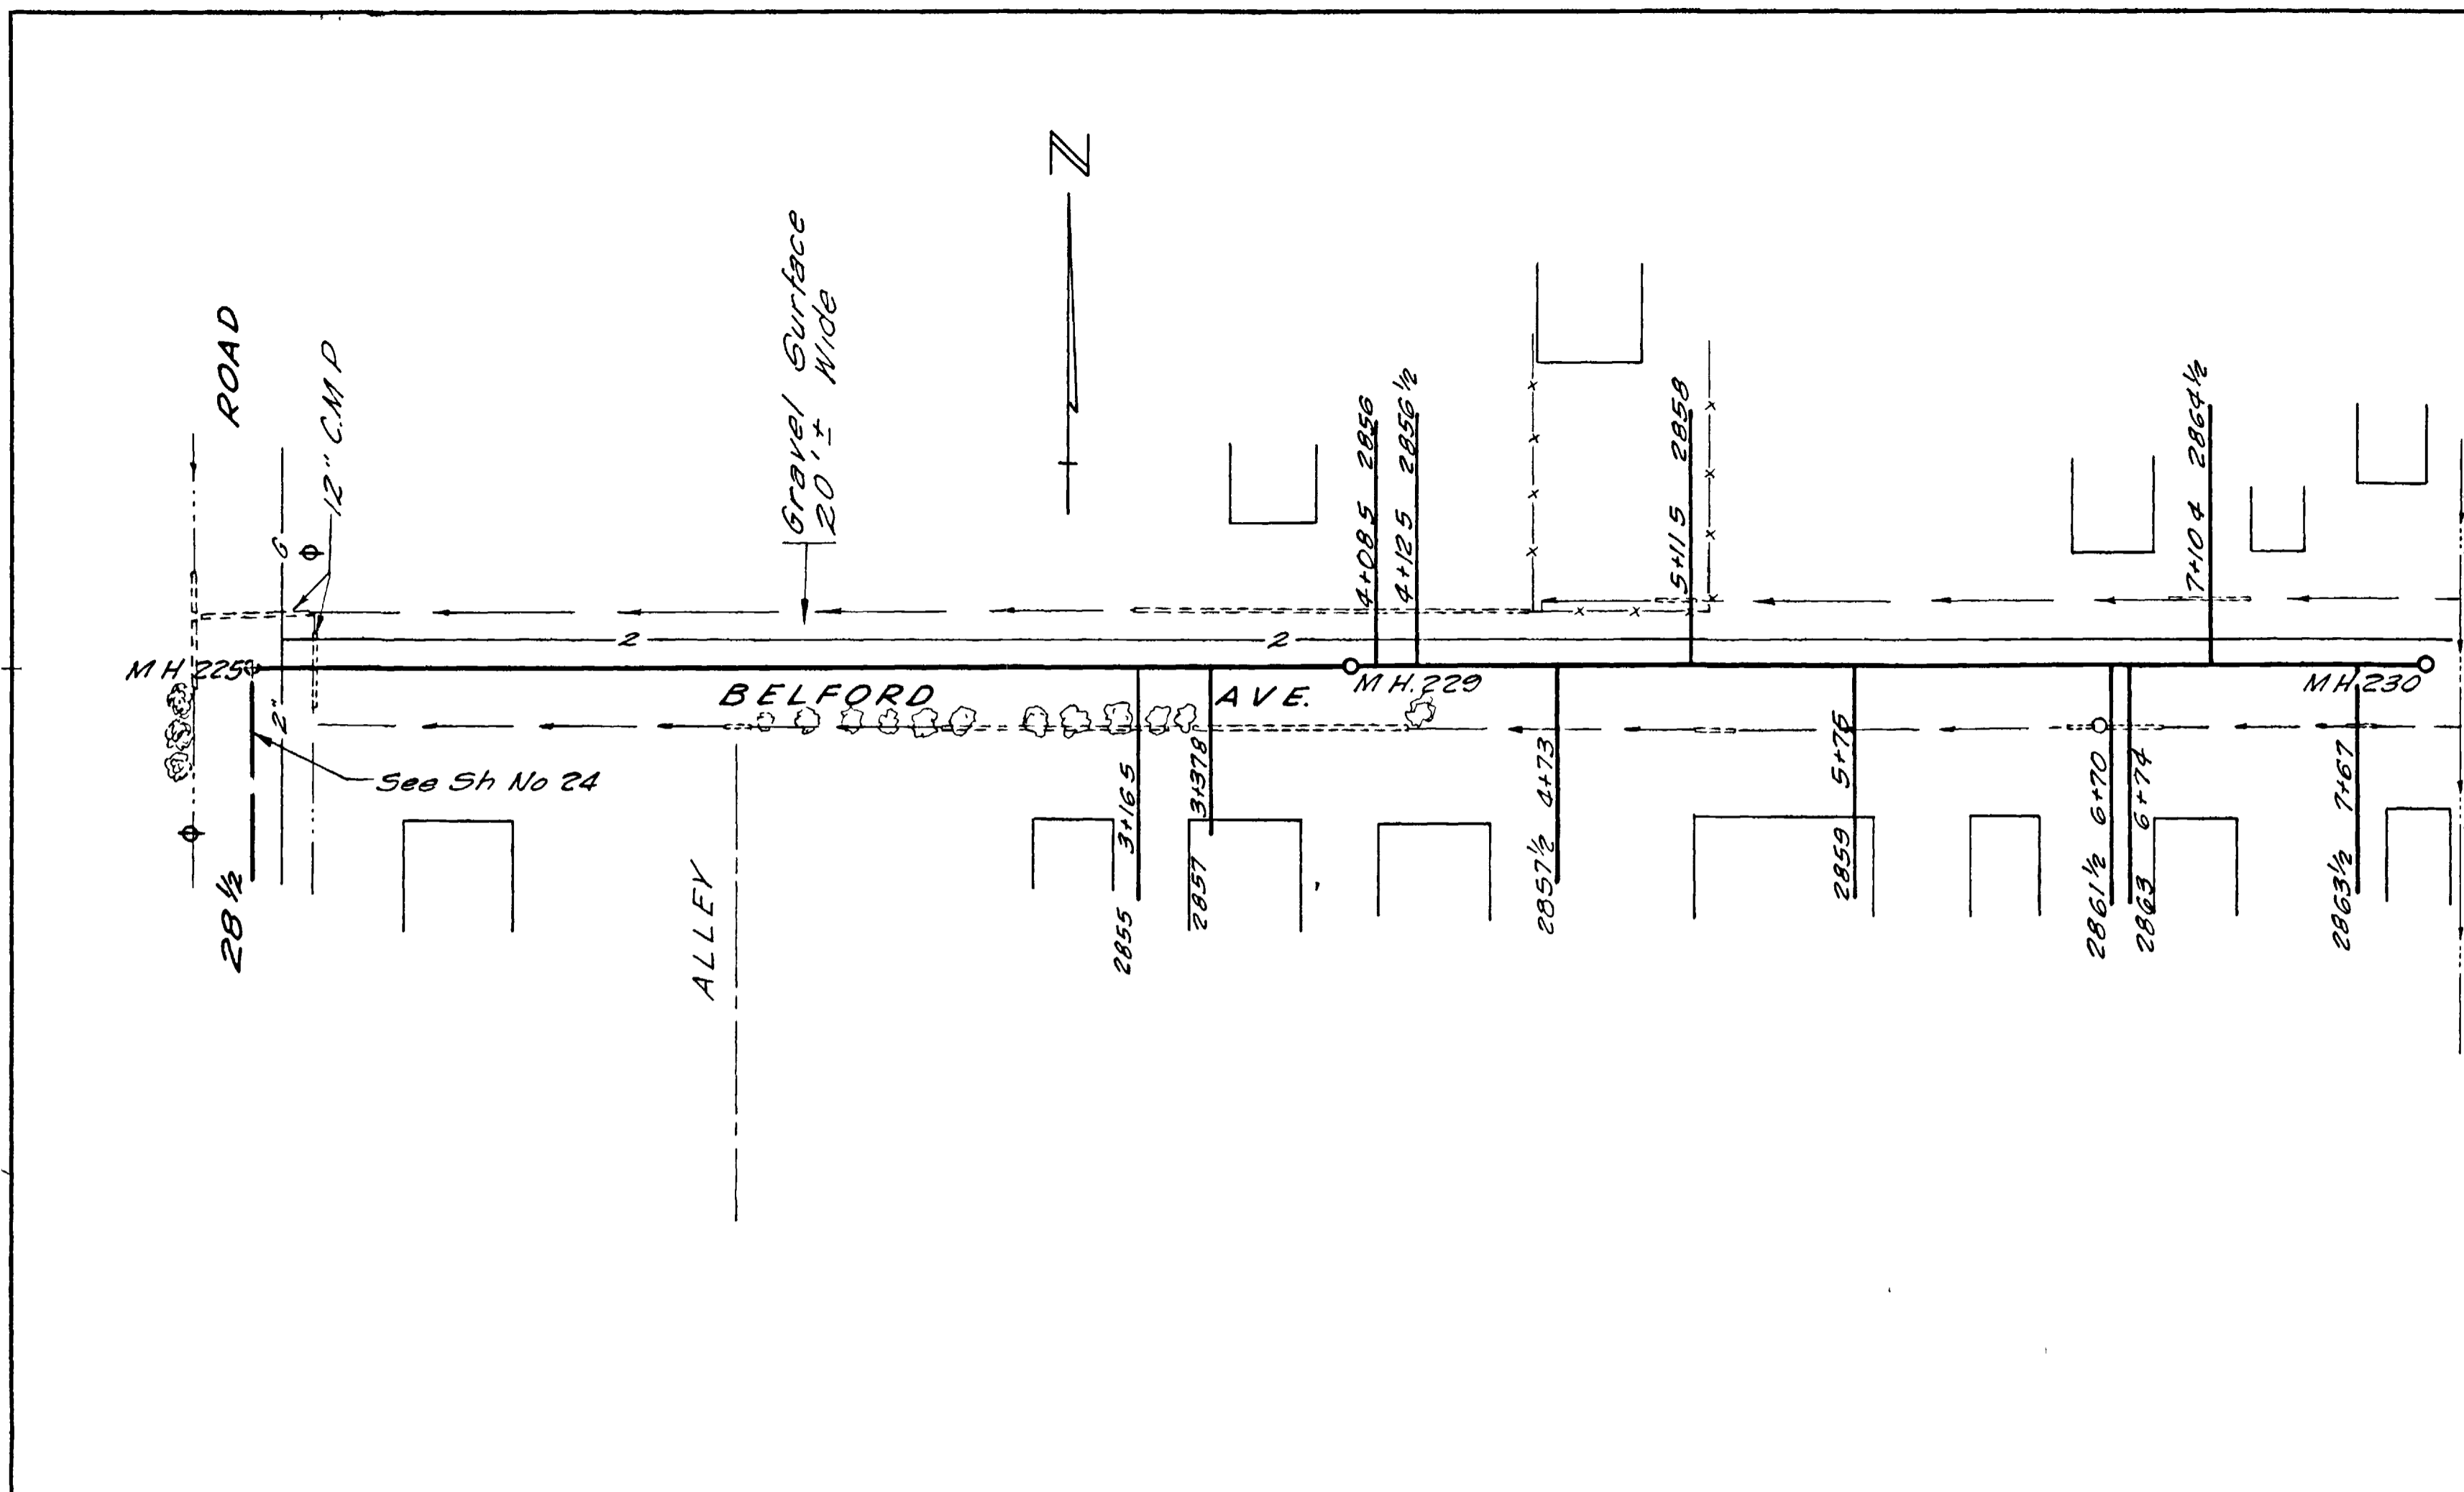

REVISIONS		DATE		DRAWN		JOB NO.	
By	DATE	DESCR	DATE	DATE	DATE	DATE	DATE
By	DATE	DESCR	DATE	DATE	DATE	DATE	DATE



HAROLD HOSKINS & ASSOCIATES
ENGINEERING CONSULTANTS
Greeley, Colorado LINCOLN, NEBRASKA

FRUITVALE, COLORADO
WATER & SANITATION DISTRICT

BELFORD AVENUE
HARMONY LANE



66 S.E.T. 10
SHEET: 26

02081726.tif

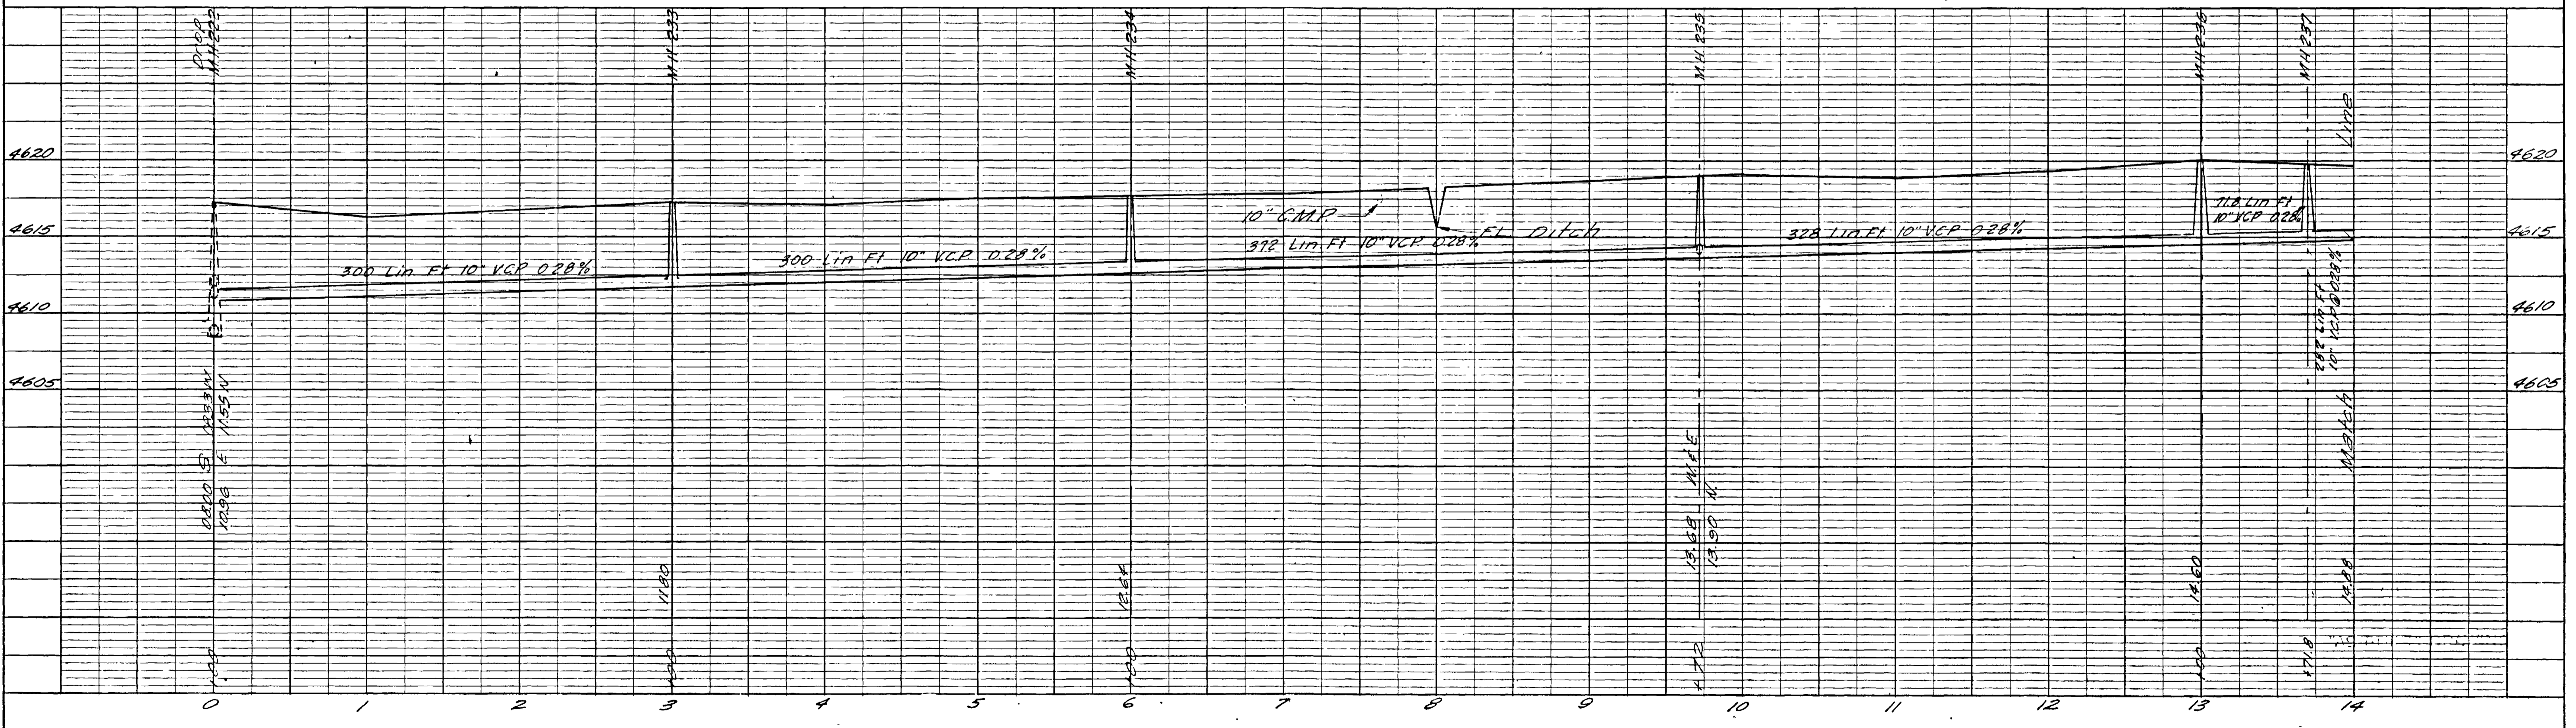
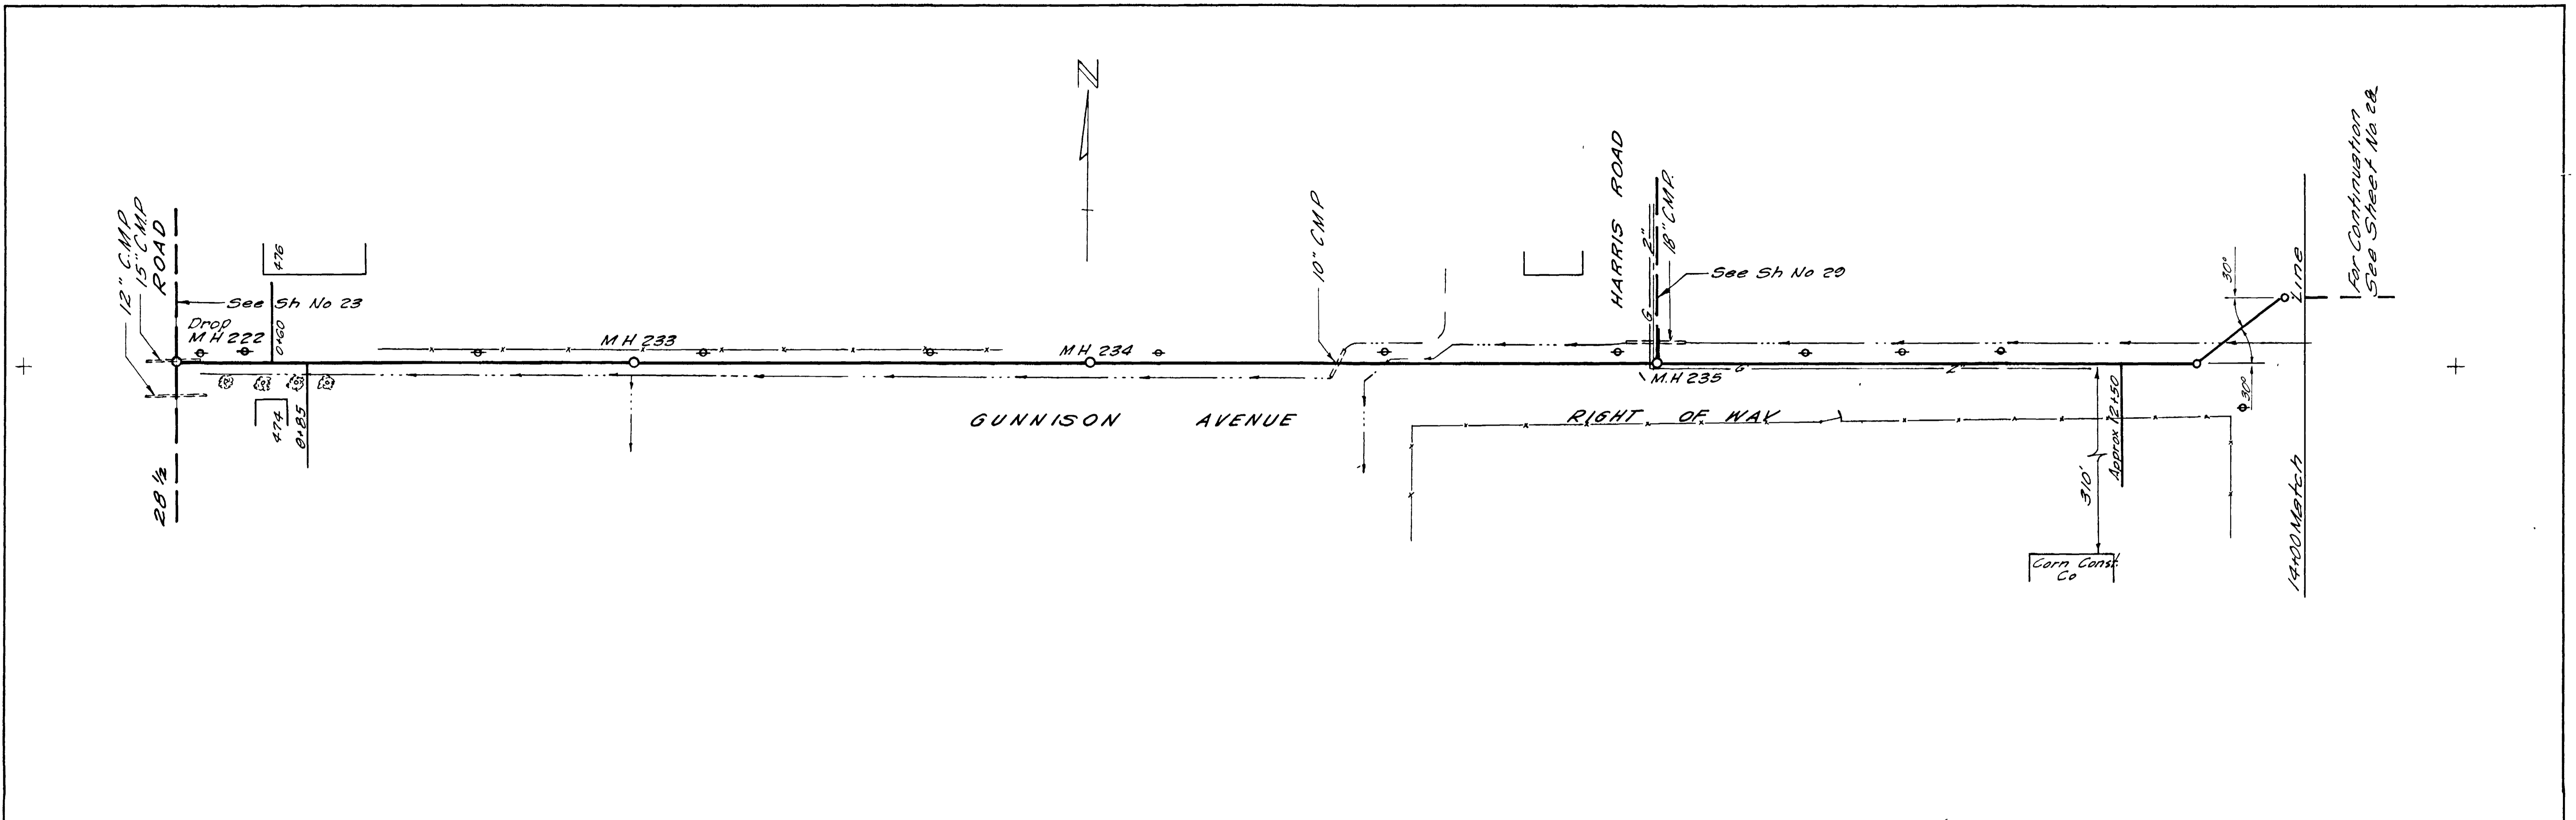


REVISIONS BY: <i>RCT</i> DATE: <i>Feb 1962</i> DESCR: <i>grades</i> BY: _____ DATE: _____ DESCR: _____ BY: _____ DATE: _____ DESCR: _____		DATE: <i>October 1957</i> DRAWN: <i>R.V.R.</i> JOB NO: <i>G-205</i> CHECKED: <i>R.E.T.</i> FILE NO: _____ APPROVED: <i>[Signature]</i> T B NO: _____	HAROLD HOSKINS & ASSOCIATES ENGINEERING CONSULTANTS GREELEY, COLORADO LINCOLN, NEBRASKA	FRUITVALE, COLORADO WATER & SANITATION DISTRICT	GUNNISON AVENUE STA. 0+00 TO STA. 14+00 66 SHEETS 27
----------------------------------------------------------------------------------------------------------------------------------------------------	--	------------------------------------------------------------------------------------------------------------------------------------------------------------	-----------------------------------------------------------------------------------------------	----------------------------------------------------	---------------------------------------------------------

02081727.tif

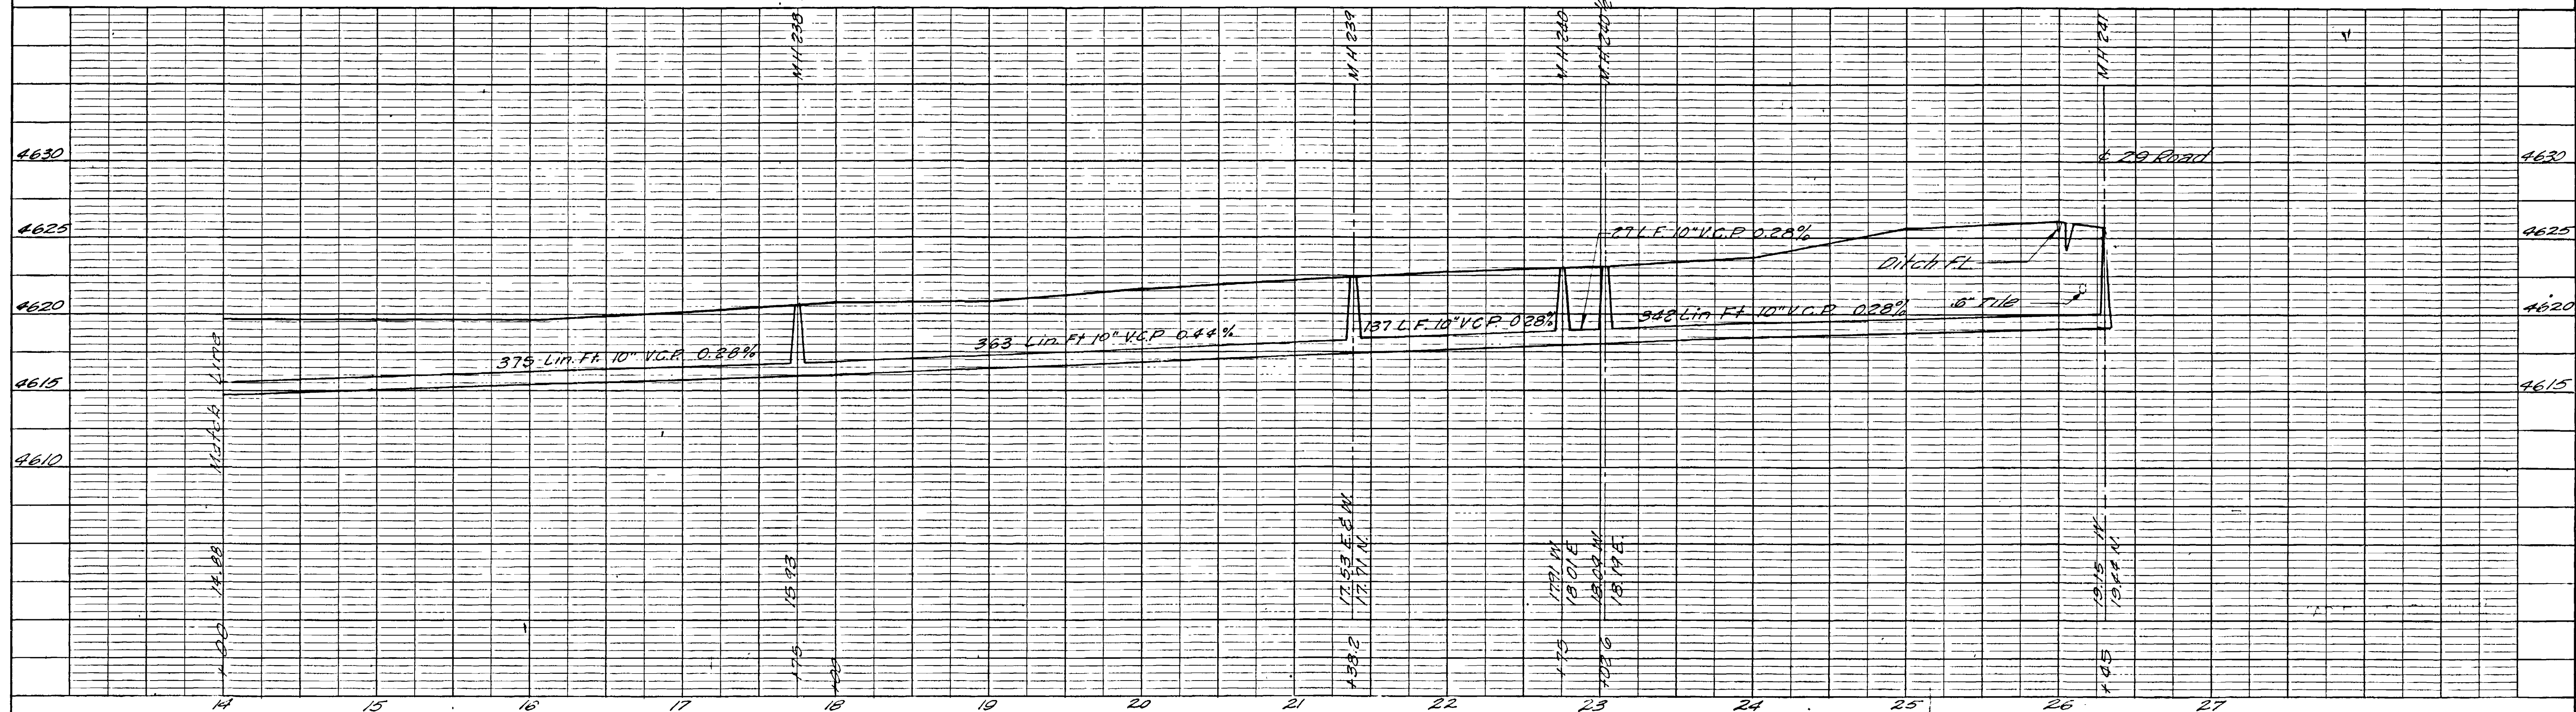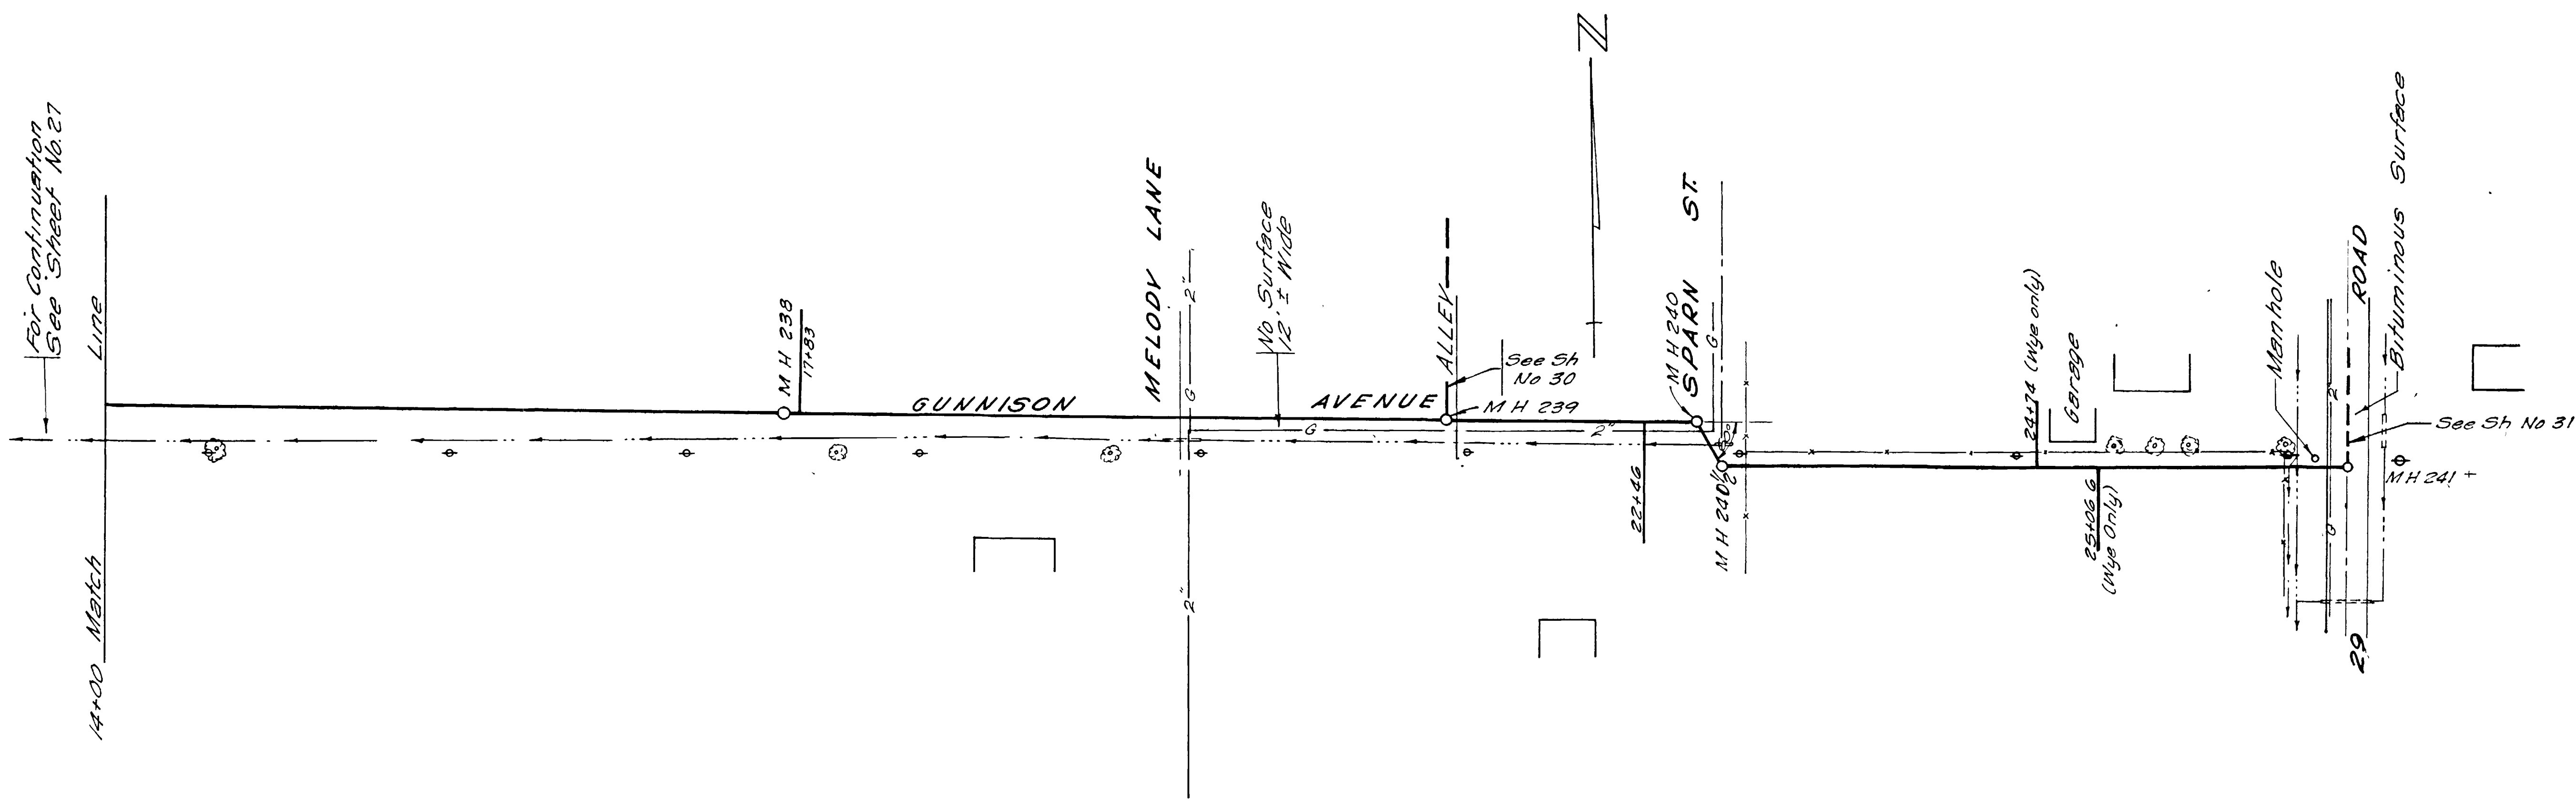

REVISIONS BY: R.C.T. DATE: Feb 1960 DESC: Grade BY: DATE: DESC:		DATE: October 1957 DRAWN: D.J.R. JOB NO: G-205 CHECKED: R.C.T. FILE NO: APPROVED: R.C.T. P.B. NO:		HAROLD HOSKINS & ASSOCIATES ENGINEERING CONSULTANTS GREELEY, COLORADO LINCOLN, NEBRASKA		FRUITVALE, COLORADO WATER & SANITATION DISTRICT		GUNNISON AVENUE STA. 14+00 TO STA. 26+31 66 SHEETS 28 SHEETS	
-----------------------------------------------------------------------	--	---------------------------------------------------------------------------------------------------------	--	-----------------------------------------------------------------------------------------------	--	----------------------------------------------------	--	--------------------------------------------------------------------	--

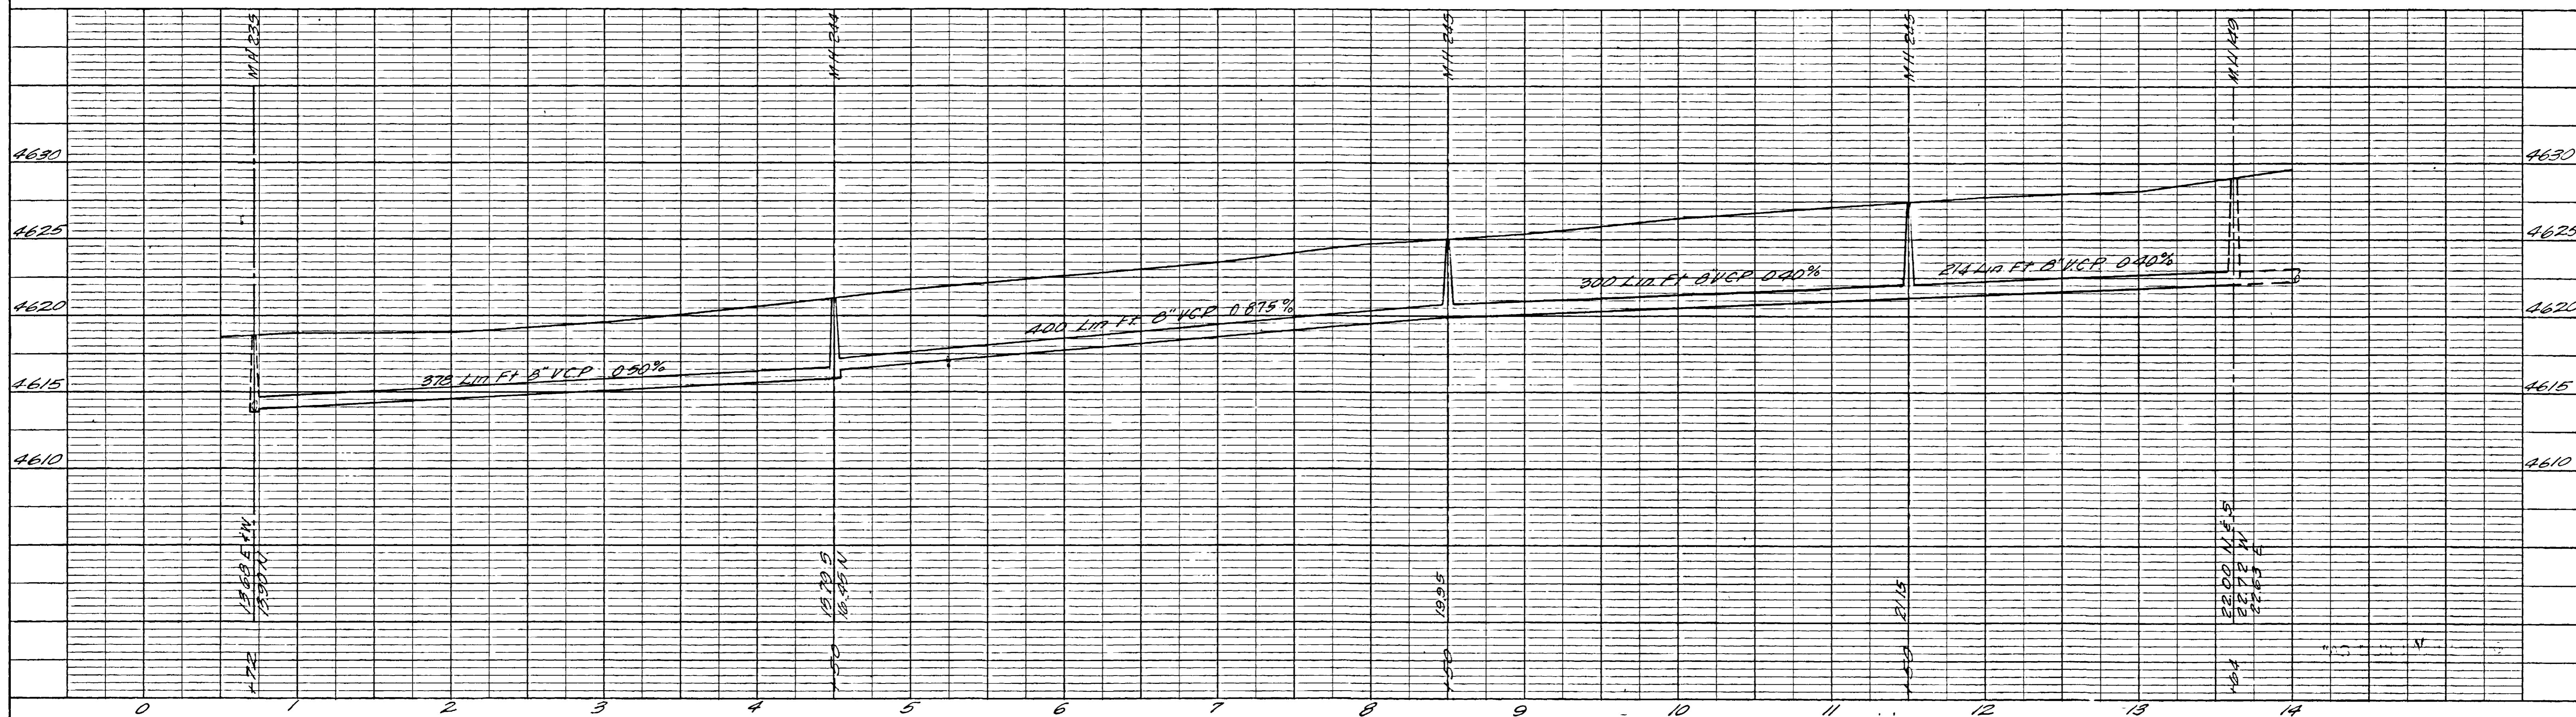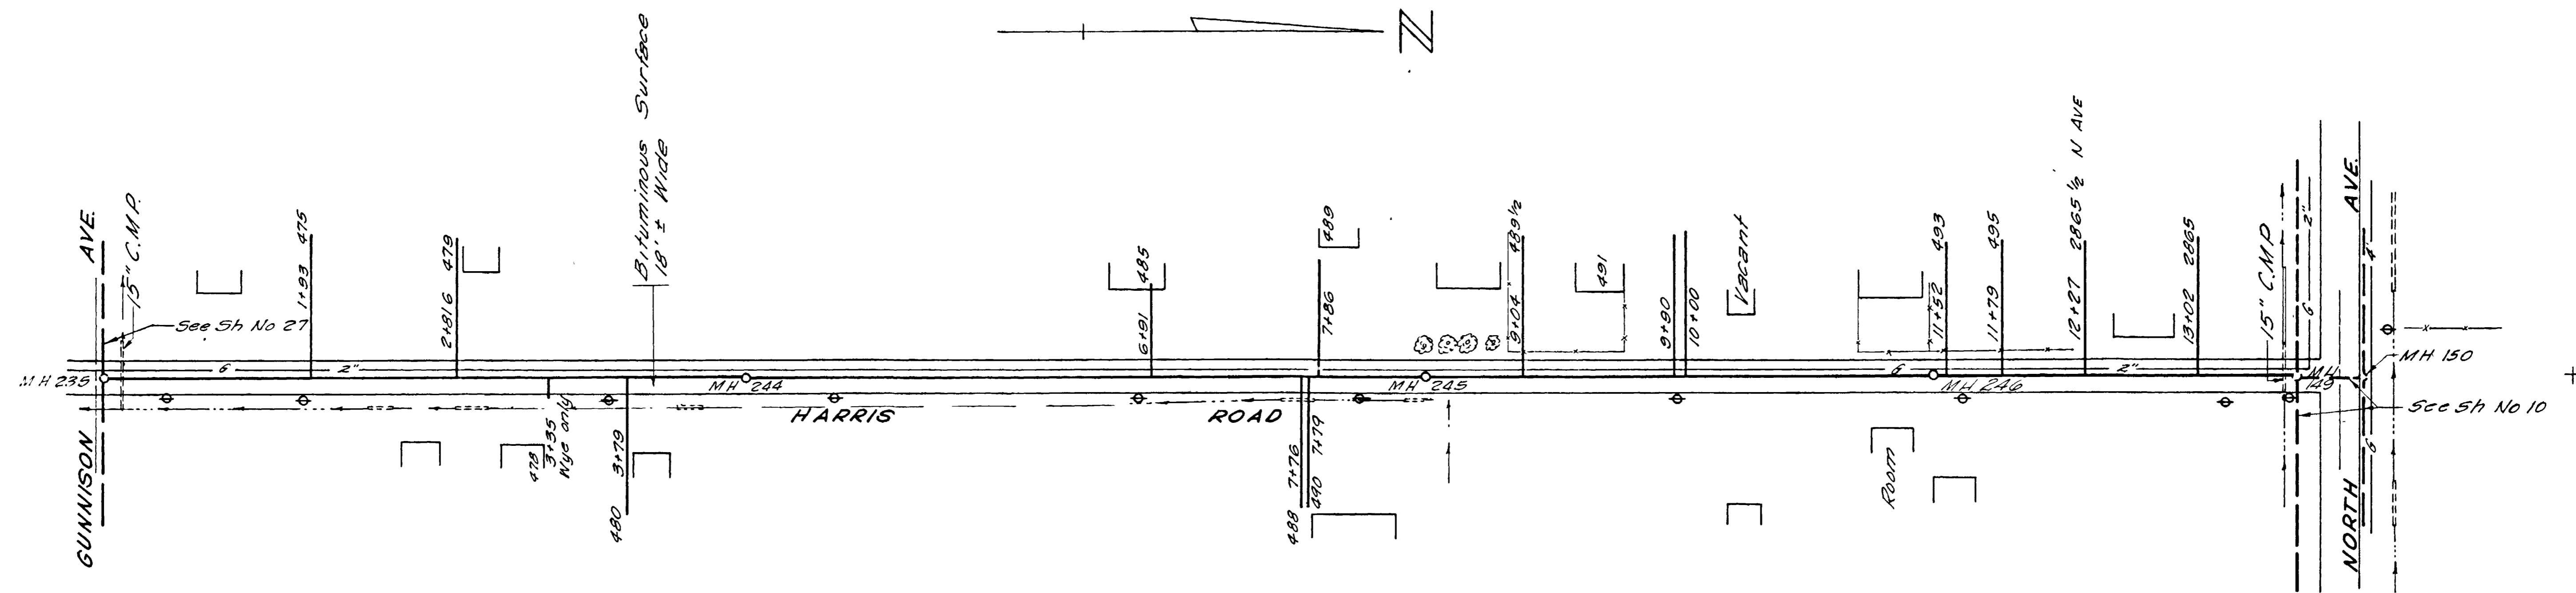

REVISIONS	DATE	BY	DESCR	DATE	BY	DESCR	DATE	BY	DESCR
	Feb. 1990	B.S.T.	Grade						

DATE: October 1957
 DRAWN: D.V.R.
 CHECKED: [Signature]
 APPROVED: [Signature]



HAROLD HOSKINS & ASSOCIATES
 ENGINEERING CONSULTANTS
 GREELEY, COLORADO

FRUITVALE, COLORADO
 WATER & SANITATION DISTRICT


HARRIS ROAD

66 SHEET NO.
 29 SHEETS


02081729.tif

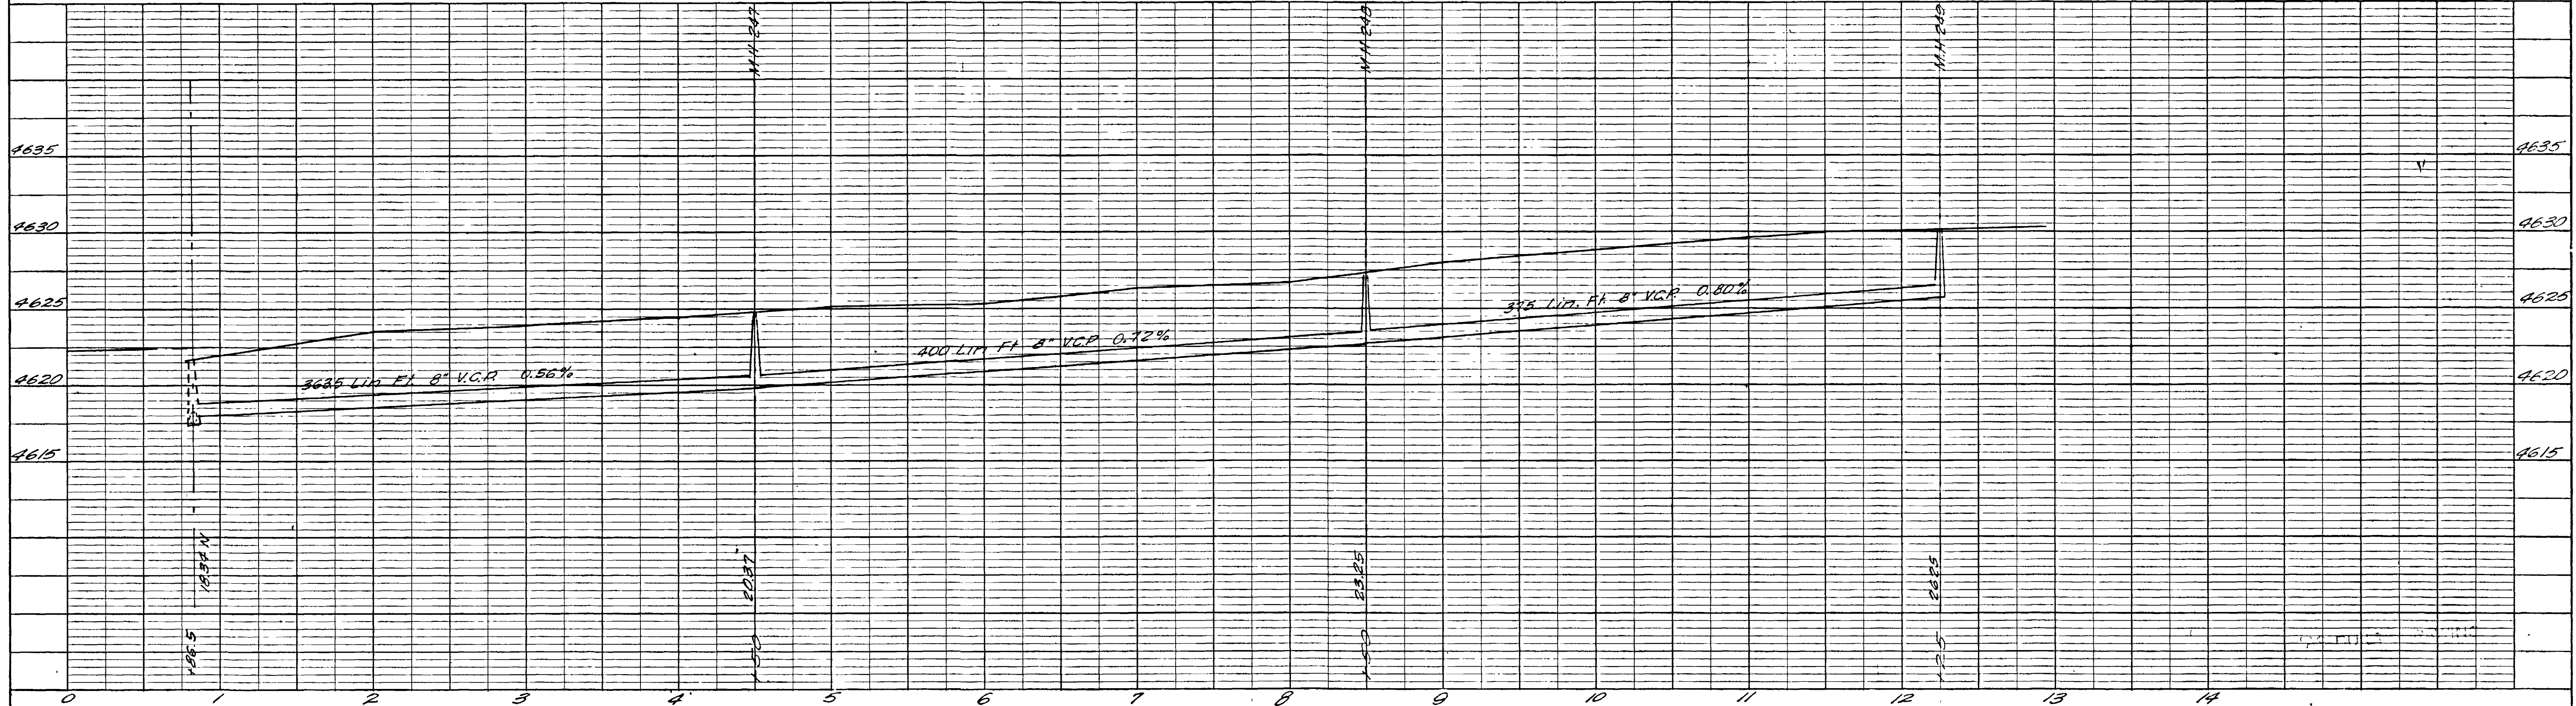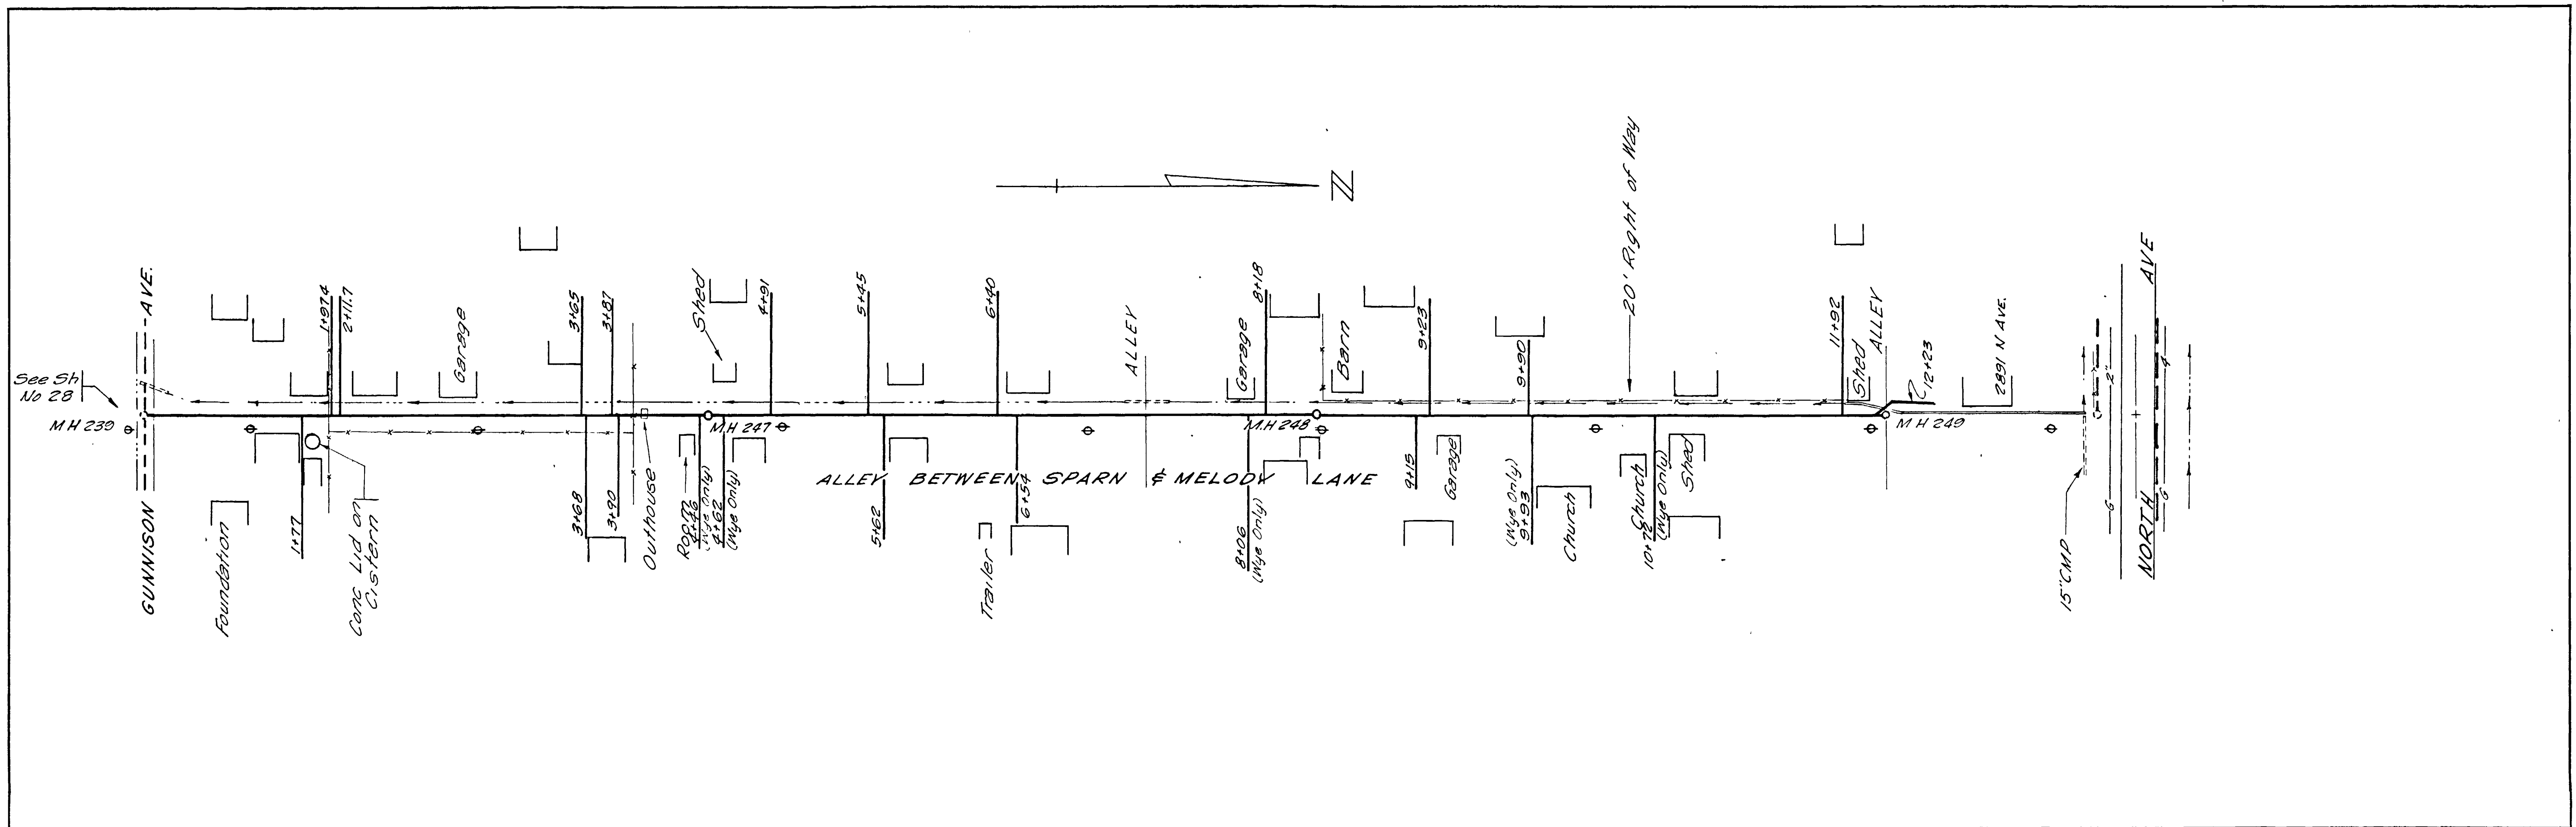



REVISIONS BY: <u>R.C.T.</u> DATE: <u>Feb 1960</u> DESCR: <u>Grade & Alignment</u> BY: _____ DATE: _____ DESCR: _____ BY: _____ DATE: _____ DESCR: _____		DATE: <u>October 1957</u> DRAWN: <u>D.V.R.</u> JOB NO: <u>G-205</u> CHECKED: <u>R.C.T.</u> FILE NO: _____ APPROVED: <u>[Signature]</u> F & NO: _____		HAROLD HOSKINS & ASSOCIATES ENGINEERING CONSULTANTS GREELEY, COLORADO LINCOLN, NEBRASKA		FRUITVALE, COLORADO WATER & SANITATION DISTRICT		ALLEY BETWEEN SPARN STREET & MELODY LANE		66 SHEET NO SHEETS 30
----------------------------------------------------------------------------------------------------------------------------------------------------------------------	--	------------------------------------------------------------------------------------------------------------------------------------------------------------	--	-----------------------------------------------------------------------------------------------	--	----------------------------------------------------	--	------------------------------------------	--	--------------------------

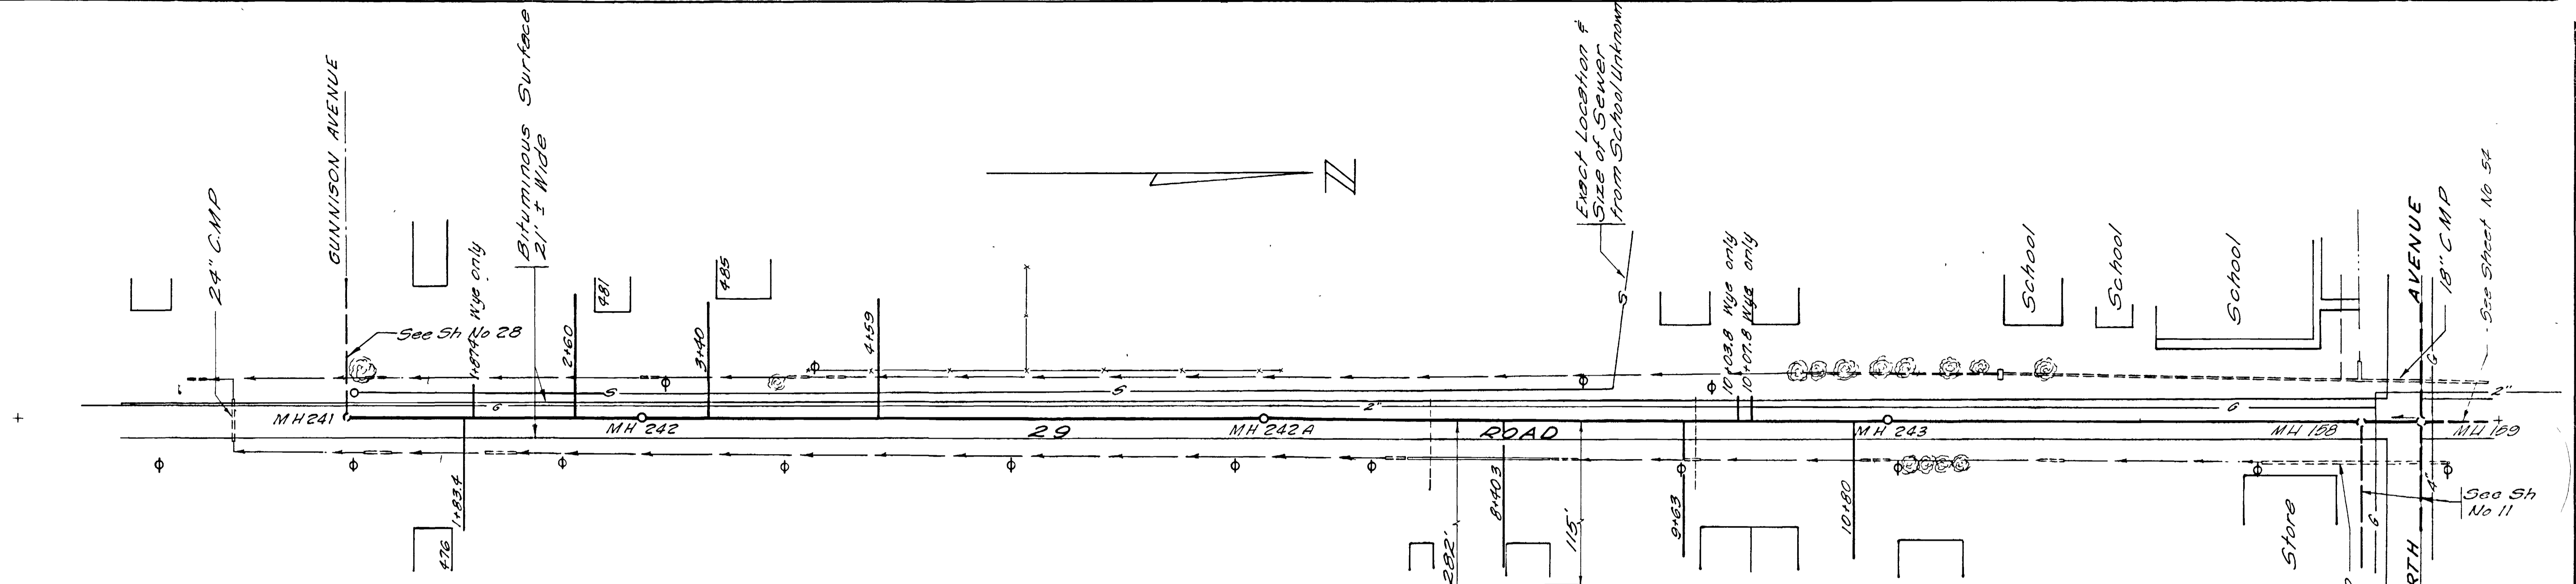



NOTE: Special Backfill Req'd. Sta 4+50 to Sta 14+00
 (6-7') Trench Depth = 375 Lin. Ft.
 (7-8') Trench Depth = 150 Lin. Ft.
 (8-9') Trench Depth = 175 Lin. Ft.
 (9-10') Trench Depth = 250 Lin. Ft.

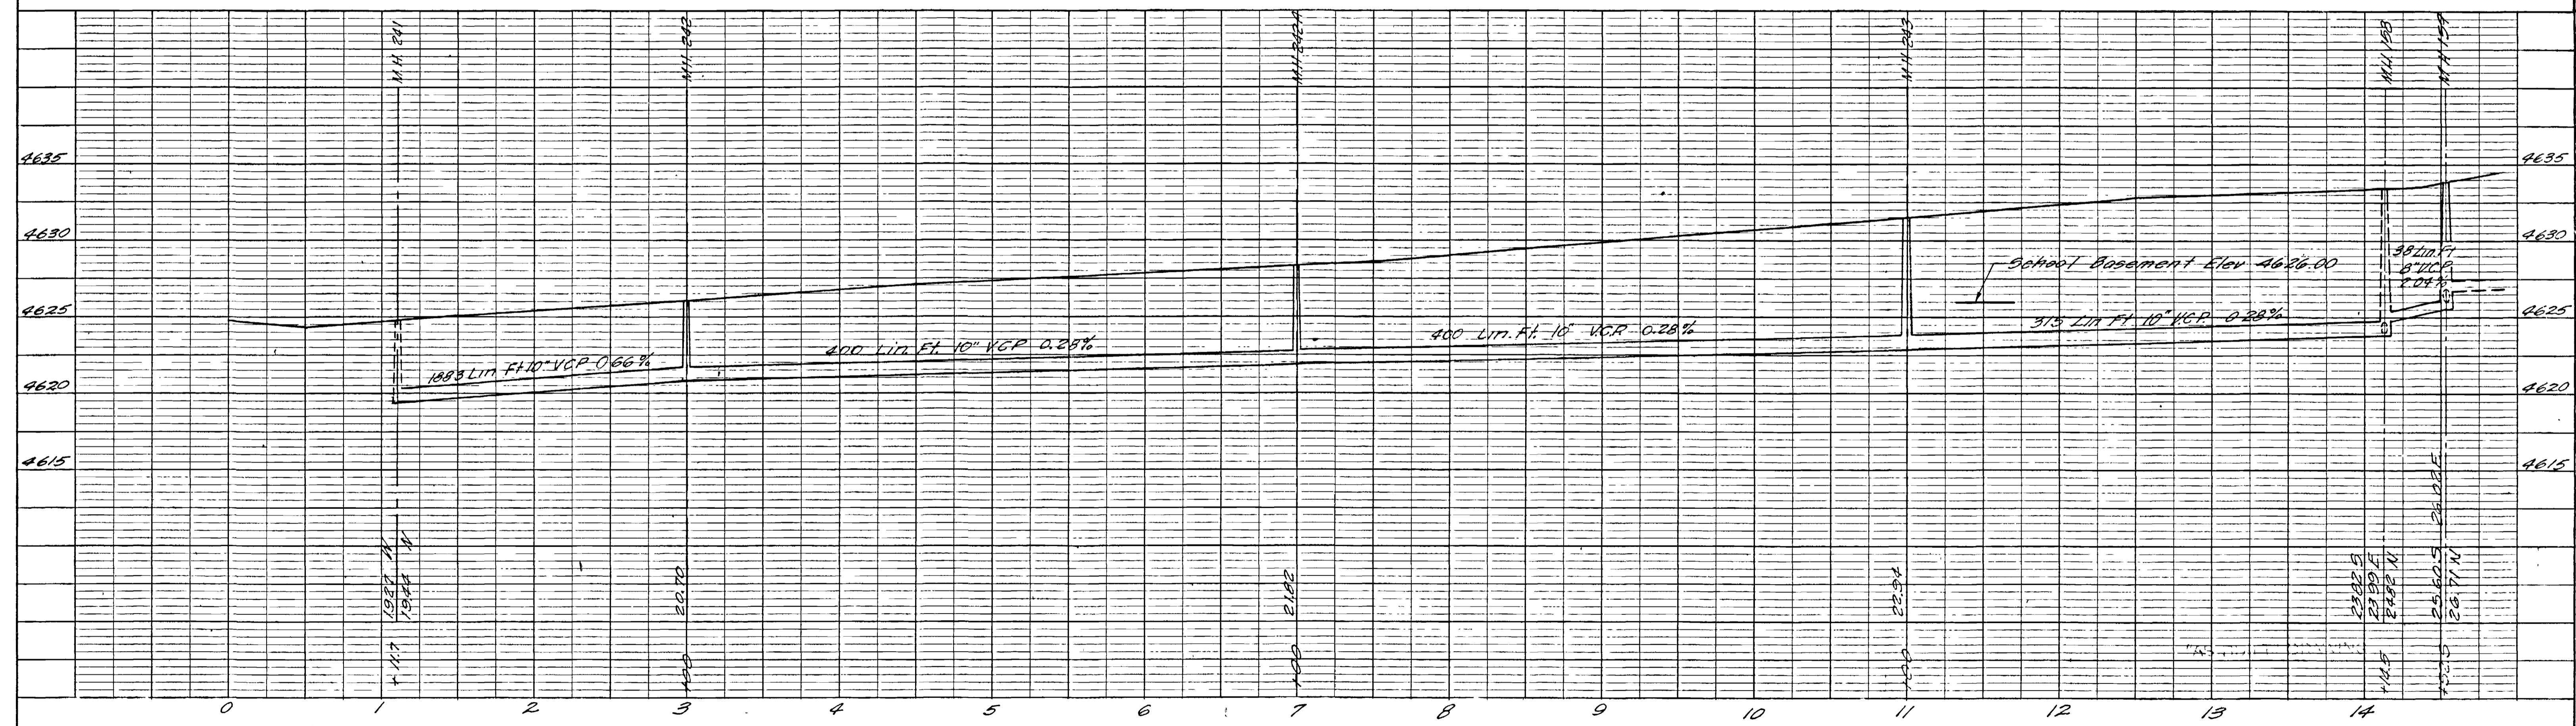

REVISIONS BY: R.C.T. DATE: Feb 1960 DESCR: Grade BY: DATE: DESCR:	DATE: October 1952 DRAWN: D.V.R. JOB NO: G-205 CHECKED: R.C.T. FILE NO: APPROVED: [Signature] F.B. NO.:	HAROLD HOSKINS & ASSOCIATES ENGINEERING CONSULTANTS GREELEY, COLORADO LINCOLN, NEBRASKA	FRUITVALE, COLORADO WATER & SANITATION DISTRICT	29 ROAD SOUTH FROM NORTH AVENUE SHEET NO. 66 SHEETS 31
-------------------------------------------------------------------------	---------------------------------------------------------------------------------------------------------------	-----------------------------------------------------------------------------------------------	----------------------------------------------------	--------------------------------------------------------------

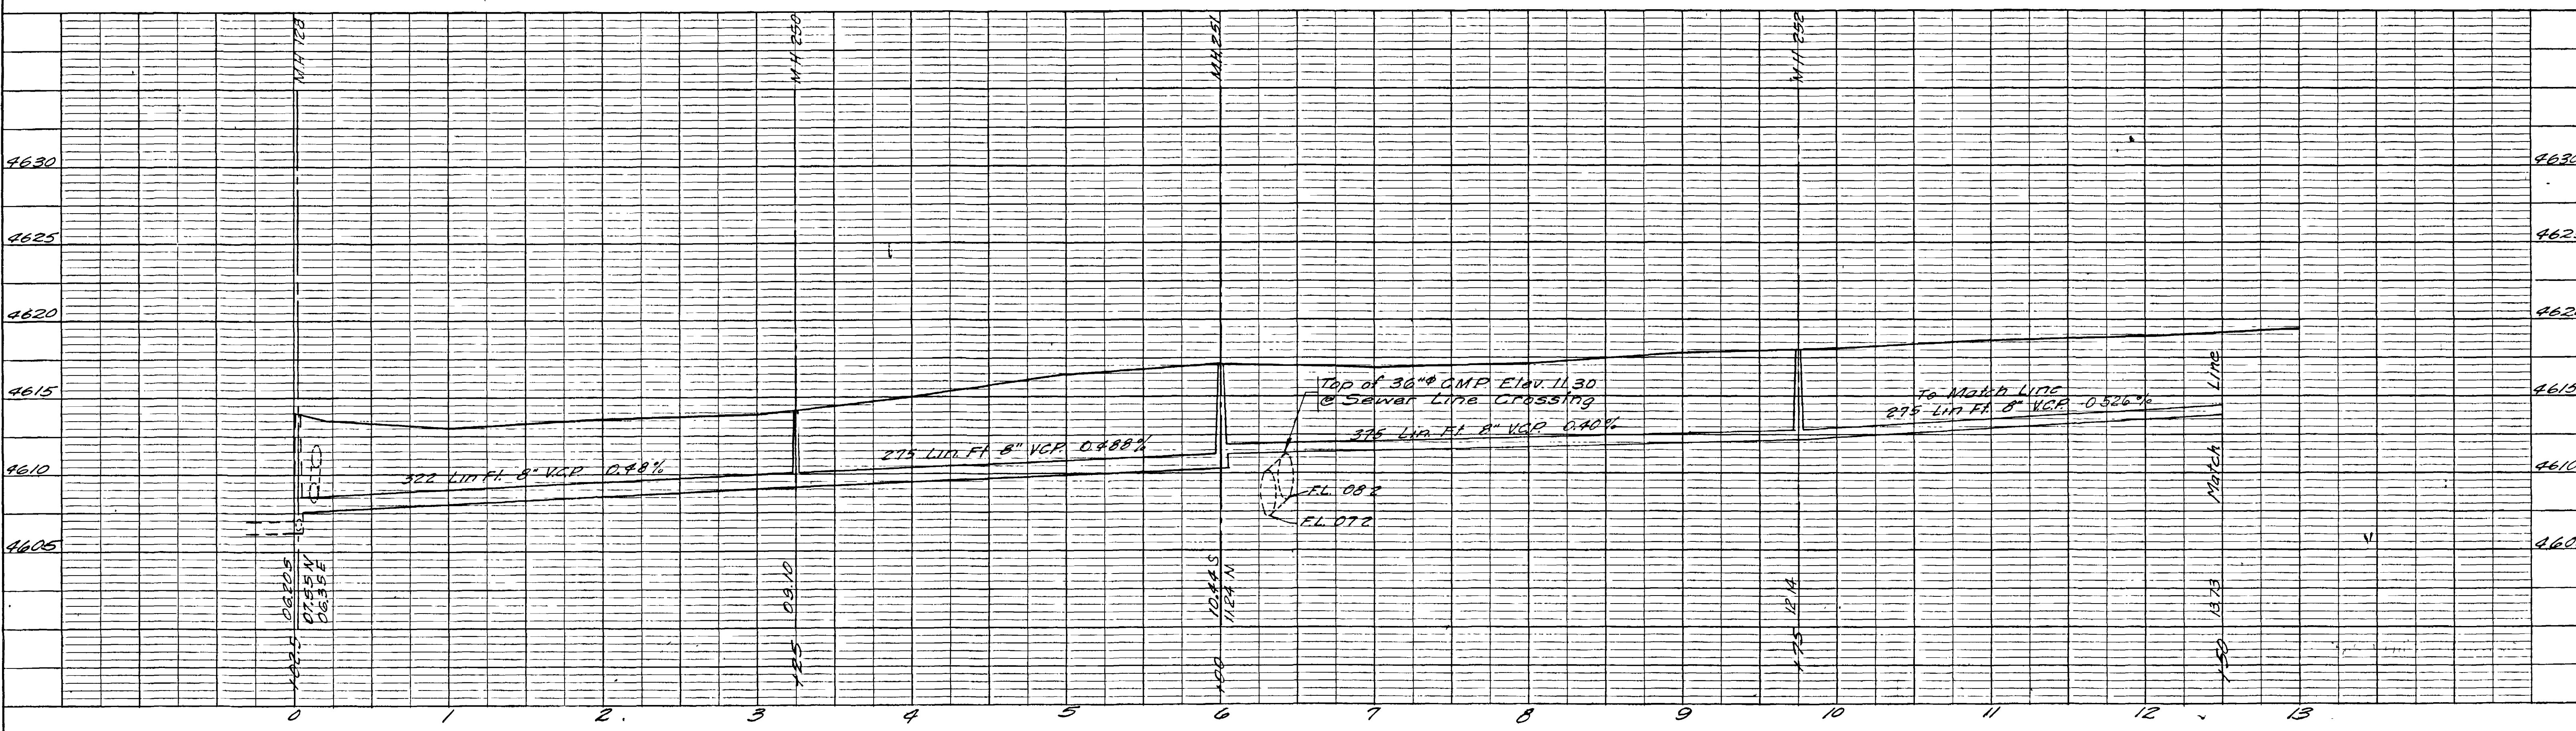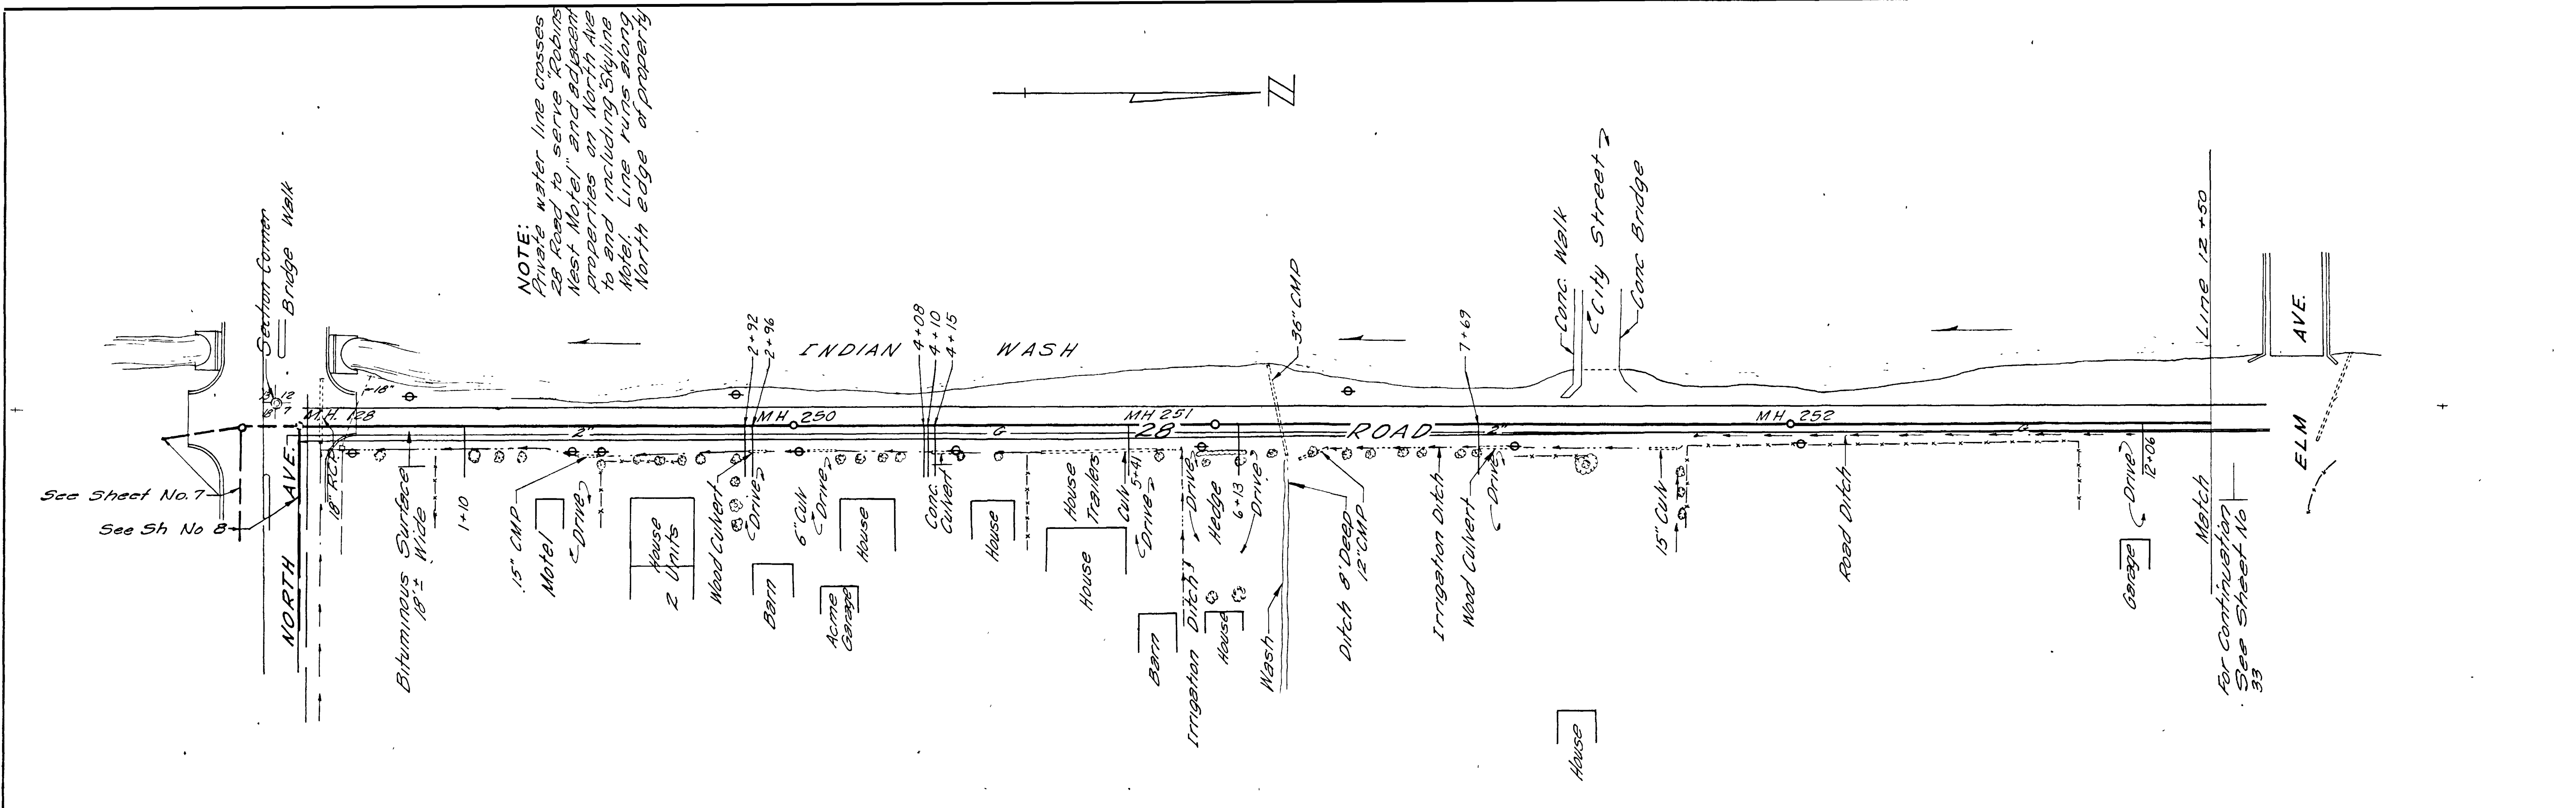

REVISIONS BY: R.H. DATE: Feb 1960 DESCR: Change BY: DATE: DESCR:		DATE: October 1957 DRAWN: D.V.R. CHECKED: R.G.F. APPROVED: W.H.	JOB NO: G-205 FILE NO: F B NO:	HAROLD HOSKINS & ASSOCIATES ENGINEERING CONSULTANTS GREELEY, COLORADO	FRUITVALE, COLORADO WATER & SANITATION DISTRICT LINCOLN, NEBRASKA	28 ROAD NORTH OF NORTH AVENUE	66 SHEET NO SHEETS 32
------------------------------------------------------------------------	--	-----------------------------------------------------------------------	--------------------------------------	-----------------------------------------------------------------------------	-------------------------------------------------------------------------	-------------------------------	--------------------------

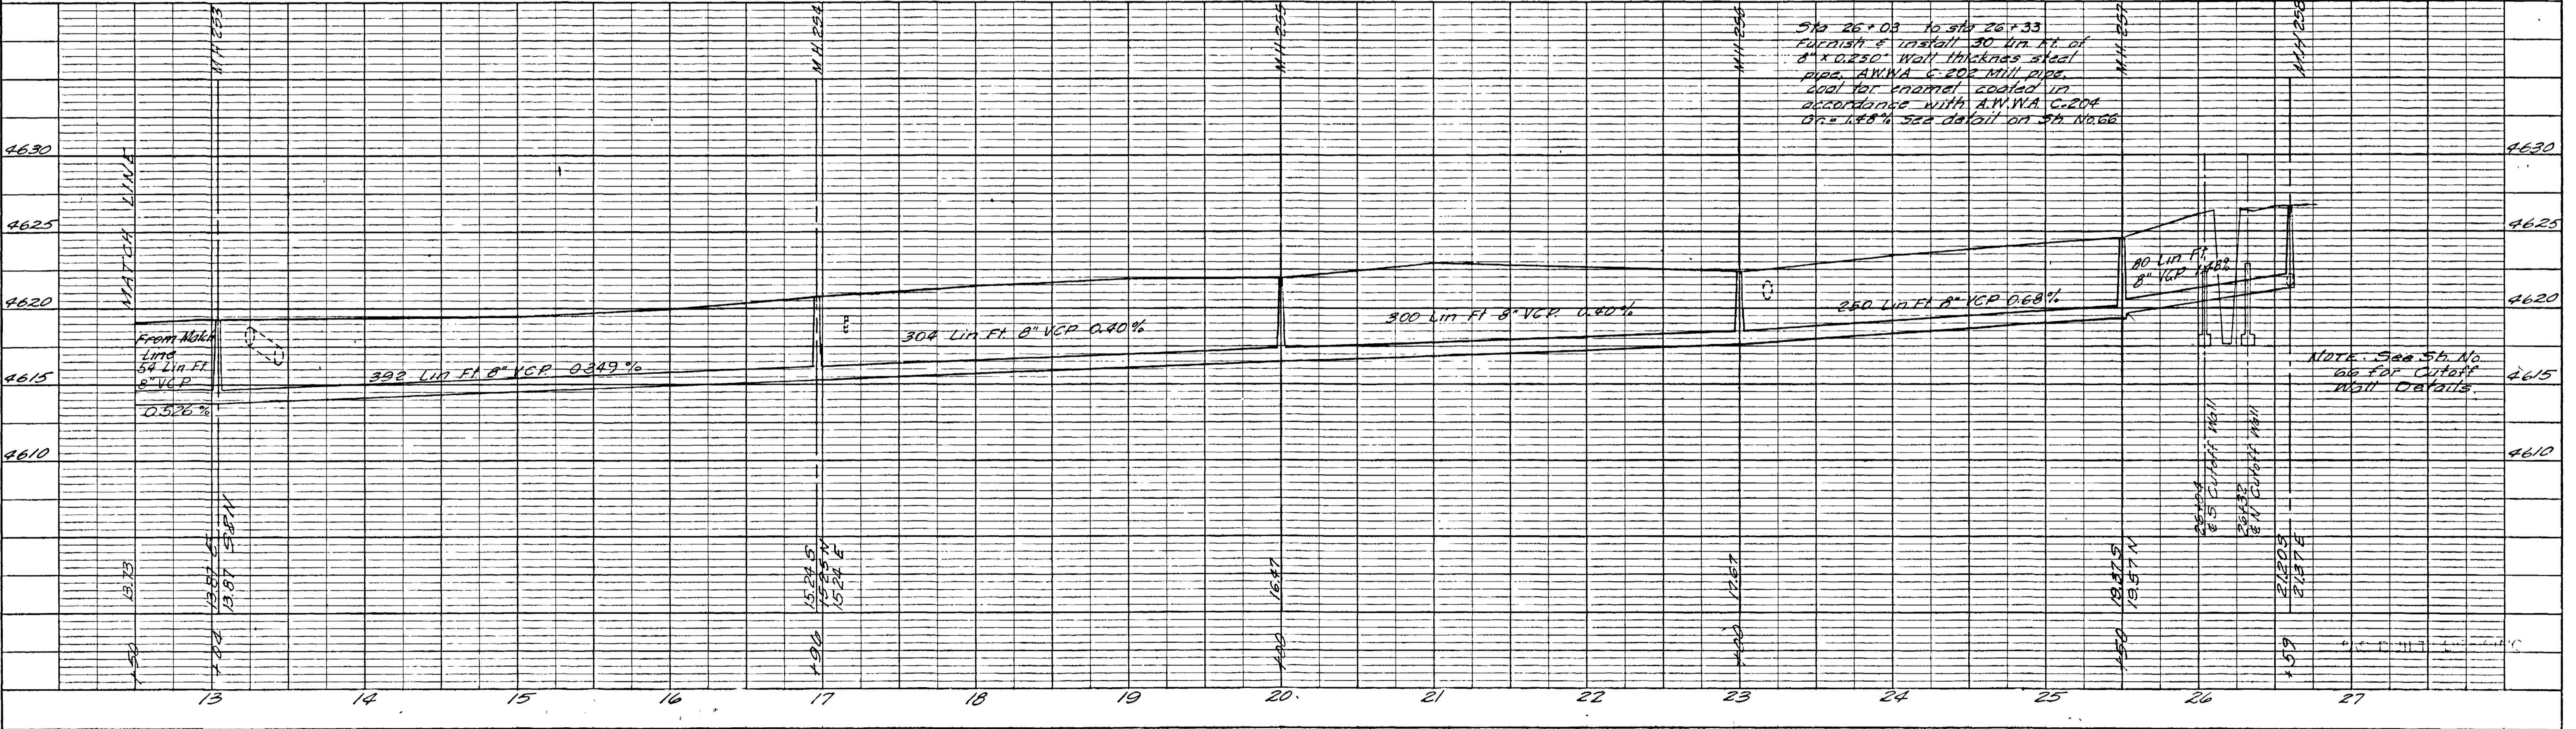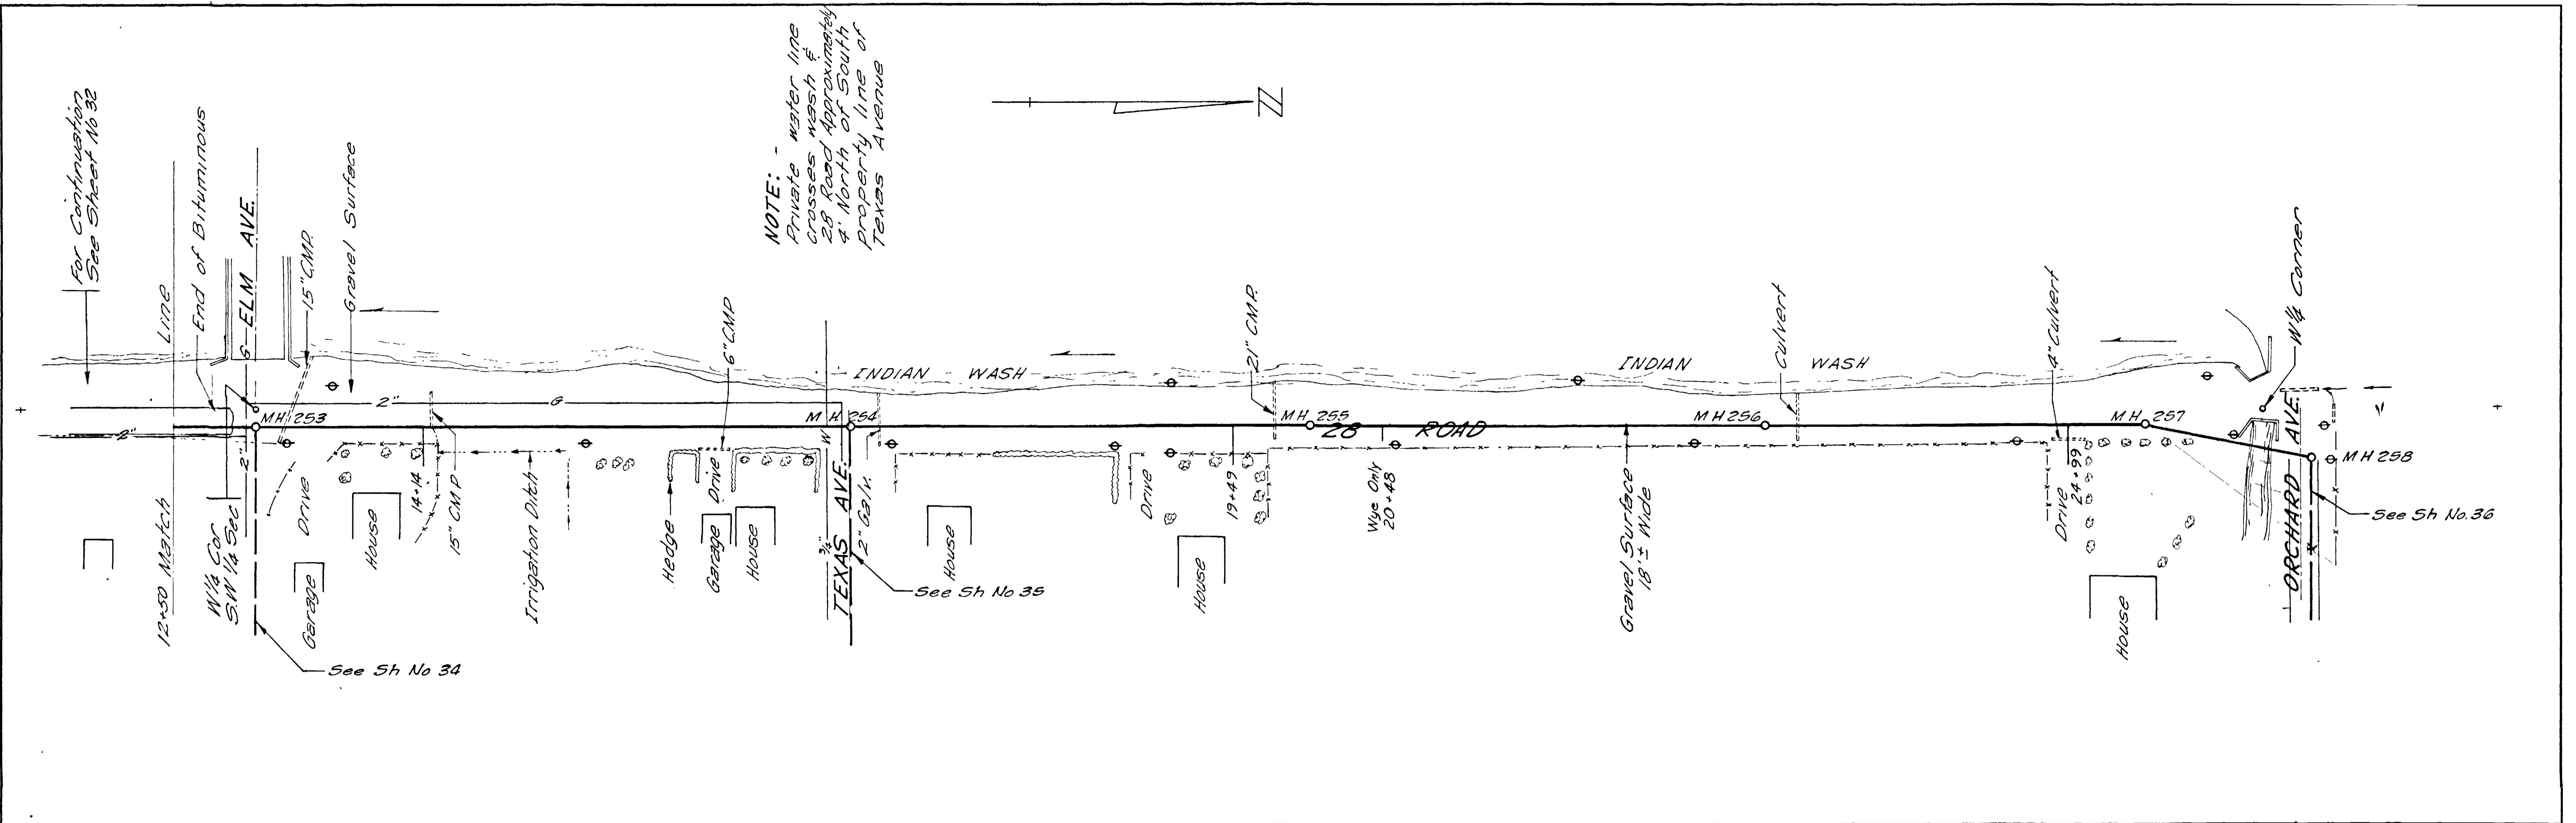

REVISIONS	DATE	DESCR	DRAWN	JOB NO
1	Feb. 1960	Grade	D.V.R.	G-205
2	October 1952		R.C.F.L.	



BY: R.C.T. DATE: Feb. 1960 DESC: Grade
 DATE: October 1952 DRAWN: D.V.R. JOB NO: G-205
 CHECKED: R.C.F.L. FILE NO:
 SCALE: 1"=50' APPROVED: [Signature] F.B. NO:

HAROLD HOSKINS & ASSOCIATES
 ENGINEERING CONSULTANTS
 GREELEY, COLORADO LINCOLN, NEBRASKA



FRUITVALE, COLORADO
 WATER & SANITATION DISTRICT

28 ROAD NORTH OF NORTH AVENUE
 STA. 12+50 TO STA. 26+60



SHEET NO. 66
 SHEETS 33

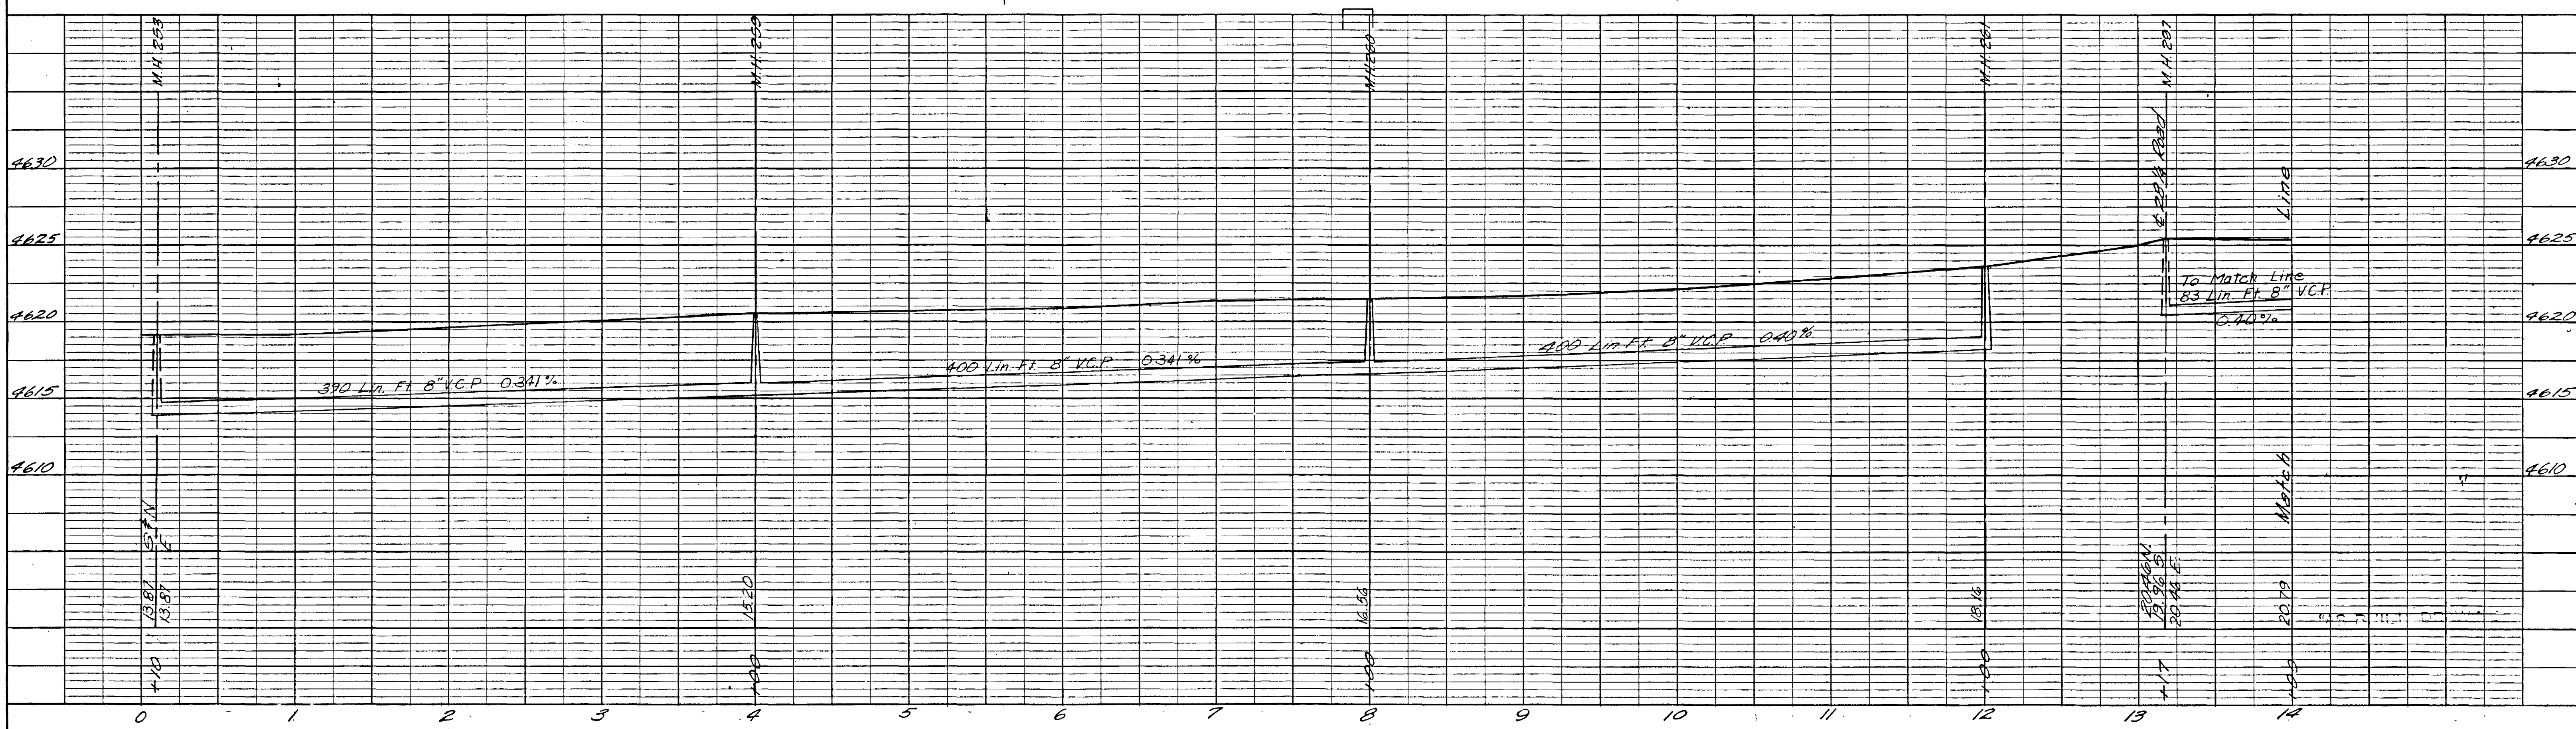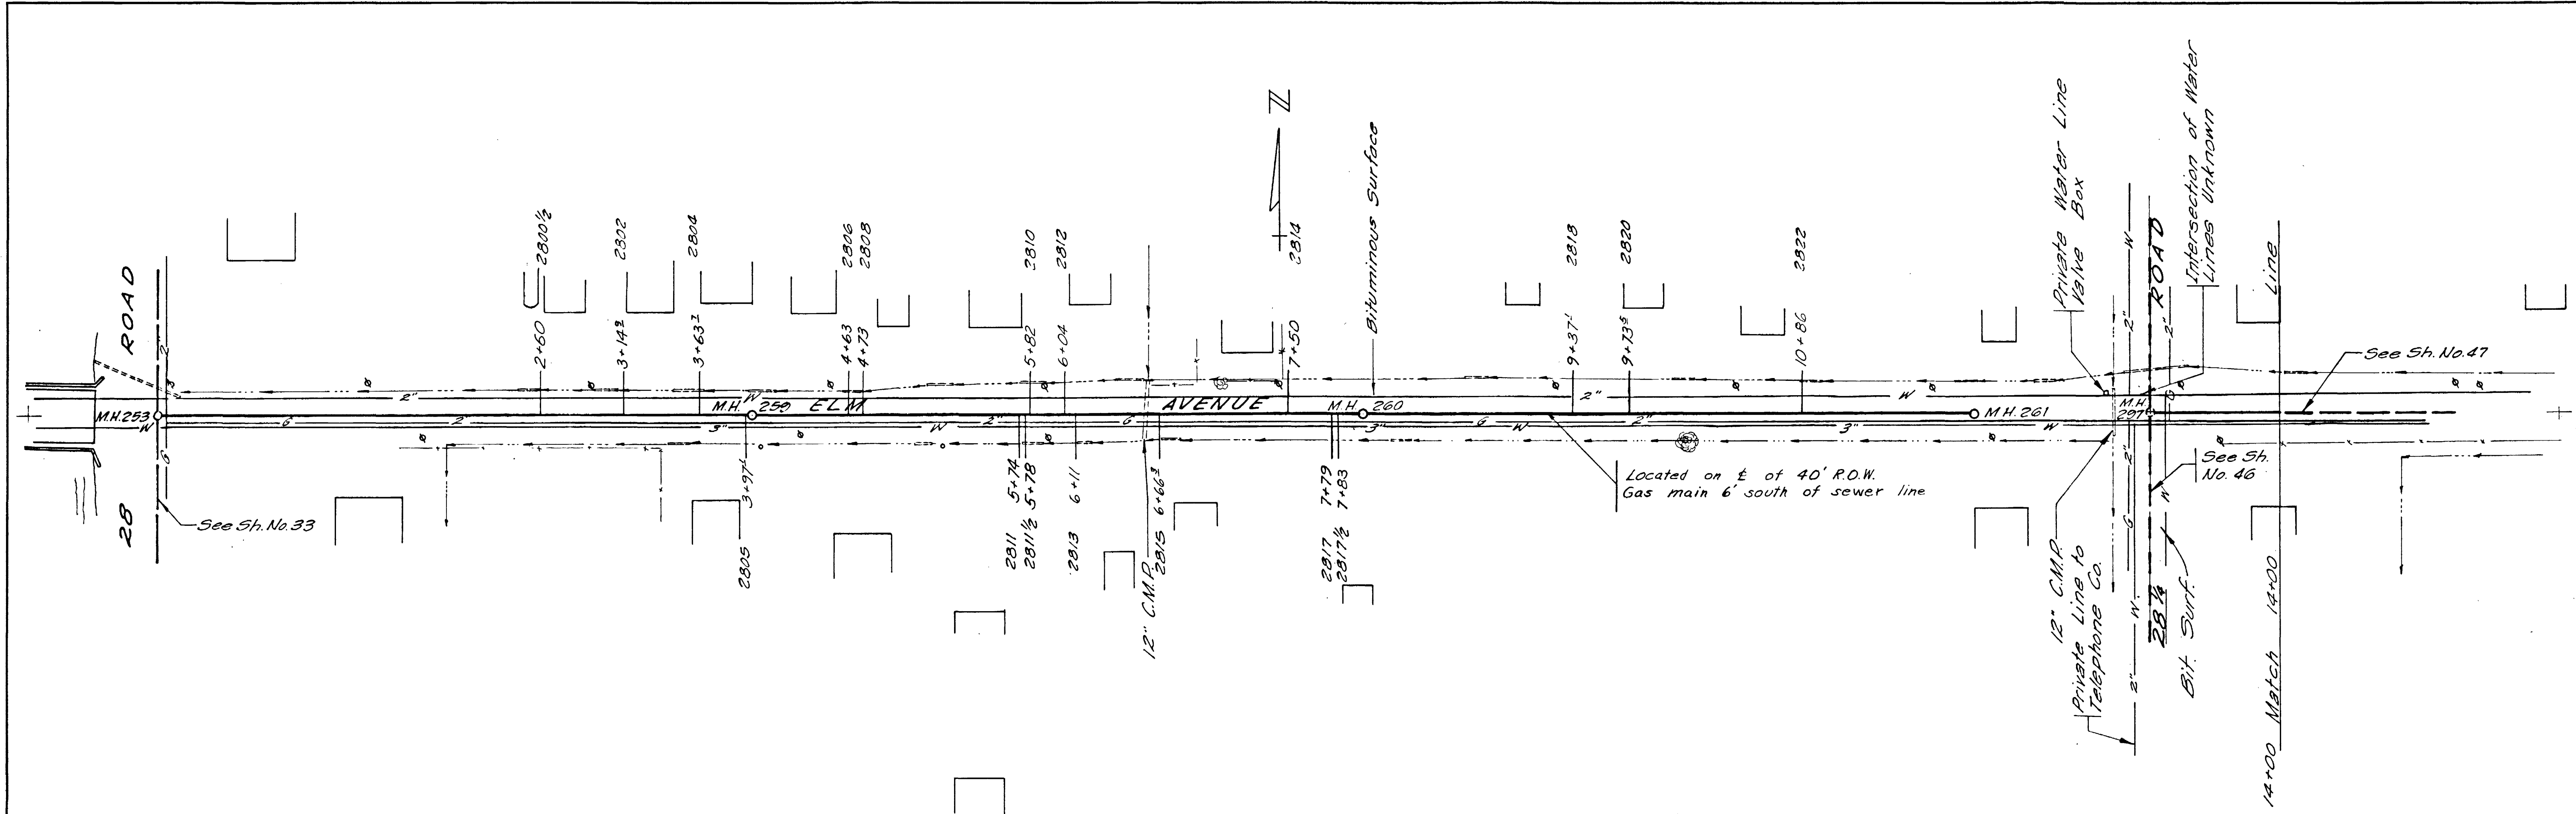

REVISIONS BY: P.C.T. DATE: Feb. 1940 DESCR: G-205 BY: DATE: DESCR:		DATE: October 1957 SCALE: 1"=50' CHECKED: R.C.P. APPROVED:	DRAWN: D.V.R. FILE NO: G-205 F. B. NO.:	HAROLD HOSKINS & ASSOCIATES ENGINEERING CONSULTANTS GREELEY, COLORADO LINCOLN, NEBRASKA	FRUITVALE, COLORADO WATER & SANITATION DISTRICT	ELM AVENUE STA. 0+10 TO STA. 14+00	66 SHEETS 34 SHEET NO.
--------------------------------------------------------------------------	--	---------------------------------------------------------------------	-----------------------------------------------	-----------------------------------------------------------------------------------------------	----------------------------------------------------	---------------------------------------	---------------------------

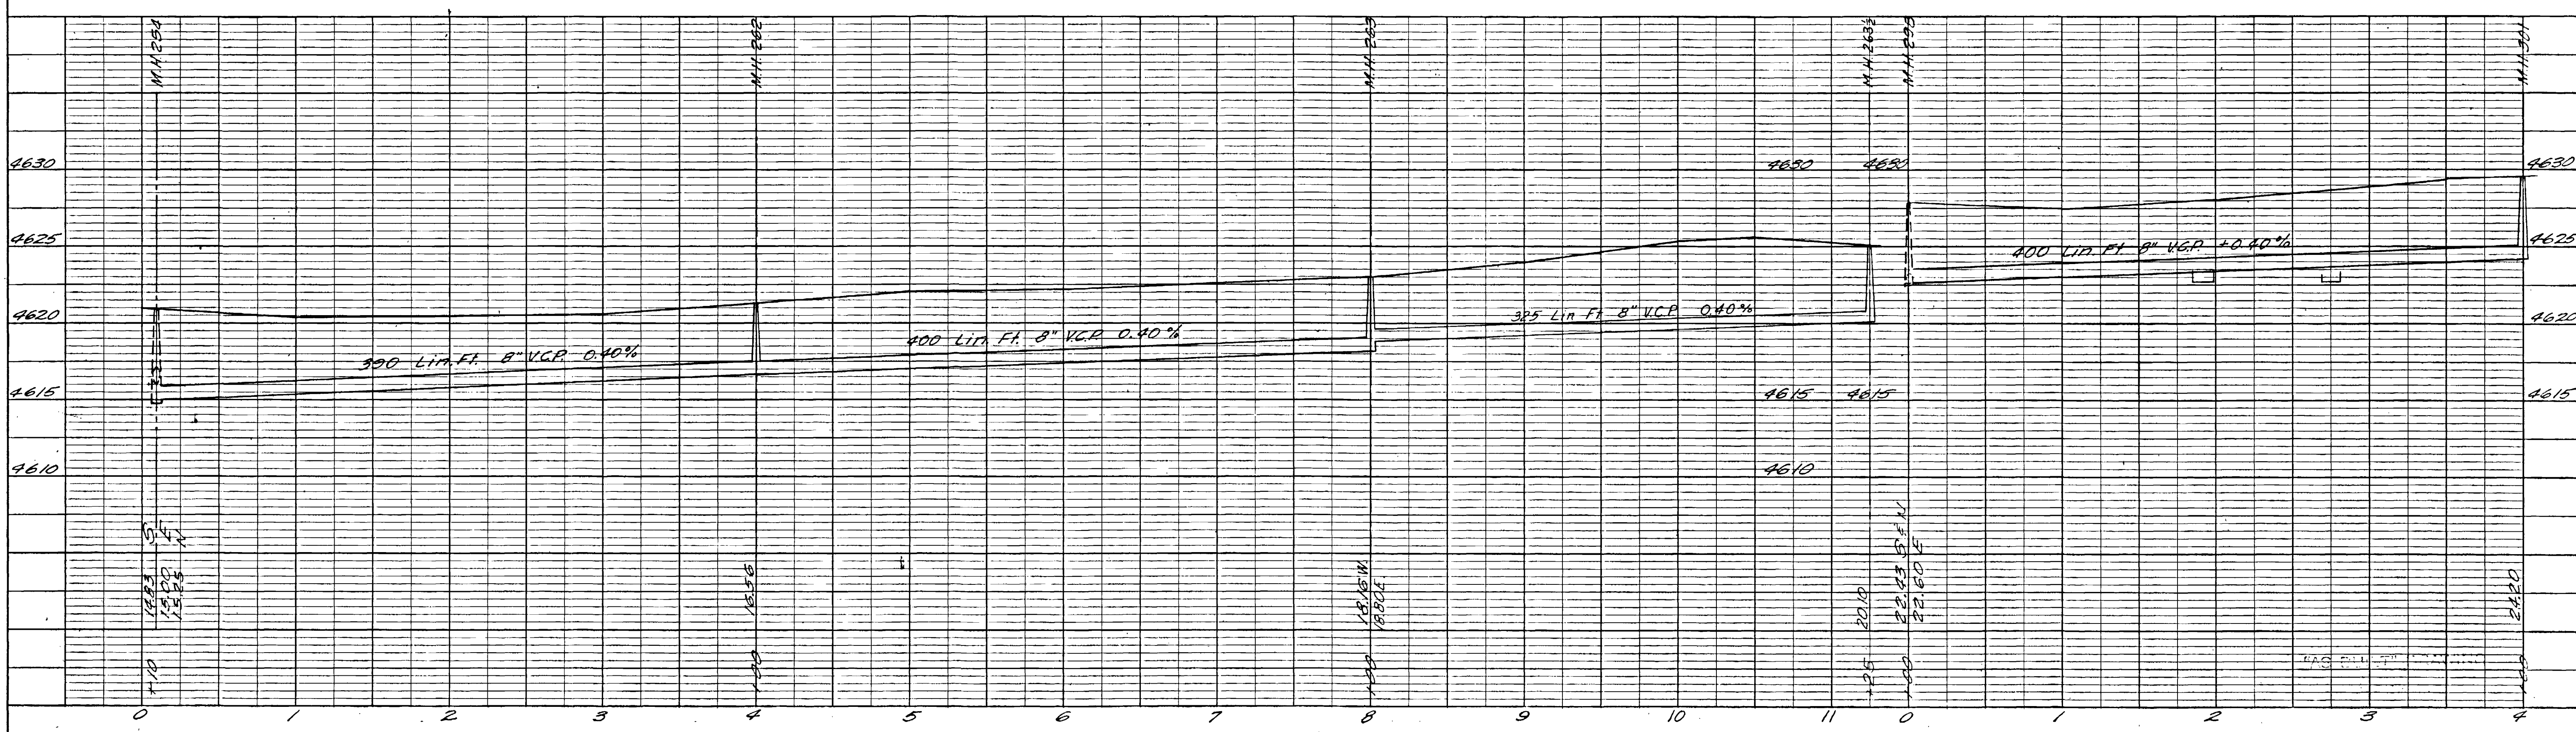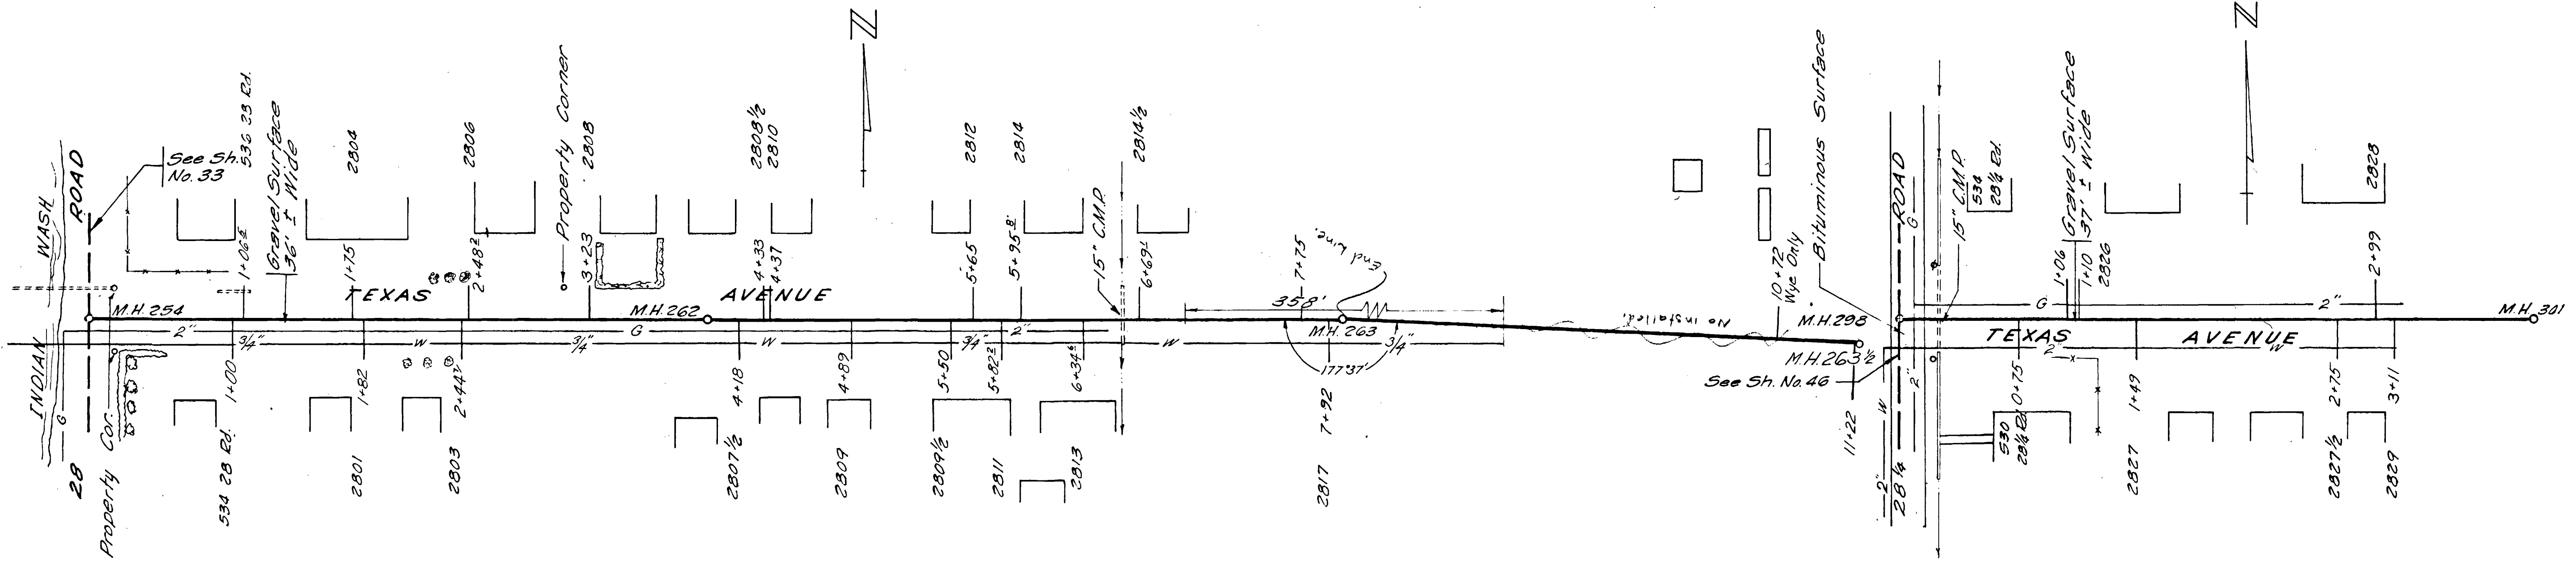

REVISIONS BY: R.C.T. DATE: Feb. 1980 DESCR: 202062 DATE: _____ DESCR: _____ DATE: _____ DESCR: _____		DATE: October 1957 DRAWN: D.V.R. JOB NO: G-205 CHECKED: R.C.T. FILE NO: _____ APPROVED: _____ F.B. NO: _____		HAROLD HOSKINS & ASSOCIATES ENGINEERING CONSULTANTS GREELEY, COLORADO LINCOLN, NEBRASKA		FRUITVALE, COLORADO WATER & SANITATION DISTRICT		TEXAS AVENUE EAST OF 28 ROAD TEXAS AVENUE EAST OF 28 1/4 ROAD		66 <small>11-75</small>	SHEET NO 35
---------------------------------------------------------------------------------------------------------------	--	--------------------------------------------------------------------------------------------------------------------	--	----------------------------------------------------------------------------------------------------------	--	----------------------------------------------------------------------	--	--------------------------------------------------------------------------------	--	----------------------------	-----------------------

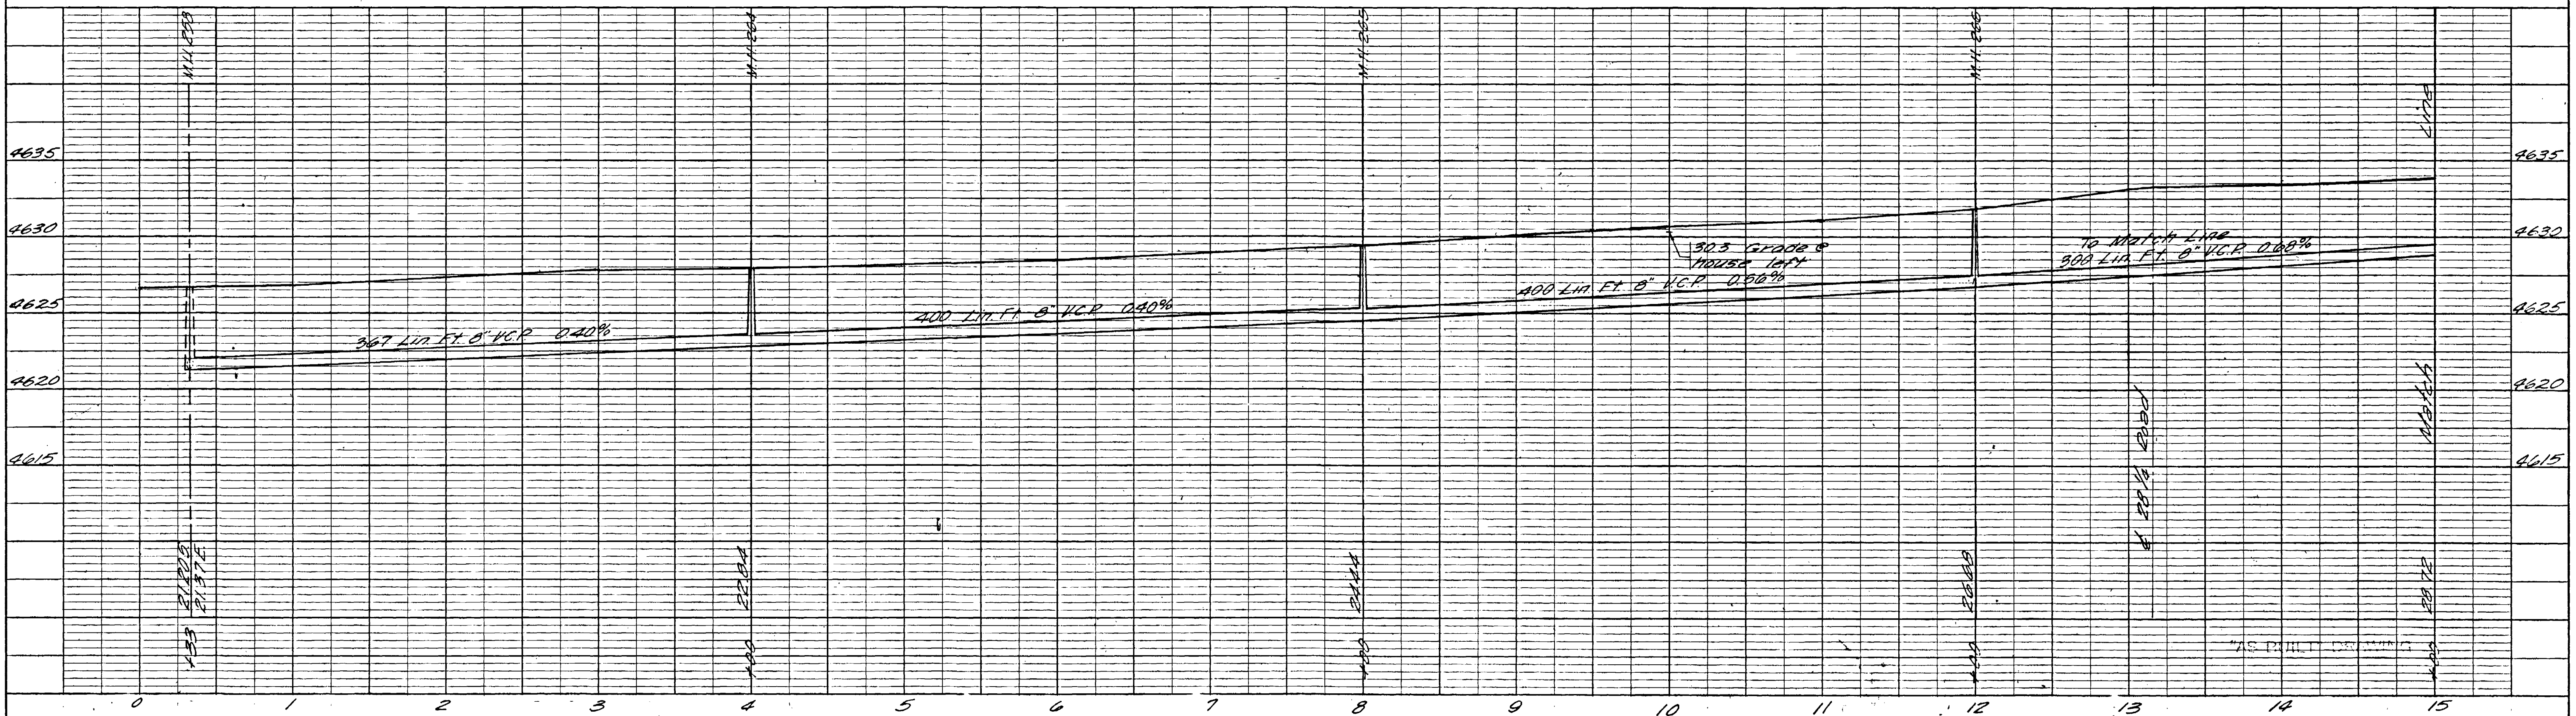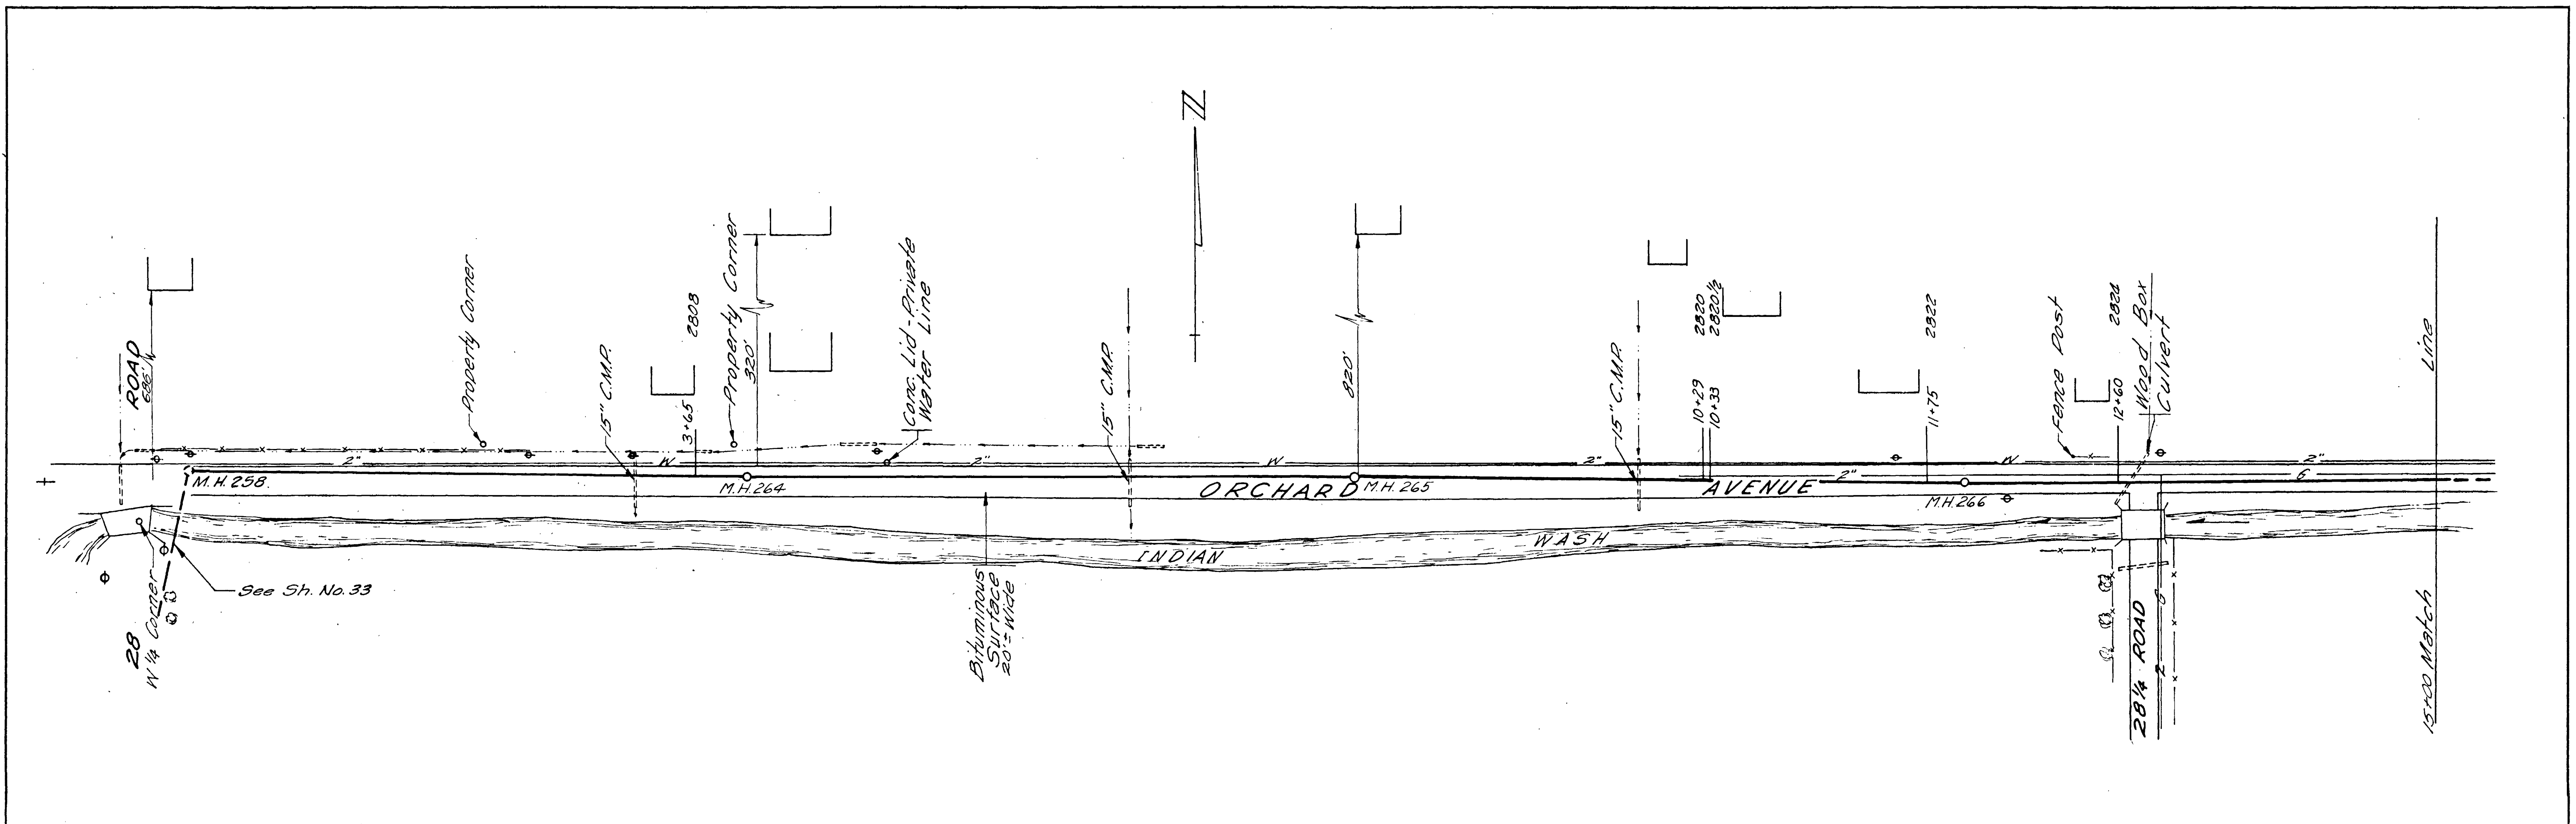



REVISIONS		DATE	DESCR.	DATE	DESCR.	DRAWN	CHECKED	APPROVED	JOB NO.	FILE NO.	F. B. NO.
BY	DATE	DESCR.									

HAROLD HOSKINS & ASSOCIATES
ENGINEERING CONSULTANTS
GREELEY, COLORADO LINCOLN, NEBRASKA

FRUITVALE, COLORADO
WATER & SANITATION DISTRICT



ORCHARD AVENUE
STA. 0+33 TO STA. 15+00

66 SHEET NO.
SHEETS 36

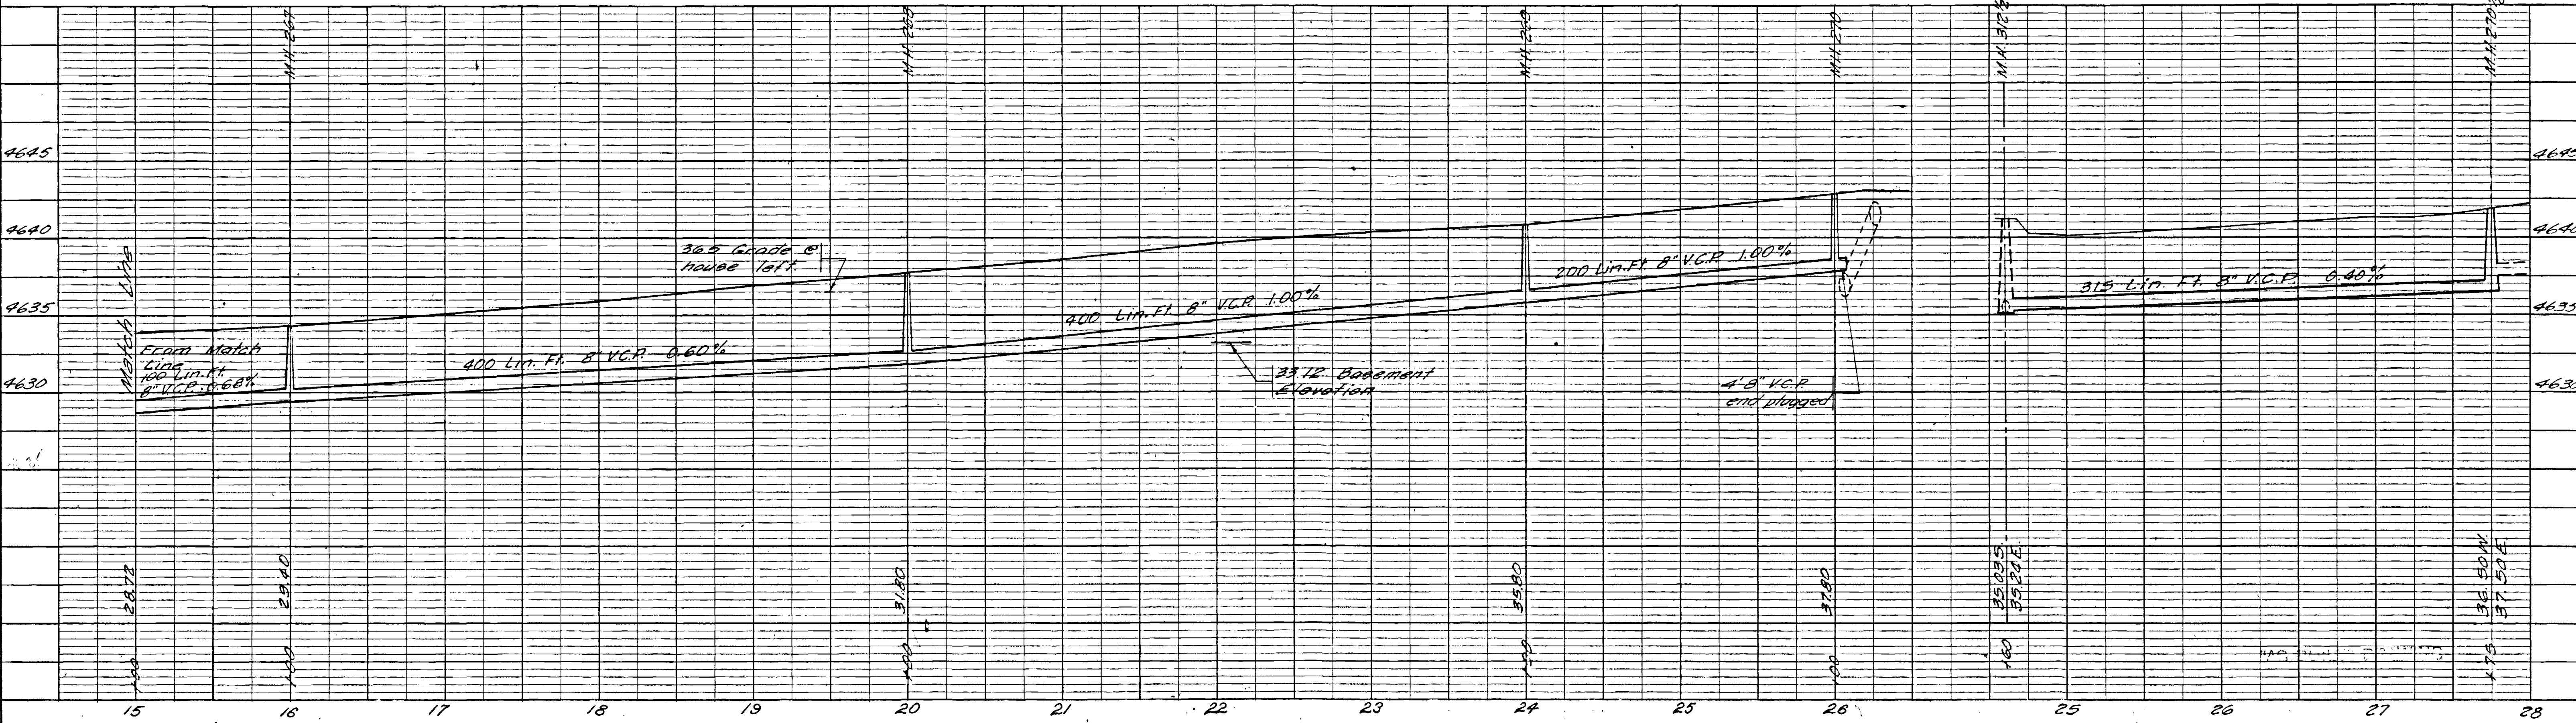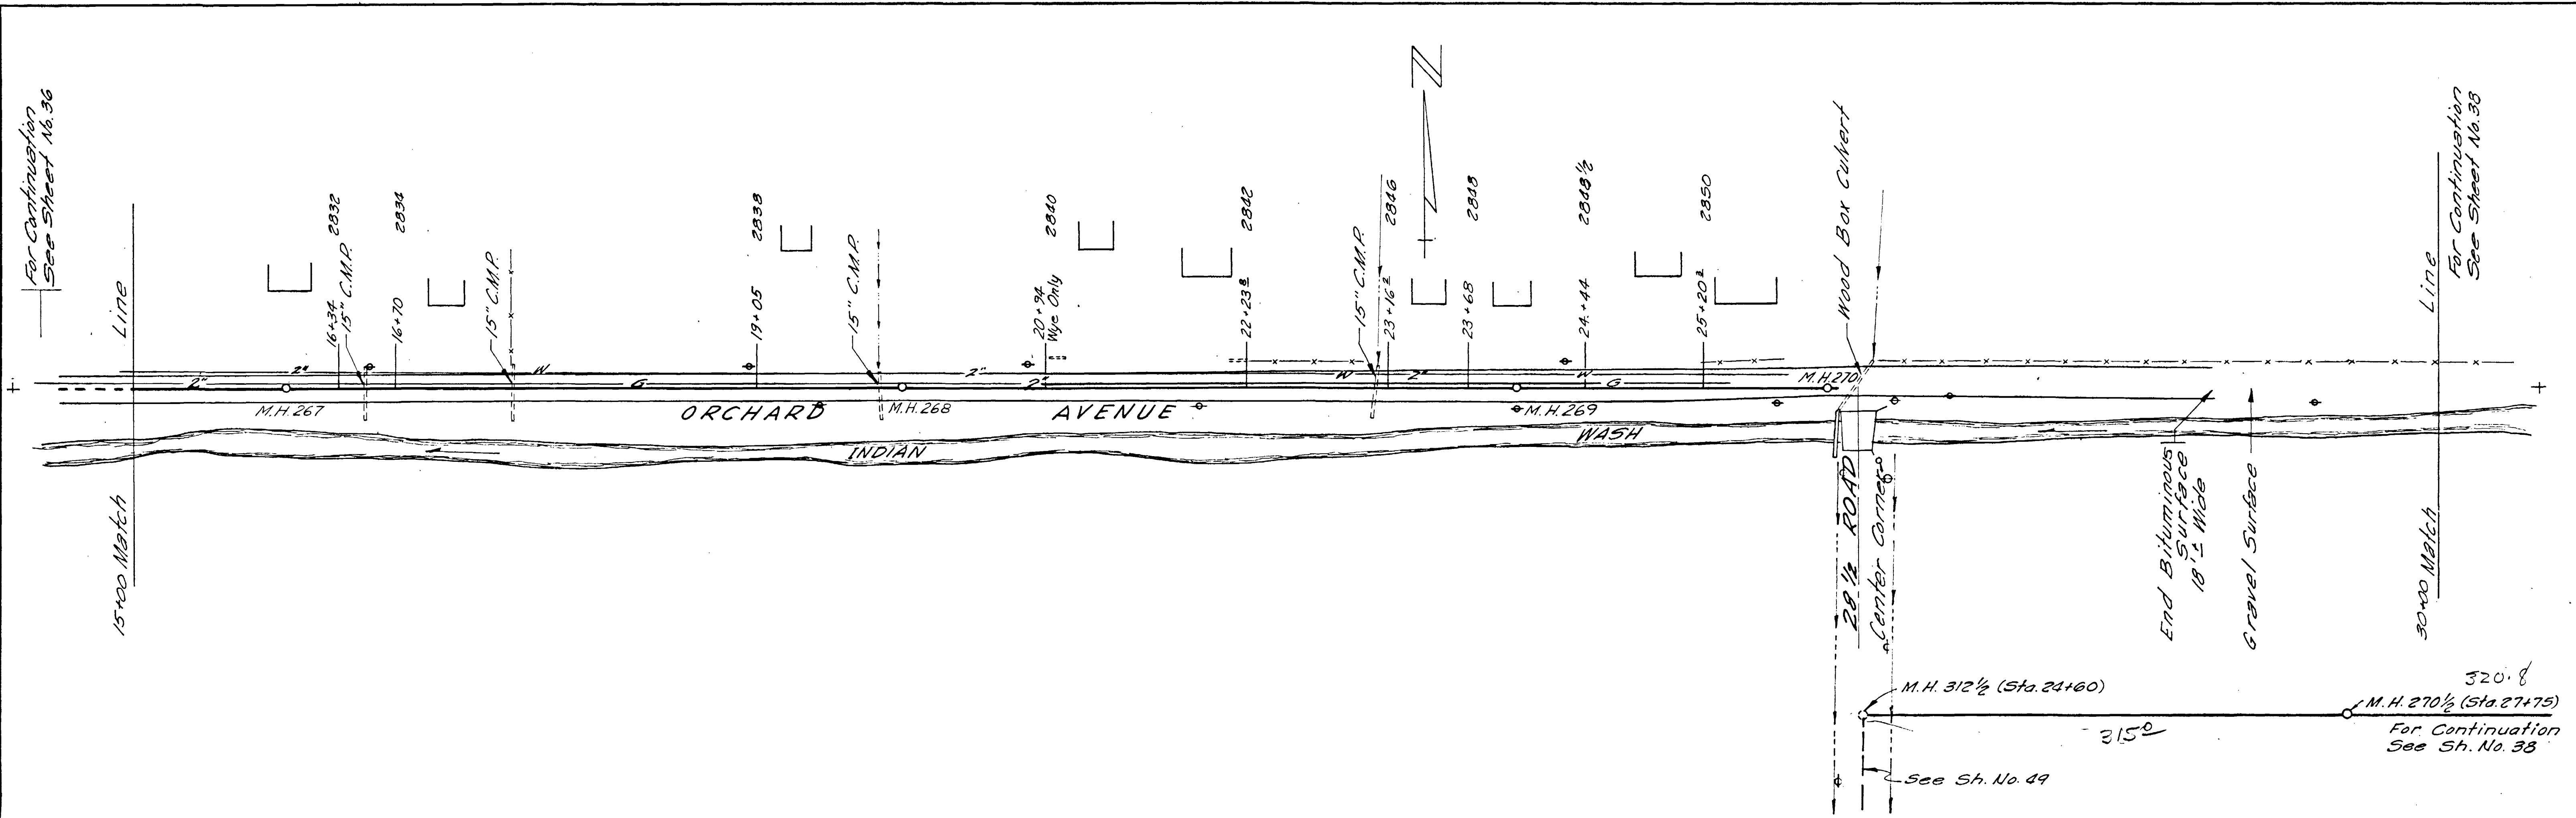

REVISIONS BY: R.H.I. DATE: Feb. 1960 DESC: Grades DATE: _____ DESC: _____ DATE: _____ DESC: _____	DATE: October 1957 DRAWN: D.V.R. JOB NO: G-205 CHECKED: R.G.T. FILE NO: _____ SCALE: 1"=50' APPROVED: [Signature] F.R. NO: _____	HAROLD HOSKINS & ASSOCIATES ENGINEERING CONSULTANTS GREELEY, COLORADO LINCOLN, NEBRASKA	FRUITVALE, COLORADO WATER & SANITATION DISTRICT	ORCHARD AVENUE STA. 15+00 TO STA. 26+00	66 SHEET NO. SHEETS 37
------------------------------------------------------------------------------------------------------------	----------------------------------------------------------------------------------------------------------------------------------------	-----------------------------------------------------------------------------------------------	----------------------------------------------------	--------------------------------------------	---------------------------

02081737.tif

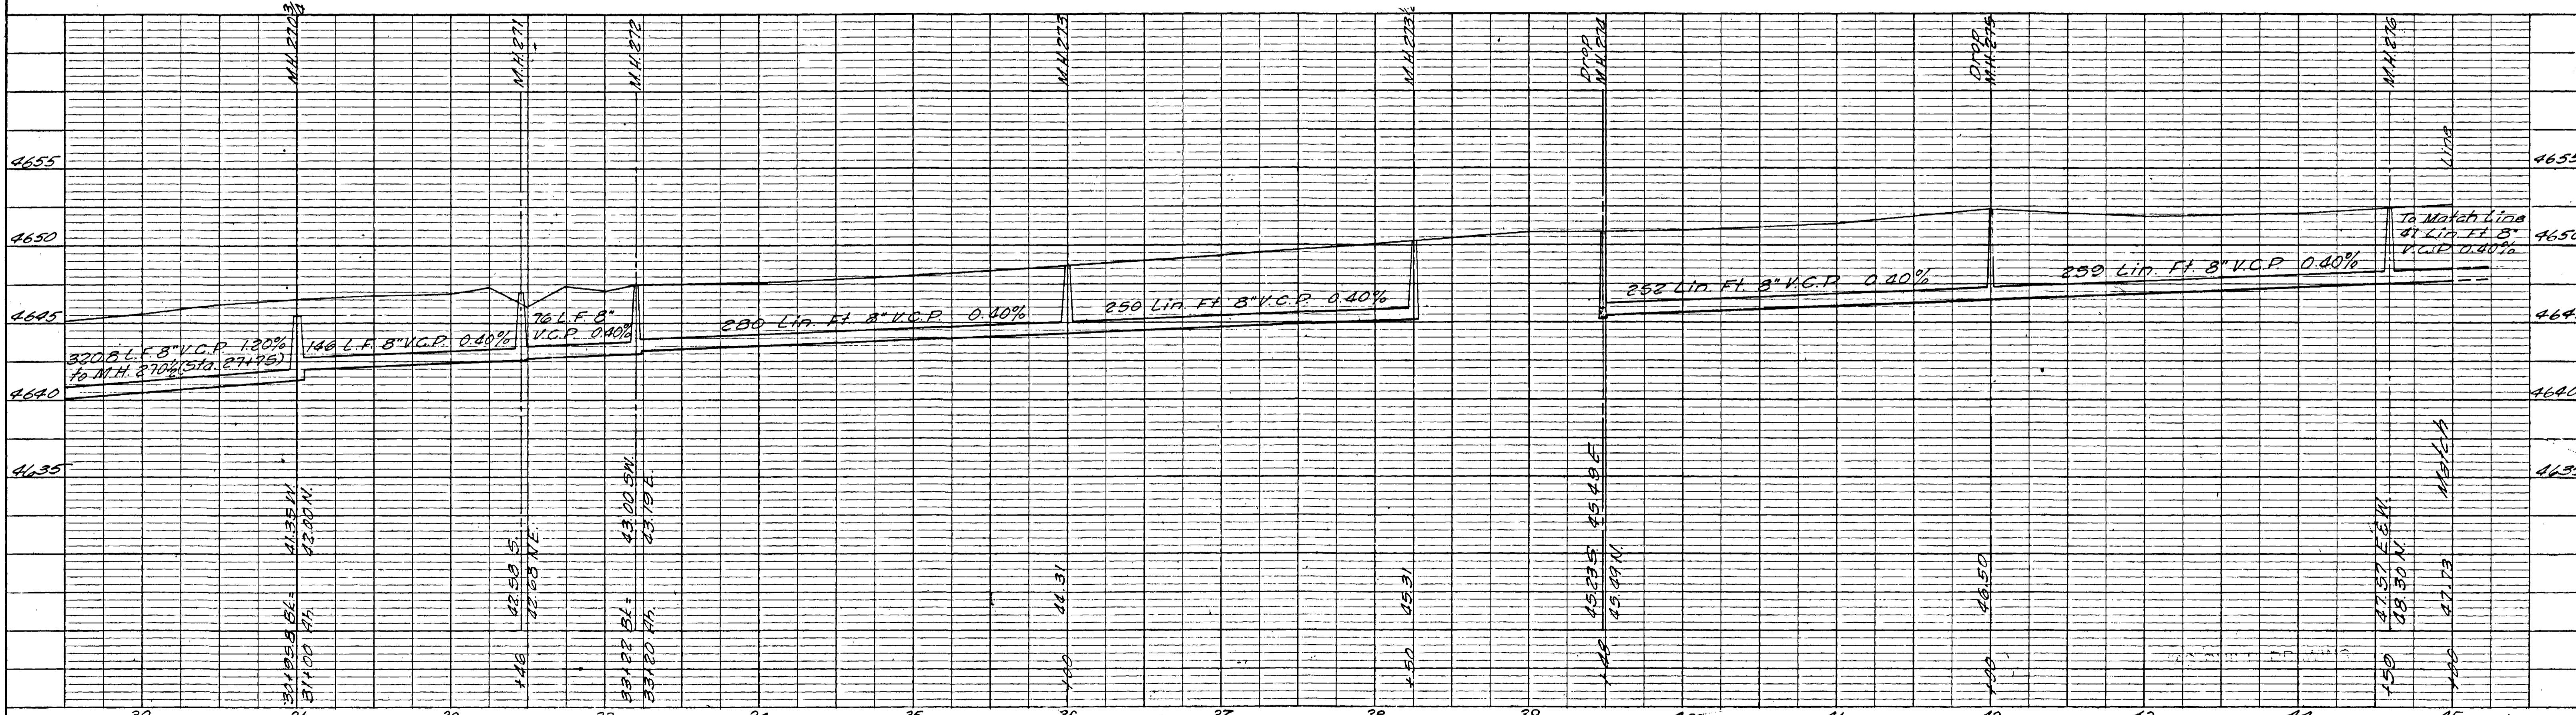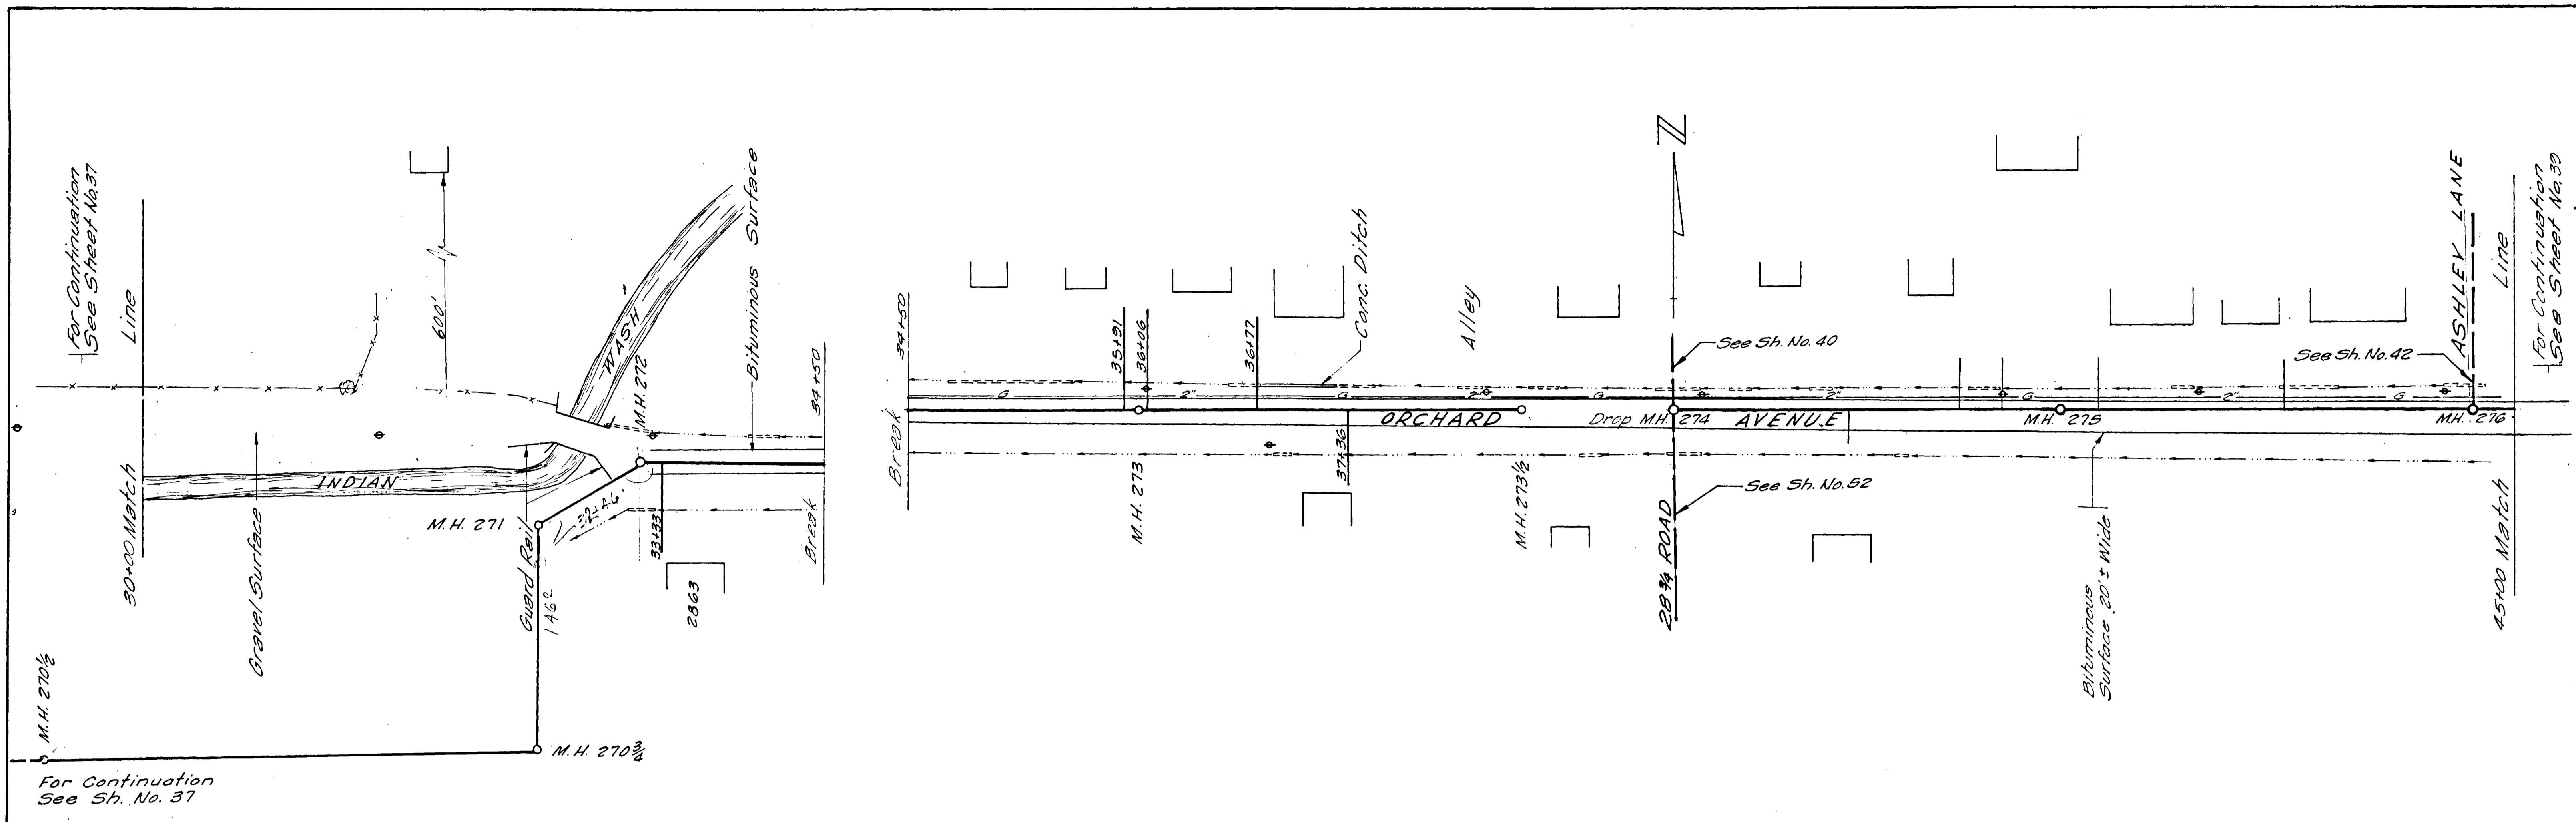



REVISIONS	DATE	DESCR.	DATE	DESCR.	DATE	DESCR.
BY: R.C.T.	DATE: Feb 1960	DESCR: Grades	DATE: October 1957	DESCR: DRAWN: D.V.R.	DATE:	DESCR:
BY:	DATE:	DESCR:	DATE:	DESCR:	DATE:	DESCR:

HAROLD HOSKINS & ASSOCIATES
 ENGINEERING CONSULTANTS
 LINCOLN, NEBRASKA



FRUITVALE, COLORADO
 WATER & SANITATION DISTRICT

ORCHARD AVENUE
 STA. 33+90 TO STA. 45+00



66 SHEET NO.
 38

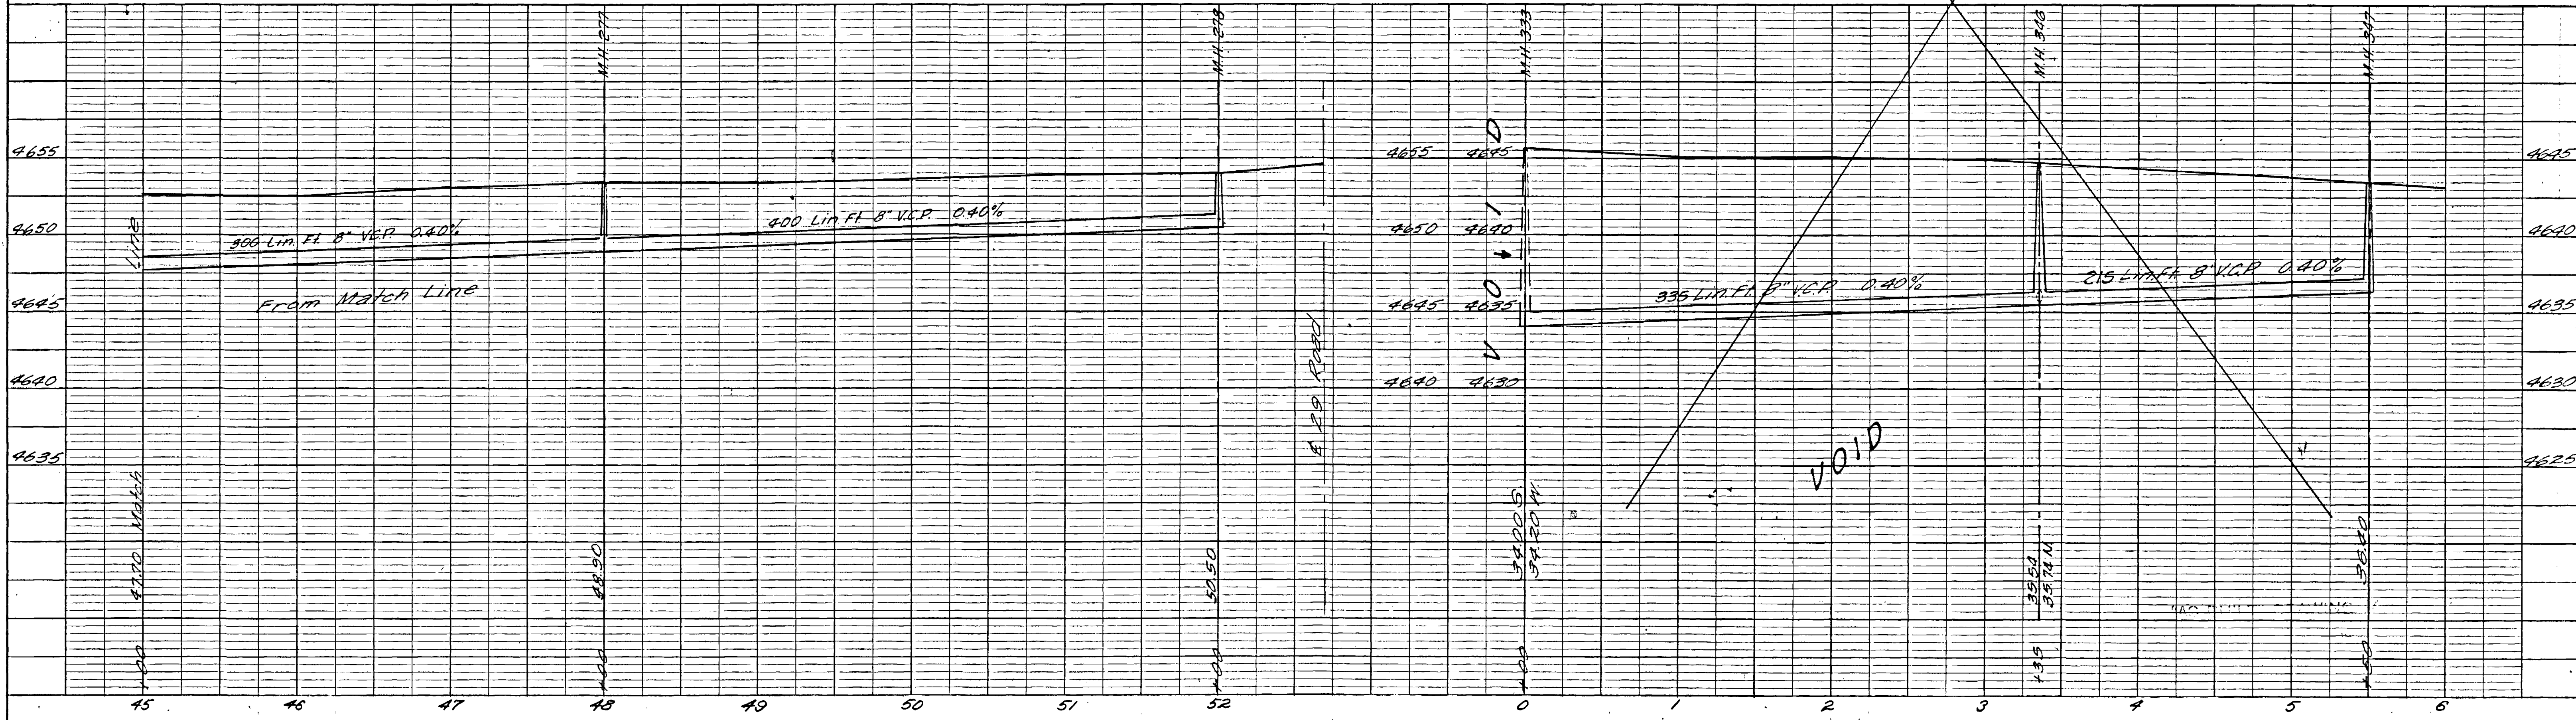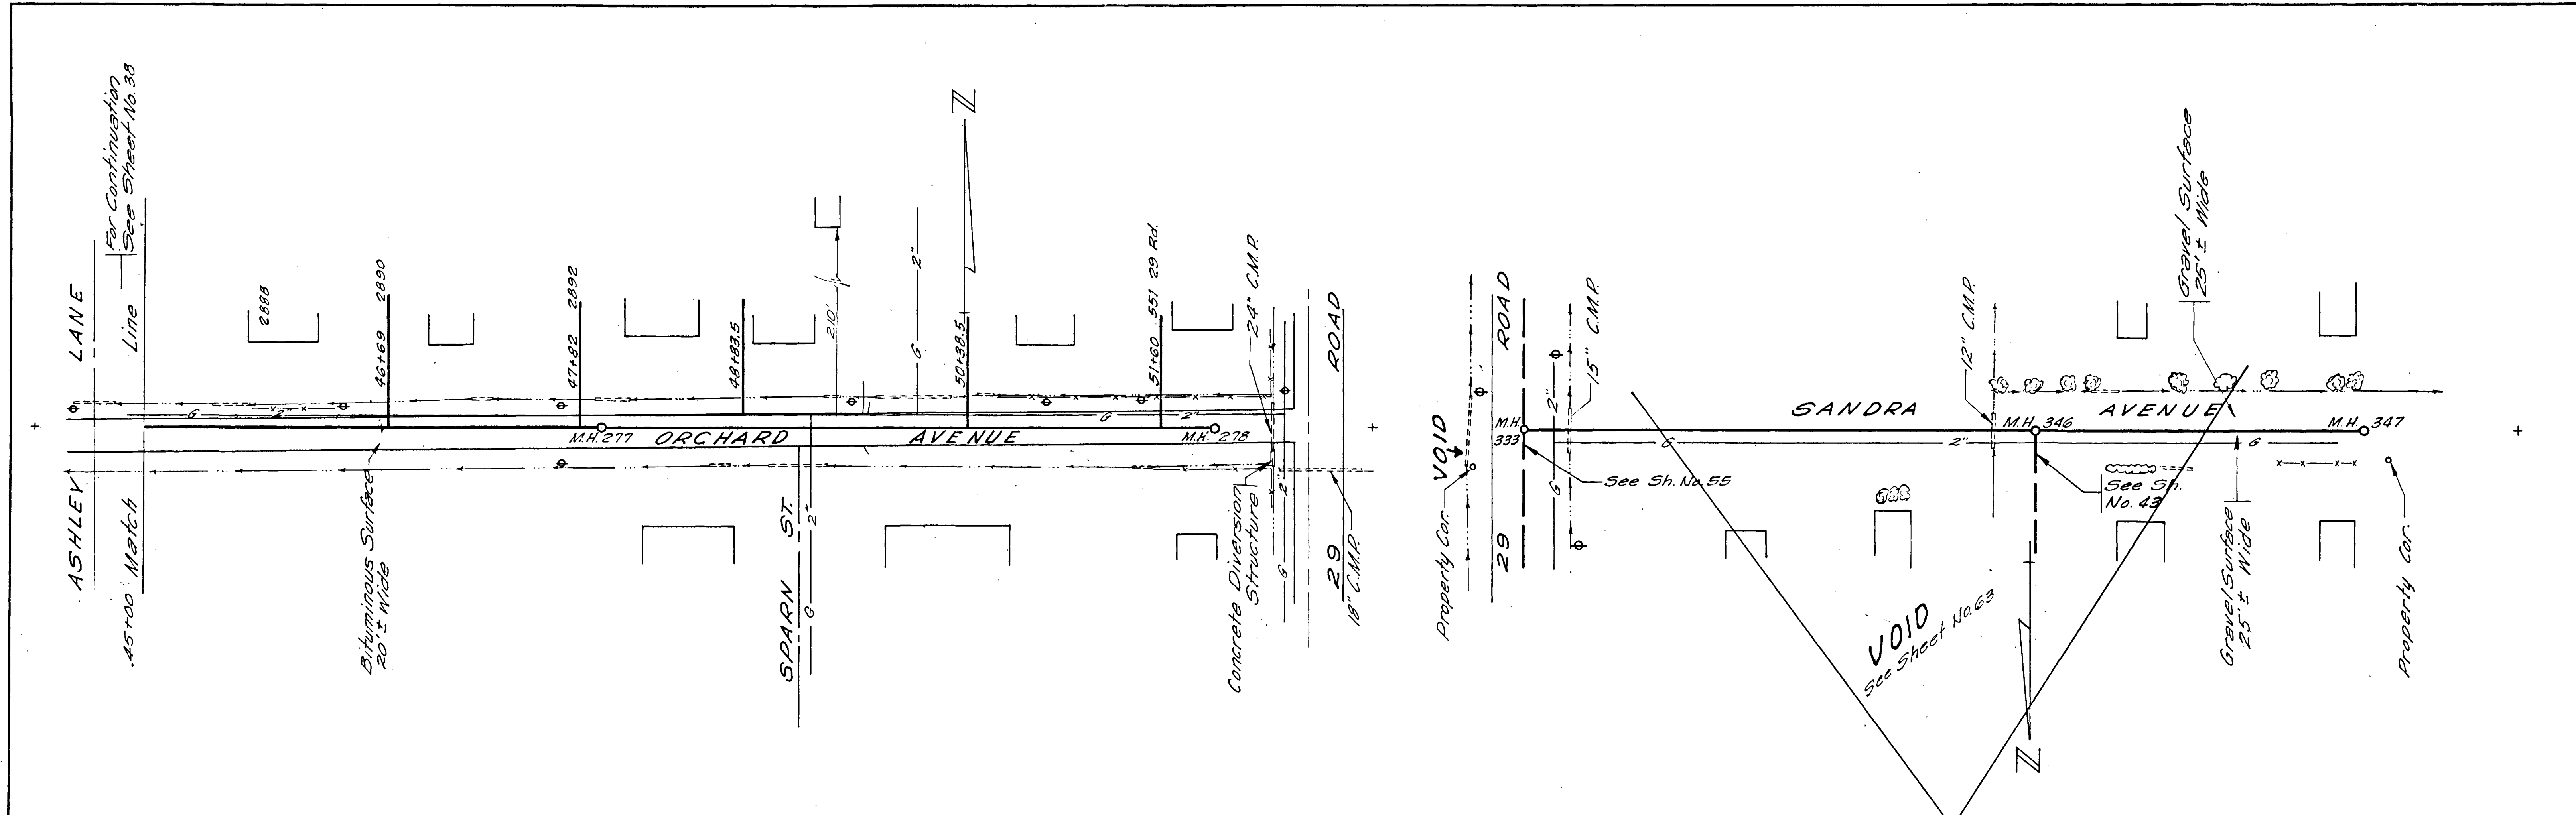

REVISIONS BY: R.G.T. DATE: Feb 1960 DESCR: Graders DATE: _____ DESCR: _____ DATE: _____ DESCR: _____		DATE: October 1957 DRAWN: D.V.R. JOB NO: G-205 CHECKED: J.C.T. FILE NO: _____ SCALE: 1"=50' APPROVED: [Signature] F.B. NO: _____		HAROLD HOSKINS & ASSOCIATES ENGINEERING CONSULTANTS GREELEY, COLORADO LINCOLN, NEBRASKA		FRUITVALE, COLORADO WATER & SANITATION DISTRICT		ORCHARD AVENUE STA. 45+00 TO STA. 52+00 SHEET NO. 39 SHEETS 66	
---------------------------------------------------------------------------------------------------------------	--	----------------------------------------------------------------------------------------------------------------------------------------	--	-----------------------------------------------------------------------------------------------	--	----------------------------------------------------	--	----------------------------------------------------------------------	--


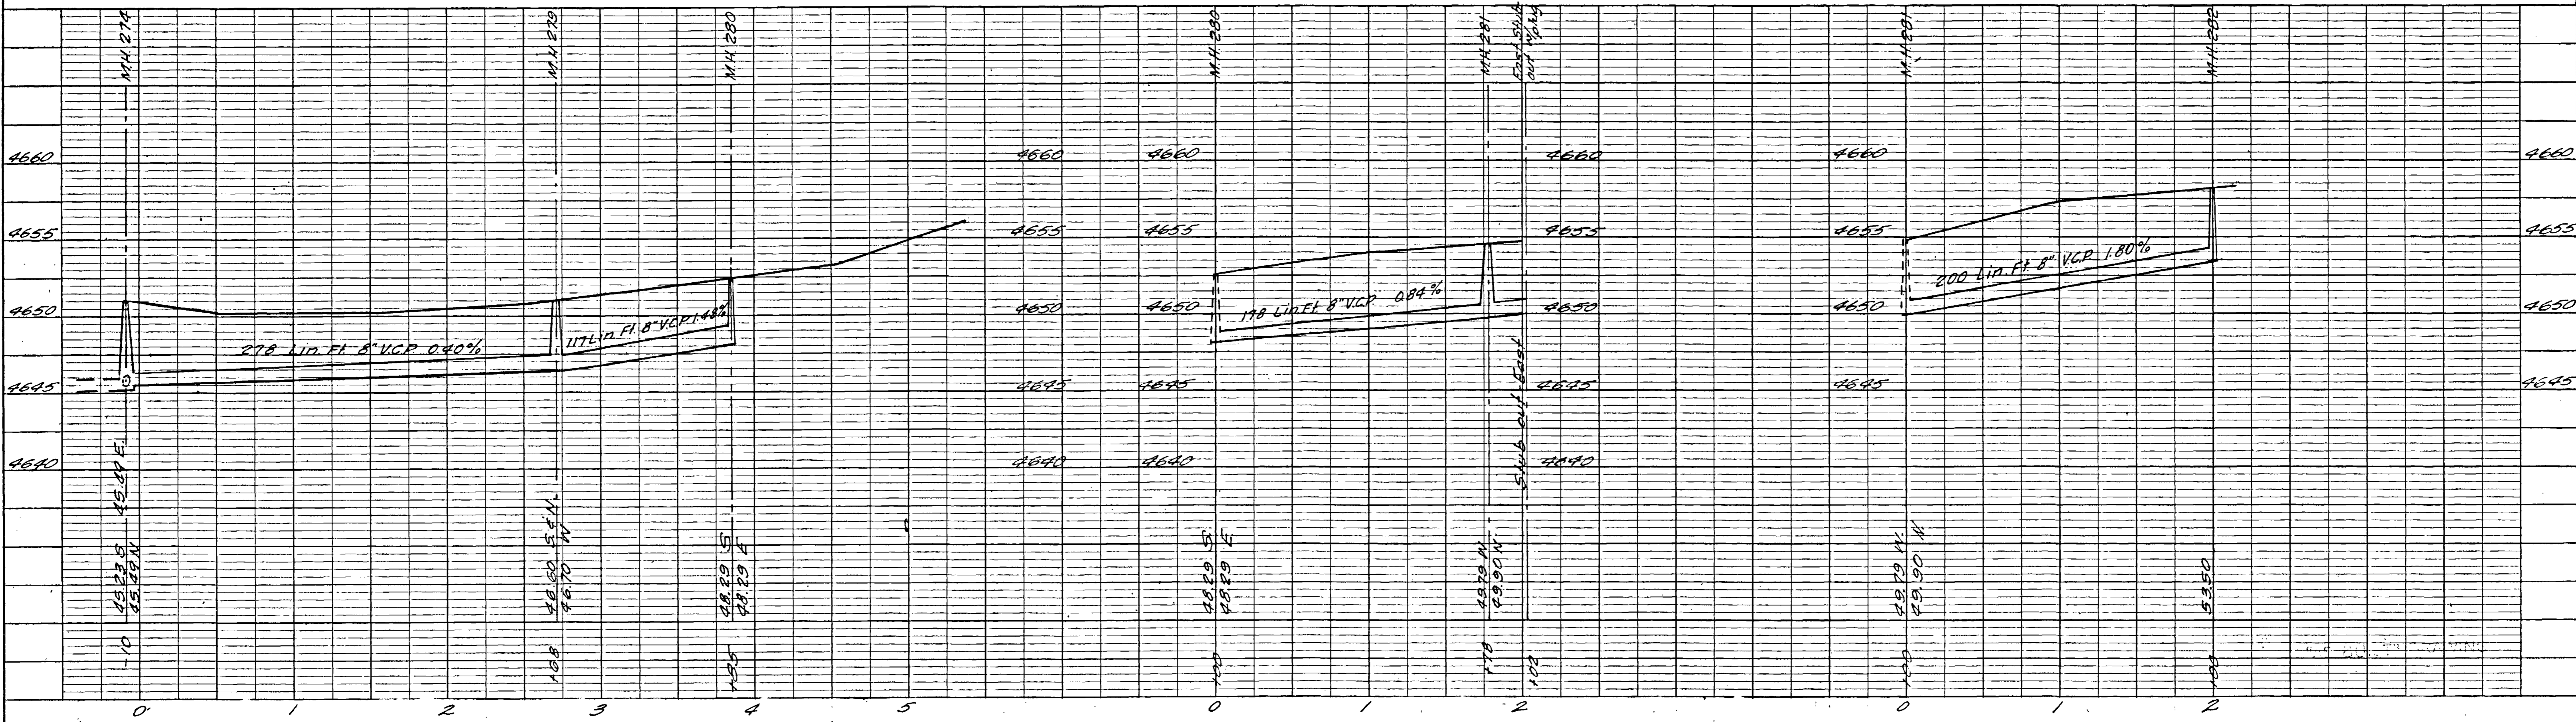
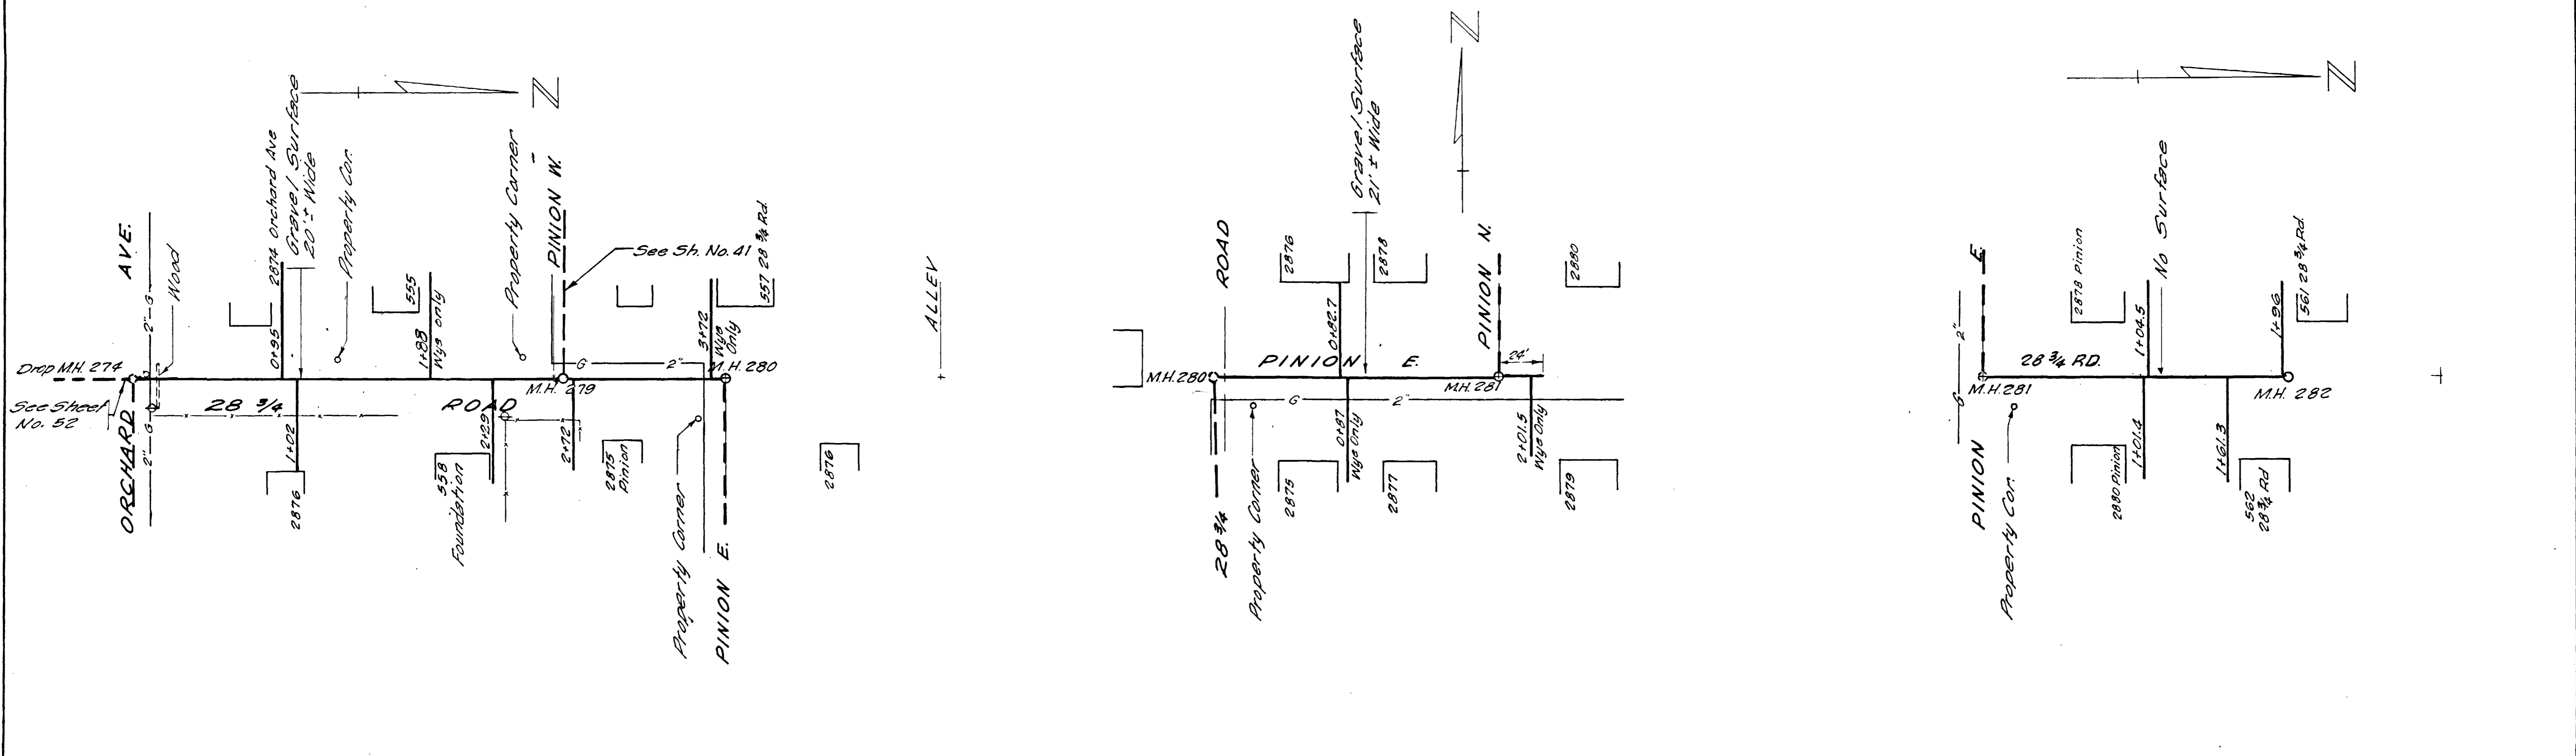


REVISIONS BY: RCT DATE: Feb 1960 DESCR: Grades BY: DATE: DESCR: BY: DATE: DESCR:	DATE: October 1957 SCALE: 1" = 50' DRAWN: D.V.A. CHECKED: [Signature] APPROVED: [Signature]	HAROLD HOSKINS & ASSOCIATES ENGINEERING CONSULTANTS GREELEY, COLORADO	FRUITVALE, COLORADO WATER & SANITATION DISTRICT	28 3/4 ROAD NORTH OF ORCHARD AVENUE PINION AVENUE	66 SHEET NO. SHEETS 40
-------------------------------------------------------------------------------------------	---------------------------------------------------------------------------------------------------------	-----------------------------------------------------------------------------	----------------------------------------------------	------------------------------------------------------	---------------------------

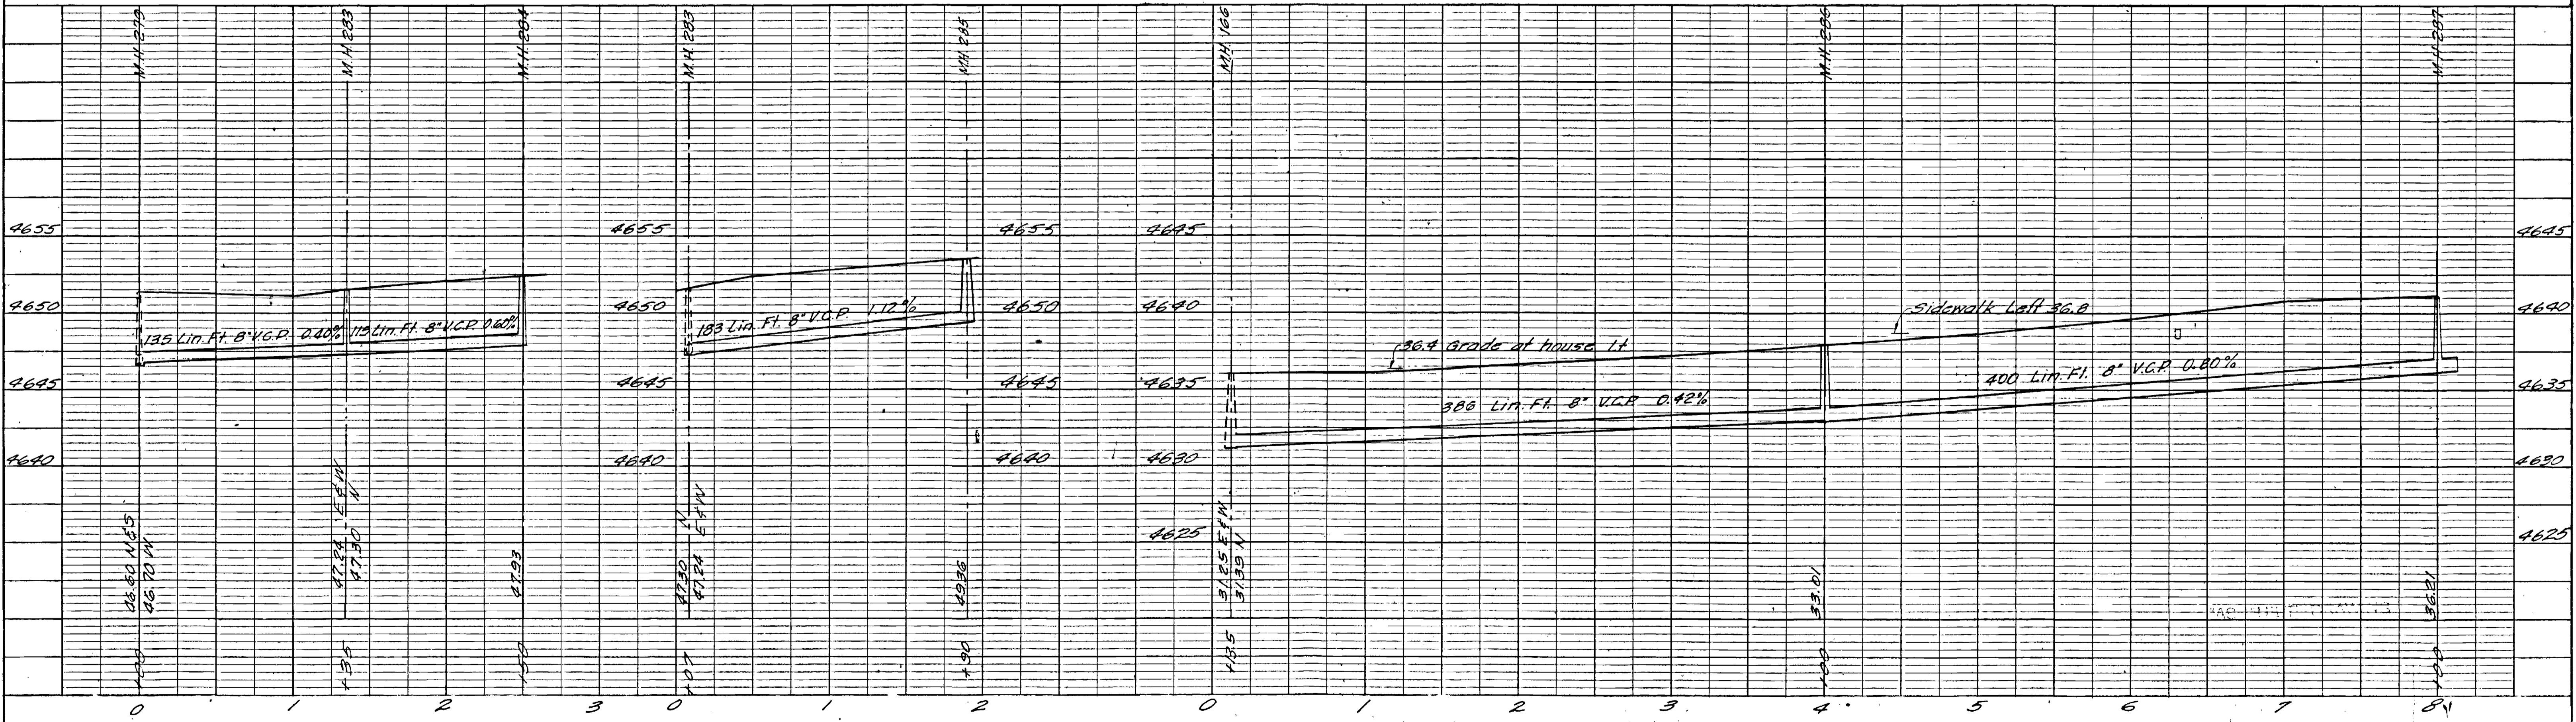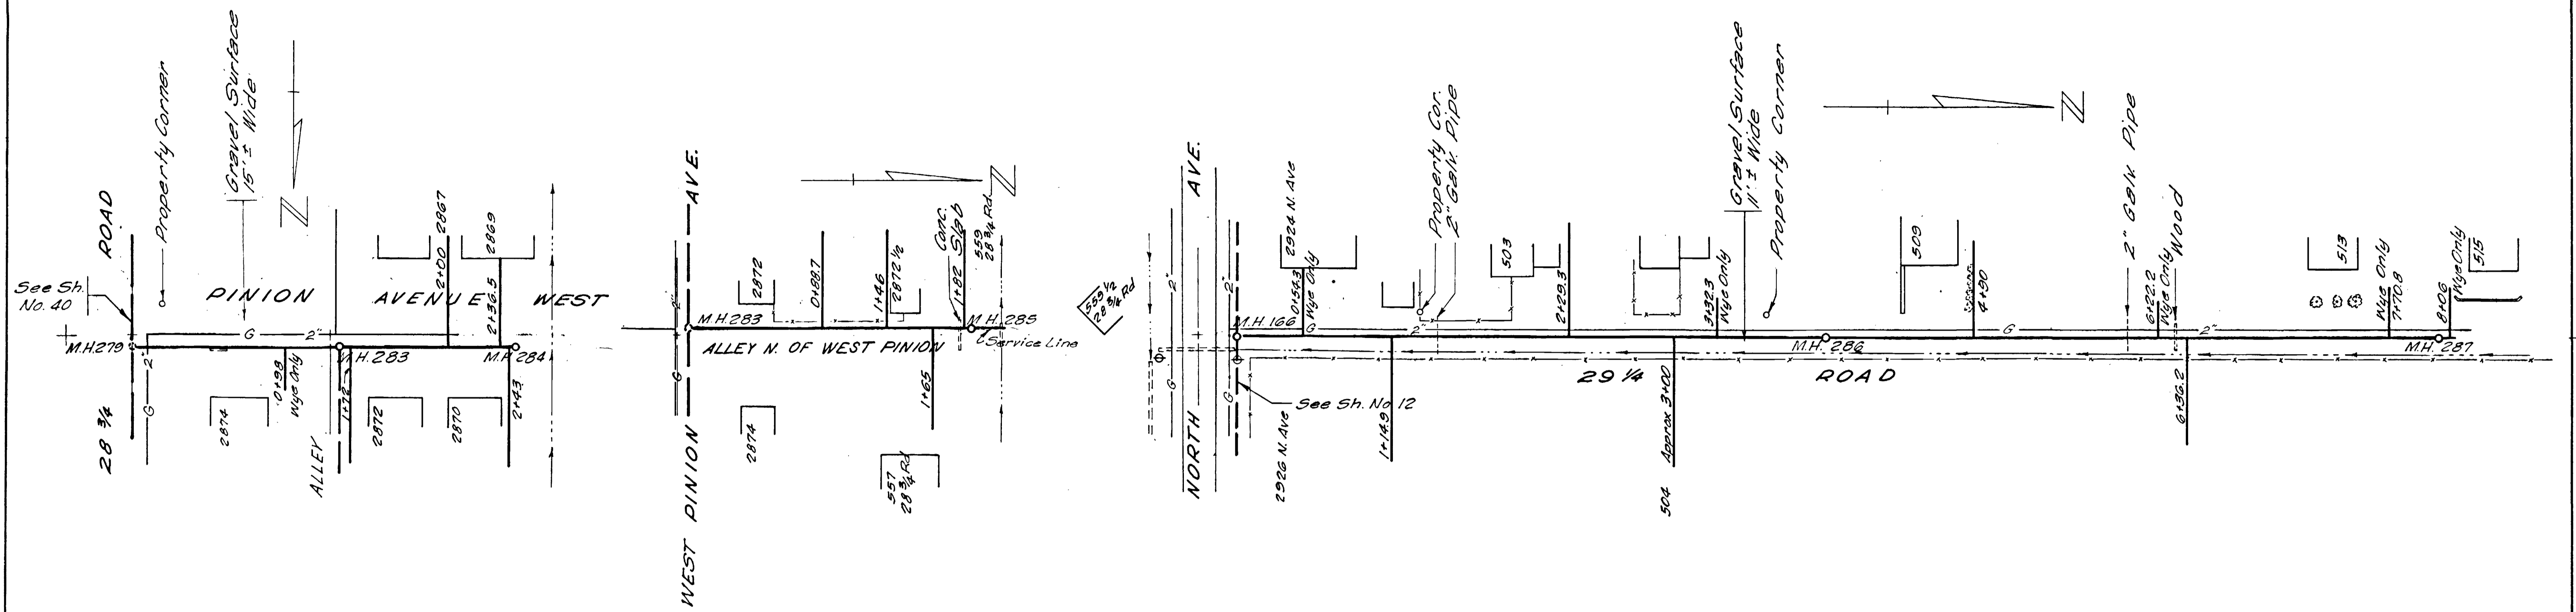



BY <u>R.G.T.</u> DATE <u>Feb. 1960</u> DESCR. <u>Grades</u> BY _____ DATE _____ DESCR. _____ BY _____ DATE _____ DESCR. _____	REVISIONS DATE _____ DESCR. _____ DATE _____ DESCR. _____	DATE <u>October 1952</u> DRAWN <u>D.V.R.</u> JOB NO. <u>G-205</u> CHECKED <u>R.G.T.</u> FILE NO. _____ SCALE <u>1" = 50'</u> APPROVED <u>[Signature]</u> F. B. NO. _____	HAROLD HOSKINS & ASSOCIATES ENGINEERING CONSULTANTS GREELEY, COLORADO LINCOLN, NEBRASKA	FRUITVALE, COLORADO WATER & SANITATION DISTRICT.	WEST PINION — ALLEY NORTH OF WEST PINION 29 1/4 ROAD	66 SHEET NO. SHEETS 41
-------------------------------------------------------------------------------------------------------------------------------------	-----------------------------------------------------------------	--------------------------------------------------------------------------------------------------------------------------------------------------------------------------------	---------------------------------------------------------------------------------------------------------------	-----------------------------------------------------------------------	-----------------------------------------------------------------------	---------------------------

02081741.tif

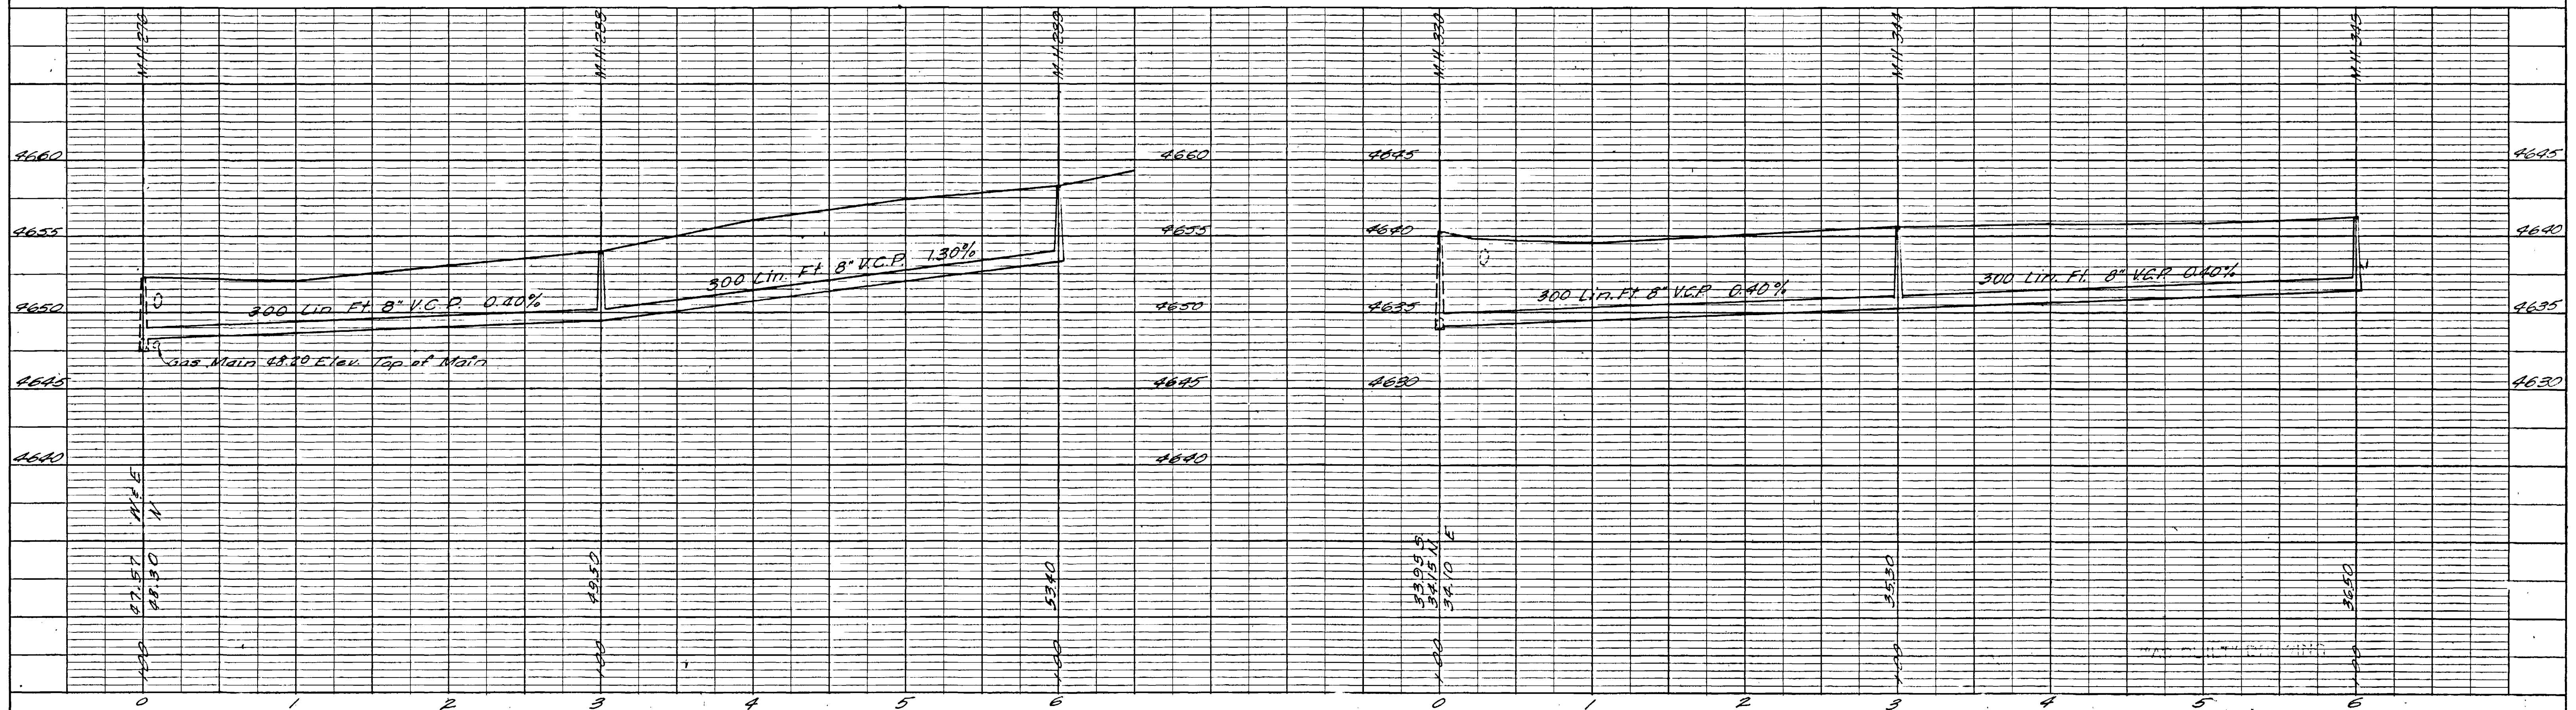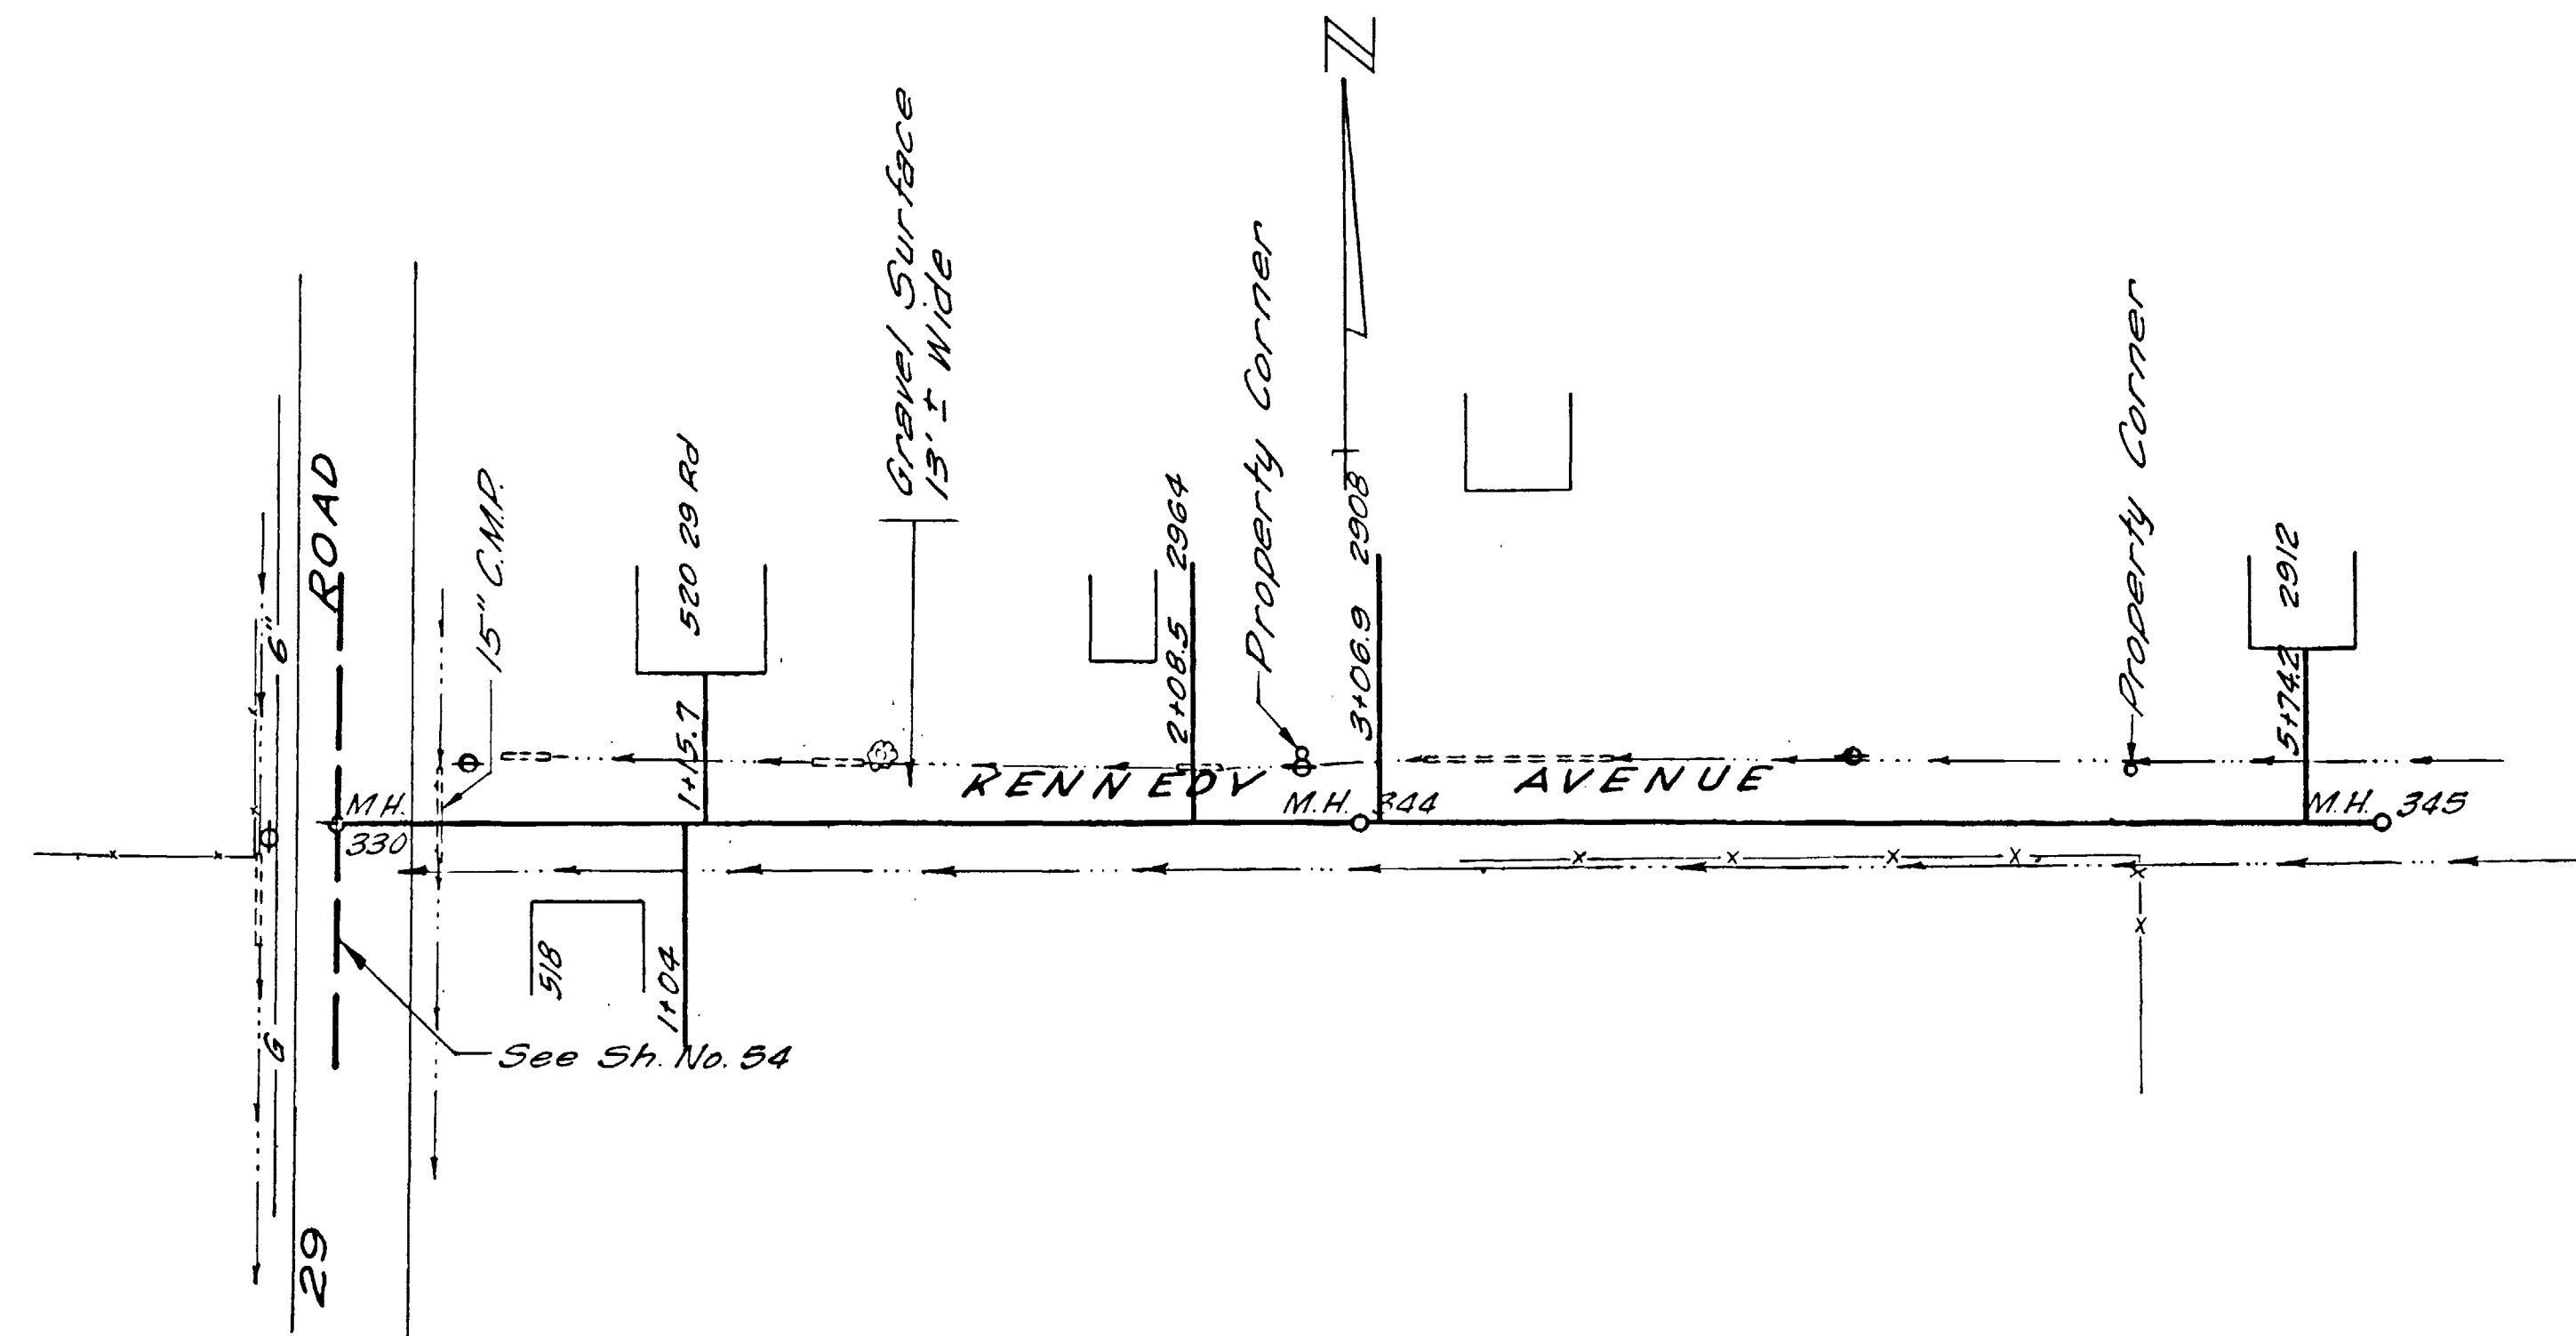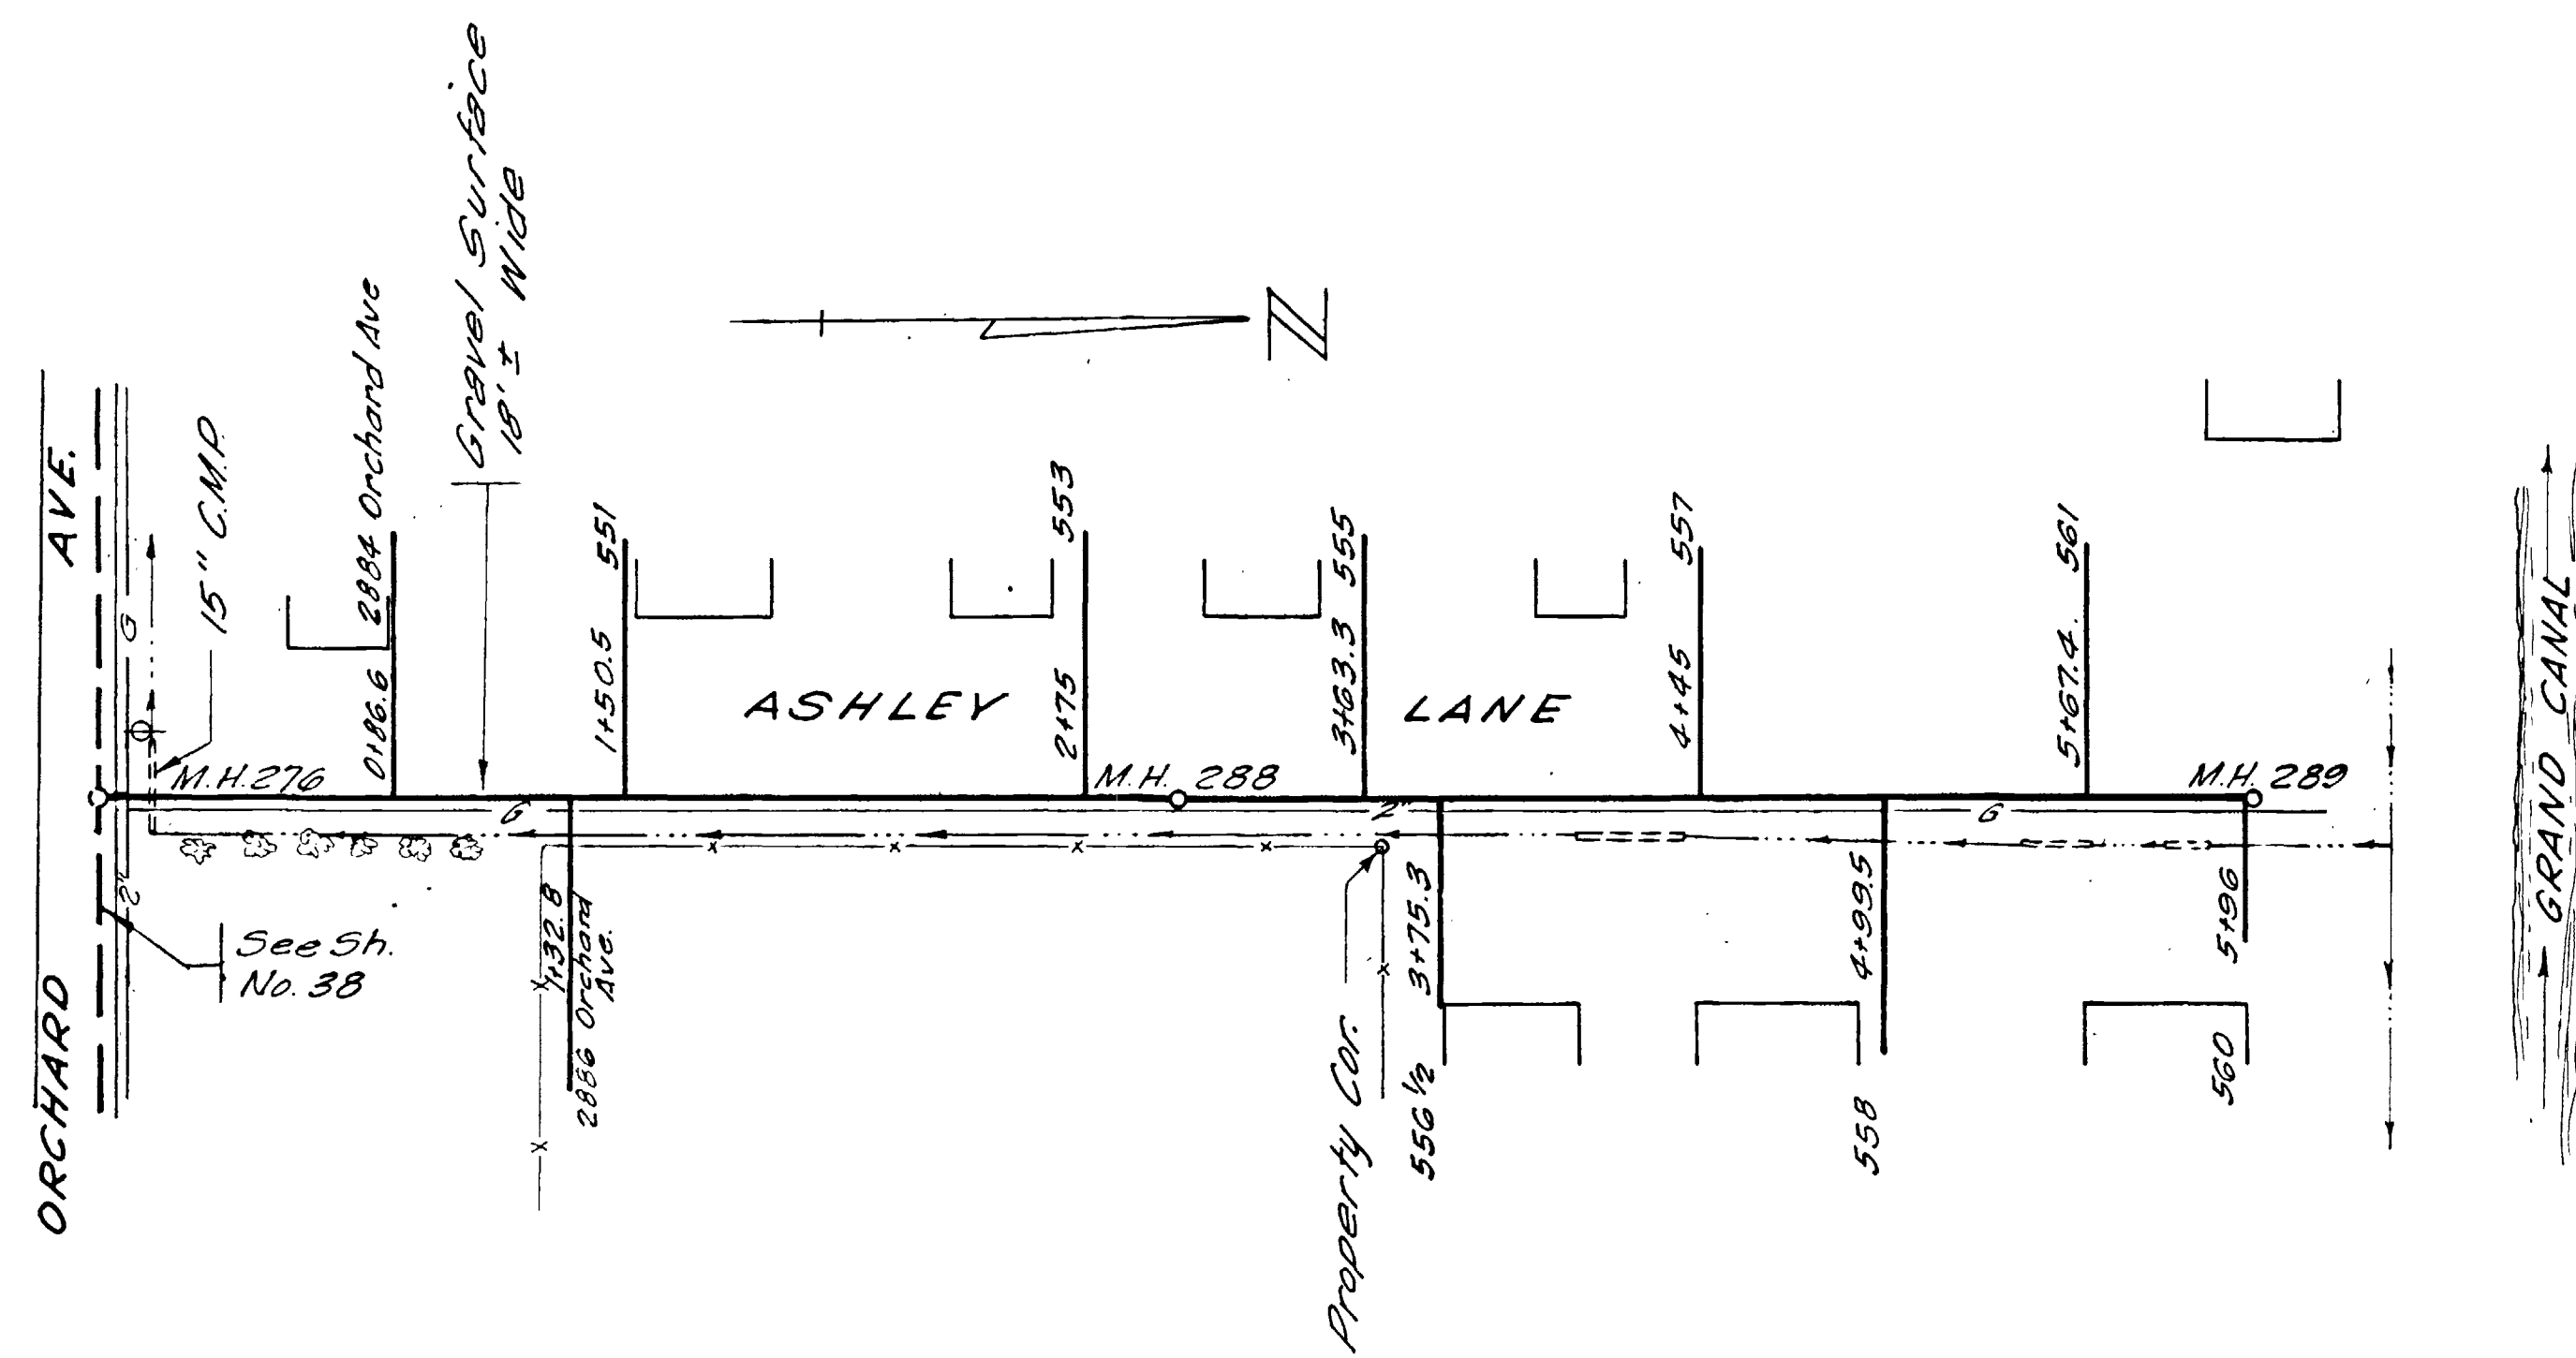




REVISIONS BY: R.C.T. DATE: Feb 13 1960 DESCR: Grades BY: DATE: DESCR: BY: DATE: DESCR:		DATE: October 1957 SCALE: 1"=50'	DRAWN: D.M.R. CHECKED: R.C.T. APPROVED: [Signature]	JOB NO: G-205 FILE NO: F. B. NO:	HAROLD HOSKINS & ASSOCIATES ENGINEERING CONSULTANTS GREELEY, COLORADO	FRUITVALE, COLORADO WATER & SANITATION DISTRICT LINCOLN, NEBRASKA	ASHLEY LANE KENNEDY AVENUE	66 SHEET NO. SHEETS 42
-------------------------------------------------------------------------------------------------	--	-------------------------------------	-----------------------------------------------------------	----------------------------------------	-----------------------------------------------------------------------------	-------------------------------------------------------------------------	-------------------------------	---------------------------

02081742.tif

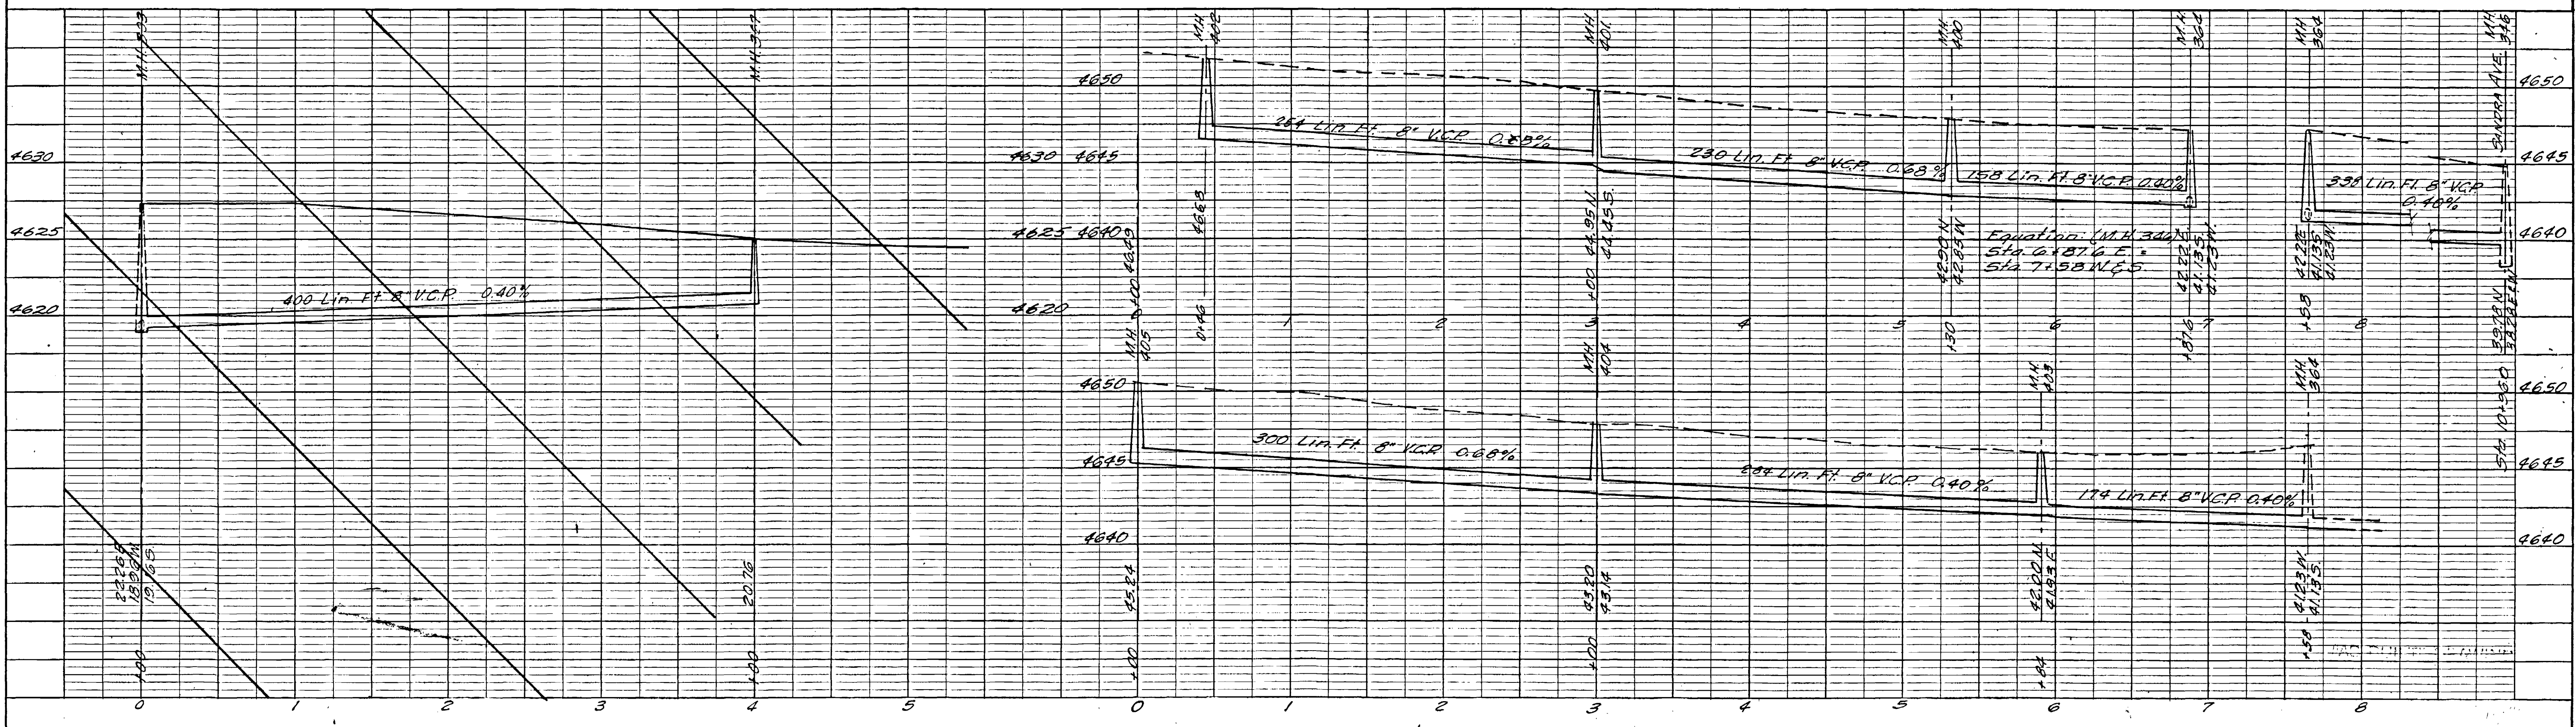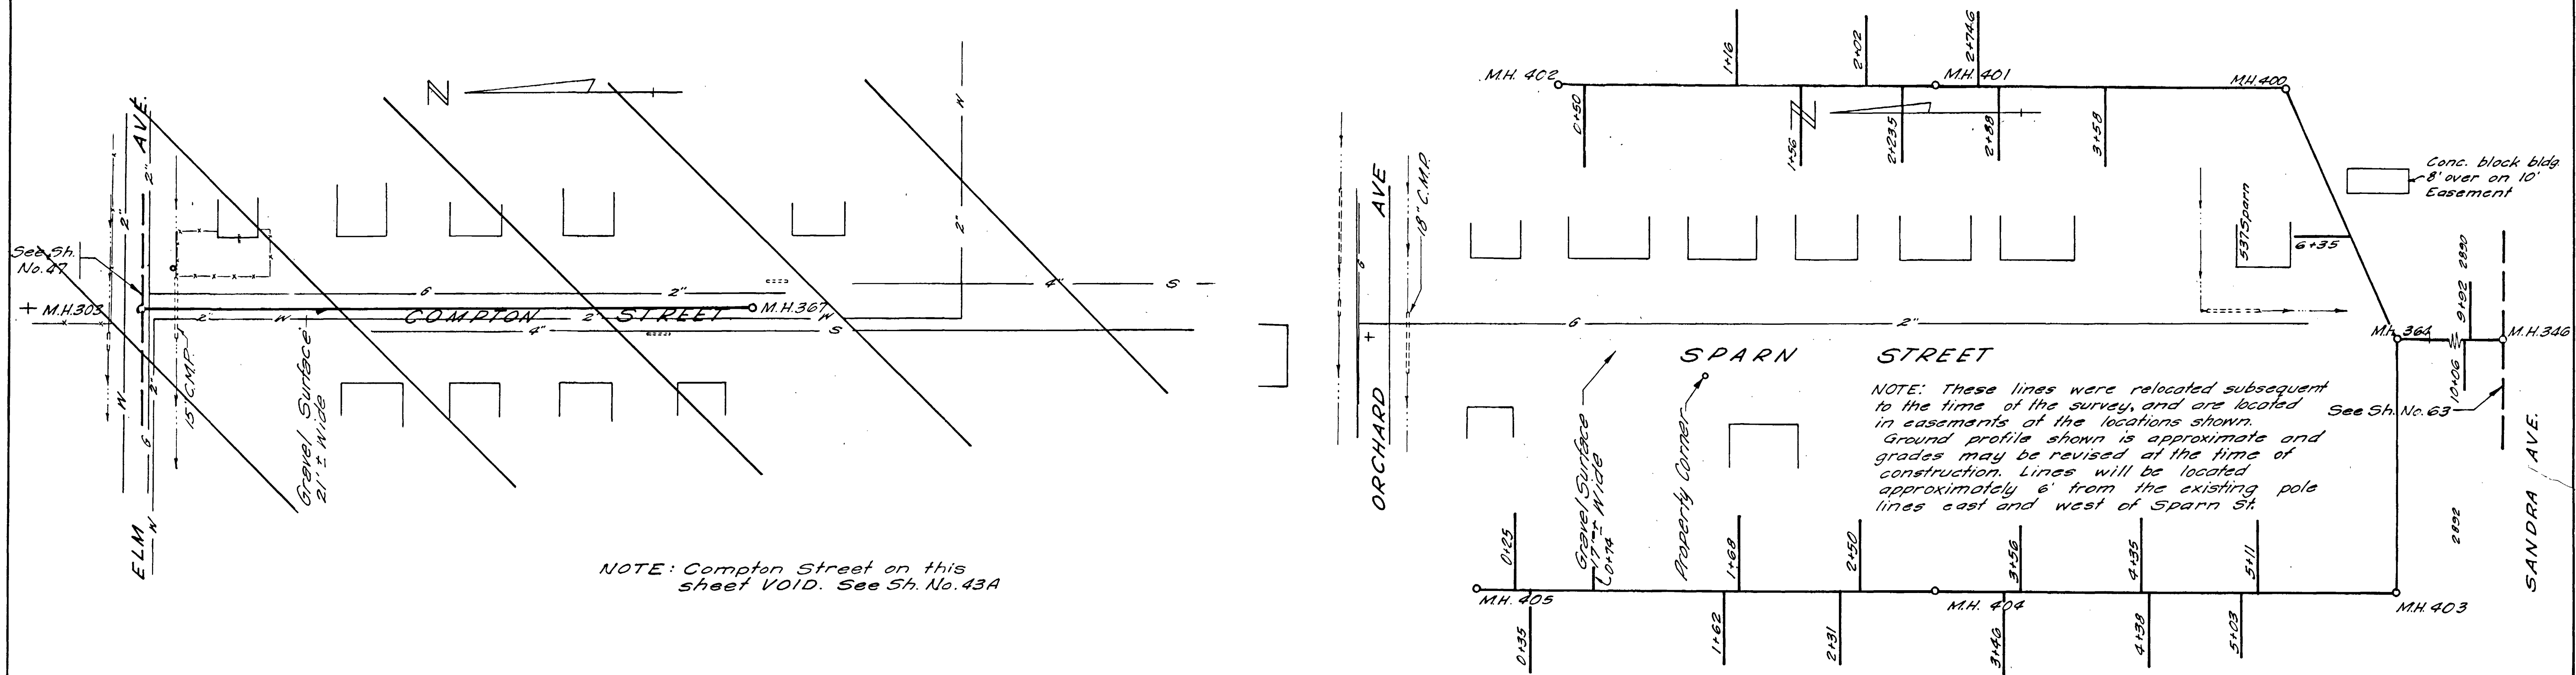



REVISIONS BY: <i>RWT</i> DATE: <i>Feb 1960</i> DESCR: <i>Grades & Alignment</i> BY: _____ DATE: _____ DESCR: _____		DATE: <i>October 1957</i> SCALE: <i>1"=50'</i>	DRAWN: <i>D.V.R.</i> JOB NO: <i>6-205</i> CHECKED: <i>R.G.T.</i> FILE NO: _____ APPROVED: <i>[Signature]</i> F. B. NO: _____	HAROLD HOSKINS & ASSOCIATES ENGINEERING CONSULTANTS GREELEY, COLORADO	FRUITVALE, COLORADO WATER & SANITATION DISTRICT LINCOLN, NEBRASKA	COMPTON STREET SPARN STREET SOUTH OF ORCHARD AVENUE	SHEET NO. 66 SHEETS 43
------------------------------------------------------------------------------------------------------------------------------	--	---------------------------------------------------	------------------------------------------------------------------------------------------------------------------------------------	----------------------------------------------------------------------------------------	--------------------------------------------------------------------------------	----------------------------------------------------------------------	-----------------------------------------

ELM AVENUE

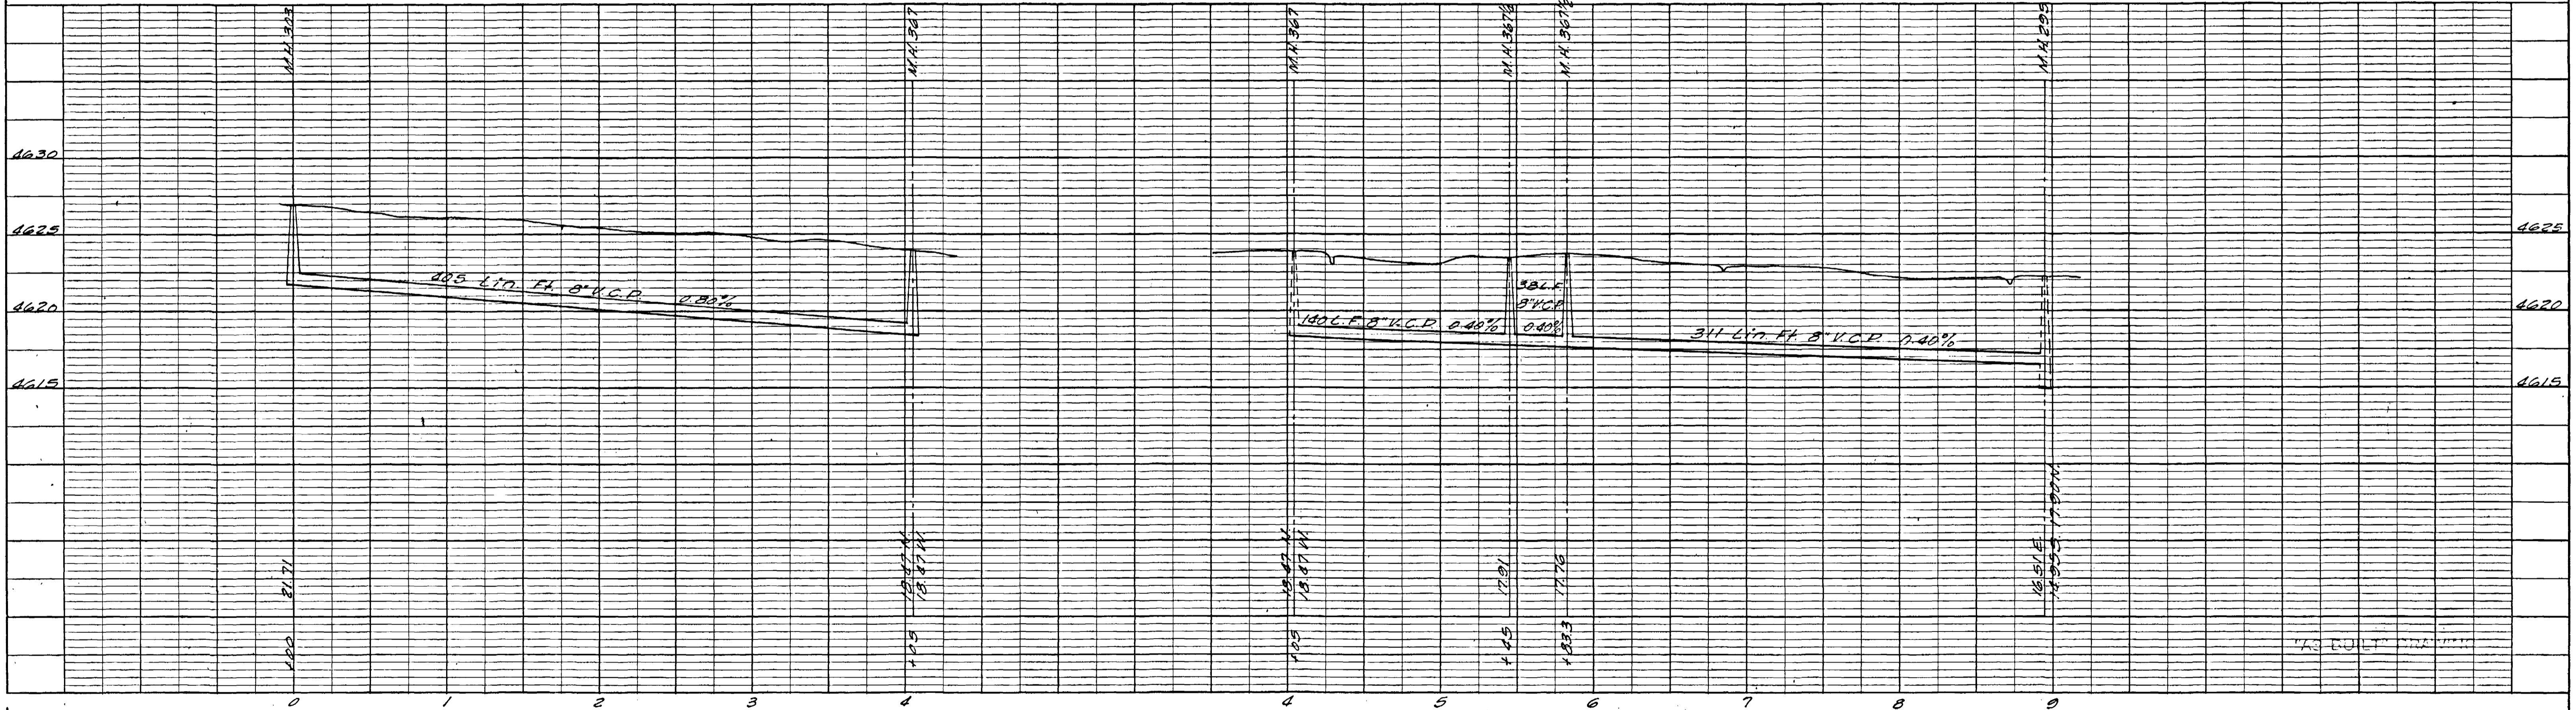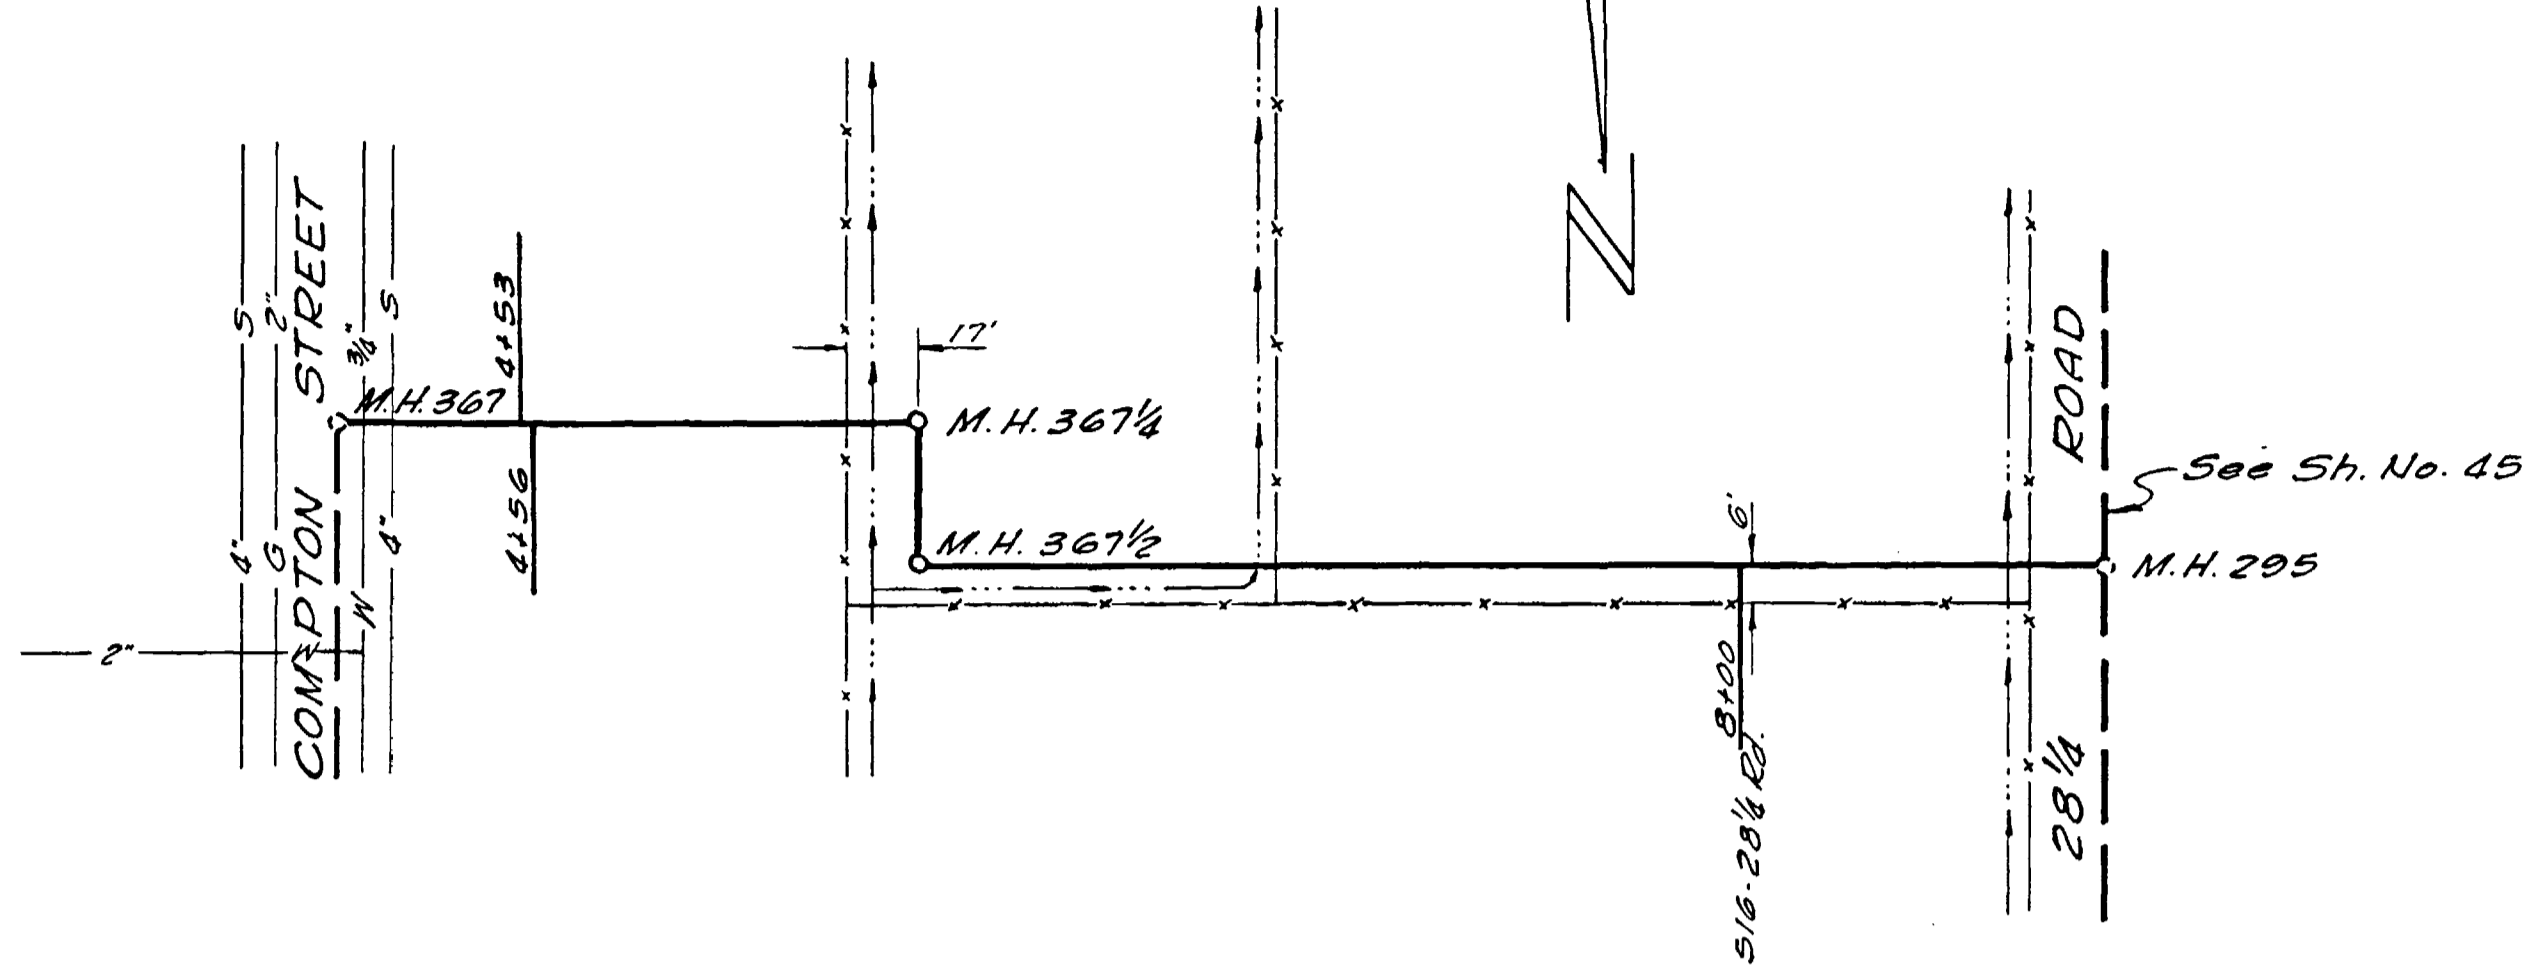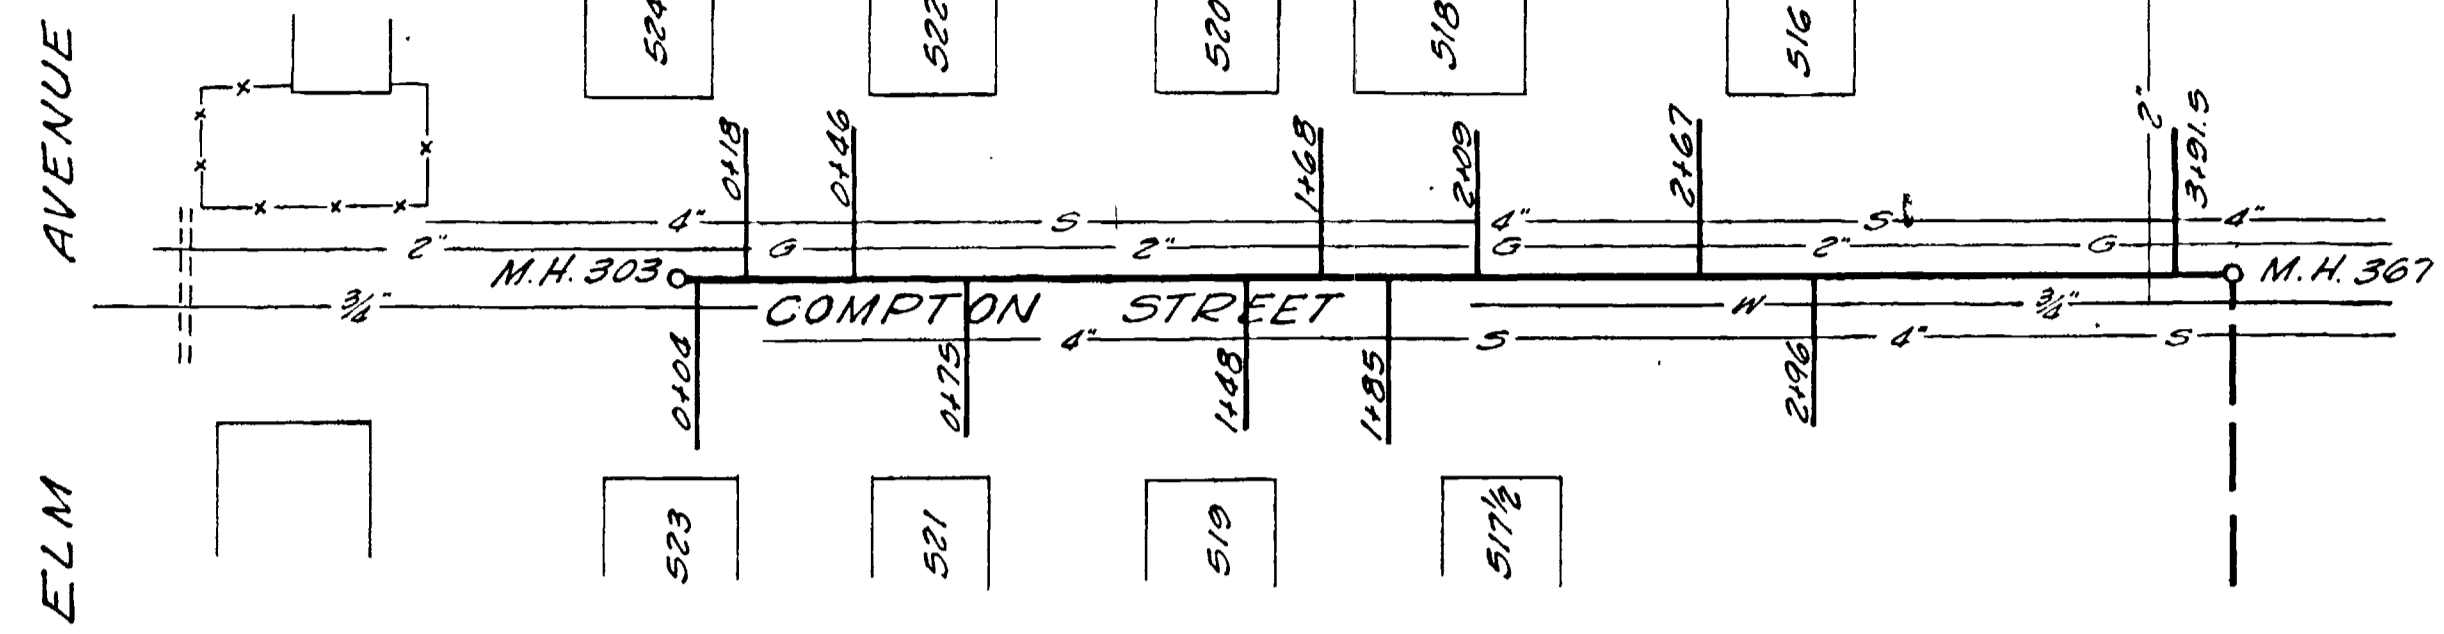


REVISIONS			DATE: 9-60			DESIGNED: H.G.U.			JOB NO.: 205		
BY: _____	DATE: _____	DESCR: _____	Horiz: 1"=50'	CHECKED: R.C.T.	FILE NO. _____	HAROLD HOSKINS & ASSOCIATES			FRUITVALE, COLORADO		
BY: _____	DATE: _____	DESCR: _____	SCALE: Vert: 1"=5'	APPROVED: R.C.T.	F. B. NO. _____	ENGINEERING CONSULTANTS			WATER & SANITATION DISTRICT		
						Greeley, Colorado			Great Falls, Montana		
						Lincoln, Nebraska			COMPTON STREET - TO 28 1/4 ROAD		
						66			SHEET NO. 43A		



02081744.tif

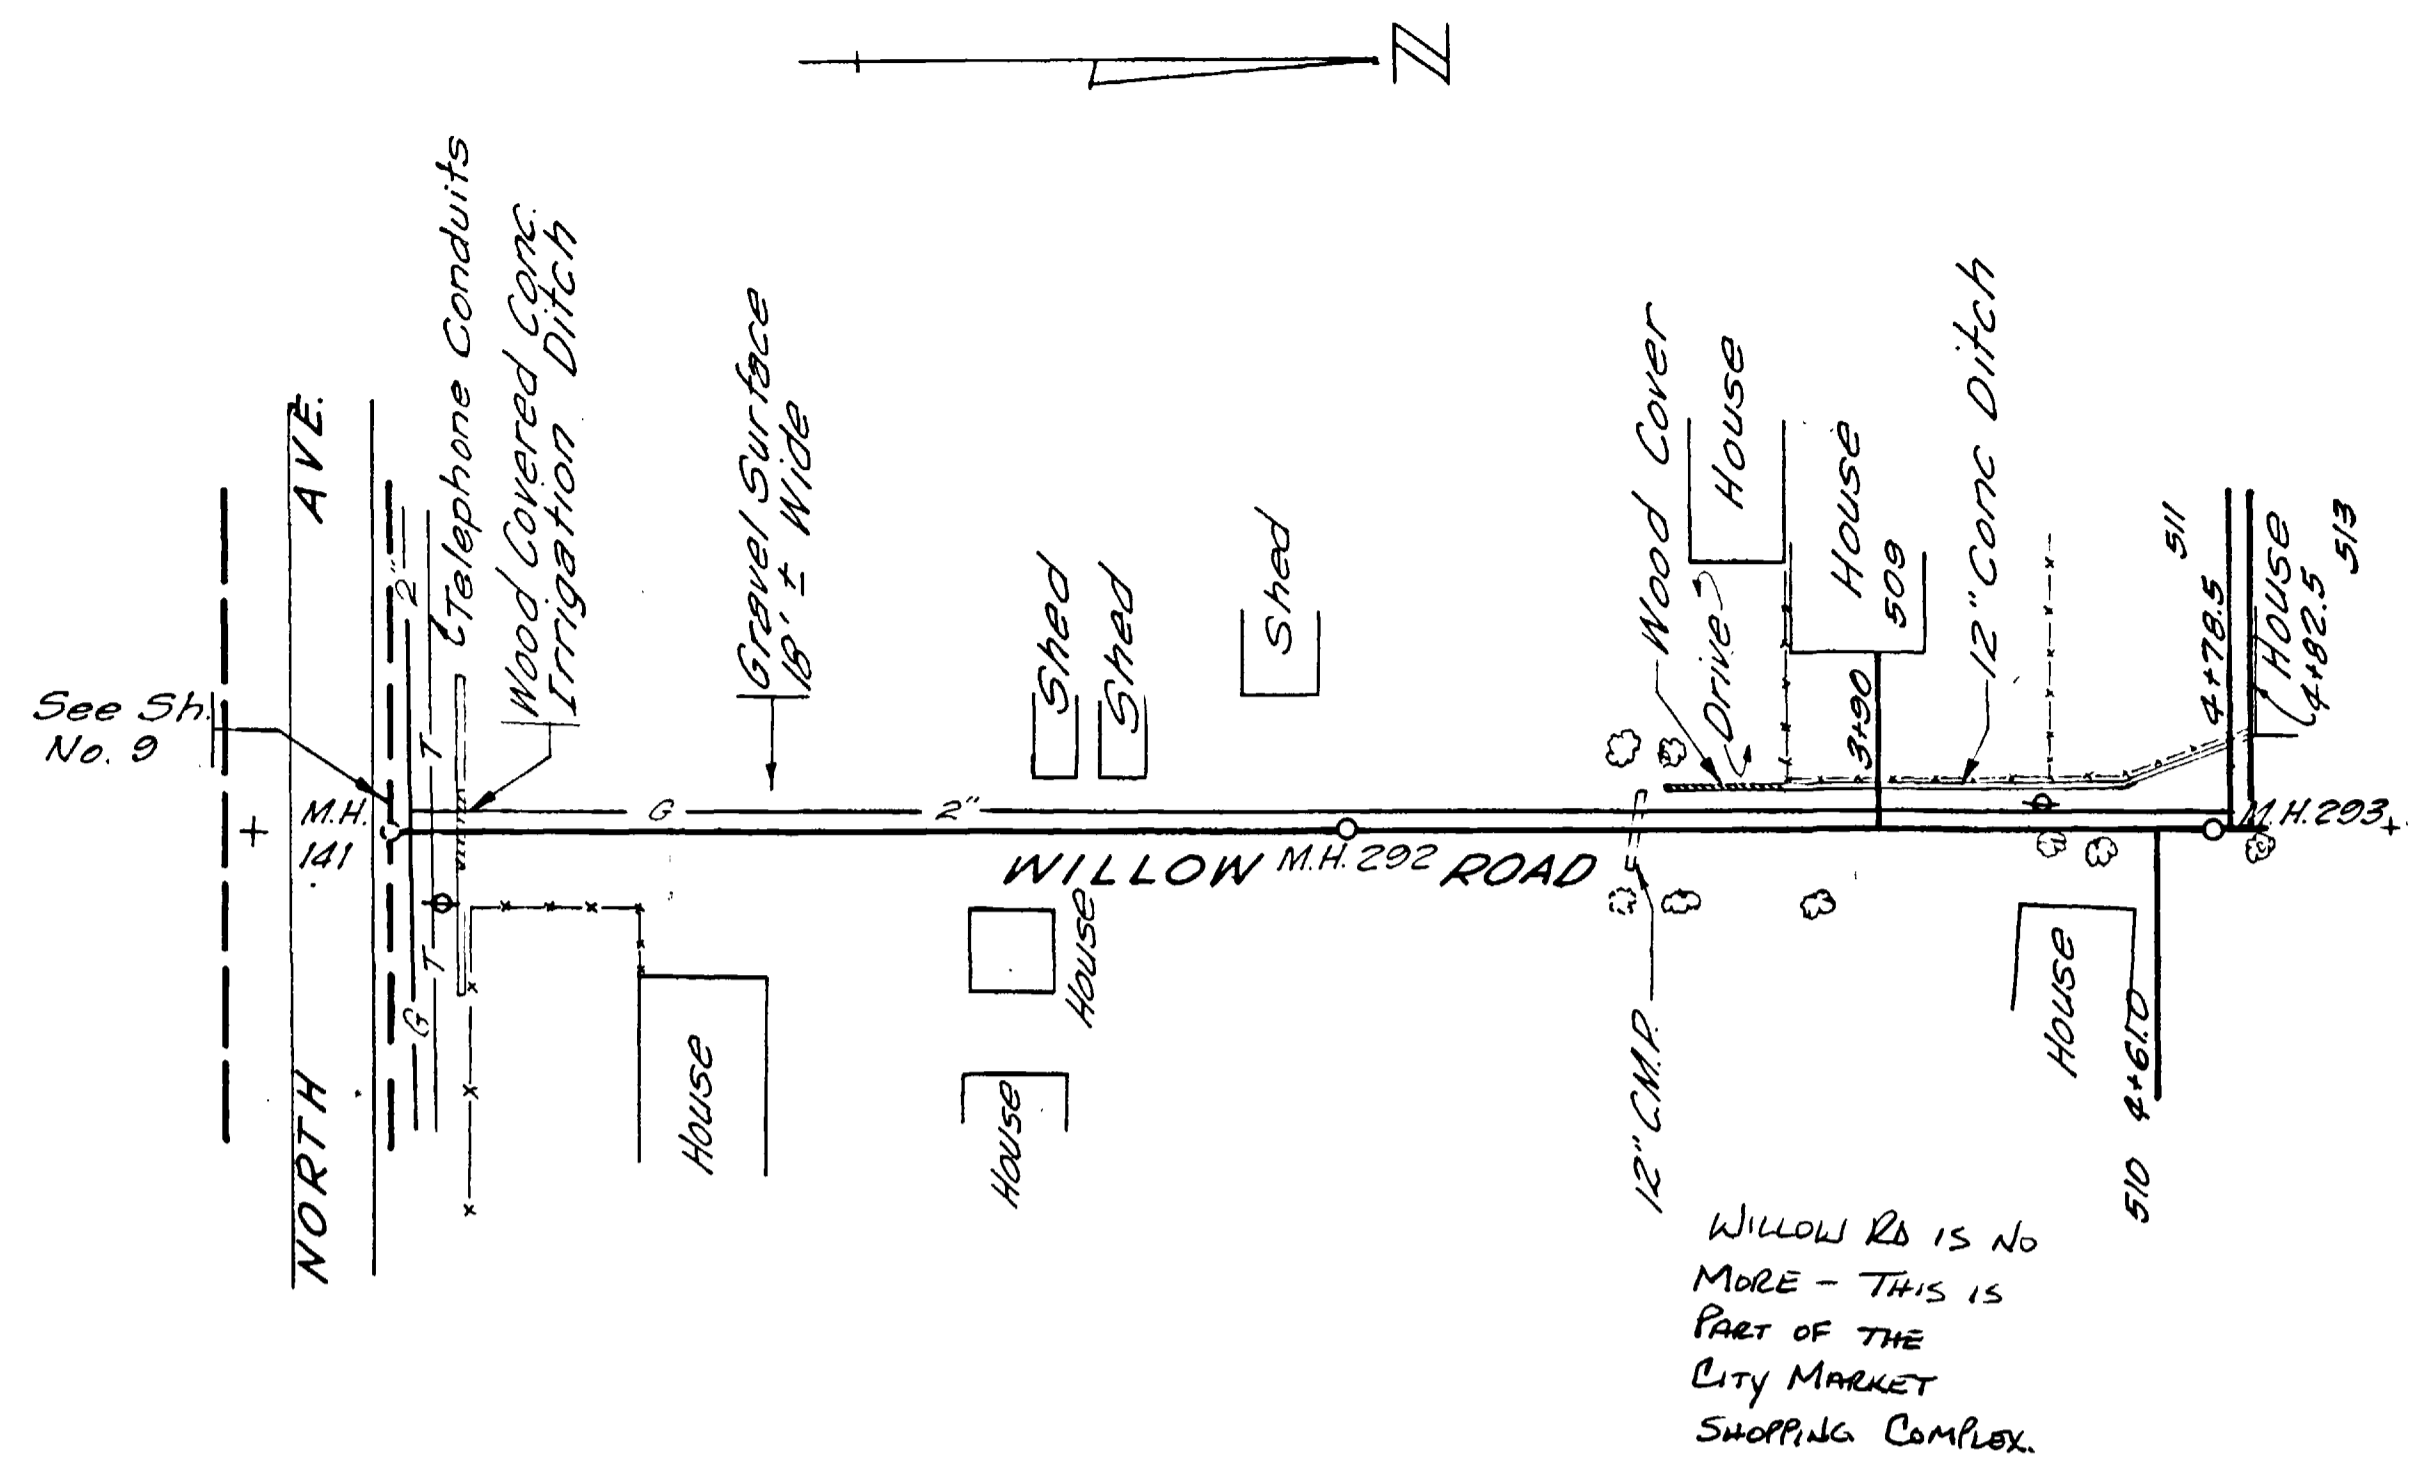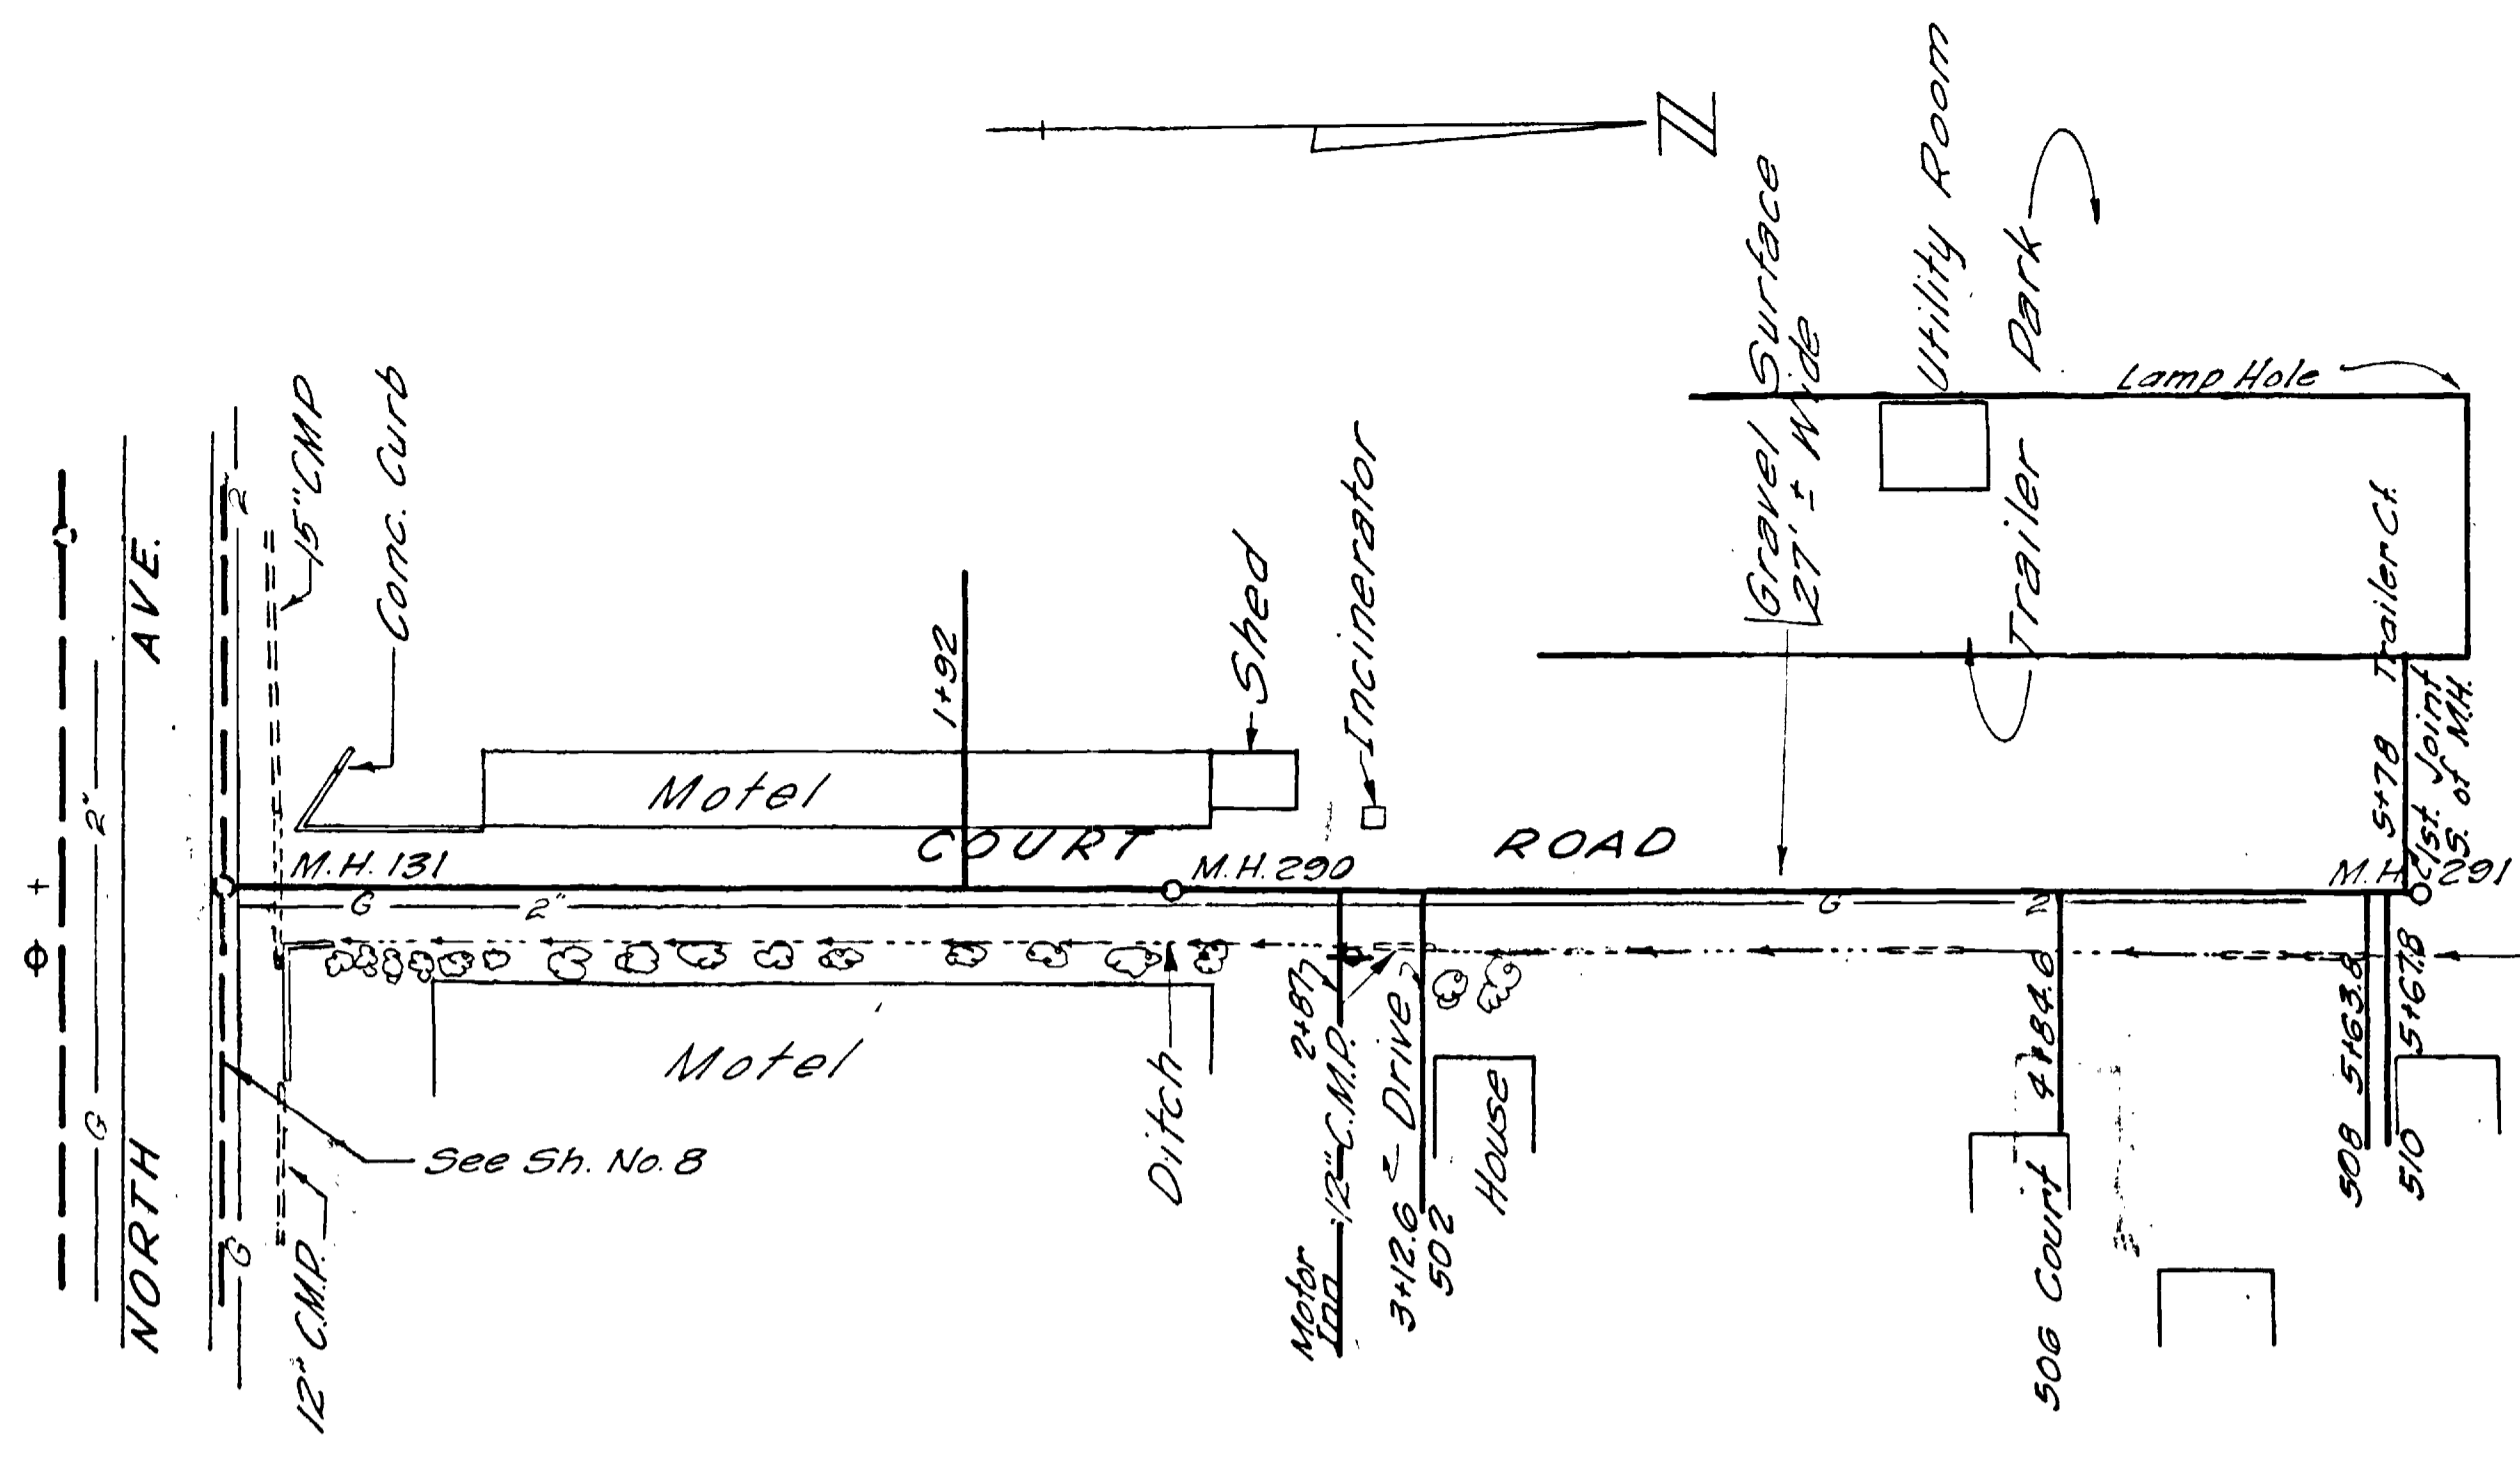

WILLOW RD IS NO MORE - THIS IS PART OF THE CITY MARKET SHOPPING COMPLEX.

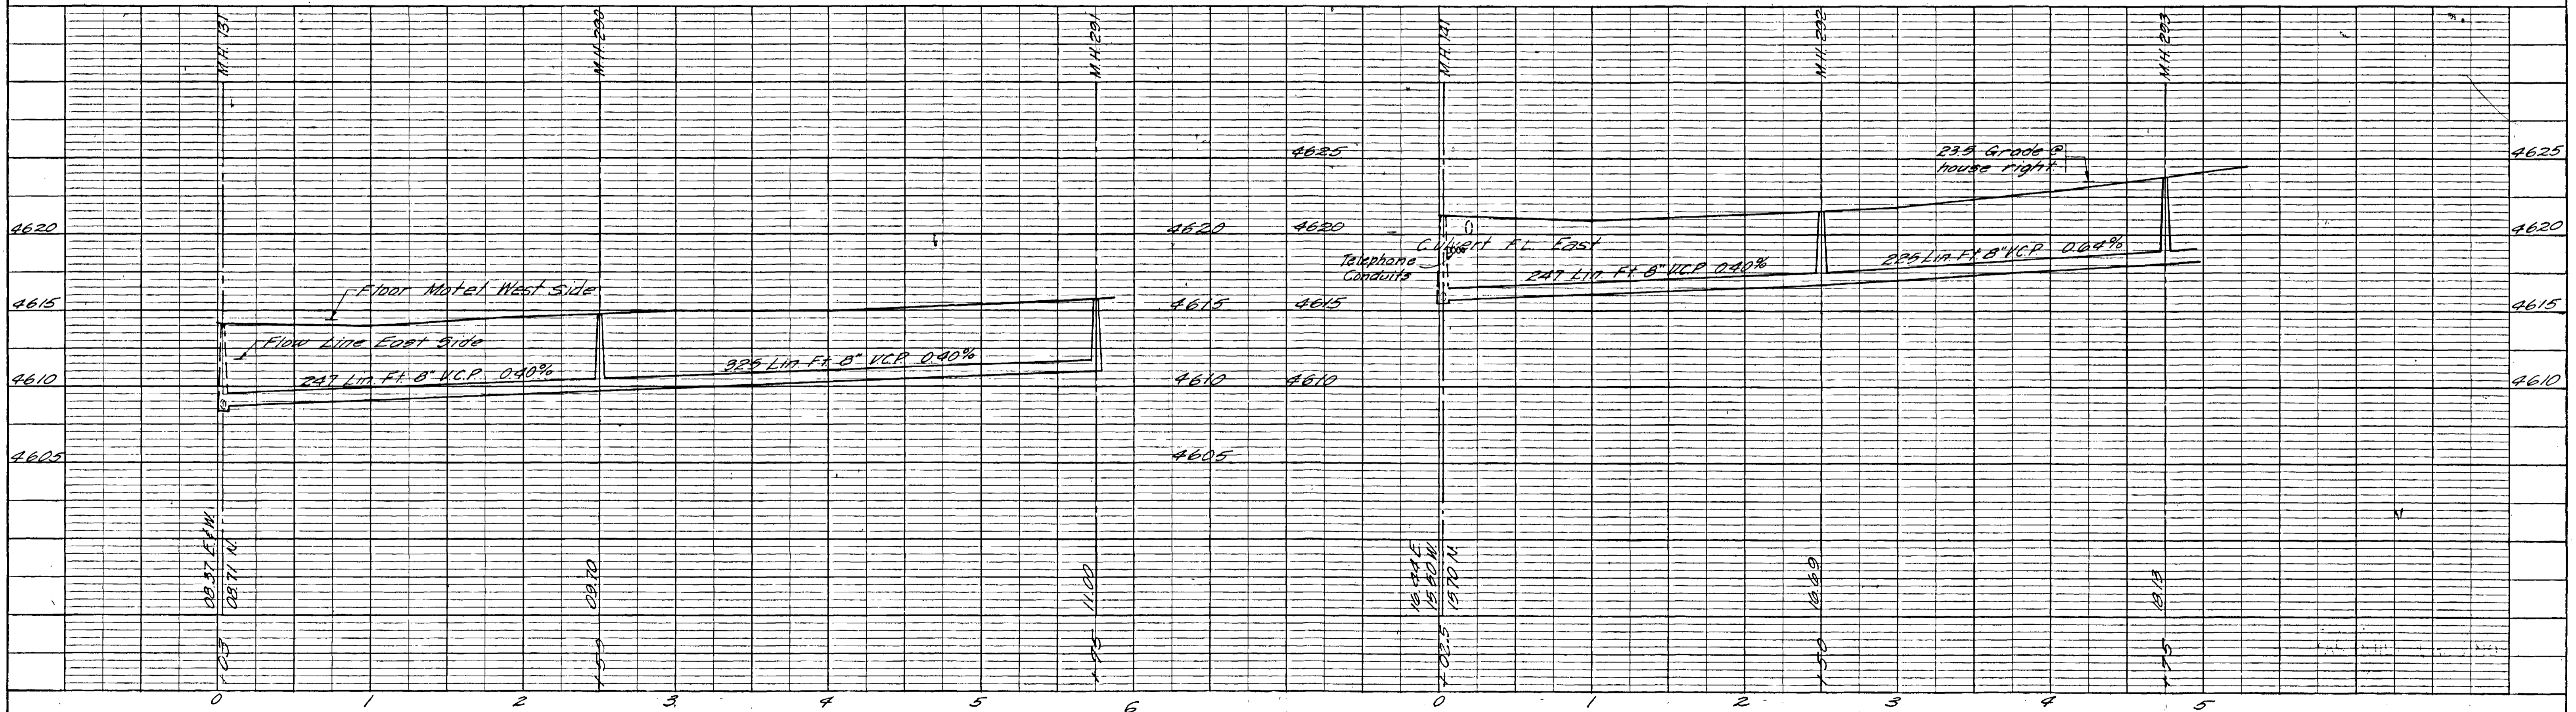

REVISIONS BY: RCT DATE: Feb, 1960 DESCR: Guide BY: DATE: DESCR:		DATE: October 1957 DRAWN: D.V.R. JOB NO: G-205 CHECKED: R.P.T. FILE NO: APPROVED: [Signature] F.B. NO:		HAROLD HOSKINS & ASSOCIATES ENGINEERING CONSULTANTS GREELEY, COLORADO		FRUITVALE, COLORADO WATER & SANITATION DISTRICT		COURT ROAD WILLOW ROAD		66 SHEETS	44 SHEET NO.
-----------------------------------------------------------------------	--	--------------------------------------------------------------------------------------------------------------	--	-----------------------------------------------------------------------------	--	----------------------------------------------------	--	---------------------------	--	--------------	-----------------

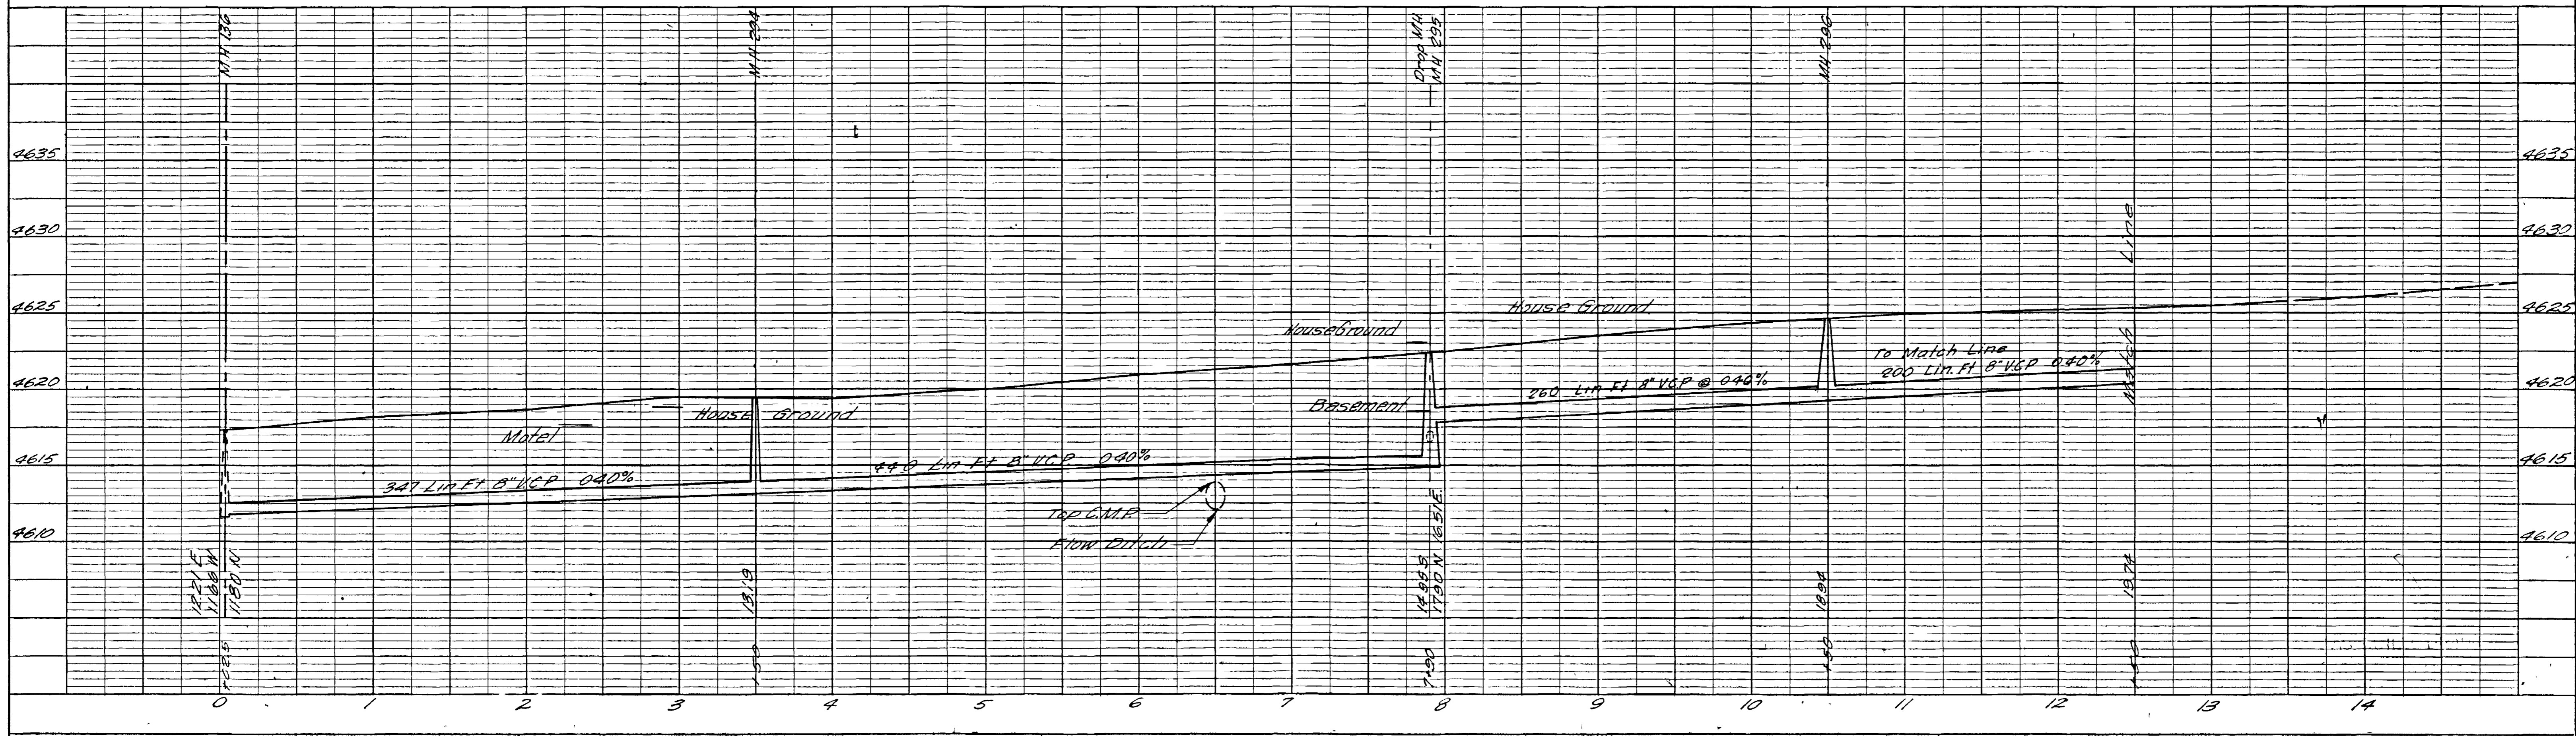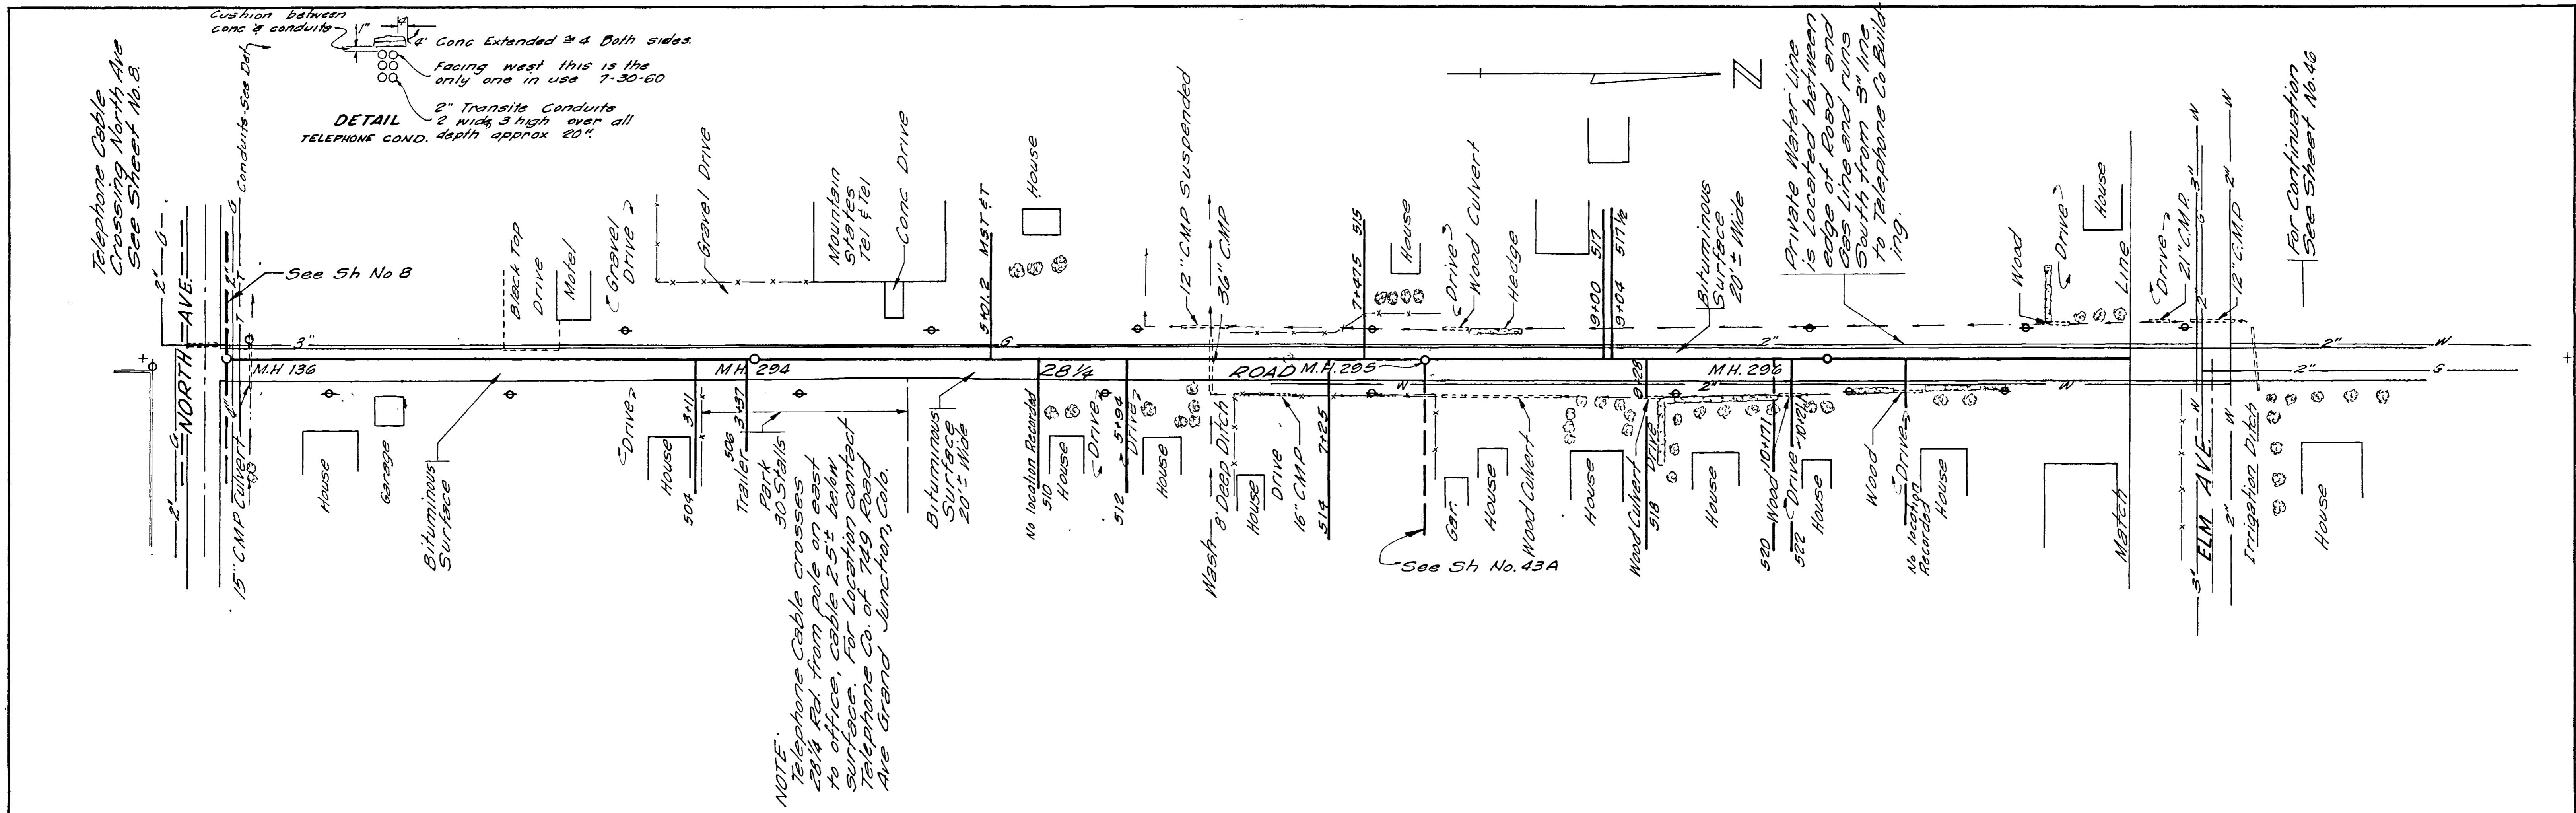



REVISIONS	DATE	BY	DESCR	DATE	BY	DESCR	DATE	BY	DESCR
	Feb 1960	RCT	Grades	October 1959					

HAROLD HOSKINS & ASSOCIATES
 ENGINEERING CONSULTANTS
 GREELEY, COLORADO
 LINCOLN, NEBRASKA



FRUITVALE, COLORADO
 WATER & SANITATION DISTRICT

28 1/4 ROAD STA. 0+00 TO STA. 12+50



SHEET NO. 45 OF 66

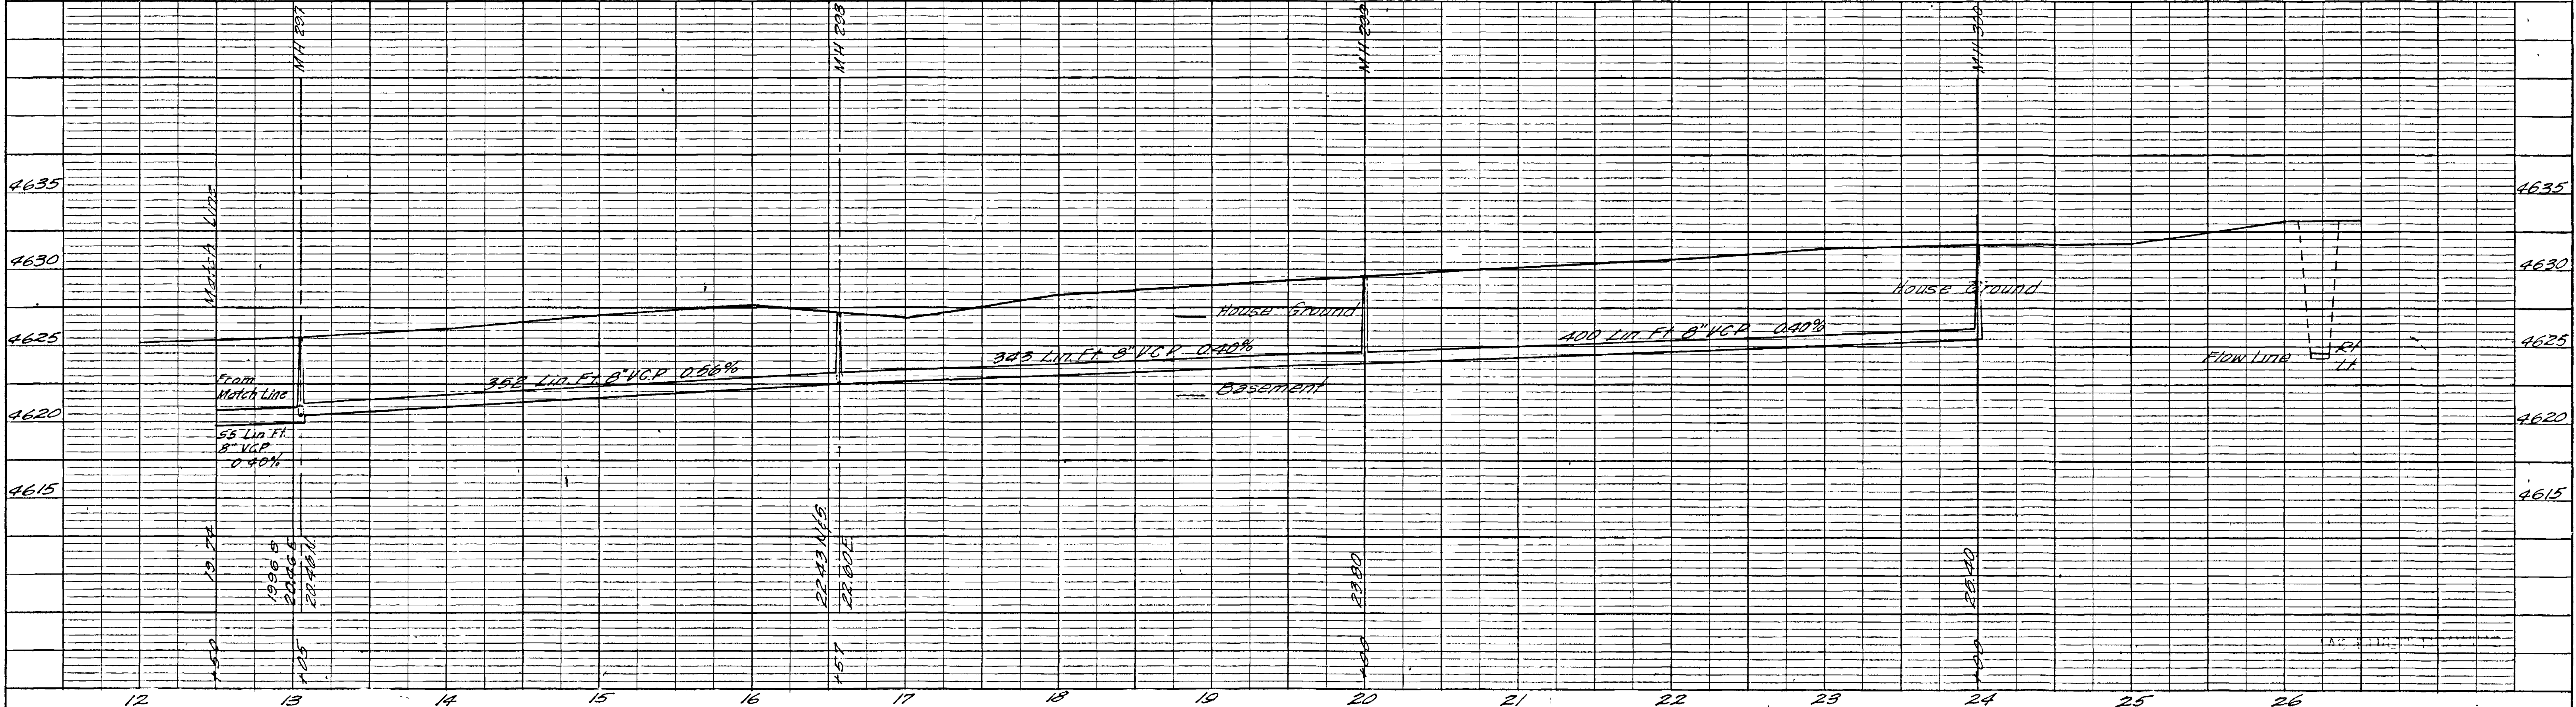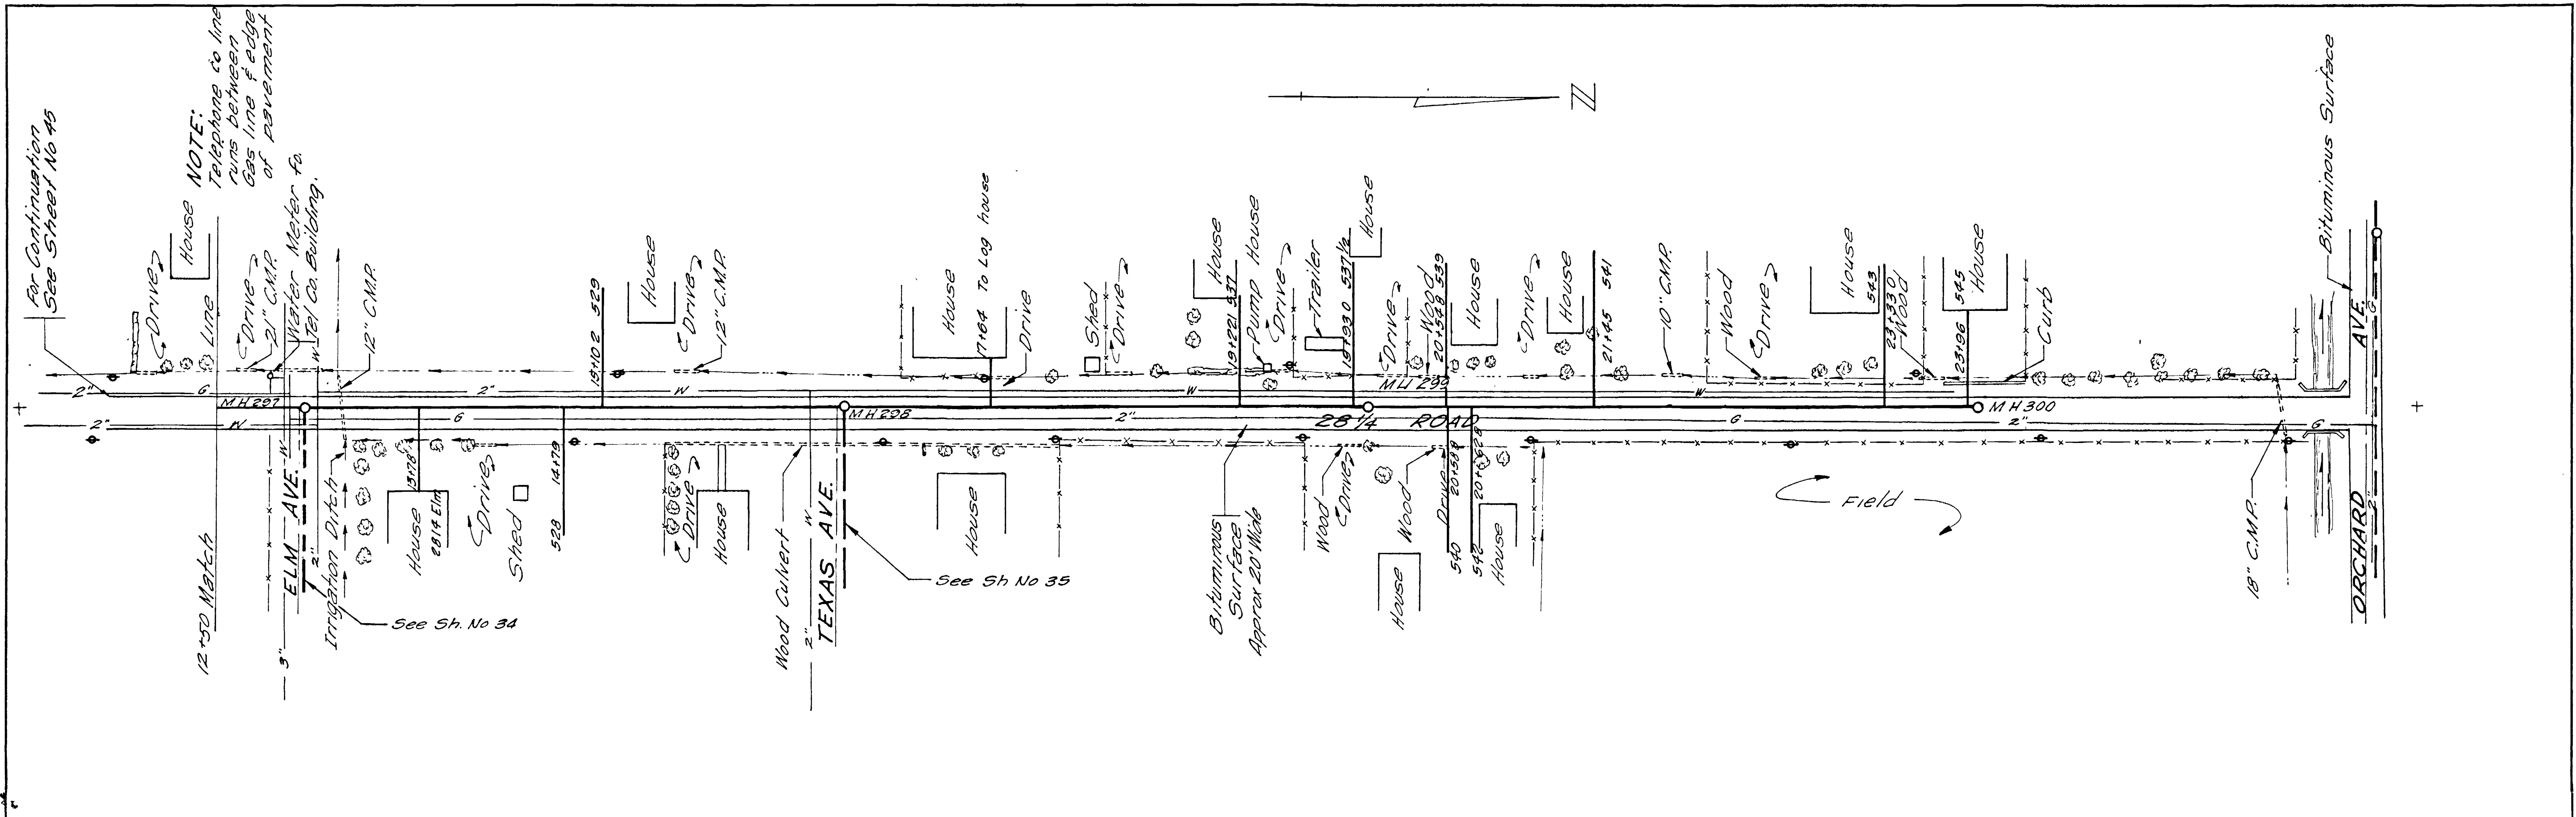

REVISIONS BY: _____ DATE: _____ DESCR: _____ BY: _____ DATE: _____ DESCR: _____		DATE: <u>October 1952</u> DRAWN: <u>D.V.R.</u> JOB NO: <u>G-205</u> CHECKED: <u>R.C.F.</u> FILE NO: _____ APPROVED: <u>[Signature]</u> F.B. NO: _____		HAROLD HOSKINS & ASSOCIATES ENGINEERING CONSULTANTS GREELEY, COLORADO LINCOLN, NEBRASKA		FRUITVALE, COLORADO WATER & SANITATION DISTRICT		28 1/4 ROAD STA. 12+50 TO STA. 24+00		66 SHEET NO. SHEETS 40	
---------------------------------------------------------------------------------------	--	-------------------------------------------------------------------------------------------------------------------------------------------------------------	--	-----------------------------------------------------------------------------------------------	--	----------------------------------------------------	--	--------------------------------------	--	---------------------------	--

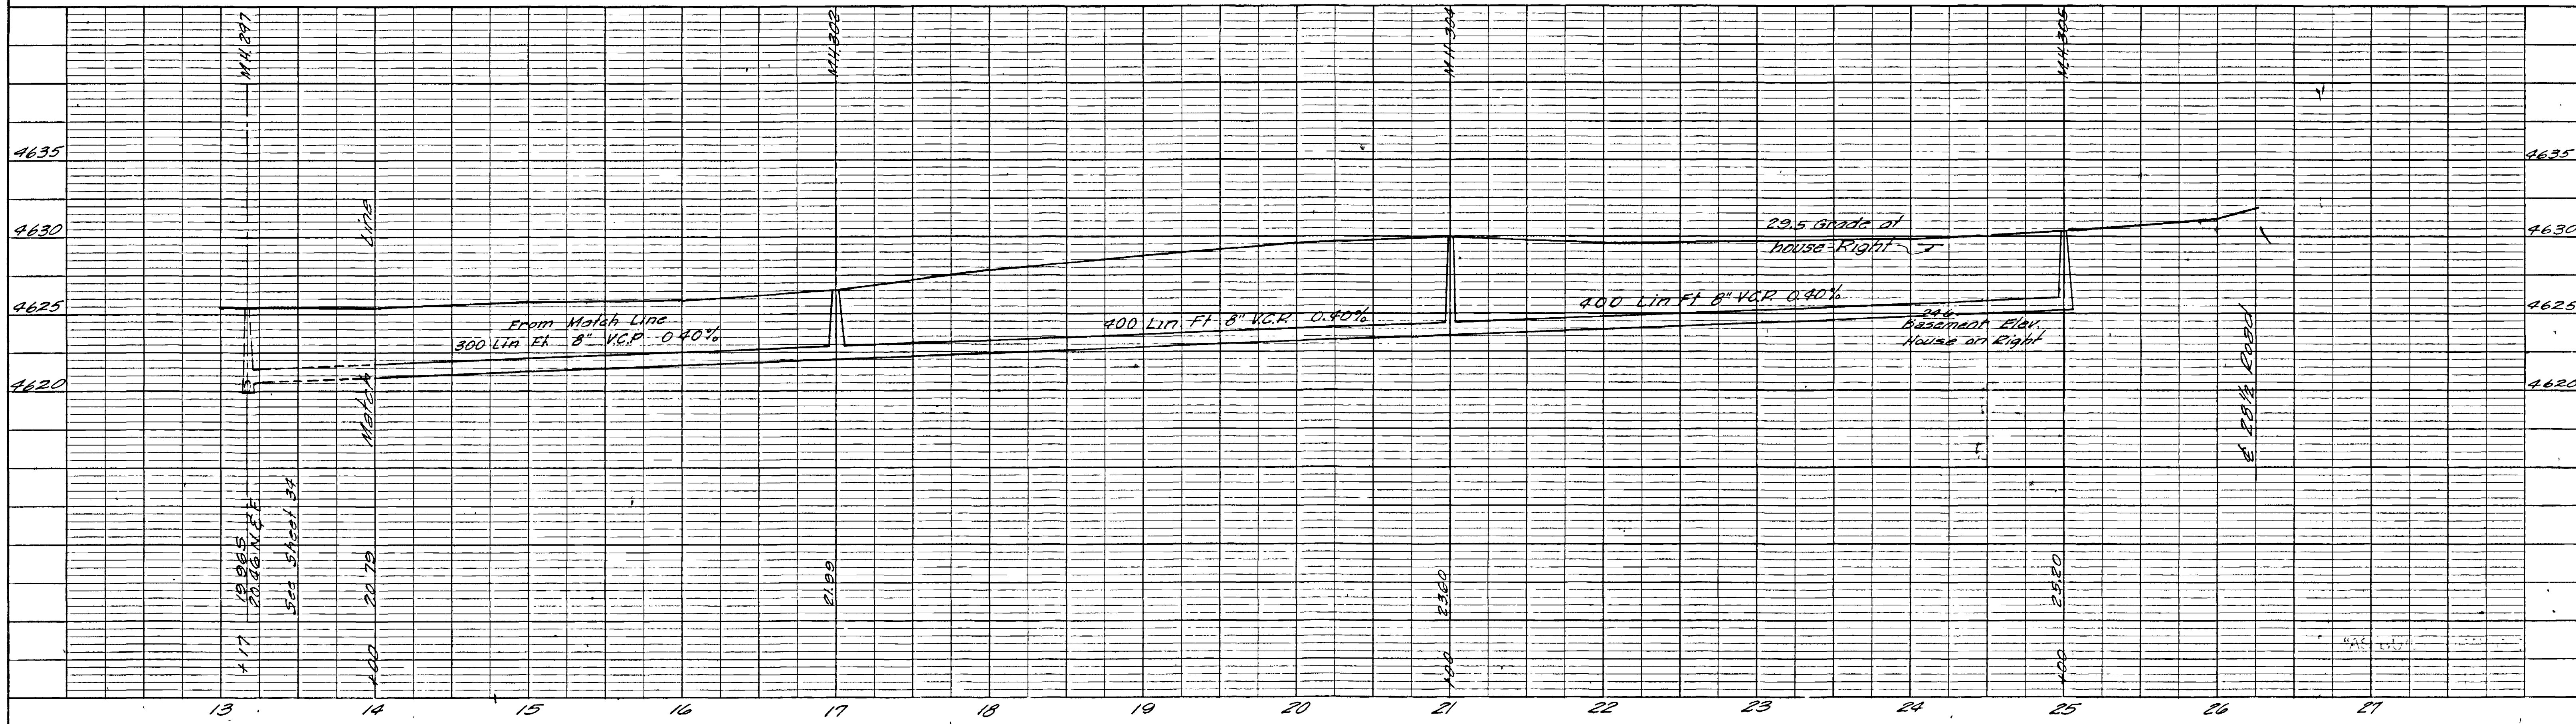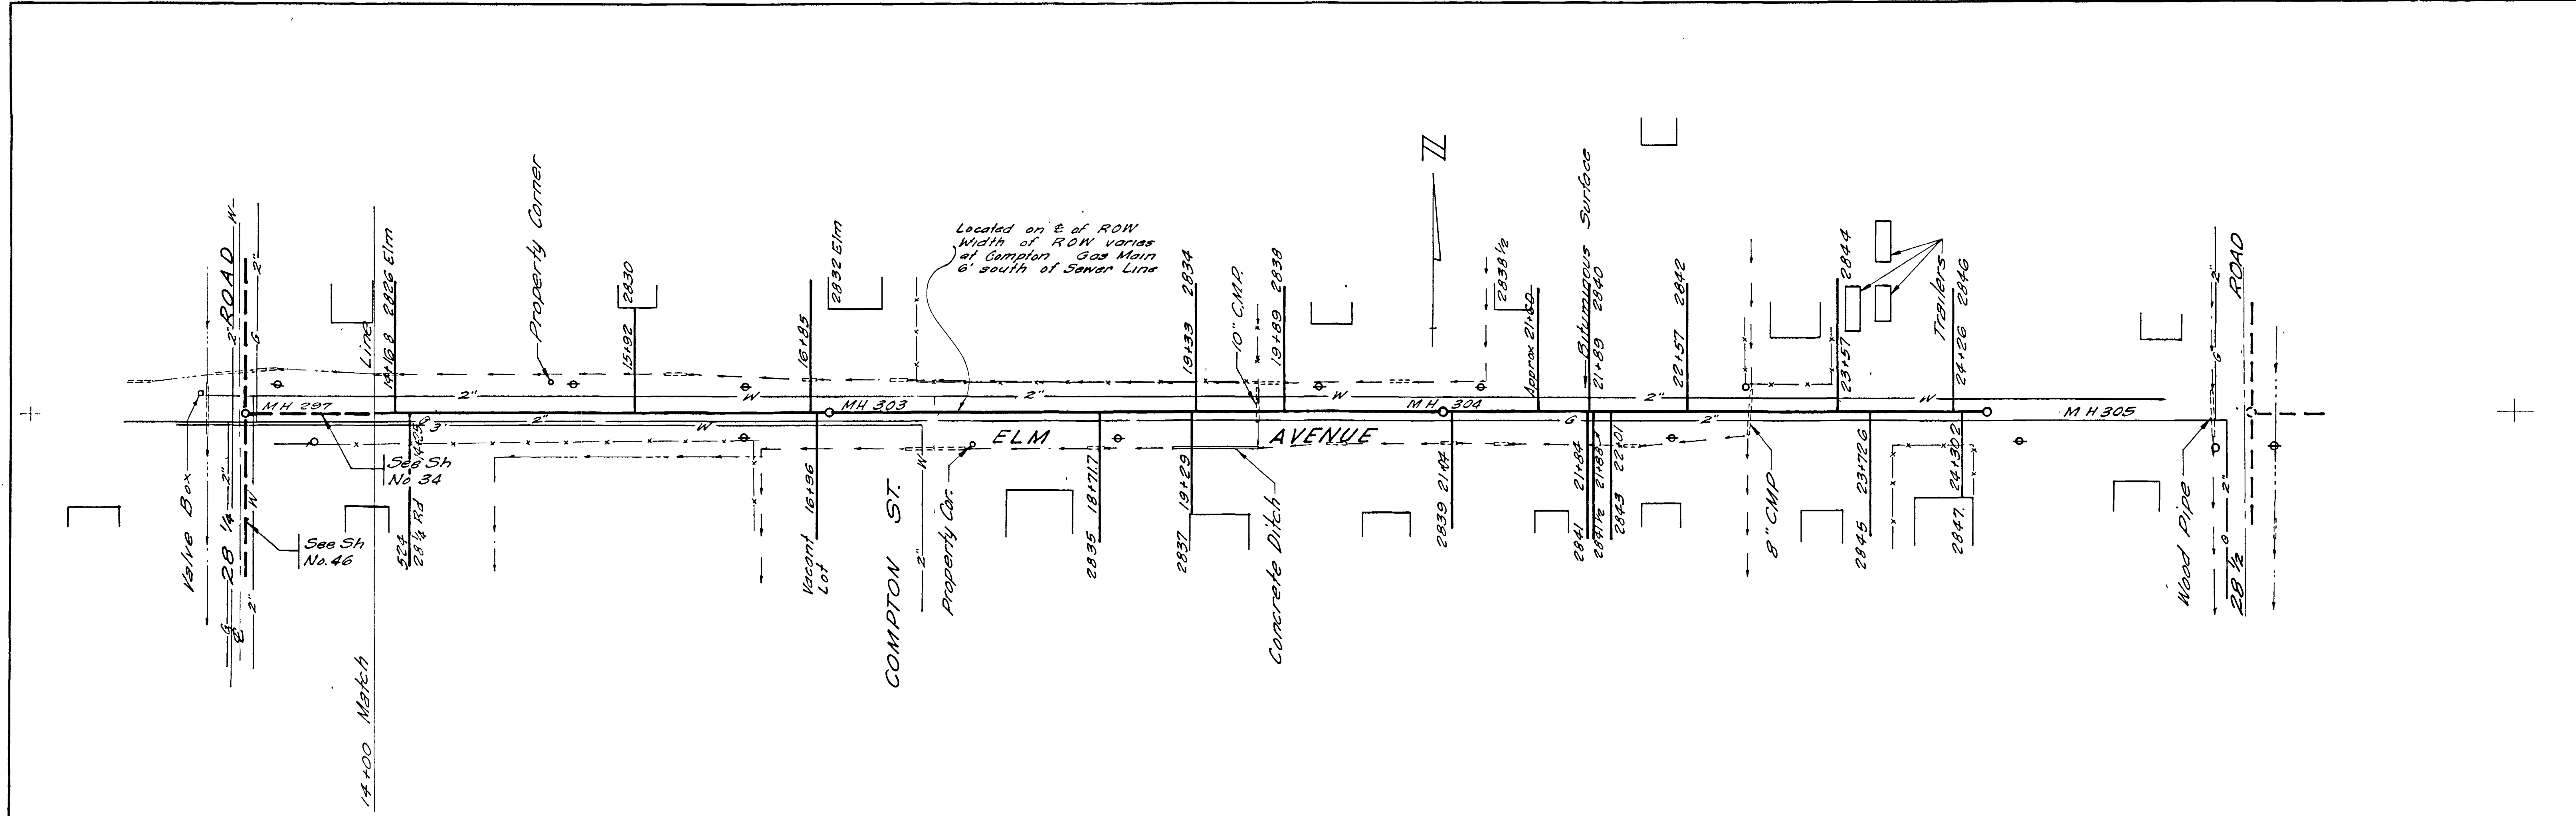

REVISIONS BY: R.C.T. DATE: Feb 1960 DESC: Grooves BY: DATE: DESC:		DATE: October 1957 DRAWN: D.V.R. JOB NO: G-205 CHECKED: R.C.T. FILE NO: APPROVED: [Signature] F.B. NO:		HAROLD HOSKINS & ASSOCIATES ENGINEERING CONSULTANTS GREELEY, COLORADO LINCOLN, NEBRASKA		FRUITVALE, COLORADO WATER & SANITATION DISTRICT		ELM AVENUE EAST OF 28 1/4 ROAD TO 28 1/2 ROAD		66 SHEETS	SHEET NO 47
-------------------------------------------------------------------------	--	--------------------------------------------------------------------------------------------------------------	--	-----------------------------------------------------------------------------------------------	--	----------------------------------------------------	--	--------------------------------------------------	--	--------------	----------------

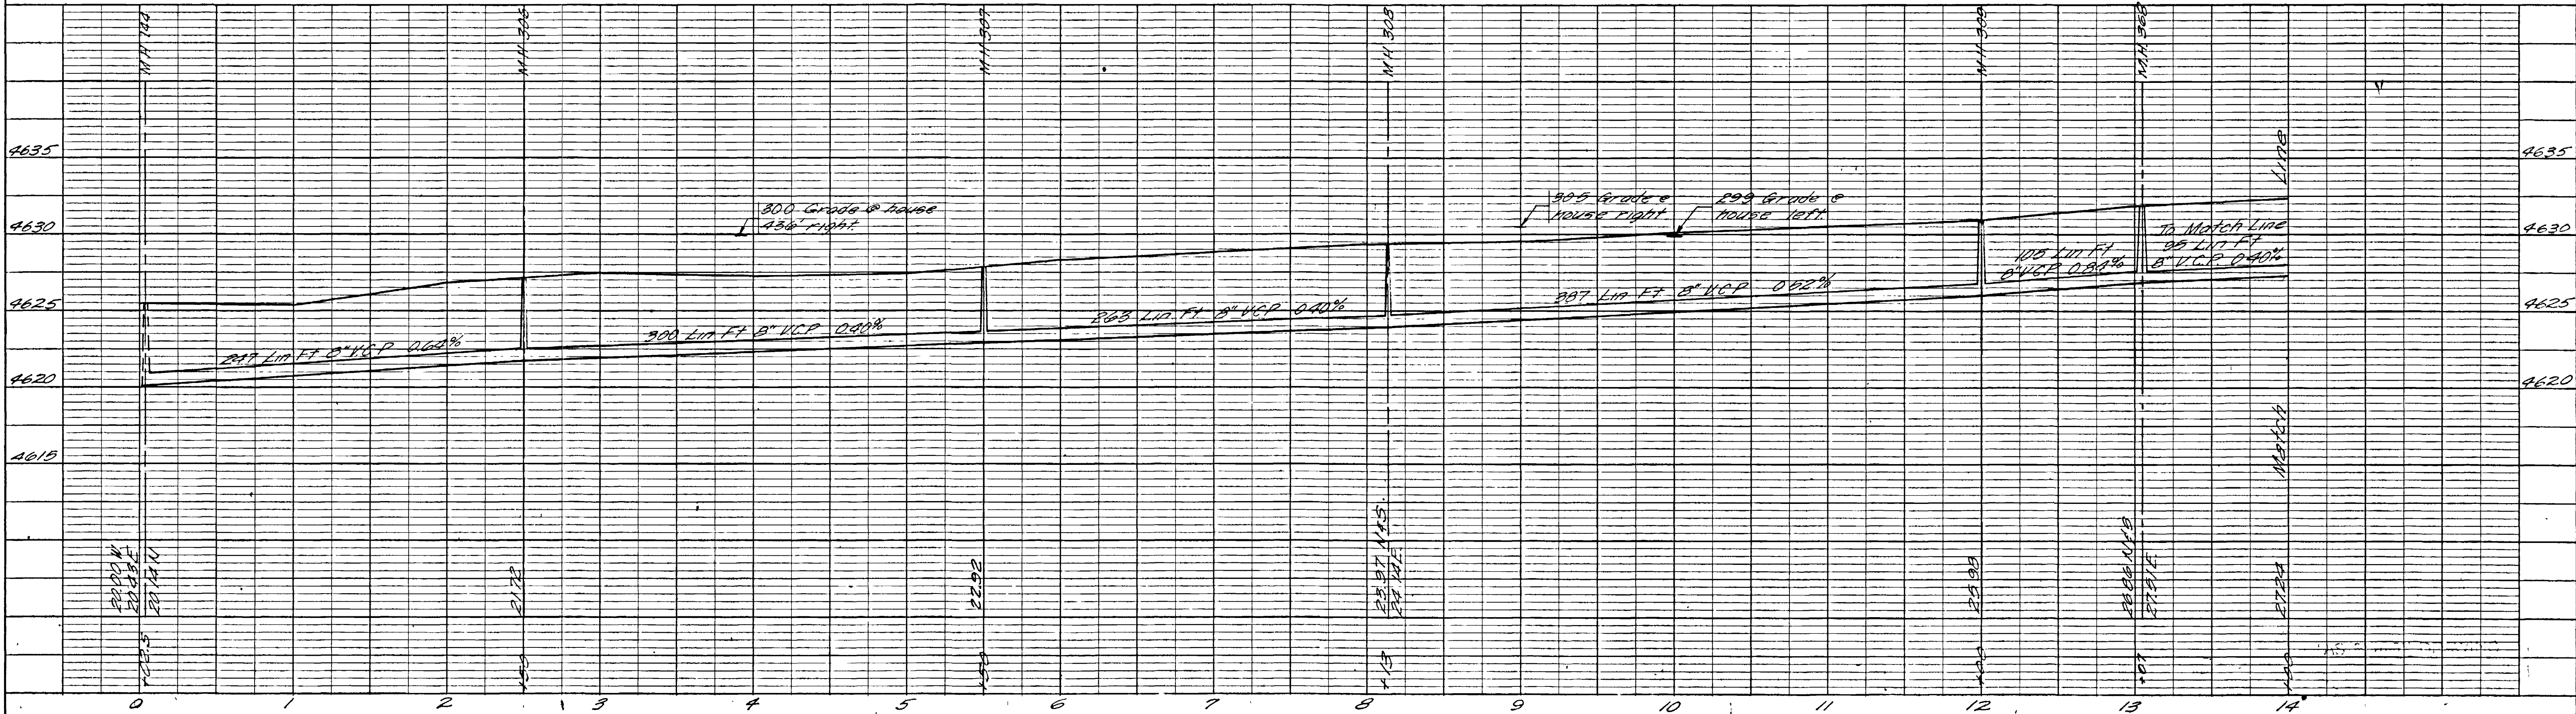
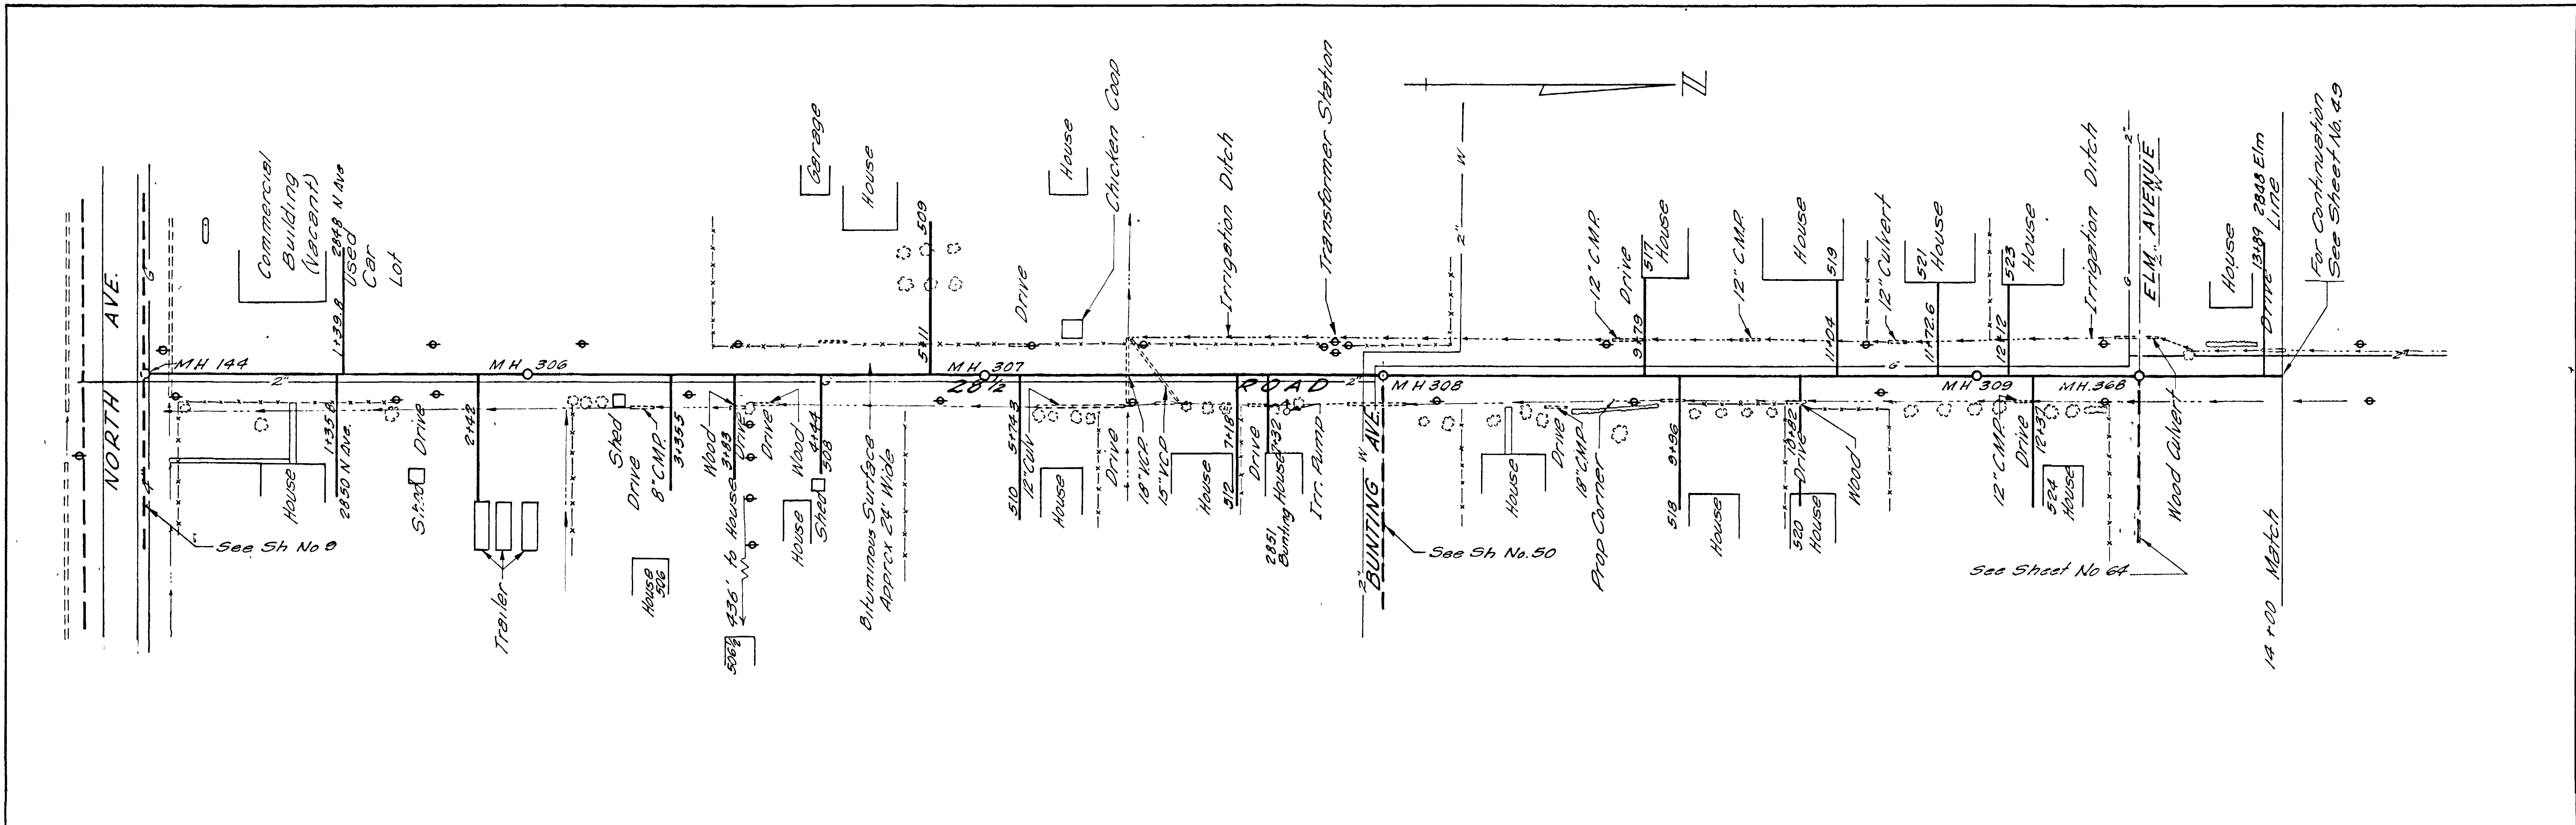


REVISIONS	DATE	DESCRIPTION	BY	DATE	DESCRIPTION	BY
1	Feb. 1960	Grade	P.C.T.			

DATE: October, 1957	DRAWN: D.V.R.	JOB NO: G-505
SCALE: 1" = 50'	CHECKED: R.C.T.	FILE NO:
	APPROVED: [Signature]	F B NO:



HAROLD HOSKINS & ASSOCIATES	FRUITVALE, COLORADO	28 1/2 ROAD NORTH OF NORTH AVENUE
ENGINEERING CONSULTANTS	WATER & SANITATION DISTRICT	STA. 0+00 TO STA. 14+00
GREELEY, COLORADO	LINCOLN, NEBRASKA	

66	SHEET NO.
48	SHEETS

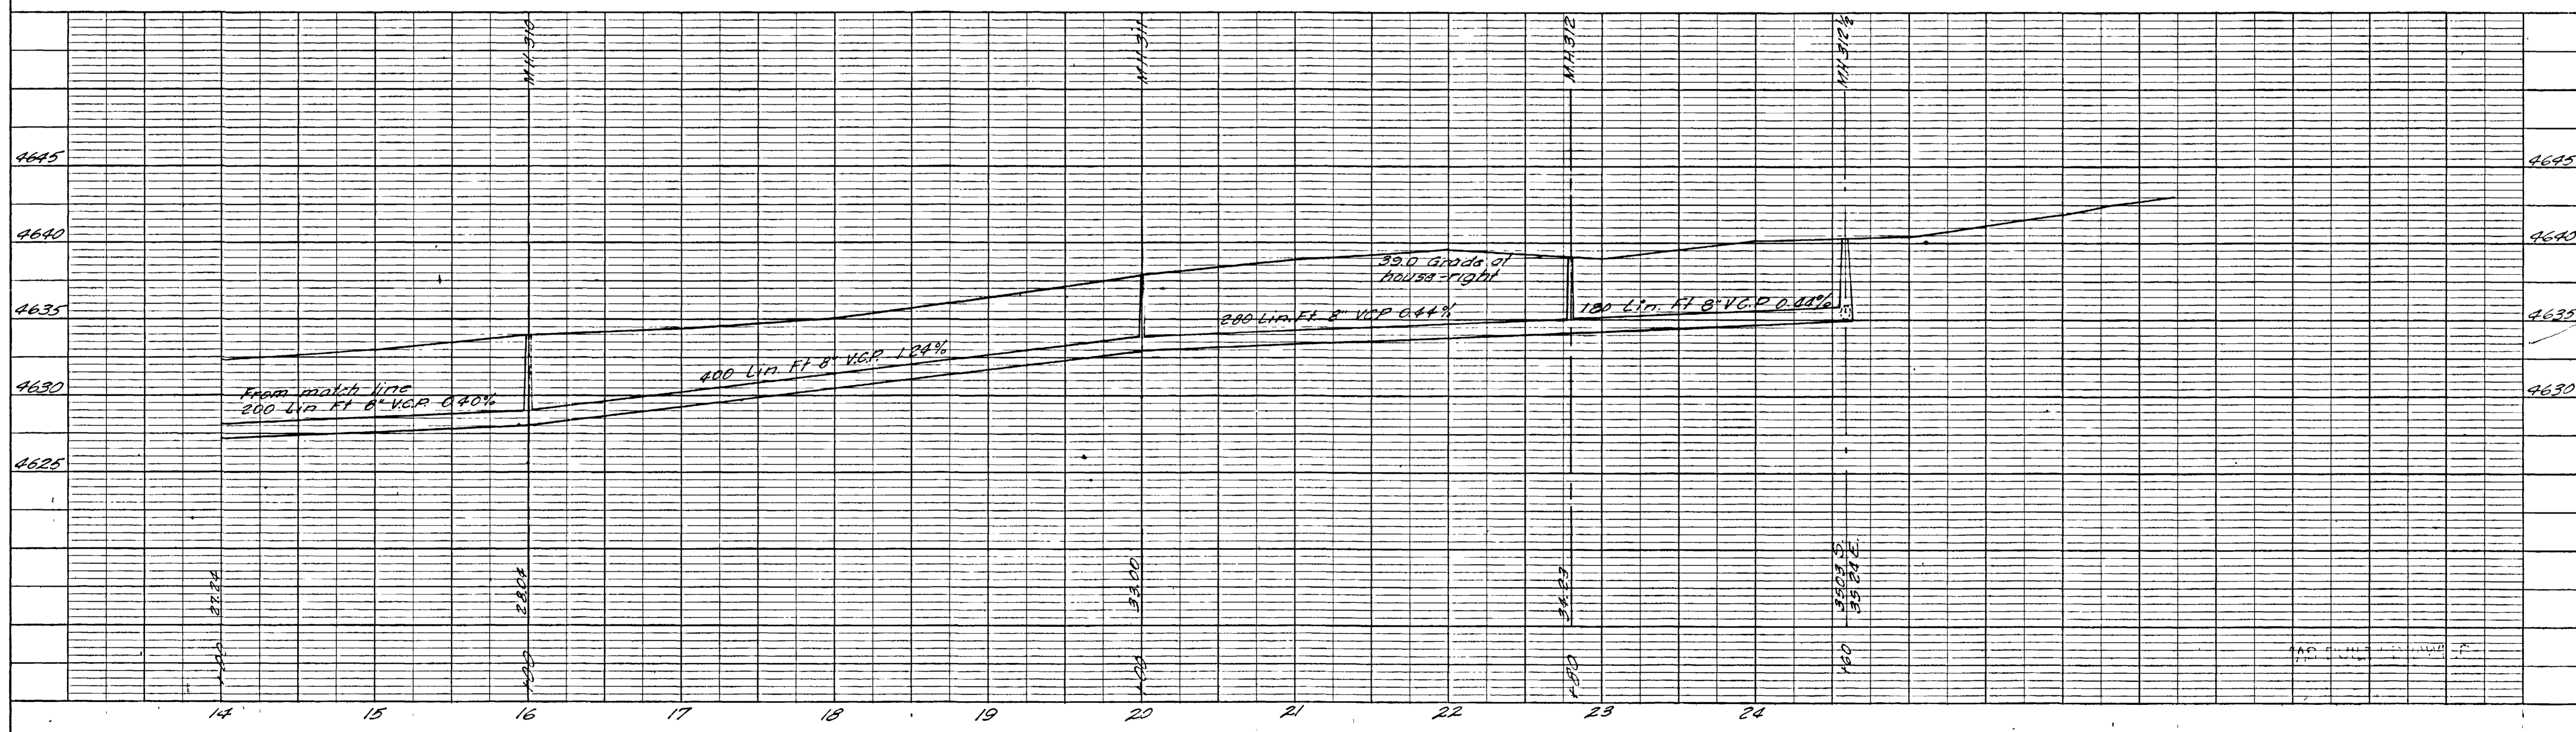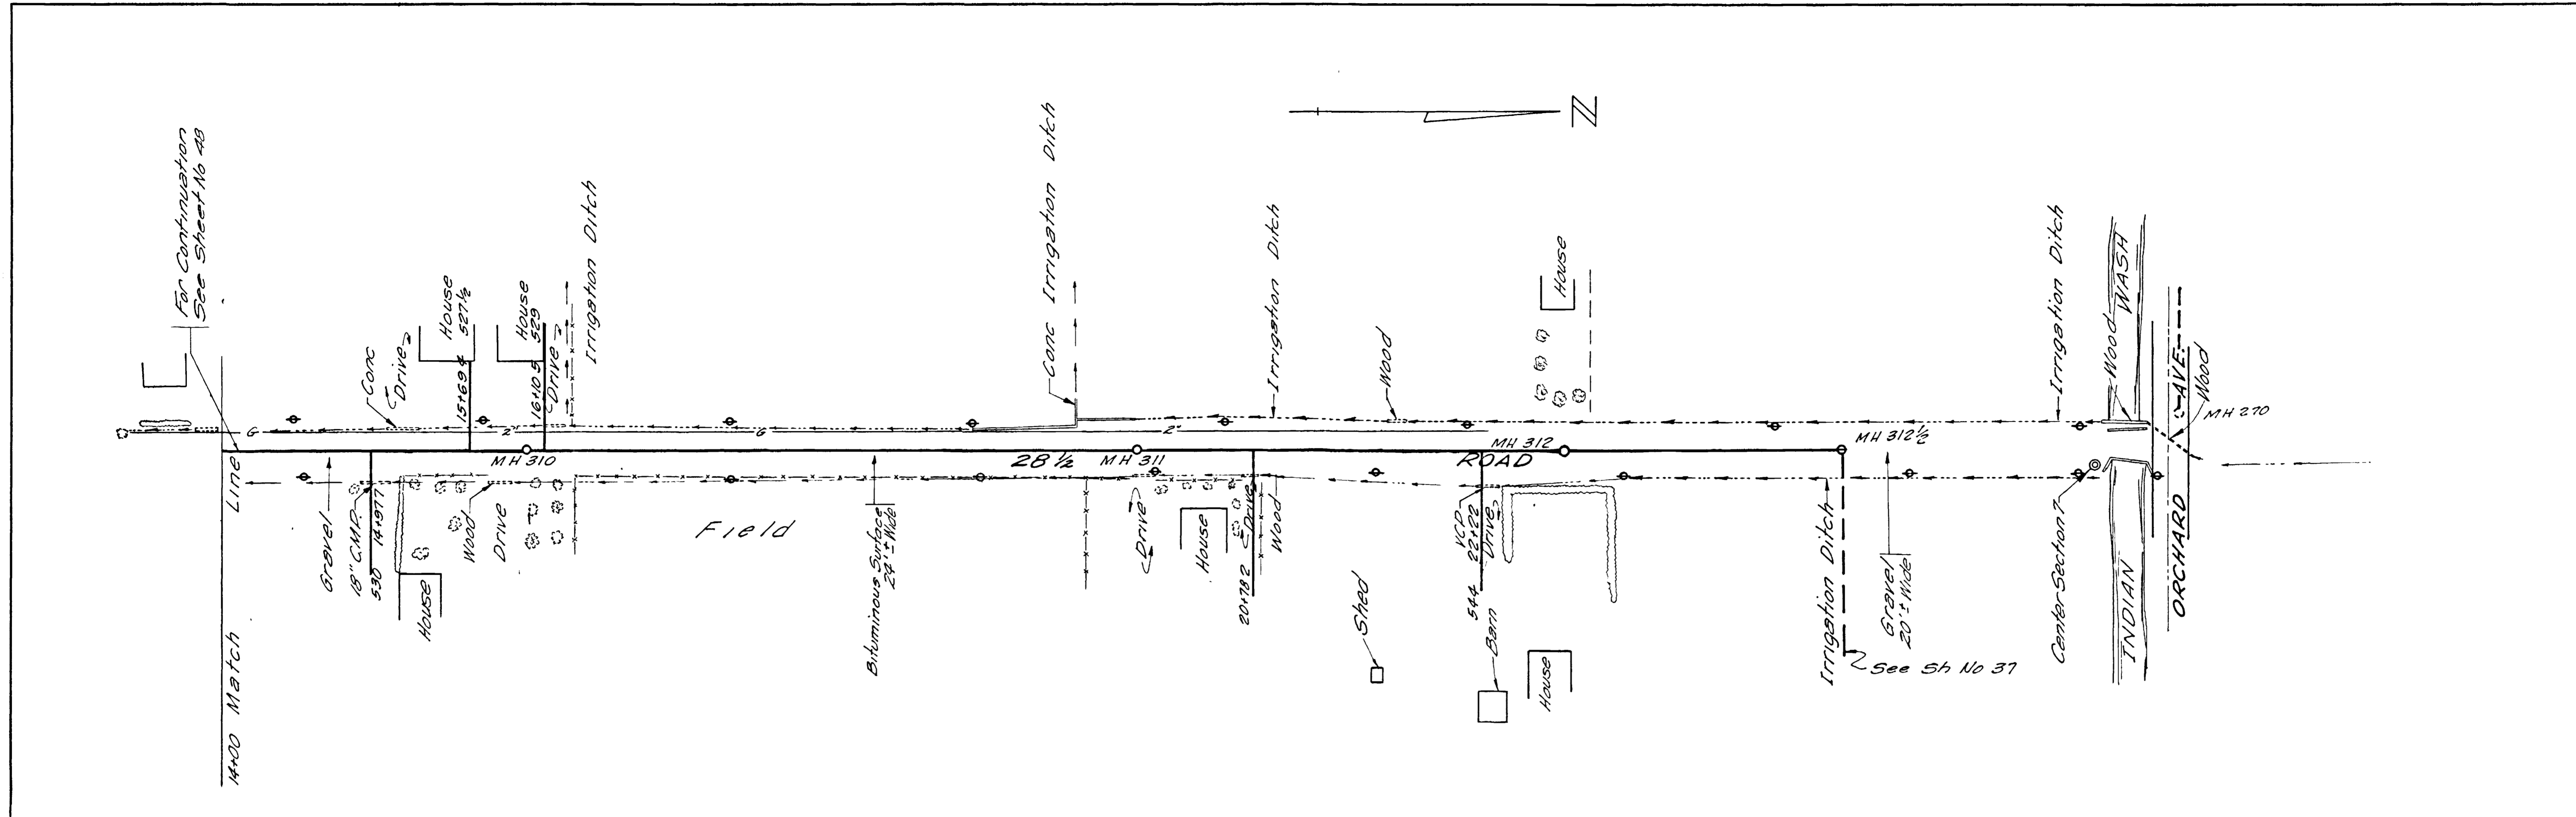

REVISIONS BY: P.C.T. DATE: Feb. 1960 DESCR: Grades BY: _____ DATE: _____ DESCR: _____		DATE: October 1957 SCALE: 1"=50'	DRAWN: D.V.R. CHECKED: P.C.T. APPROVED: [Signature]	JOB NO: G-205 FILE NO: F.B. NO.:	HAROLD HOSKINS & ASSOCIATES ENGINEERING CONSULTANTS GREELEY, COLORADO	FRUITVALE, COLORADO WATER & SANITATION DISTRICT	28 1/2 ROAD NORTH OF NORTH AVENUE STA. 14+00 TO STA. 22+80	66 SHEET NO. SHEETS: 49
---------------------------------------------------------------------------------------------	--	-------------------------------------	-----------------------------------------------------------	----------------------------------------	----------------------------------------------------------------------------------------	-----------------------------------------------------------	----------------------------------------------------------------------	----------------------------

02081750.tif

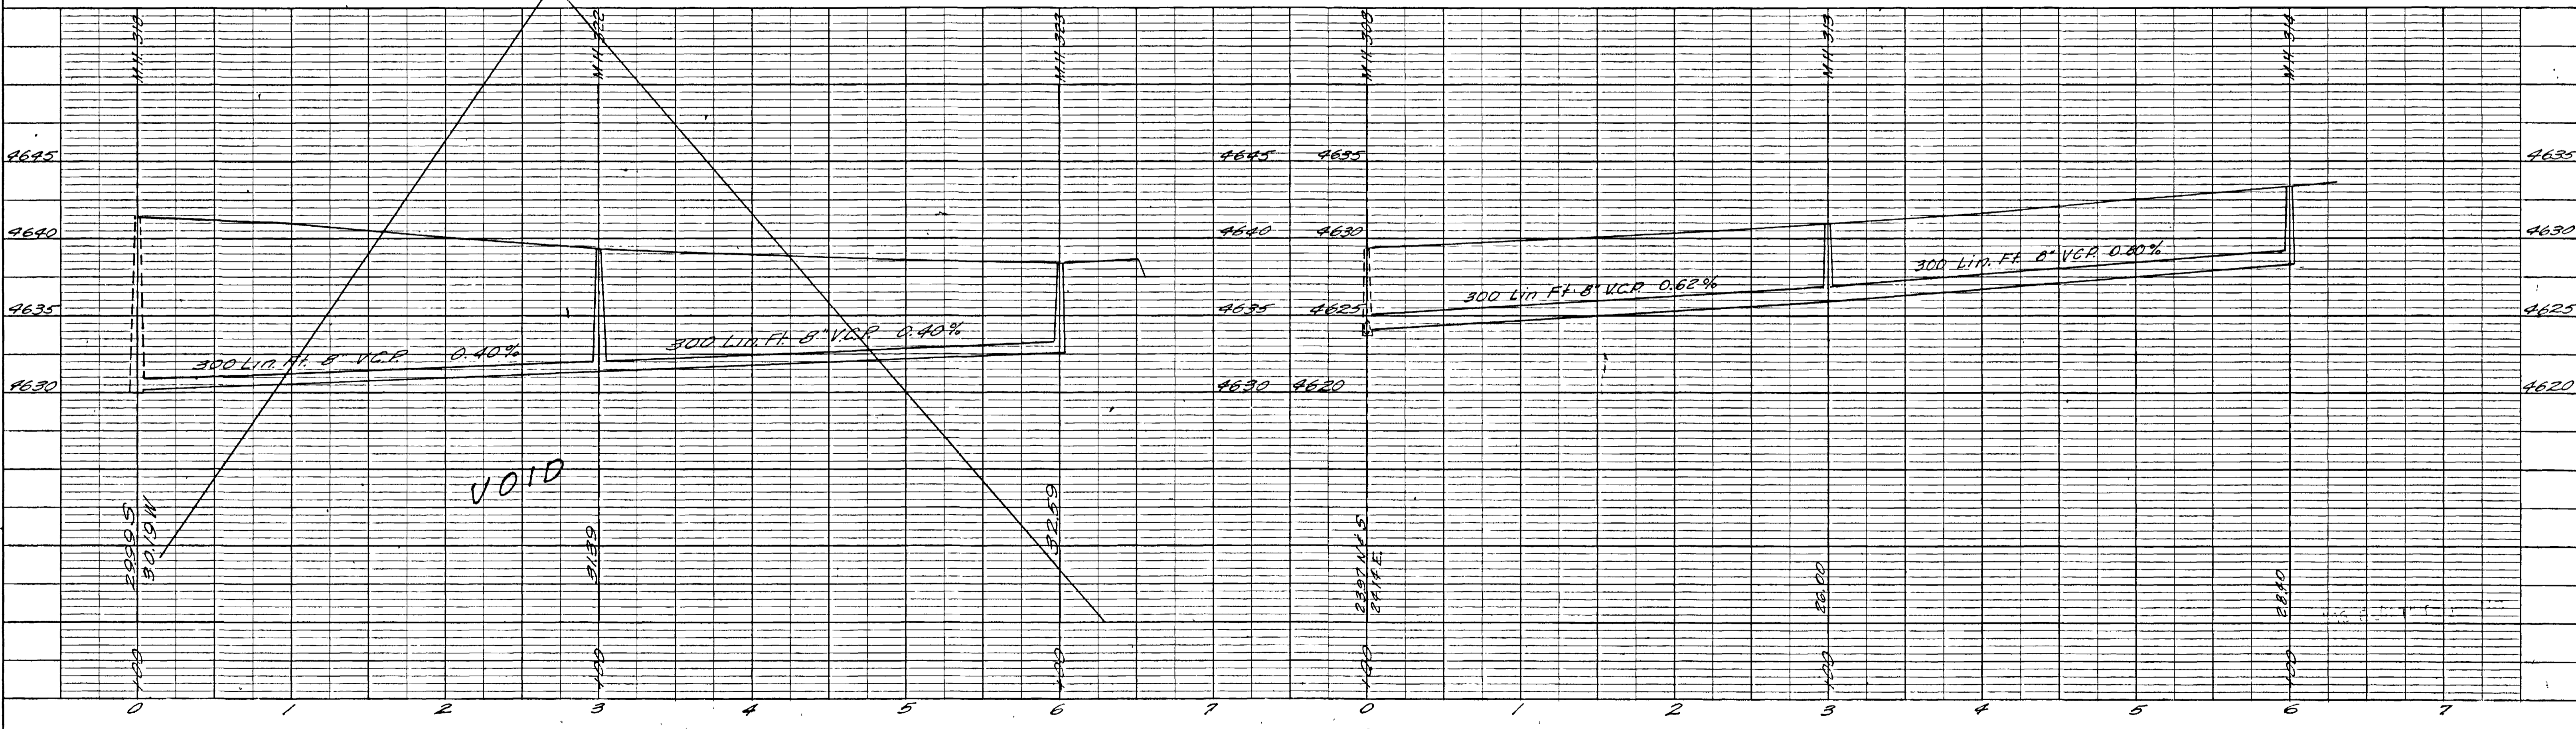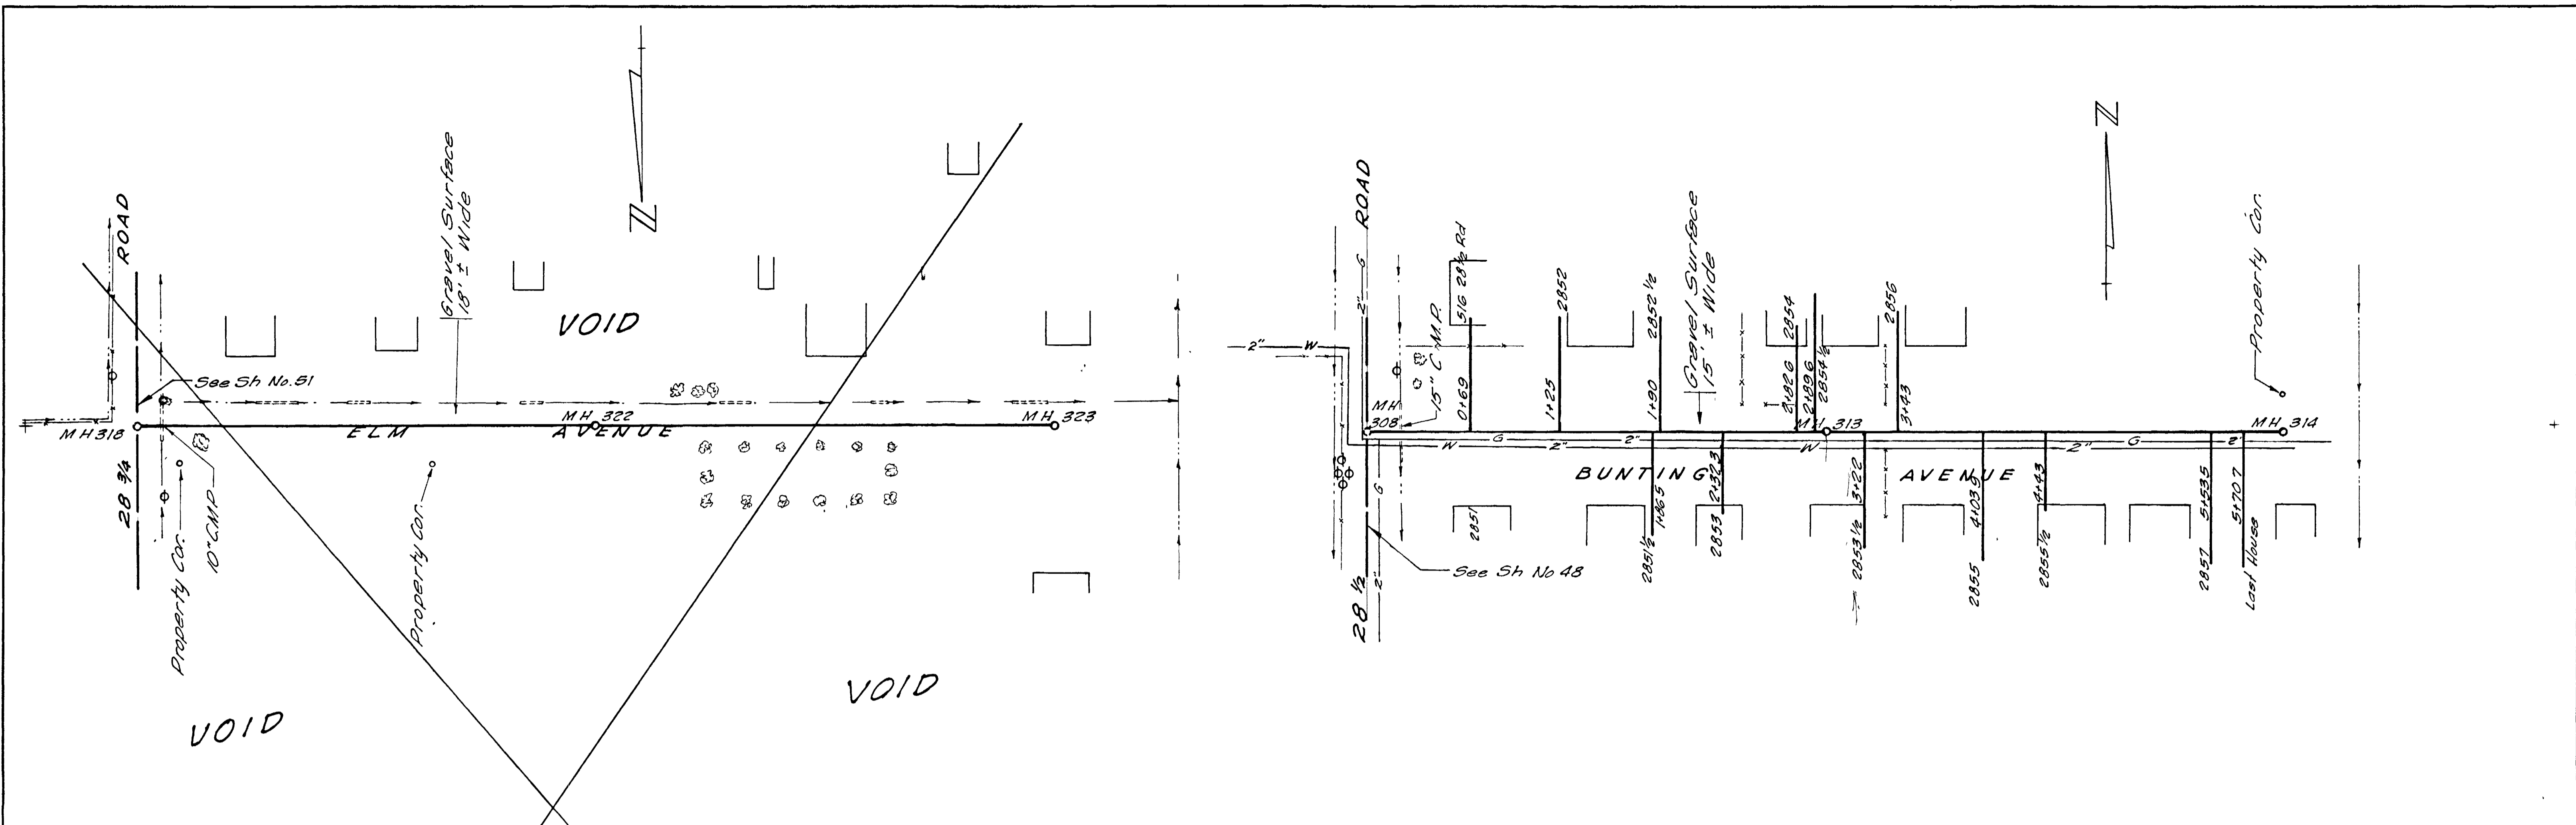

REVISIONS		DATE	DESCR	DATE	DESCR	DATE	DESCR	DATE	DESCR
BY	DATE	DATE	DESCR	DATE	DESCR	DATE	DESCR	DATE	DESCR


DATE October 1957 DRAWN D.V.R. JOB NO G-205
 CHECKED R.C.T. FILE NO _____
 APPROVED [Signature] I & B NO _____

HAROLD HOSKINS & ASSOCIATES
 ENGINEERING CONSULTANTS
 GREELEY, COLORADO LINCOLN, NEBRASKA

FRUITVALE, COLORADO
 WATER & SANITATION DISTRICT

BUNTING AVENUE WEST OF 28 1/2 ROAD

66 SHEET NO
 SKILLS 50

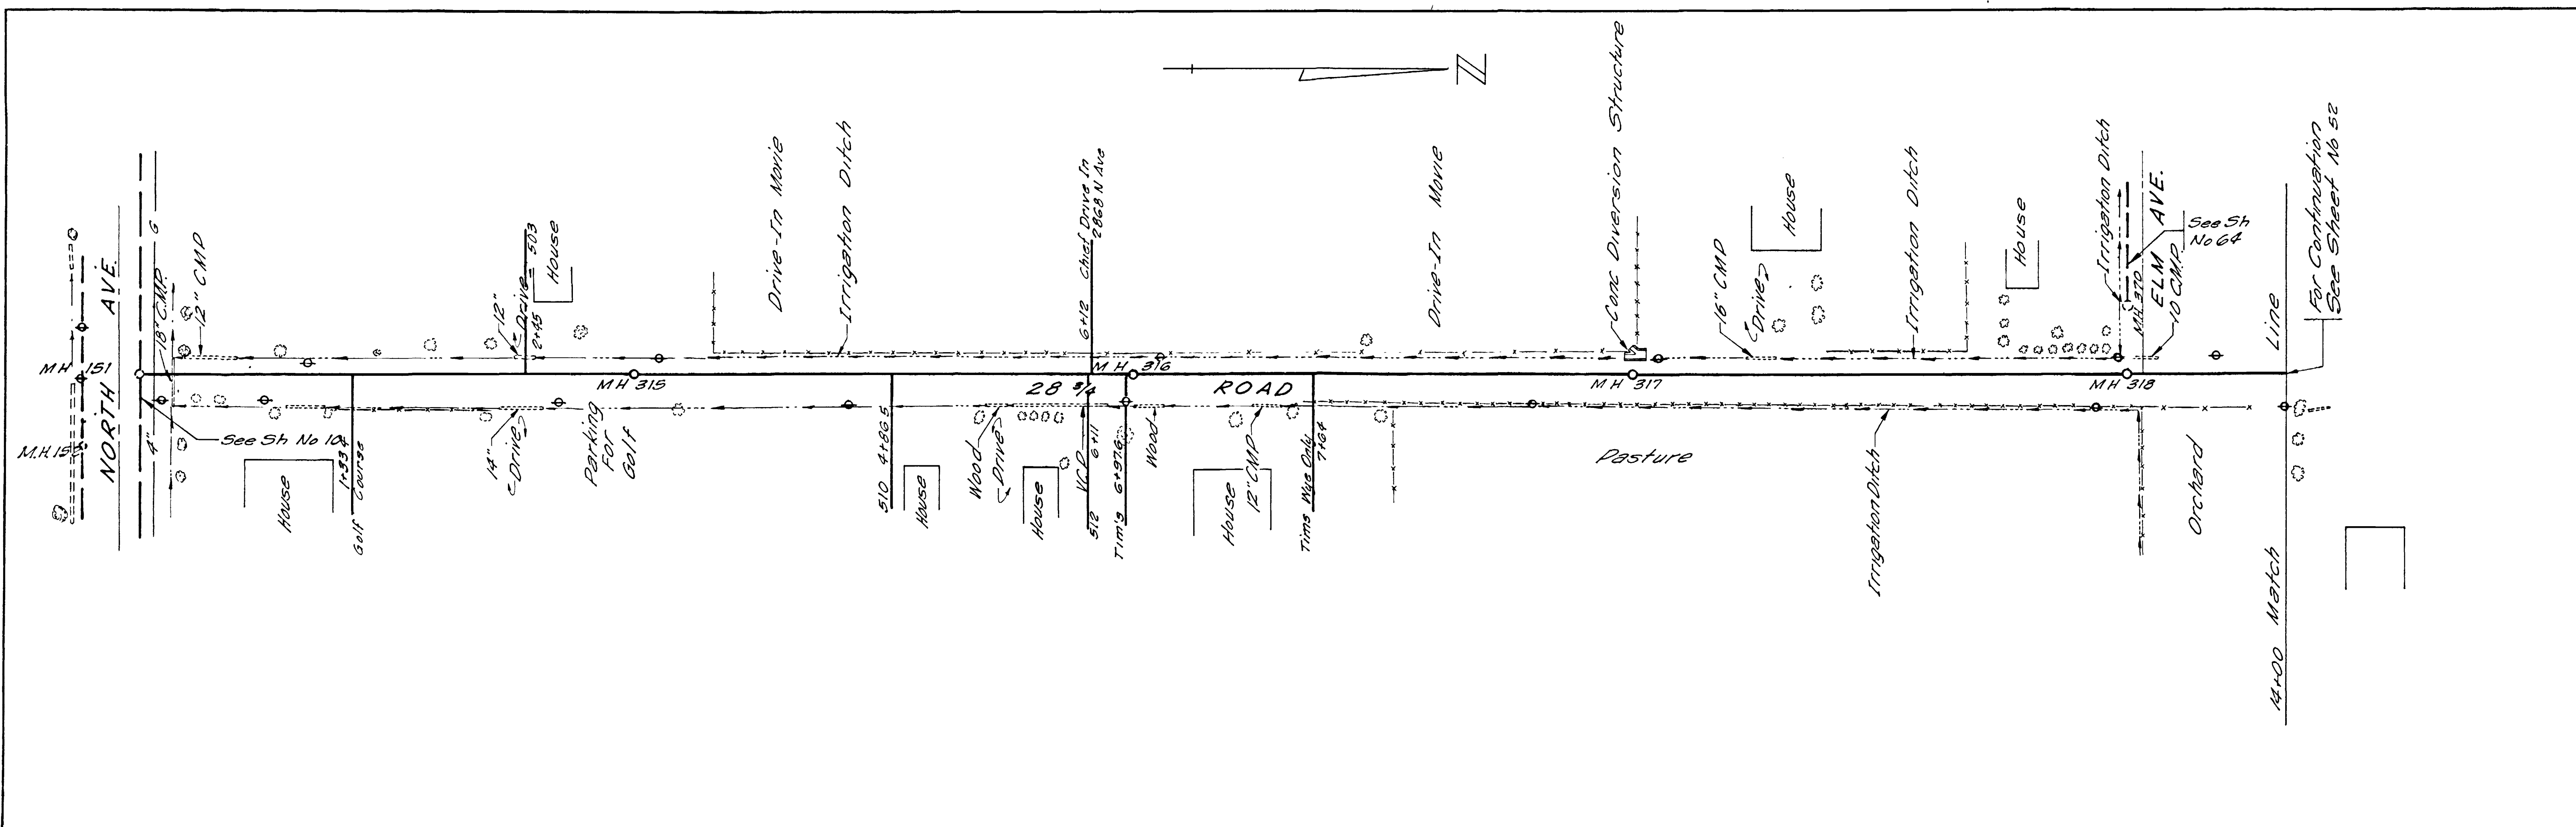

REVISIONS
 BY: RGT DATE: Feb 1960 DESCR: Grades
 BY: DATE: DESCR:
 BY: DATE: DESCR:



DATE: October 1957 DRAWN: D.V.R. JOB NO: G-205
 CHECKED: E.S.F. FILE NO:
 SCALE: 1"=50' APPROVED: M.L. [Signature] P. & NO:

HAROLD HOSKINS & ASSOCIATES
 ENGINEERING CONSULTANTS
 GREELEY, COLORADO LINCOLN, NEBRASKA



FRUITVALE, COLORADO
 WATER & SANITATION DISTRICT

28 3/4 ROAD STA. 0+00 TO STA. 14+00

66 SHEET NO
 51 SHEETS

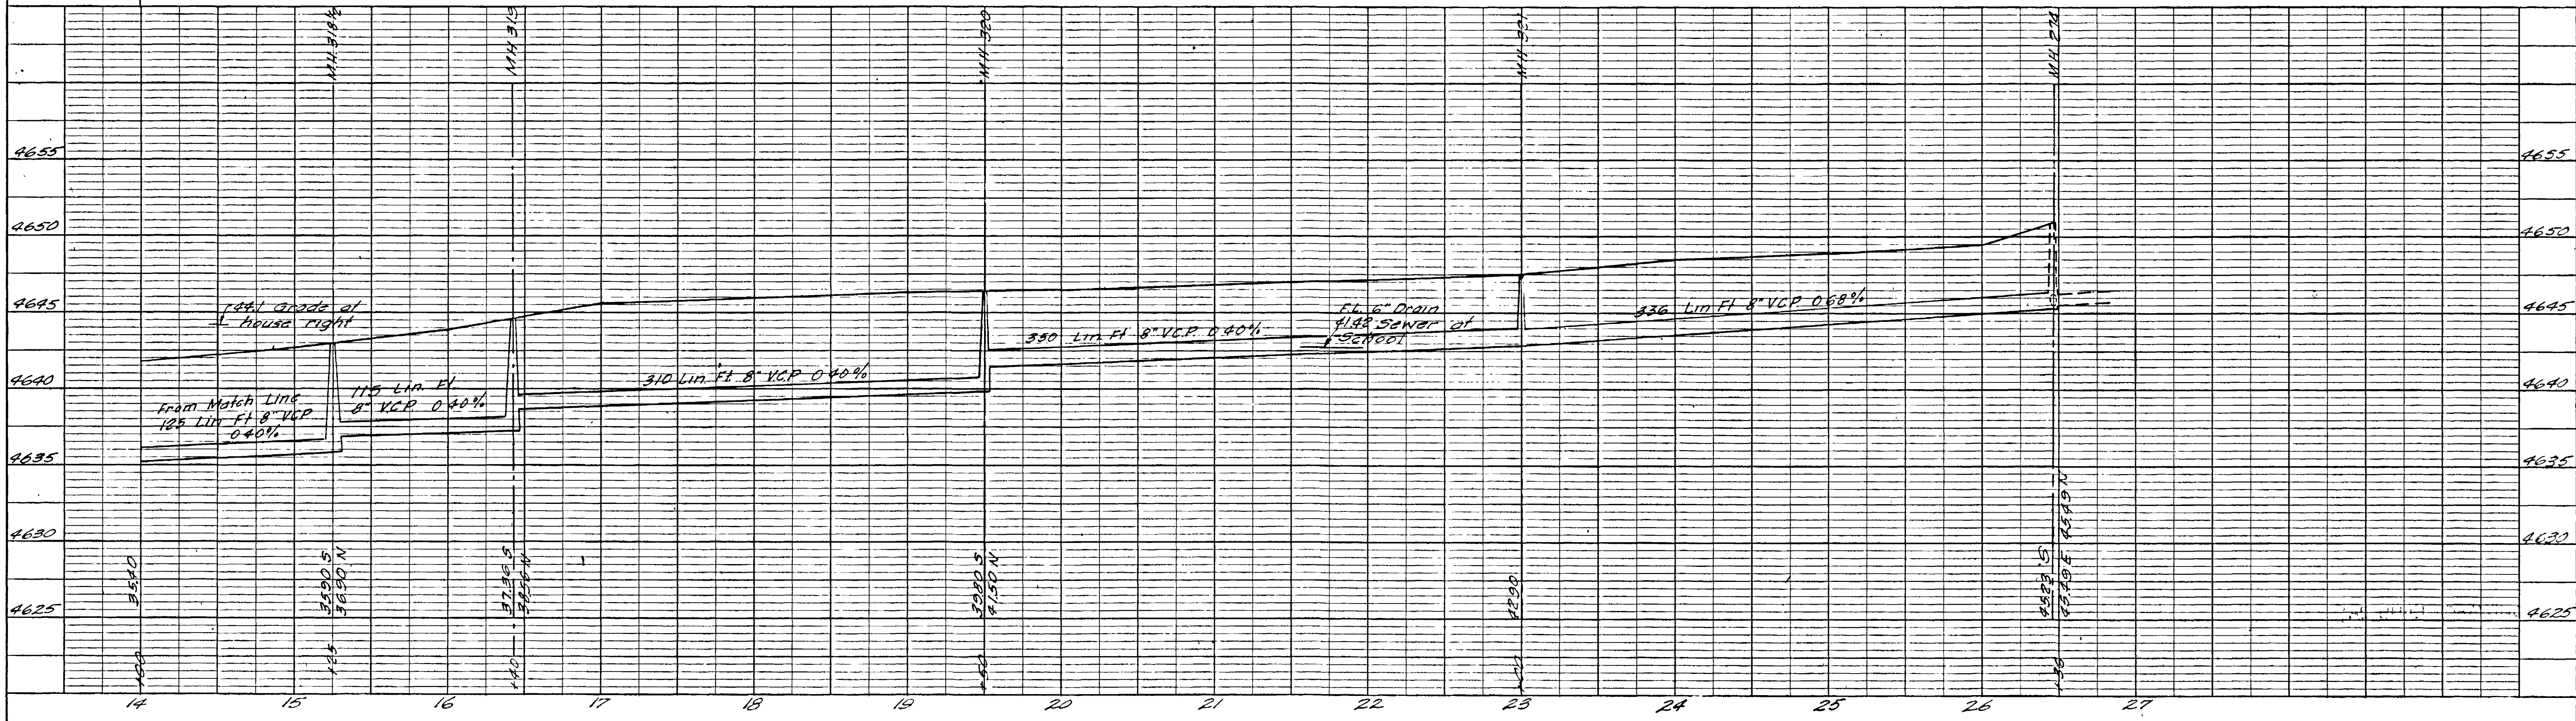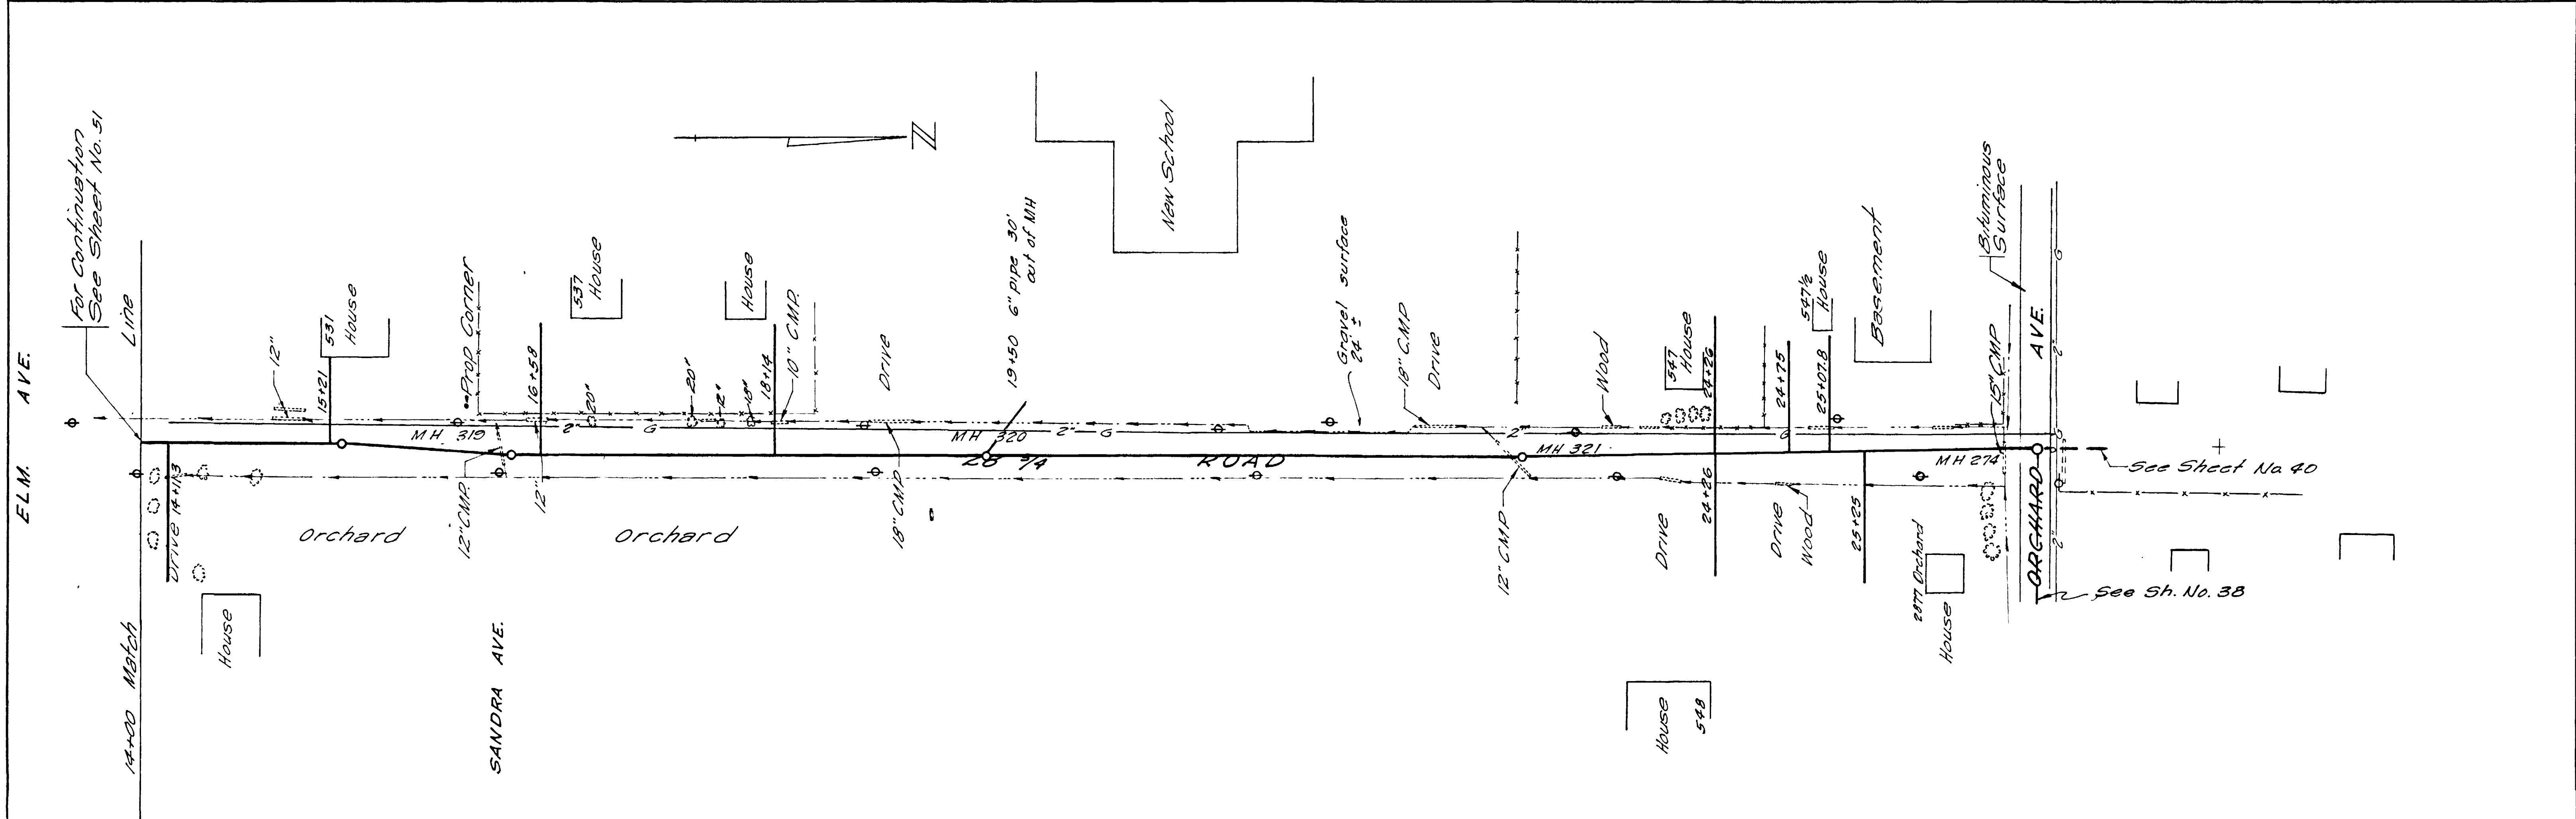


REVISIONS BY: P.C.T. DATE: 10/6/1960 DESCR: Change BY: DATE: DESCR:		DATE: October 1952 DRAWN: D.V.R. CHECKED: P.C.T. SCALE: 1"=30'		JOB NO. G-205 FILE NO. F.B. NO.		HAROLD HOSKINS & ASSOCIATES ENGINEERING CONSULTANTS GREELEY, COLORADO LINCOLN, NEBRASKA		FRUITVALE, COLORADO WATER & SANITATION DISTRICT		28 3/4 ROAD STA. 14+00 TO STA. 26+46 SHEET NO. 66 SHEET 52	
---------------------------------------------------------------------------	--	----------------------------------------------------------------------	--	---------------------------------------	--	----------------------------------------------------------------------------------------------------------	--	-----------------------------------------------------------	--	---------------------------------------------------------------	--

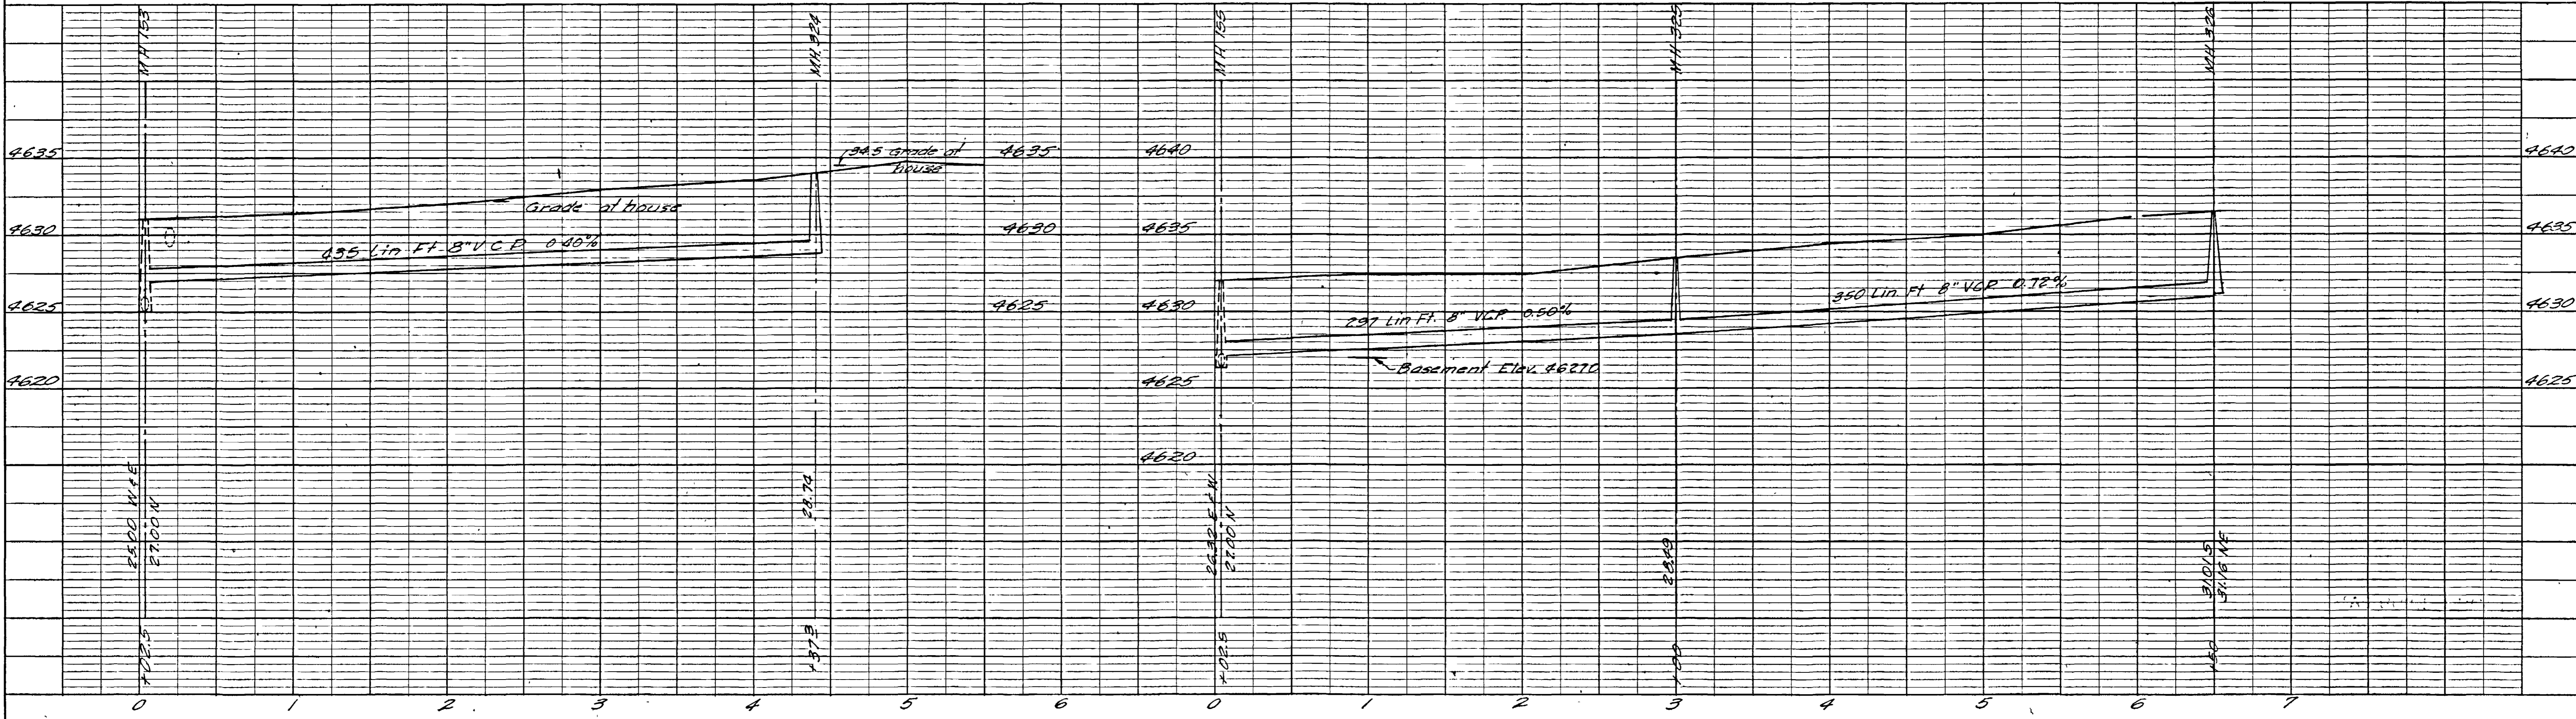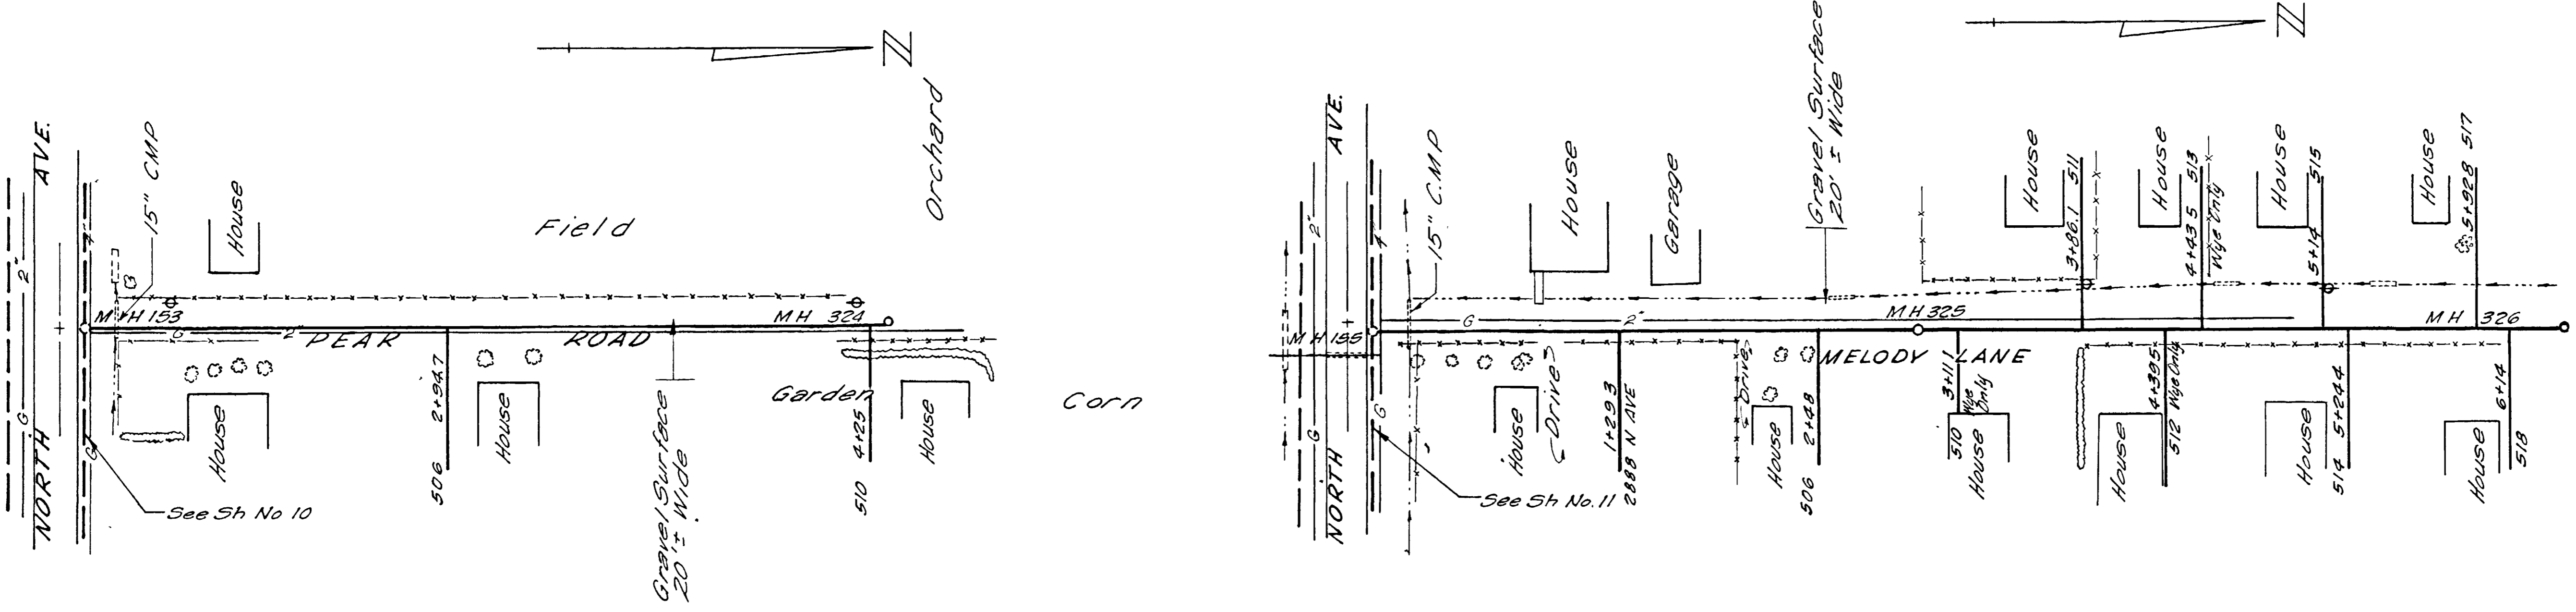


REVISIONS BY RCT DATE Feb 1960 DESCR Grades BY DATE DESCR		DATE October 1957 SCALE 1" = 50'	DRAWN D.W.R. CHECKED R.C.T. APPROVED [Signature]	JOB NO. G-205 FILE NO. F.B. NO.	HAROLD HOSKINS & ASSOCIATES ENGINEERING CONSULTANTS GREELEY, COLORADO	FRUITVALE, COLORADO WATER & SANITATION DISTRICT	PEAR ROAD MELODY LANE	SHEET NO. 66 SHEETS 53
-----------------------------------------------------------------	--	-------------------------------------	--------------------------------------------------------	---------------------------------------	-----------------------------------------------------------------------------	----------------------------------------------------	--------------------------	---------------------------



02081754.tif

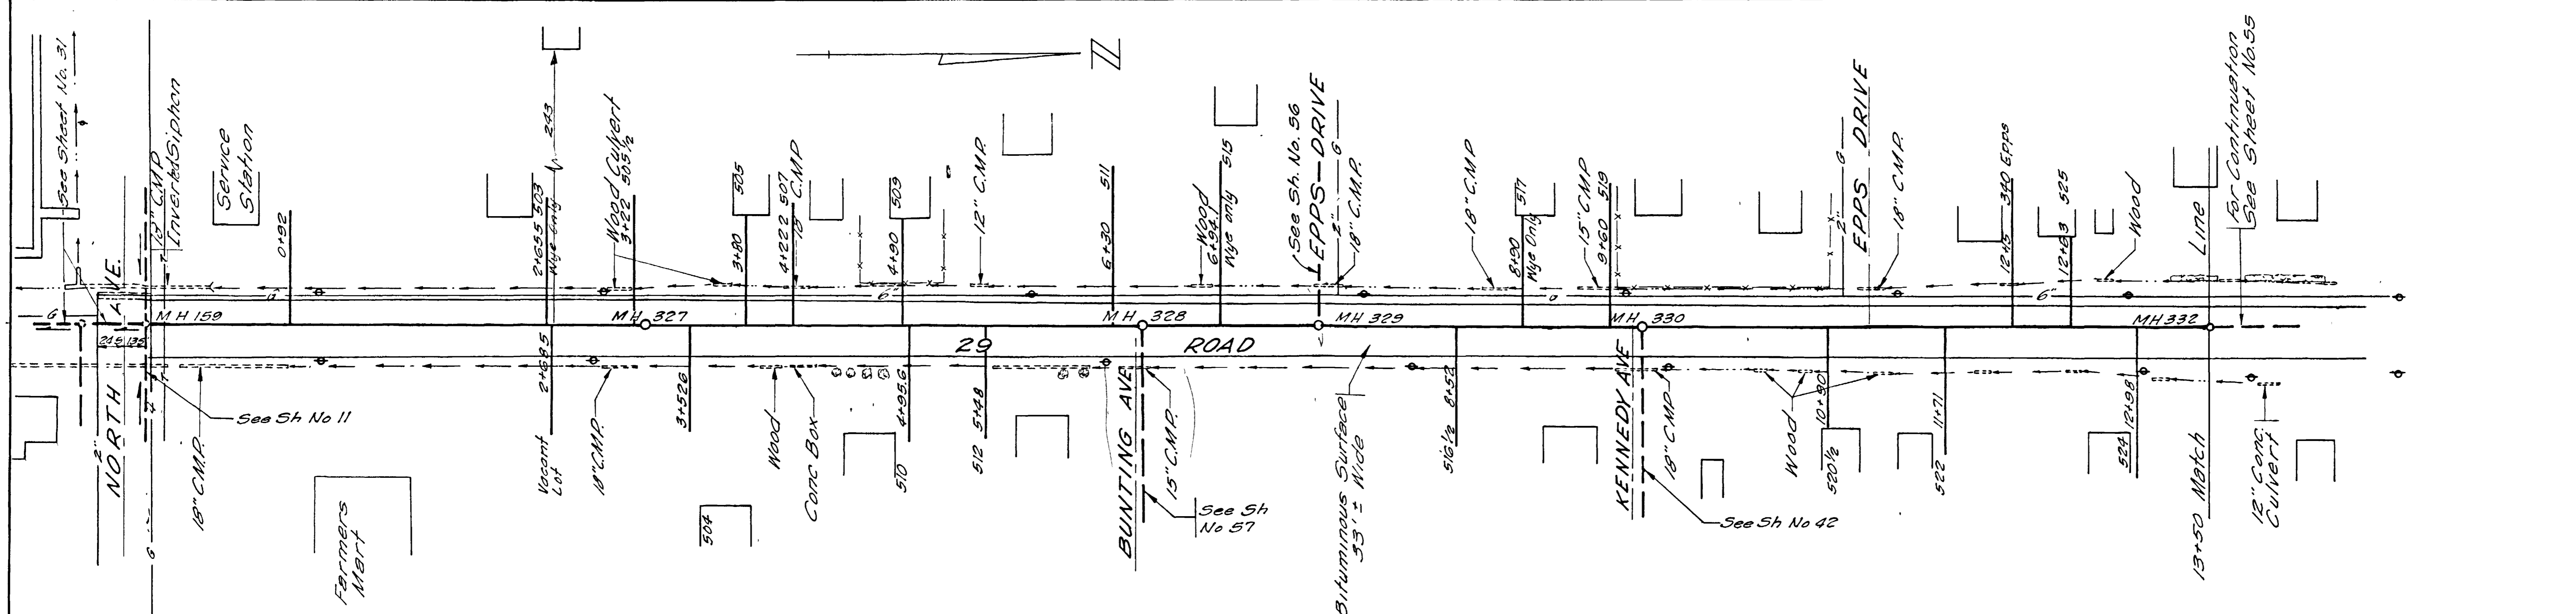

NOTE:
 Special Backfill
 (6'-7') Trench Depth - 528 Lin. Ft.
 (7'-8') Trench Depth - 220 Lin. Ft.

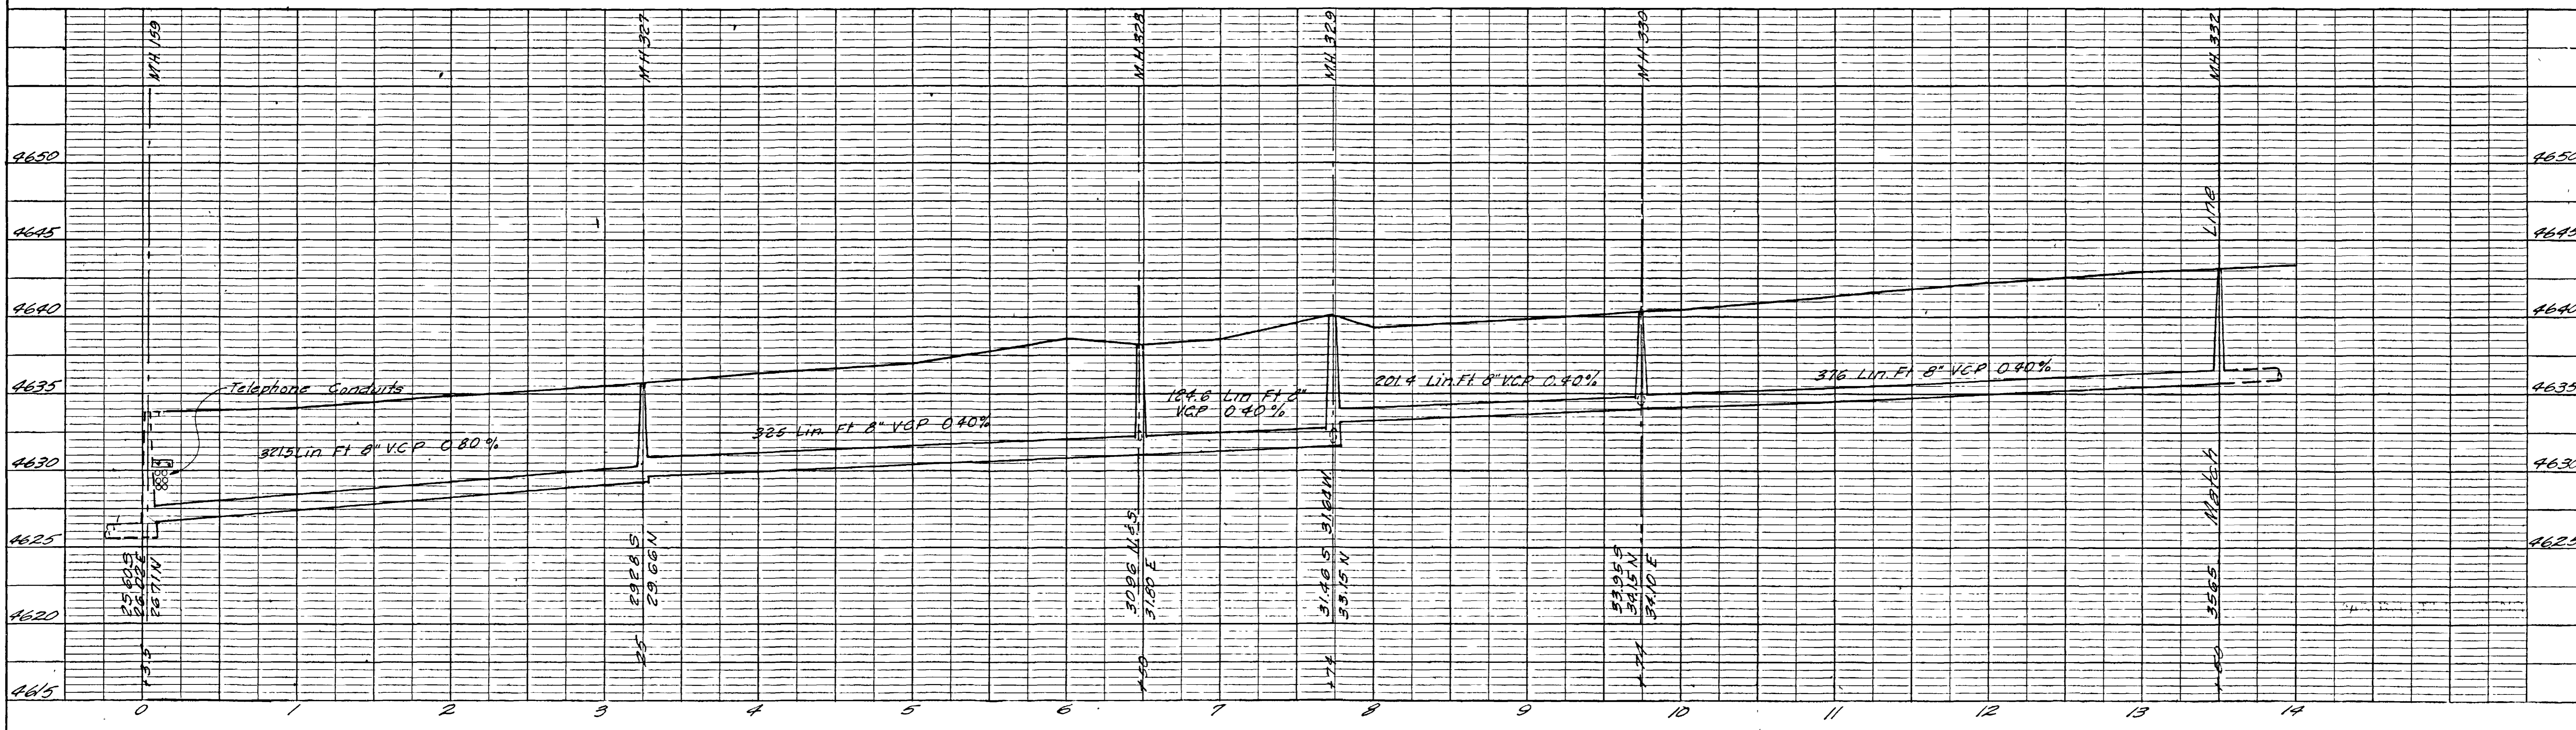


REVISIONS BY: RCT DATE: Feb 1962 DESCR: Reader BY: DATE: DESCR:		DATE: October 1957 SCALE: 1" = 30'	DRAWN: D.V.R. CHECKED: R.C.T. APPROVED: [Signature]	JOB NO: G-205 FILE NO: F B NO:	HAROLD HOSKINS & ASSOCIATES ENGINEERING CONSULTANTS GREELEY, COLORADO	FRUITVALE, COLORADO WATER & SANITATION DISTRICT LINCOLN, NEBRASKA	29. ROAD NORTH OF NORTH AVENUE	66 SHEET NO SHEETS 54
-----------------------------------------------------------------------	--	---------------------------------------	-----------------------------------------------------------	--------------------------------------	----------------------------------------------------------------------------------------	--------------------------------------------------------------------------------	---------------------------------------	--------------------------

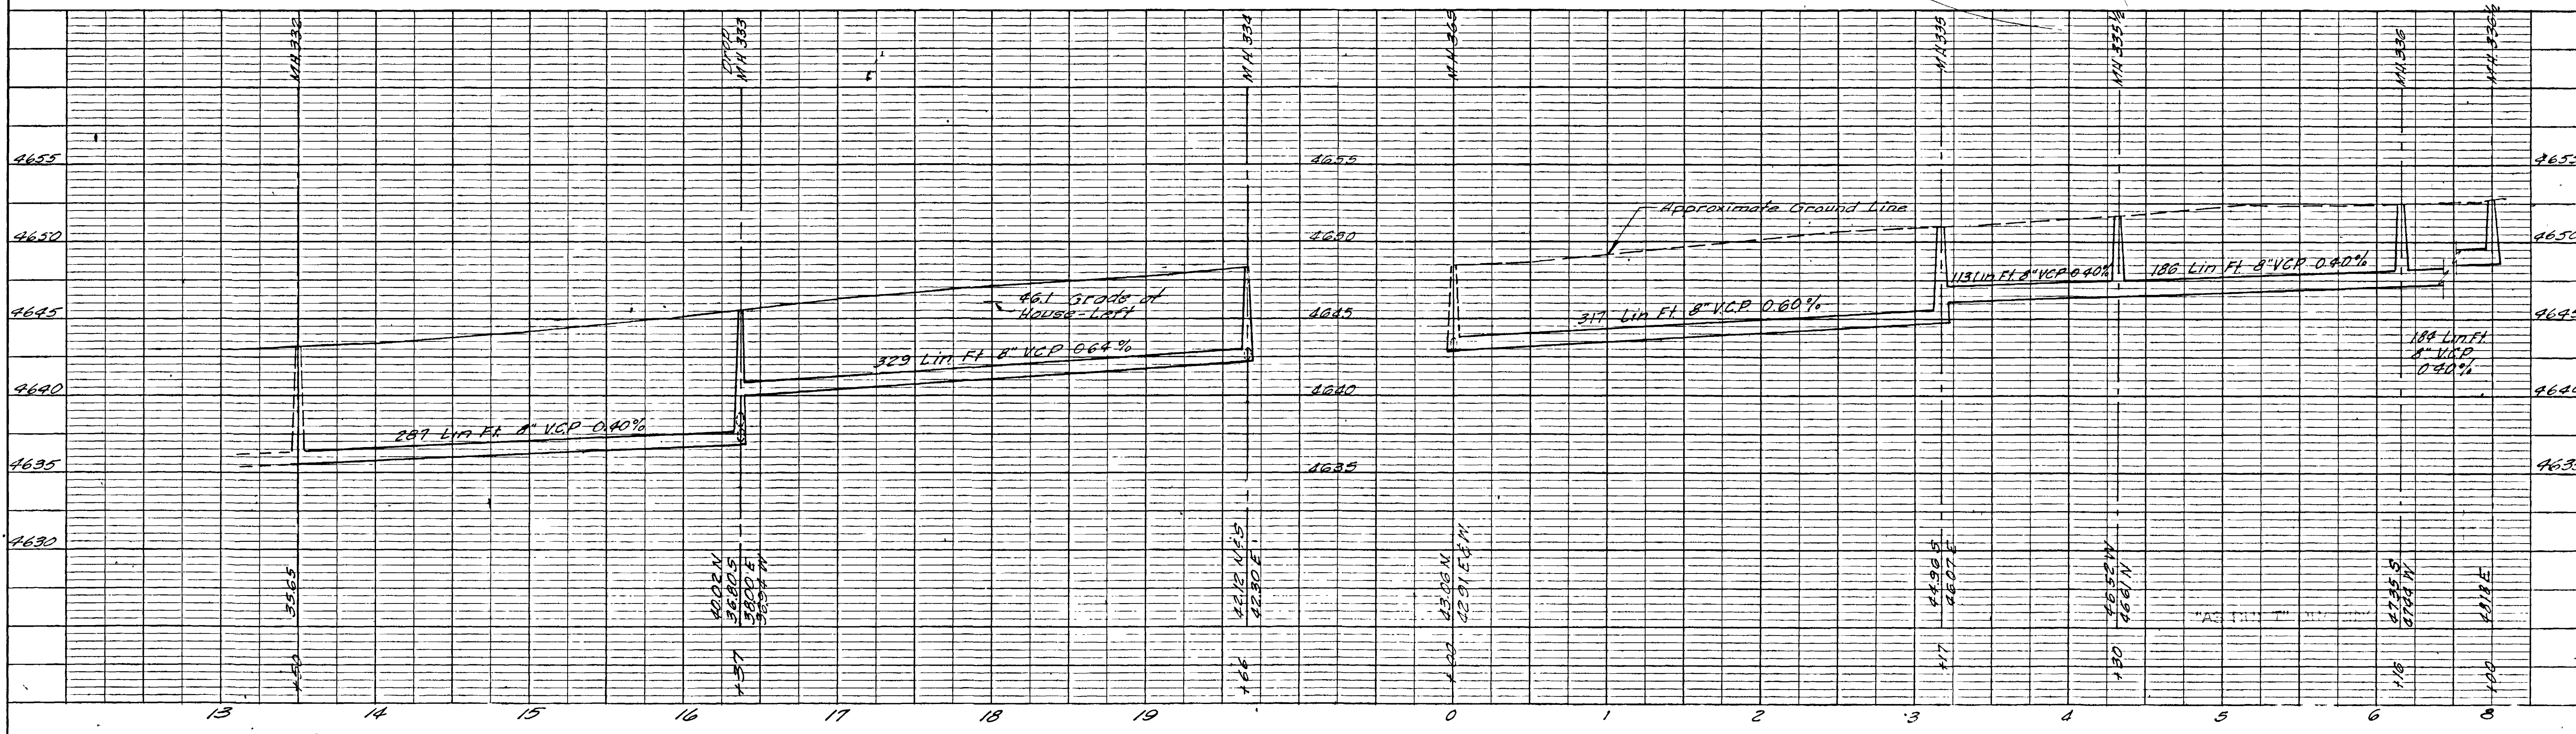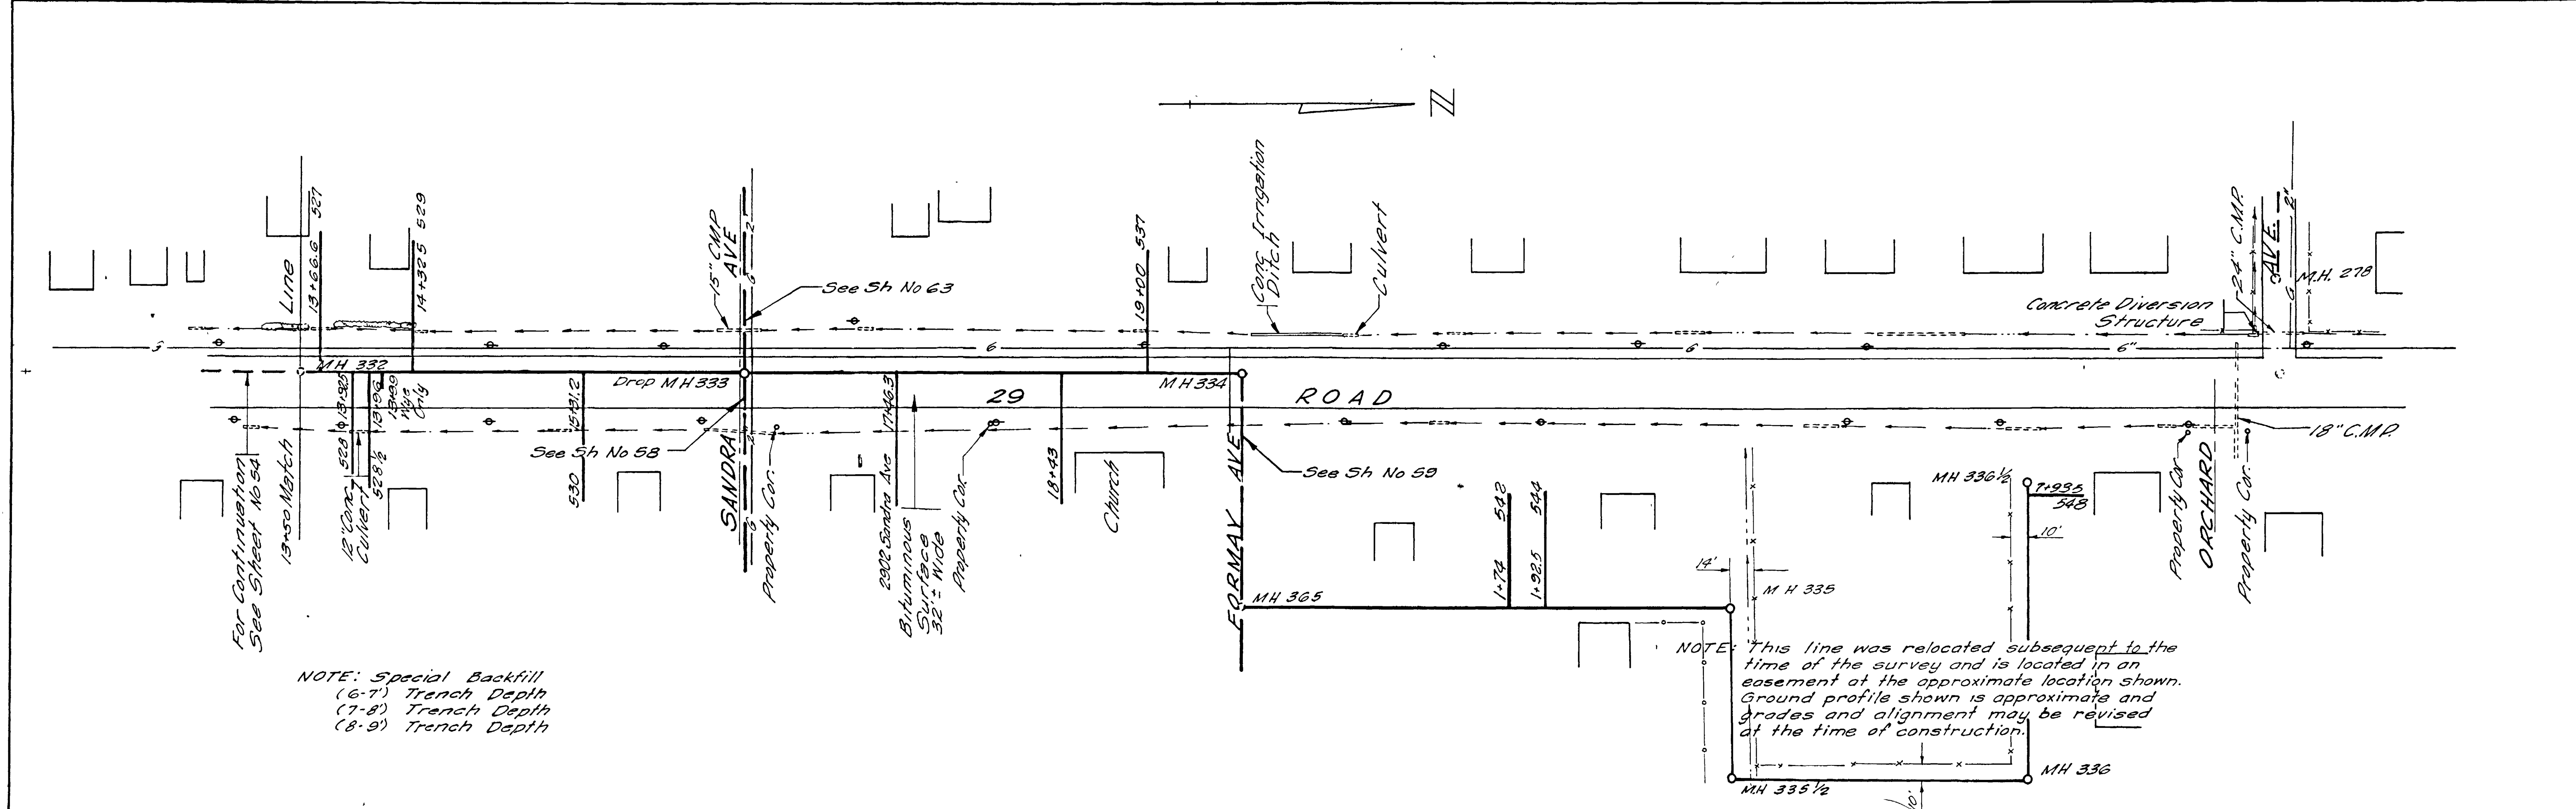



REVISIONS BY: RCT DATE: Feb 1962 DESCR: Grades BY: DATE: DSCR:		DATE: October 1962 DRAWN: DWR CHECKED: RCT SCALE: 1"=50' APPROVED: W. Hoskins		JOB NO: G-205 FILE NO: F. B. NO:		HAROLD HOSKINS & ASSOCIATES ENGINEERING CONSULTANTS GREELEY, COLORADO LINCOLN, NEBRASKA		FRUITVALE, COLORADO WATER & SANITATION DISTRICT		29 ROAD STA. 13+50 TO STA. 26+45		66 SHEETS	SHEET NO 55
----------------------------------------------------------------------	--	-------------------------------------------------------------------------------------	--	----------------------------------------	--	-----------------------------------------------------------------------------------------------	--	----------------------------------------------------	--	-------------------------------------	--	--------------	----------------

02081756.tif

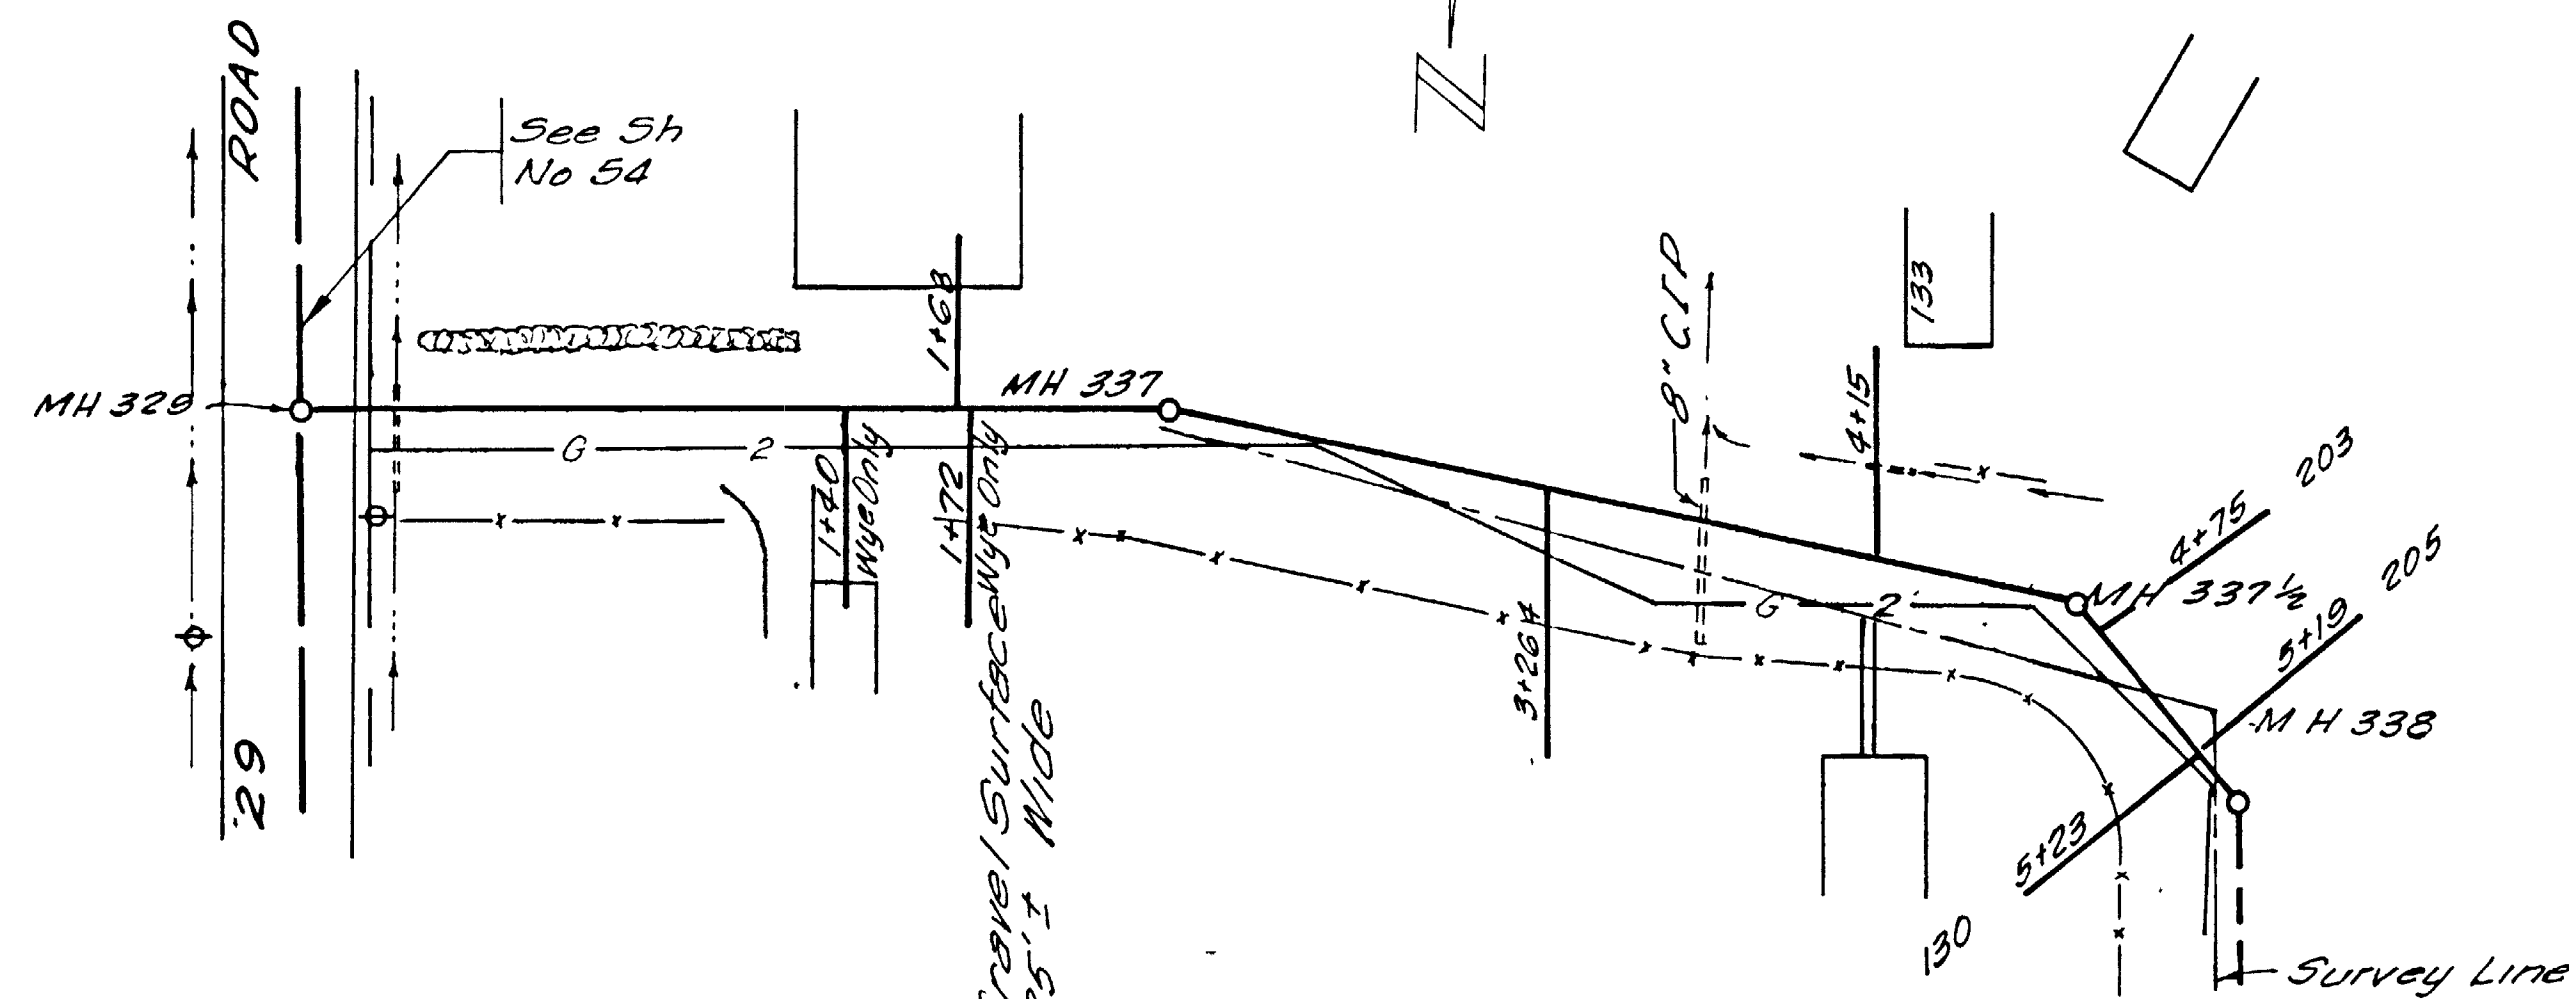


NOTE: Line from MH 337 1/2 to MH 326 was added subsequent to the time of the survey and will be located in an assessment at the approximate location shown. Ground profile shown is approximate and grades may be revised at the time of construction.



For Continuation See Adjacent Plan

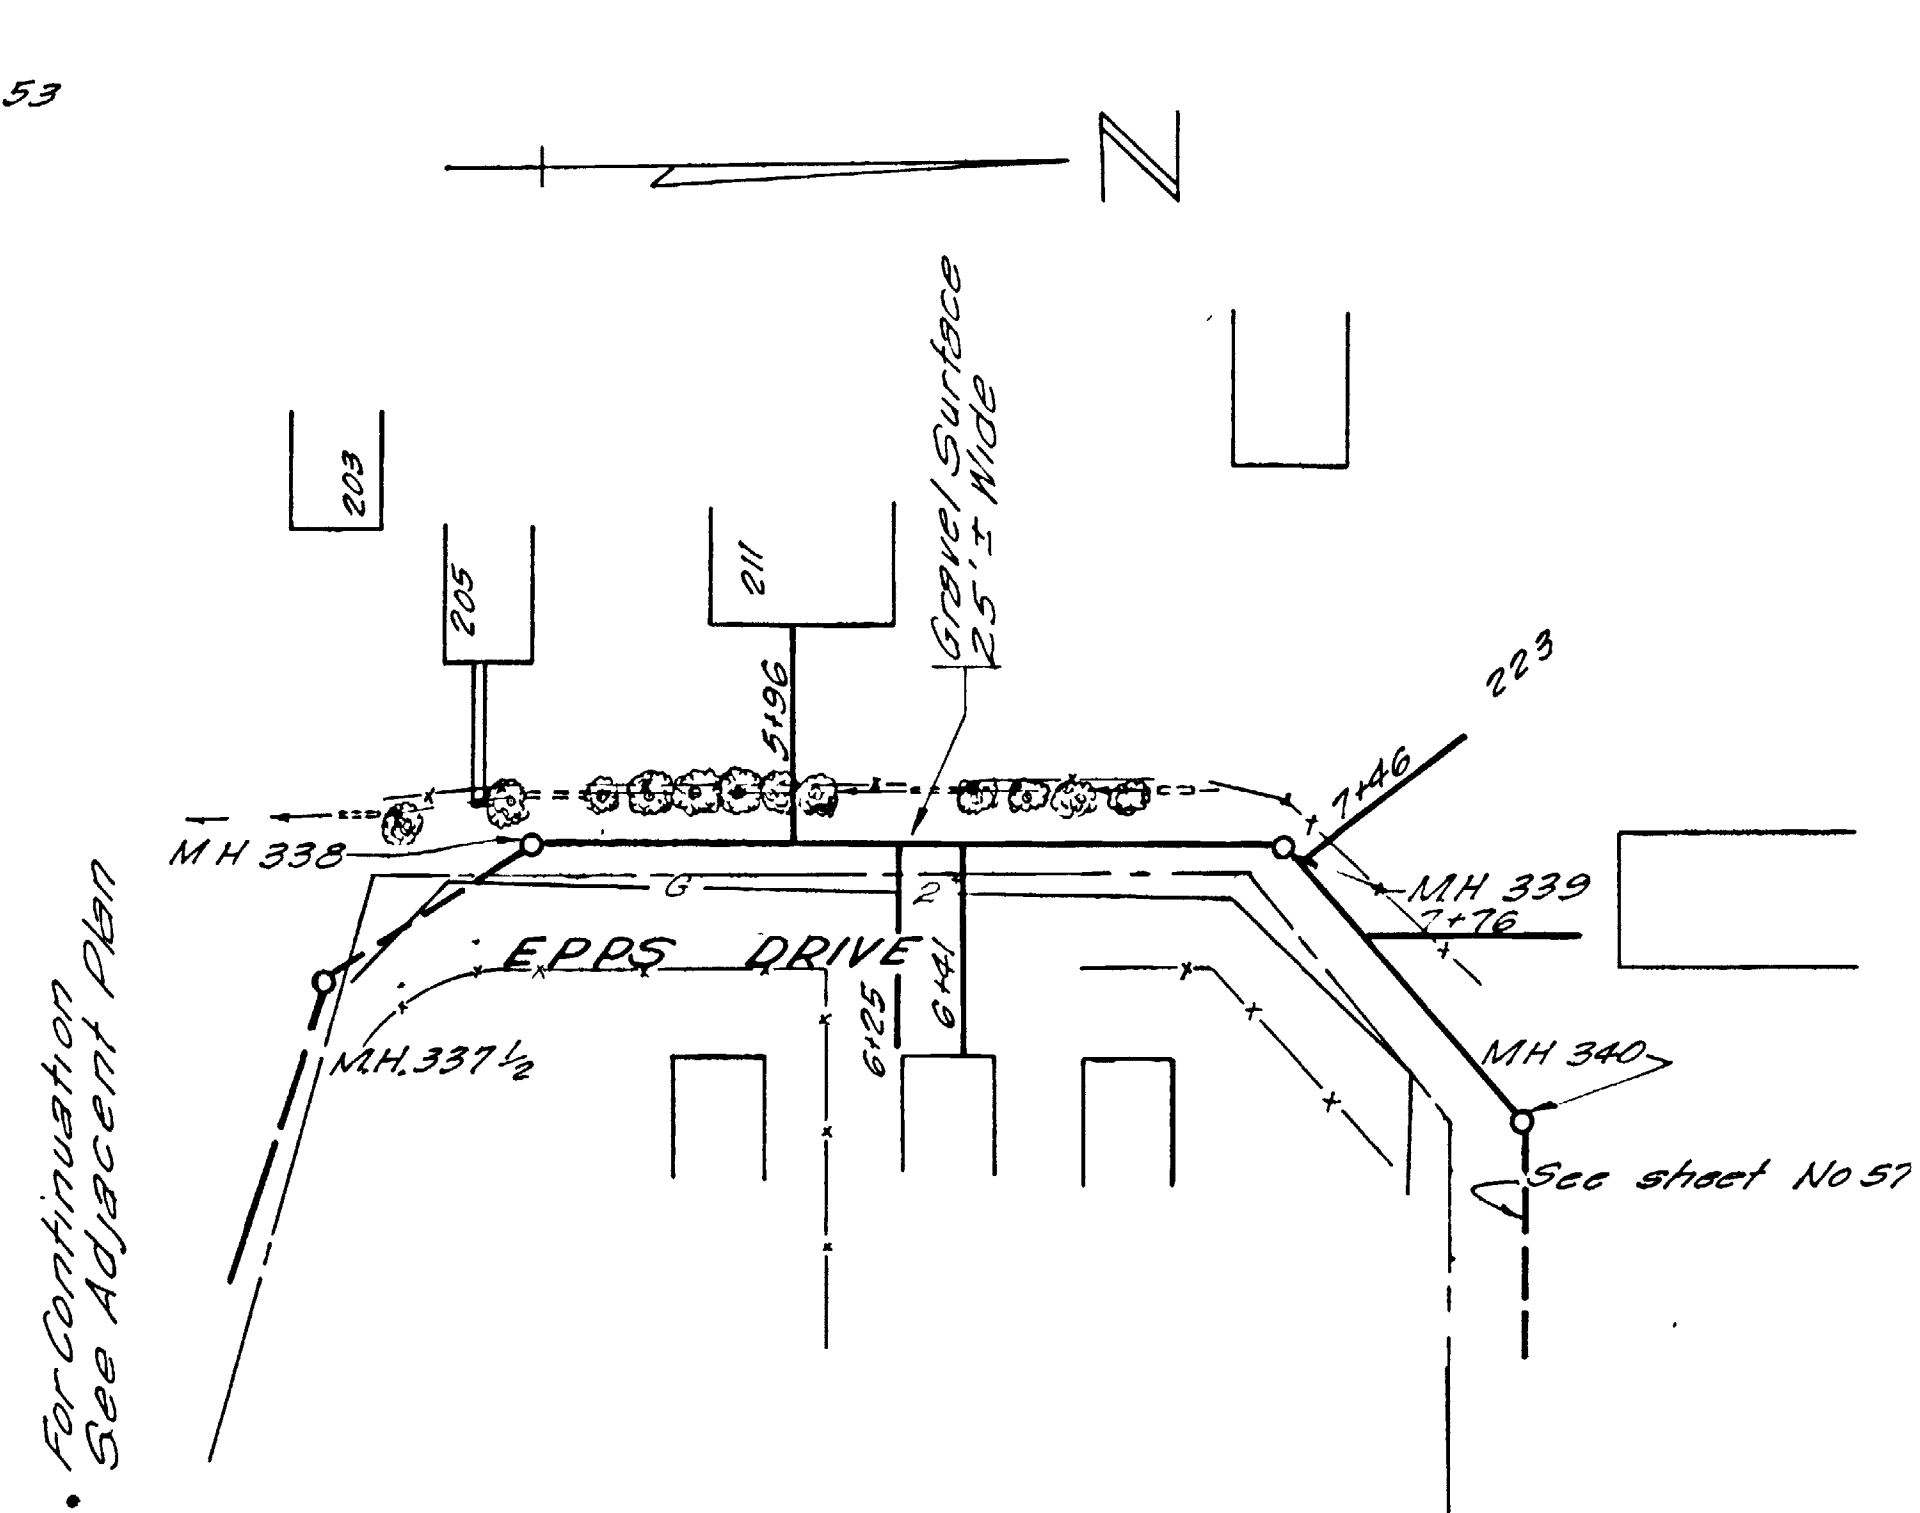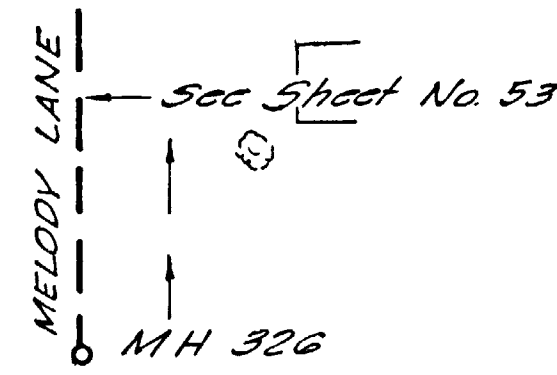

For Continuation See Adjacent Plan

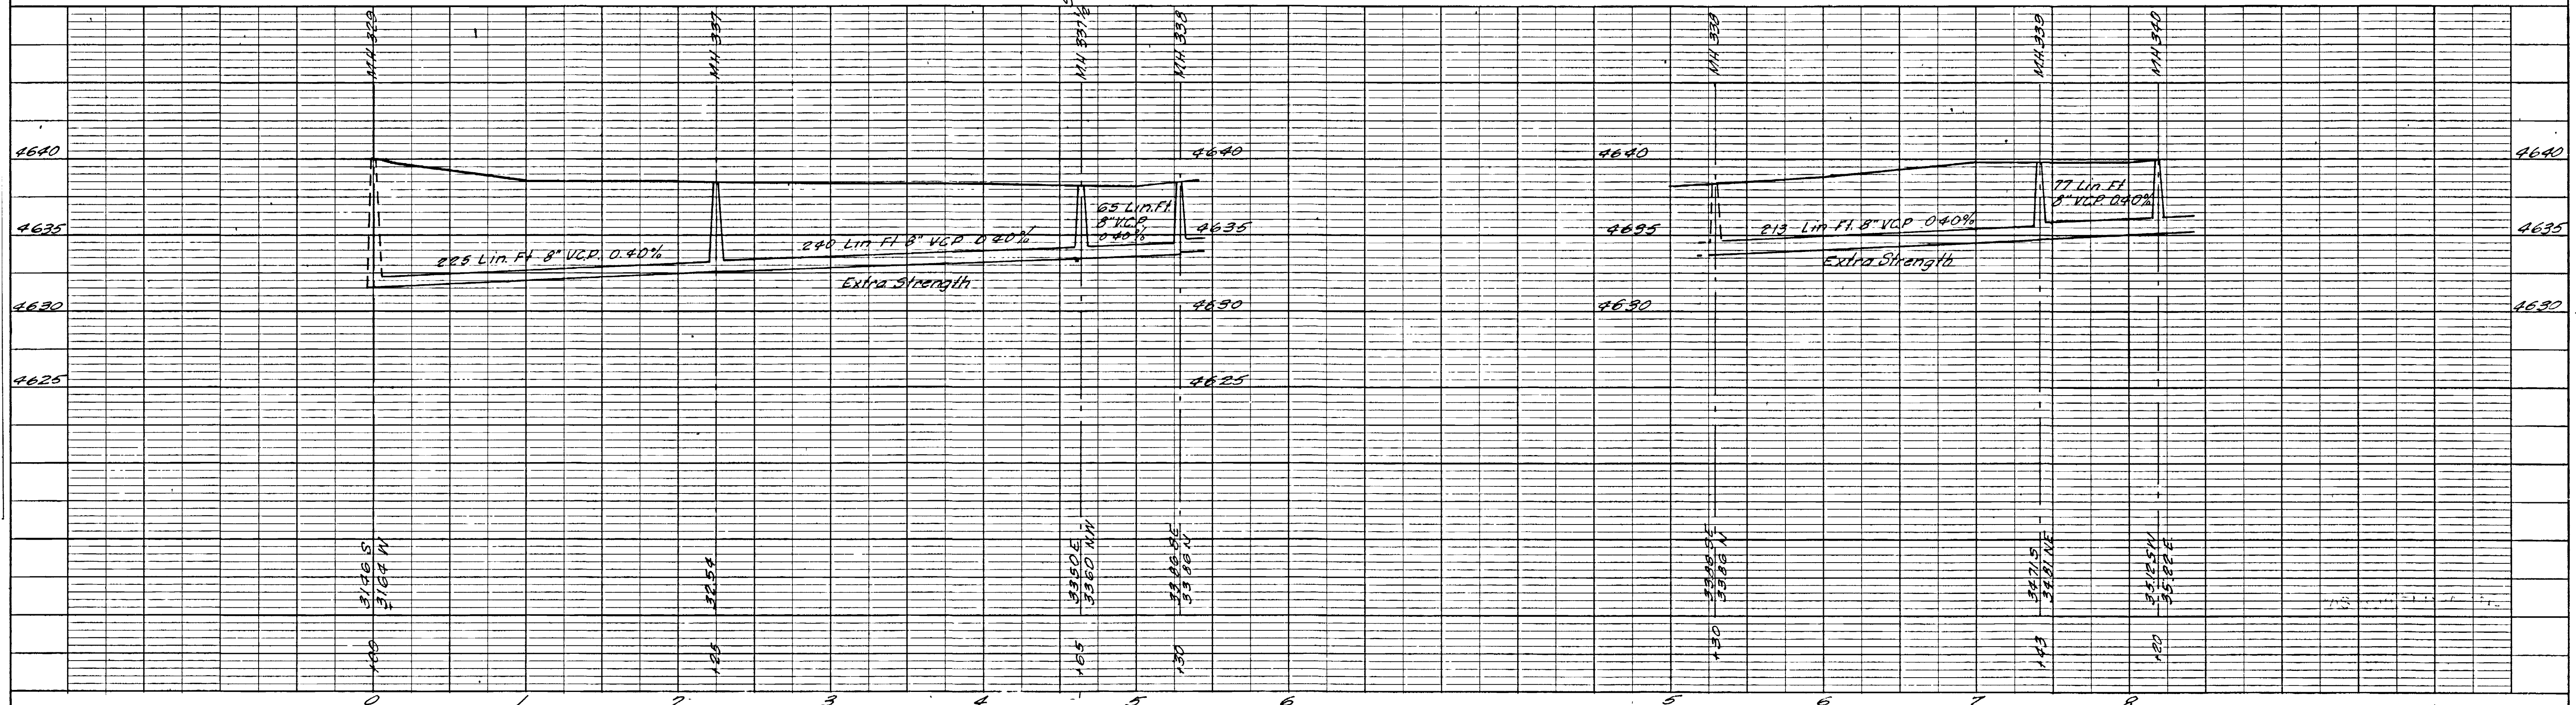

REVISIONS BY DATE DESC BY DATE DESC		DATE October 13, 2002 SCALE 1" = 50'		DRAWN D.M.K. CHECKED R.C.F. APPROVED [Signature]		JOB NO. G-205 FILE NO. F B NO.		HAROLD HOSKINS & ASSOCIATES ENGINEERING CONSULTANTS GREELEY, COLORADO		FRUITVALE, COLORADO WATER & SANITATION DISTRICT LINCOLN, NEBRASKA		EPPS DRIVE SHEET NO. 66 SHEET NO. 56	
-------------------------------------------	--	-----------------------------------------	--	--------------------------------------------------------	--	--------------------------------------	--	-----------------------------------------------------------------------------	--	-------------------------------------------------------------------------	--	--------------------------------------------	--

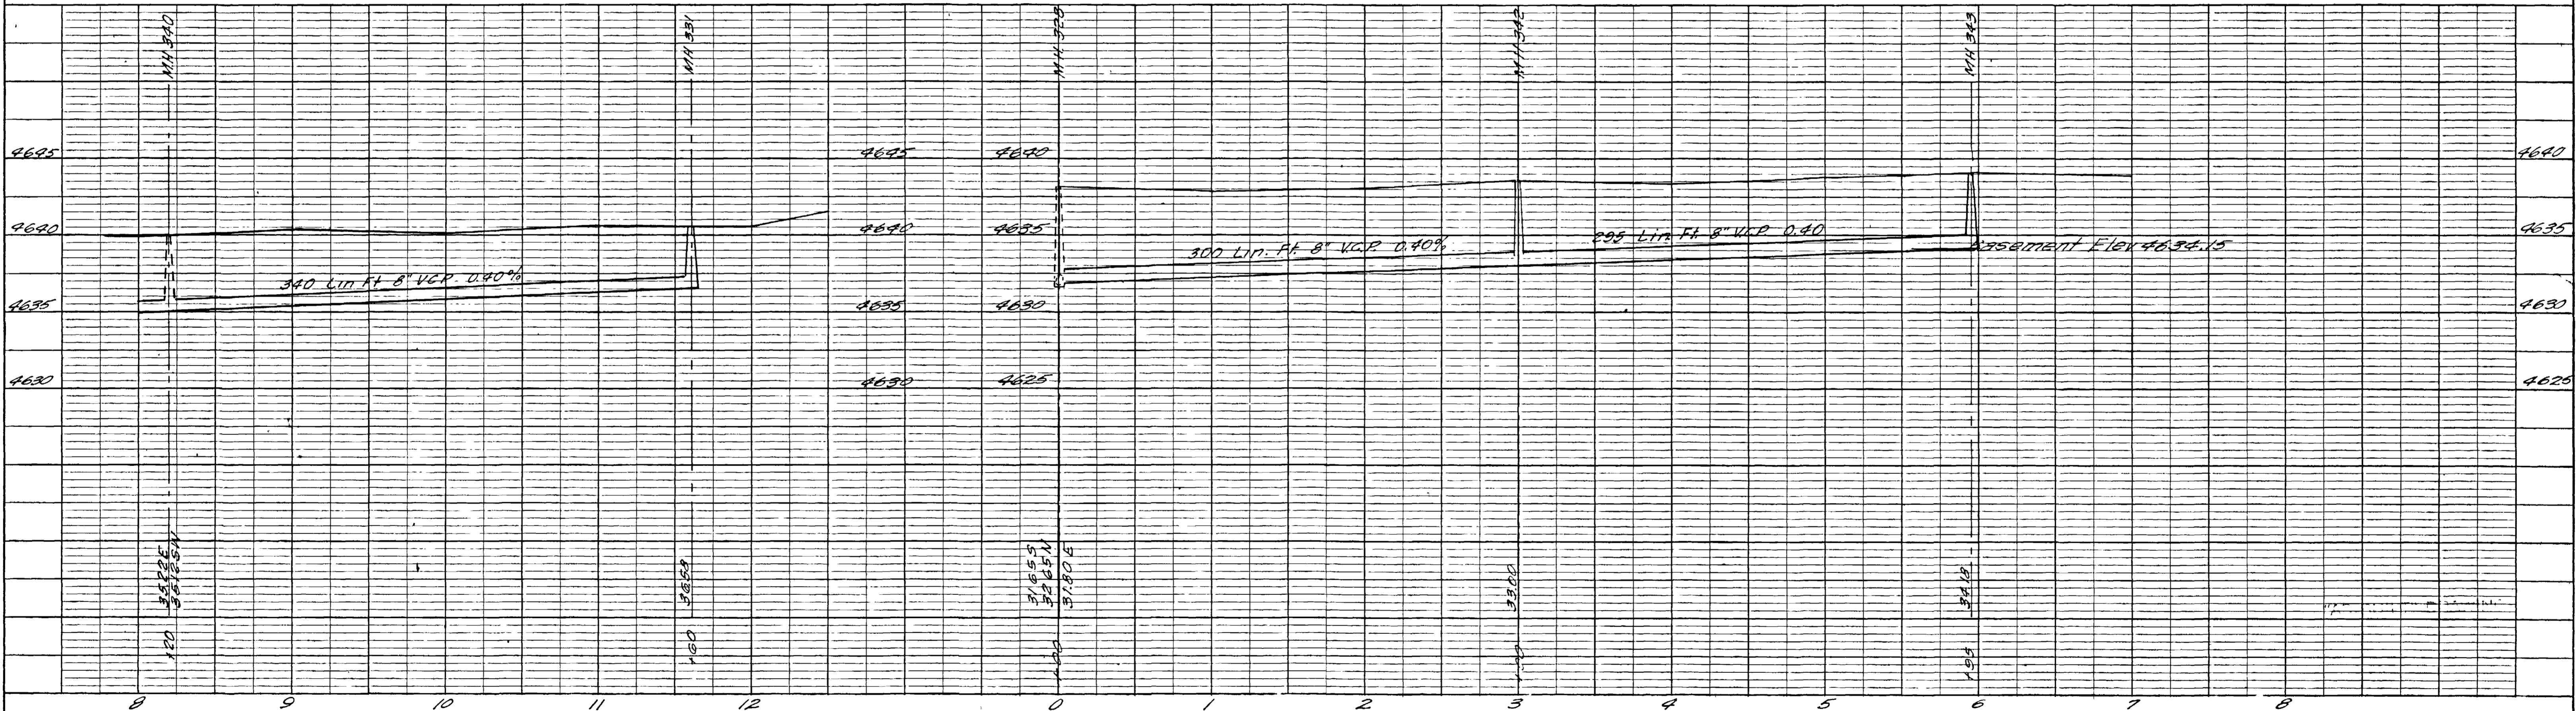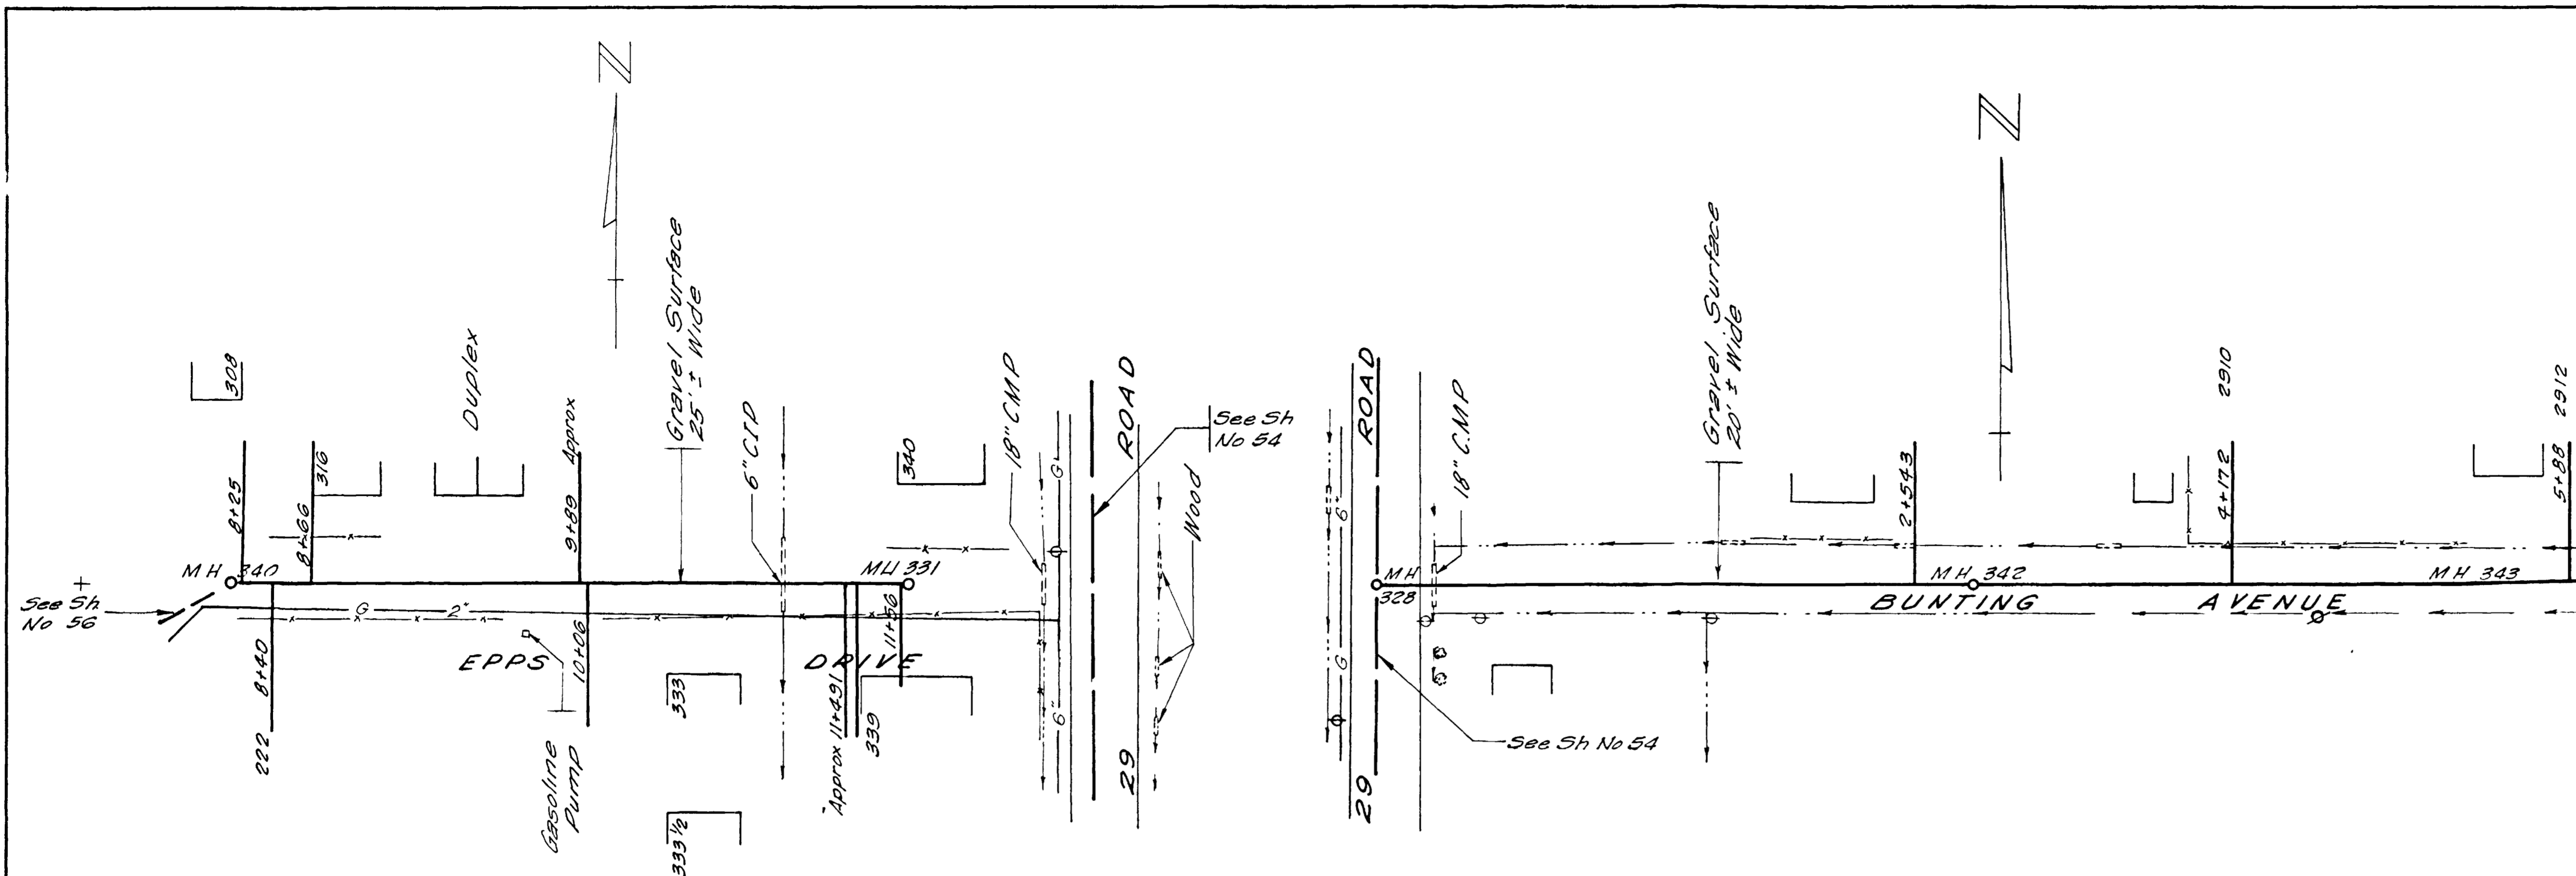

REVISIONS			
BY	DATE	DESCR	
BY	DATE	DESCR	
BY	DATE	DESCR	



DATE October 1957 DRAWN D.V.R. JOB NO. G-205
 CHECKED [Signature] FILE NO. _____
 SCALE 1"=50' APPROVED [Signature] F.B. NO. _____

HAROLD HOSKINS & ASSOCIATES
 ENGINEERING CONSULTANTS
 GREELEY, COLORADO LINCOLN, NEBRASKA

FRUITVALE, COLORADO
 WATER & SANITATION DISTRICT

EPPS DRIVE
BUNTING AVENUE EAST OF 29 ROAD

66 SHEET NO
 SHEETS 57

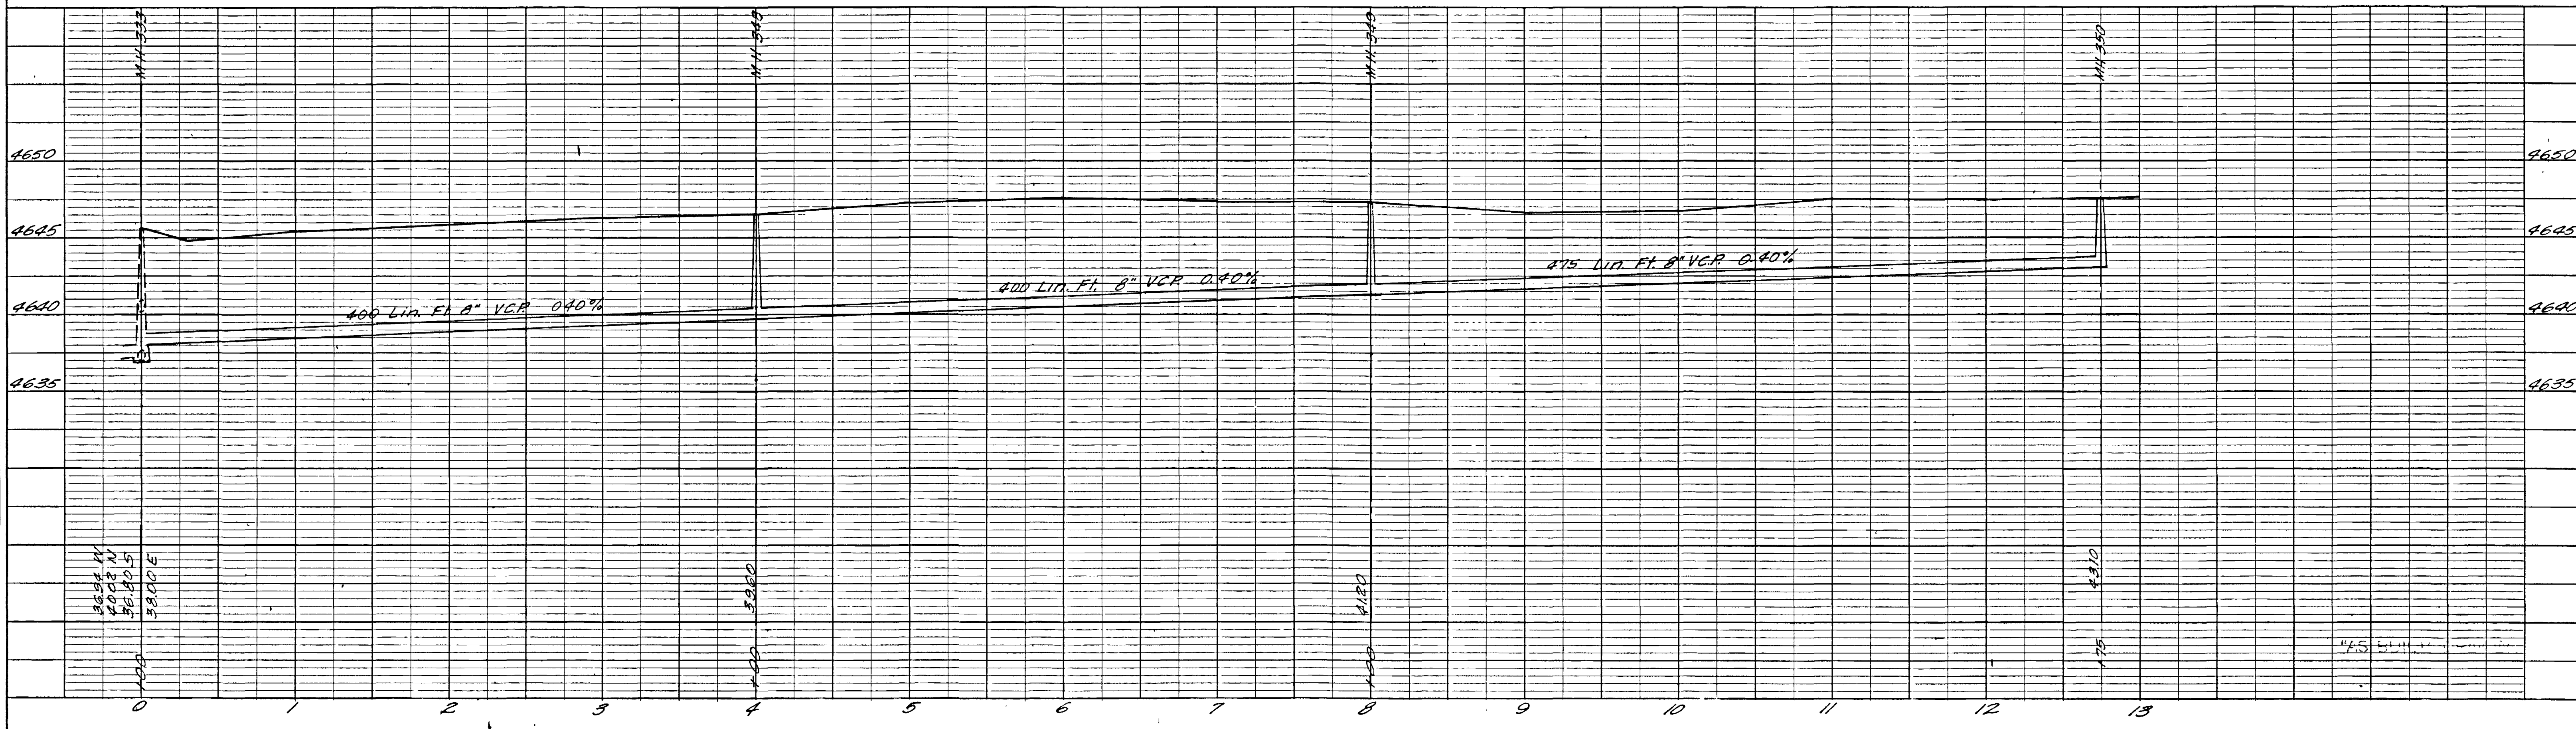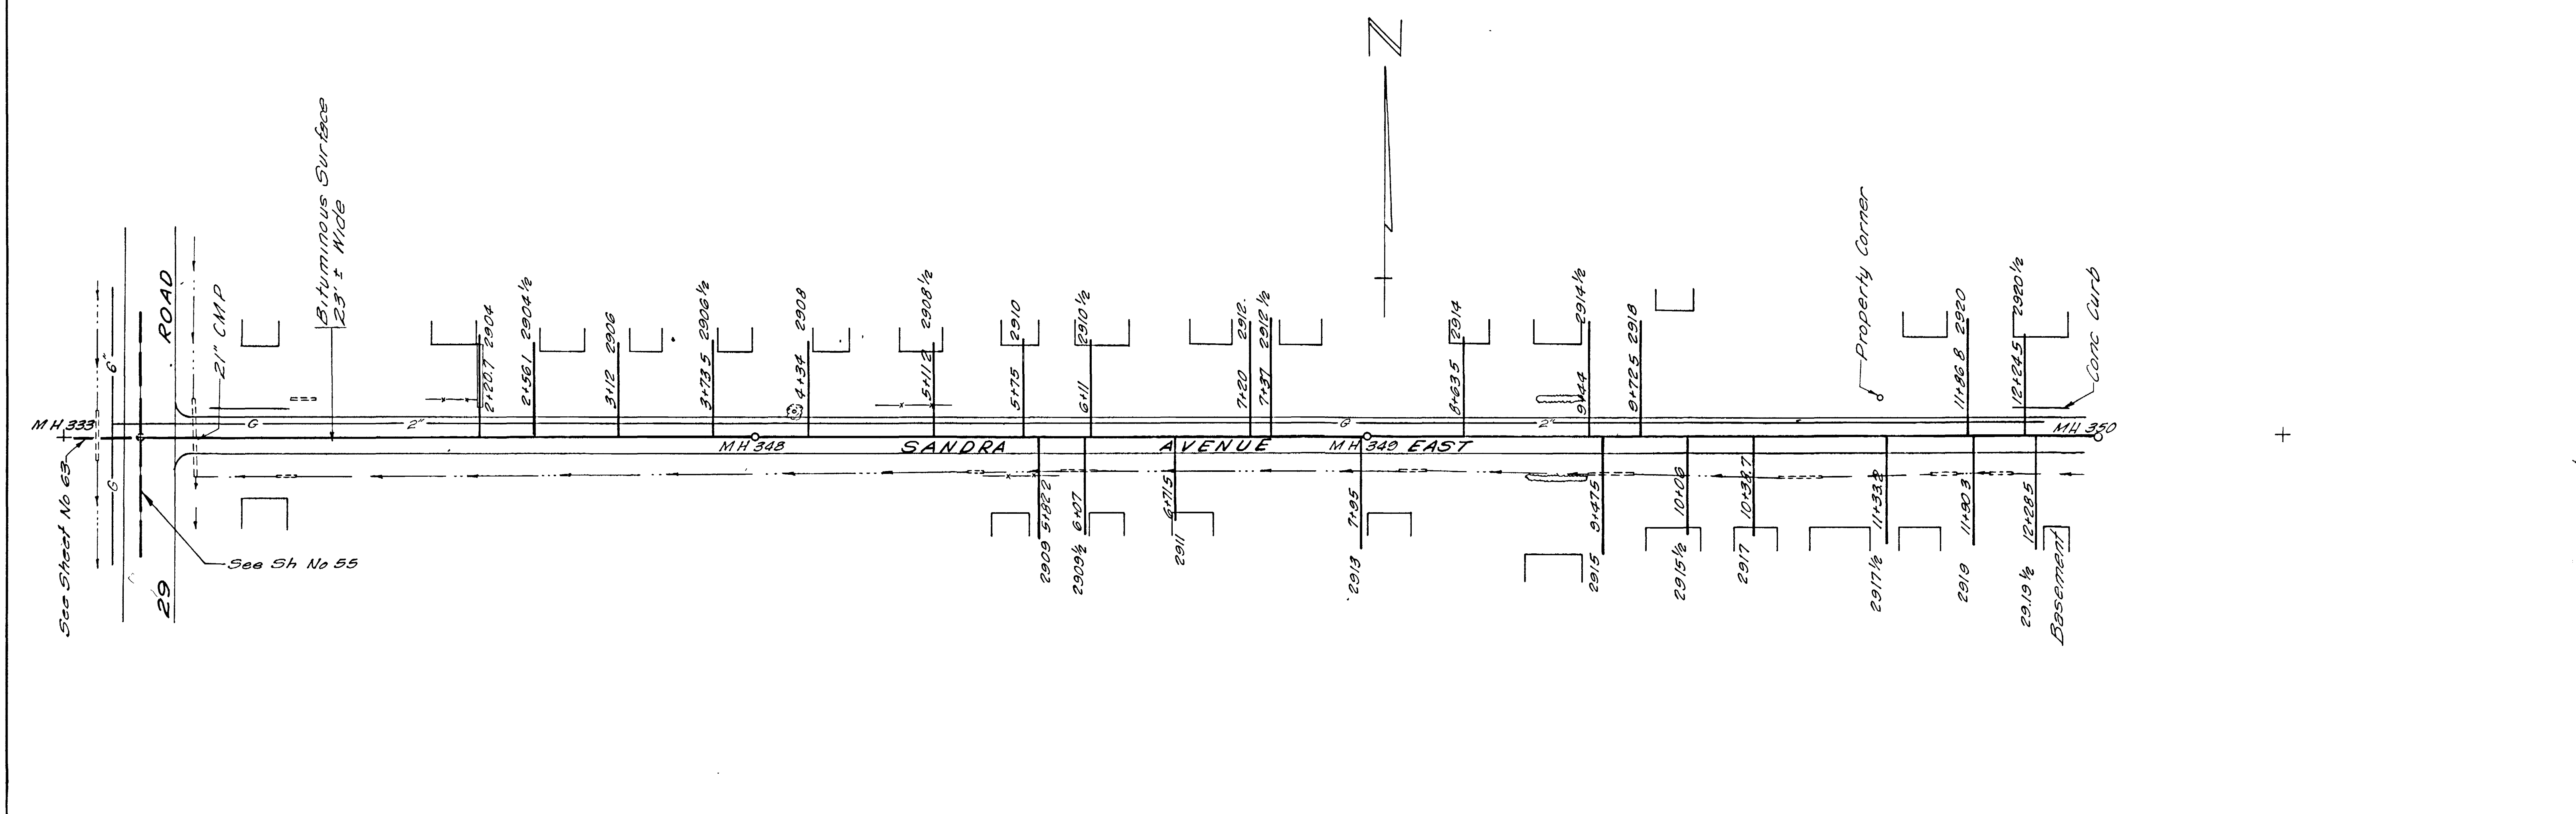



REVISIONS		DATE	DESCR	CHECKED	APPROVED	FILE NO	F B NO
BY	DATE	DESCR	DATE	DESCR	DATE	DESCR	DATE

HAROLD HOSKINS & ASSOCIATES
ENGINEERING CONSULTANTS
GREELEY, COLORADO LINCOLN, NEBRASKA



FRUITVALE, COLORADO
WATER & SANITATION DISTRICT

SANDRA AVENUE EAST OF 29 ROAD

66 SHEET NO
SHEETS 58

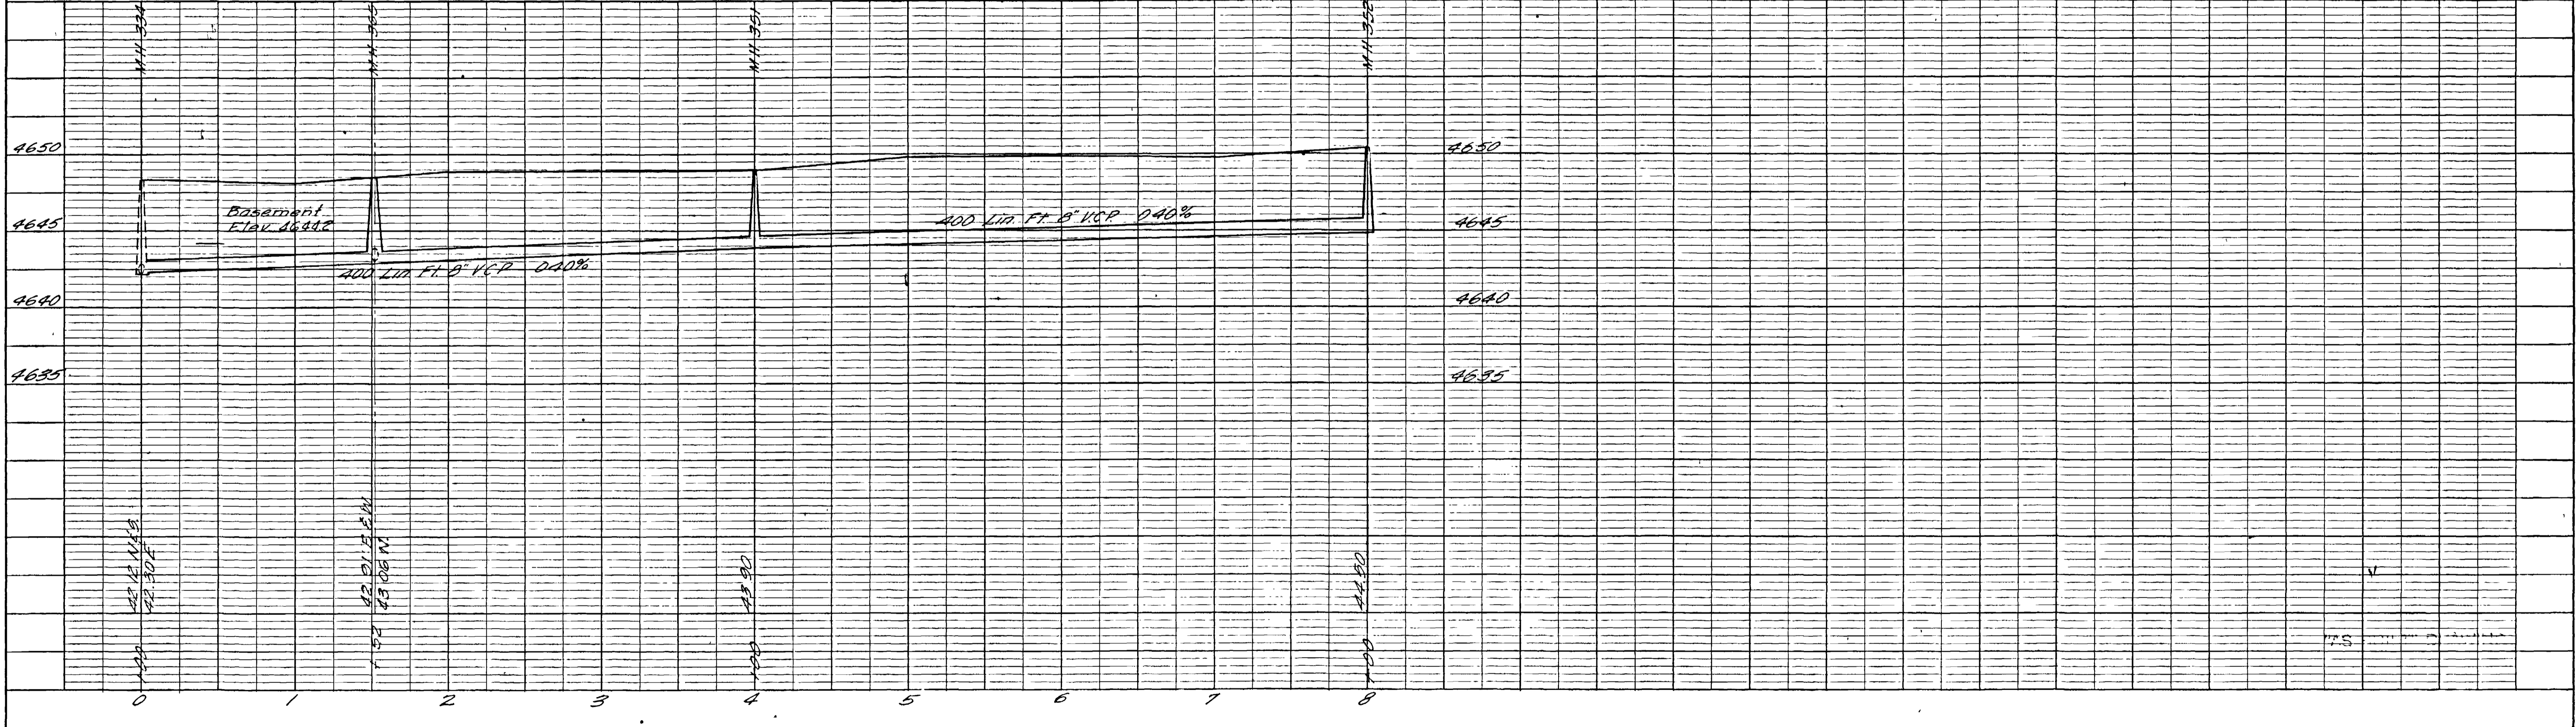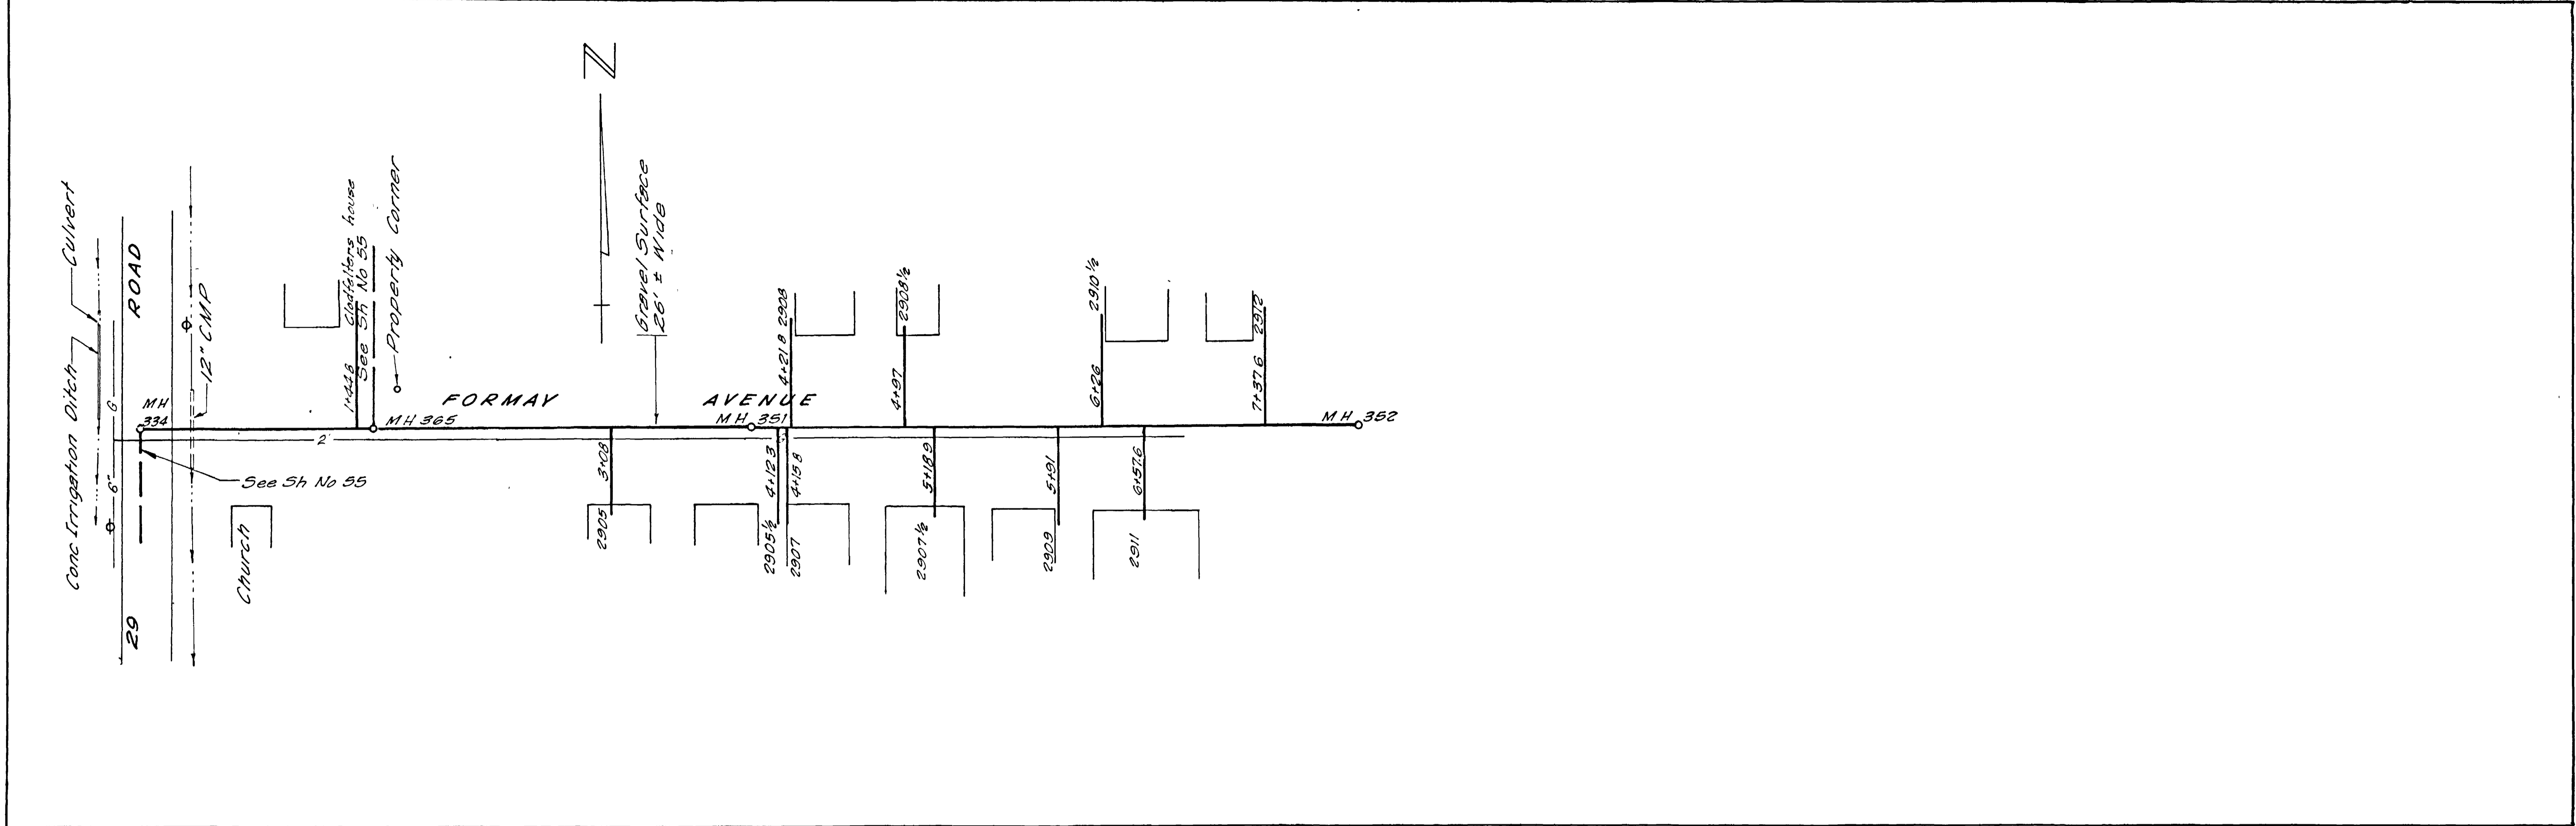

REVISIONS BY DATE DESCR BY DATE DESCR BY DATE DESCR	DATE <u>October 1957</u> DRAWN <u>D.V.R.</u> JOB NO. <u>G-205</u> CHECKED <u>R.C.T.</u> FILE NO. APPROVED <u>[Signature]</u> F.B. NO.	HAROLD HOSKINS & ASSOCIATES ENGINEERING CONSULTANTS GREELEY, COLORADO LINCOLN, NEBRASKA	FRUITVALE, COLORADO WATER & SANITATION DISTRICT	FORMAY AVENUE 66 SHEETS 59 SHEET NO
--------------------------------------------------------------	---------------------------------------------------------------------------------------------------------------------------------------------	-----------------------------------------------------------------------------------------------	----------------------------------------------------	----------------------------------------

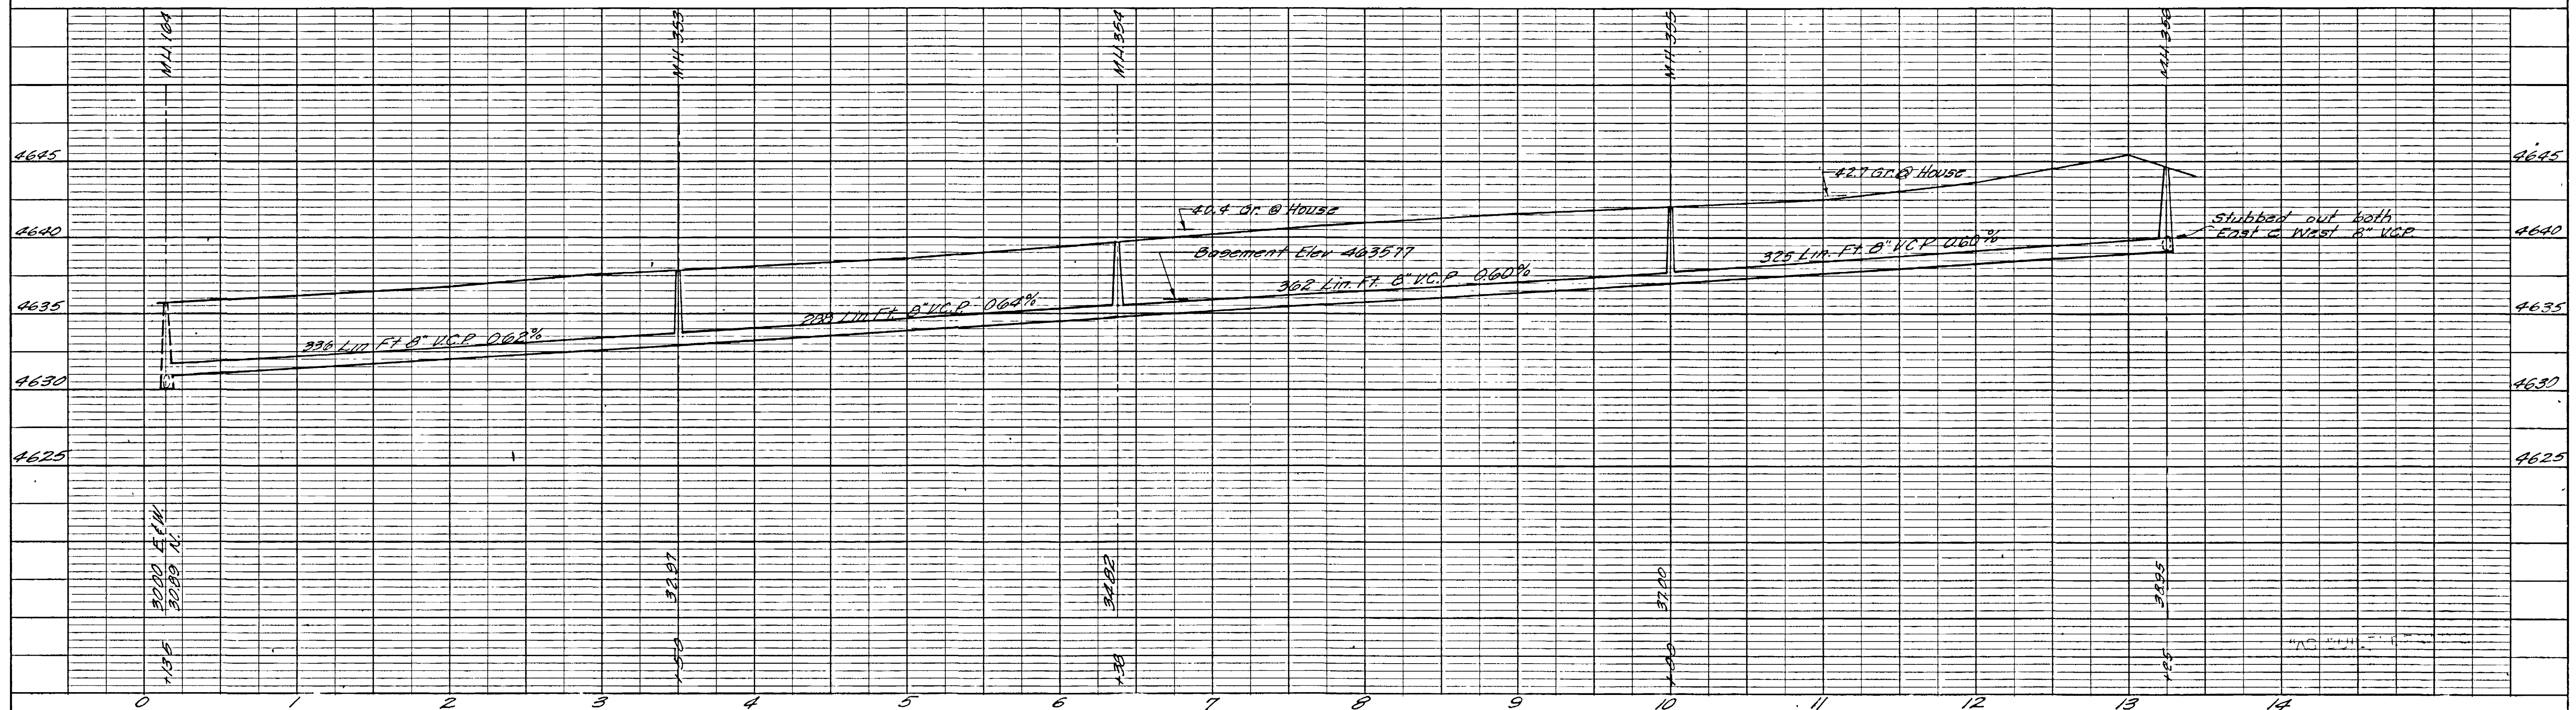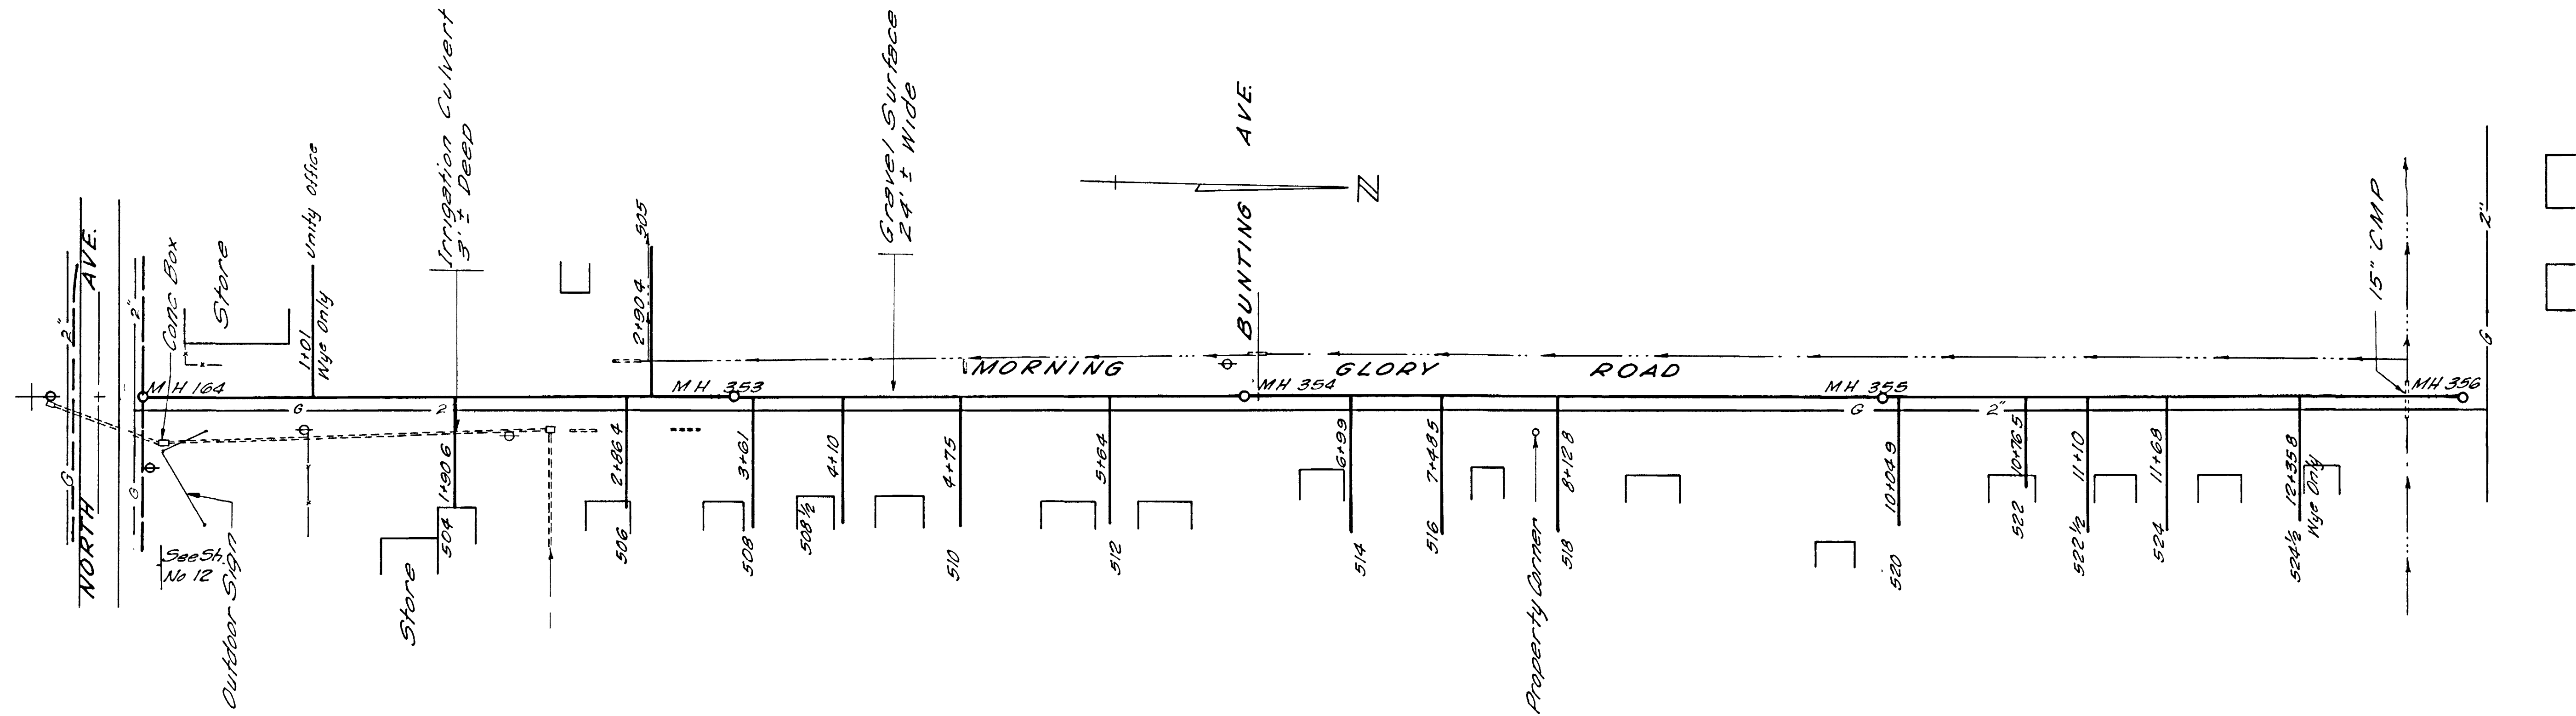

REVISIONS		
BY: RCT	DATE: Feb 1960	DESCR: Grades
BY: _____	DATE: _____	DESCR: _____



DATE: October 1957	DRAWN: D.V.R.	JOB NO: G-205
SCALE: 1" = 50'	CHECKED: _____	FILE NO: _____
APPROVED: _____	F & NO: _____	

HAROLD HOSKINS & ASSOCIATES
ENGINEERING CONSULTANTS
GREELEY, COLORADO LINCOLN, NEBRASKA



FRUITVALE, COLORADO
WATER & SANITATION DISTRICT

MORNING GLORY ROAD

66	SHEET NO
CO	SHEET

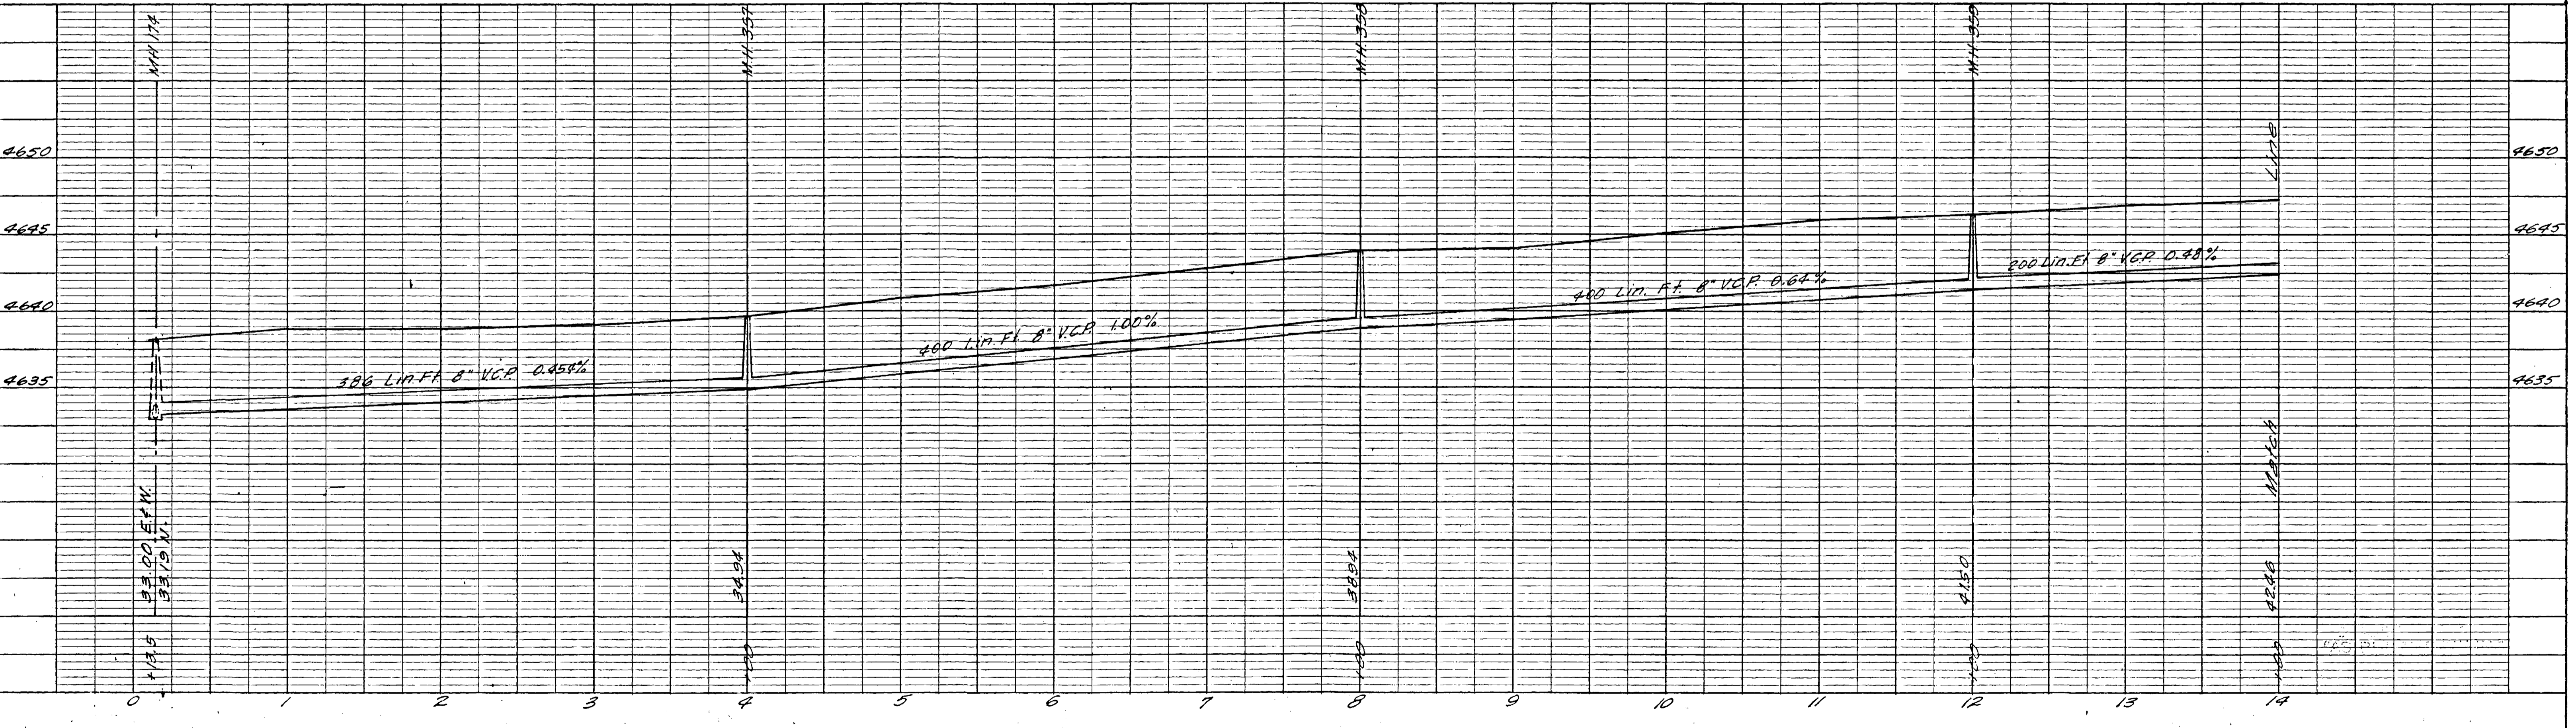
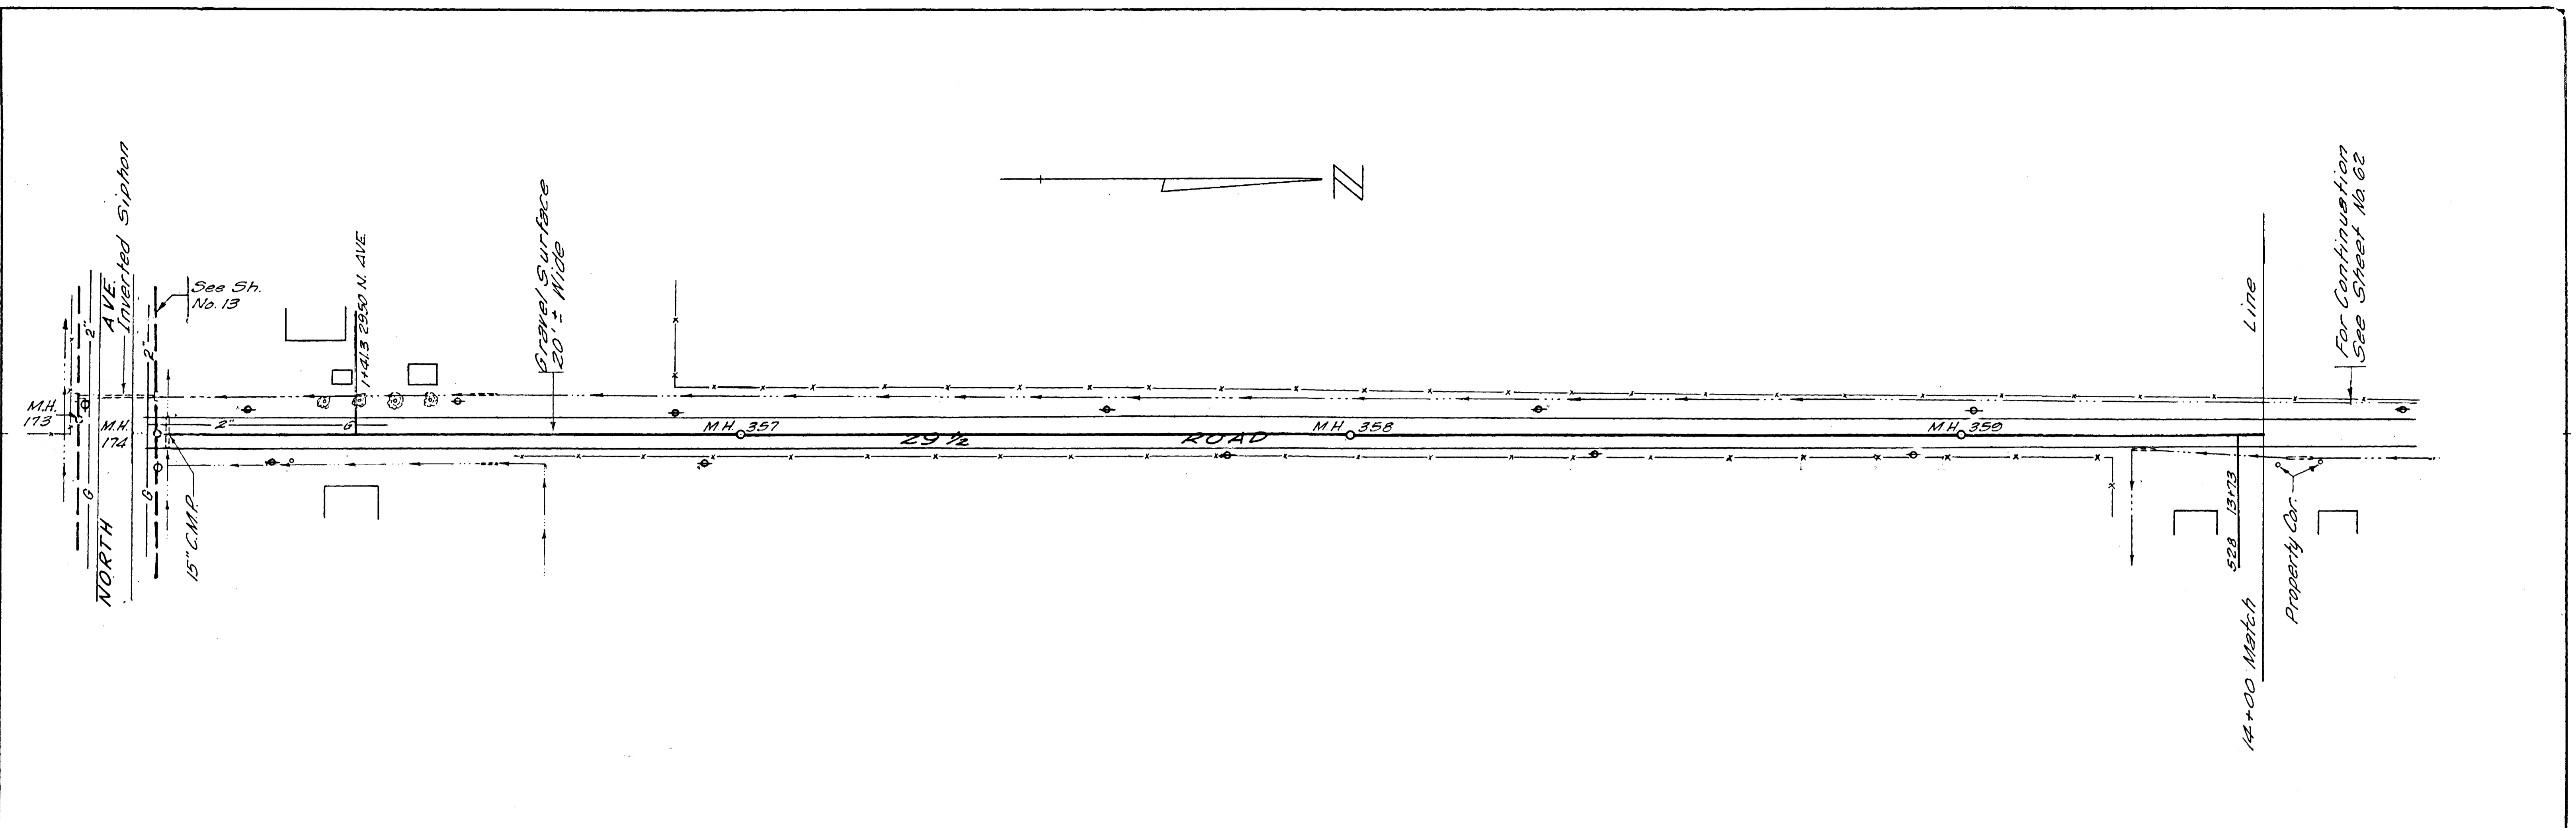


REVISIONS BY: RCT DATE: Feb 1960 DESCR: 300 dia BY: DATE: DESCR:		DATE: October 1957 SCALE: 1"=50' DRAWN: D.V.R. CHECKED: R.C.T. APPROVED: [Signature]	JOB NO. G-805 FILE NO. F. B. NO.	HAROLD HOSKINS & ASSOCIATES ENGINEERING CONSULTANTS GREELEY, COLORADO LINCOLN, NEBRASKA	FRUITVALE, COLORADO WATER & SANITATION DISTRICT	29 1/2 ROAD STA. 0+025 TO STA. 14+00	66 SHEETS 61 SHEET 1-3
------------------------------------------------------------------------	--	--------------------------------------------------------------------------------------------------	----------------------------------------	-----------------------------------------------------------------------------------------------	----------------------------------------------------	-----------------------------------------	---------------------------

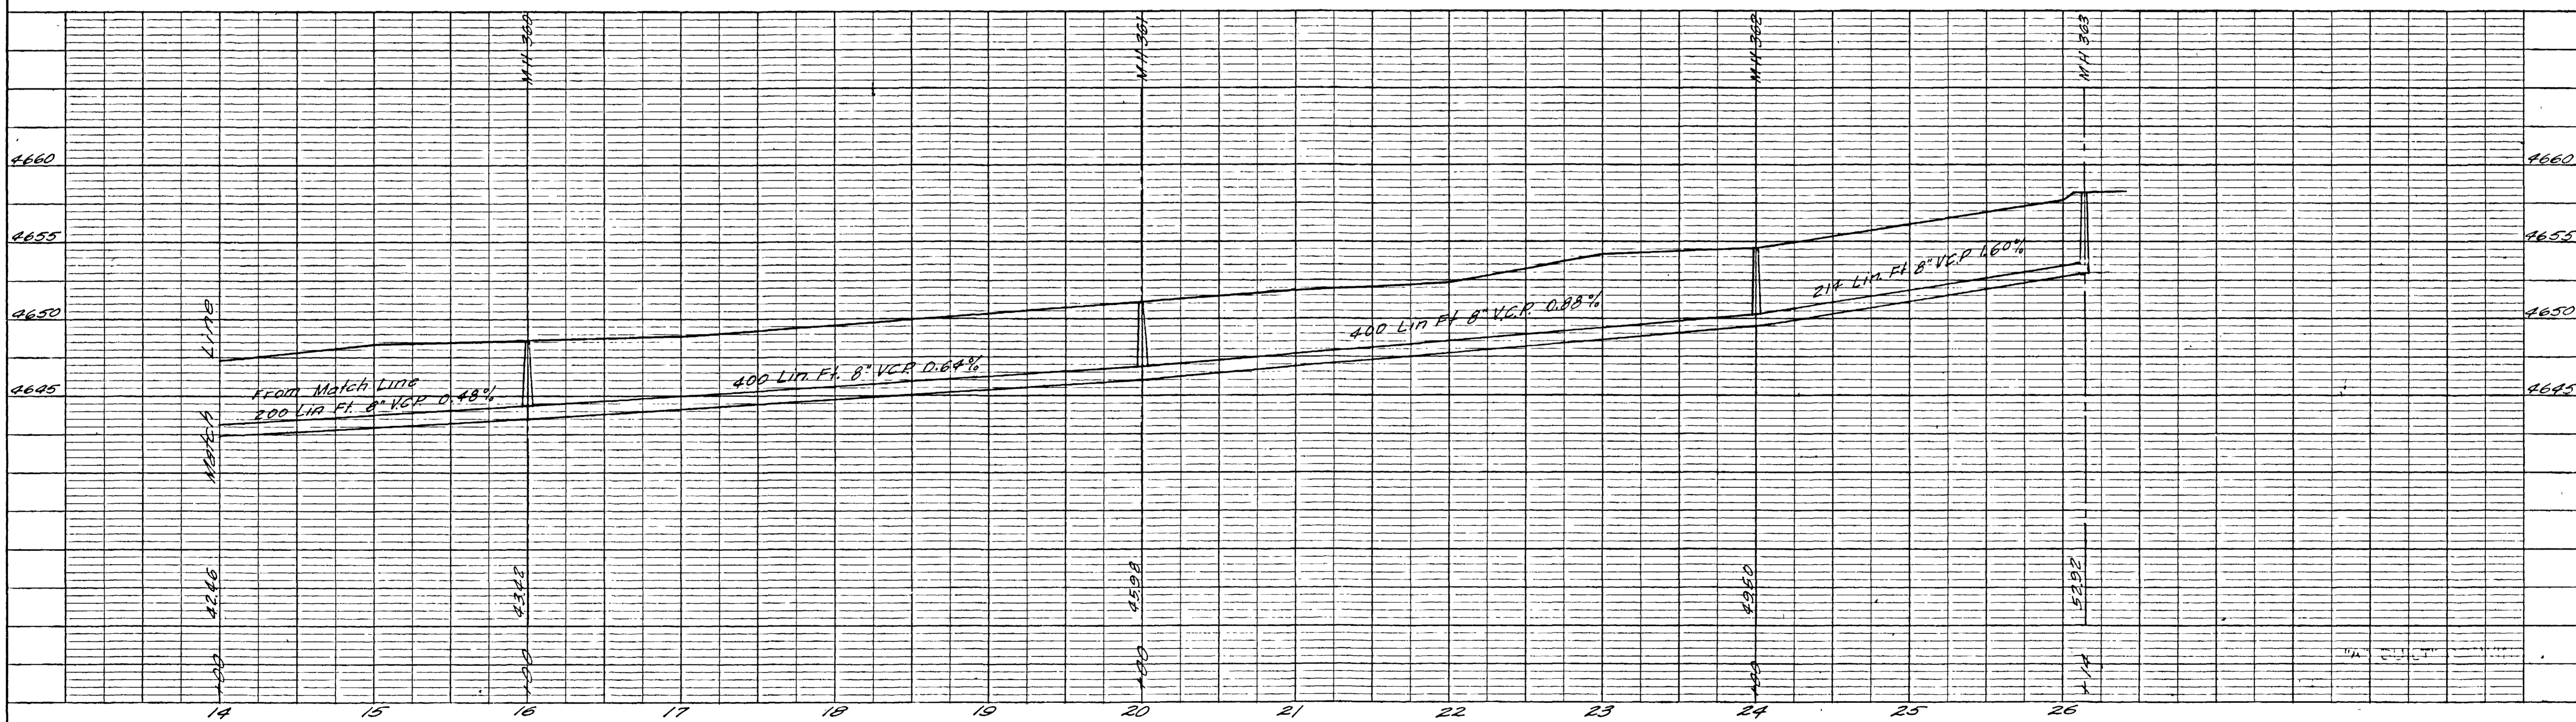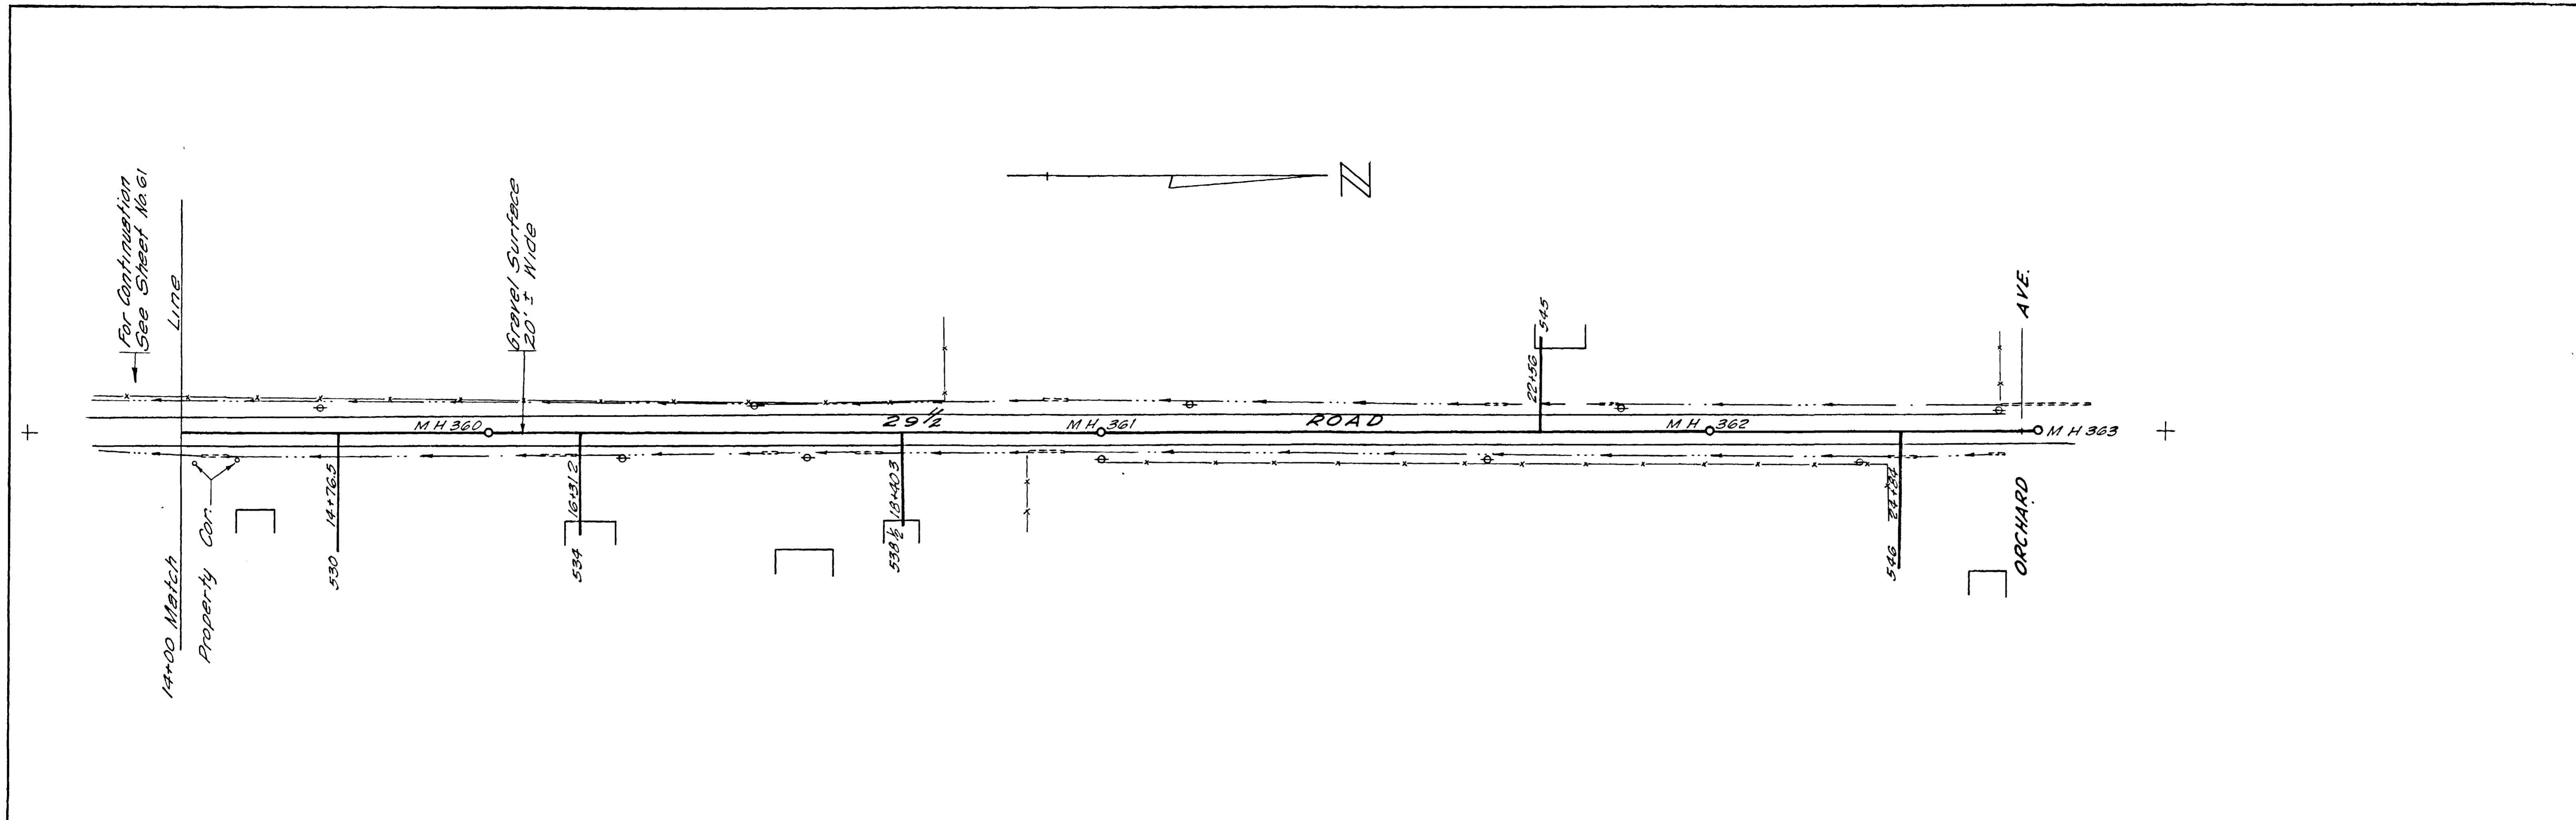





REVISIONS BY: <i>R.C.S.</i> DATE: <i>Feb. 1960</i> DESCR: <i>Grades</i> BY: _____ DATE: _____ DESCR: _____ BY: _____ DATE: _____ DESCR: _____		DATE: <i>October 1952</i> DRAWN: <i>D.V.R.</i> JOB NO.: <i>G-205</i> CHECKED: <i>R.C.S.</i> FILE NO.: _____ APPROVED: <i>[Signature]</i> P & NO.: _____	HAROLD HOSKINS & ASSOCIATES ENGINEERING CONSULTANTS GREELEY, COLORADO LINCOLN, NEBRASKA	FRUITVALE, COLORADO WATER & SANITATION DISTRICT	29 1/2 ROAD STA. 14+00 TO STA. 26+14	66 SHEET NO. SHEETS 62
--------------------------------------------------------------------------------------------------------------------------------------------------------	--	---------------------------------------------------------------------------------------------------------------------------------------------------------------	----------------------------------------------------------------------------------------------------	----------------------------------------------------	-----------------------------------------	---------------------------

02081763.tif


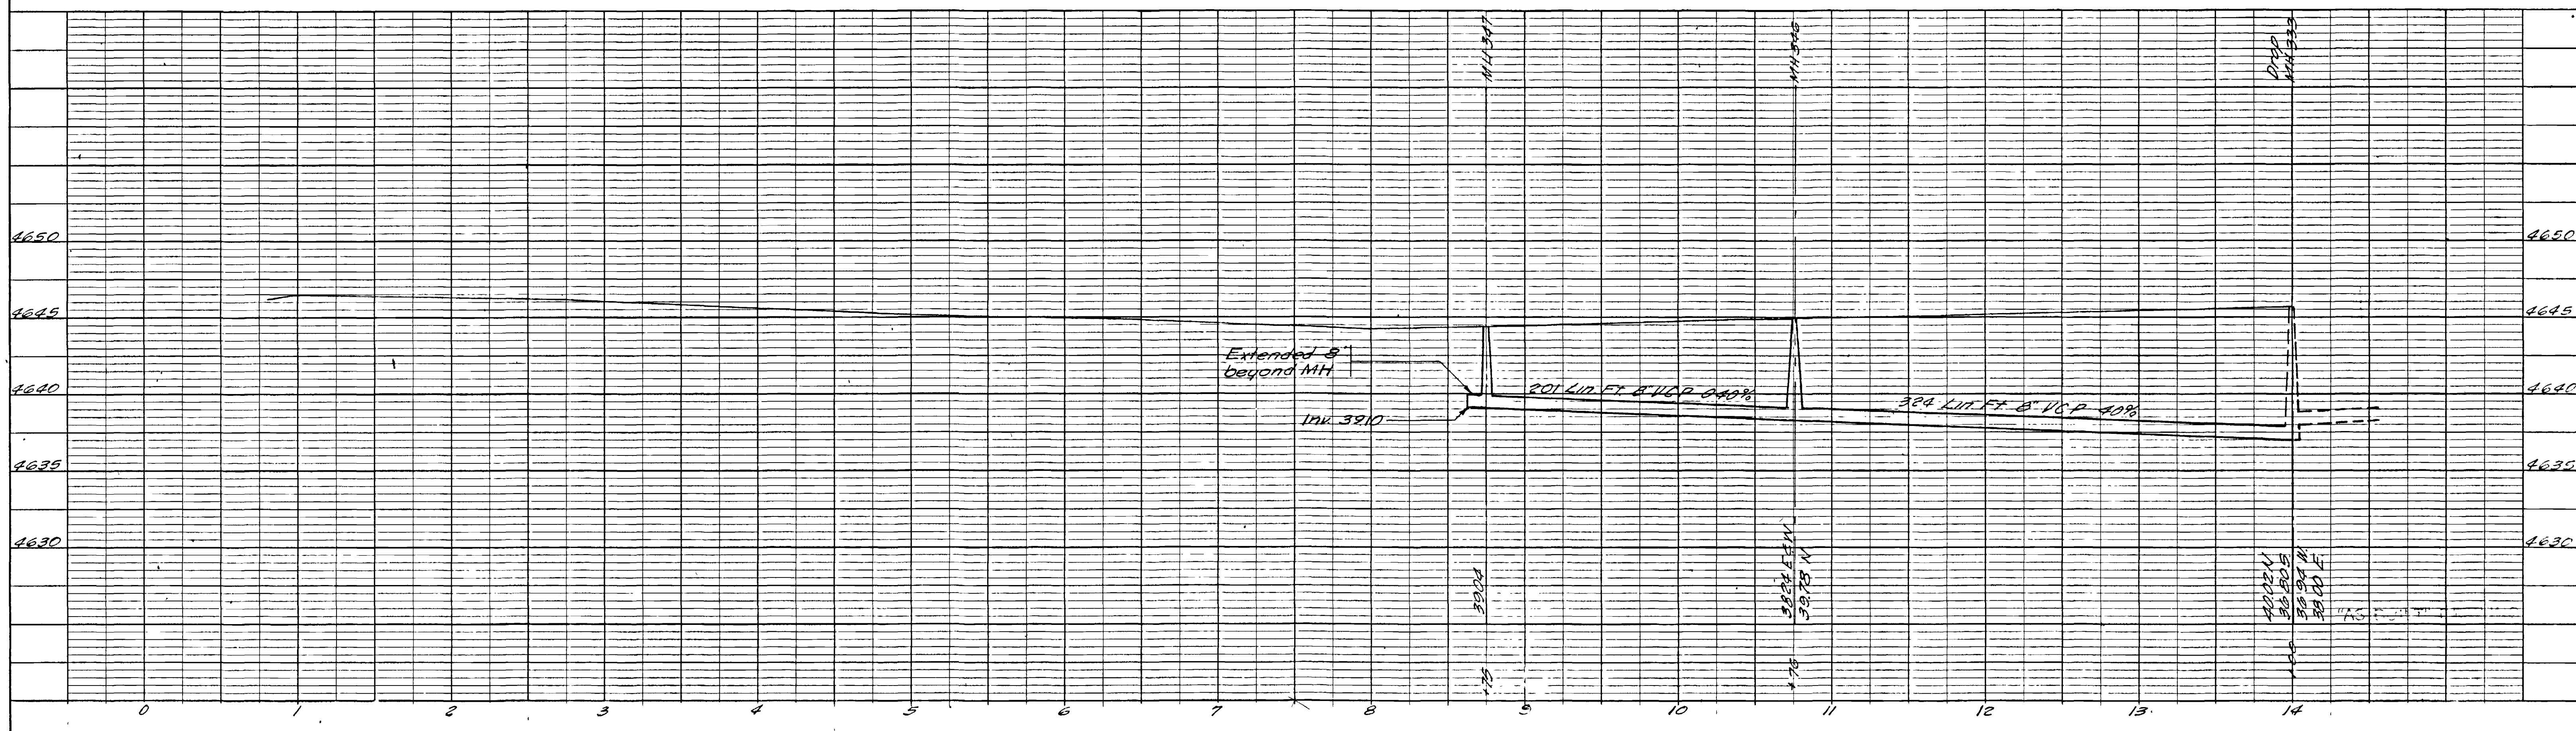
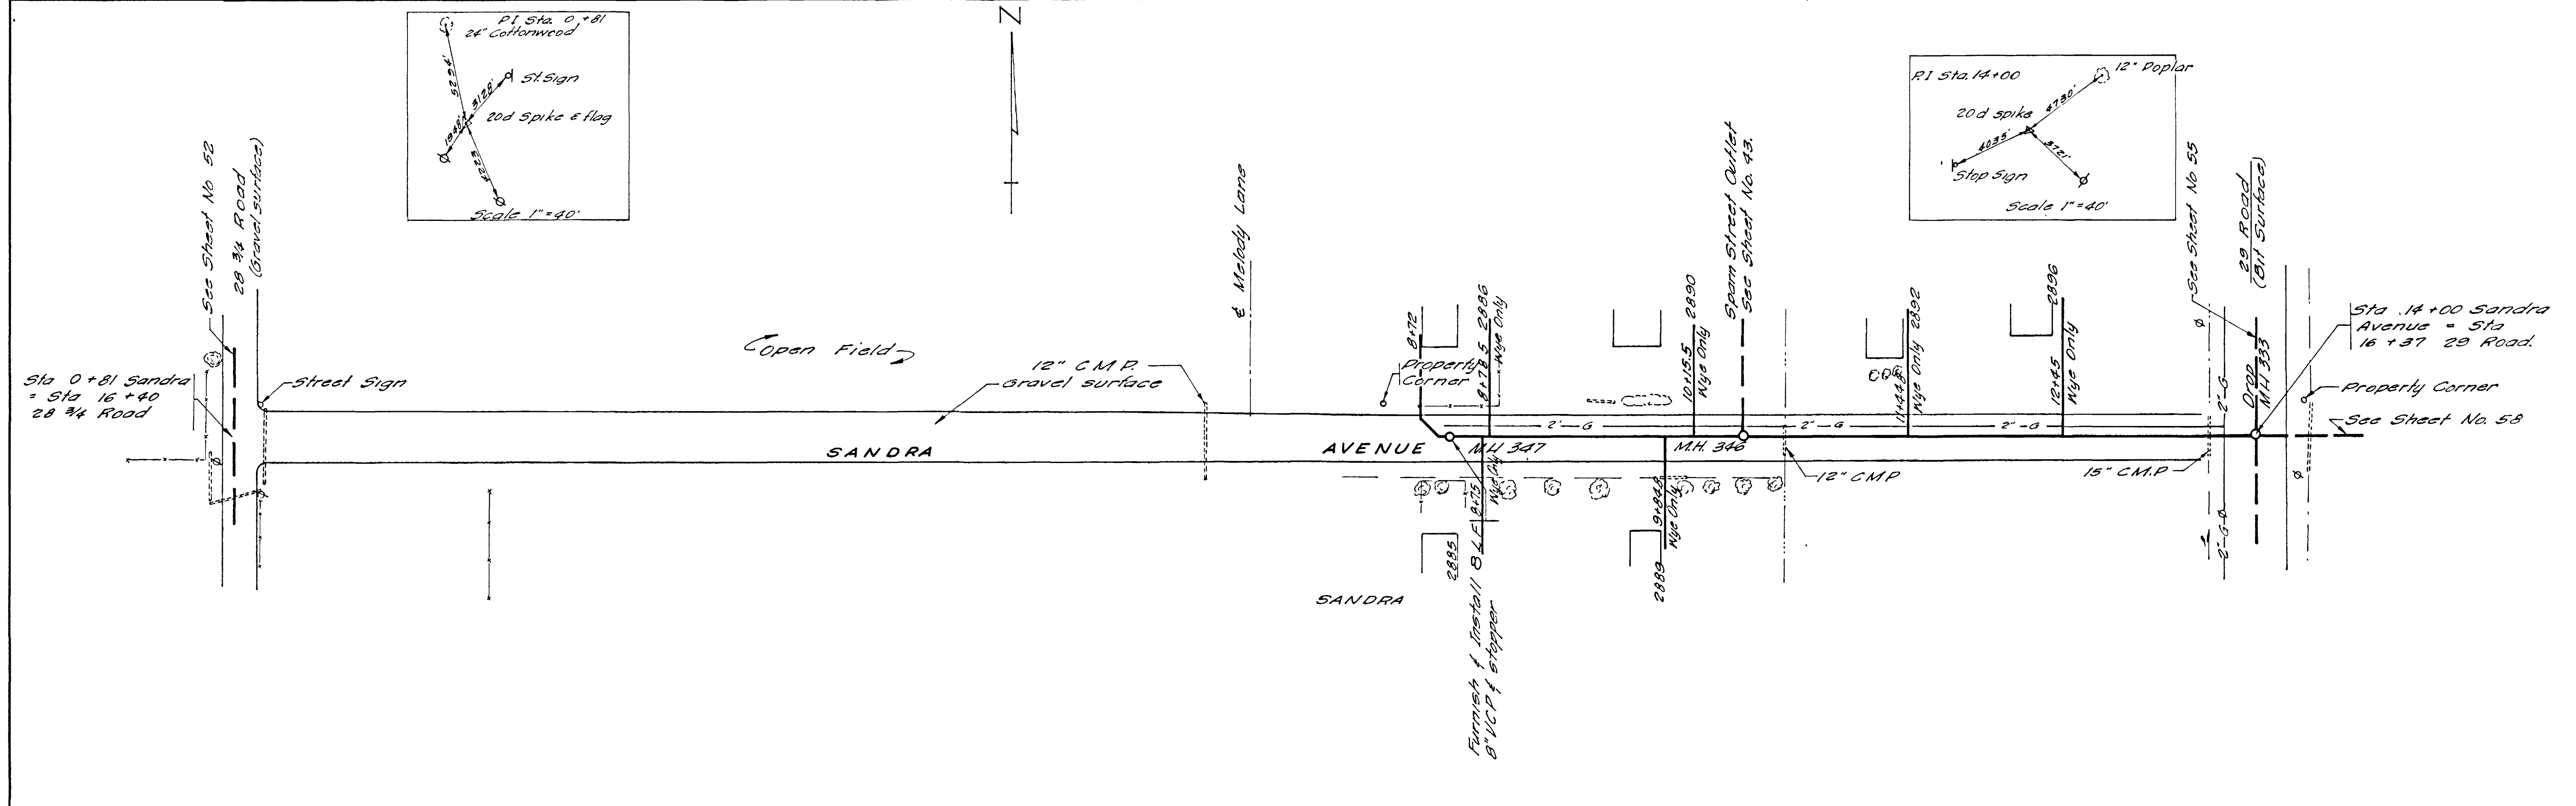


REVISIONS BY PCT DATE Feb. 1960 DESCR Grades #1 DATE _____ DESCR _____ #2 DATE _____ DESCR _____		DATE October 1957 SCALE 1" = 50'	DESIGNED MS CHECKED HGU APPROVED _____	JOB NO G-205 FILE NO _____ F B NO _____	HAROLD HOSKINS & ASSOCIATES ENGINEERING CONSULTANTS GREELEY, COLORADO	FRUITVALE, COLORADO WATER & SANITATION DISTRICT	SANDRA AVENUE WEST OF 29 ROAD	66 SHEET NO SHEETS 67
-----------------------------------------------------------------------------------------------------------	--	-------------------------------------	----------------------------------------------	-----------------------------------------------	----------------------------------------------------------------------------------------	-----------------------------------------------------------	------------------------------------------------	--------------------------

02081764.tif

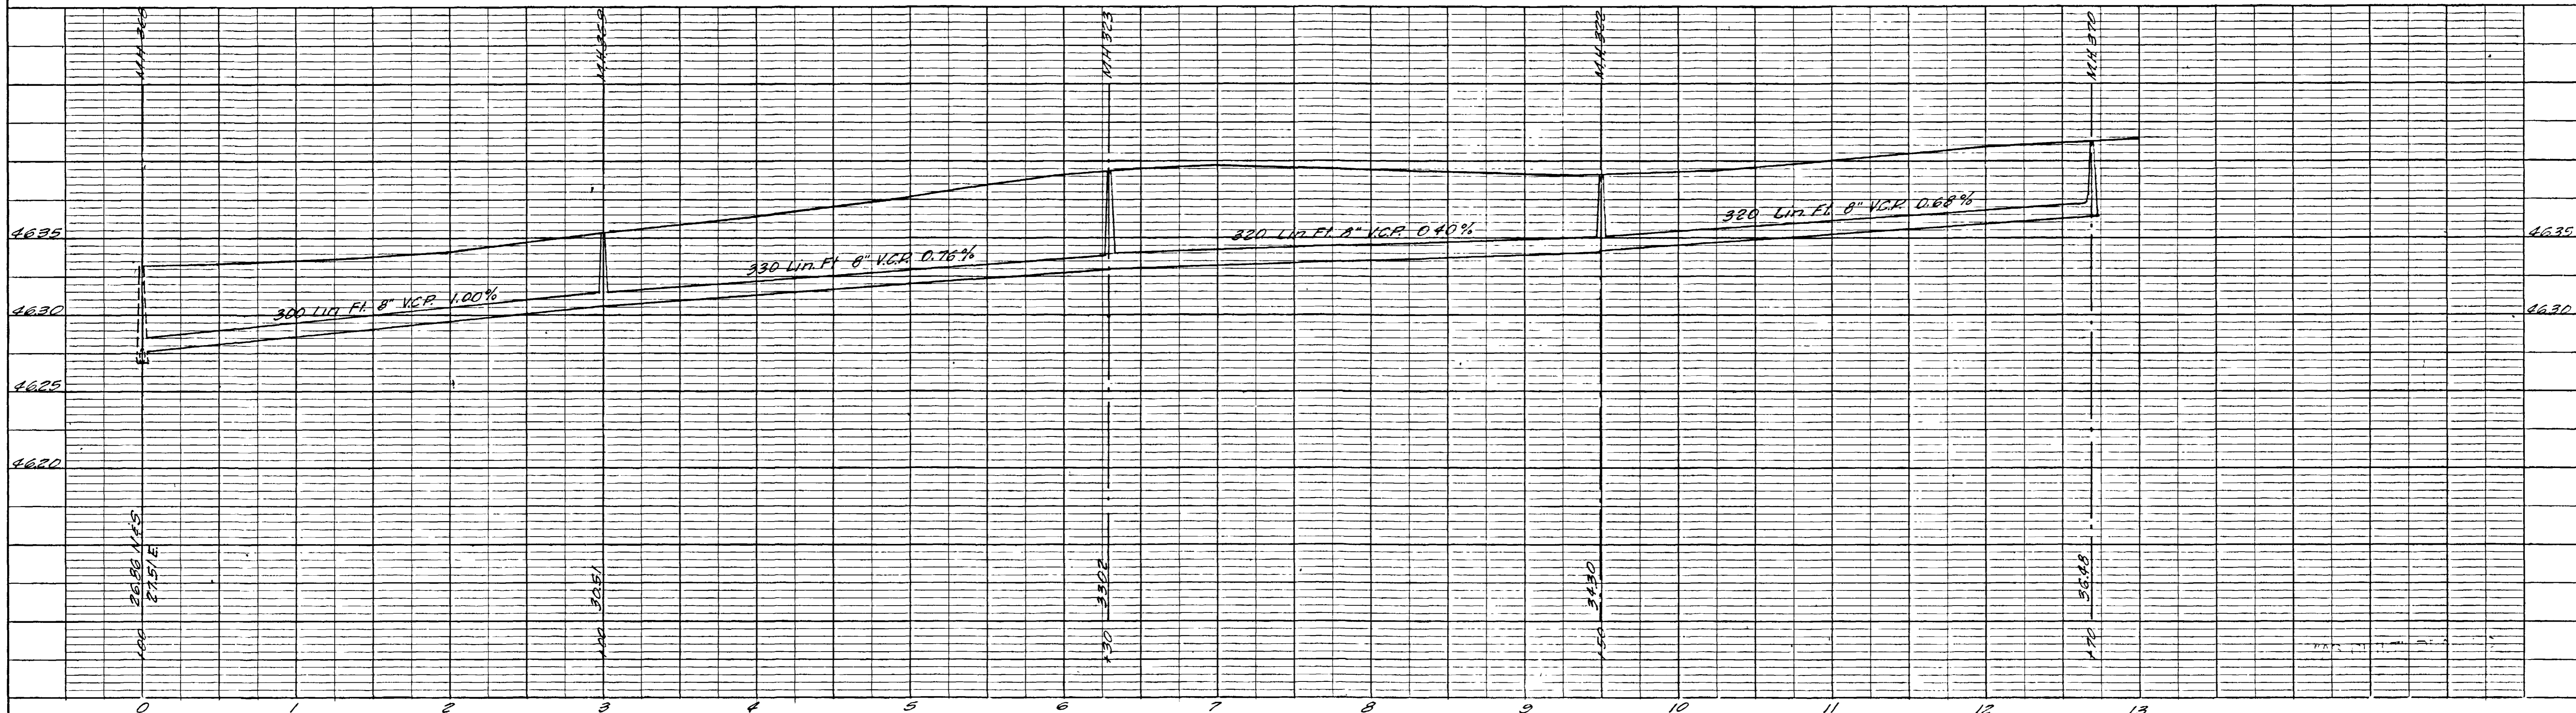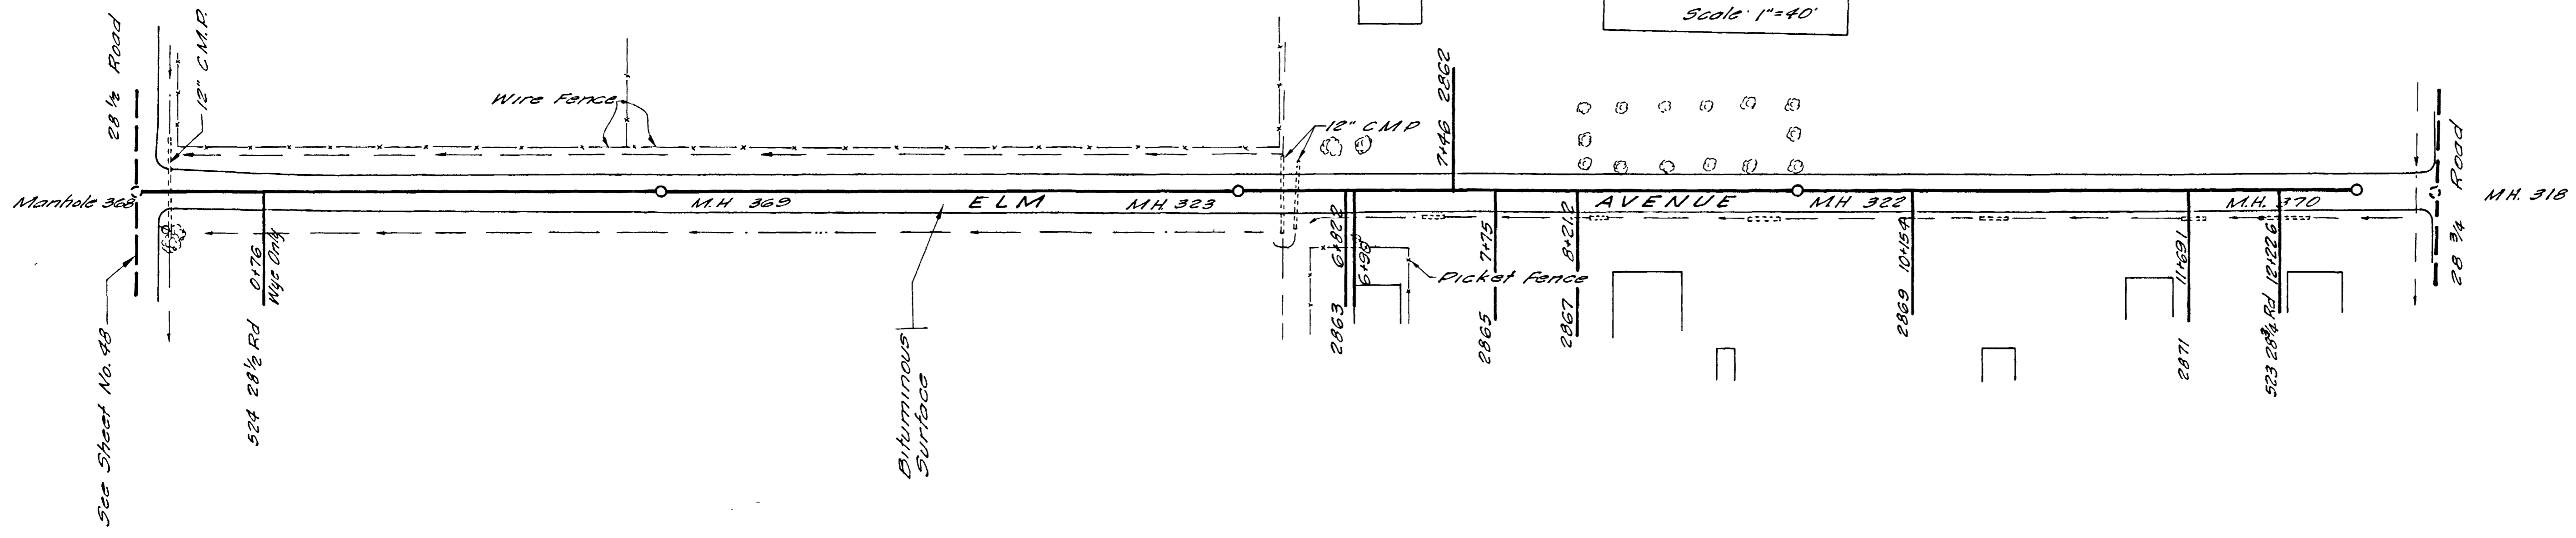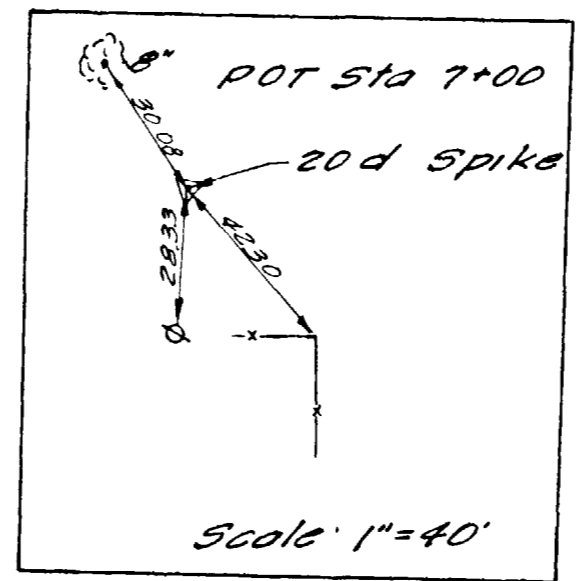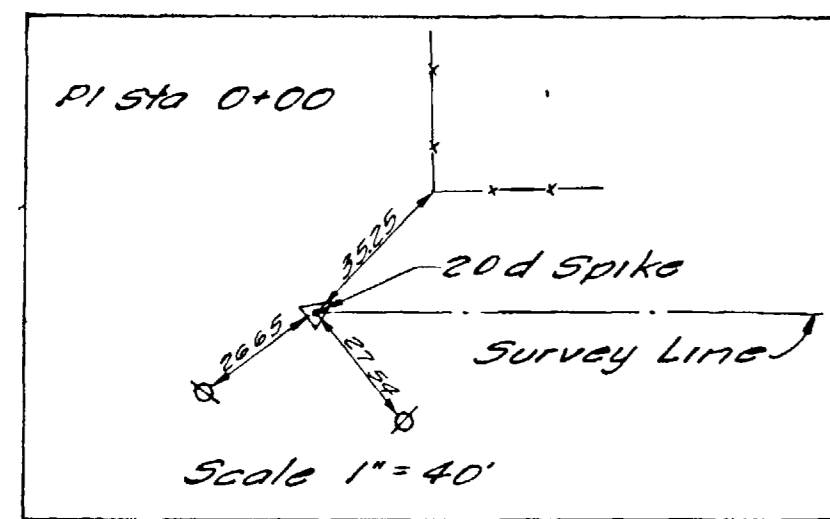

REVISIONS BY: R.L.T. DATE: Feb 1960 DESCR: Grades BY: DATE: DESCR: BY: DATE: DESCR:		DATE: October 1959 DESIGNED: M.S. JOB NO: G-205 CHECKED: H.G.L. FILE NO: SCALE: 1"=50' APPROVED: F.B. NO:		HAROLD HOSKINS & ASSOCIATES ENGINEERING CONSULTANTS GREELEY, COLORADO LINCOLN, NEBRASKA		FRUITVALE, COLORADO WATER & SANITATION DISTRICT		ELM AVENUE STA. 0+00 TO STA. 12+70		66 SHEET NO. 64 SHEETS
----------------------------------------------------------------------------------------------	--	-----------------------------------------------------------------------------------------------------------------	--	-----------------------------------------------------------------------------------------------	--	----------------------------------------------------	--	---------------------------------------	--	---------------------------

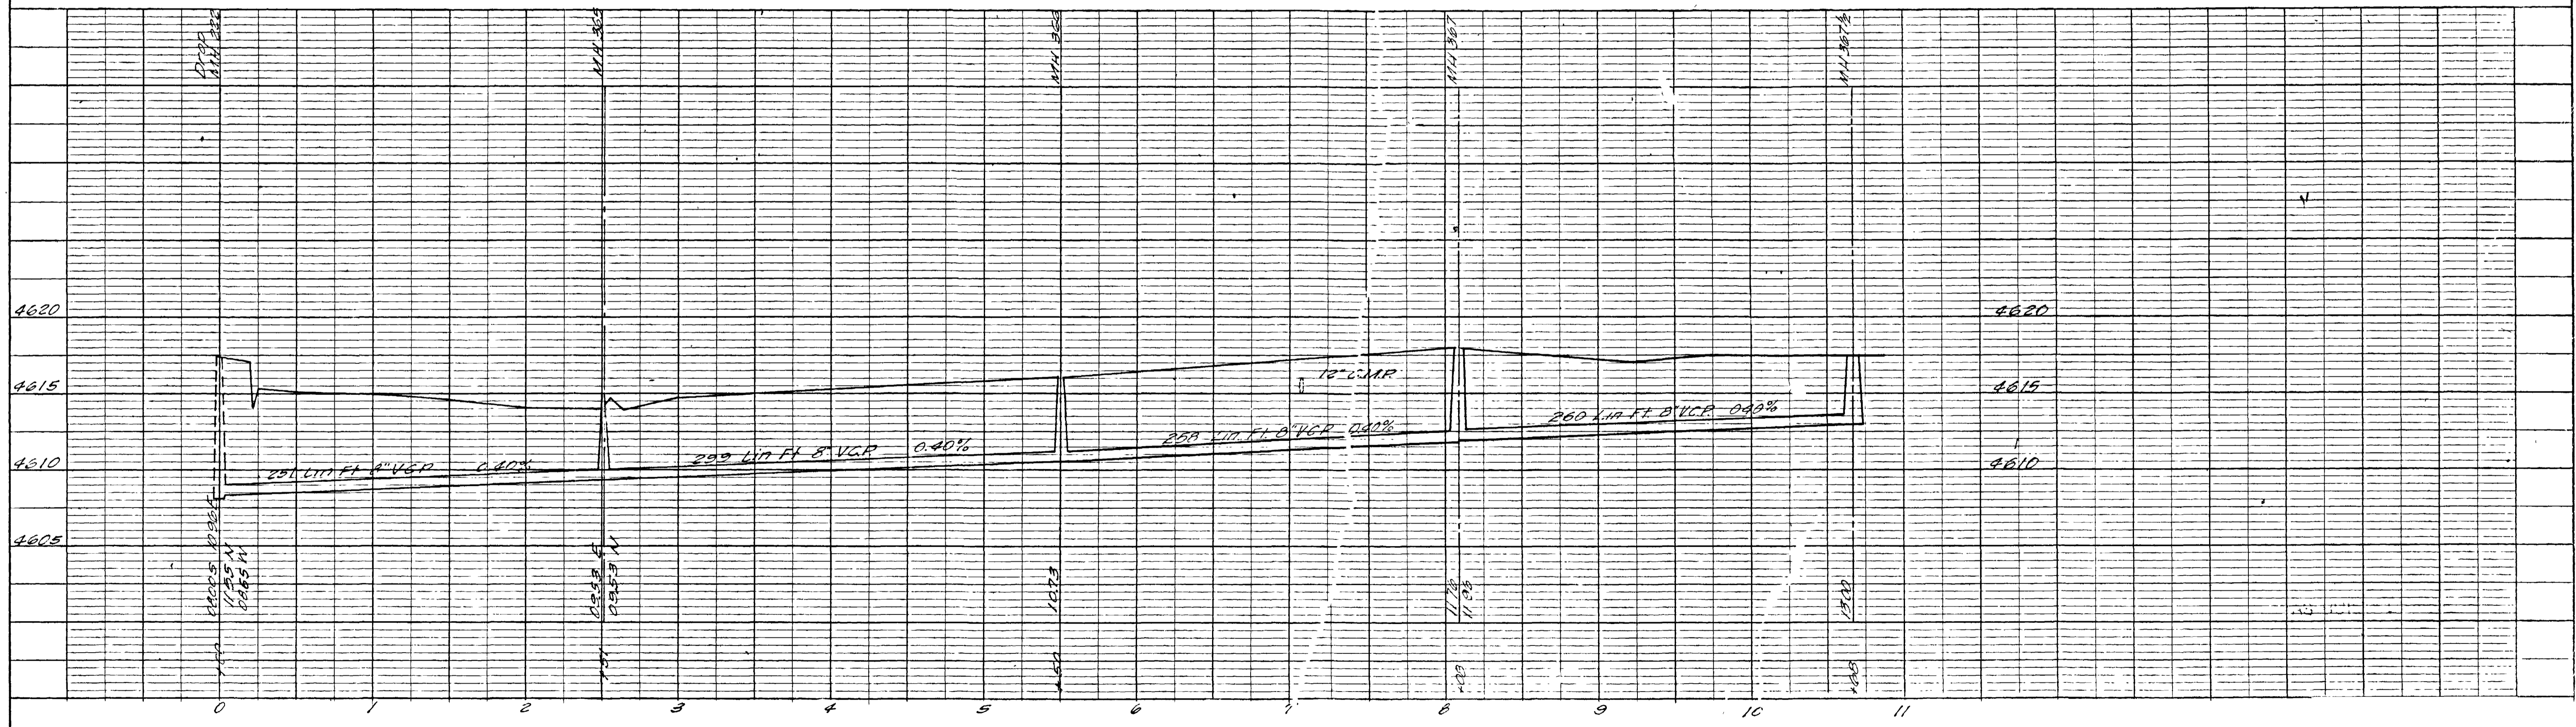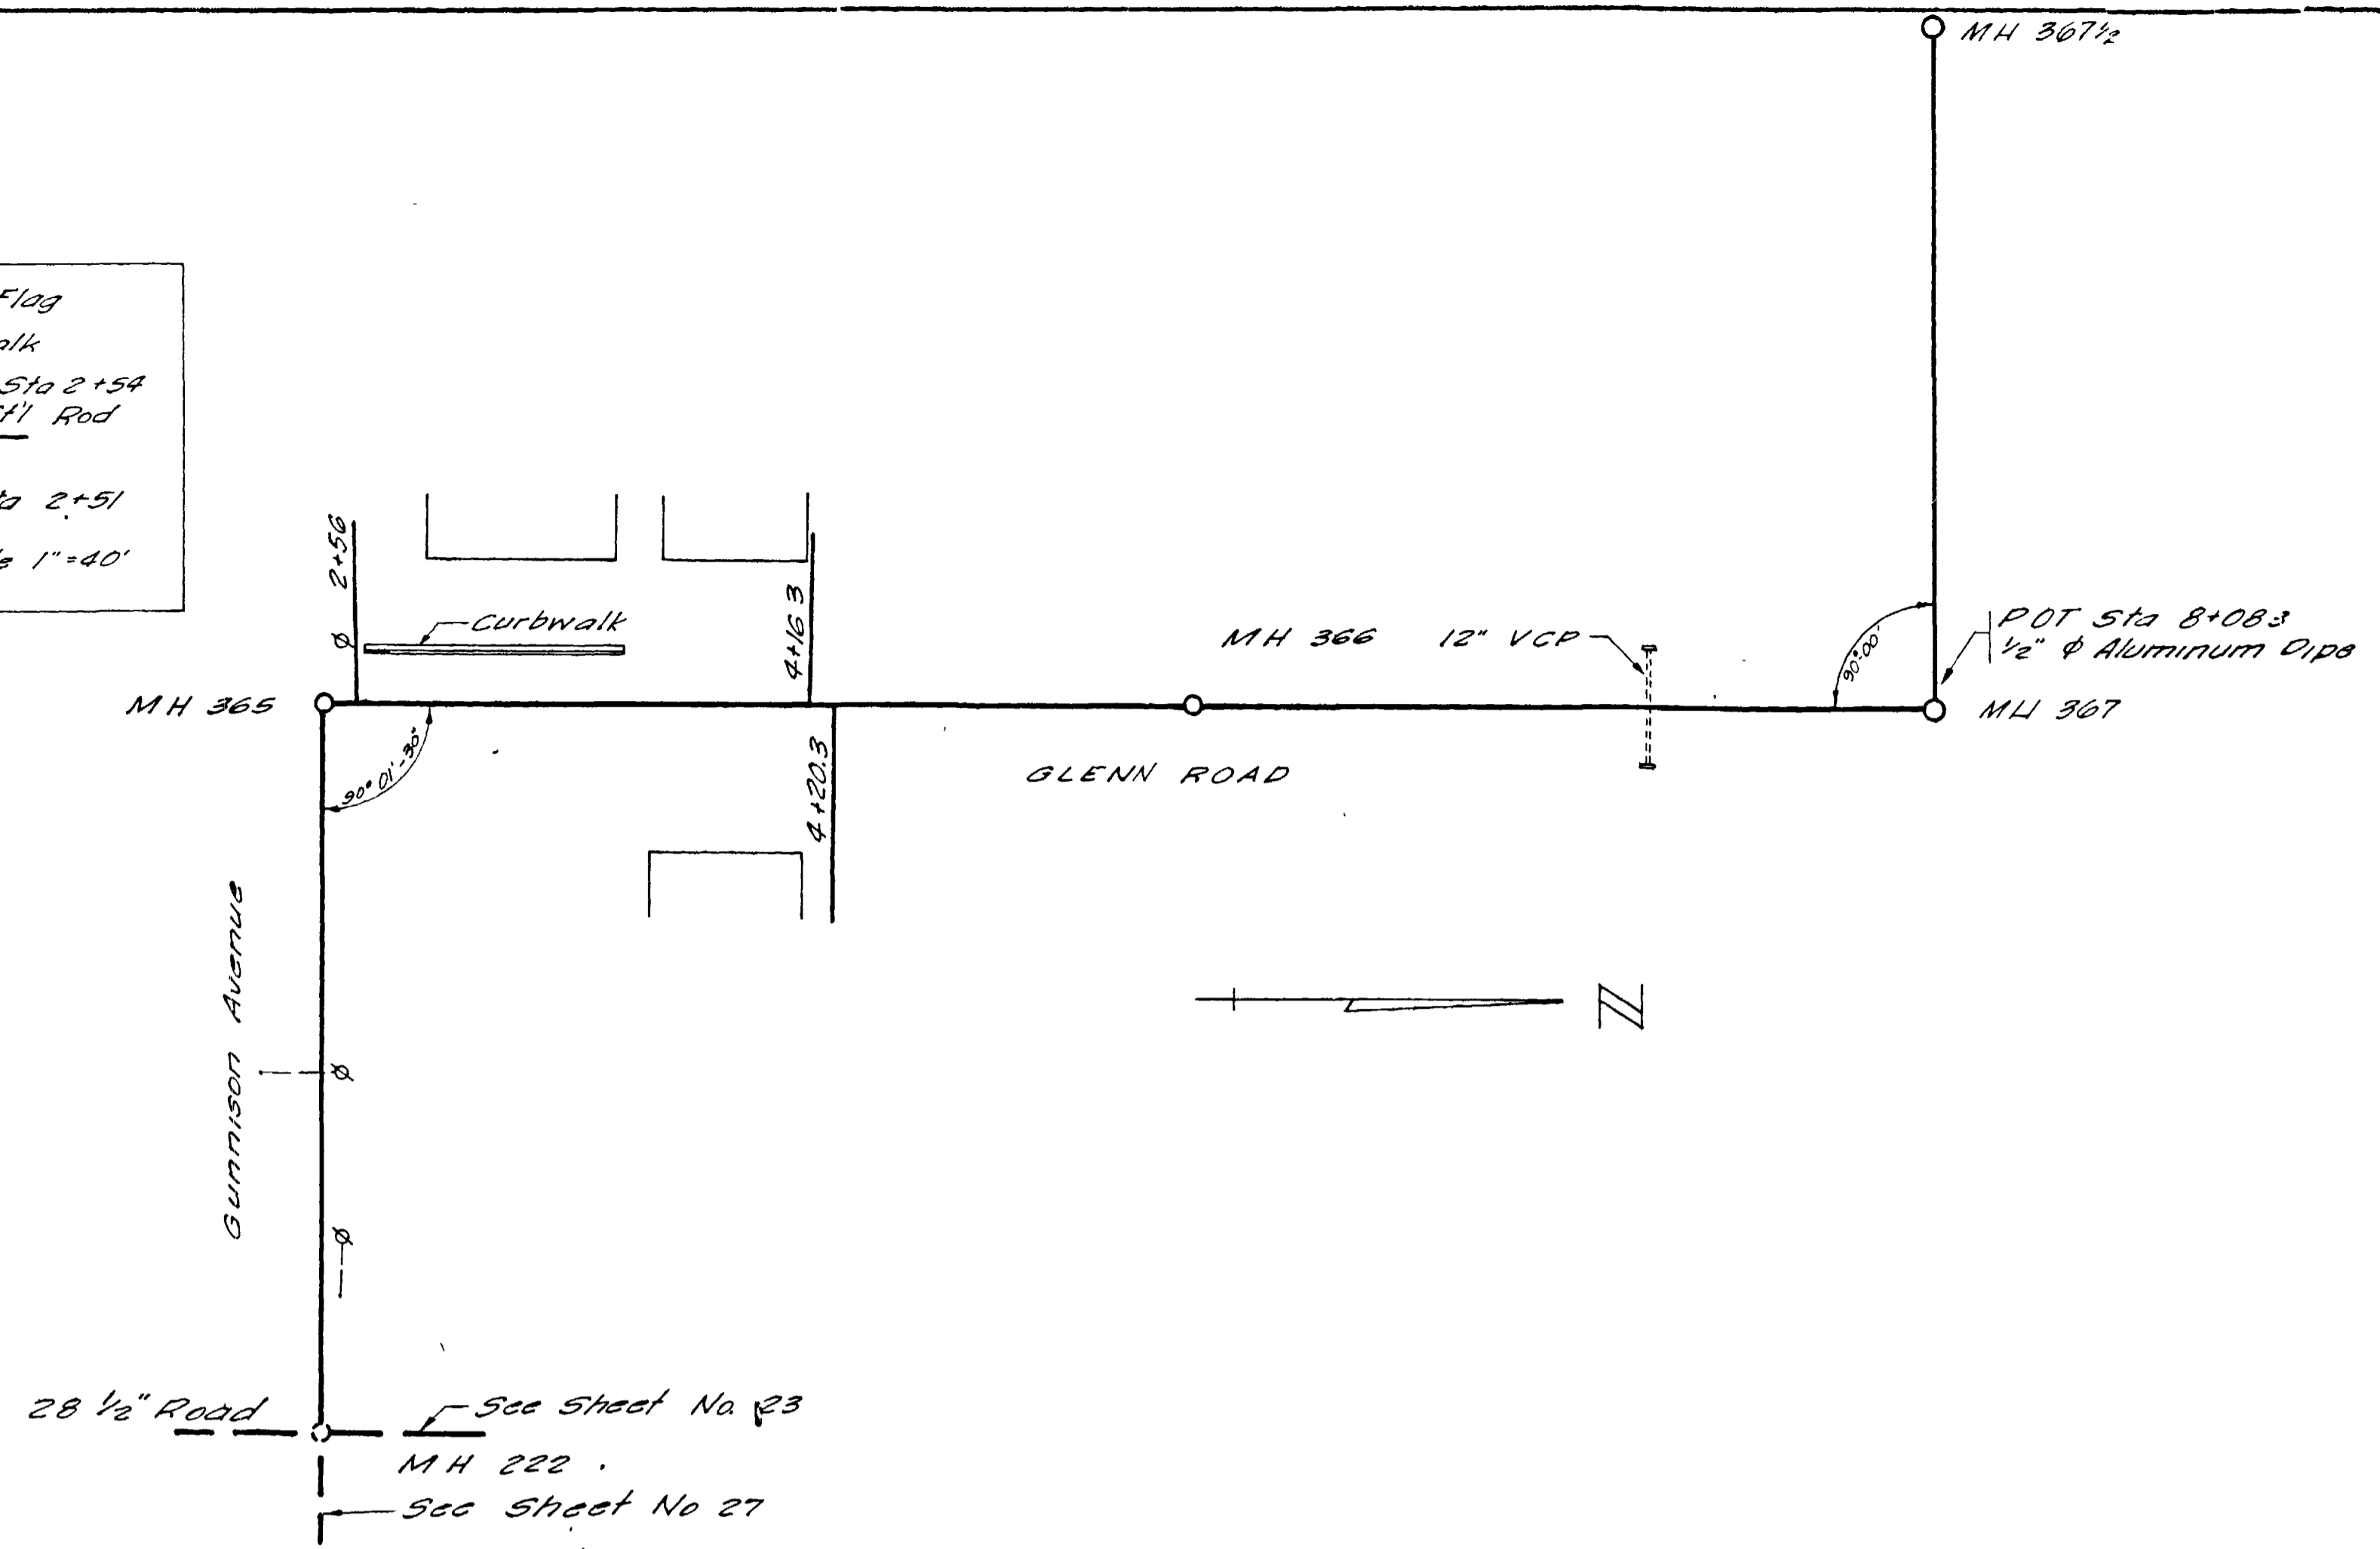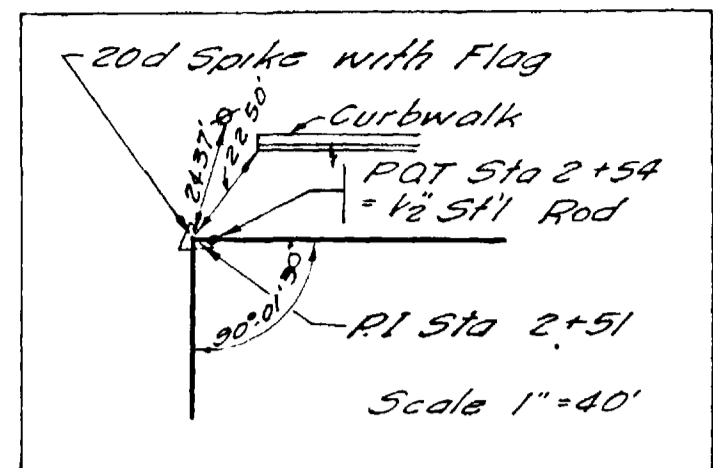

REVISIONS BY RCT. DATE Feb 1960 DESCR Grade DATE DESCR DATE DESCR		DATE October 1959 DESIGNED M.S. CHECKED H.B.U. FILE NO. 6-205 SCALE 1" = 50' APPROVED F.B.N.		HAROLD HOSKINS & ASSOCIATES ENGINEERING CONSULTANTS GREELEY, COLORADO LINCOLN, NEBRASKA		FRUITVALE, COLORADO WATER & SANITATION DISTRICT		GUNNISON AVE. STA 0+00 TO STA. 2+51 GLENN ROAD STA. 2+51 TO STA. 8+08.3		66
----------------------------------------------------------------------------	--	----------------------------------------------------------------------------------------------------	--	-----------------------------------------------------------------------------------------------	--	----------------------------------------------------	--	----------------------------------------------------------------------------	--	----