

MATCHETT

BLM BRASS CAP
E 1/4 CORNER
SECTION 6
T.1S., R.1E.
UTE MERIDIAN

CHASE

DARLA JEAN SUBDIVISION

GENERAL NOTES:

- CONSTRUCTION SHALL BE IN ACCORDANCE WITH CENTRAL GRAND VALLEY SANITATION DISTRICT STANDARDS AND SPECIFICATIONS.
- STEPS WILL BE REQUIRED IN ALL MANHOLES.

INFILTRATION CERTIFICATE


THIS IS TO CERTIFY THAT BANNER ASSOCIATES, INC. REVIEWED THE SANITARY SEWER EXTENSION AT 29 RD. AND F 1/2 RD. AND FOUND THAT THE GROUND WATER INFILTRATION DID NOT EXCEED THE MAXIMUM ALLOWABLE RATE AS DETAILED IN THE CITY OF GRAND JUNCTION CONSTRUCTION SPECIFICATIONS.

Edward E. Chas. REGISTERED PROFESSIONAL ENGINEER
BANNER ASSOCIATES, INC. DATE 6-18-90



LEGEND

- POWER POLE & OVERHEAD LINES
- UTILITY PEDESTAL
- WATERLINE
- NATURAL GASLINE
- BURIED TELEPHONE CABLE
- SAN. SEWER SERVICE
- FENCELINE
- EDGE OF ASPHALT
- IRRIGATION DITCH
- BURIED IRRIG. LINE & VALVE
- PROPERTY P.W. & PROPERTY LINE
- BARE REBAR

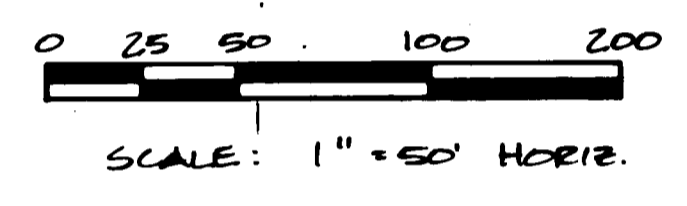

4730
4720
4710
4700
4690

4730
4720
4710
4700
4690

5' STUB FOR FUTURE EXTENSION
I.W. = 4718.10

MH-C3
6+92.2
RIM = 4724.93
I.W. = 4717.98
I.W. OUT = 4717.88

543 L.F. 8" & PVC @ 1.54%

MH-C2
3+49.0
RIM = 4718.15
I.W. = 4712.61
I.W. OUT = 4712.53

349 L.F. 8" & PVC @ 0.85%

MH-1
0+00.00
RIM = 4715.17
I.W. = 4704.46
I.W. DROP = 4704.46
I.W. OUT = 4703.6

CONSTRUCTION DRAWING
OF RECORD
JUNE 4, 1990

Drawn By: DEC	APPROVED: DATE _____ FOR _____
Checked By: DEC	REVIEWED: DATE _____ FOR BANNER ASSOCIATES, INC.

BANNER
CONSULTING ENGINEERS & ARCHITECTS
1000 W. 10TH AVENUE, SUITE 100
DENVER, CO 80202

REVISION	DATE	DESCRIPTION	MADE	APPR
#1	10-16	ADD ADDITIONAL NOTES AND EASEMENT	DEC	DEC
#2	11-29	REVISE GRADES & LVERTS	DEC	DEC
#3	6-18-90	ADJUST PER AS-CONSTRUCTED	DEC	DEC

Edwin D. CHASE
Grand Junction, Colorado
SANITARY SEWER EXTENSION
29 ROAD & F 1/2 ROAD

Scale: 1" = 50' HORIZ. 1" = 10' VERT.	Project No. 8901C
Date: June 18, 1990	Sheet No. 1 OF 1