

NOTE: TAP LOCATIONS SHOWN ARE FROM CITY OF GRAND JUNCTION T.V. REPORT



REVISION	DESCRIPTION	DATE	DRAWN BY	CAK	DATE	8/91

SCALE	
PLAN	PROFILE
HORIZ. 1"=30'	HORIZ. _____
VERT. _____	VERT. _____

**CENTURY SURVEYING**  
 P.O. BOX 356  
 GRAND JUNCTION, COLORADO

**CAMBRIDGE SUBDIVISION**  
**SEWERLINE PLAN AS-BUILT**  
 Plan Sheet

SHEET NO. 1
OF 2
FILE NO.

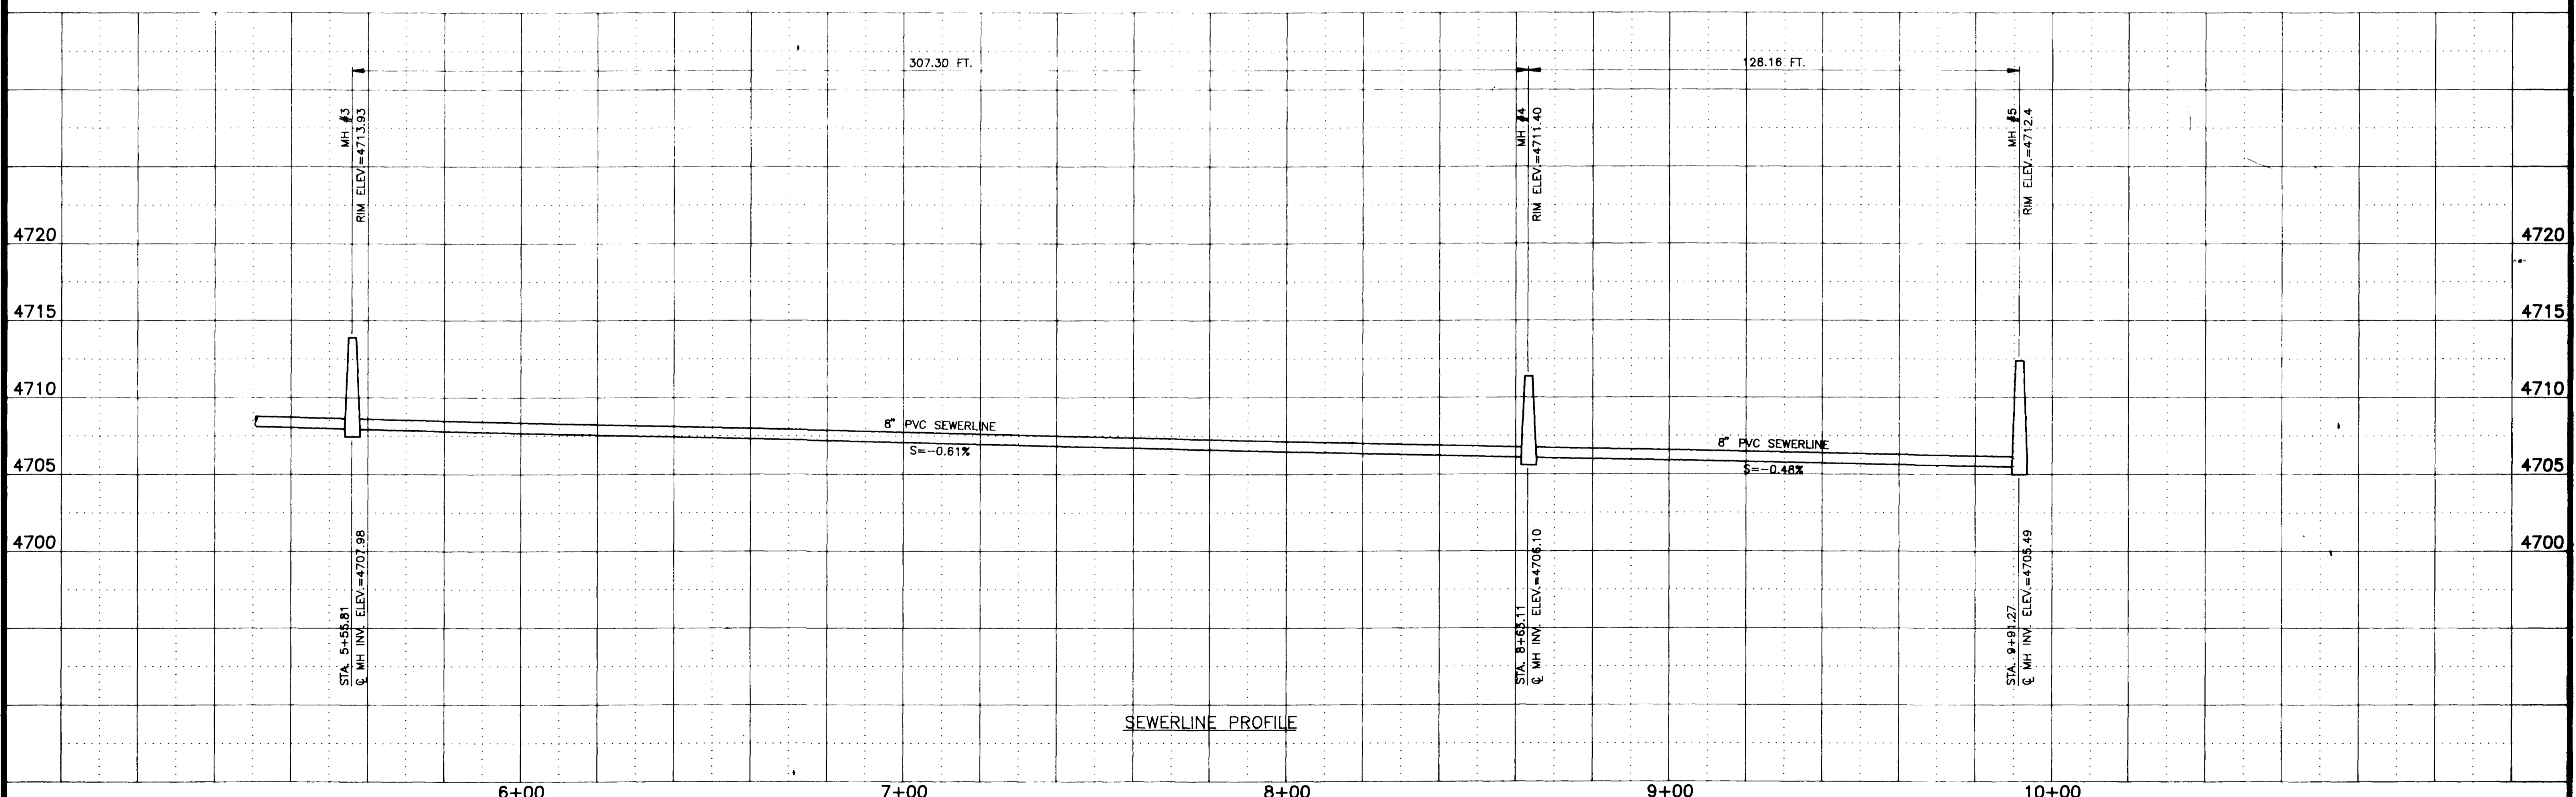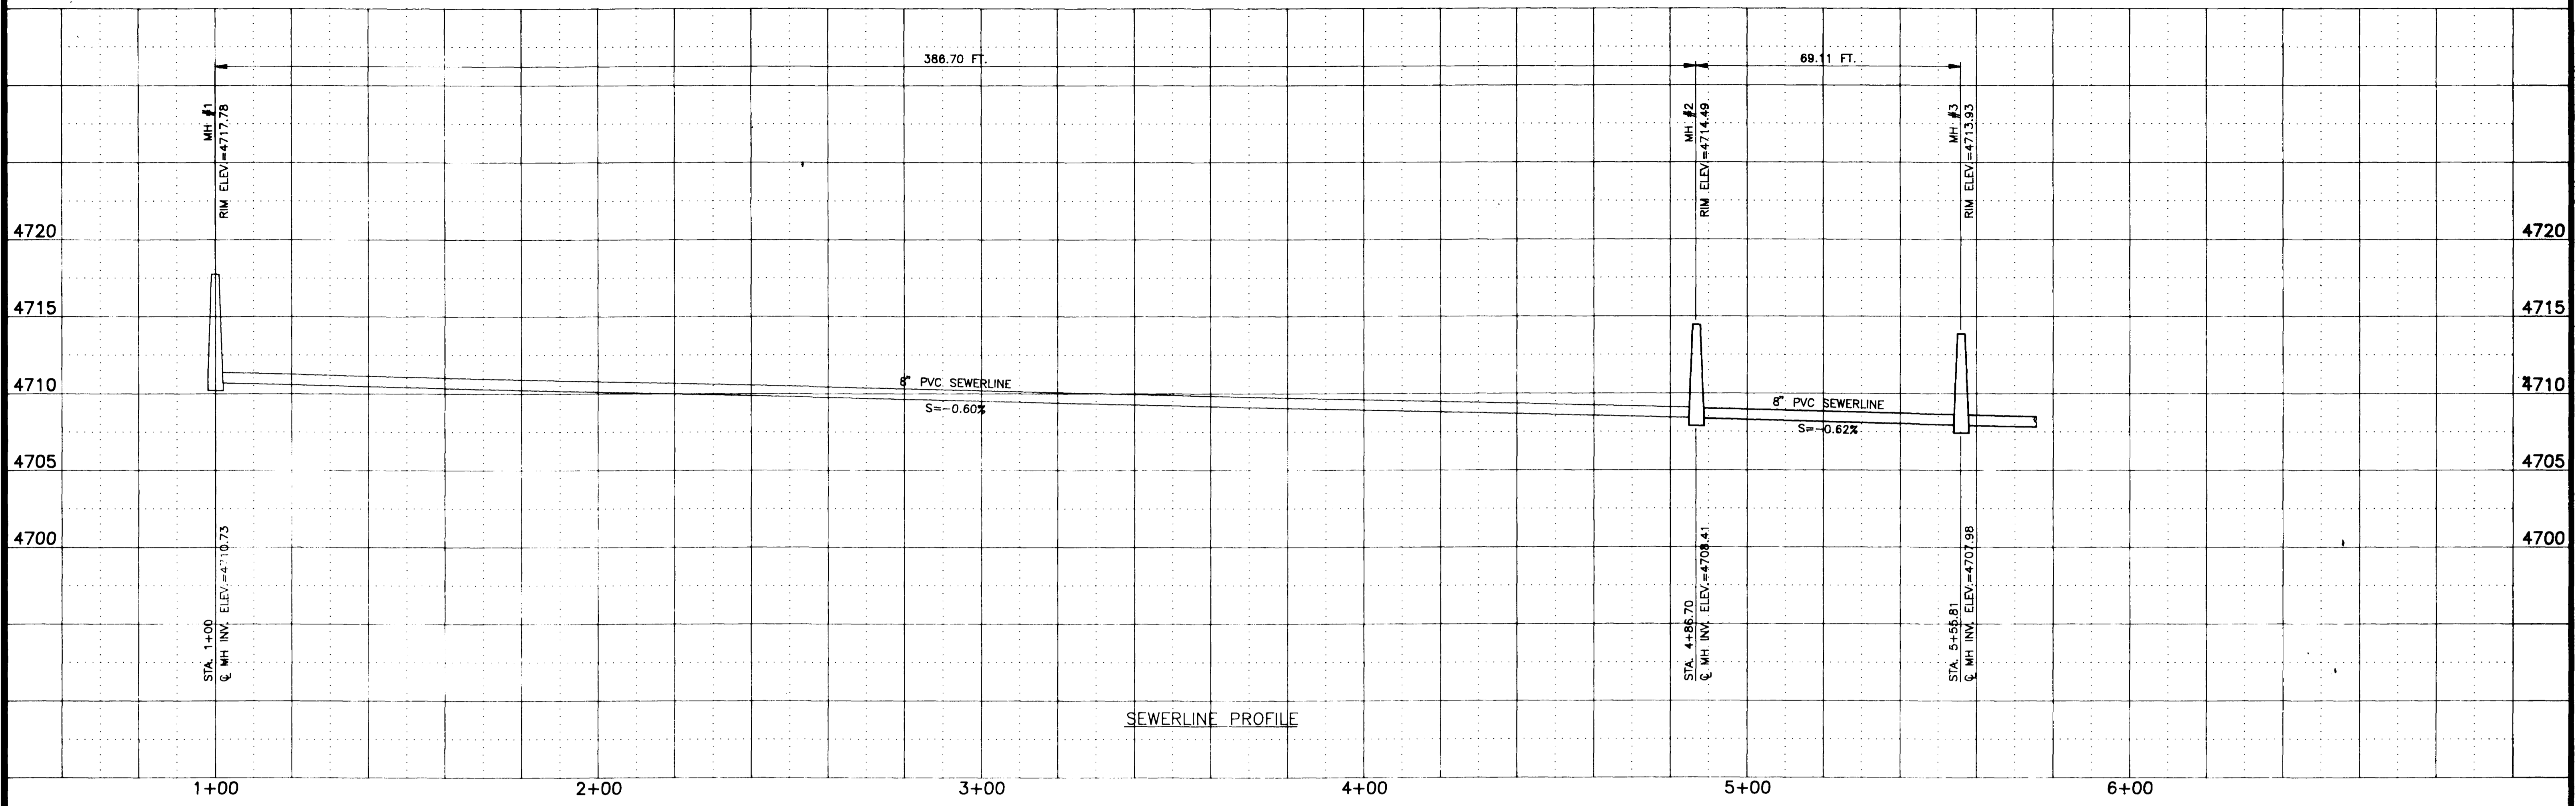

<b>DESCRIPTION</b>	<b>DATE</b>	DRAWN BY <u>CAK</u>	DATE <u>8/91</u>	<b>SCALE</b>	<b>CENTURY SURVEYING</b>	<b>CAMBRIDGE SUBDIVISION</b>
REVISION _____		CHECKED BY _____	DATE _____	PLAN _____ PROFILE _____	P.O. BOX 356	SEWERLINE PROFILE AS-BUILT
REVISION _____		APPROVED BY _____	DATE _____	HORIZ. _____ HORIZ. 1"=20'	GRAND JUNCTION, COLORADO	Profile Sheet
REVISION _____		FIELD BOOK NO. _____	PAGE _____	VERT. 1"=5'		SHEET NO. <u>2</u>
						OF <u>2</u>
						FILE NO. _____