
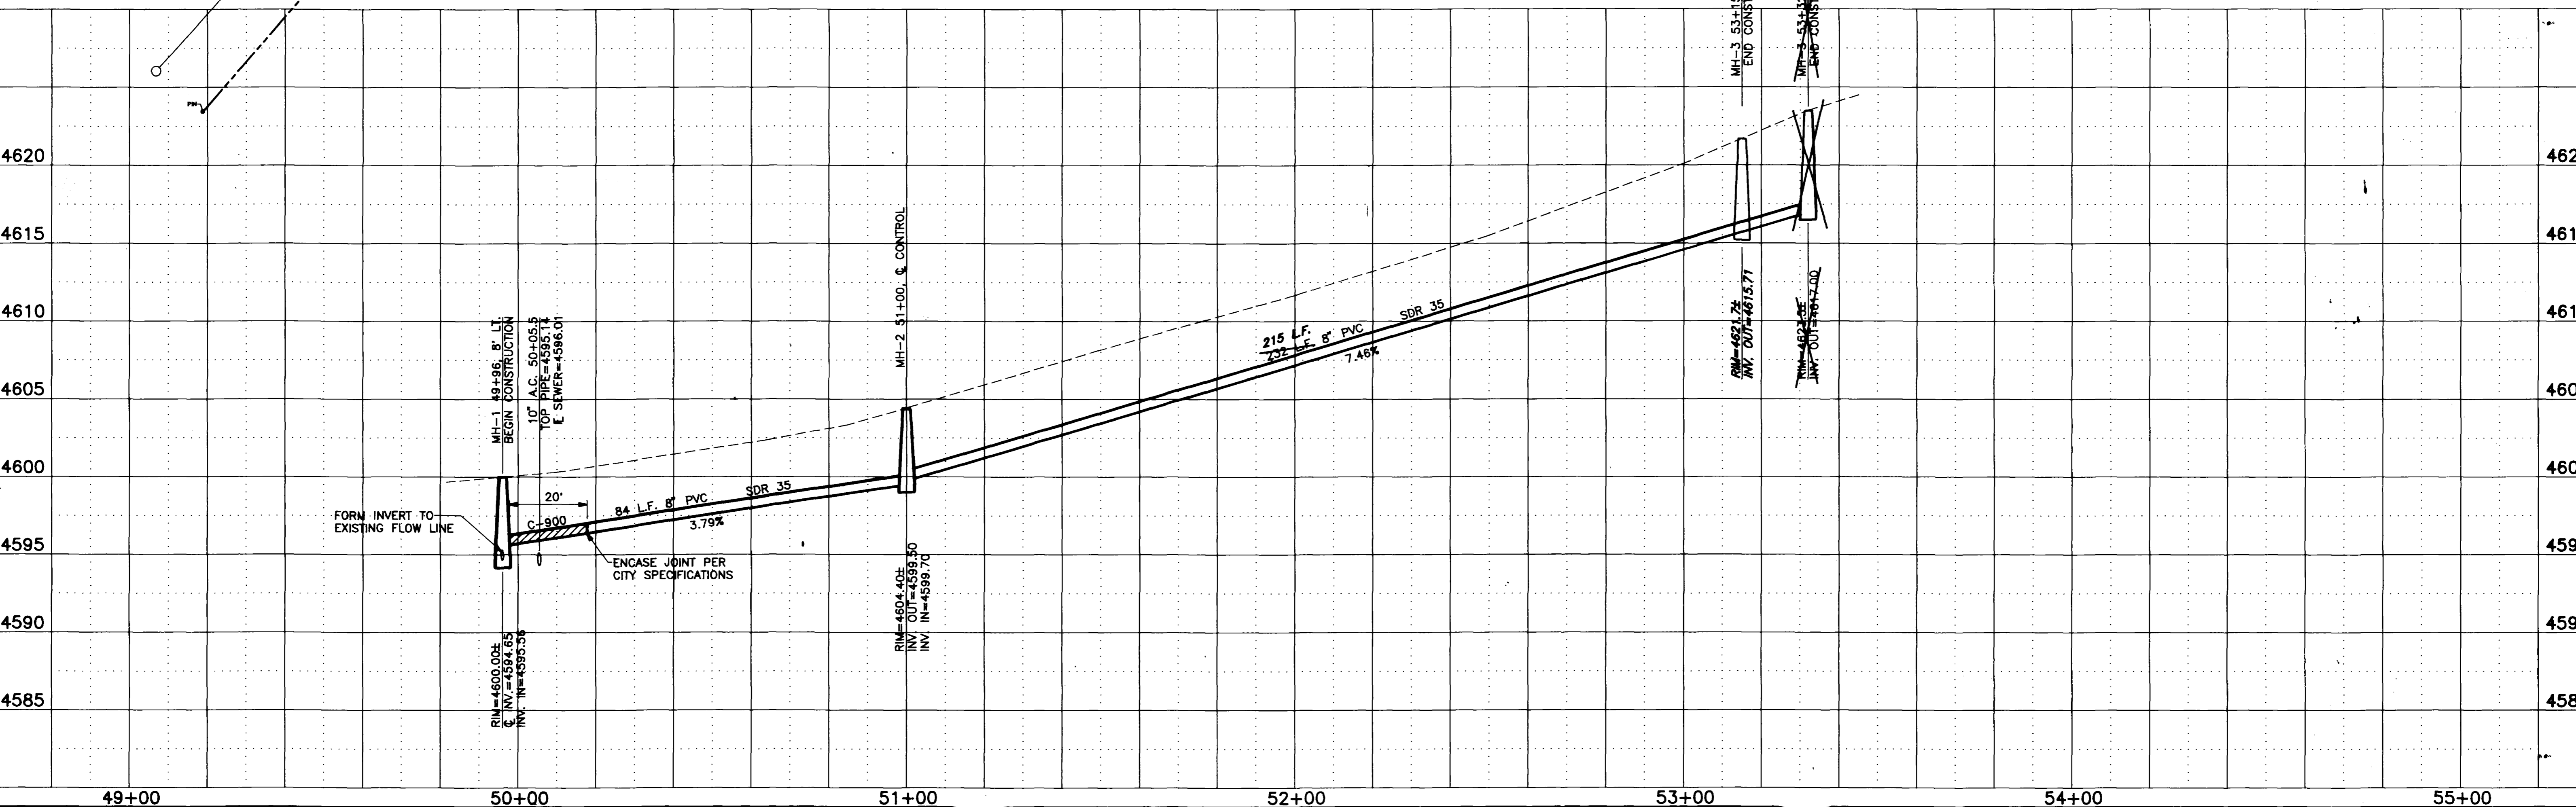
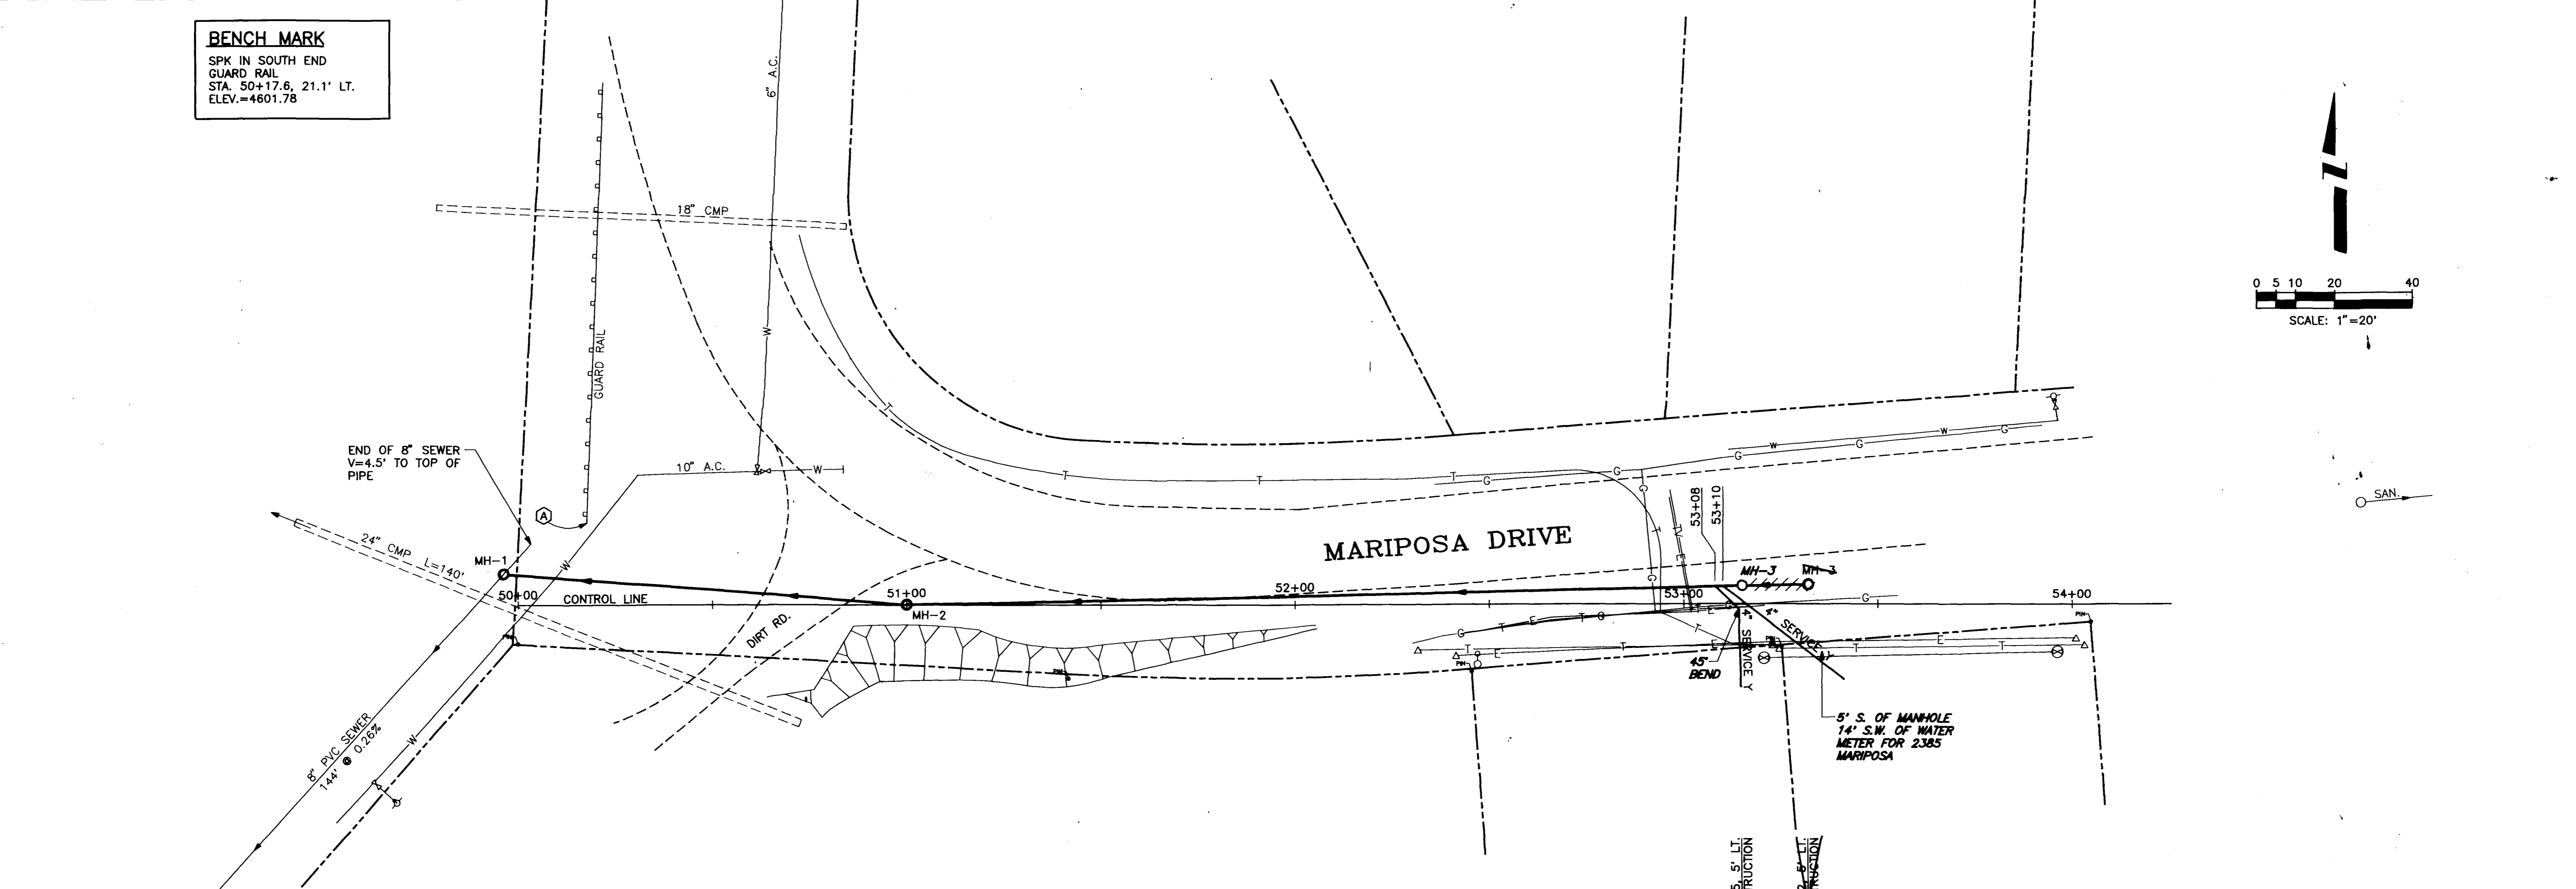


**BENCH MARK**  
 SPK IN SOUTH END  
 GUARD RAIL  
 STA. 50+17.6, 21.1' LT.  
 ELEV.=4601.78

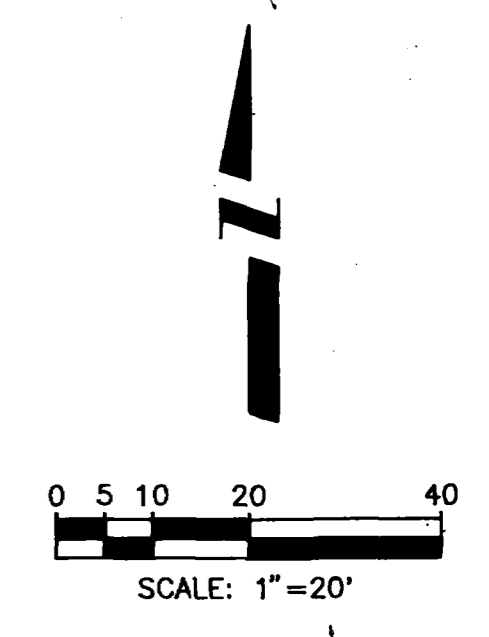

REVISION	DESCRIPTION	DATE
AS-BUILT, C.A.K.		02/02/04

DRAWN BY	C.A.K.	DATE	11/12/93
CHECKED BY	B.C.	DATE	
APPROVED BY	B.C.	DATE	
FIELD BOOK NO.		PAGE	

SCALE	
PLAN	PROFILE
HORIZ. 1"=20'	HORIZ. 1"=20'
	VERT. 1"=5'

DEPARTMENT OF PUBLIC WORKS AND UTILITIES  
 ENGINEERING DIVISION  
 CITY OF GRAND JUNCTION, COLORADO

SANITARY SEWER EXTENSION  
 MARIPOSA DRIVE IN THE RIDGES  
 Plan & Profile

SHEET NO.	1
OF	1
FILE NO.	MARIPOSA.DWG