


# NORTHRIDGE SEWER EXTENSION

1993

- 1. Cover Sheet
- 2.-3. Plan & Profile Sheets

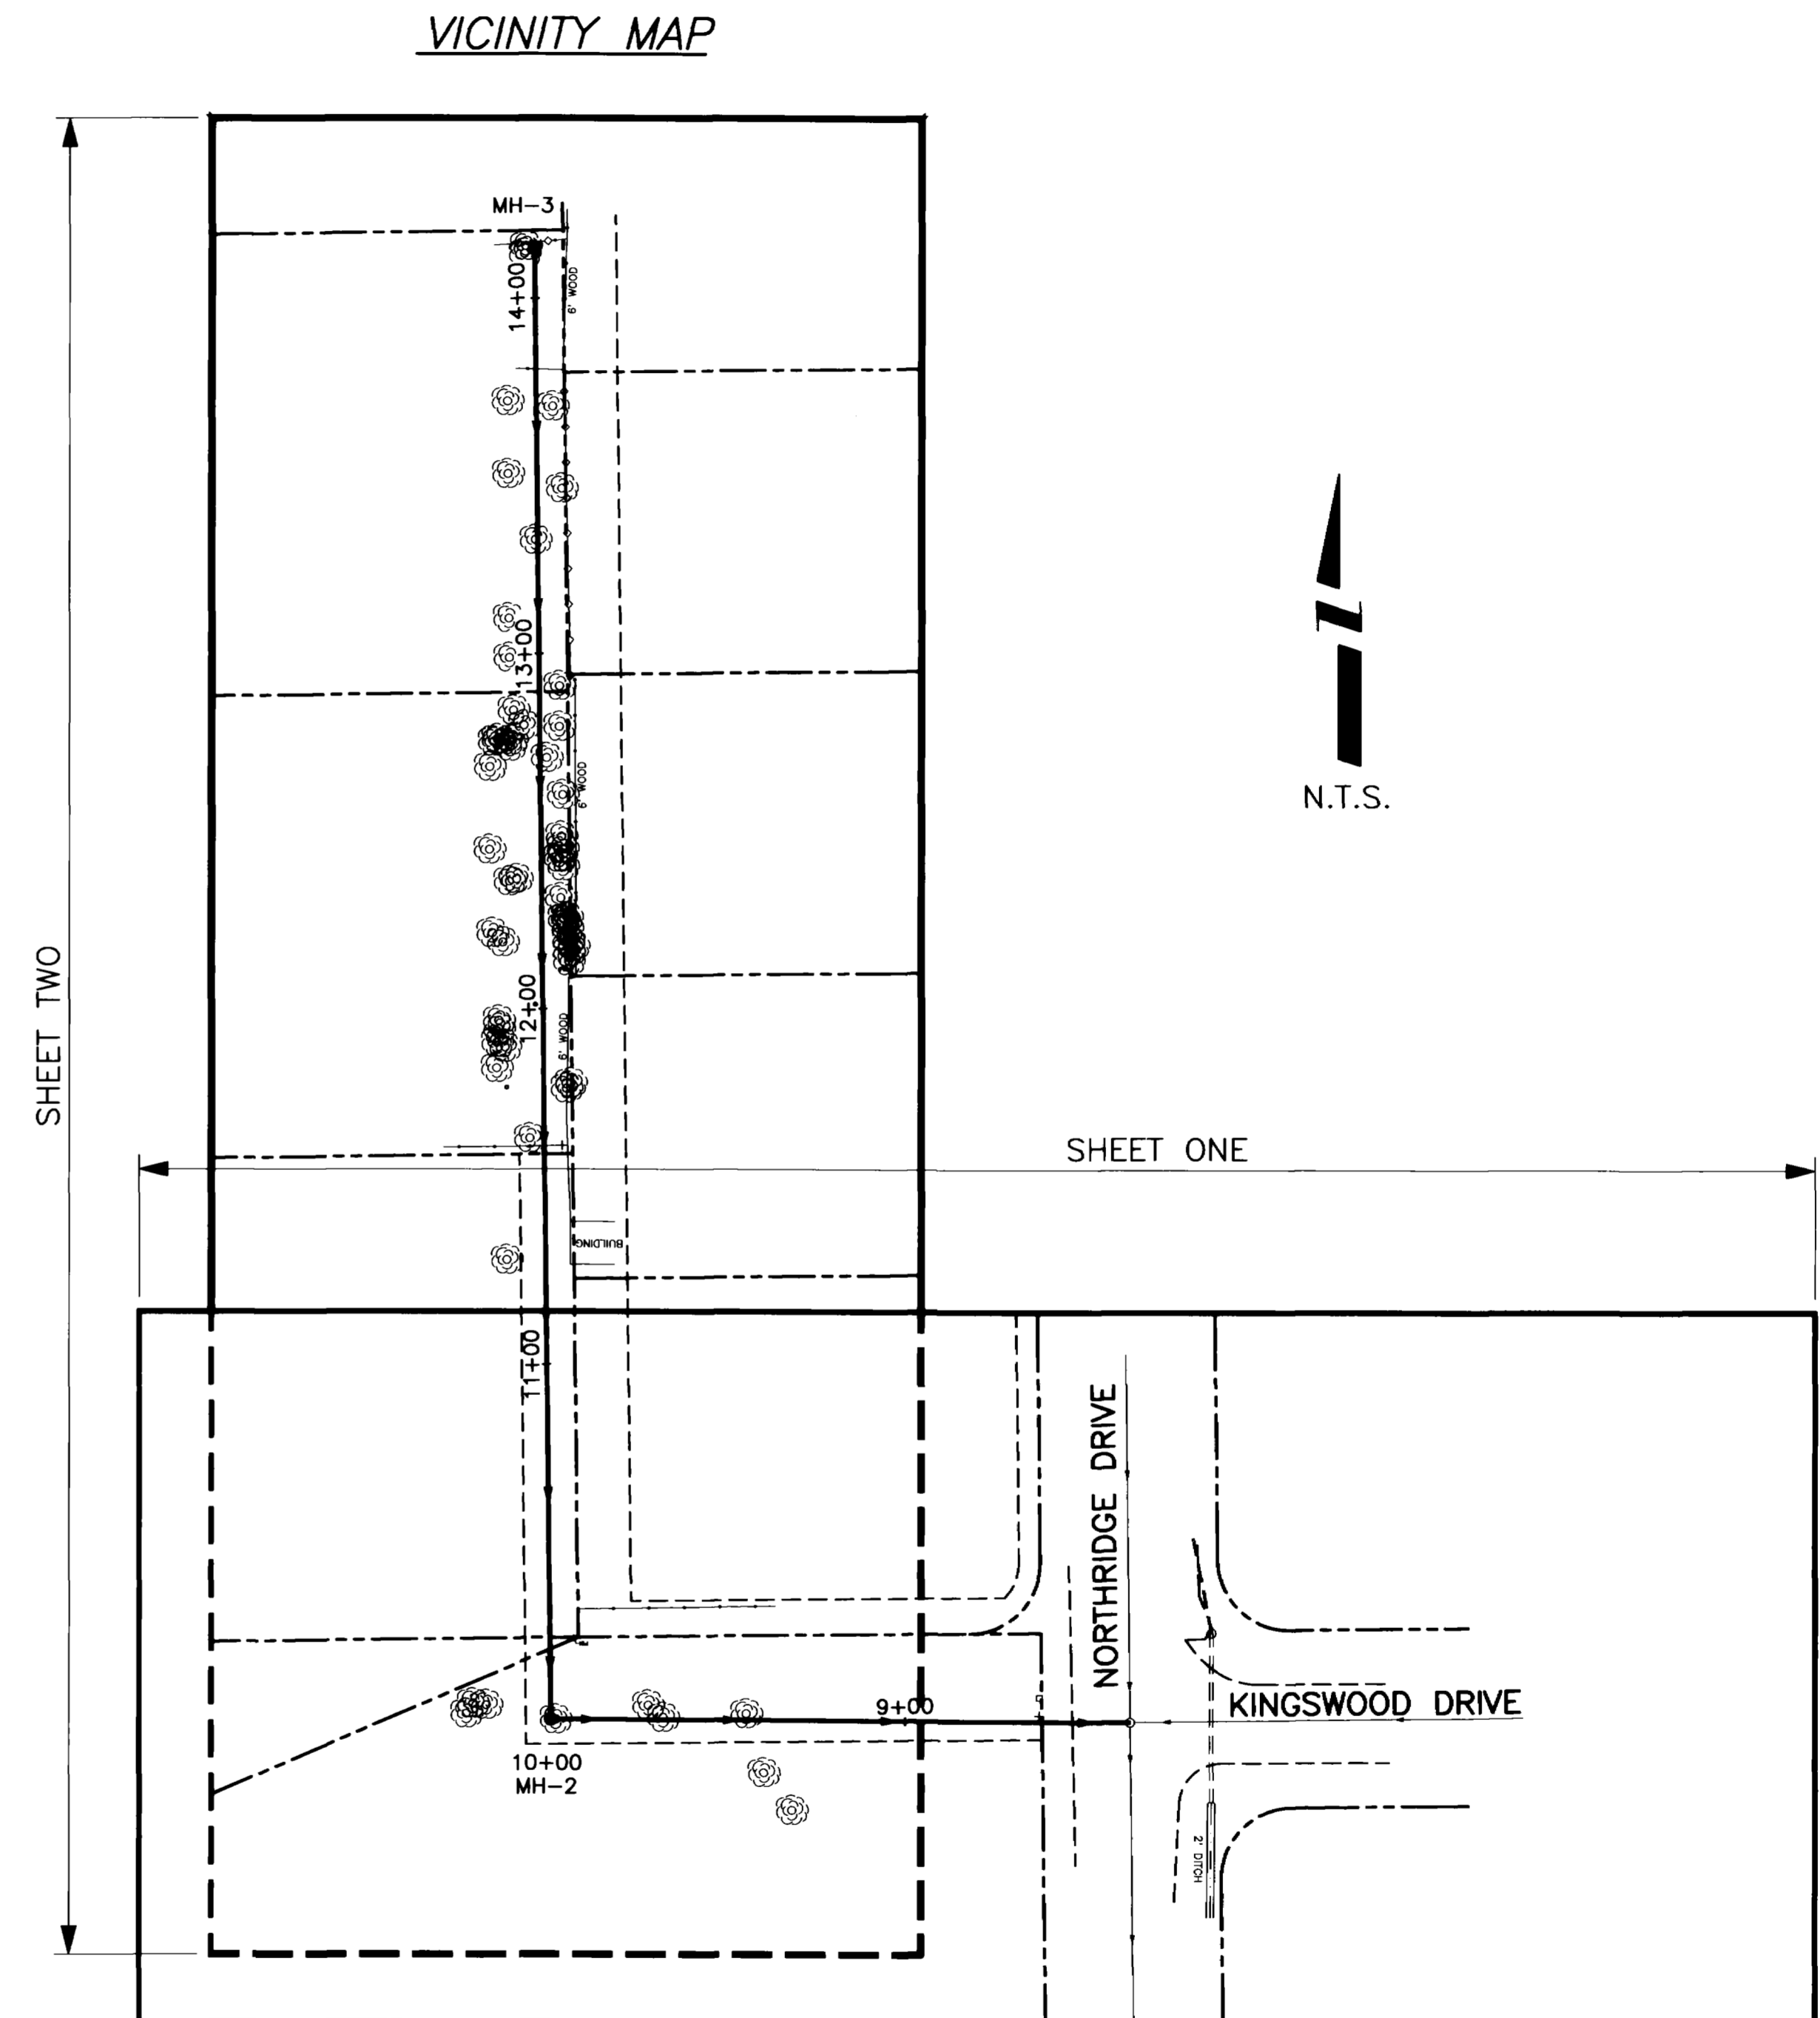




AS CONSTRUCTED

2-10-95

*City of Grand Junction, Colorado*

*Department of Public Works & Utilities*

*Engineering Division*

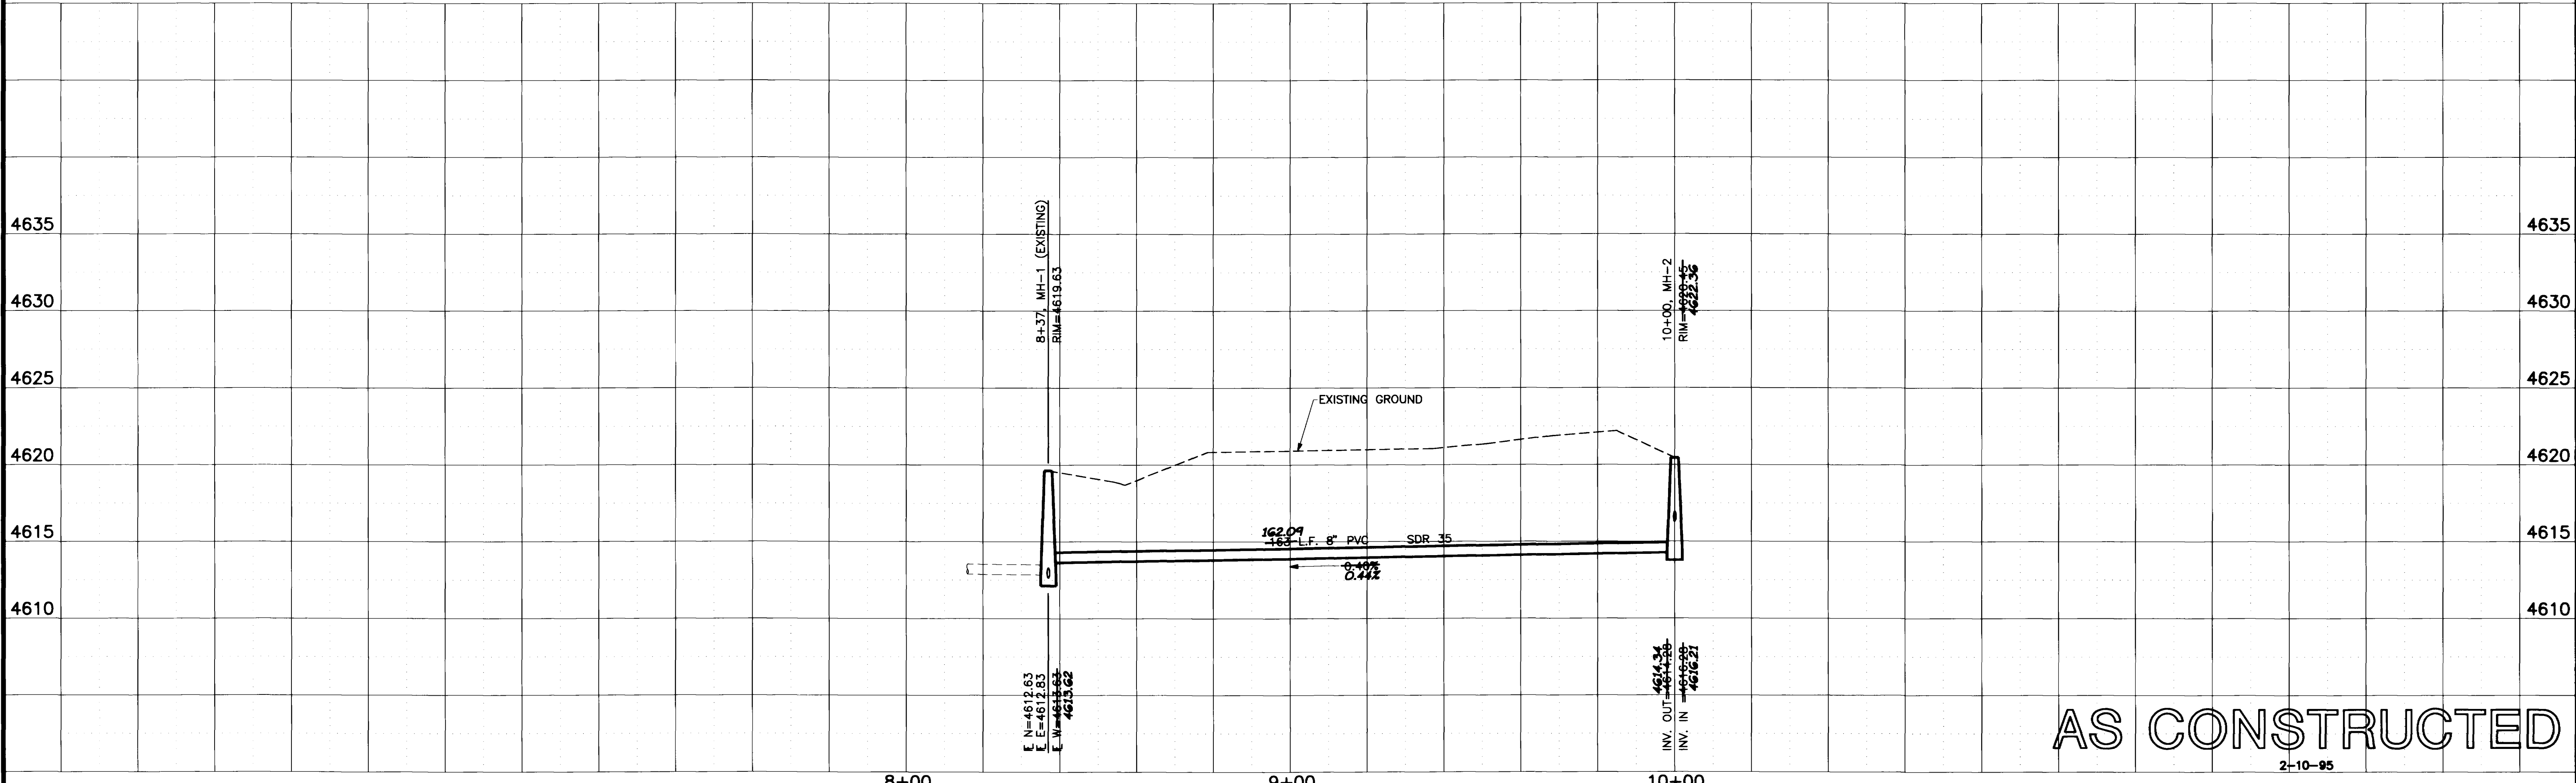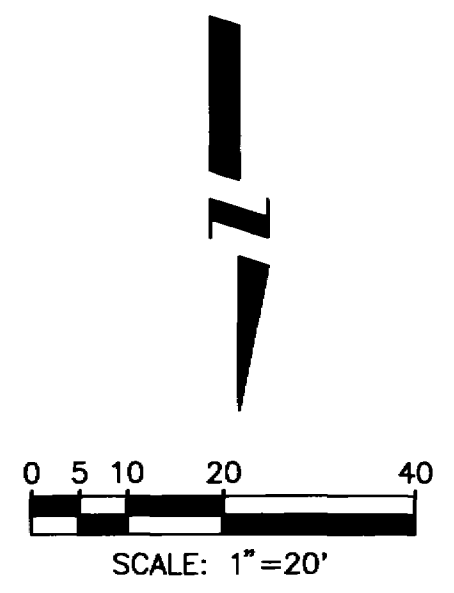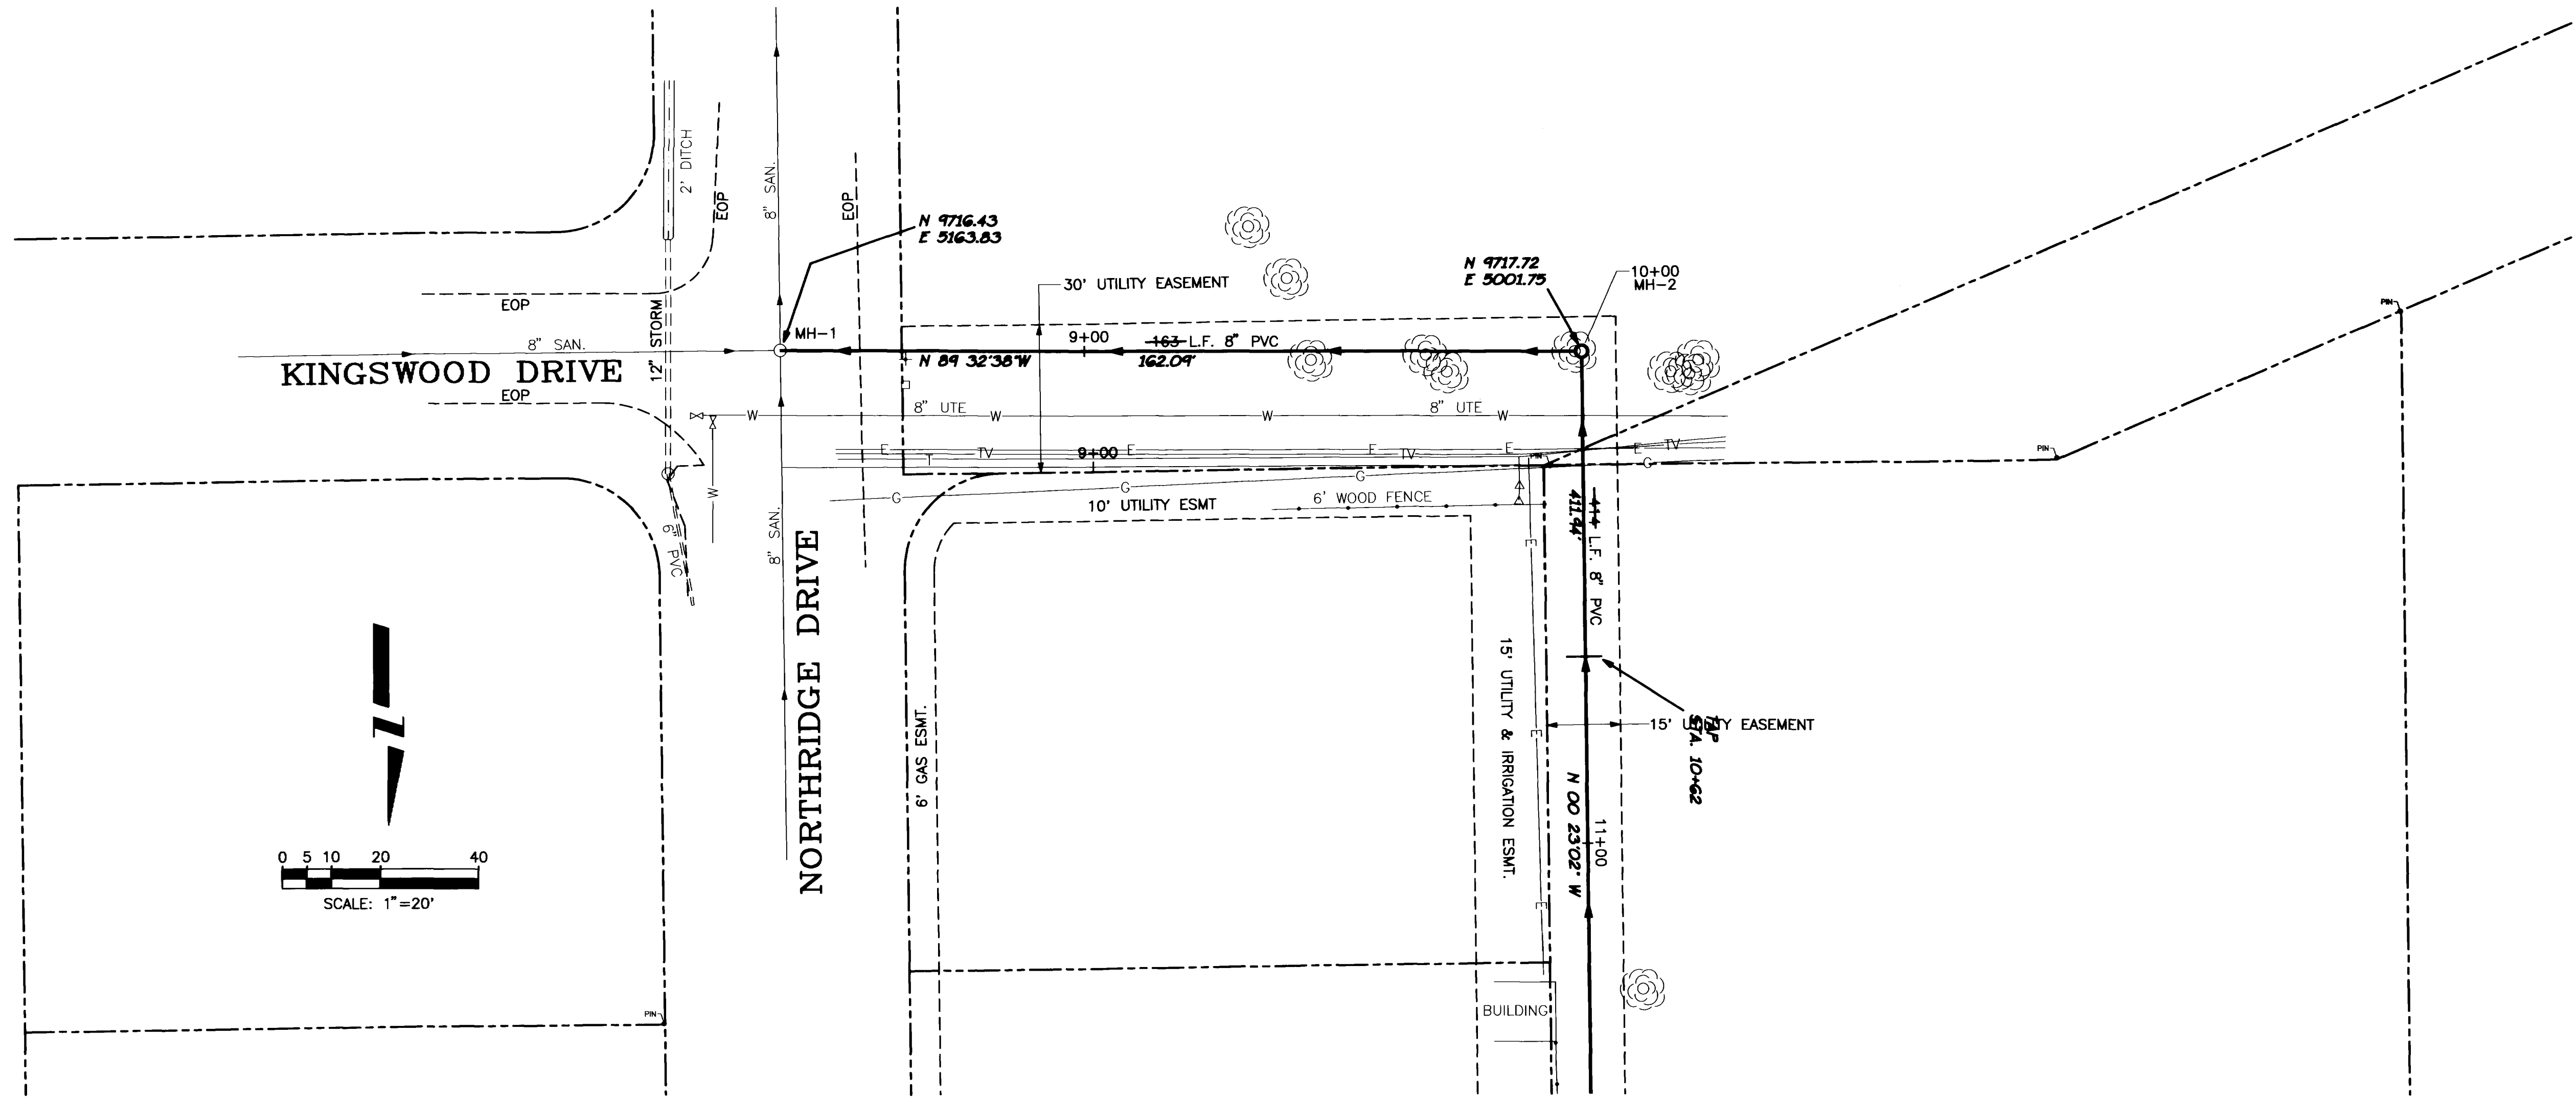




AS CONSTRUCTED

|             |      |                |        |      |          |
|-------------|------|----------------|--------|------|----------|
| DESCRIPTION | DATE | DRAWN BY       | C.A.K. | DATE | 11/17/93 |
| REVISION    |      | CHECKED BY     | B.C.   | DATE |          |
| REVISION    |      | APPROVED BY    | B.C.   | DATE |          |
| REVISION    |      | FIELD BOOK NO. |        | PAGE |          |

DEPARTMENT OF PUBLIC WORKS AND UTILITIES  
ENGINEERING DIVISION  
CITY OF GRAND JUNCTION, COLORADO

NORTHRIDGE SEWER LINE  
EXTENSION  
Plan & Profile

|           |            |
|-----------|------------|
| SHEET NO. | 2          |
| OF        | 3          |
| FILE NO.  | NRIDGE.DWG |

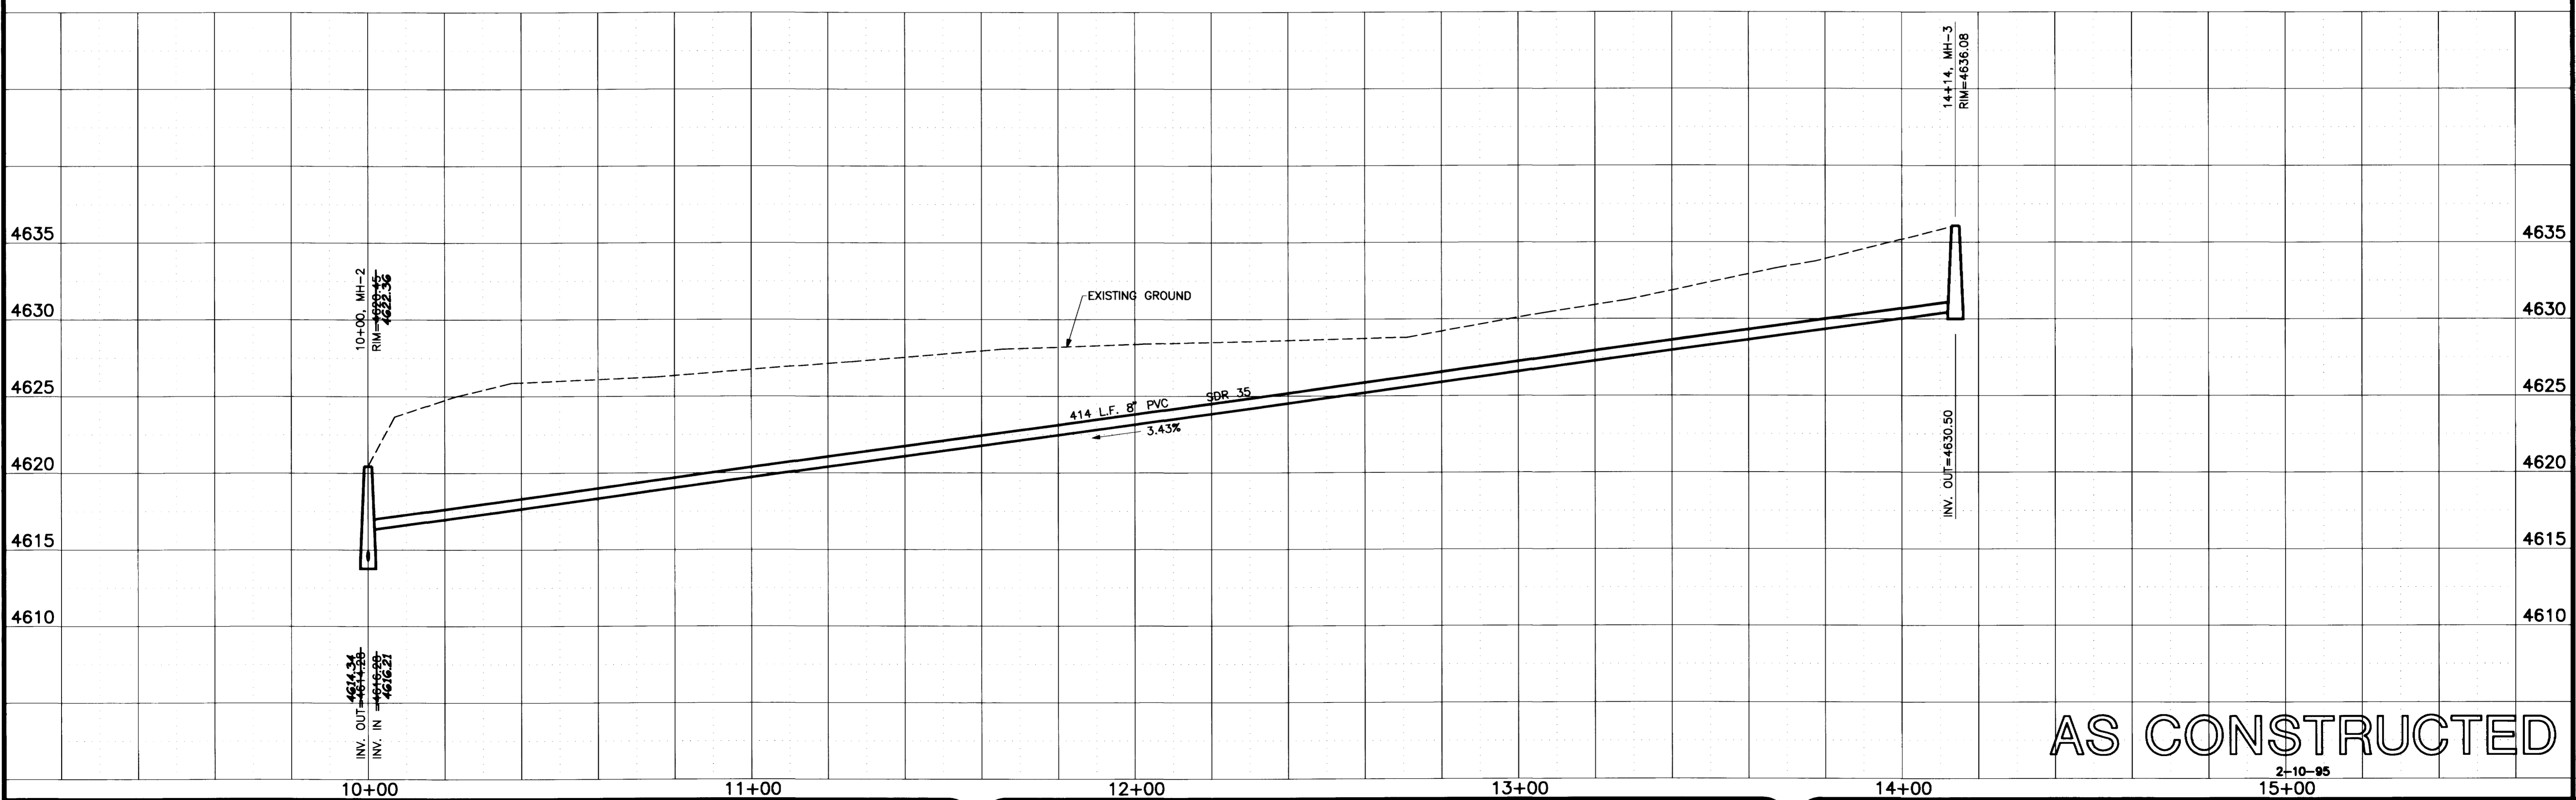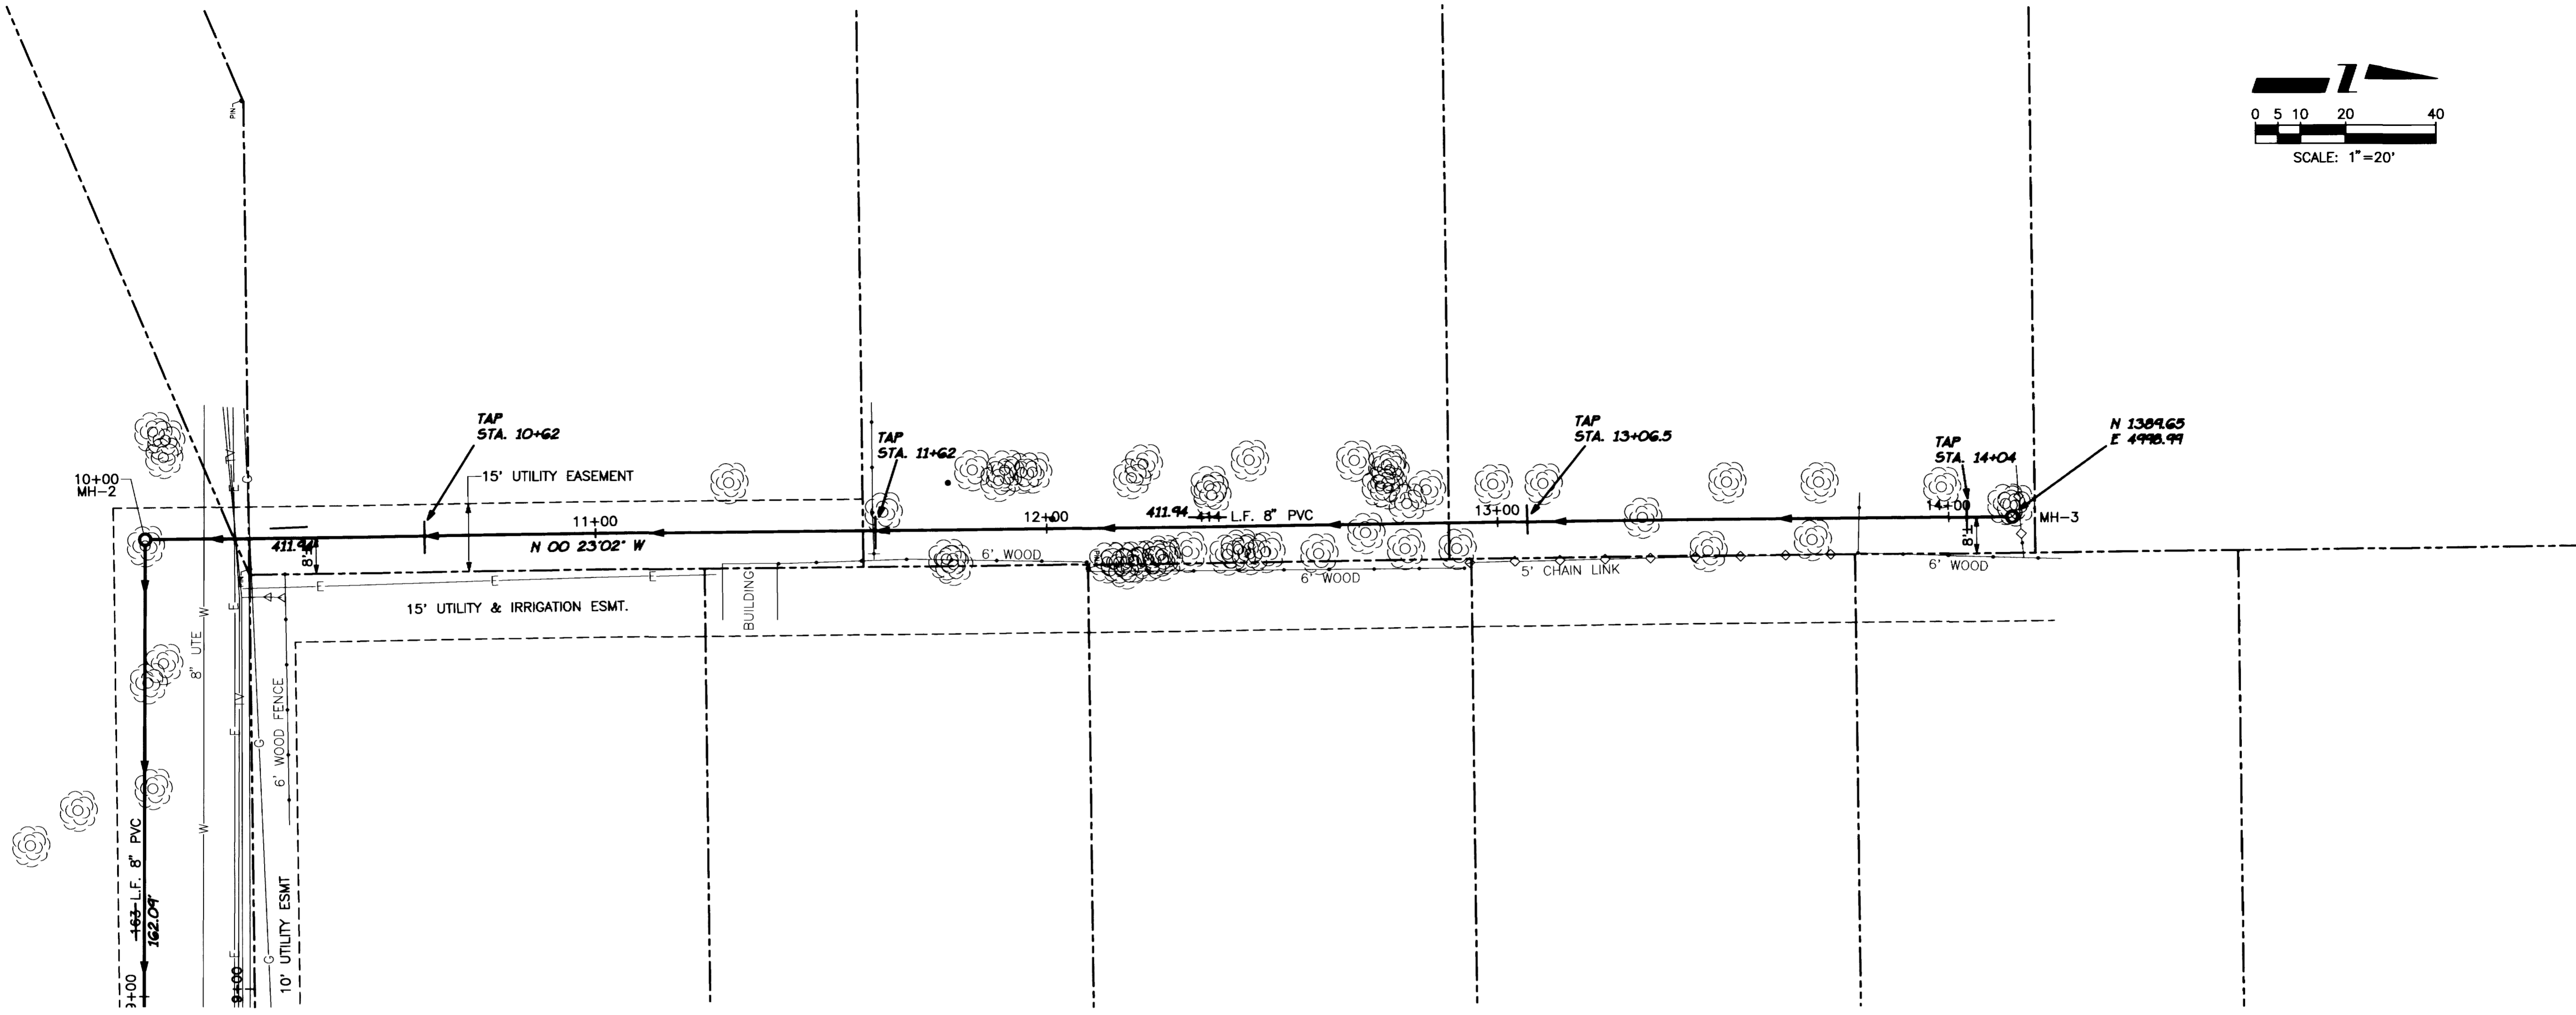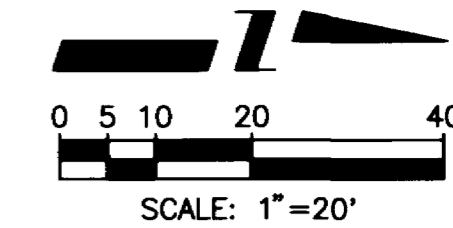

AS CONSTRUCTED

2-10-95

|  |  |   |   |   |   |   |
|--|--|---|---|---|---|---|
| REVISION $\Delta$<br>REVISION $\Delta$<br>REVISION $\Delta$<br>REVISION $\Delta$ | DATE _____<br>DATE _____<br>DATE _____<br>DATE _____ | DRAWN BY _____ C.A.K. DATE 11/17/93<br>CHECKED BY _____ B.C. DATE _____<br>APPROVED BY _____ B.C. DATE _____<br>FIELD BOOK NO. _____ PAGE _____ | SCALE<br>PLAN<br>HORIZ. 1"=20'<br>PROFILE<br>HORIZ. 1"=20'<br>VERT. 1"=5' | <b>DEPARTMENT OF PUBLIC WORKS AND UTILITIES<br/>         ENGINEERING DIVISION<br/>         CITY OF GRAND JUNCTION, COLORADO</b> | <b>NORTHRIDGE SEWER LINE<br/>         EXTENSION<br/>         Plan &amp; Profile</b> | SHEET NO. 3<br>OF 3<br>FILE NO.<br>NRIDGE.DWG |
|--|--|---|---|---|---|---|