
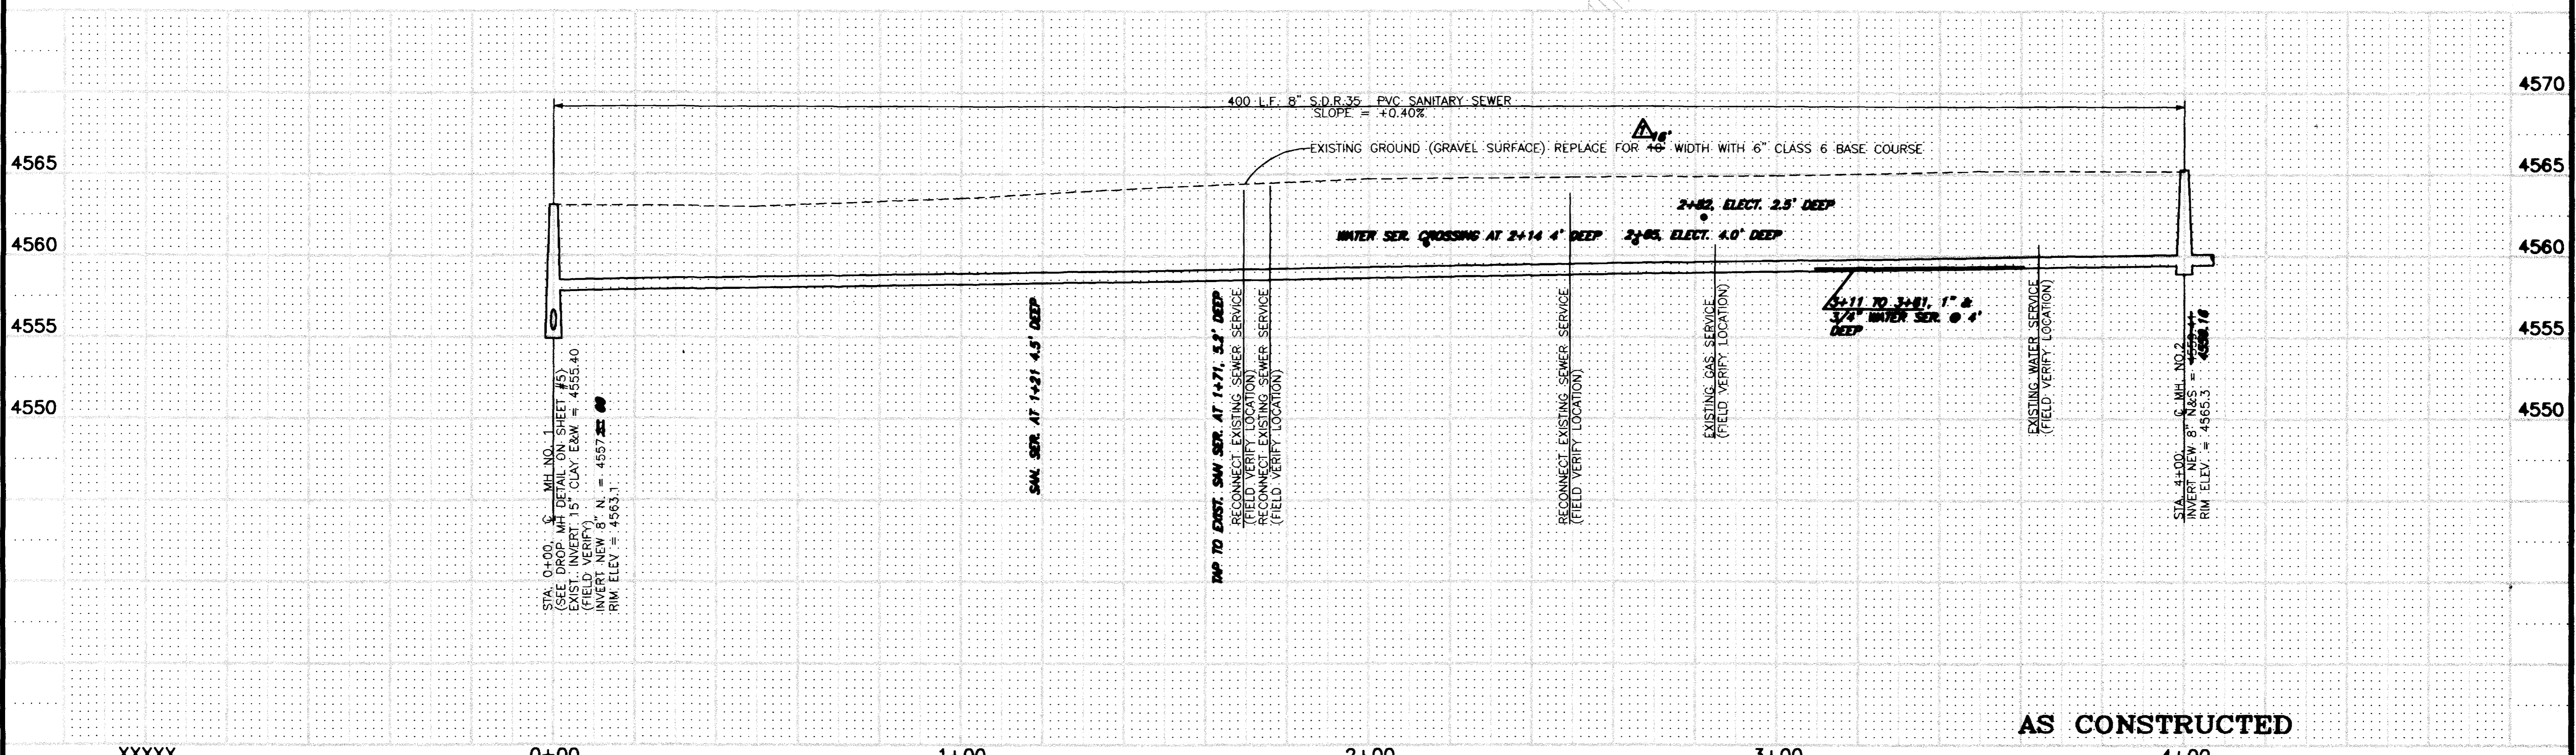
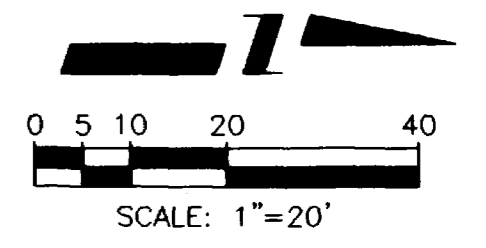


NOLAND AVE.

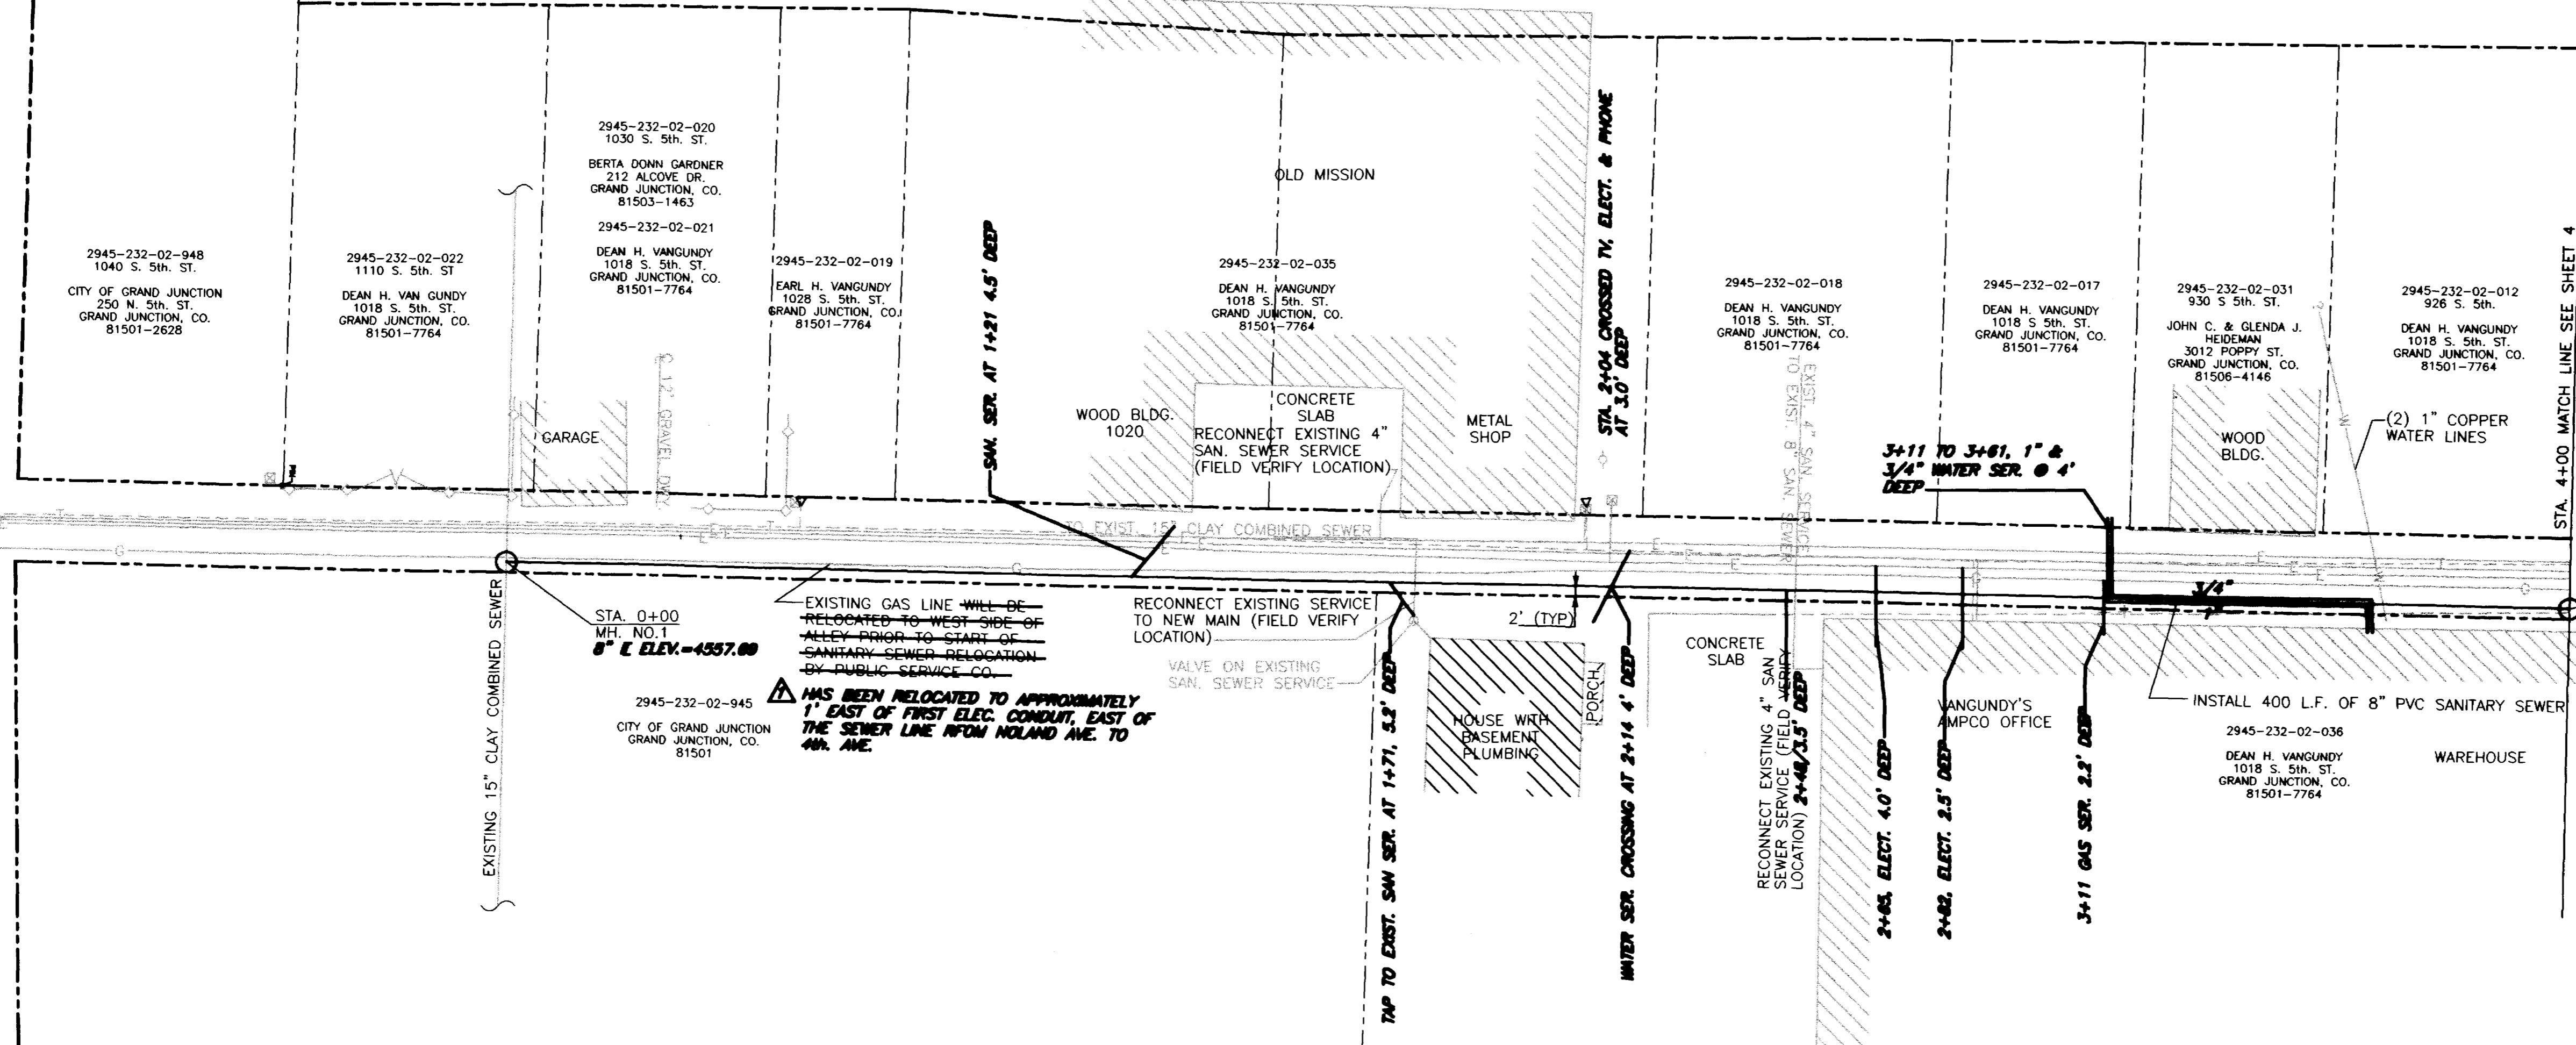

AS CONSTRUCTED

REVISION	DESCRIPTION	DATE
REVISION	REVISION	REVISION
REVISION	REVISION	REVISION
REVISION	REVISION	REVISION




DRAWN BY	DATE
CHECKED BY	DATE
APPROVED BY	DATE
FIELD BOOK NO.	PAGE

SCALE	
PLAN	PROFILE
HORIZ. 1"=20'	HORIZ. 1"=20'
	VERT. 1"=5'

DEPARTMENT OF PUBLIC WORKS AND UTILITIES  
 ENGINEERING DIVISION  
 CITY OF GRAND JUNCTION, COLORADO

5TH. STREET VIADUCT  
 SANITARY SEWER LINE RELOCATION  
 Plan & Profile STA. 0+00 TO 4+00

SHEET NO.	3
OF	5
FILE NO.	VANGUN1.DWG

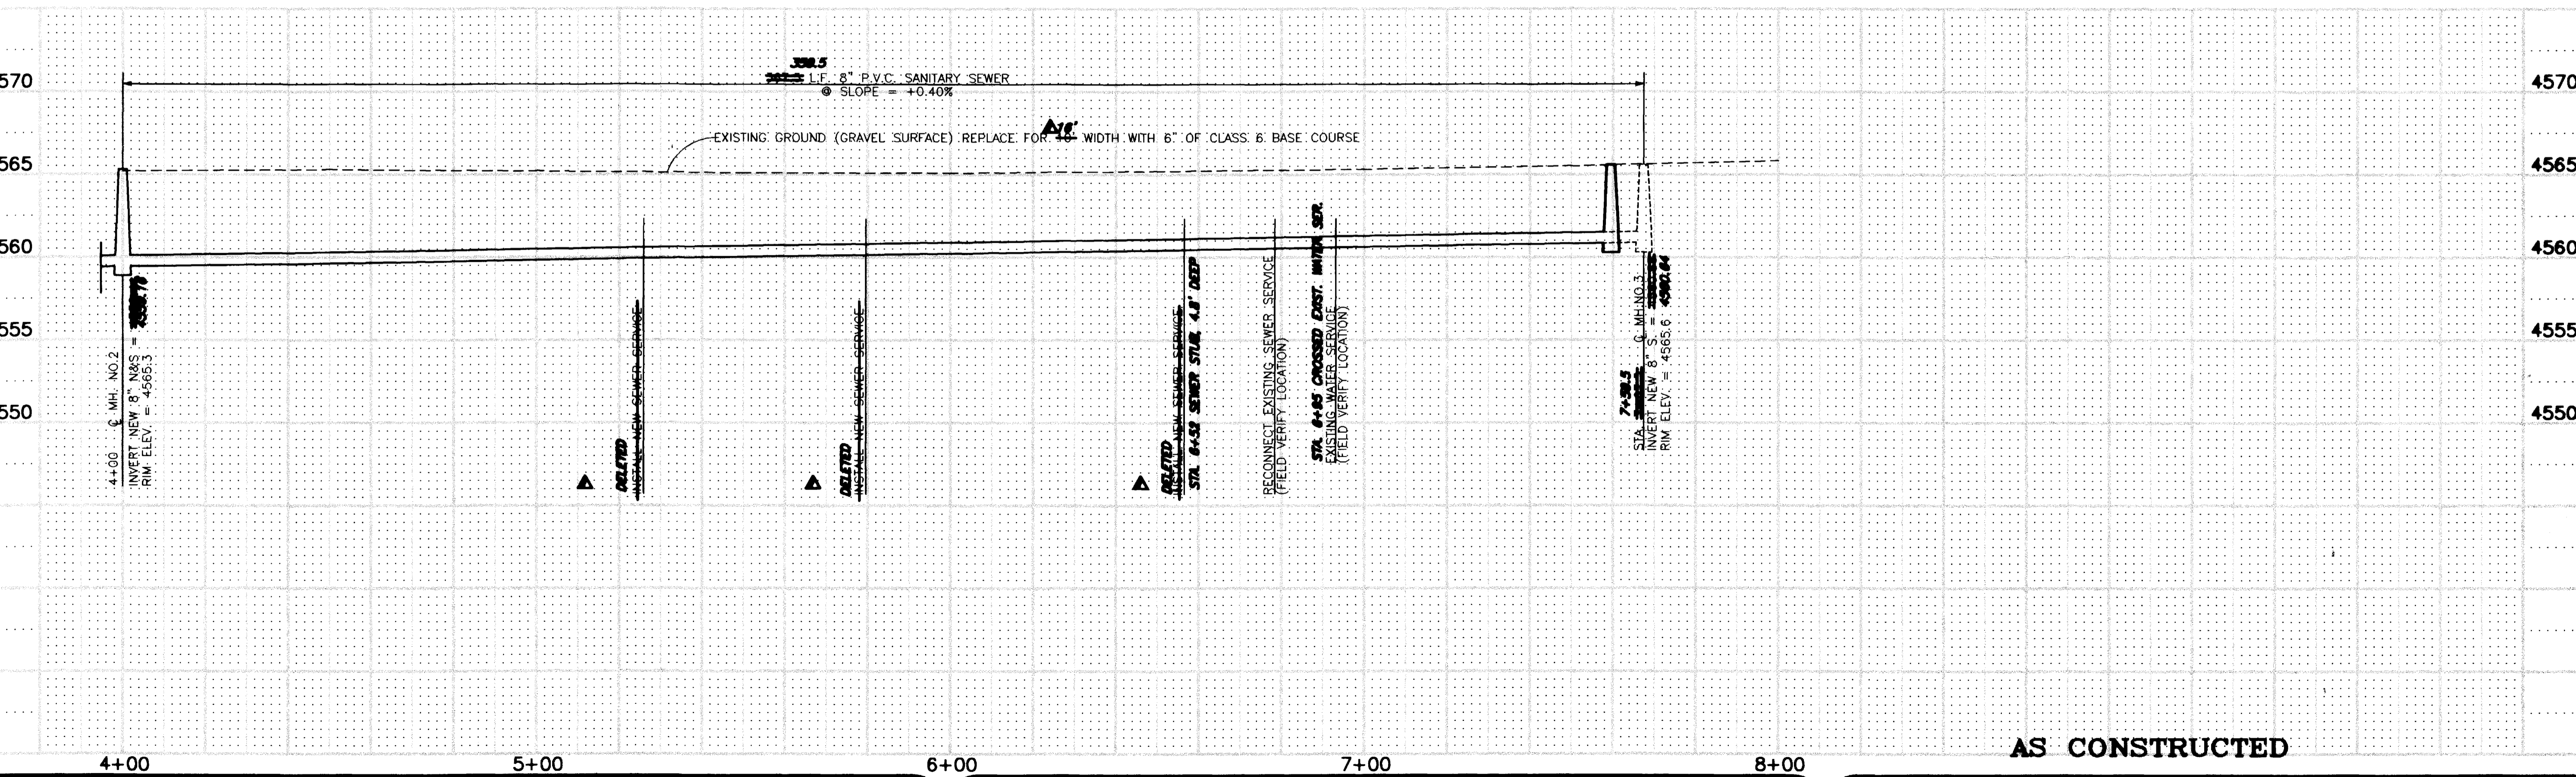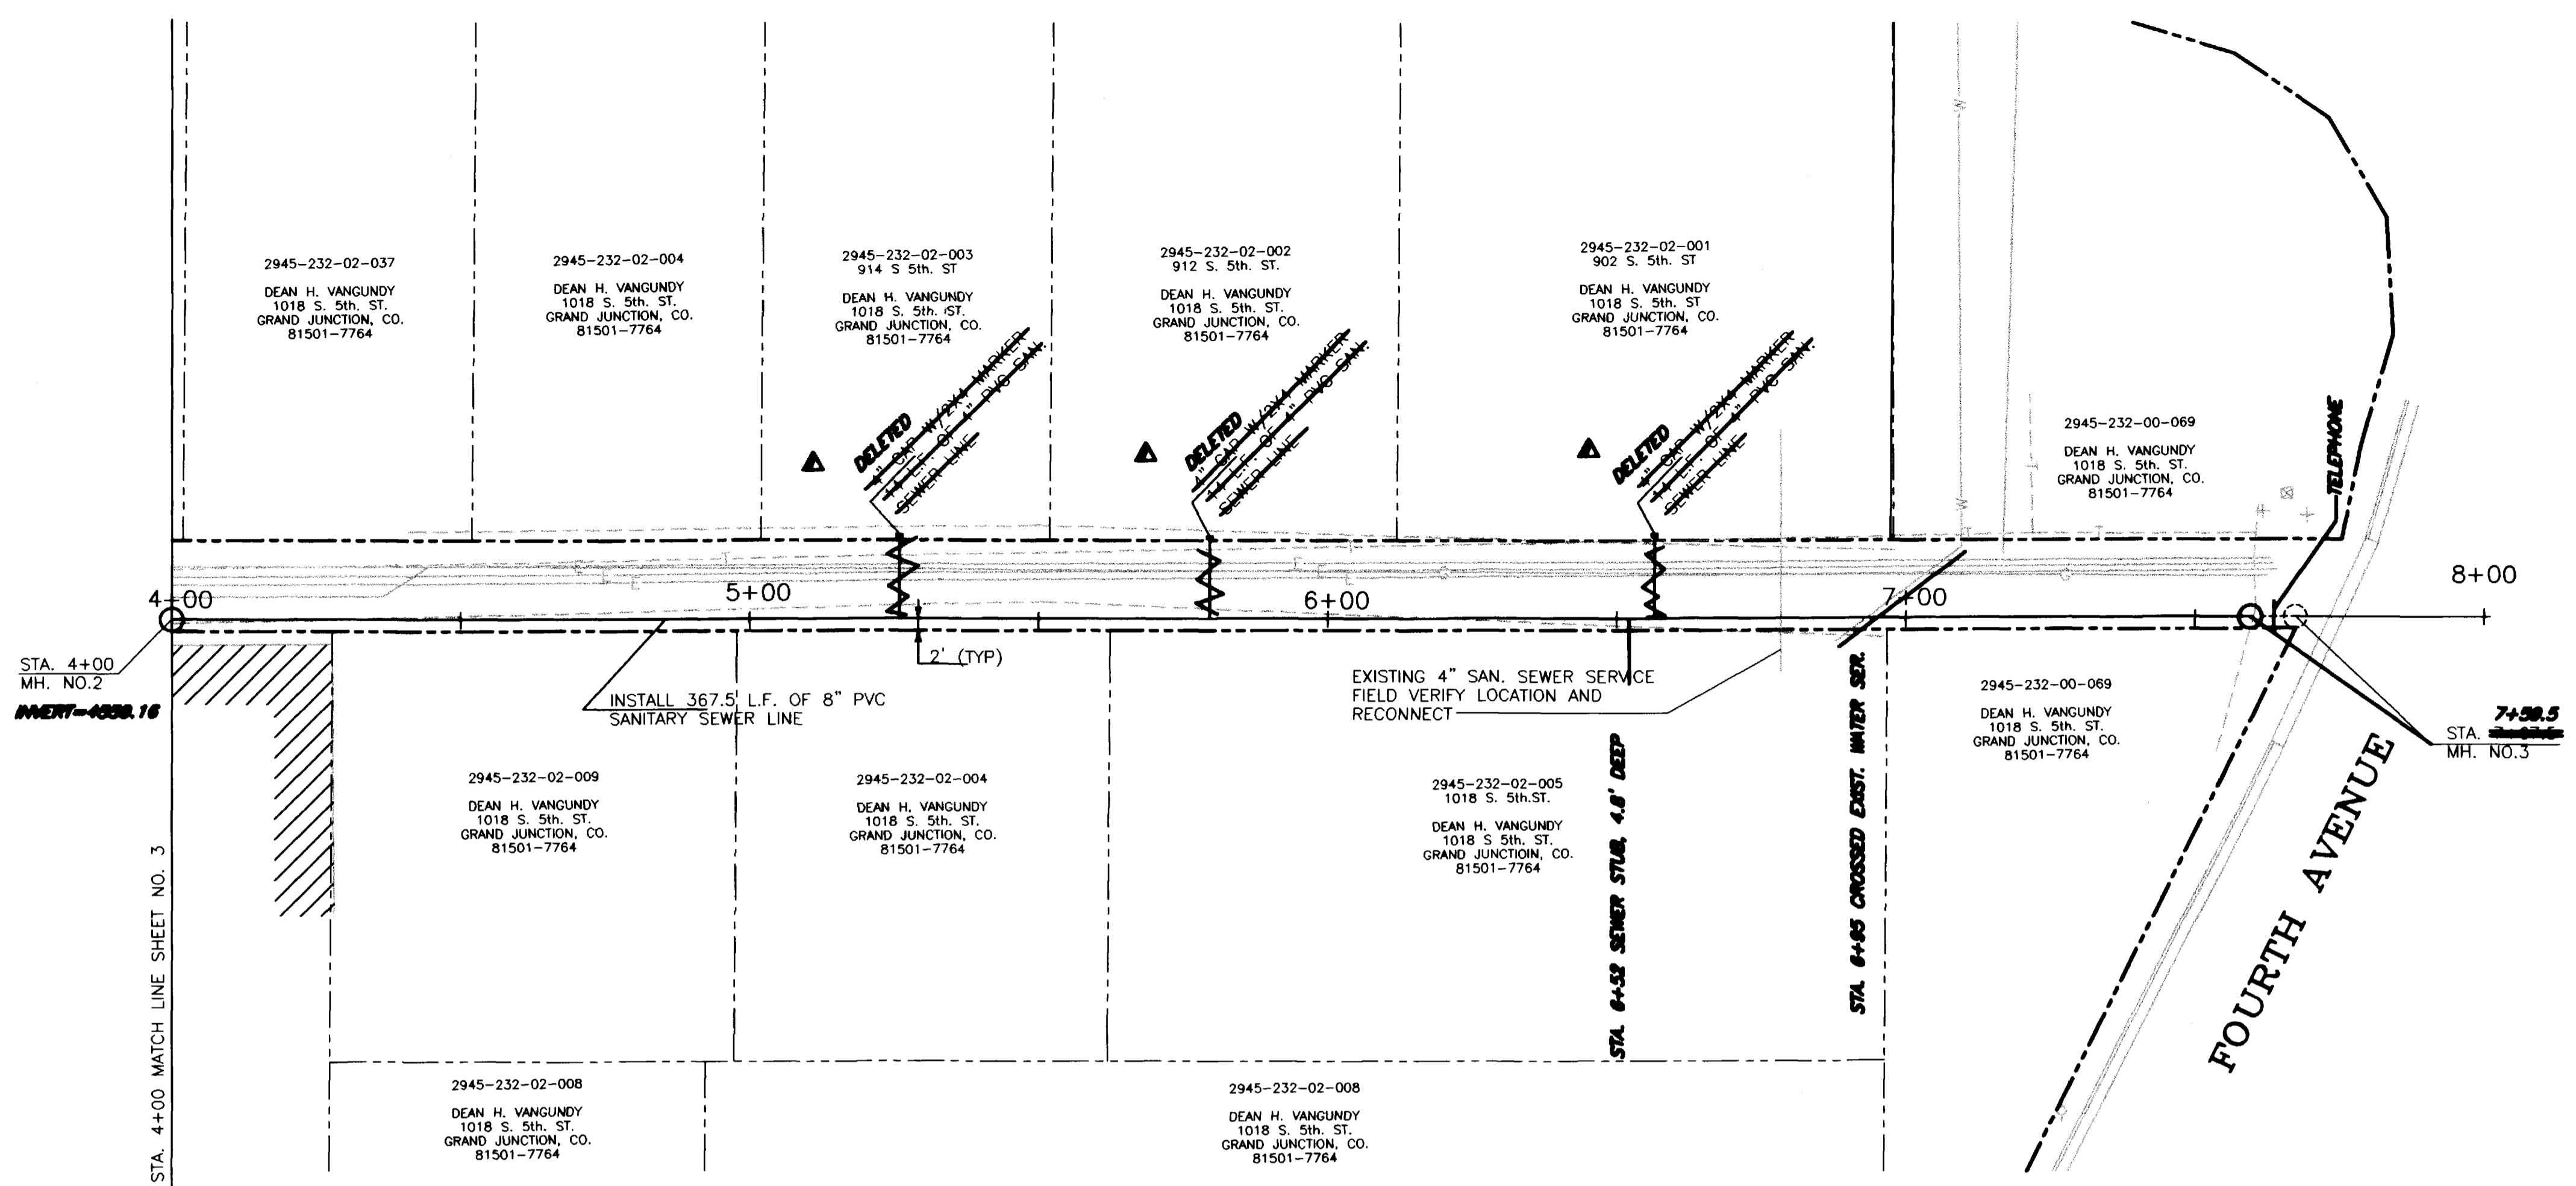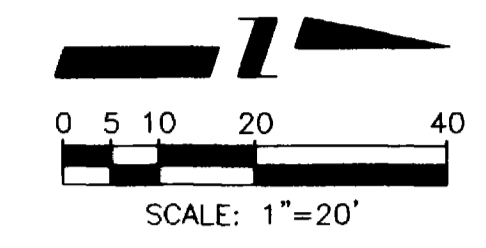

AS CONSTRUCTED

REVISION	REVISION	REVISION	REVISION	DESCRIPTION	DATE	DRAWN BY	DATE	SCALE
△	△	△	△	REVISED 1/17/07 PER MRS. CURTIS	1/17/07	L. MARTIN	10/8/96	PLAN 1"=20' PROFILE 1"=20' VERT. 1"=5'

DEPARTMENT OF PUBLIC WORKS AND UTILITIES  
ENGINEERING DIVISION  
CITY OF GRAND JUNCTION, COLORADO

5TH. STREET VIADUCT  
SANITARY SEWER LINE RELOCATION  
Plan & Profile STA. 4+00 TO 7+67.5

SHEET NO. 4  
OF 5  
FILE NO.  
VANGUN2.DWG