


- NOTES: SANITARY SEWER**
- All materials and workmanship shall be subject to inspection by the Central Grand Valley Sanitation District. The District and the City of Grand Junction reserve the right to accept or reject any materials and workmanship that does not conform to their standards and specifications.
  - The Contractor shall have one signed copy of the plans and a copy of the Central Grand Valley Sanitation District's Standards and Specifications at the job site at all times.
  - All sanitary sewer pipe to be PVC SDR35 unless otherwise noted.
  - All sewer mains shall be laid to grade utilizing a pipe laser.
  - All service line connections to the new main shall be accomplished with full body wyes or tees. Tapping saddles will not be allowed.
  - A minimum of 10 foot separation shall be maintained at all times between the water line and sewer line (except at specified crossings).
  - Sewer service stub outs shall extend 14 feet beyond the property line and shall be glue capped and marked with 2"x4" posts and painted green.
  - The Contractor shall notify the District 24 hours prior to commencement of construction.
  - No services shall be connected directly into manholes.
  - The in to existing manhole. The Contractor shall be required to chip out base of existing manhole to an invert elevation as shown on the plans. The invert shall be chipped out to accommodate an 8" pipe flow through the manhole. The contractor shall take every precaution to keep debris from entering live sewage flow in the manhole. The Contractor shall next grade the chipped out invert so that laminar flow will occur in the new invert. The Contractor shall contact the Engineer for inspection of the work done.
  - The Contractor shall cut and replace pavement according to Mesa County's most current Road and Bridge Specifications.
- Approved for Construction By: *[Signature]* Date 5-17-94  
Central Grand Valley Sanitation District
- Approved as Constructed By: *[Signature]* Date 8-28-94  
Central Grand Valley Sanitation District

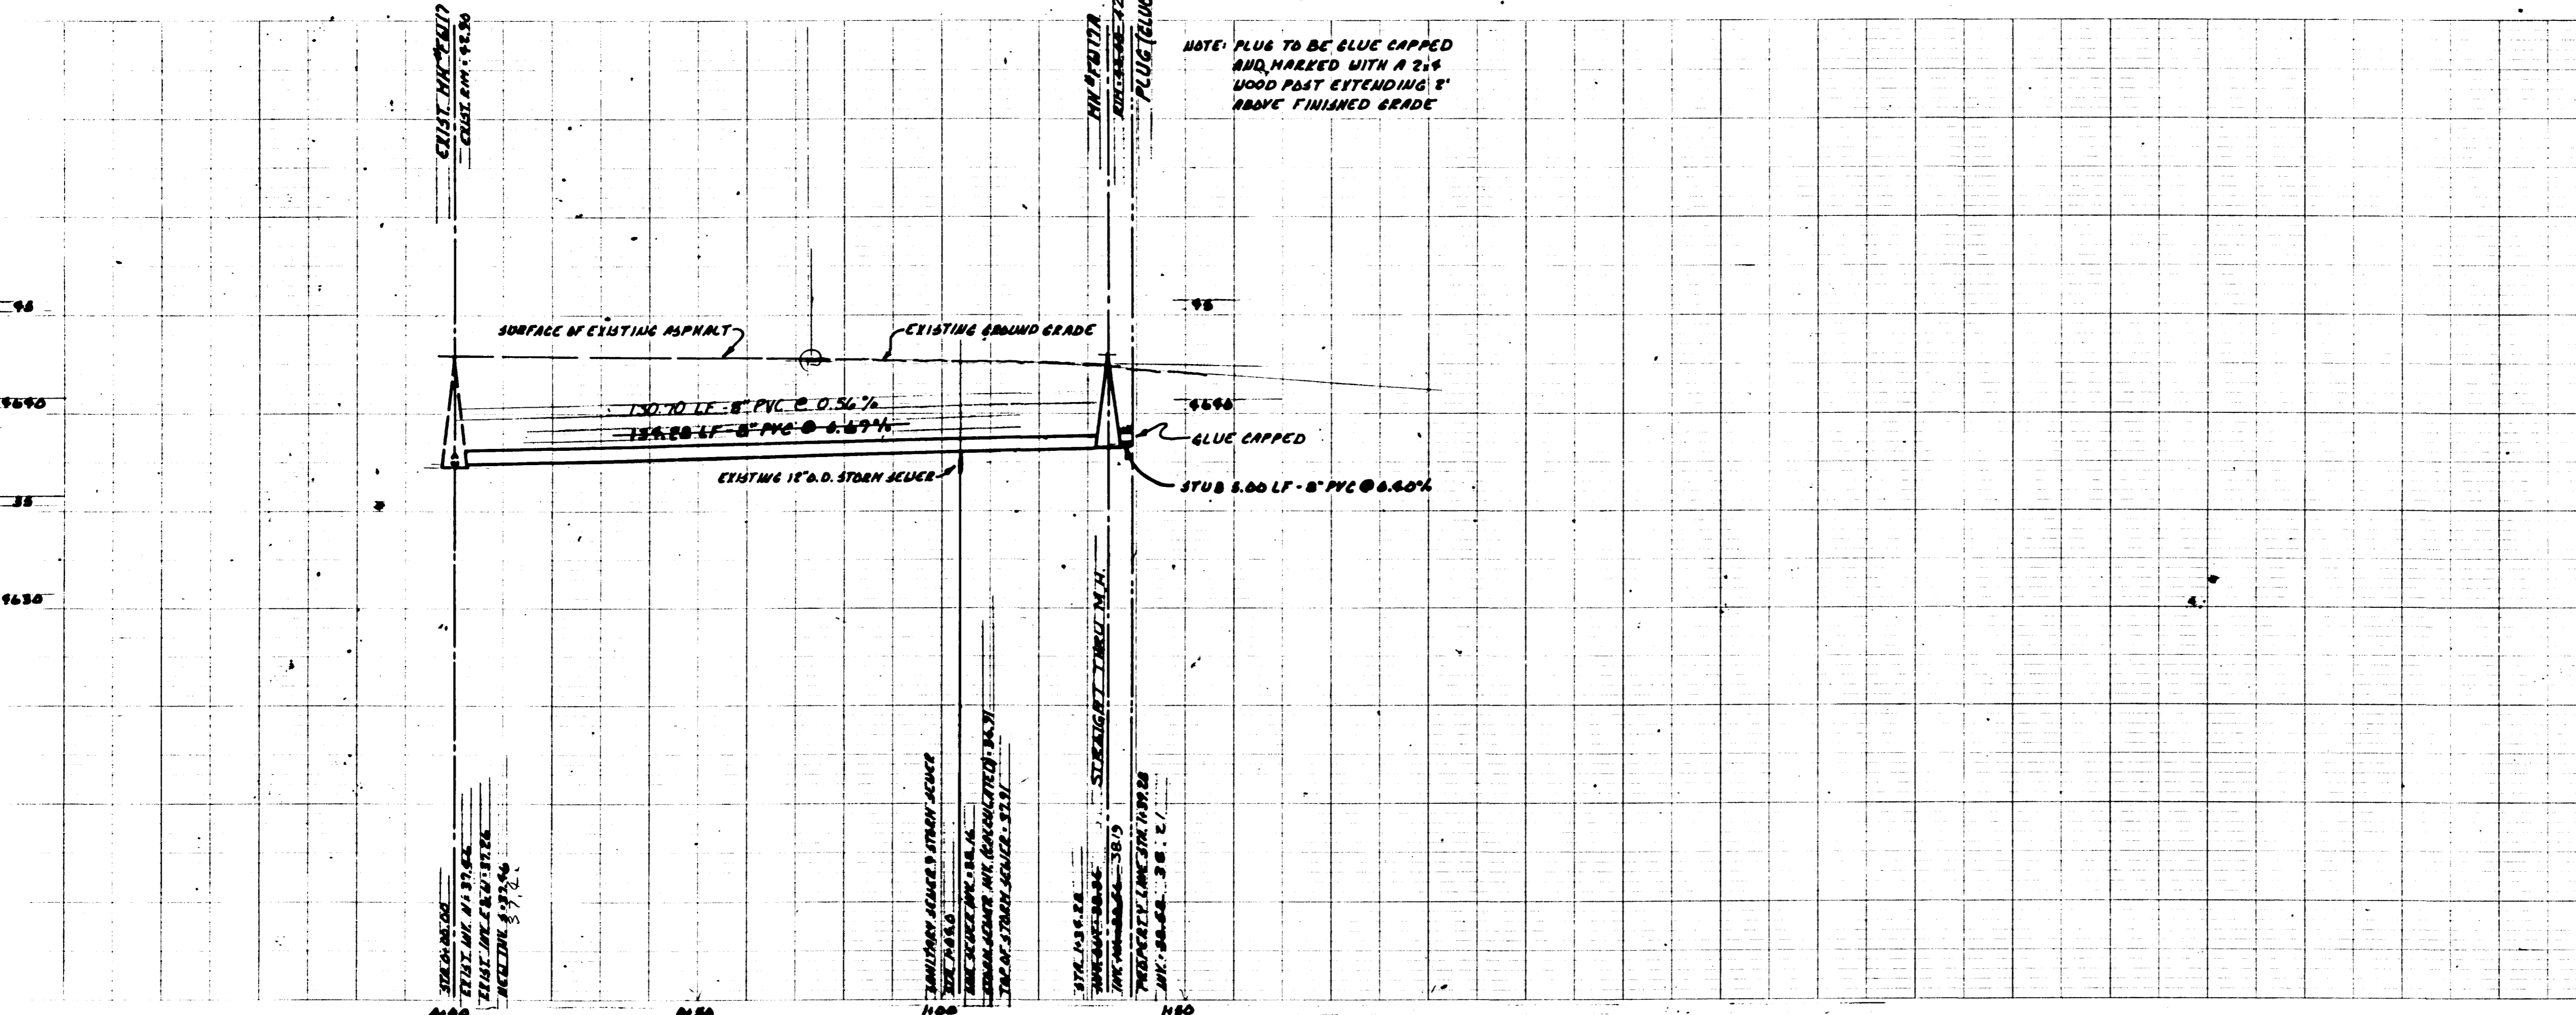

CENTRAL GRAND VALLEY  
SANITATION DISTRICT  
SEWER LINE EXTENSION  
FOR DARREL BRUMAGE

W.H. LIZER & ASSOCIATES  
ENGINEERING CONSULTING & LAND SURVEYING  
576 25 ROAD UNIT 8 241-1129  
GRAND JUNCTION, COLORADO 81505

SCALE: AS NOTED DATE: MAY 1994 PROJECT No. 992897-9 CHECKED BY: *[Signature]*