


CHECKED	
DATE	
SCALE	
REVISIONS	BY

Constructed 1984
 Bob Corliss - Eng
 Tom Logan - Draftsman

RECORD SEWER DWG.

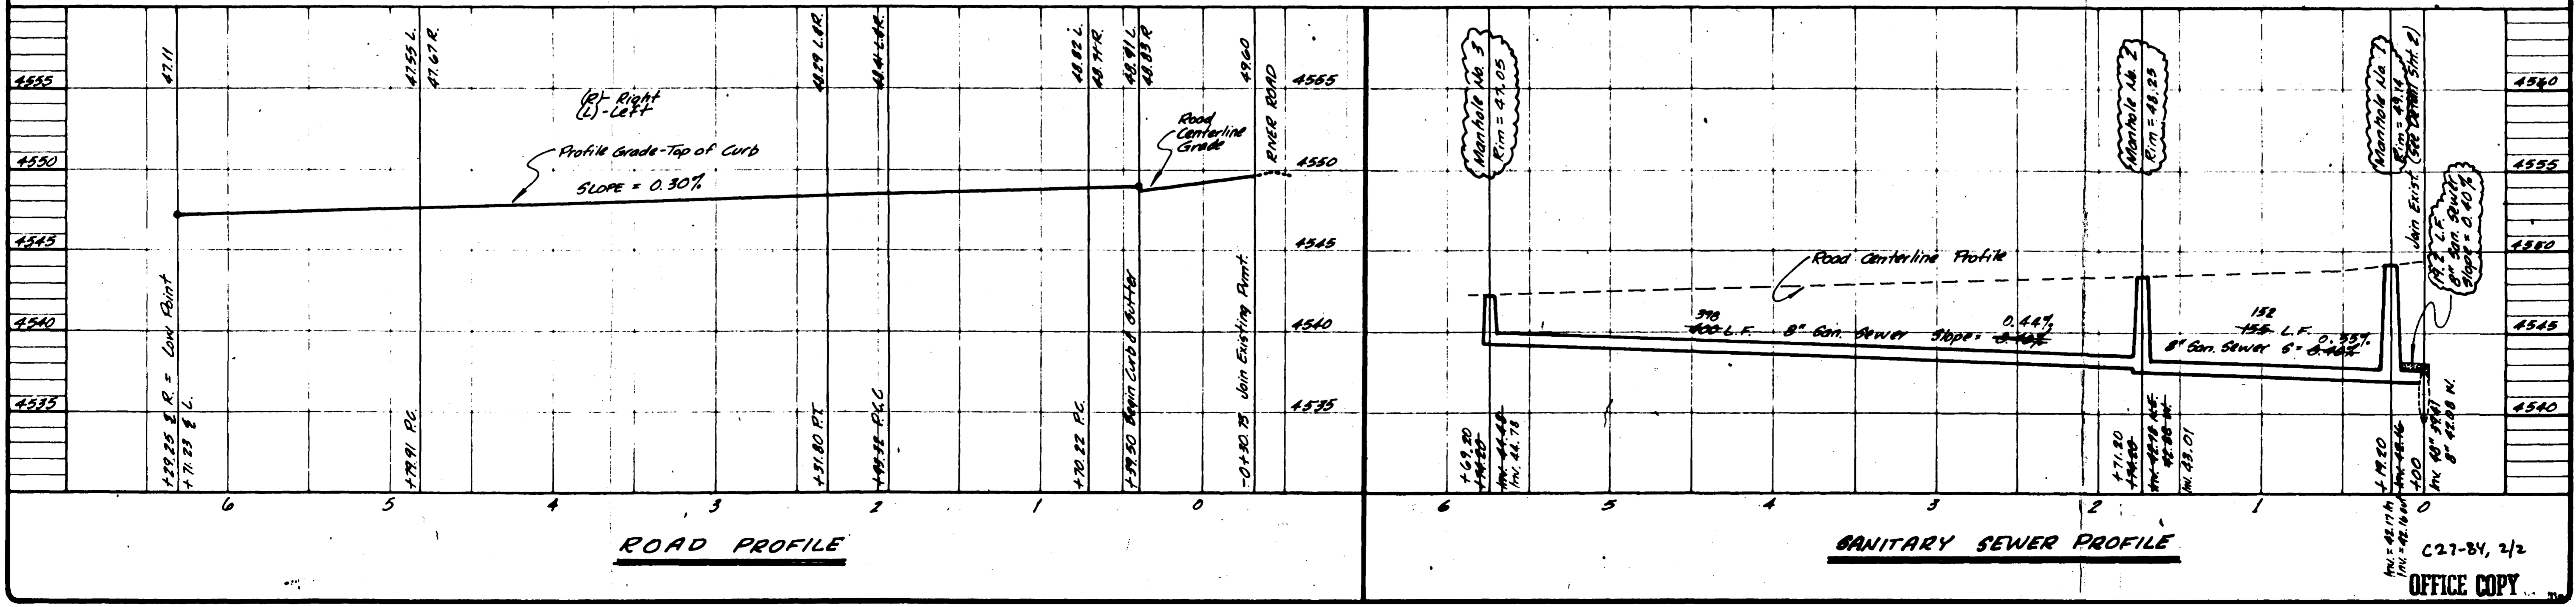

ROADWAY, SANITARY SEWER, &
 HIGH COUNTRY BUSINESS PARK
 MESA COUNTY, COLORADO

C27-84, 2/2
 OFFICE COPY