


- LEGEND**
- SS-W-IV-G- SEWER/WATER/IRR. WATER/GAS (BURIED)
  - E-T-CTV-1- ELEC./TELE/ CABLE TV/ UNIDENTIFIED (BURIED)
  - OVERHEAD UTILITIES
  - - - - - PROPERTY LINE
  - ///X/// WOOD/WIRE/CHAINLINK FENCE
  - UTILITY POLE
  - CONCRETE IN PLAN
  - ⊗ WATER VALVE
  - ⊕ FIRE HYDRANT
  - WM - WATER METER
  - GM - GAS METER

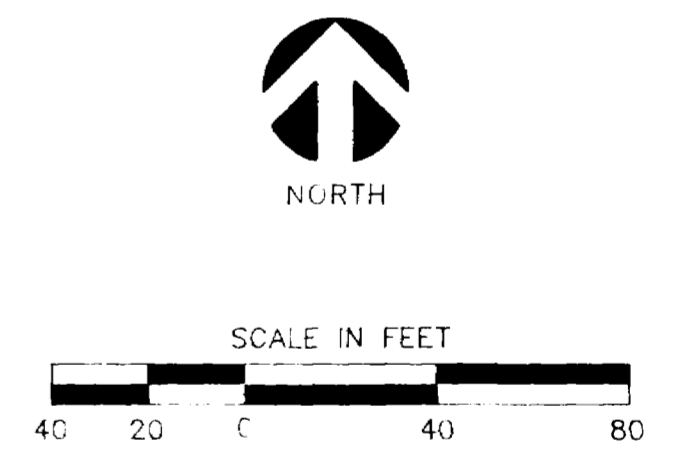

SEWER AND WATER LINE ASBUILT DRAWING  
AS OF 8-24-1993

ELEVATION DATUM: CITY OF GRAND JUNCTION  
BENCH MARK AT 9TH AND KIMBALL = 4568.40

COORDINATES ARE ASSUMED AND SET TO THE WEST  
PROPERTY LINE ON FOUND PROPERTY CORNERS.

NO.	DATE	REVISIONS	BY	CHK	A.E.	APP.
1	9-27-93	Added Pipe sizes & Types				
2		Fixed date on Value at Kimball				
3		Fixed Note for sewer Easement				
4		Fixed Note for Value				

**SPARKMAN SITE PLAN-1003 WINTERS AVE.**

FIELD ASSESSMENTS		U.S. DEPARTMENT OF ENERGY GRAND JUNCTION PROJECTS OFFICE, COLORADO			
LAND SURVEY	DATE	DESIGNED:	DATE	1003 WINTERS AVENUE GRAND JUNCTION, COLORADO	
TEAM LEADER		DRAWN:			
UTILITY LOCATION		CHECKED:			
DRAWN		PROJ. ENGR.:			
SUBMITTED		SUBMITTED:	APPROVAL	DATE	APPROVAL DATE
VERIFICATION					
CONSTRUCTION	DATE	RUST Geotech Inc.		DOE ID NO.	GJ-43921-CS
APPROVED		DWG. NO.		SHT.	OF

Submitted 8-31-93