


# RIDGE PARK

(A REPLAT OF ENTRADA TOWNHOUSES II)

# AN OVERLAY OF ASBUILT SS LATERAL LOCATIONS ON RIDGE PARK LOT LAYOUT




### LEGEND

- ⊕ - MESA COUNTY SURVEY MARKER
- - FOUND 5/8" REBAR AS NOTED
- ⊙ - FOUND 5/8" REBAR IN CONC.-L.S. 18469
- - BUILDING LOT BOUNDARY, RIDGE PARK

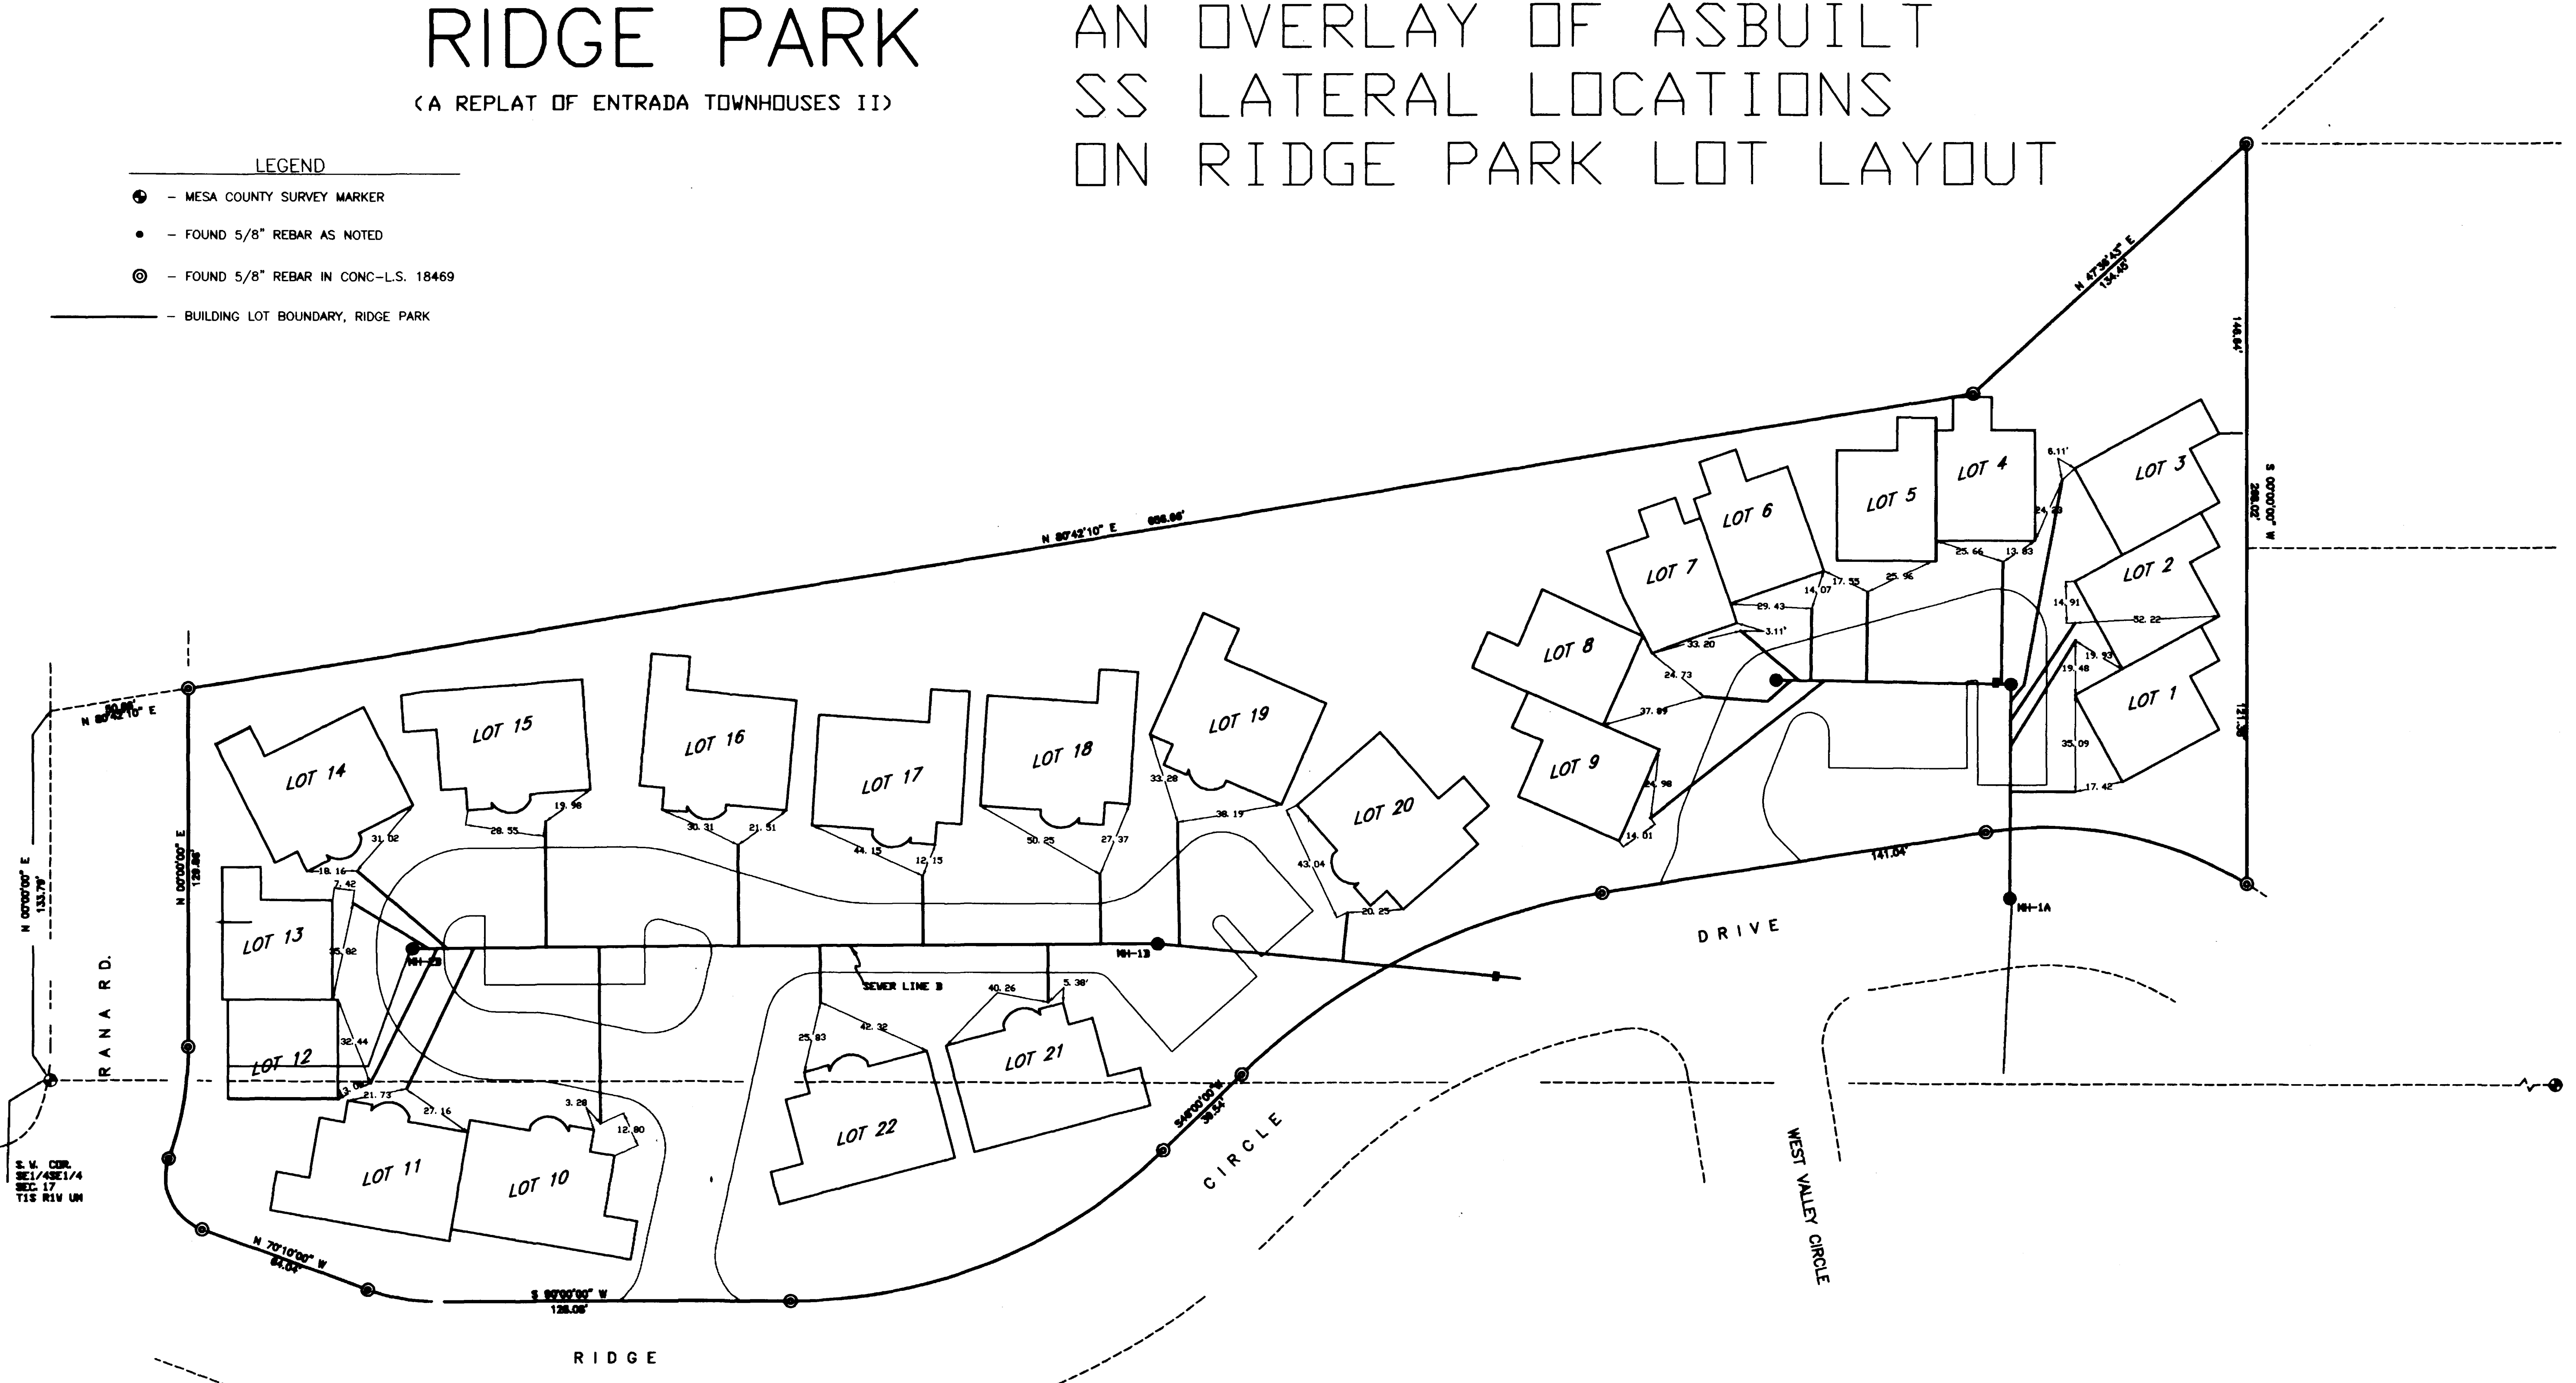

S. V. COR.  
SEC. 17 & NE1/4  
T1S R1W UM

# OVERLAY

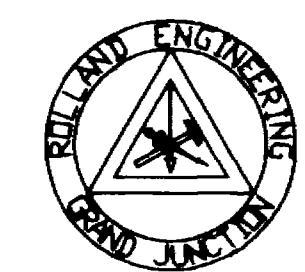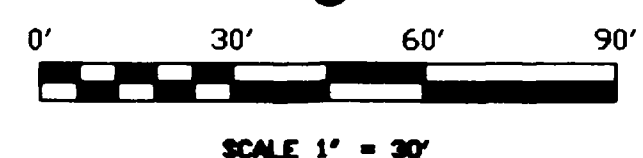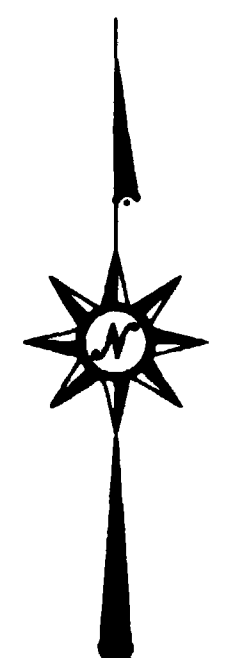

ROLLAND ENGINEERING  
405 Ridges Blvd  
Grand Jct, CO 81503  
(970) 243-8300

RIDGE PARK SITE OVERLAY  
OF AS-BUILT S.S. LATERALS  
the SE1/4 SEC. 17 & NE1/4 SEC.20  
T1S R1W UM, GRAND JUNCTION, CO

Designed	RM	Checked	RM	Plot	SS-OLAY.plt	Sheet	1
Drawn	TAB	Date	6-28-88	Rev	3/28/88	DF	1