


BENCH MARK
TOP OF LIFT STATION
COVER NORTH OF HWY
& WEST OF BRIDGE
Elevation = 4551.99

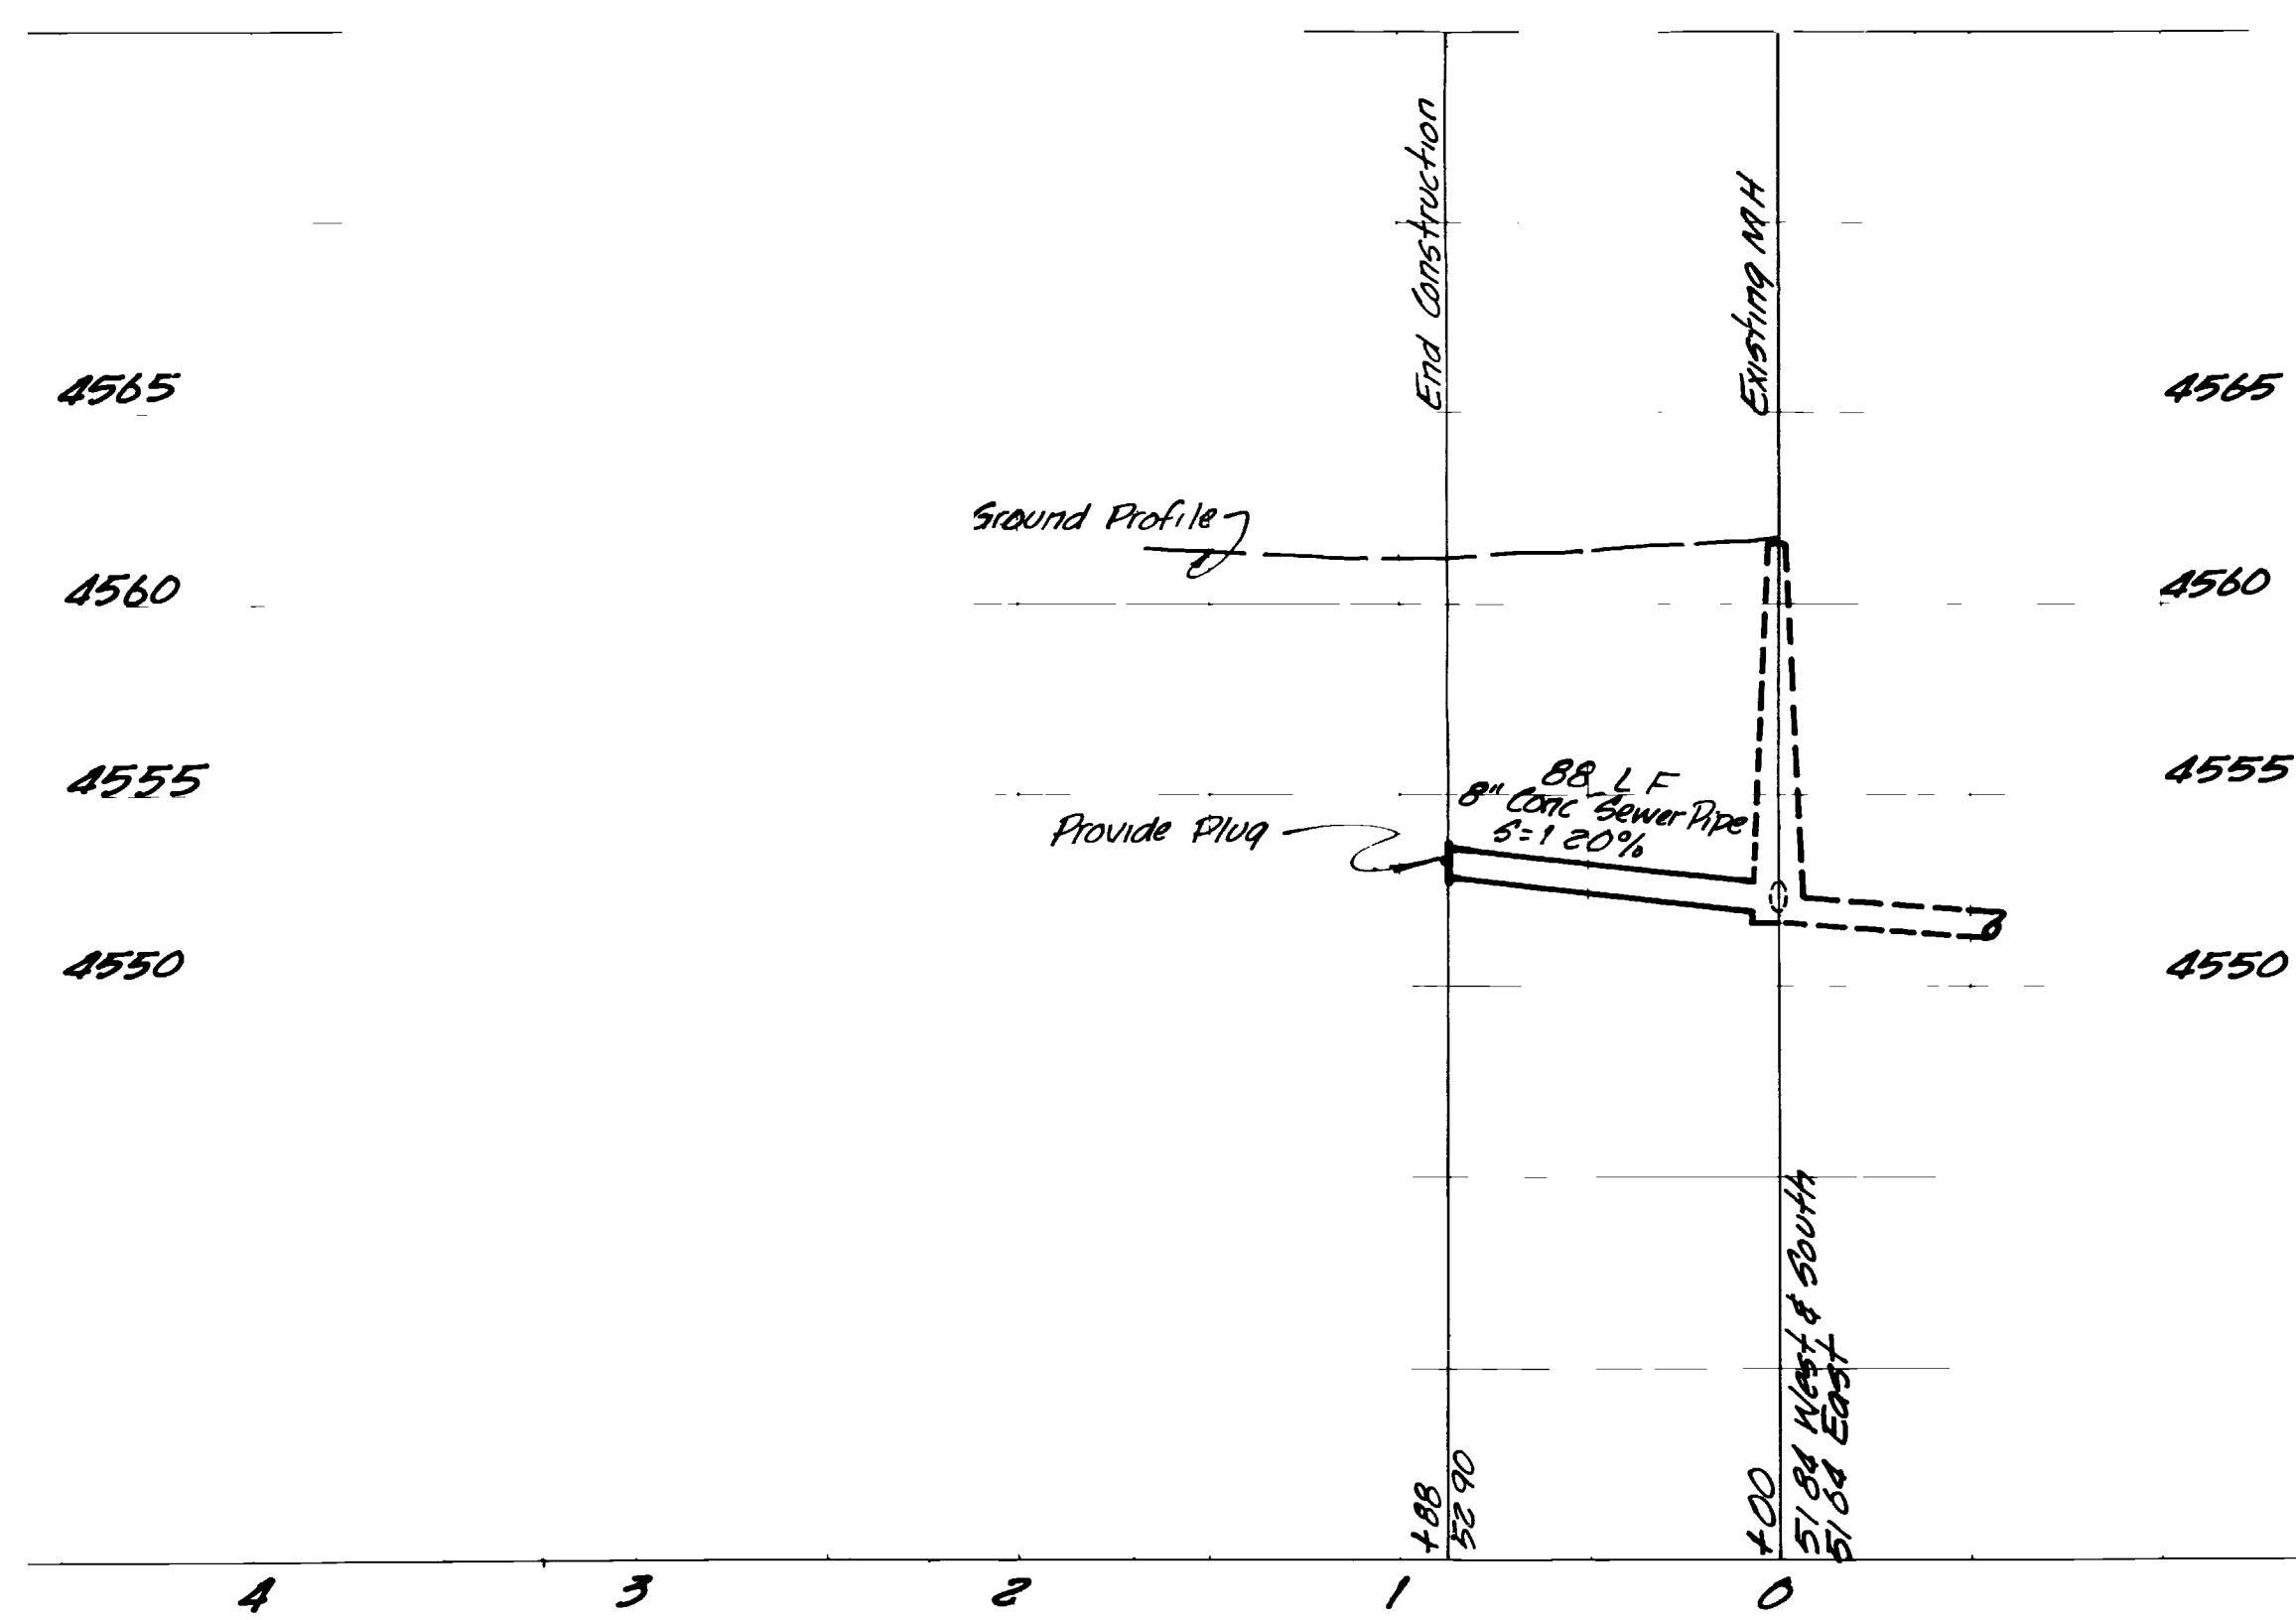

CITY OF GRAND JUNCTION
Approved *[Signature]*
City Engineer

I	TAL	10/17	RLA	"As Built Drawing"
NO	BY	DATE	APPROVED	REVISIONS

DATE: *Nov, 1973*
 DRAFTSMAN: *TAL*
 PROJECT ENGR: *RLA*
 PROJECT MGR: *GWB*
 DEPT. HEAD: *RPS*
 CONST. REP: *NHPB*

NELSON - HALEY - PATTERSON AND QUIRK
 ENGINEERING CONSULTANTS
 GRAND JUNCTION COLORADO

LOUIS BRACH

SANITARY SEWER DESIGN

1	3/1E
1	1

LEGEND

- 3" S — Indicates Existing Gas Line
- S — Indicates Existing Sanitary Sewer Line
- 3" W — Indicates Existing Water Line
- T — T — T — Indicates Existing Buried Telephone Cable
- D — D — D — Indicates Existing Storm Drain
- - - - - Indicates Edge of Pavement
- — — — — Indicates ROW Line
- — — — — Indicates Proposed Sanitary Sewer
- Indicates Utility Pole
- ⊙ Indicates Light Pole
- △ Indicates ROW Marker

