


CEDAR AVENUE

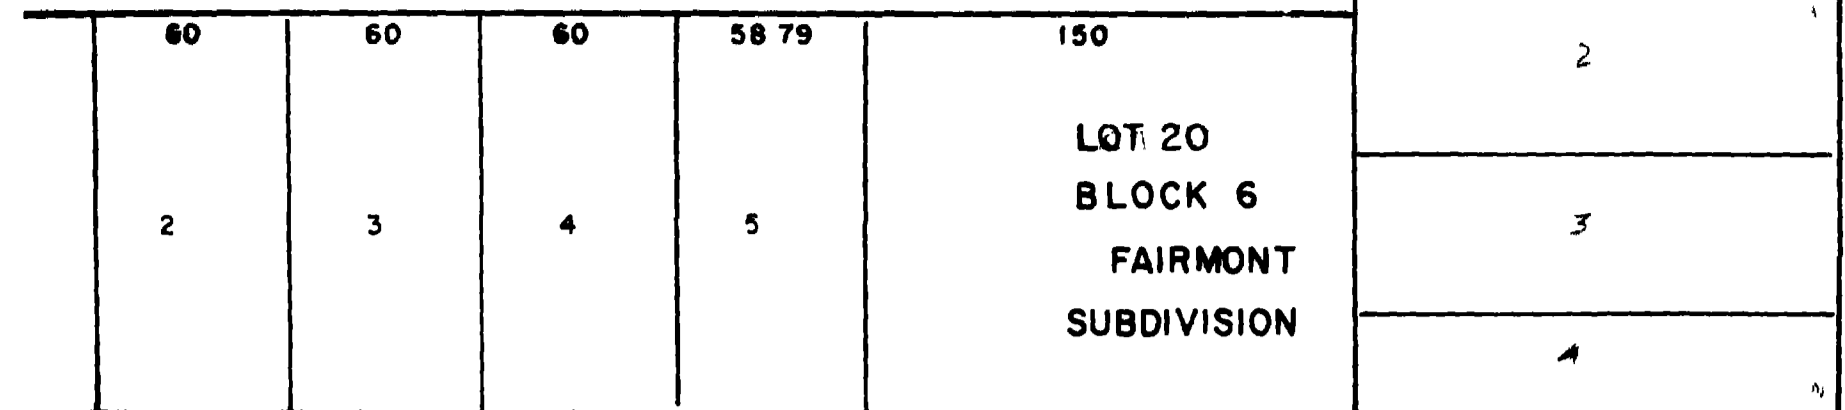

SEWER DISTRICT NO 16

GRAND JUNCTION COLORADO

1956

Scale 1"=60'


- Sewer in place
- - - Sewer to be built
- Existing Manhole
- Manhole Required

SW Cor Lot 21 Block 7 Fairmont Sub



WALNUT AVENUE

659'

Existing Iron Pin

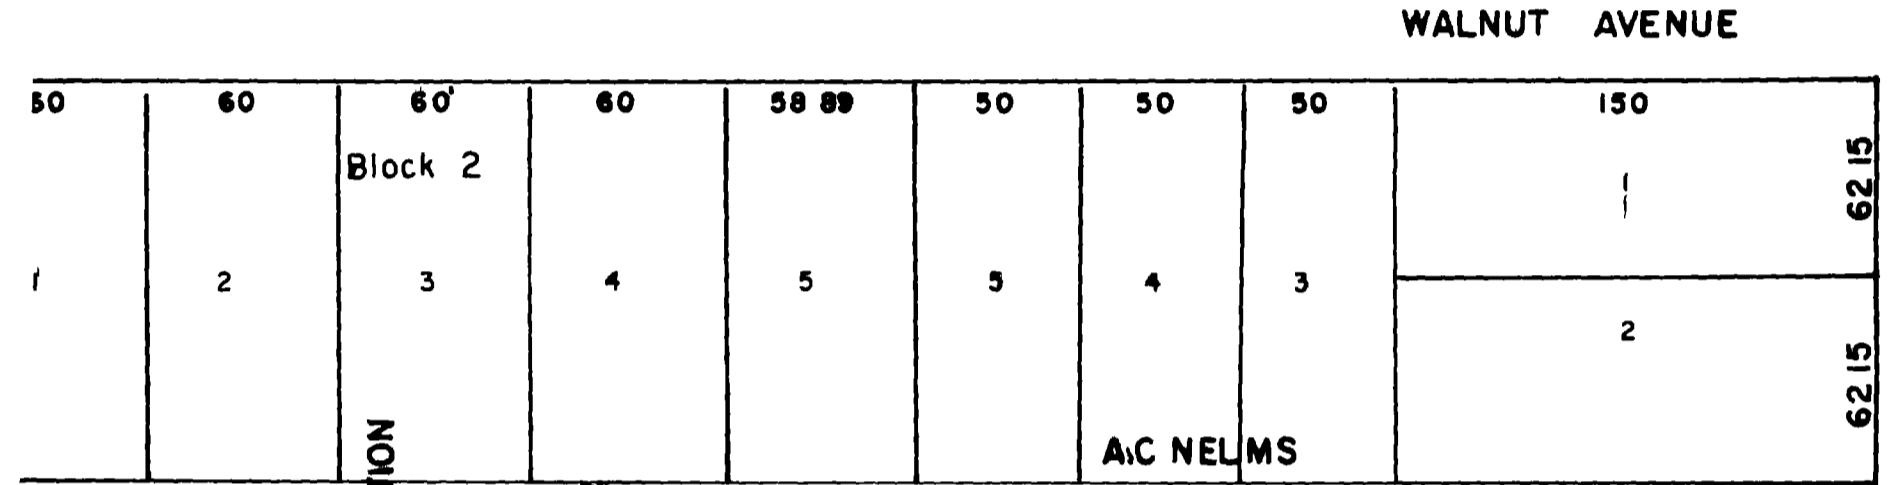


FIFTEENTH STREET

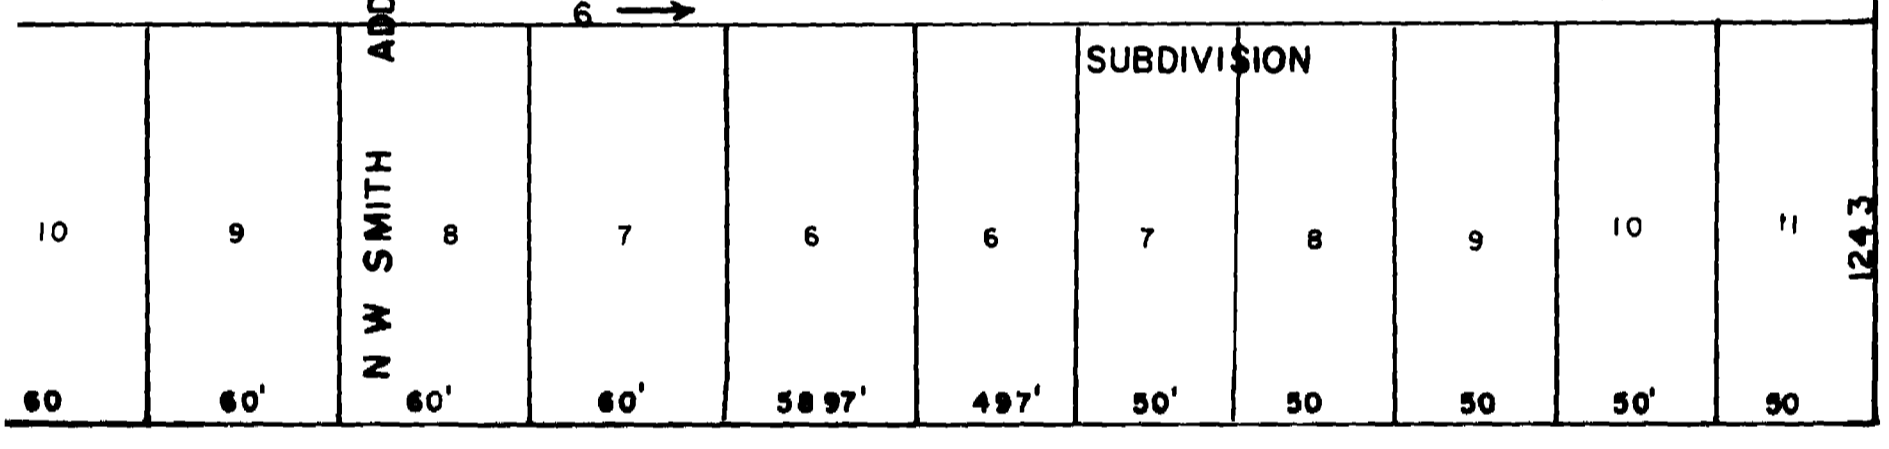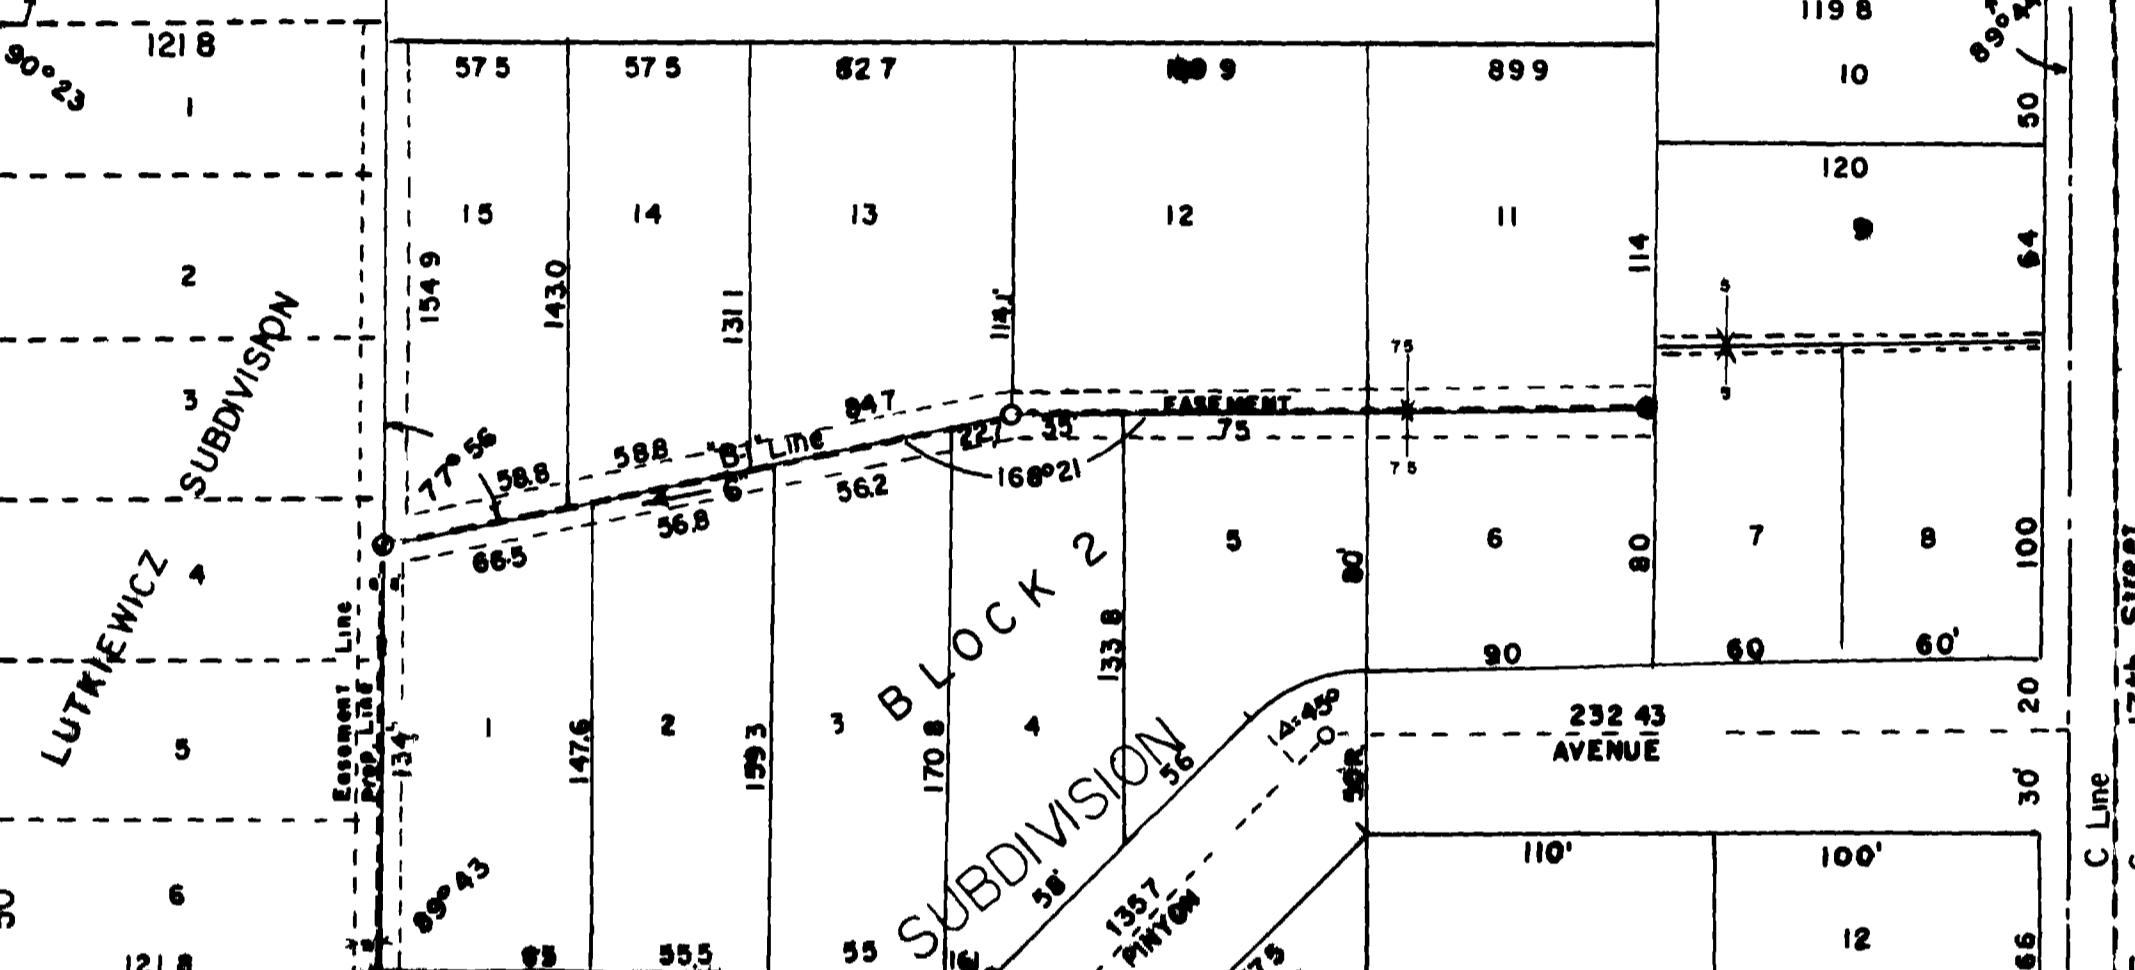



PINYON AVENUE

30

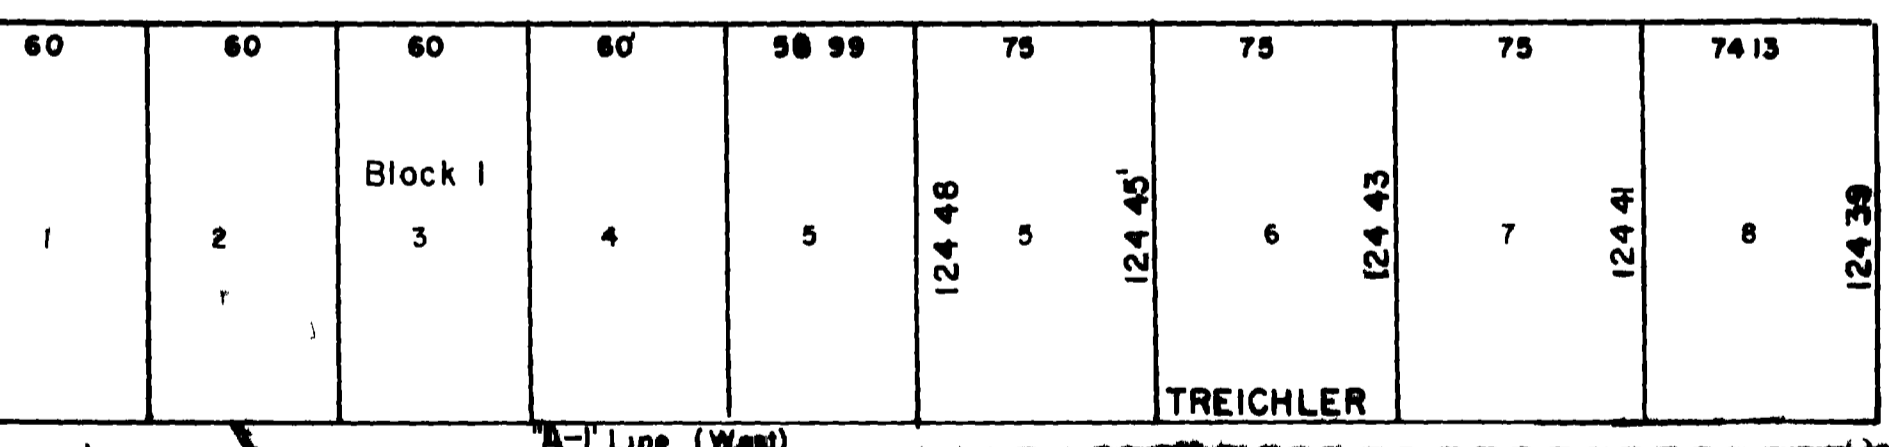

ORCHARD AVENUE

30

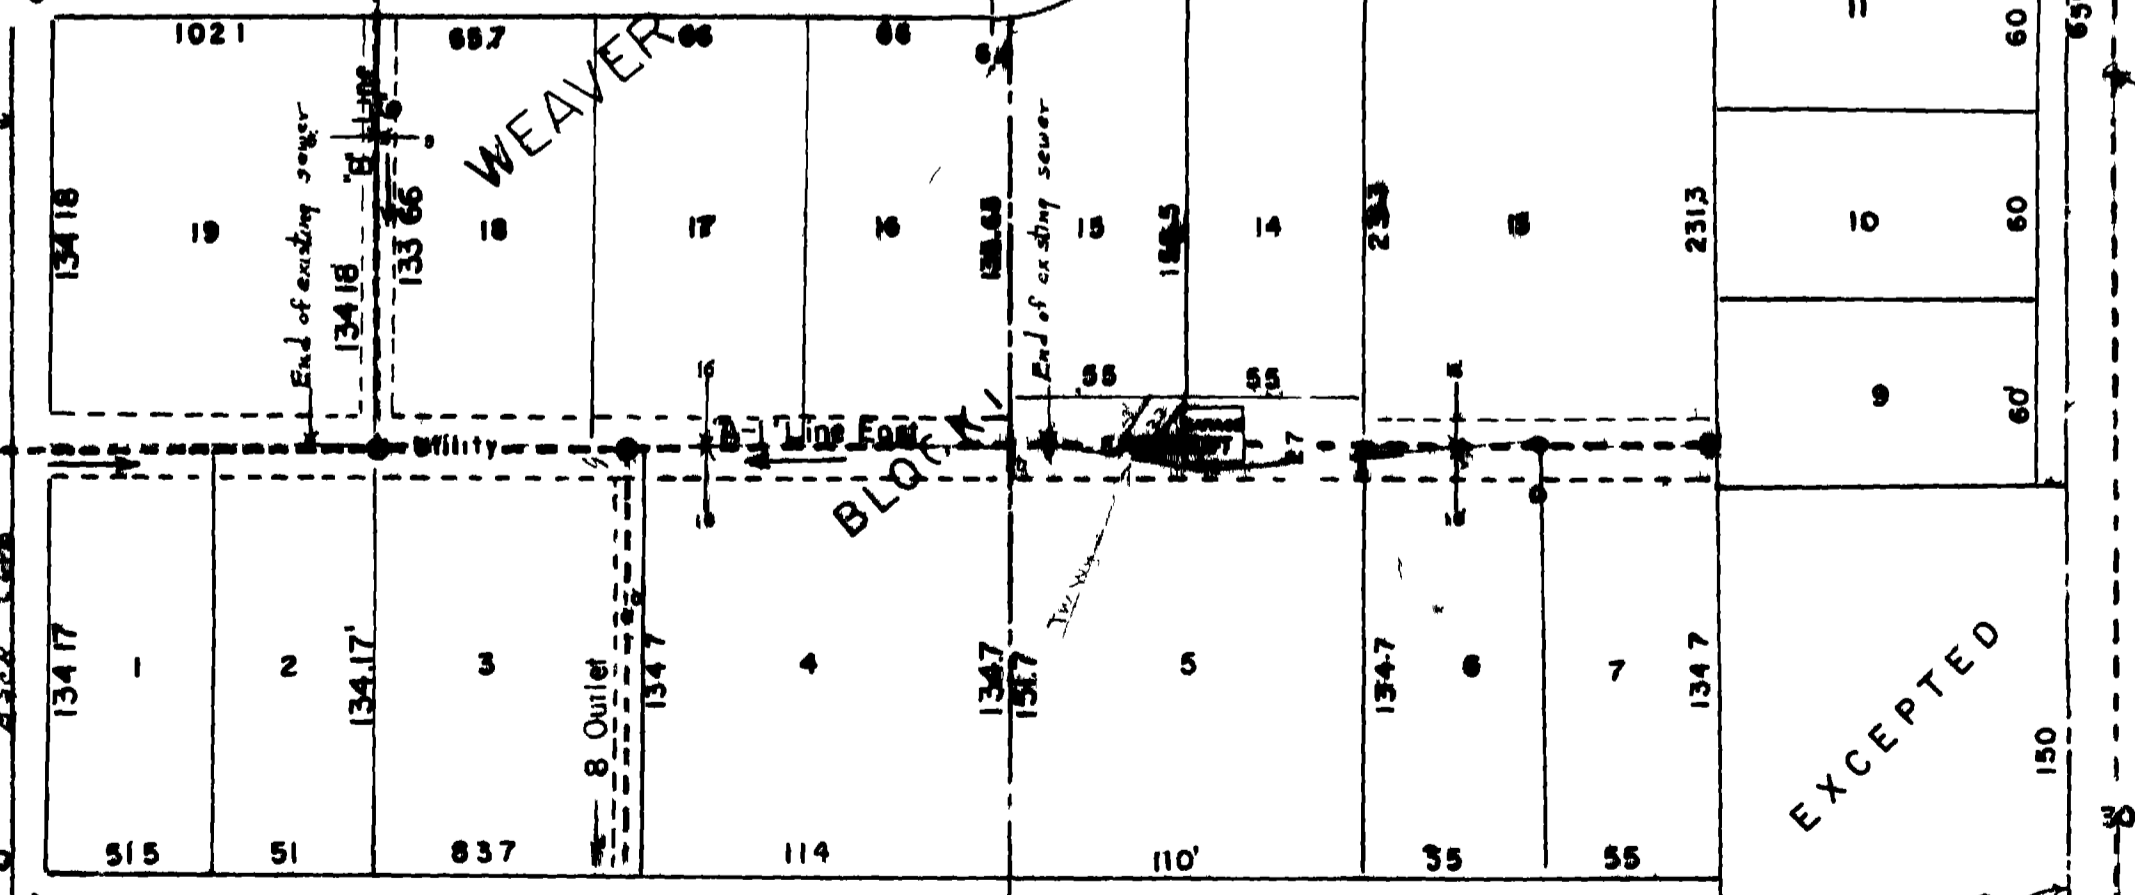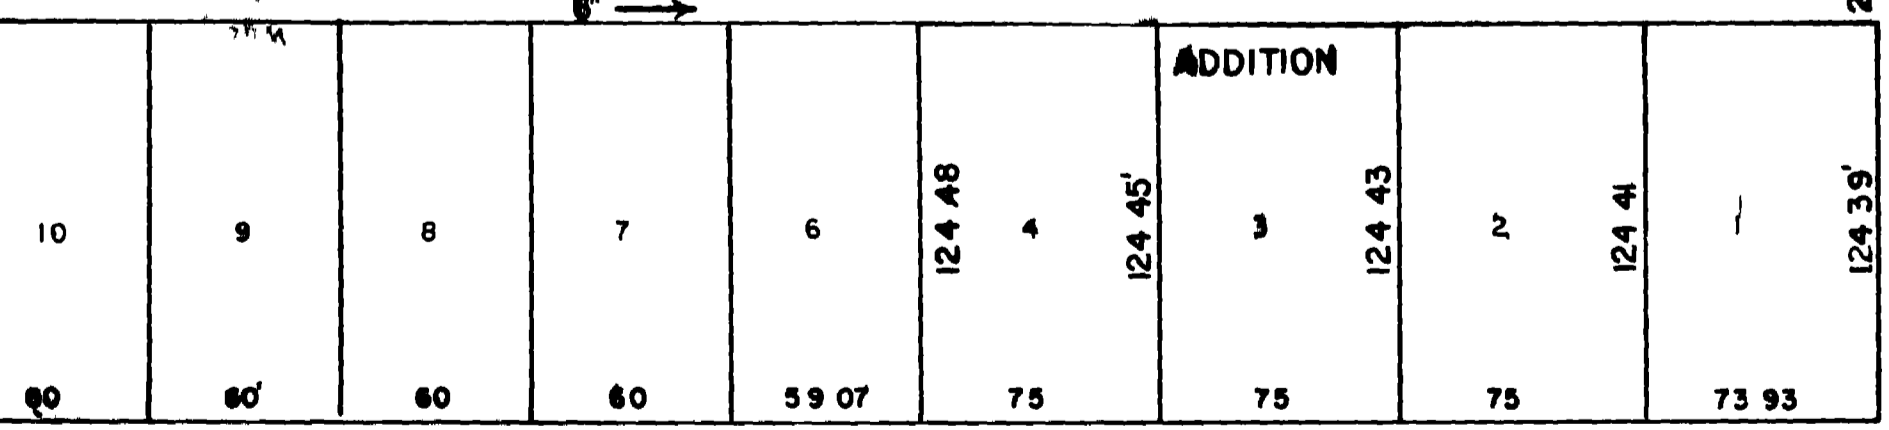

SUMMATION OF QUANTITIES

Total Lin Ft 6" Tile Sewer 3831'

Standard Manholes Required 13

Total Fittings Required 36

Total Lin Ft Special Trunk 29

Total Lin Ft of All Trunking 4156

02094502.tif



SEWER DISTRICT NO 16

GRAND JUNCTION COLORADO

1956

Scale 1" = 60'

- Sewer in place
- Sewer to be built
- Existing Manhole
- ⊙ Manhole Required

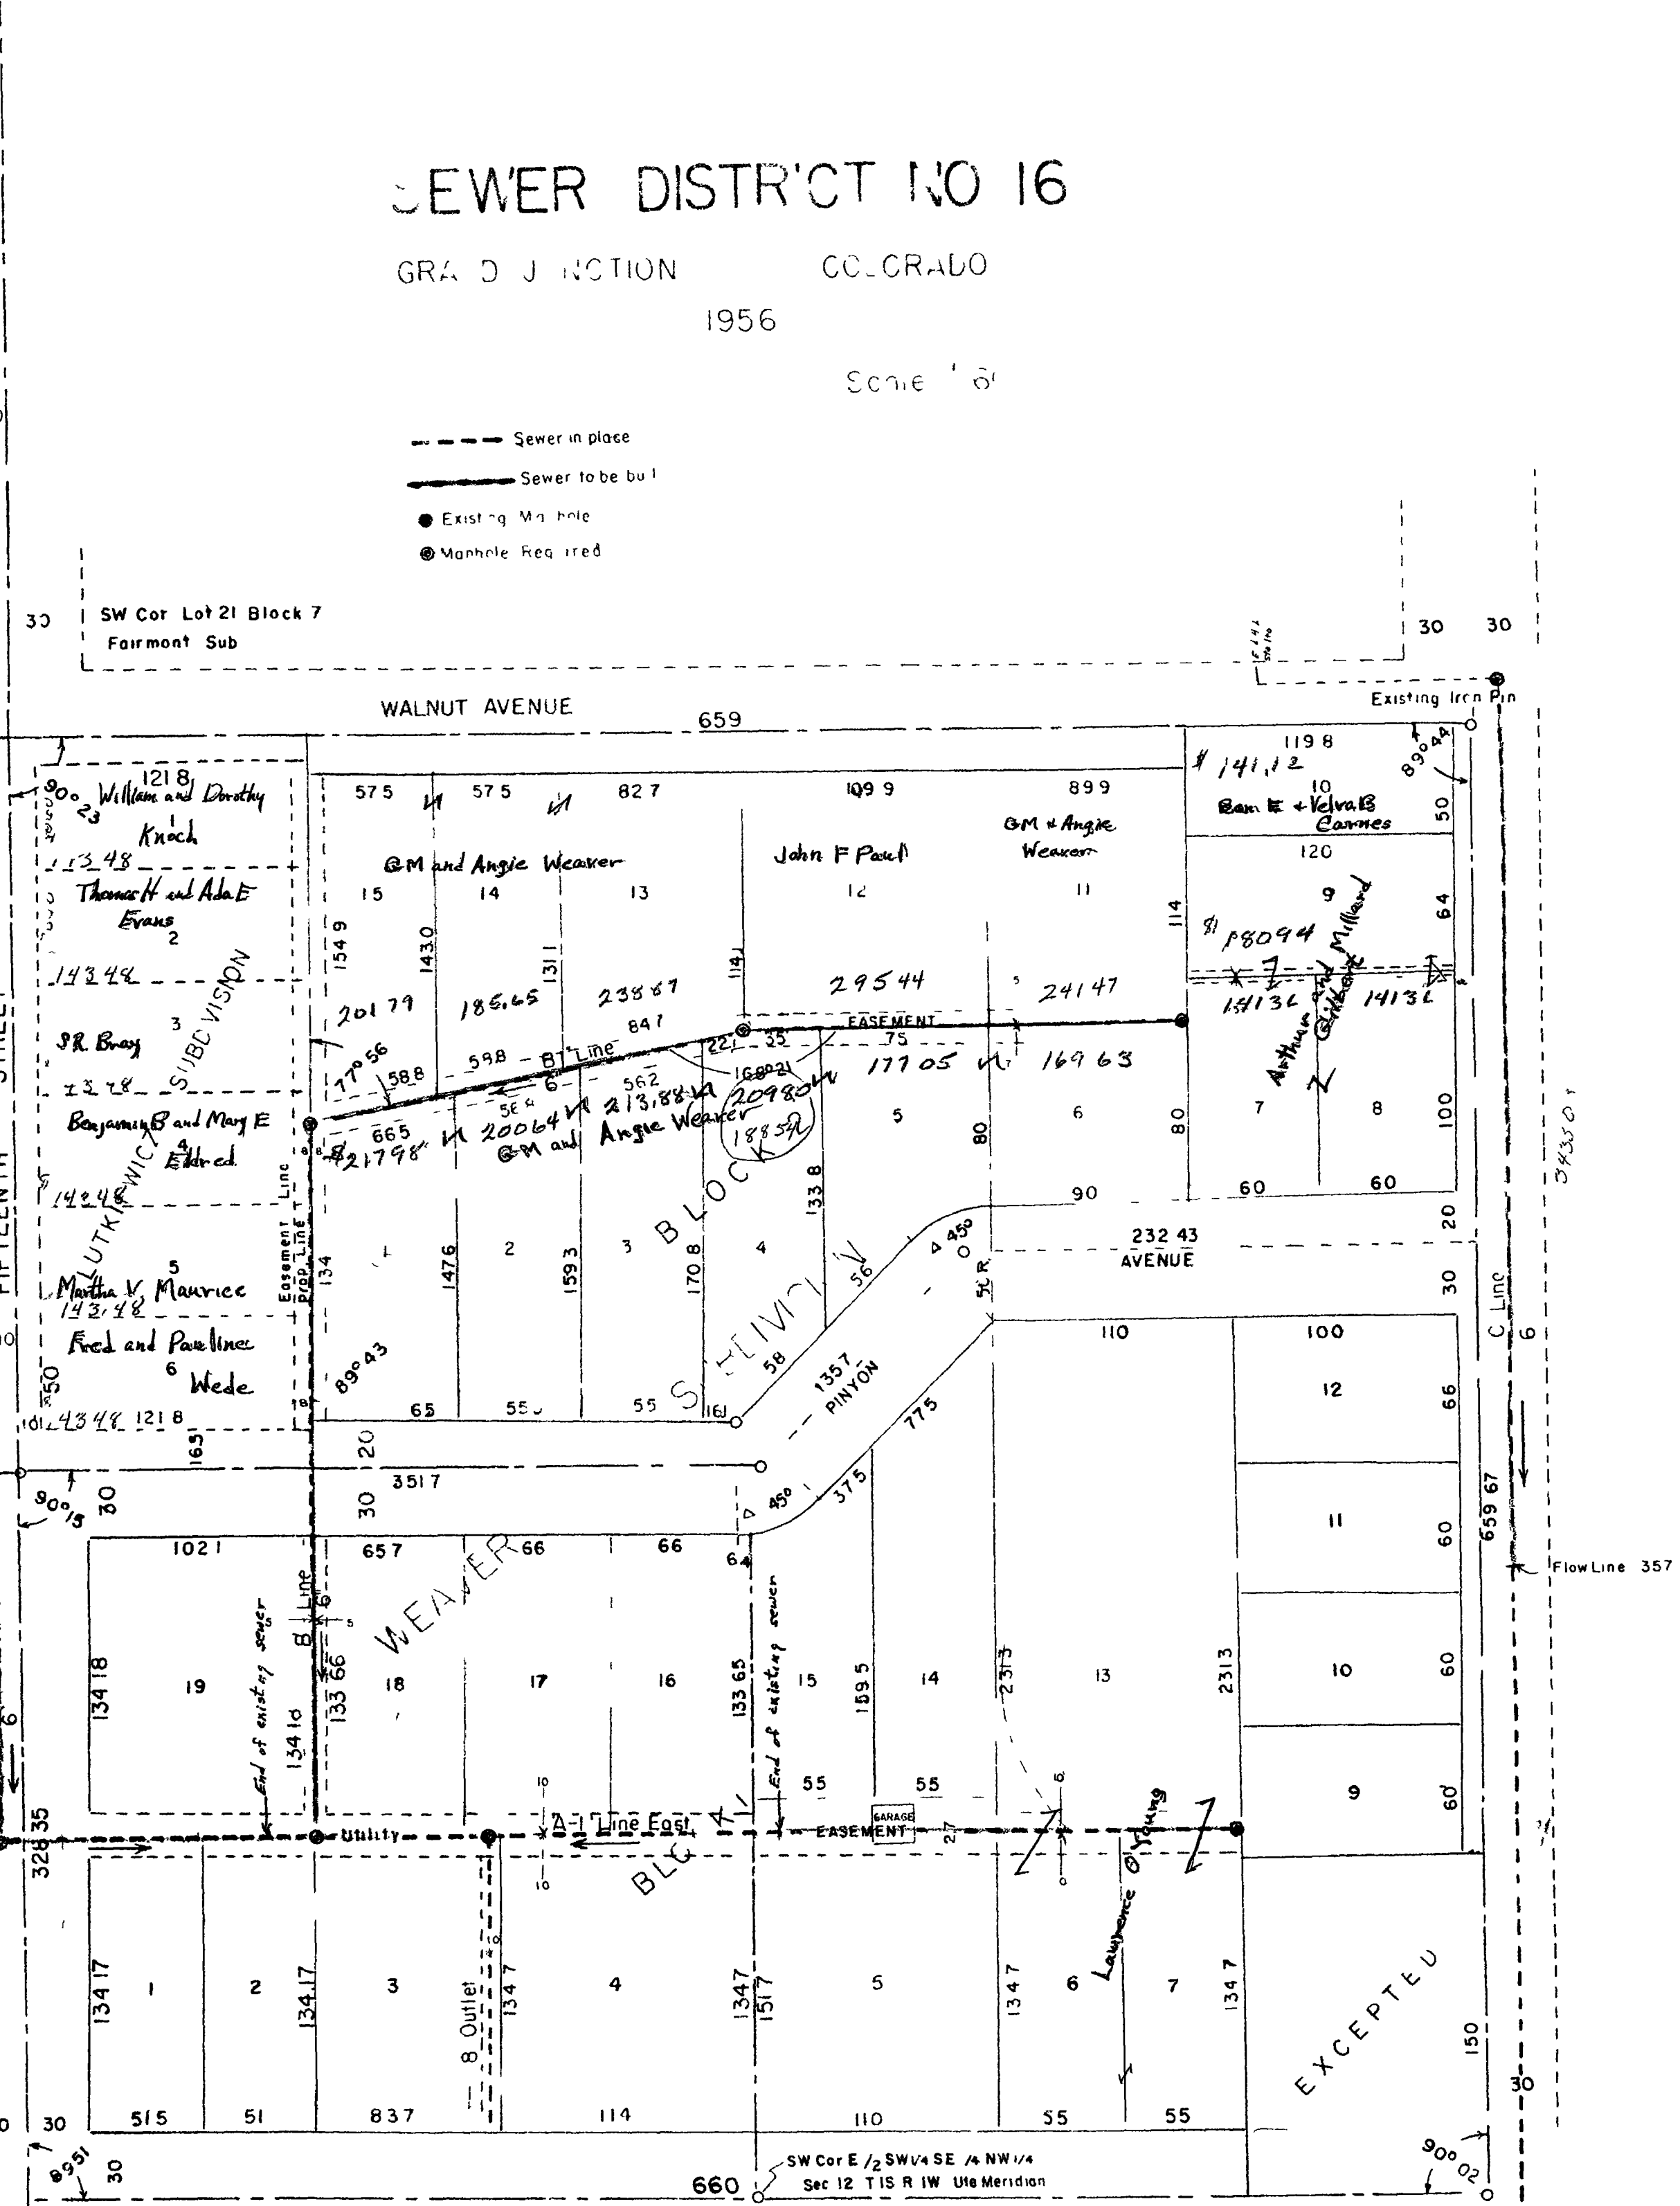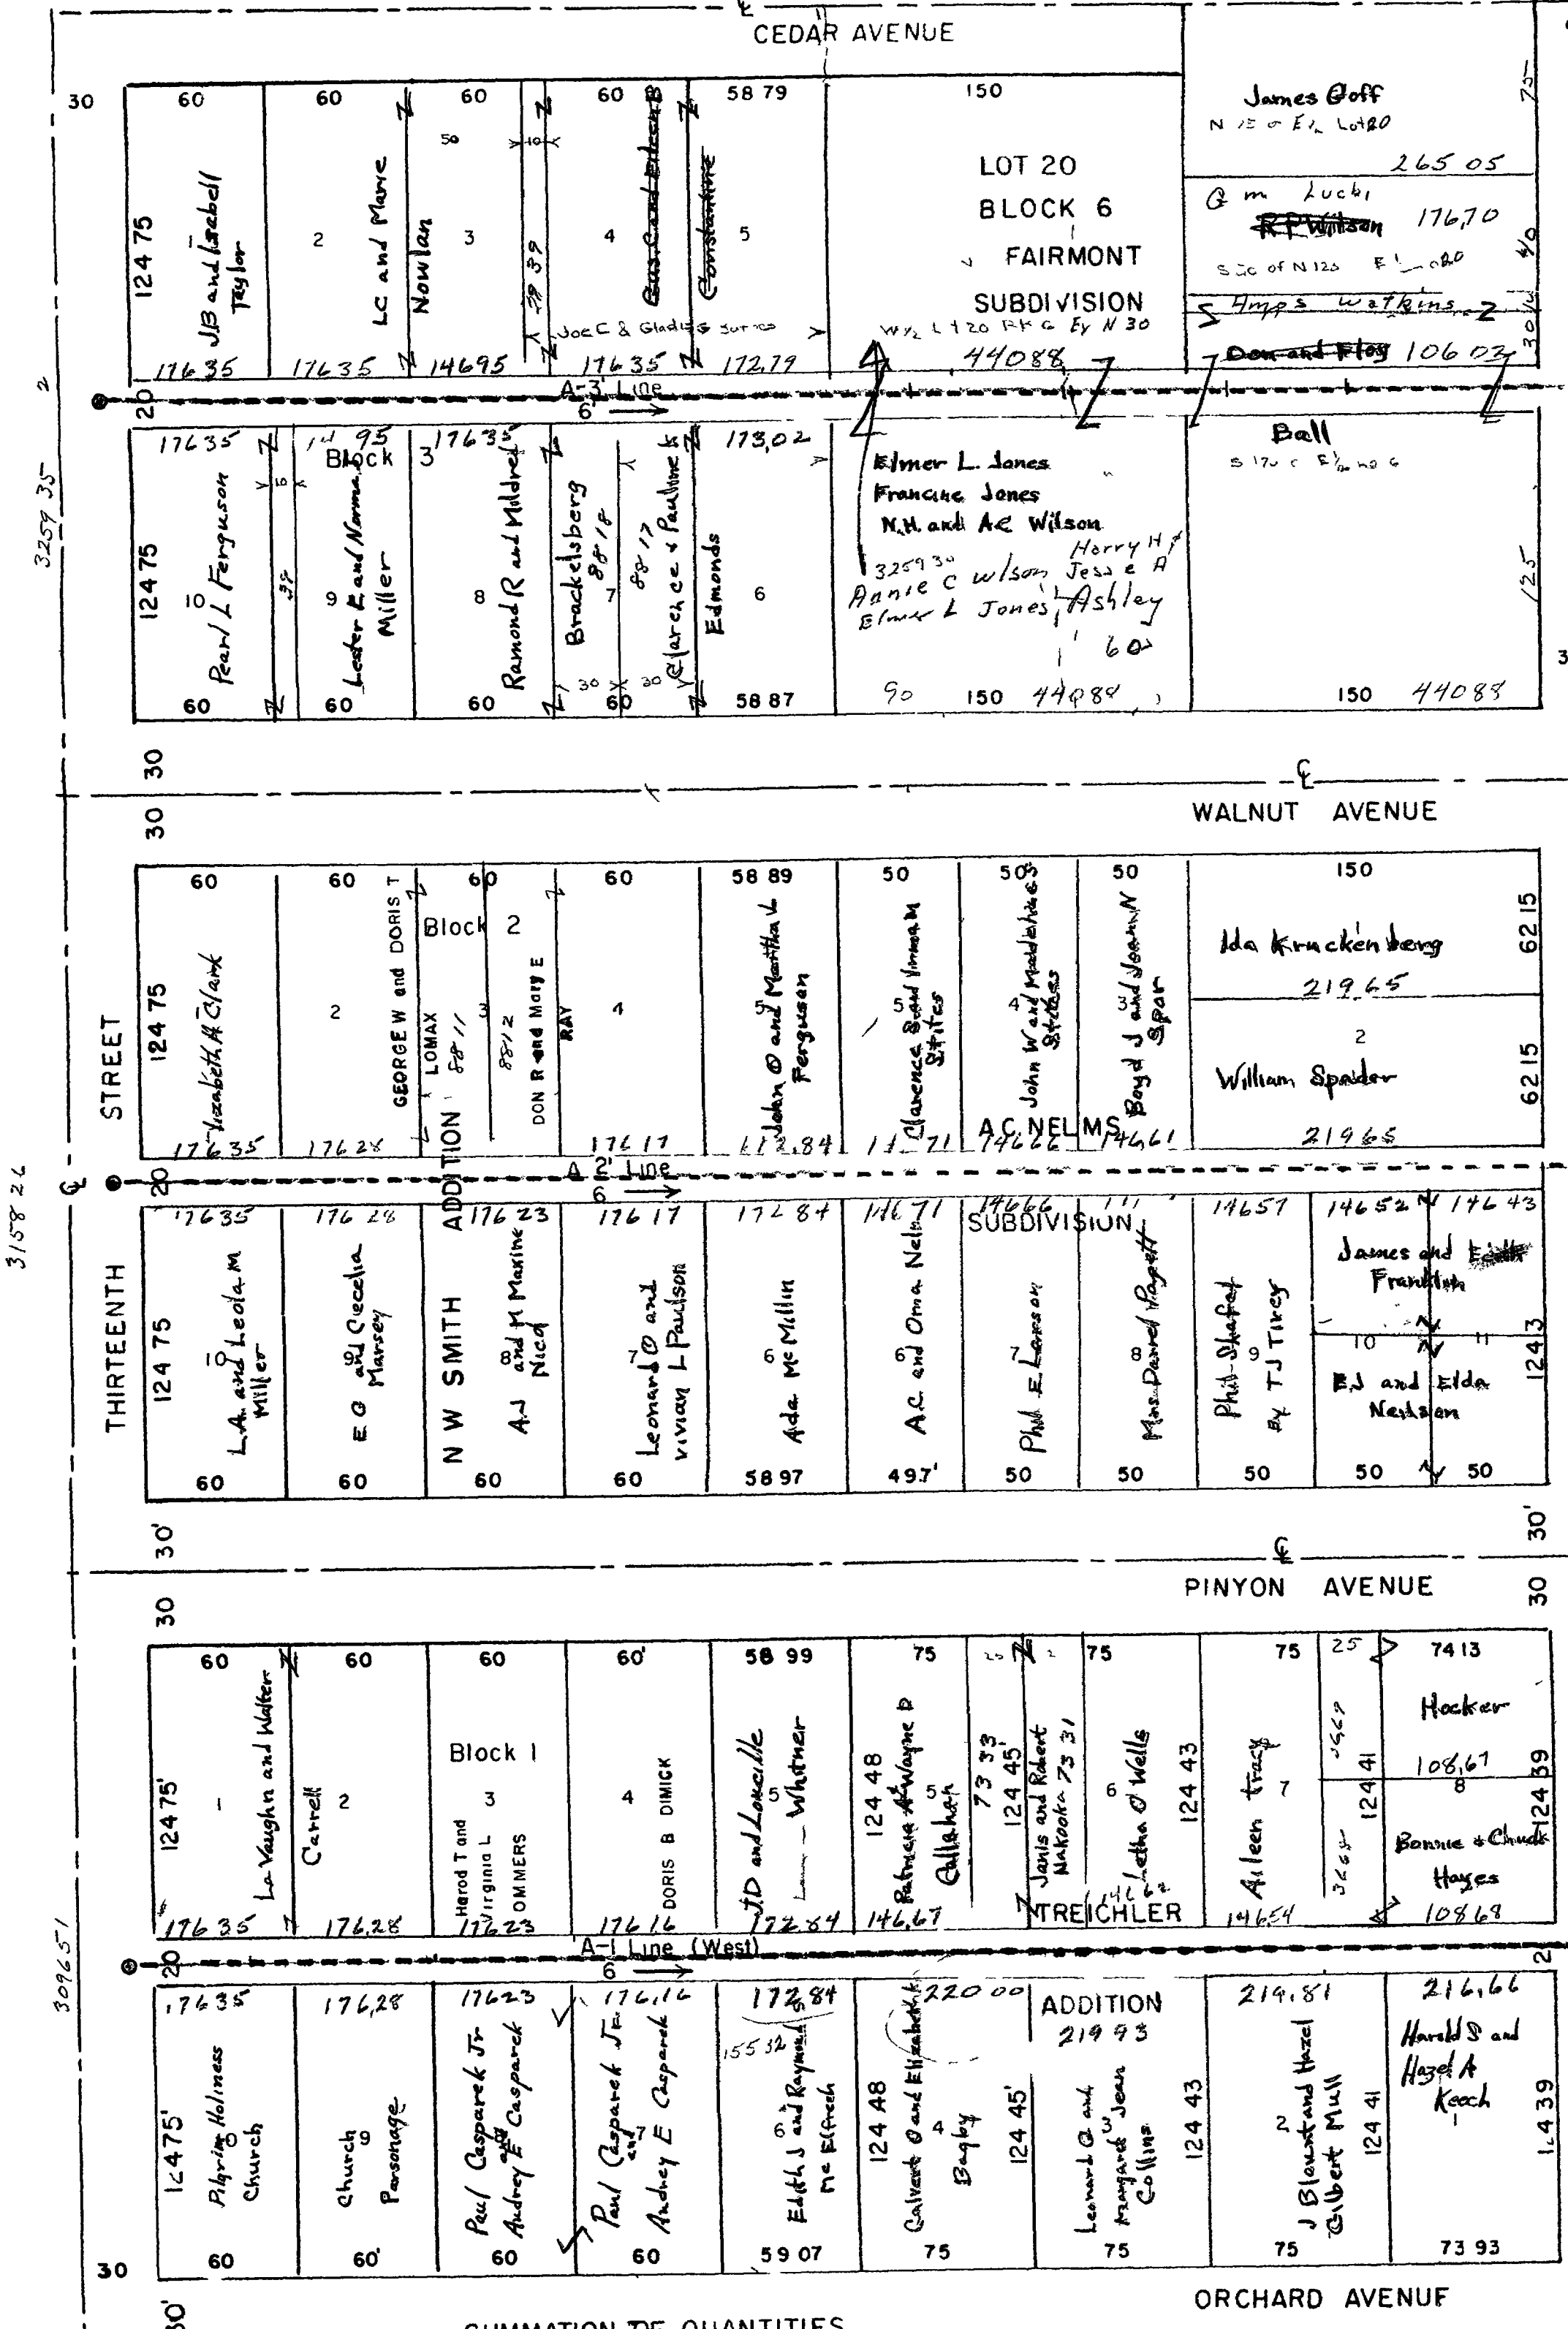

SUMMATION OF QUANTITIES

Total Lin Ft 6 Tile Sewer 3930 41-2 3915
 Standard Manholes Required 13
 Total Y Fittings Required 76 80
 Total Lin Ft Sewer Trench 4158 415
 Special Trench 24

02094503.tif

CEDAR AVENUE

JEWEL DISTRICT NO 16

OF THE CITY OF CO COLO


956

Scale 6"

Enter Sewer Line Relocated to East of Main Line

Sewer Y Locations

- Sewer in place
- - - Sewer to be built
- Existing Manhole
- Mark to be built

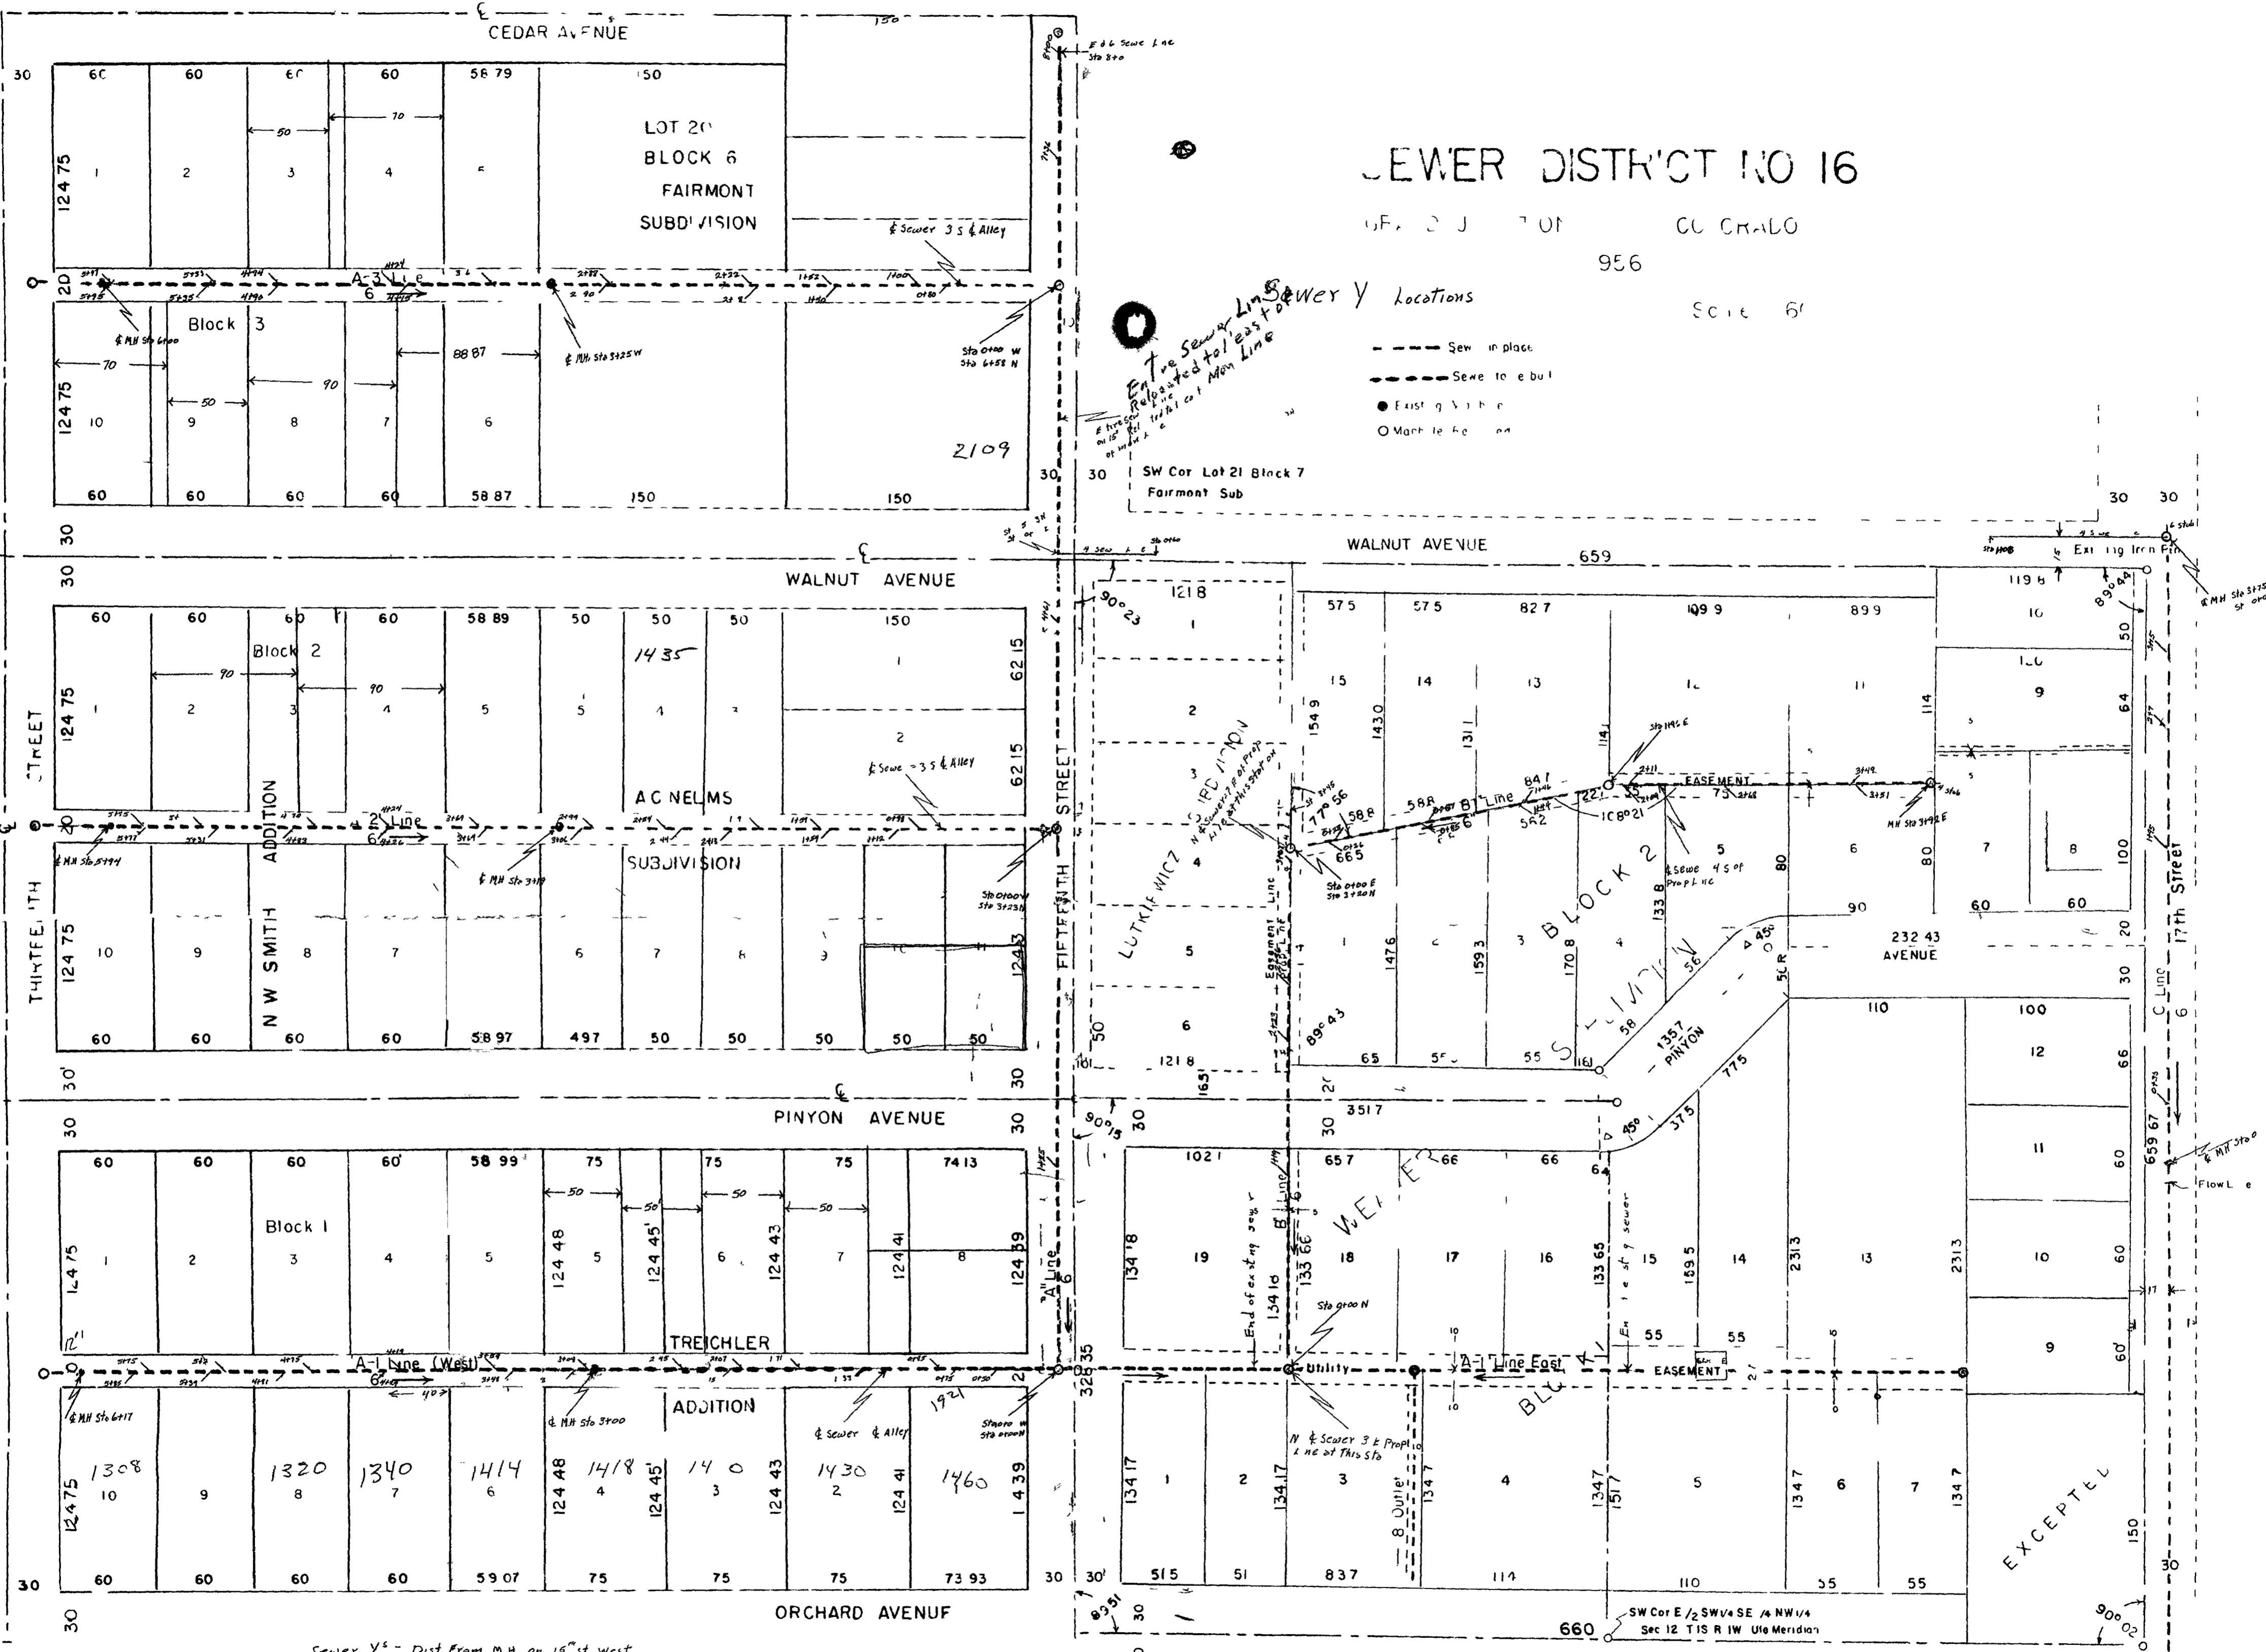

SUMMATION OF QUANTITIES

- Total Lin Ft 6 Tile Sewer 3891
- Standard Manholes Required 13
- Total Y Fittings Required 80
- Total Lin Ft Special Trench 24
- Total Lin Ft of All Trenching 4155

02094504.tif

