







LOCATION MAP
ORCHARD MESA - SANITARY SEWER

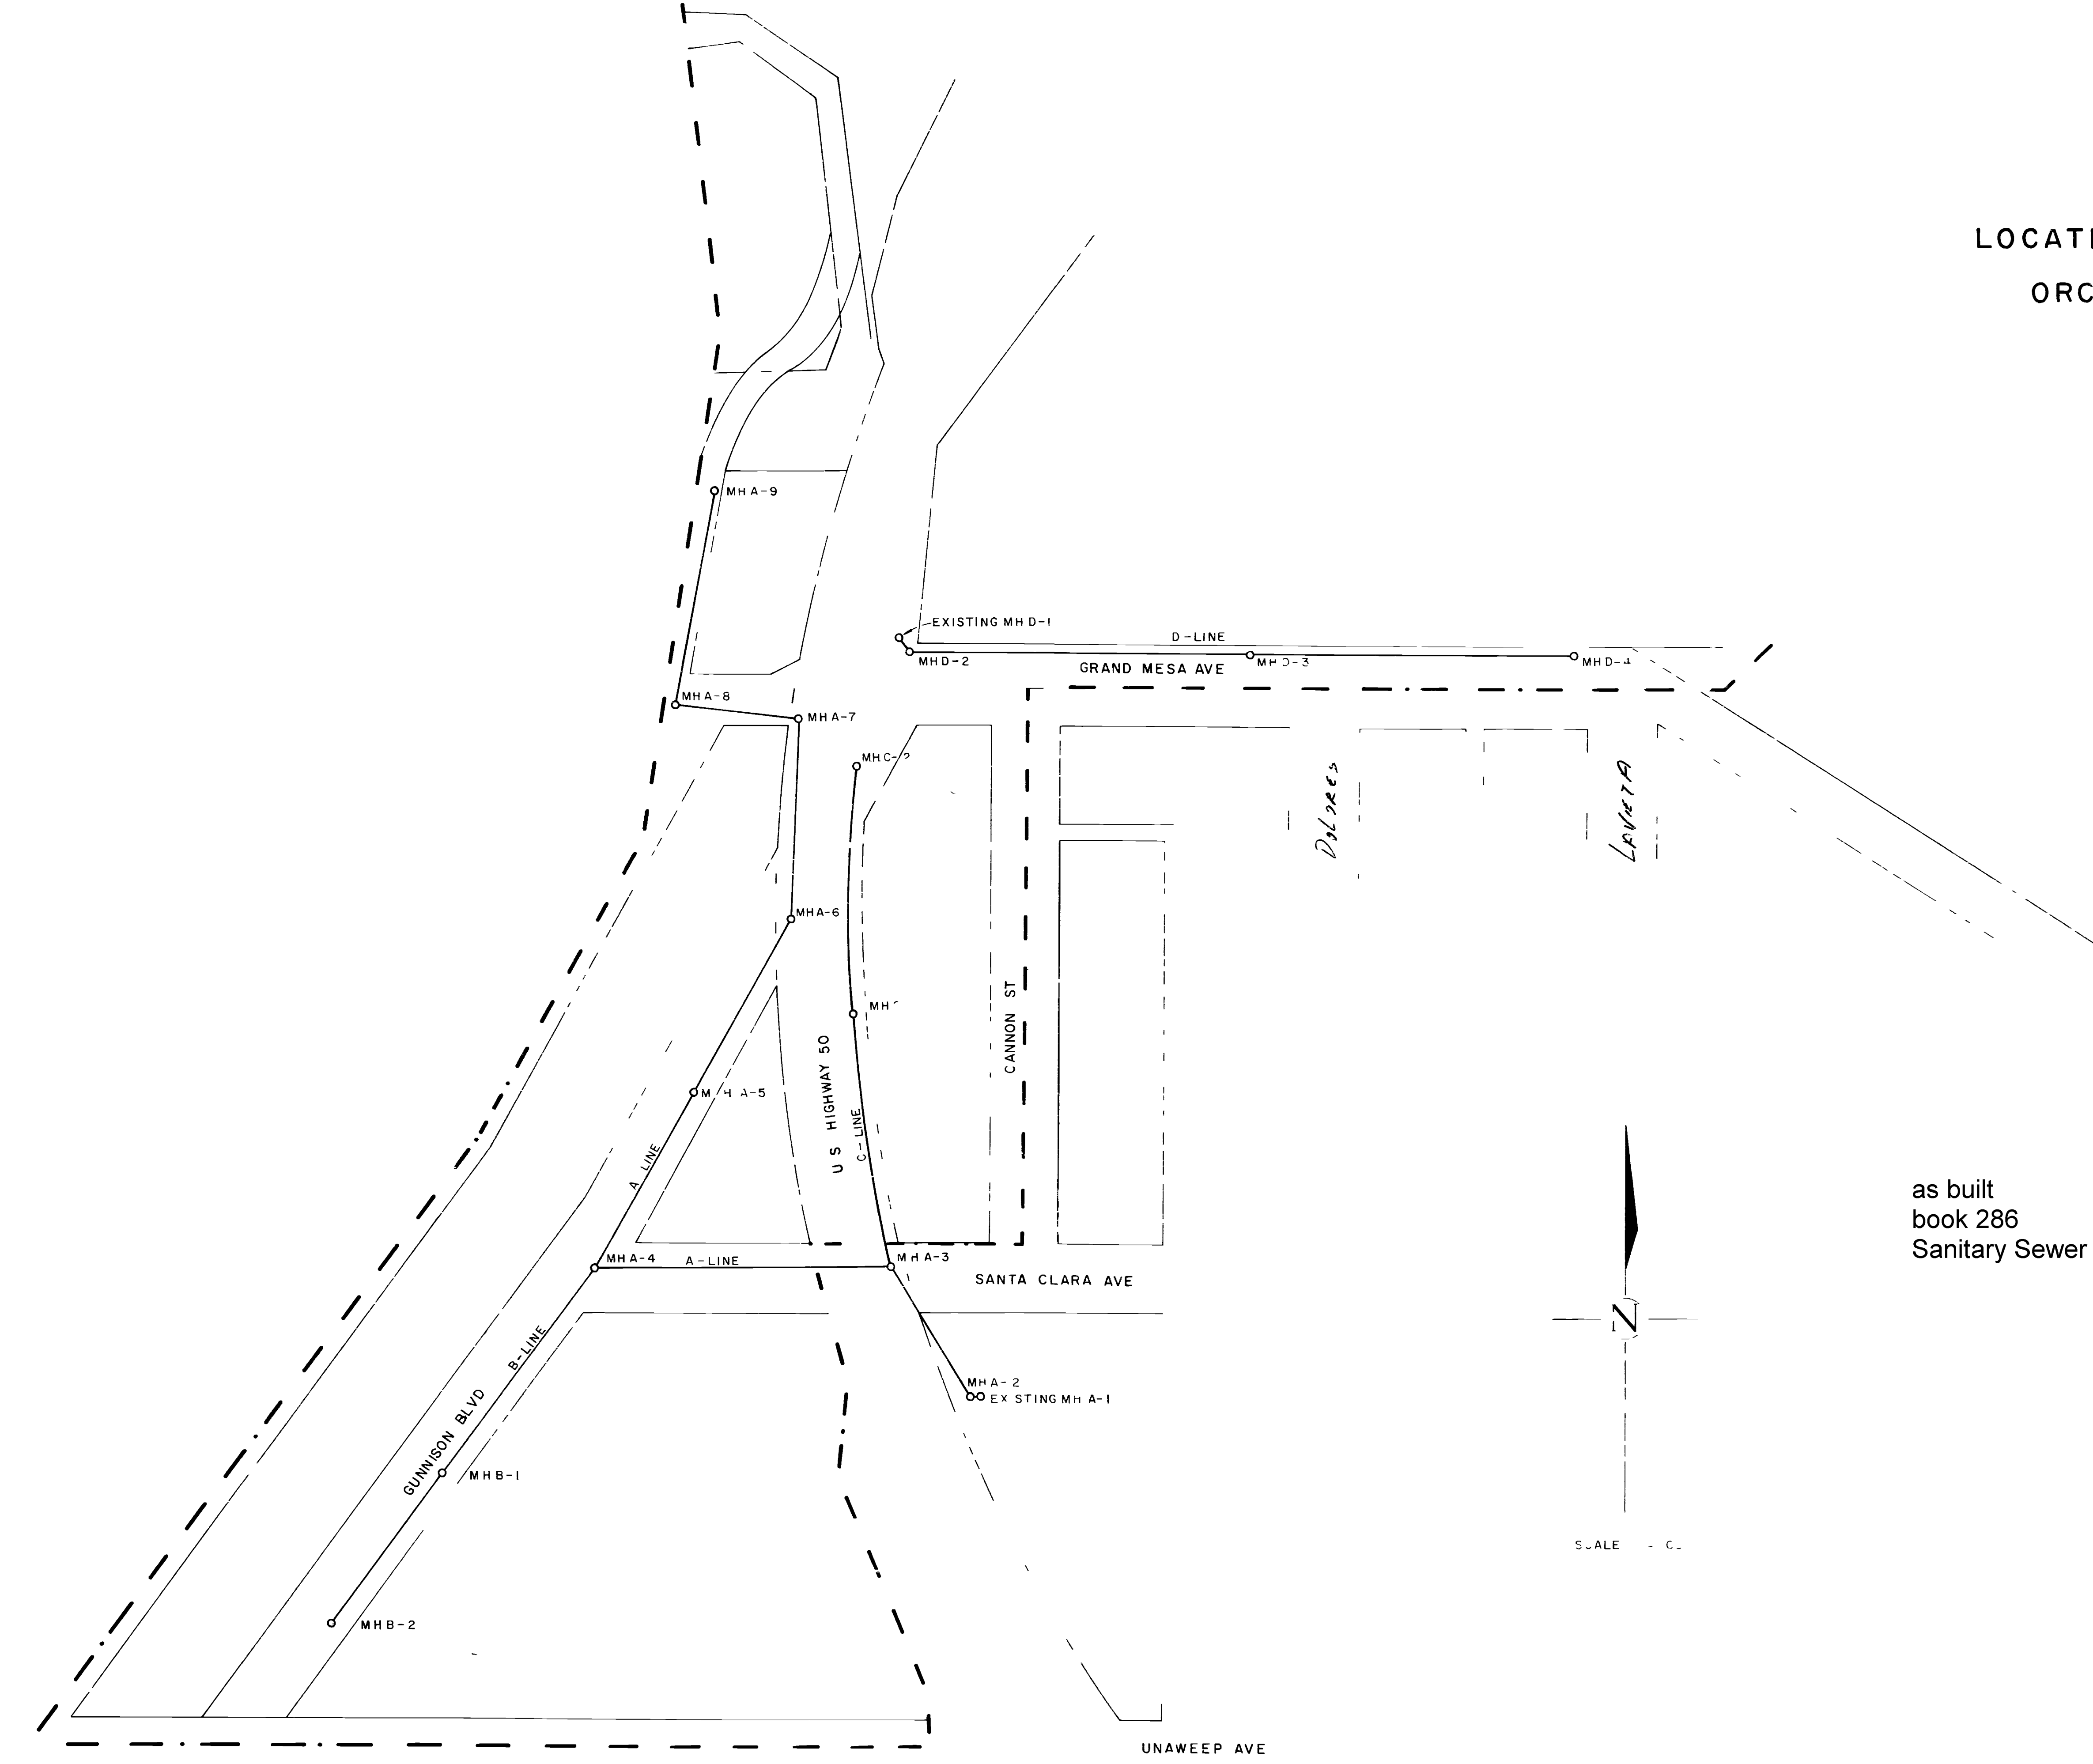

as built
book 286
Sanitary Sewer District 27-70


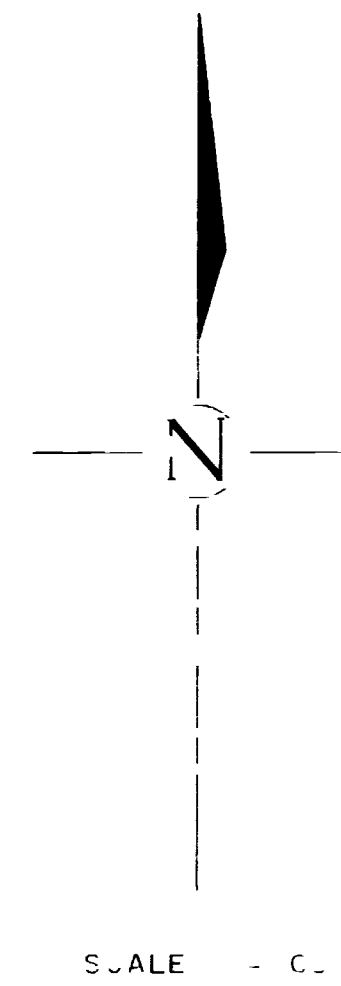


Examined by
3/23/20
Carl J. Balkum, P.E.

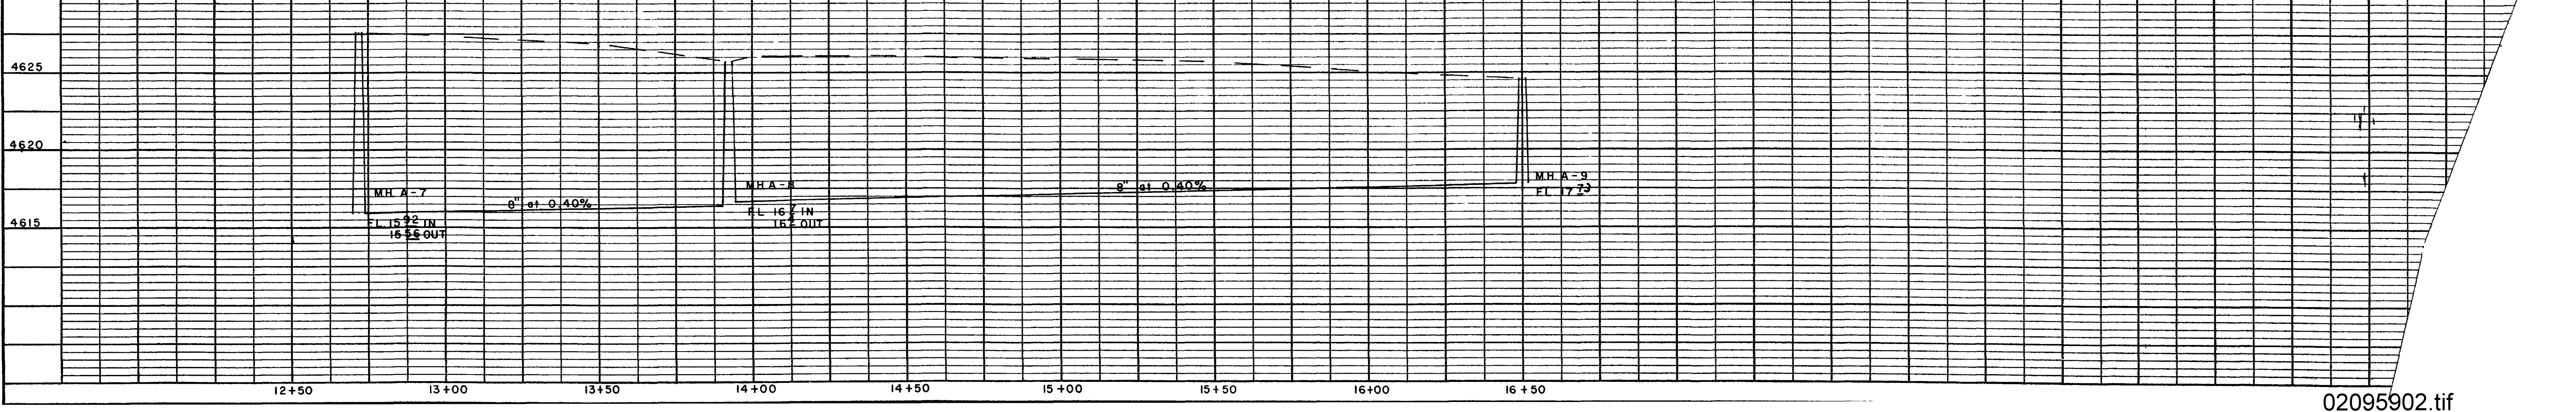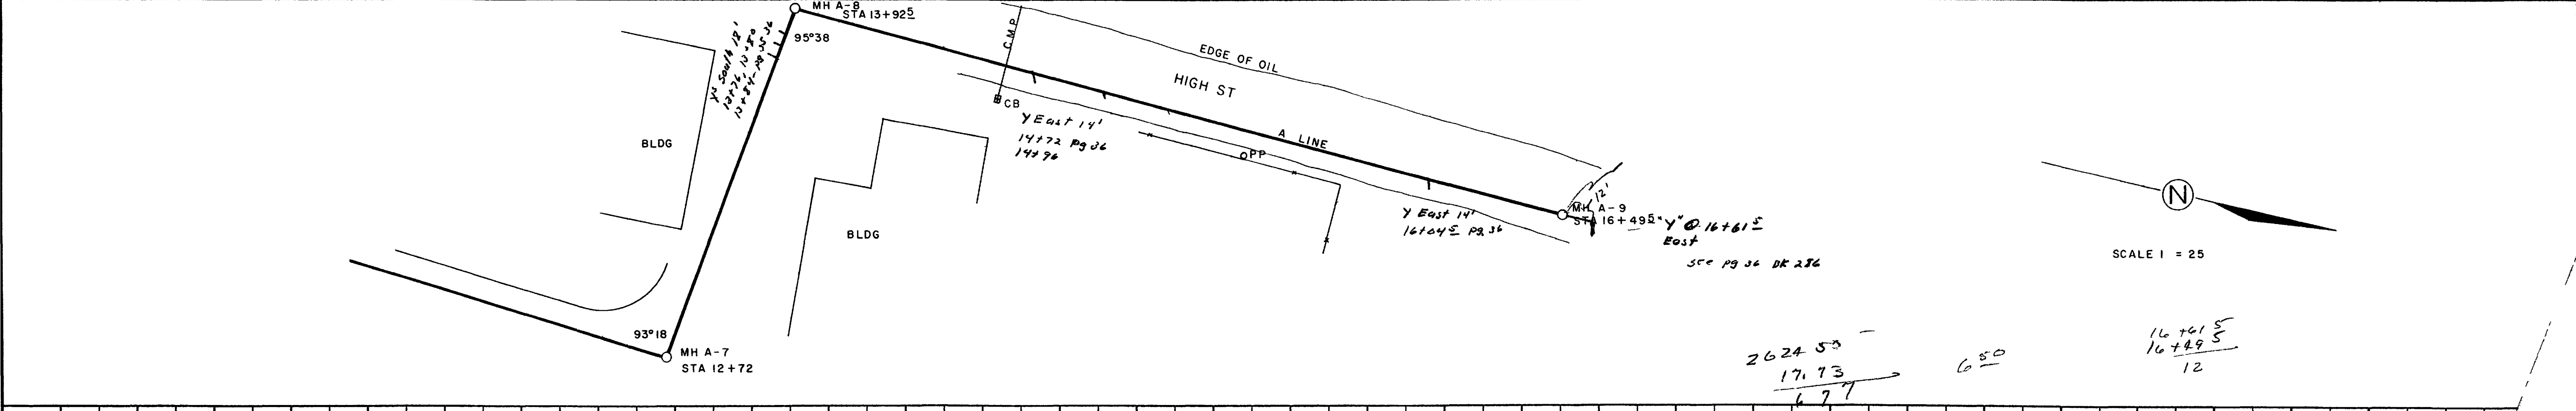
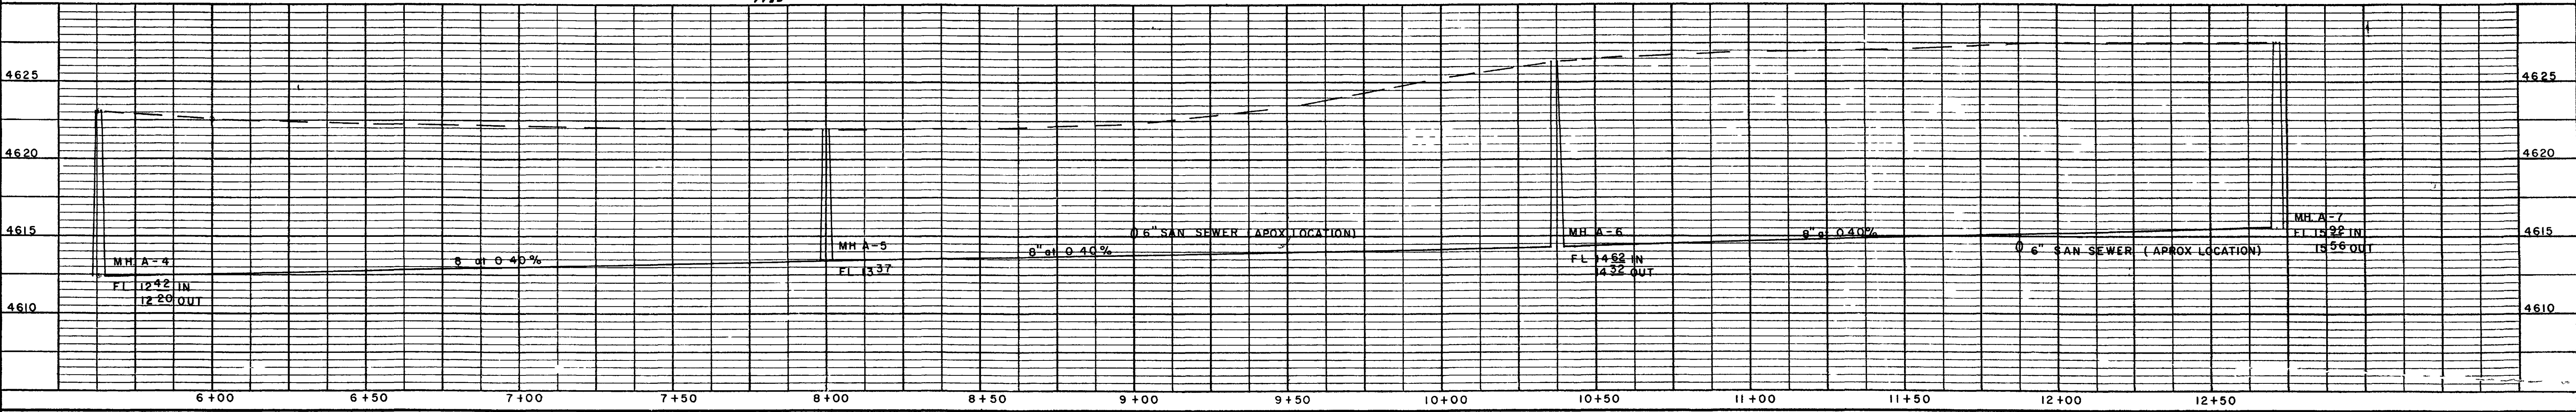
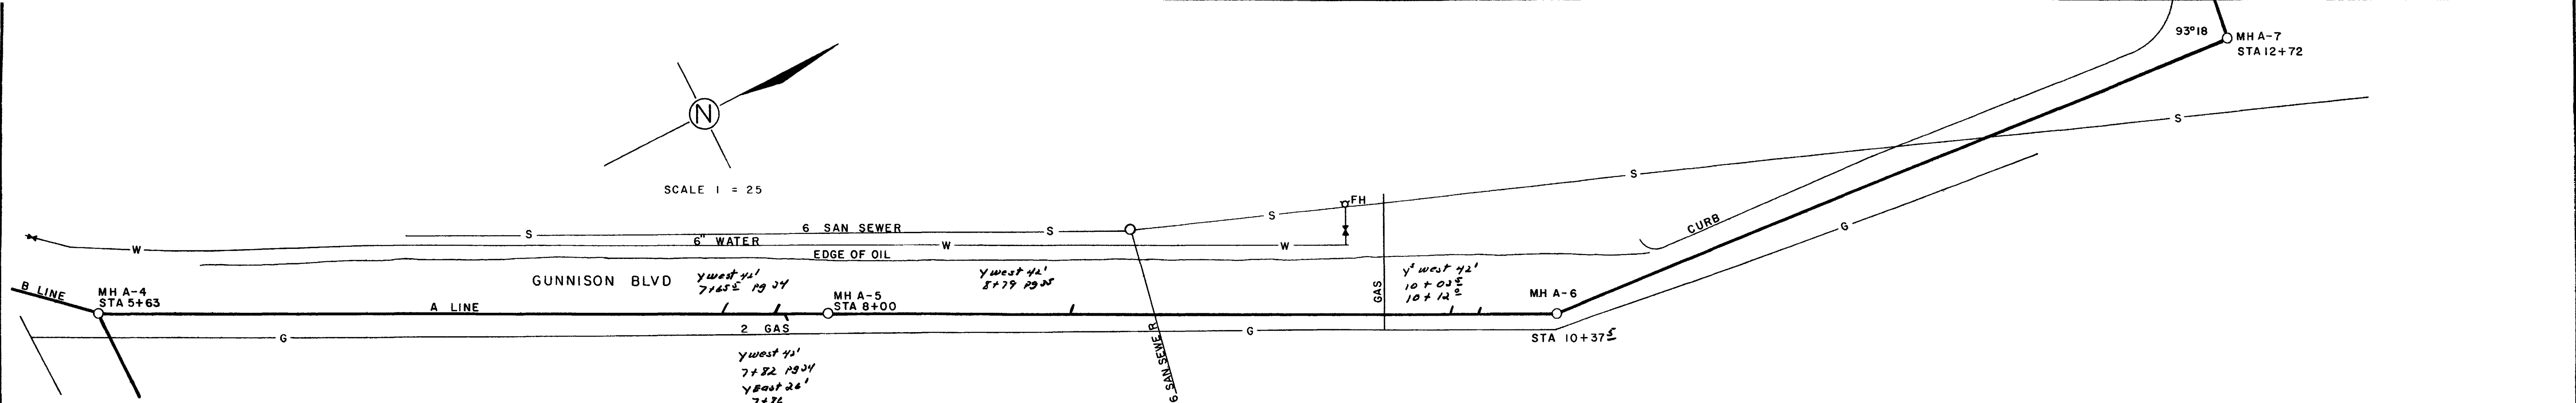


$$\begin{array}{r} 2624.53 \\ 17.73 \\ \hline 6.77 \end{array}$$

$$\frac{16+49.5}{12}$$

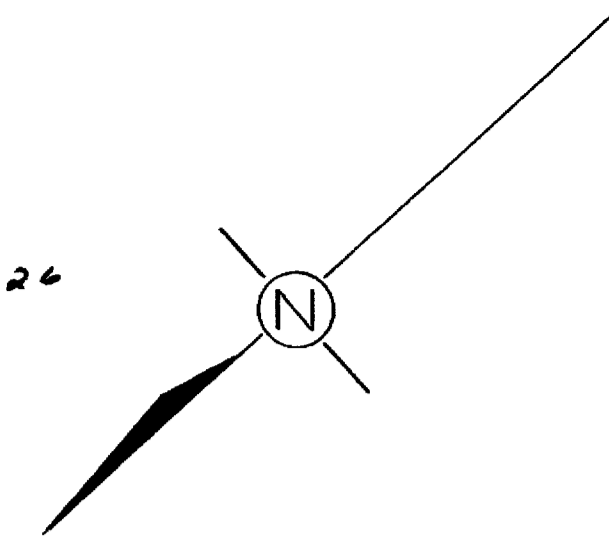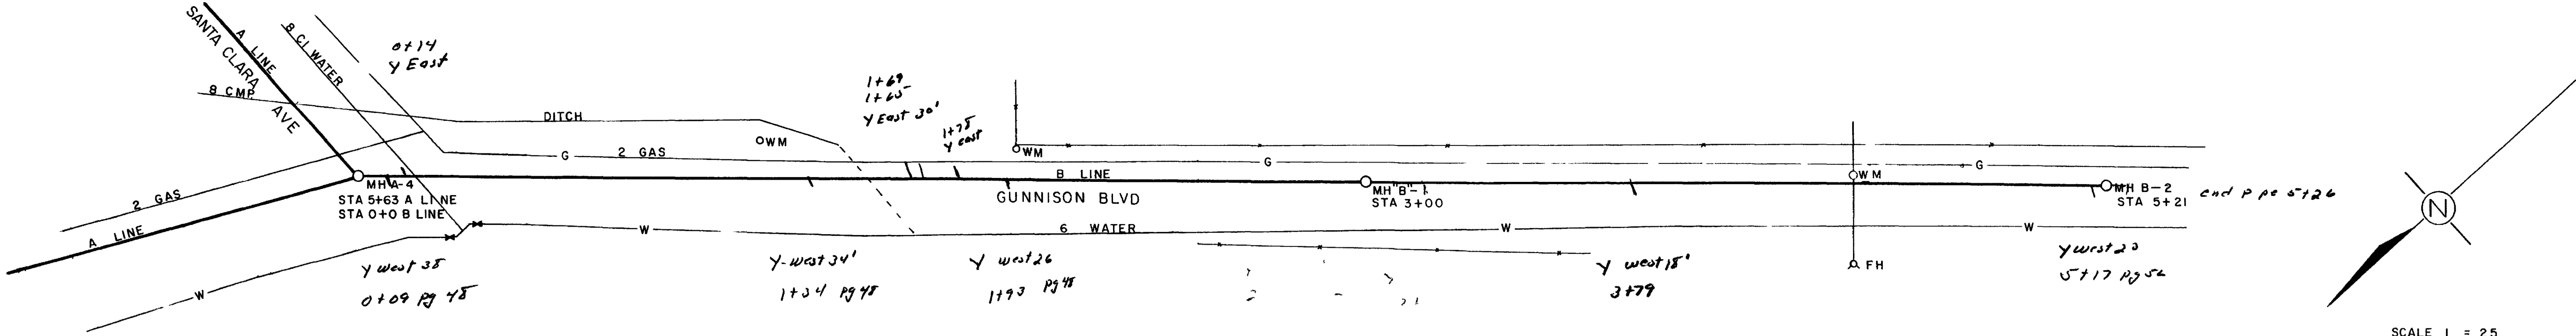

SCALE 1" = 25'

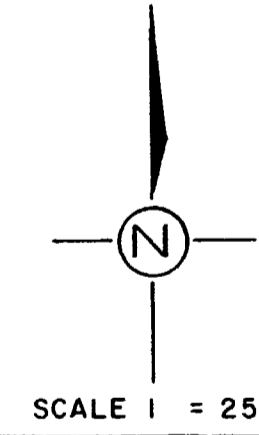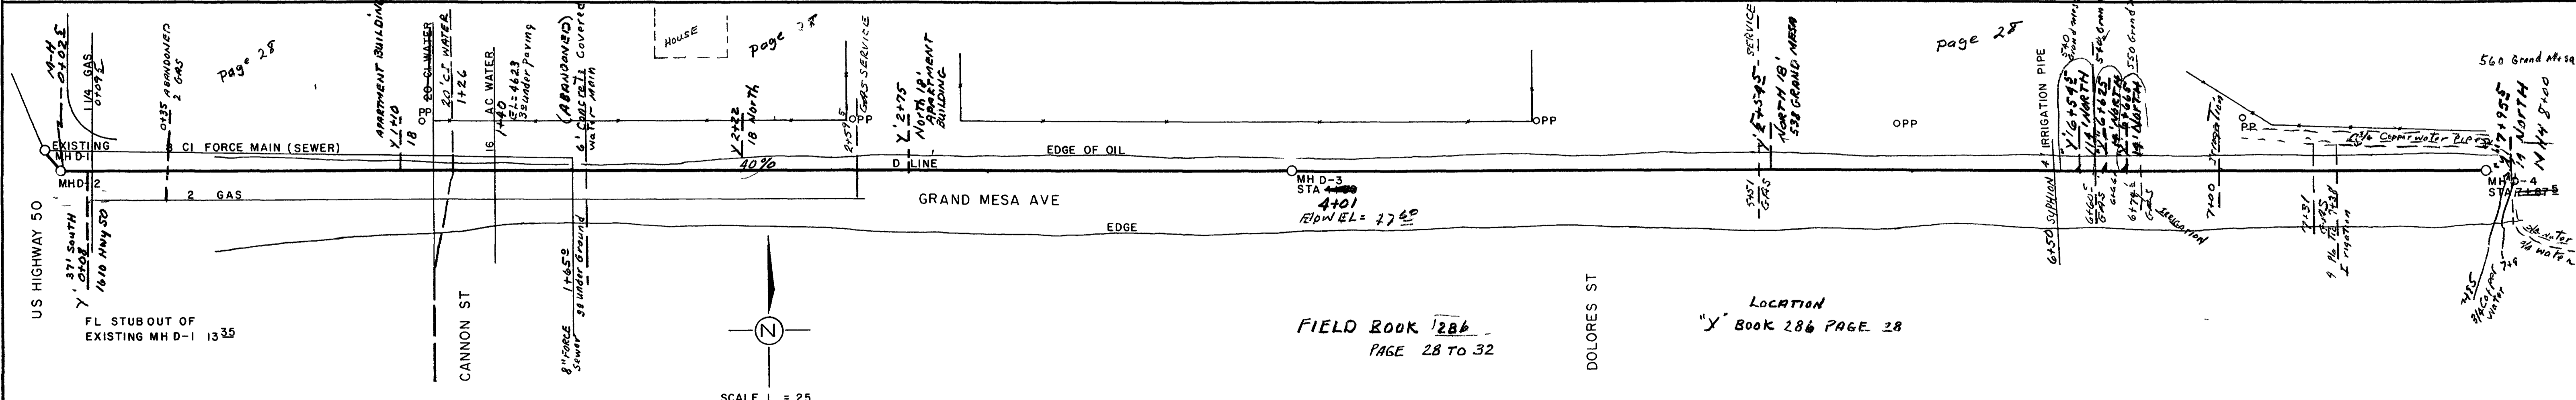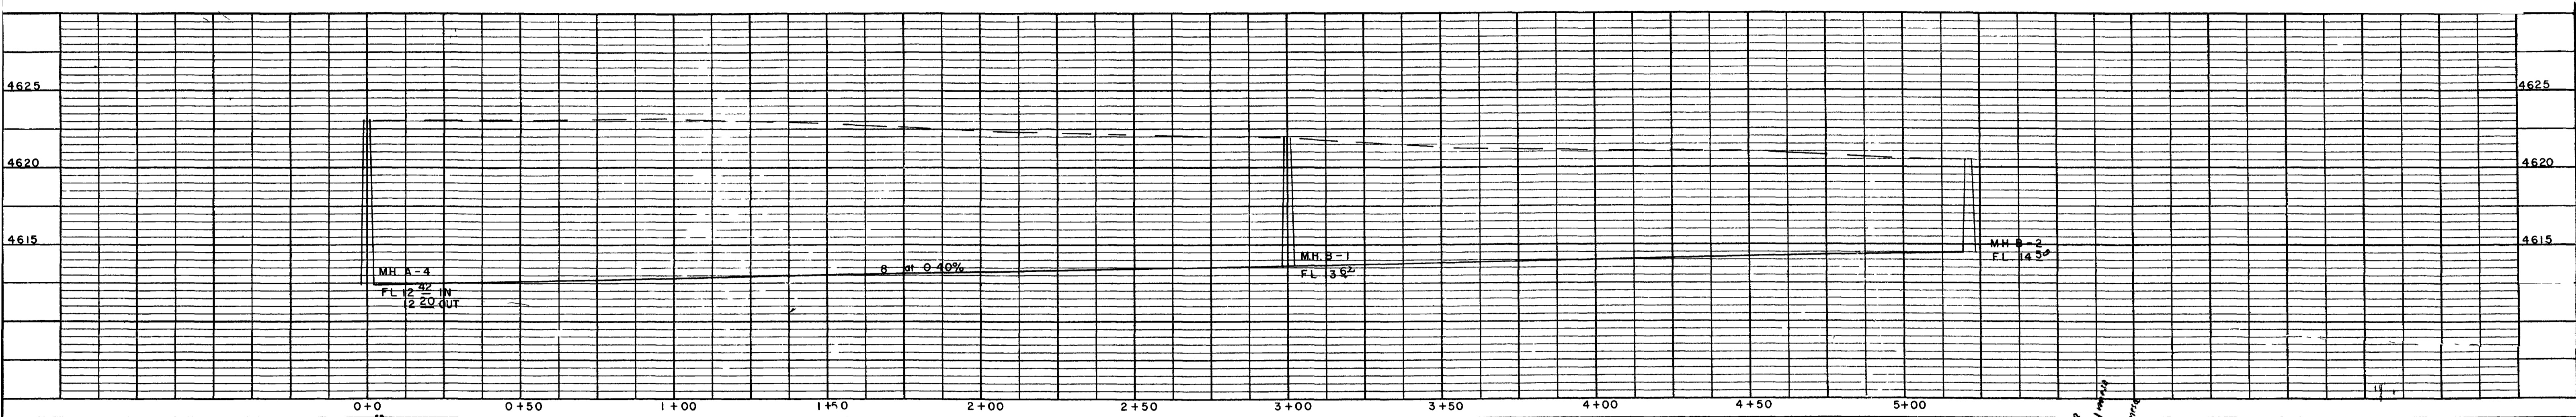

SCALE 1" = 25'

