


LOCATION MAP

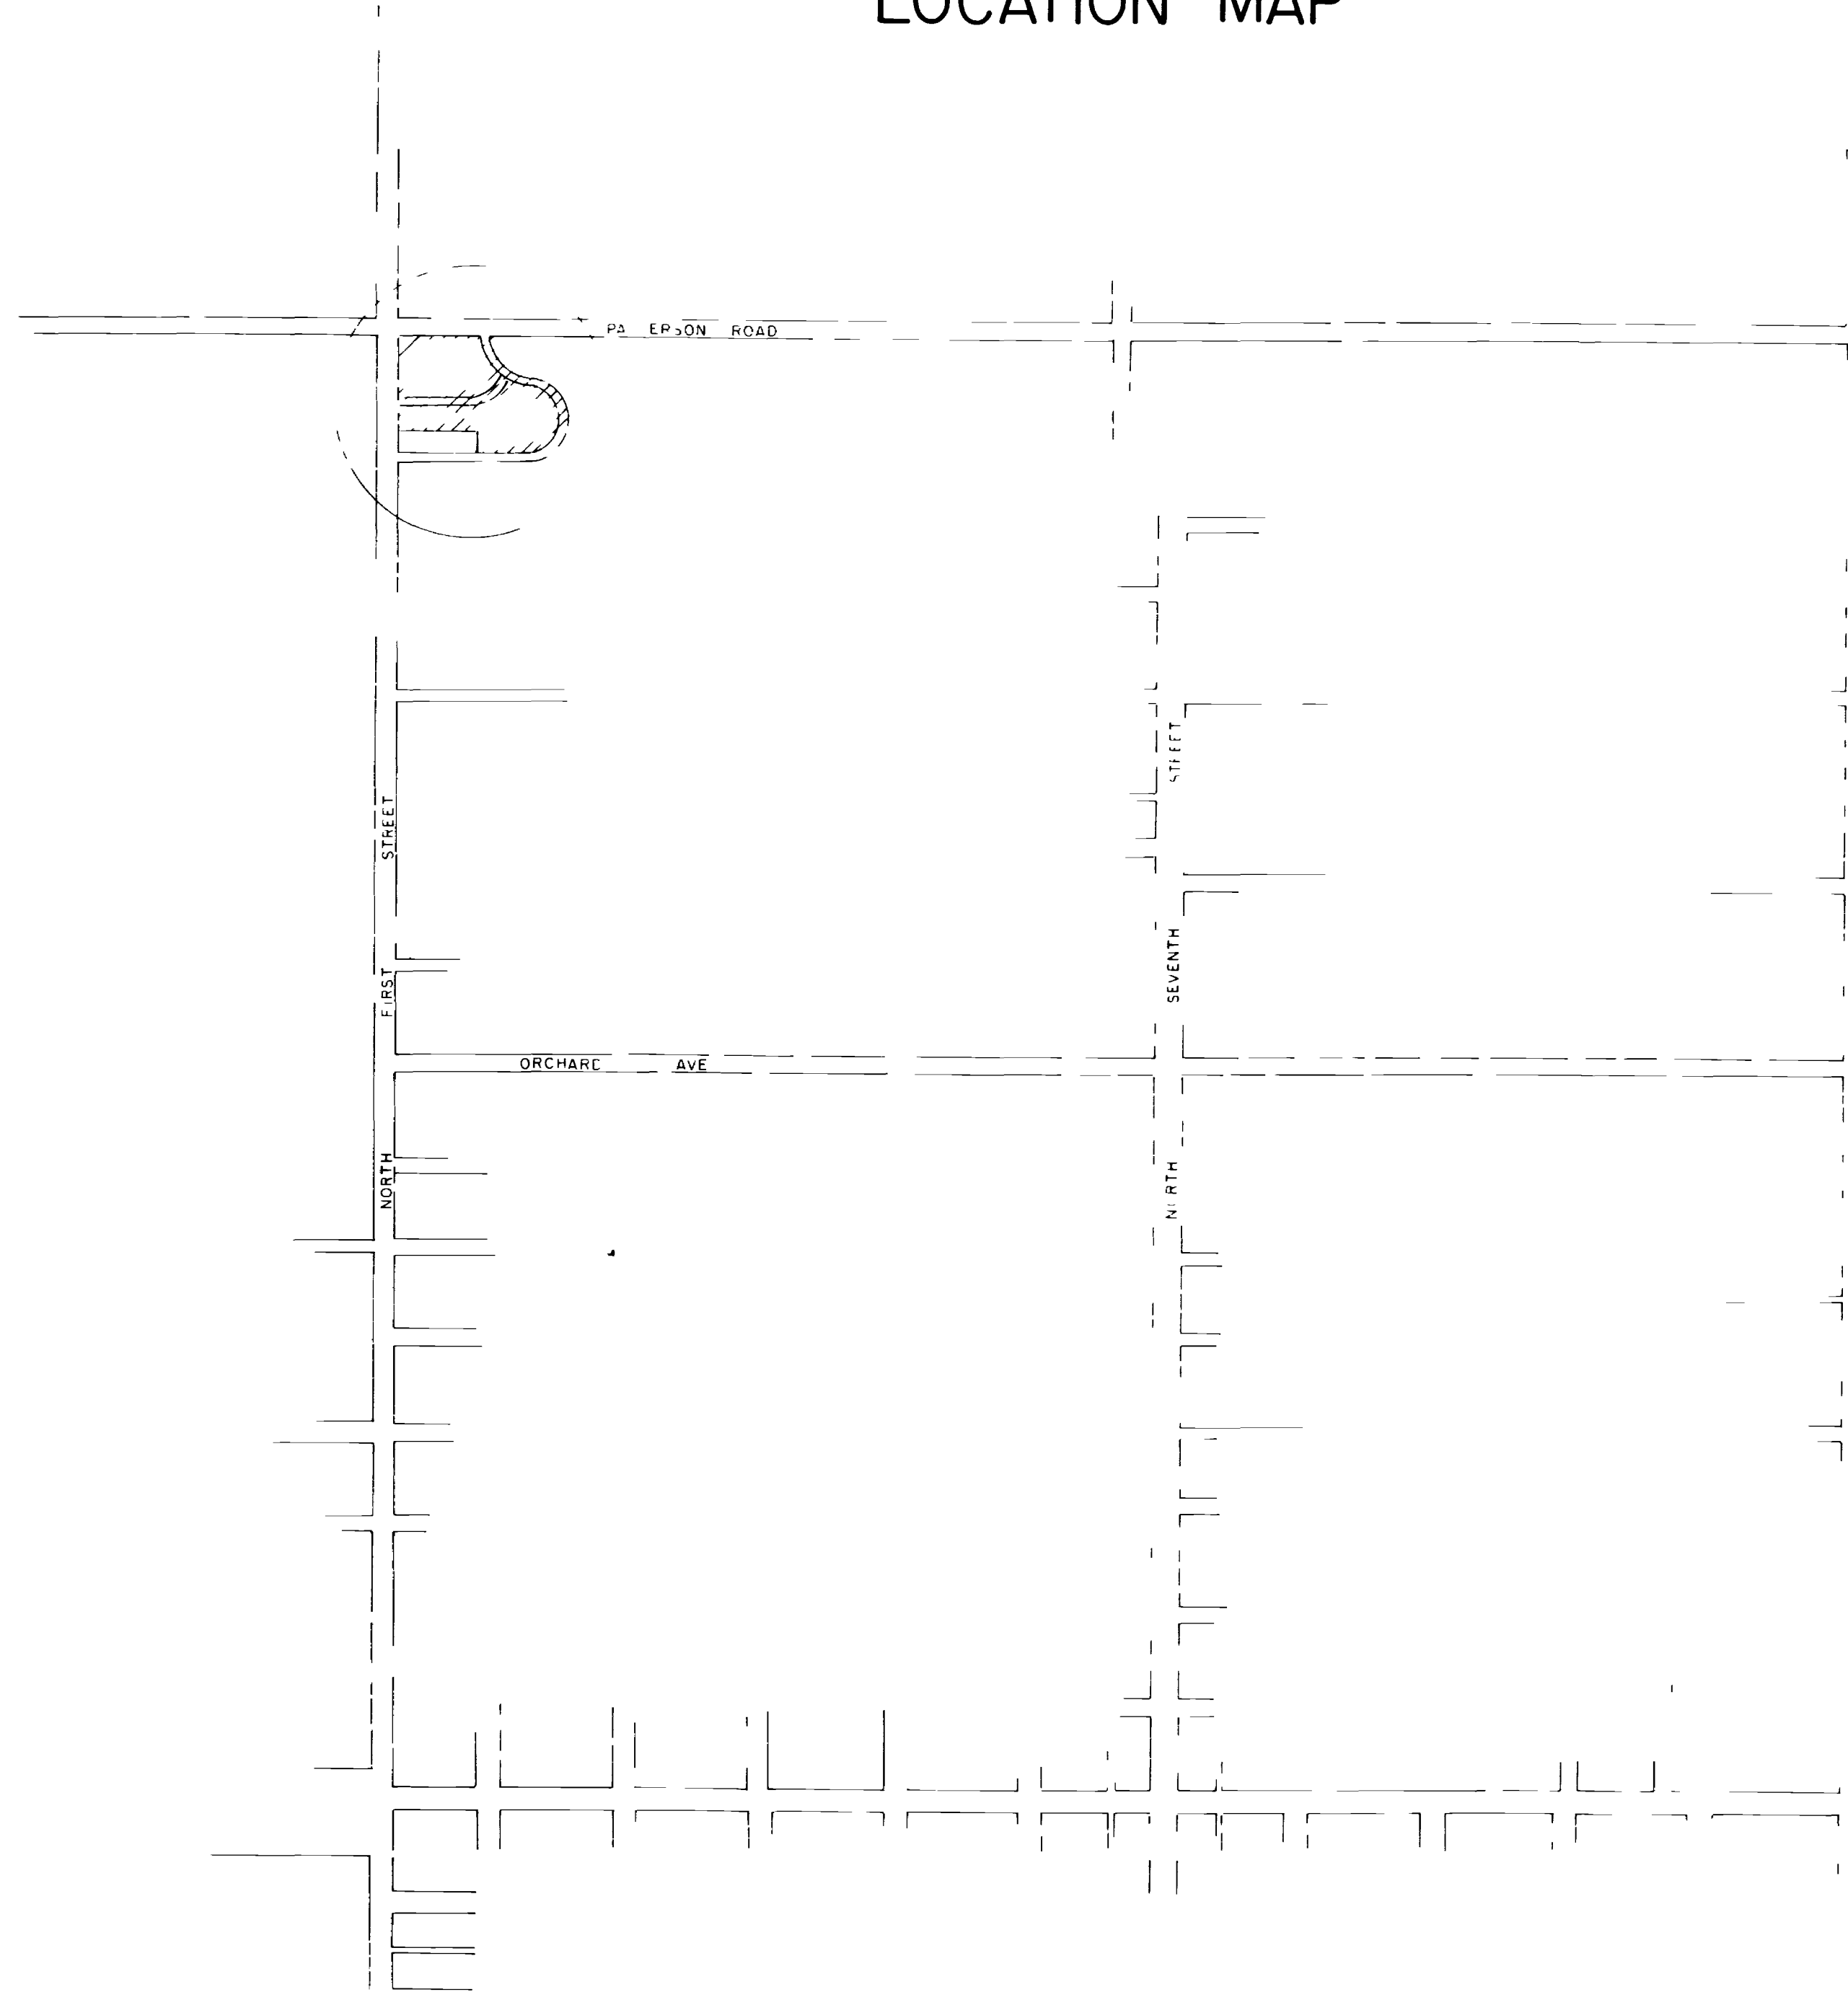

SCALE 1" = 40'


SANITARY SEWER DISTRICT 25 - 69

1969


CITY OF GRAND JUNCTION COLORADO

ENGINEERING DEPARTMENT
CITY OF GRAND JUNCTION COLORADO
SANITARY SEWER DISTRICT 25 - 69
1969


02096001.tif

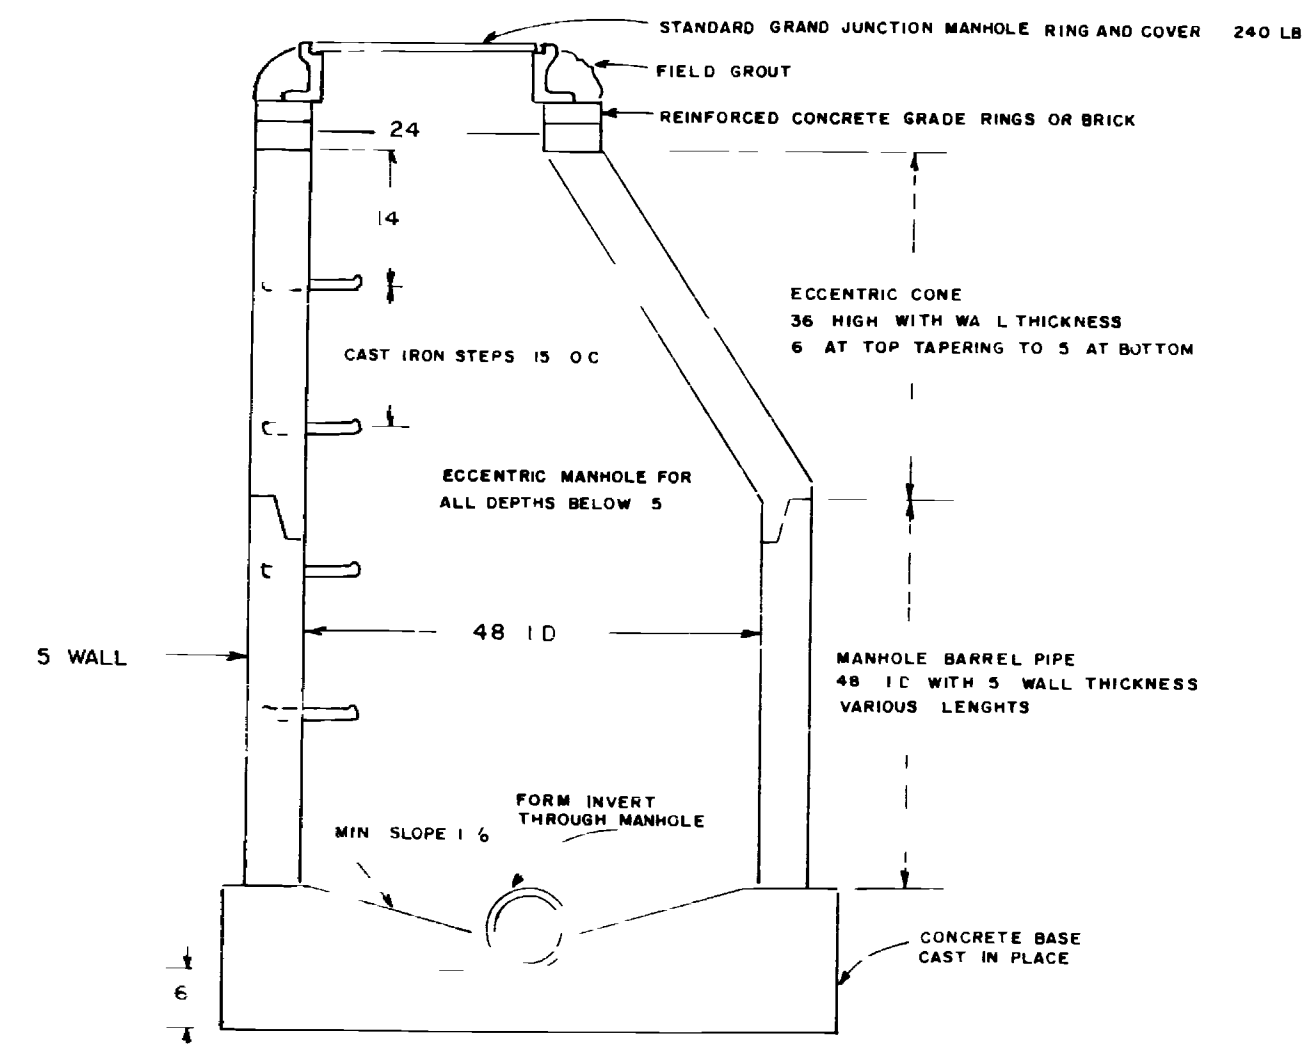


STANDARD SANITARY SEWER MANHOLE

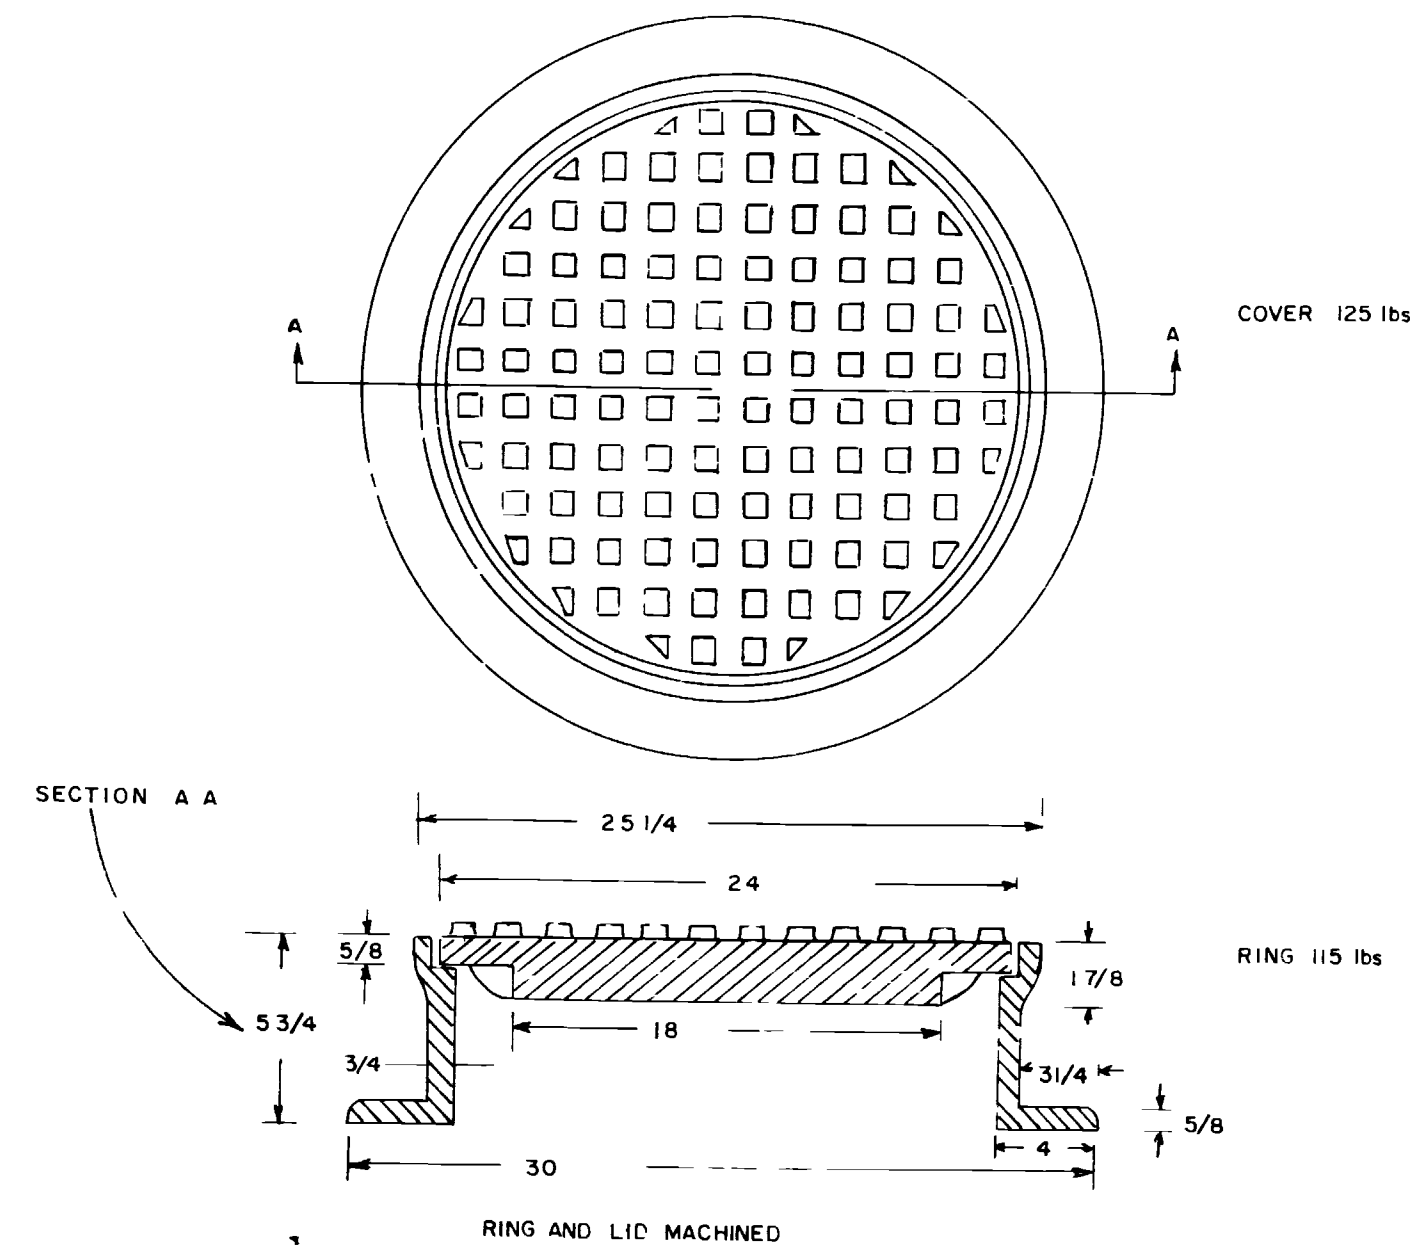


STANDARD GRAND JUNCTION RING & COVER
WT 240 lbs

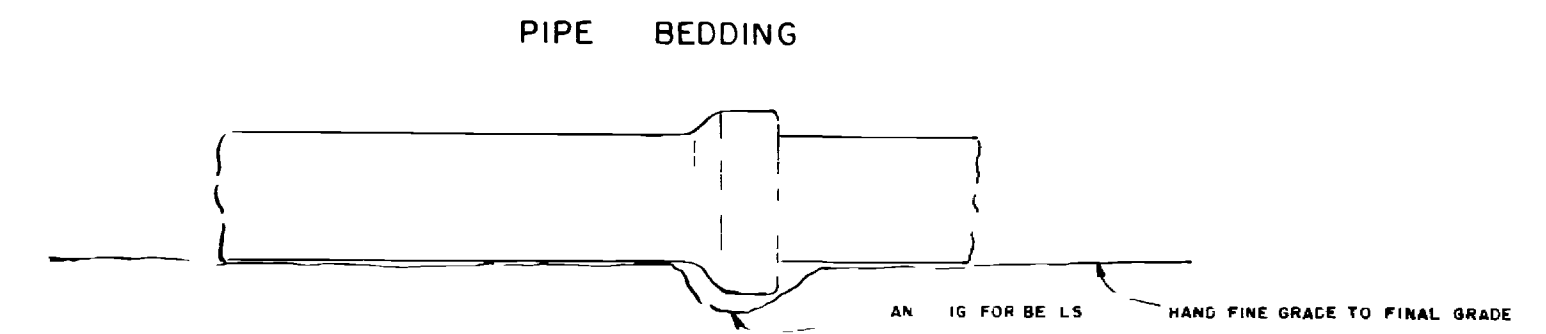

PIPE BEDDING

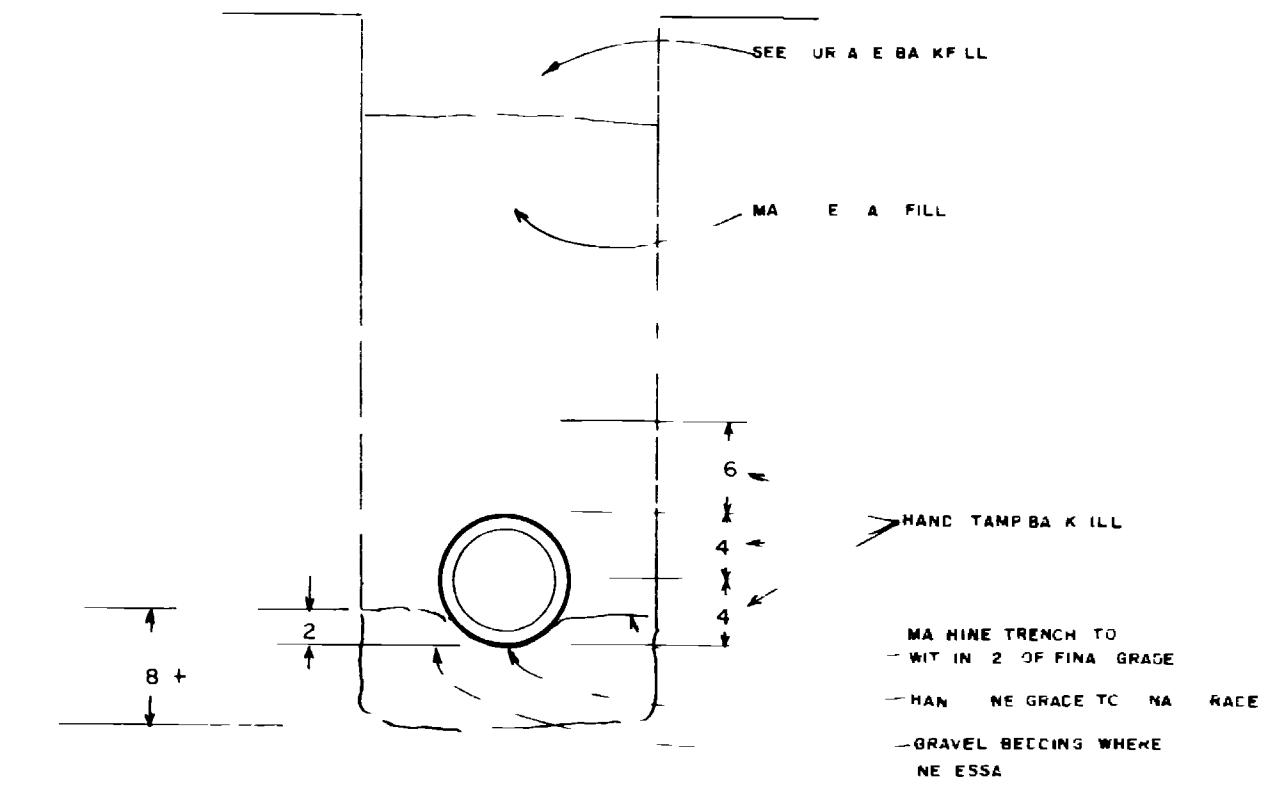

TRENCH BACKFILL

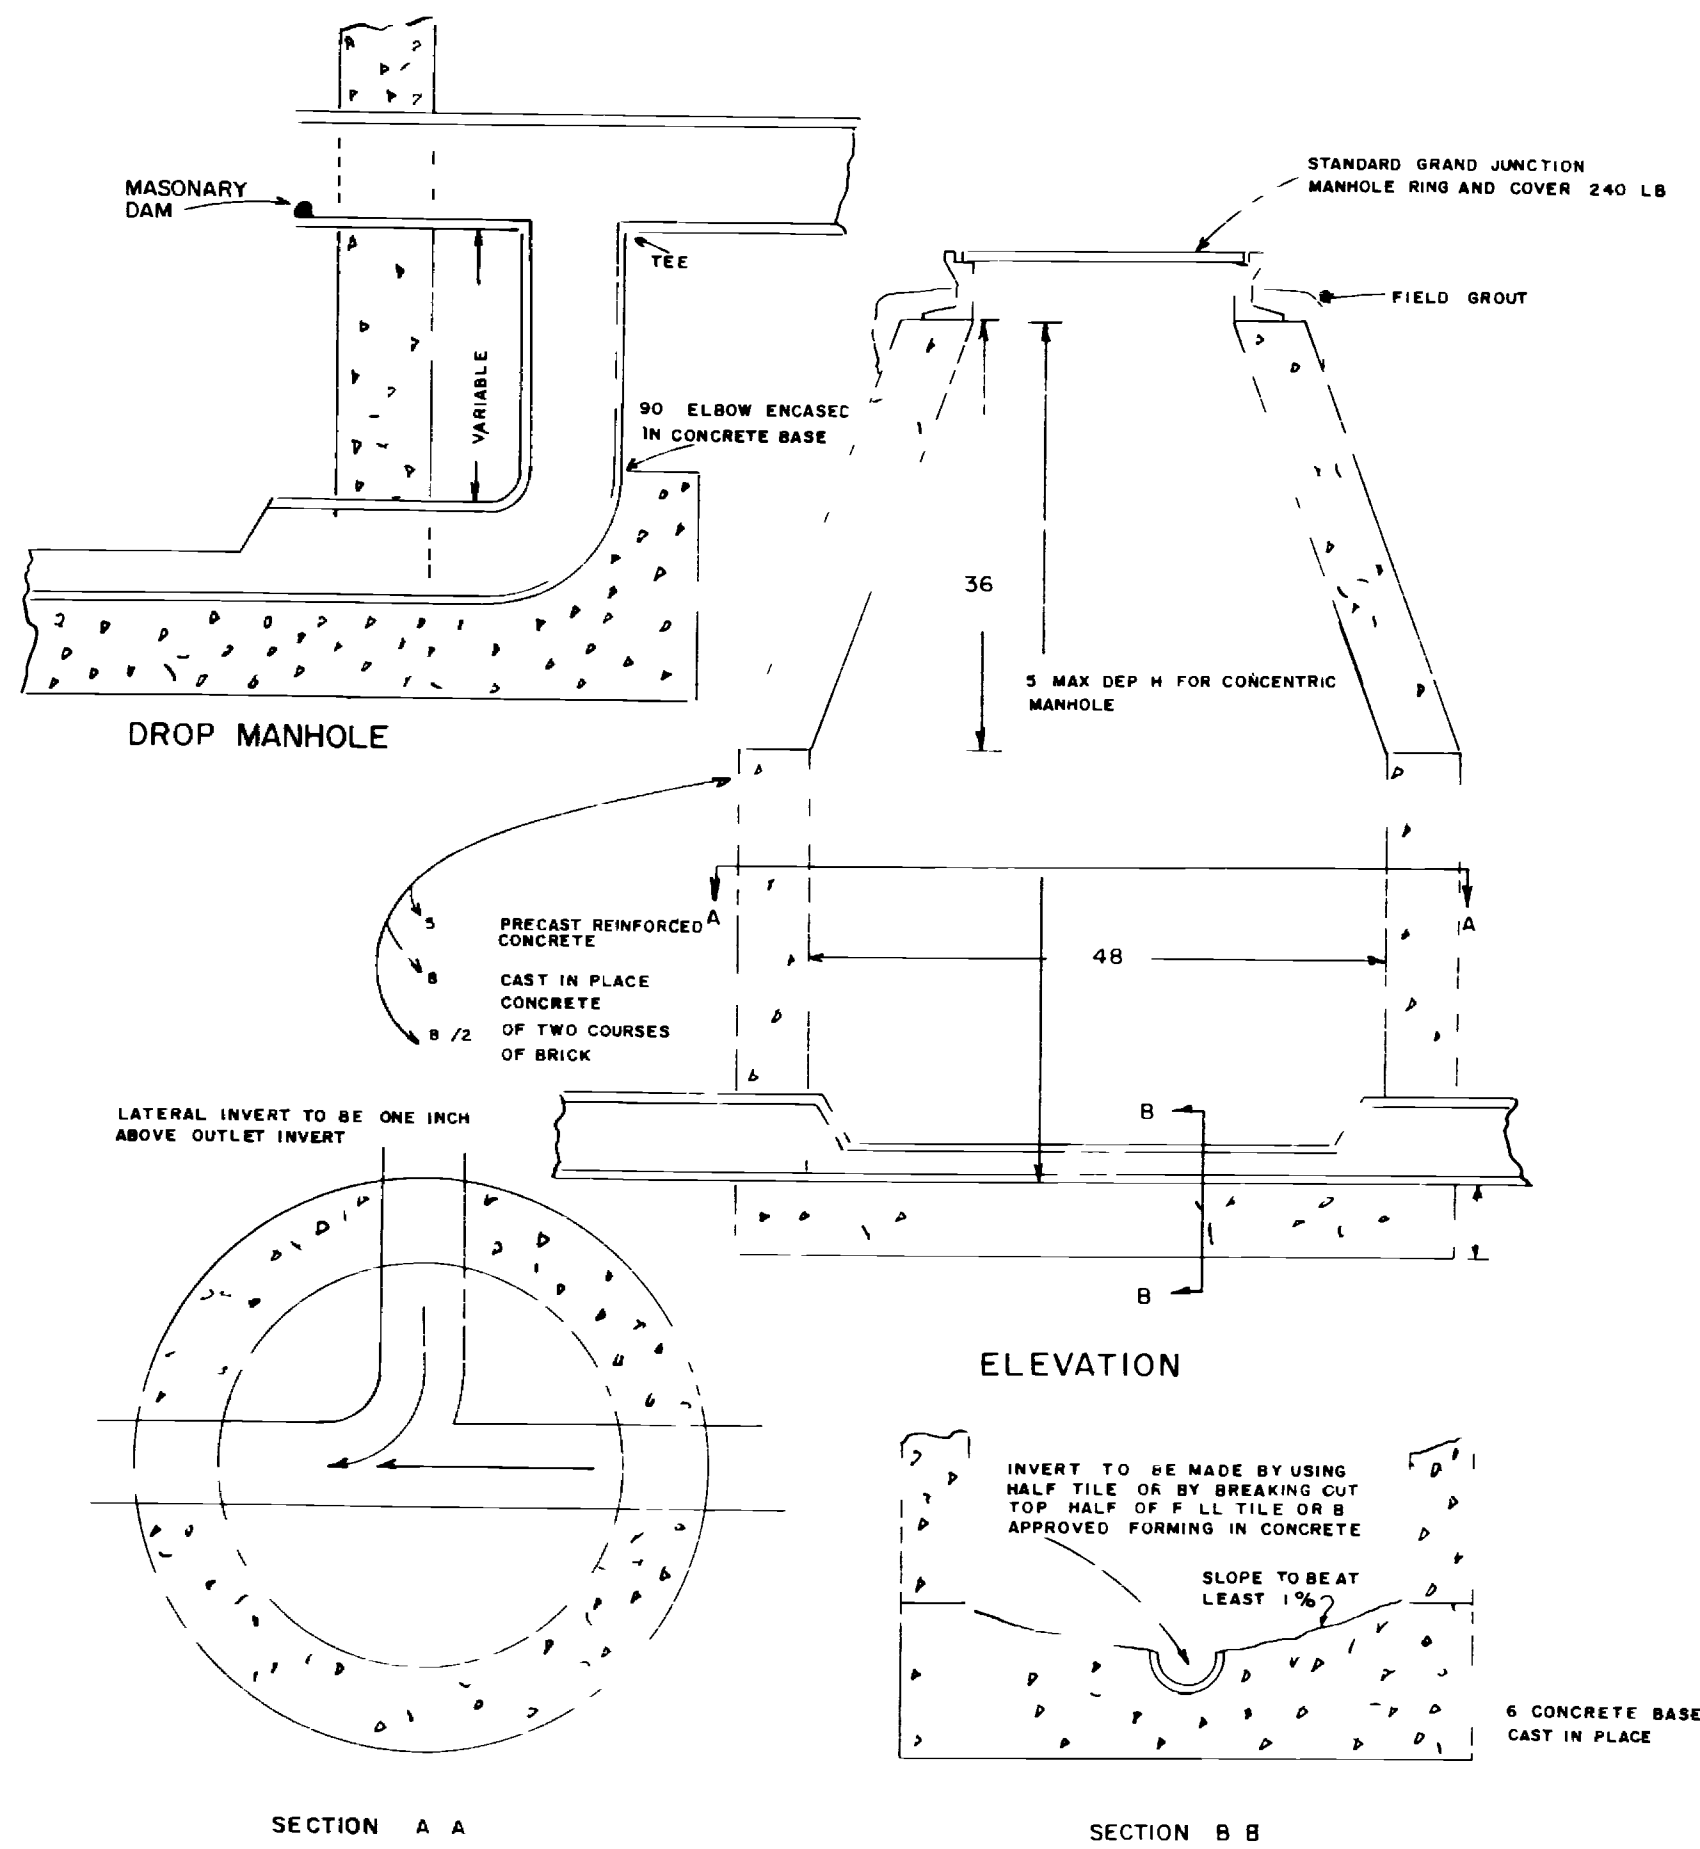


DROP MANHOLE



ELEVATION

SECTION A A

SECTION B B

SURFACE BACKFILL

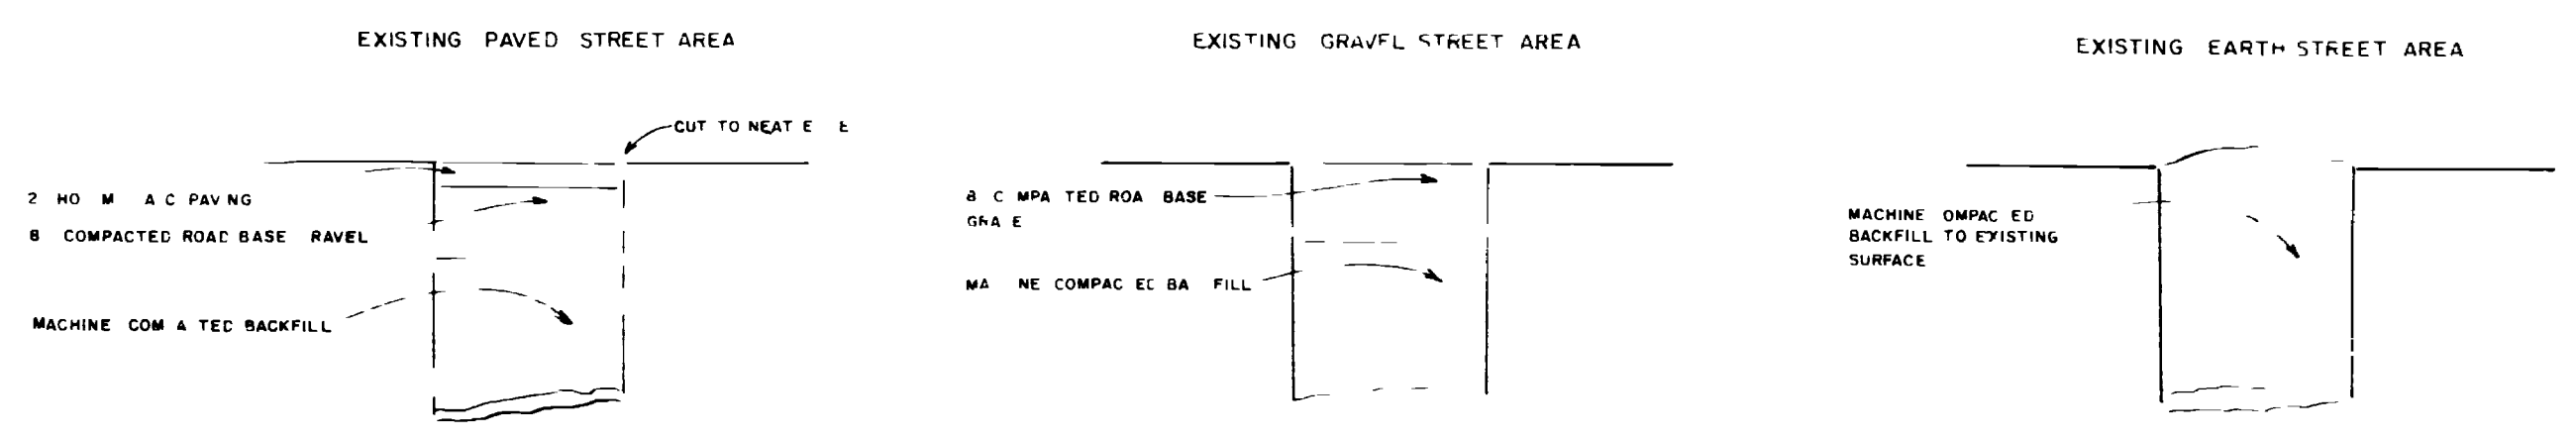


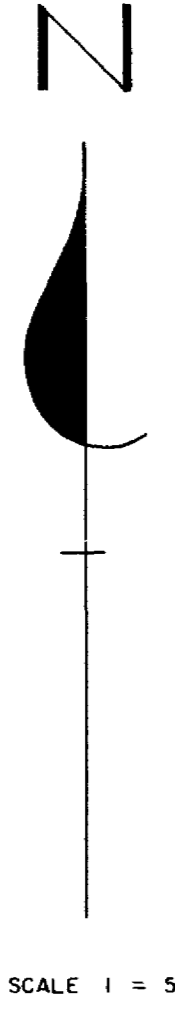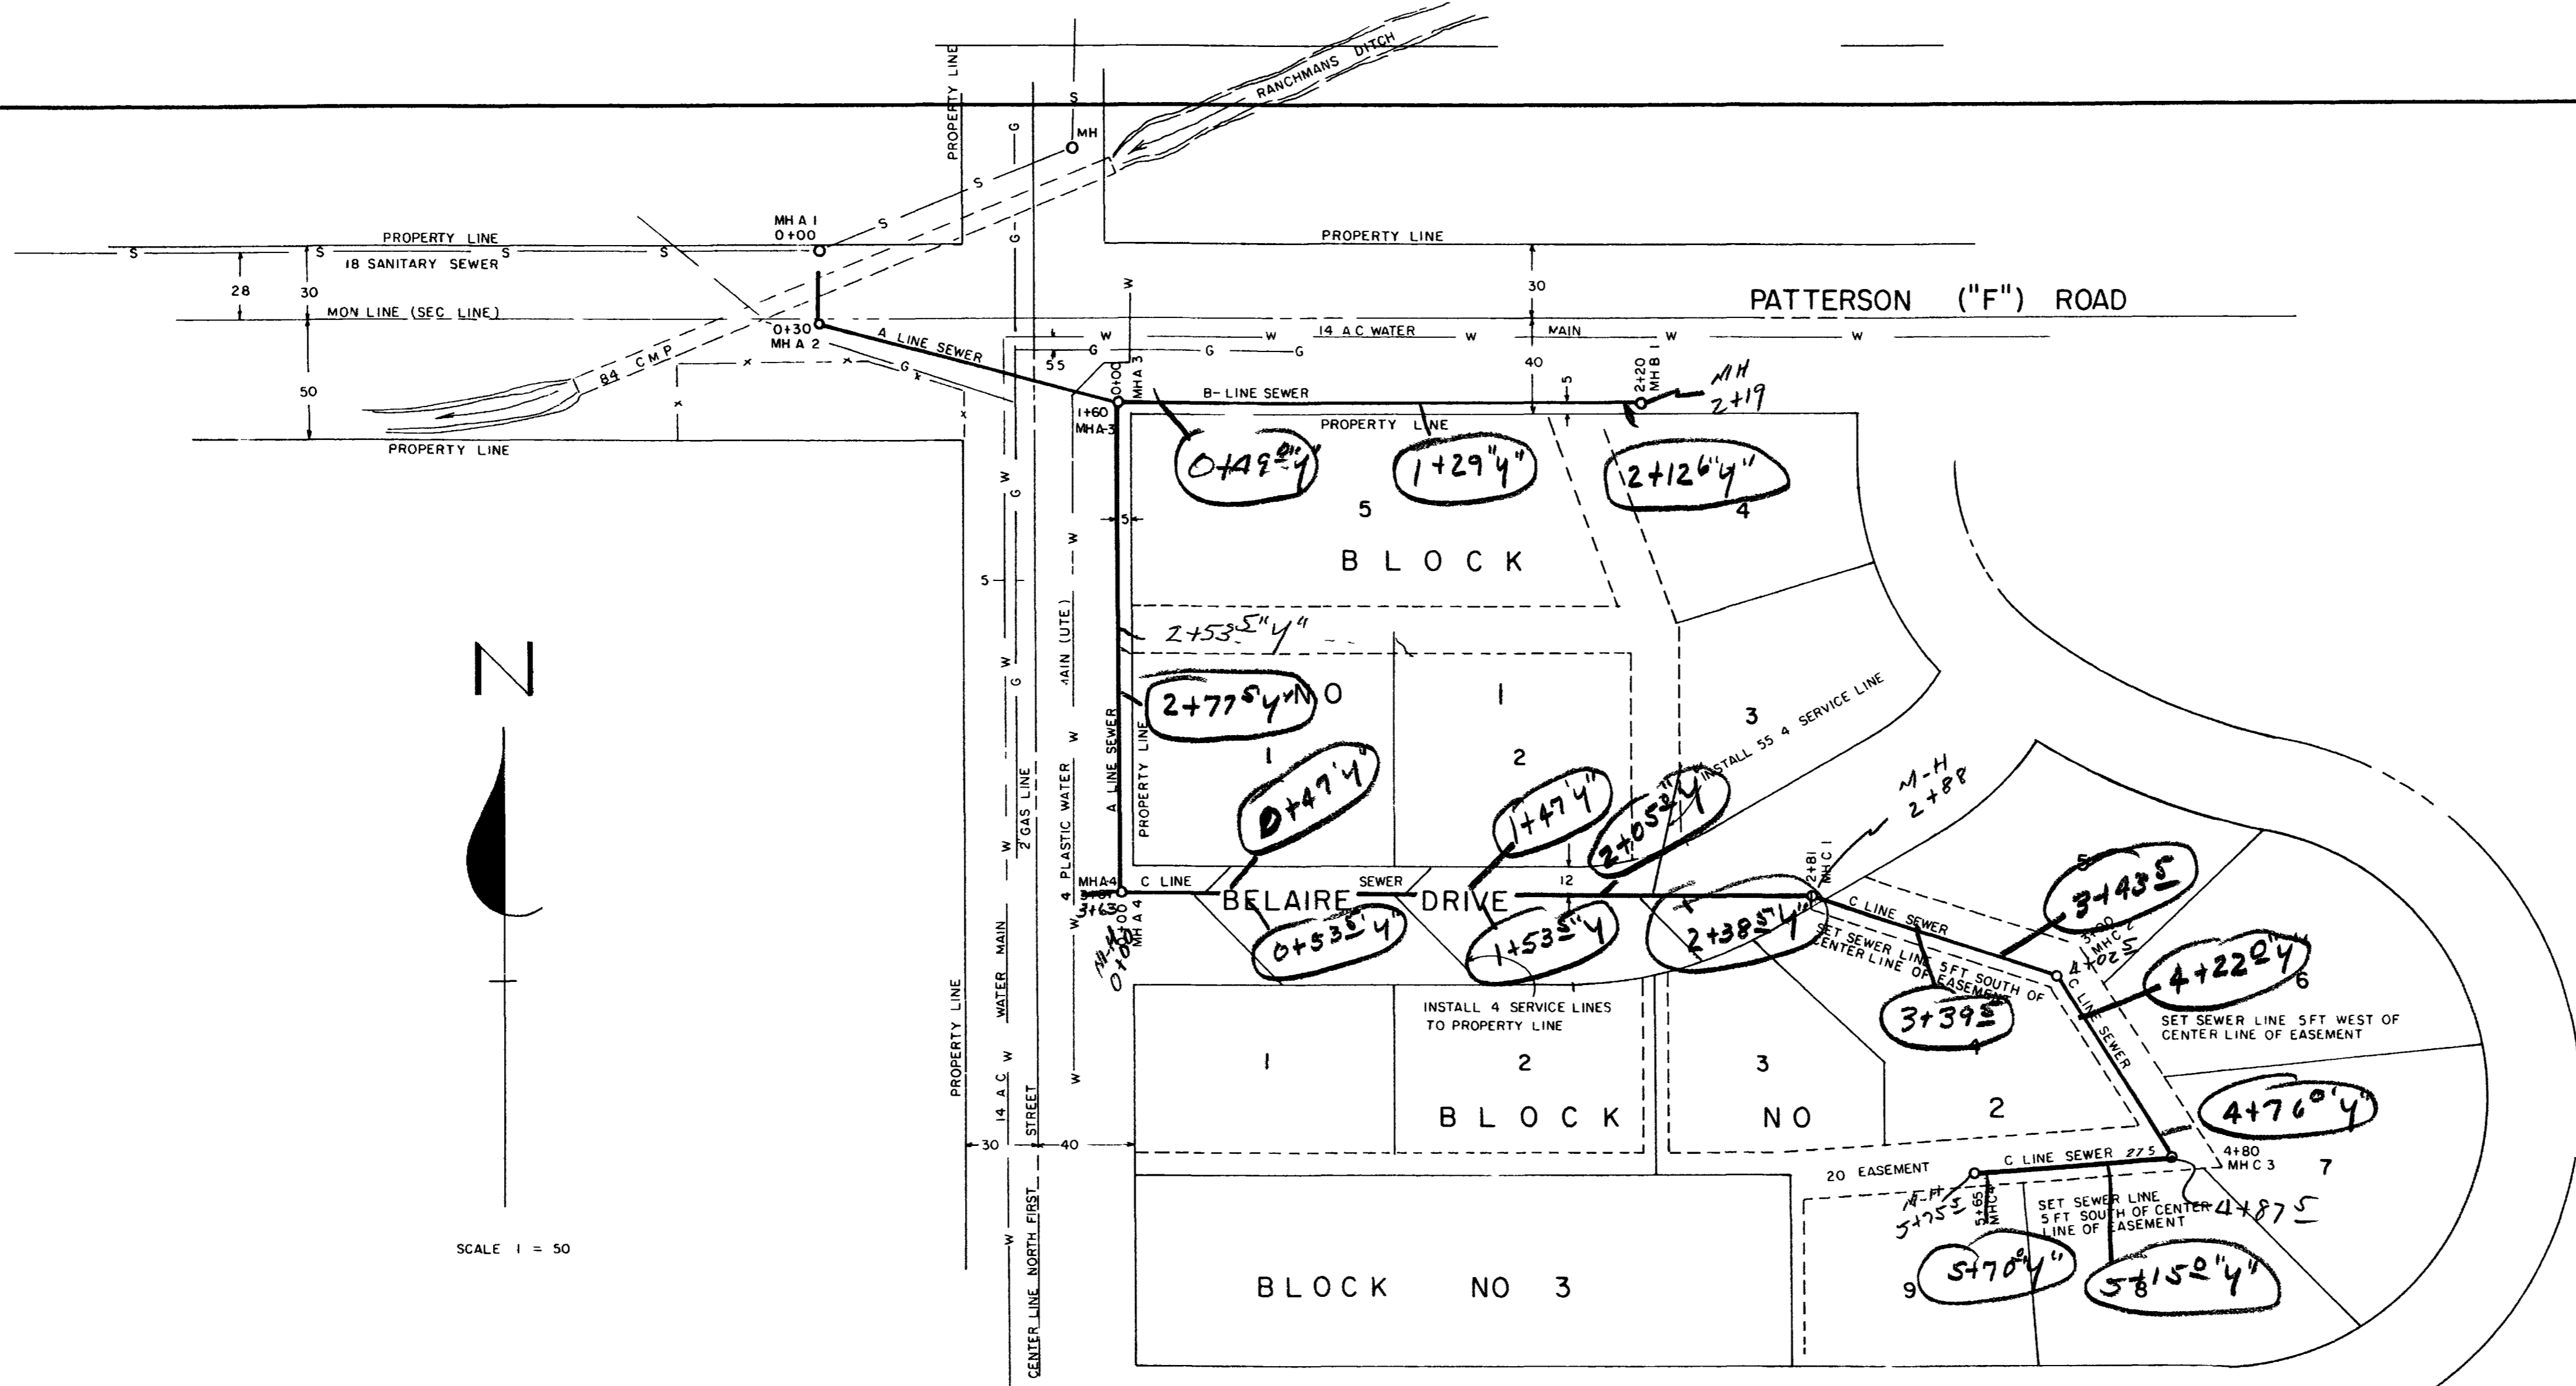


$$\begin{array}{r} 2+325 \\ -95 \\ \hline 2+230 \end{array}$$

$$\begin{array}{r} 3+395 \\ 2+88 \\ \hline 5+283 \end{array}$$

PARK DRIVE
ANNEXATION BOUNDARY

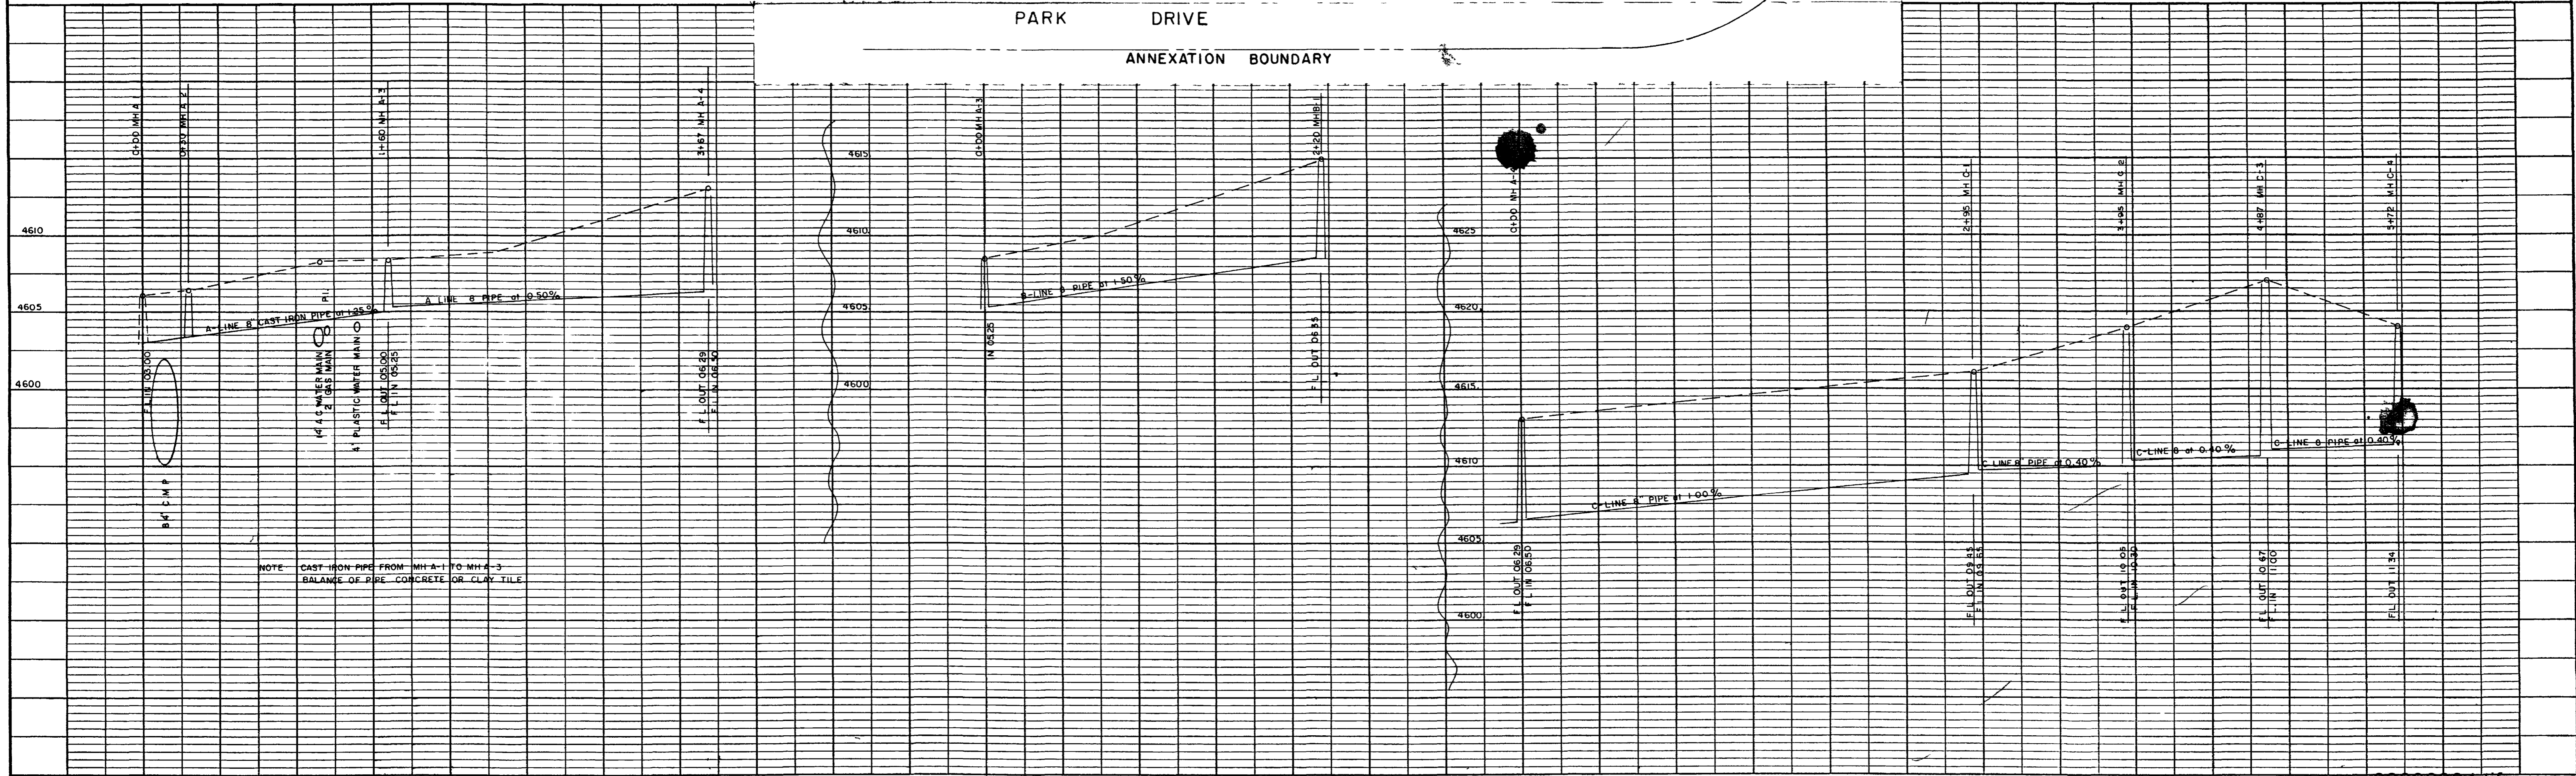

NOTE: CAST IRON PIPE FROM MH A-1 TO MH A-3
BALANCE OF PIPE CONCRETE OR CLAY TILE

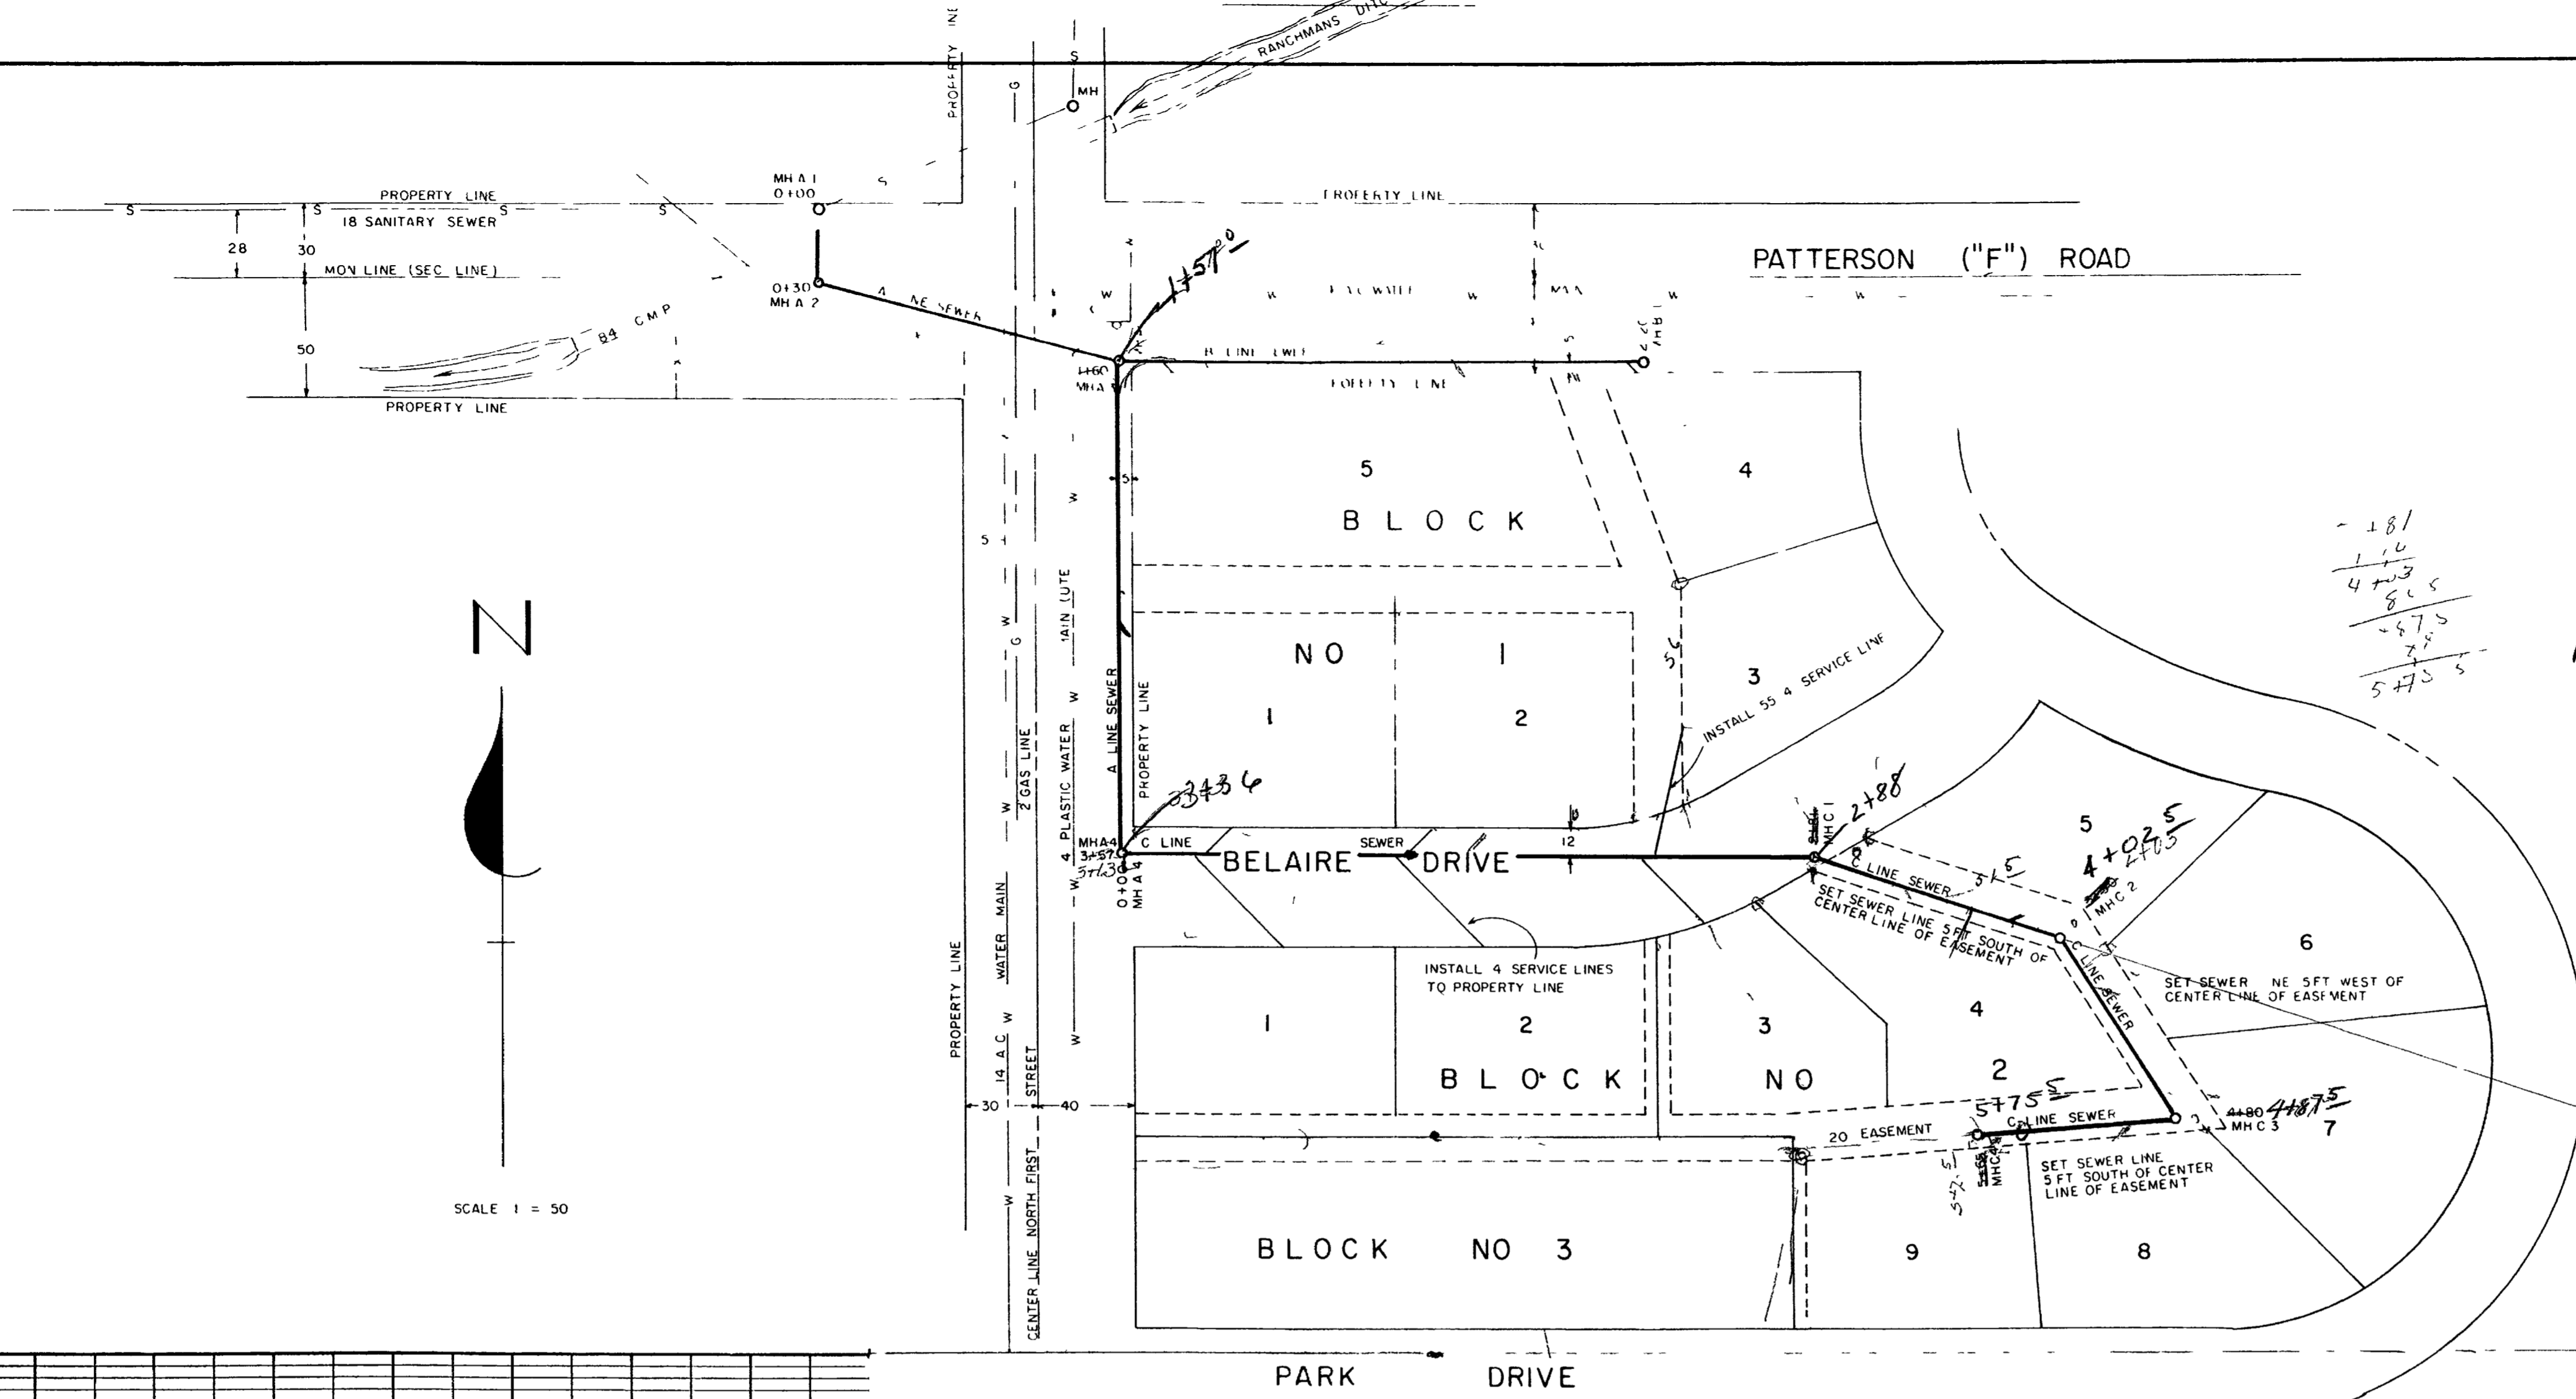

181
16
4 + 13
8 5
- 51.5
7
575.5

AS BUILT

FIELD Book 286

Vault K-13

