


15447

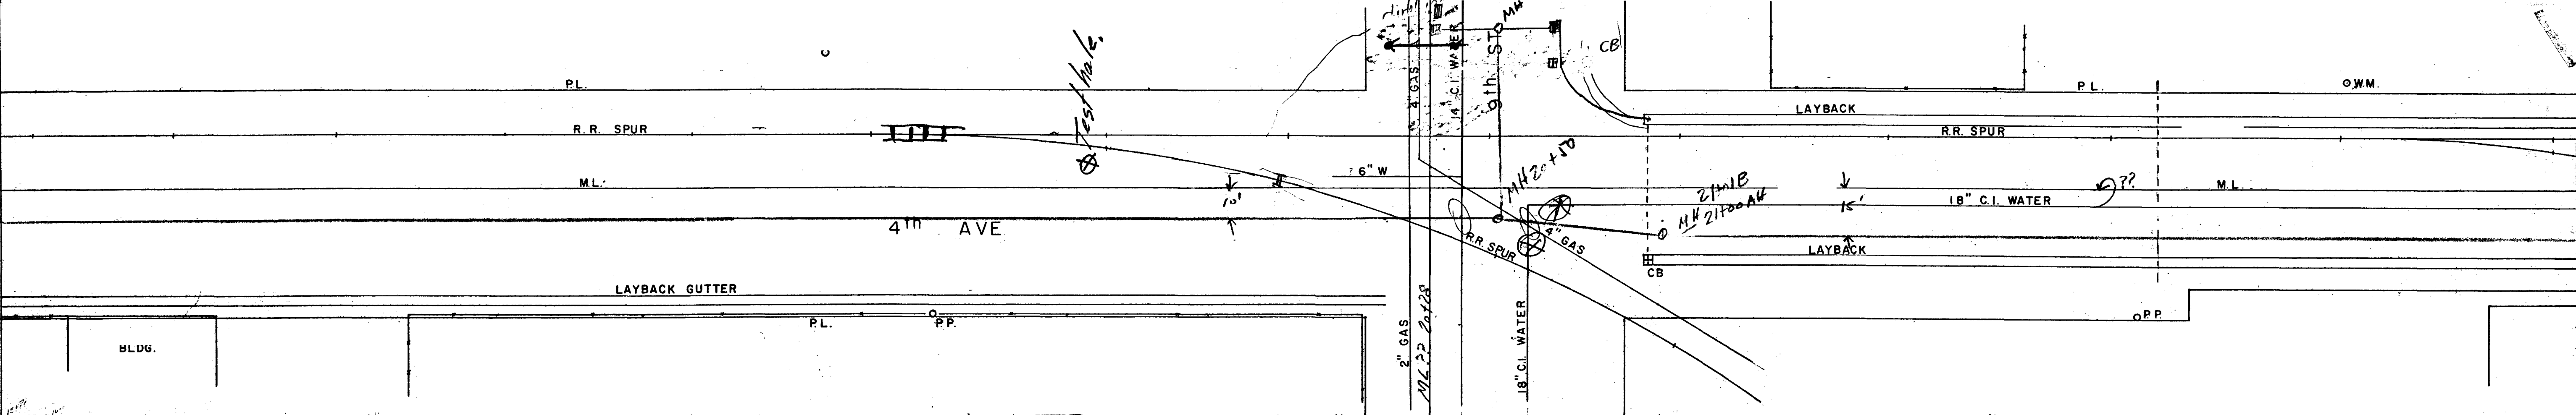



15450

15455

15460

15470

*Test hole*

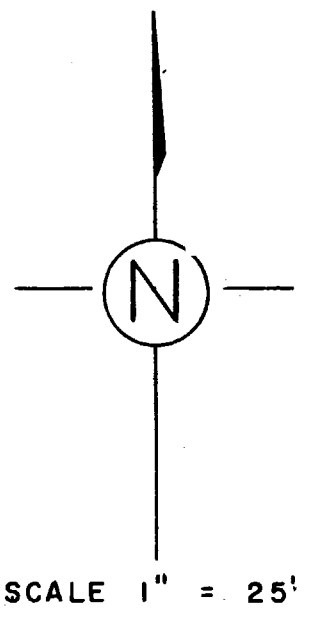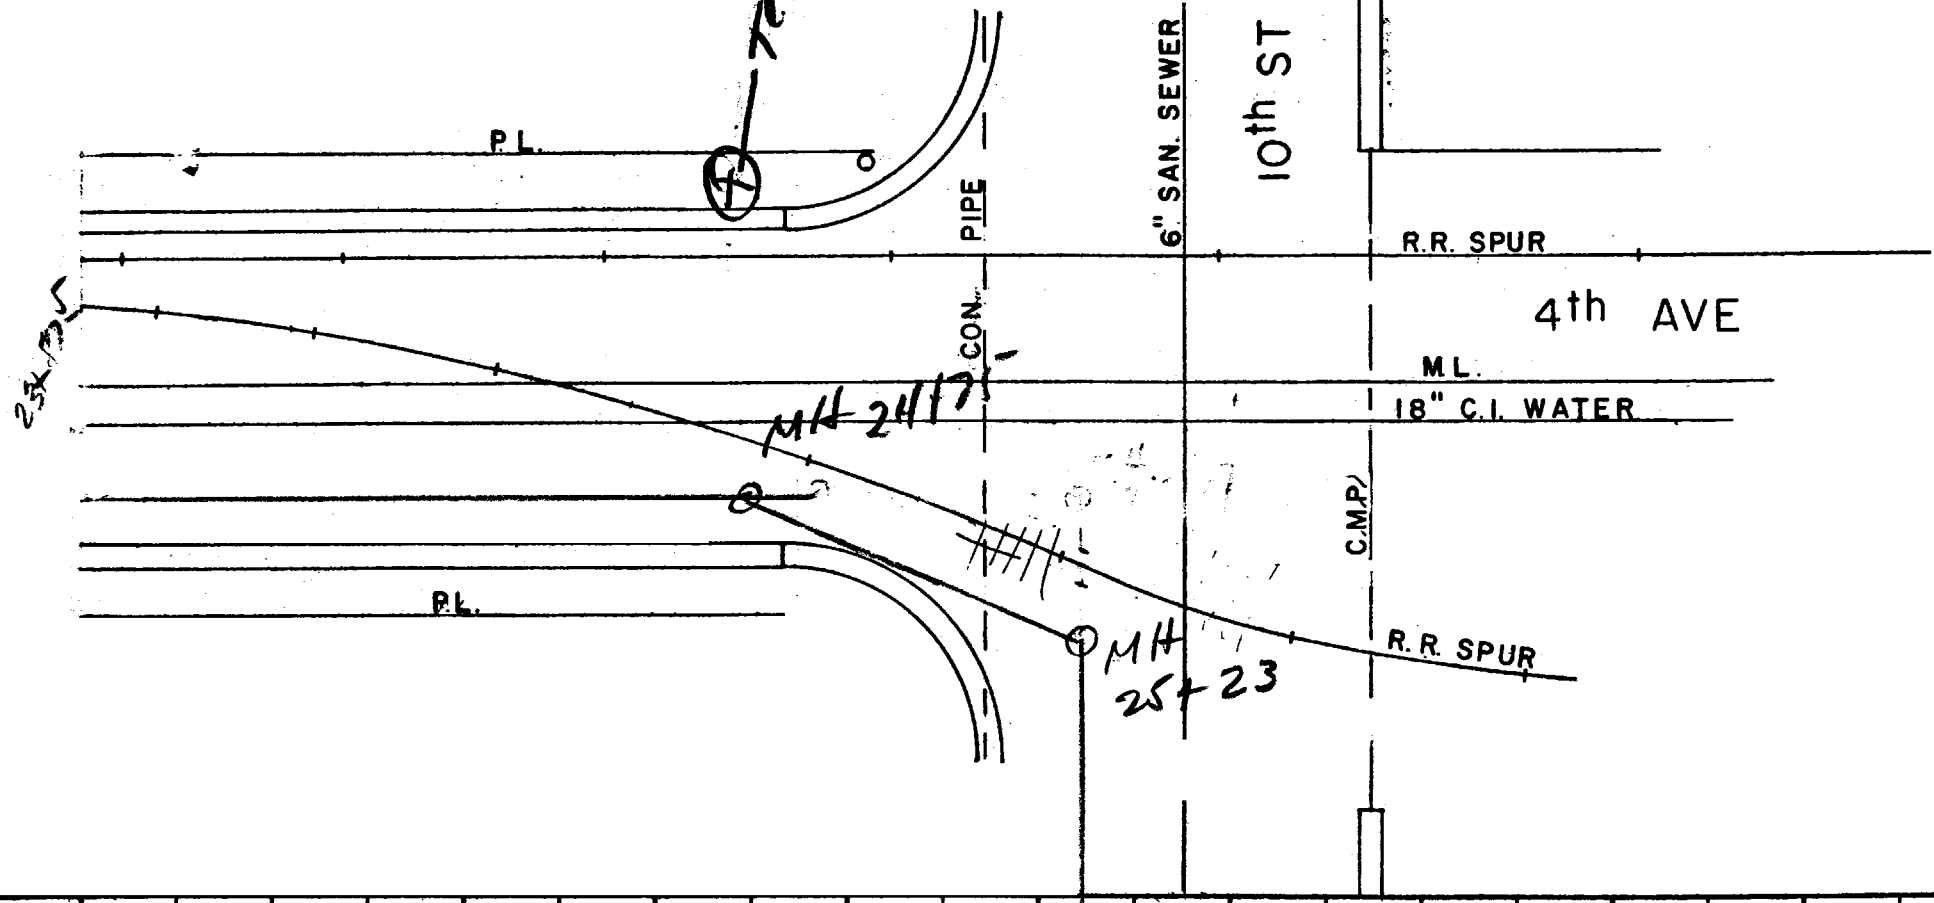

4570

*25+23*