

Site Data




Project Name	Site ID	City	Street	Starting Ftg.	Date	Time	TapelD
T1 Sewer Line	5	Grand Jct.	Independent Av.3.0		Nov. 18 1998	01:30:53 PM	68
M.H. Start	M.H. Stop	M.H. Depth	Pipe Size(in)	Type of Pipe	Direction	Surface Condition	Final Footage
1T1	T1	3 (ft) 8 (in)	8	PVC	Away-DS	Dirt	+4383.8

Site Data

Project Name	Site ID	City	Street	Starting Ftg.	Date	Time	TapelD
T1 Sewer Line	4	Grand Jct.	Independent Av.4.0		Nov. 18 1998	09:31:23 AM	
M.H. Start	M.H. Stop	M.H. Depth	Pipe Size(in)	Type of Pipe	Direction	Surface Condition	Final Footage
2T1	1T1	5 (ft) 8 (in)	8	PVC	Away-DS	Dirt	+4154.6

Site Data

Project Name	Site ID	City	Street	Starting Ftg.	Date	Time	TapelD
T1 Sewer Line	3	Grand Jct.	Independent Av.4.0		Nov. 16 1998	09:34:40 AM	68
M.H. Start	M.H. Stop	M.H. Depth	Pipe Size(in)	Type of Pipe	Direction	Surface Condition	Final Footage
3T1	2T1	5 (ft) 6 (in)	8	PVC	Away-DS	Dirt	+4325.6

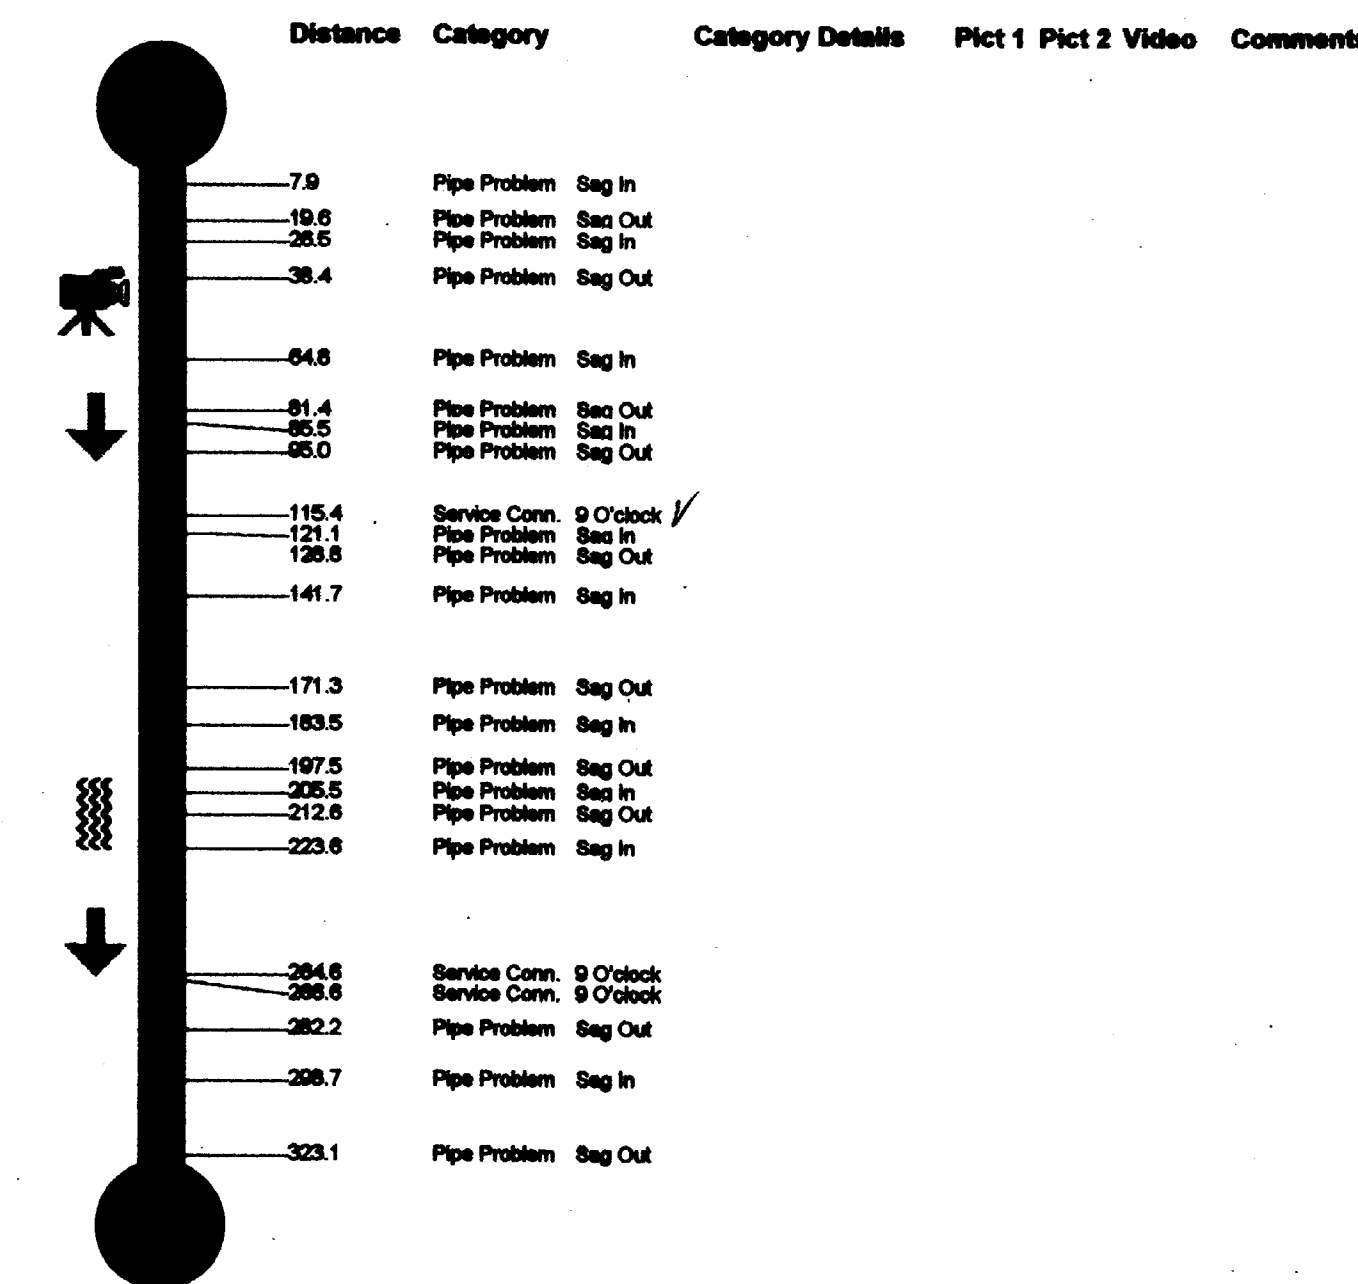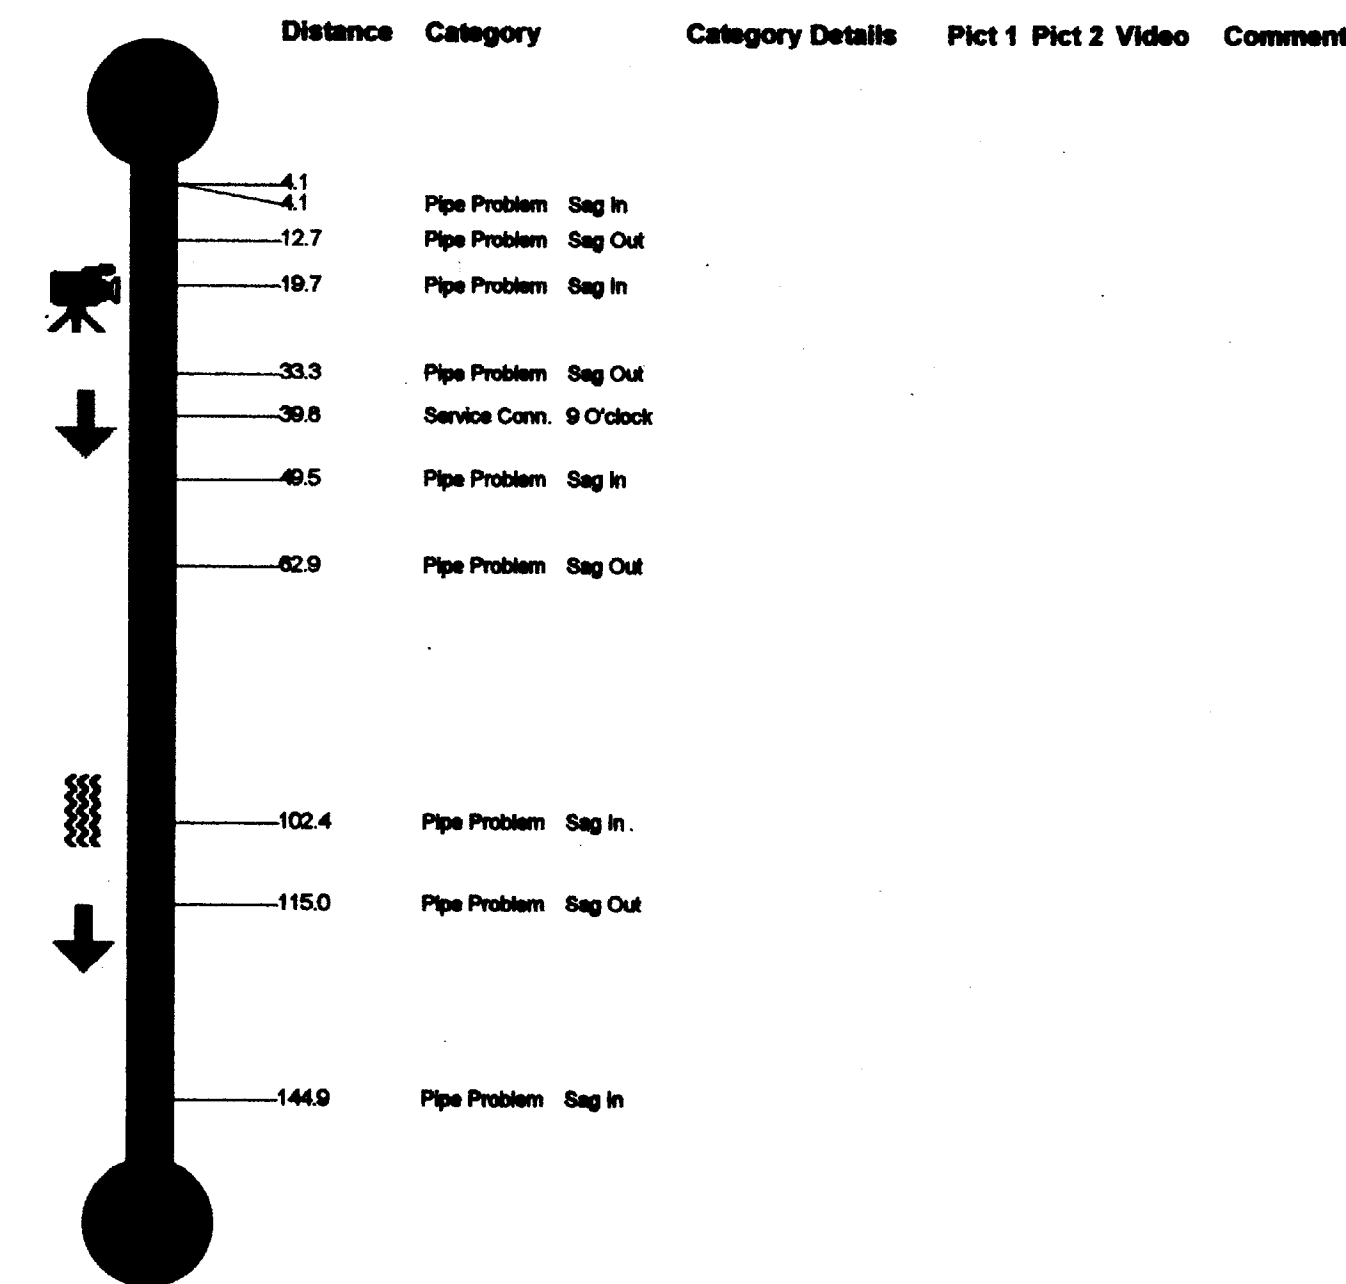
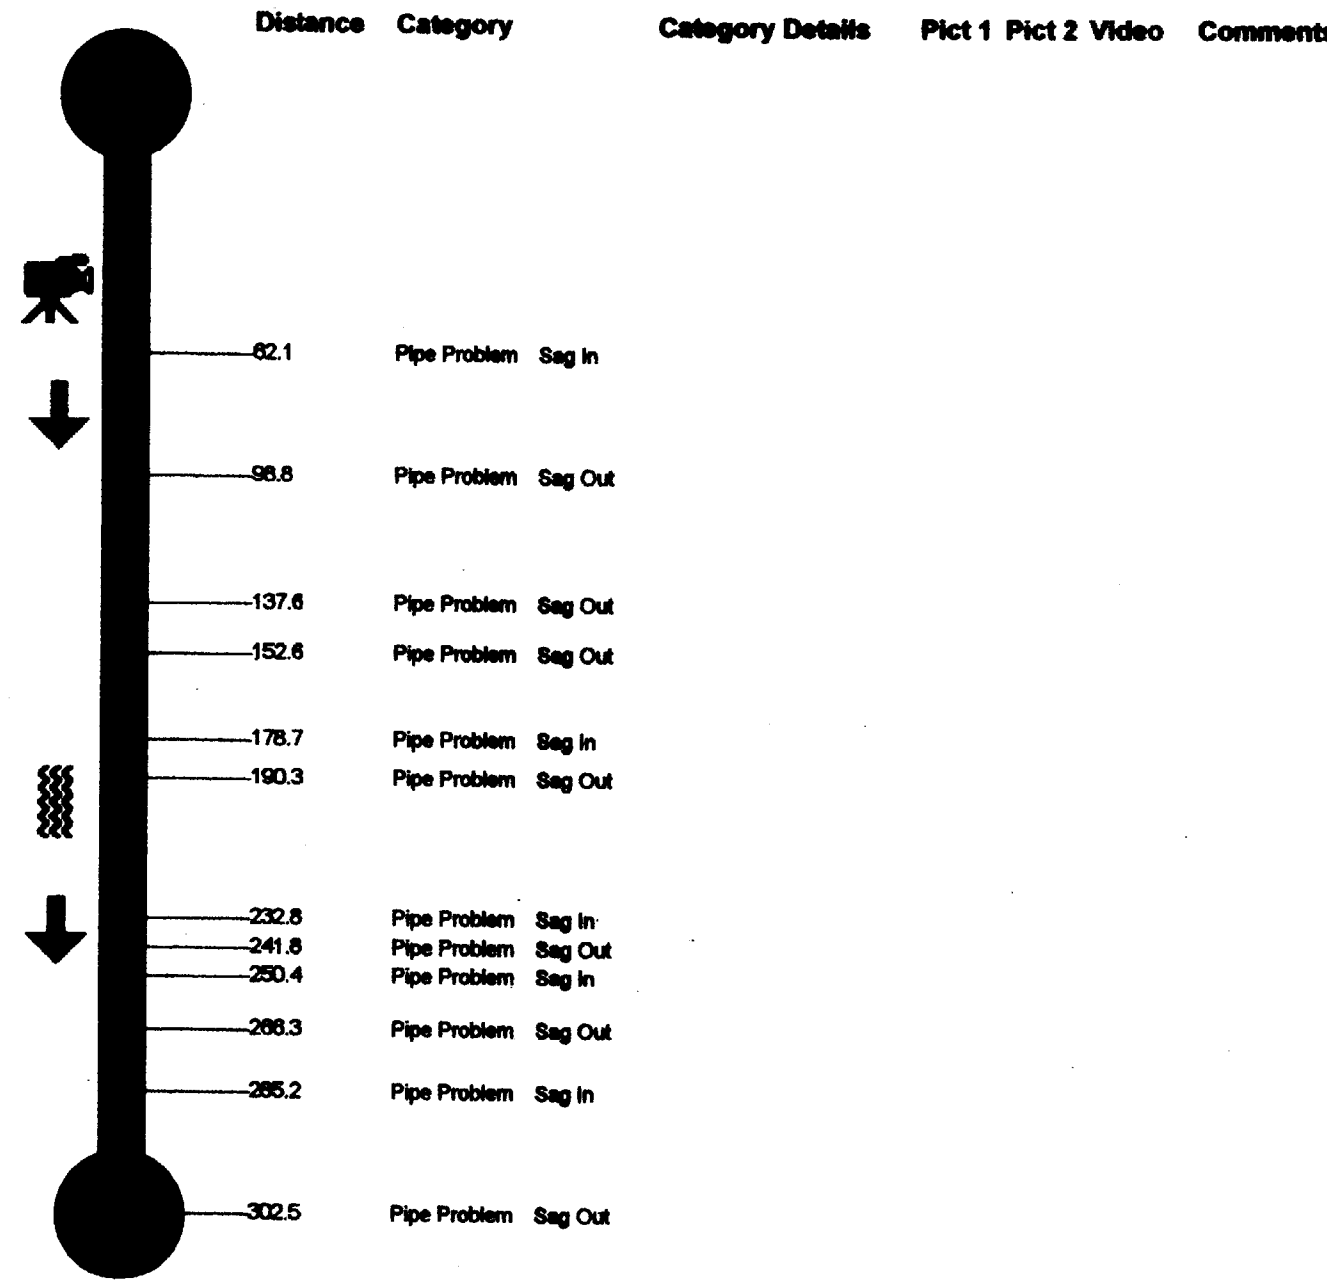


Site Data

Project Name	Site ID	City	Street	Starting Ftg.	Date	Time	TapelD
T1 Sewer Line	2	Grand Jct.	Independent Ave.4.0		Nov. 13 1998	11:41:52 AM	68
M.H. Start	M.H. Stop	M.H. Depth	Pipe Size(in)	Type of Pipe	Direction	Surface Condition	Final Footage
4T1	3T1	8 (ft) 8 (in)	8	PVC	Away-BS	Dirt	+4388.8

Site Data

Project Name	Site ID	City	Street	Starting Ftg.	Date	Time	TapelD
T1 Sewer Line	1	Grand Jct.	Independent 3.0		Nov. 09 1998	01:38:27 PM	68
M.H. Start	M.H. Stop	M.H. Depth	Pipe Size(in)	Type of Pipe	Direction	Surface Condition	Final Footage
4T1	5T1	8 (ft) 8 (in)	8	PVC	Away-US	Dirt	+4366.1

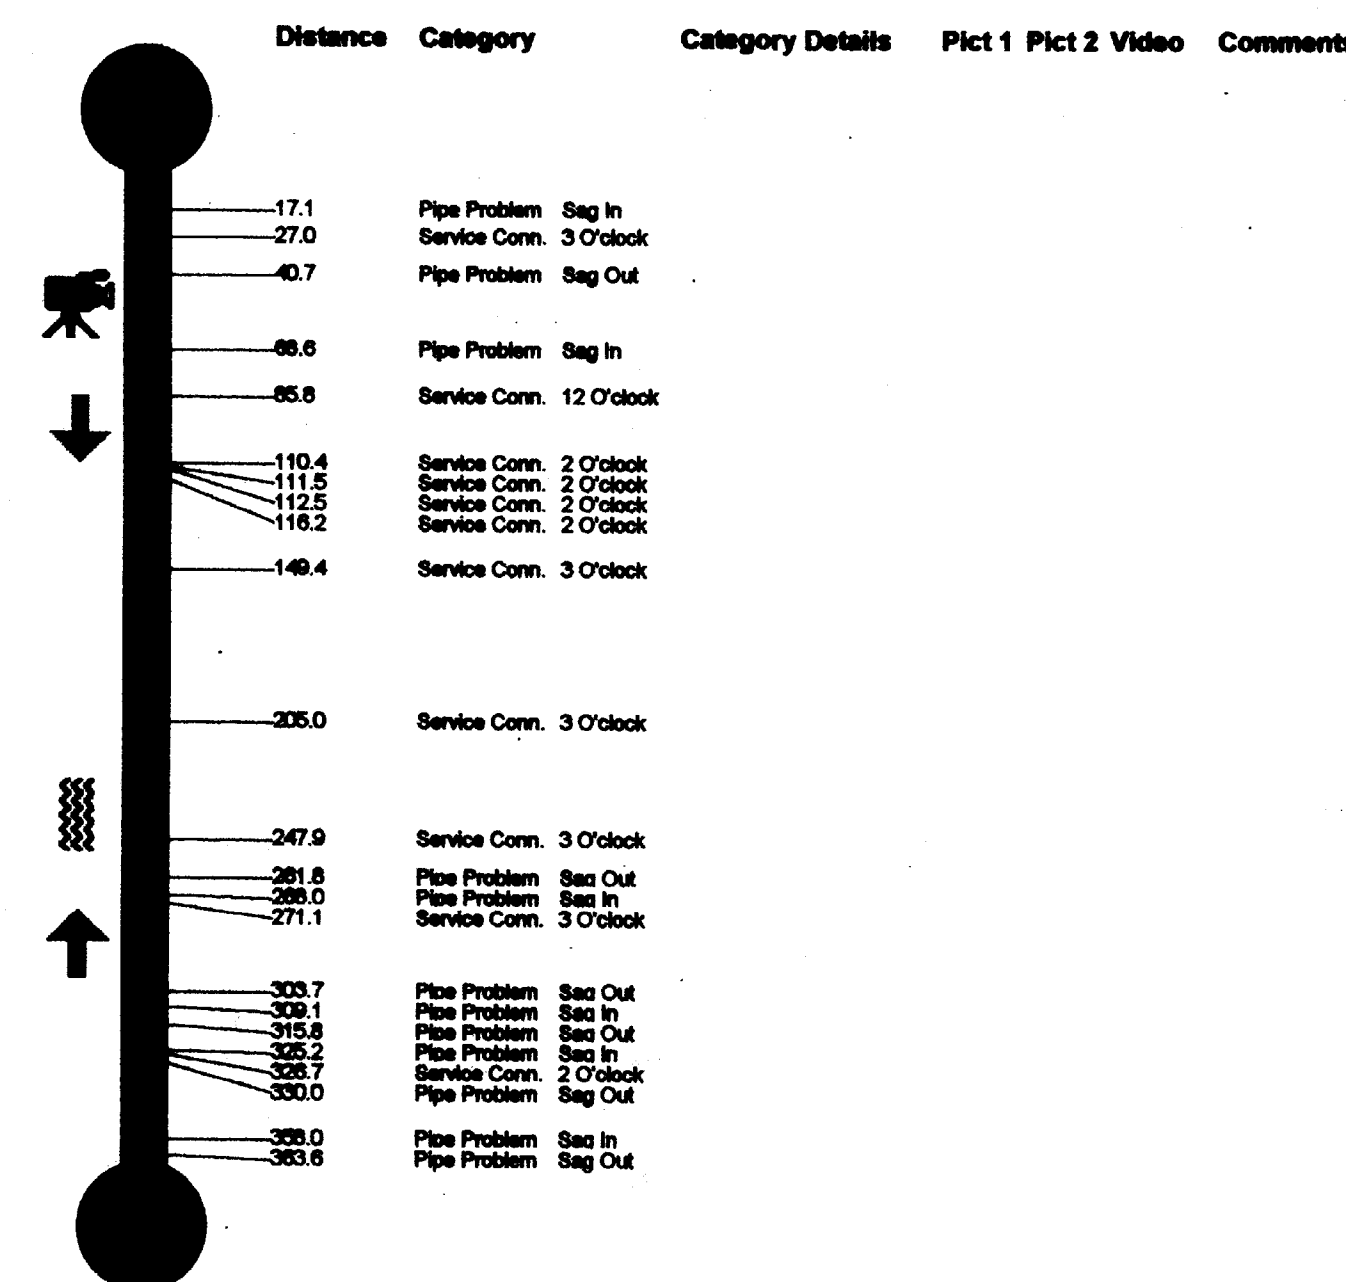
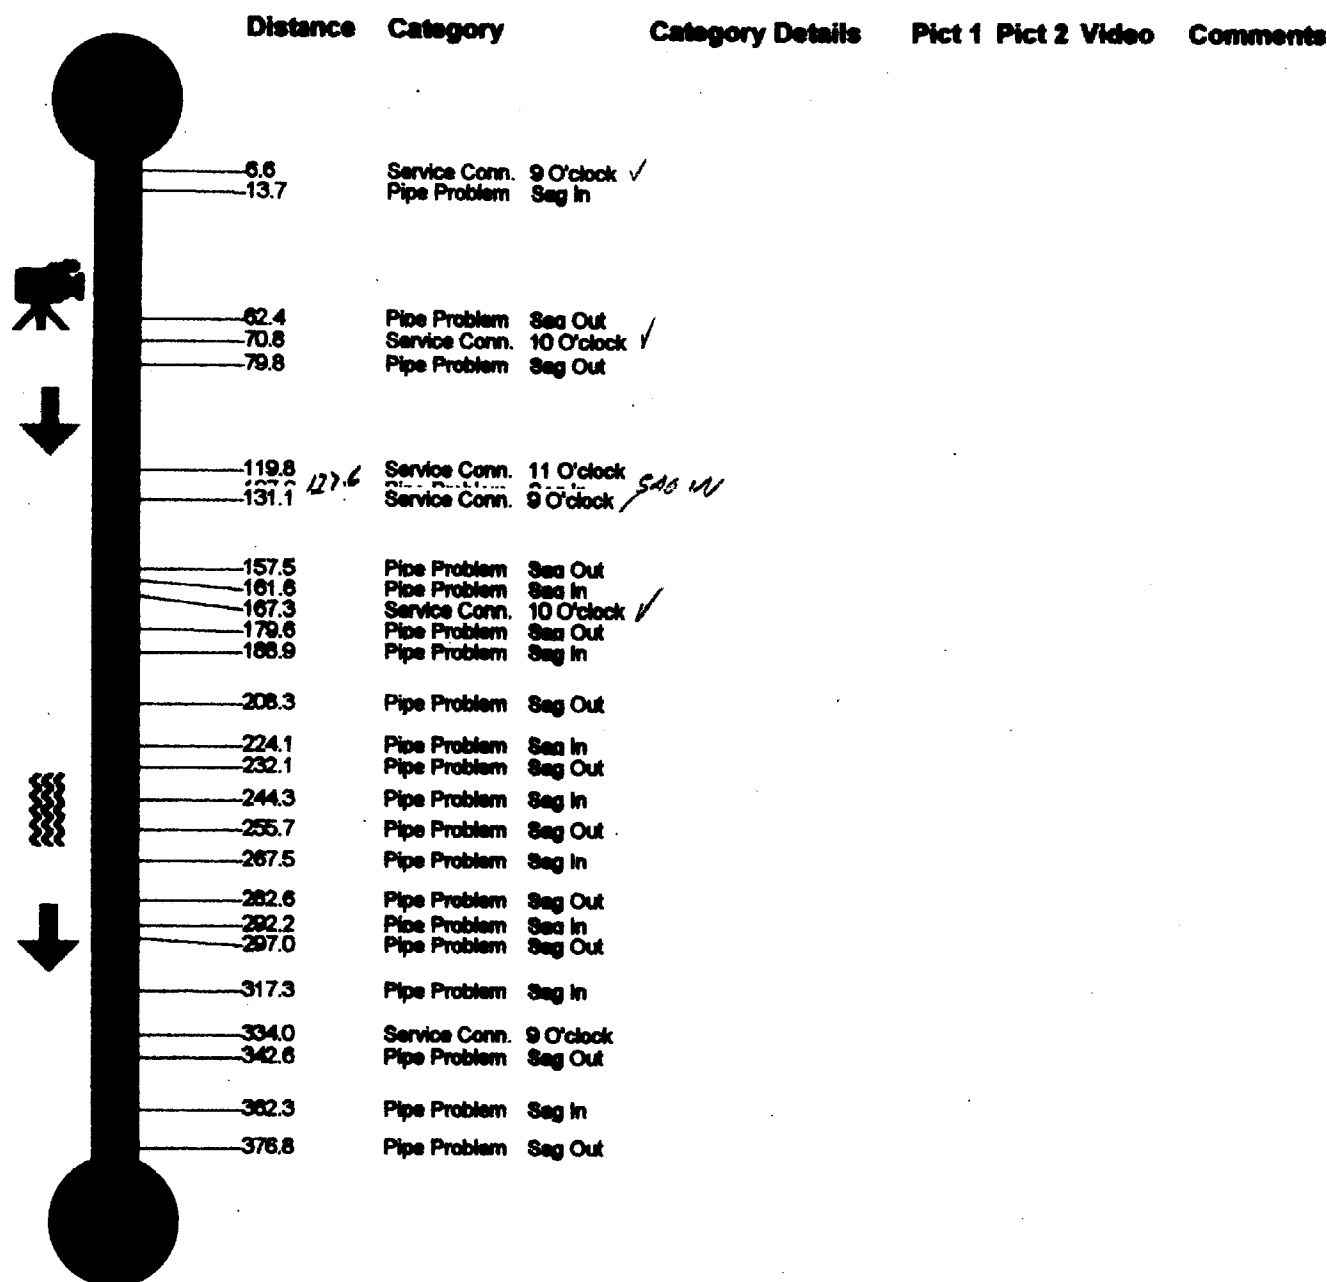


Site Data

Site Data

Project Name	Site ID	City	Street	Starting Ftg.	Date	Time	TapelD
T2 Sewer line	1	Grand Jct.	Along R.R.	3.0	Oct. 30 1998	10:28:58 AM	68
M.H. Start	M.H. Stop	M.H. Depth	Pipe Size(in)	Type of Pipe	Direction	Surface Condition	Final Footage
4T2	5T2	5 (ft) 6 (in)	8	PVC	Away-US	Dirt	+8467.8

Project Name	Site ID	City	Street	Starting Ftg.	Date	Time	TapelD
T2 Sewer line	2	Grand Jct.	R.R.	3.0	Oct. 30 1998	11:43:38 AM	
M.H. Start	M.H. Stop	M.H. Depth	Pipe Size(in)	Type of Pipe	Direction	Surface Condition	Final Footage
4T2	3T2	5 (ft) 6 (in)	8	PVC	Away-DS	Dirt	+8357.1

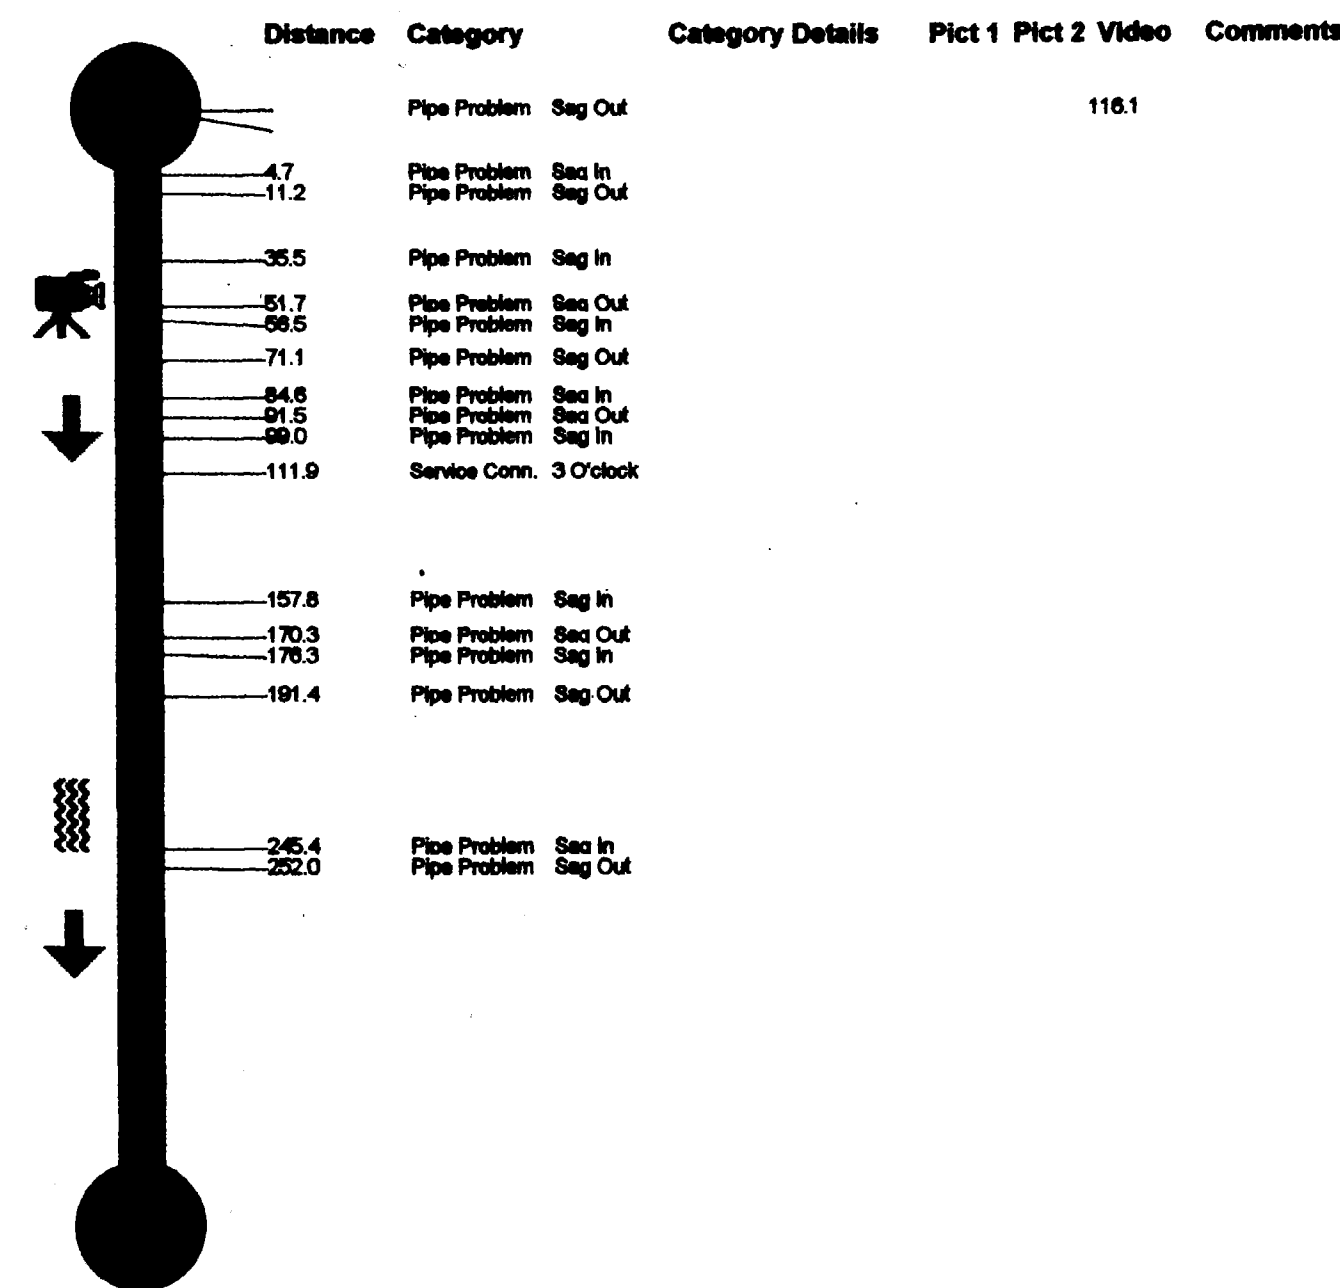
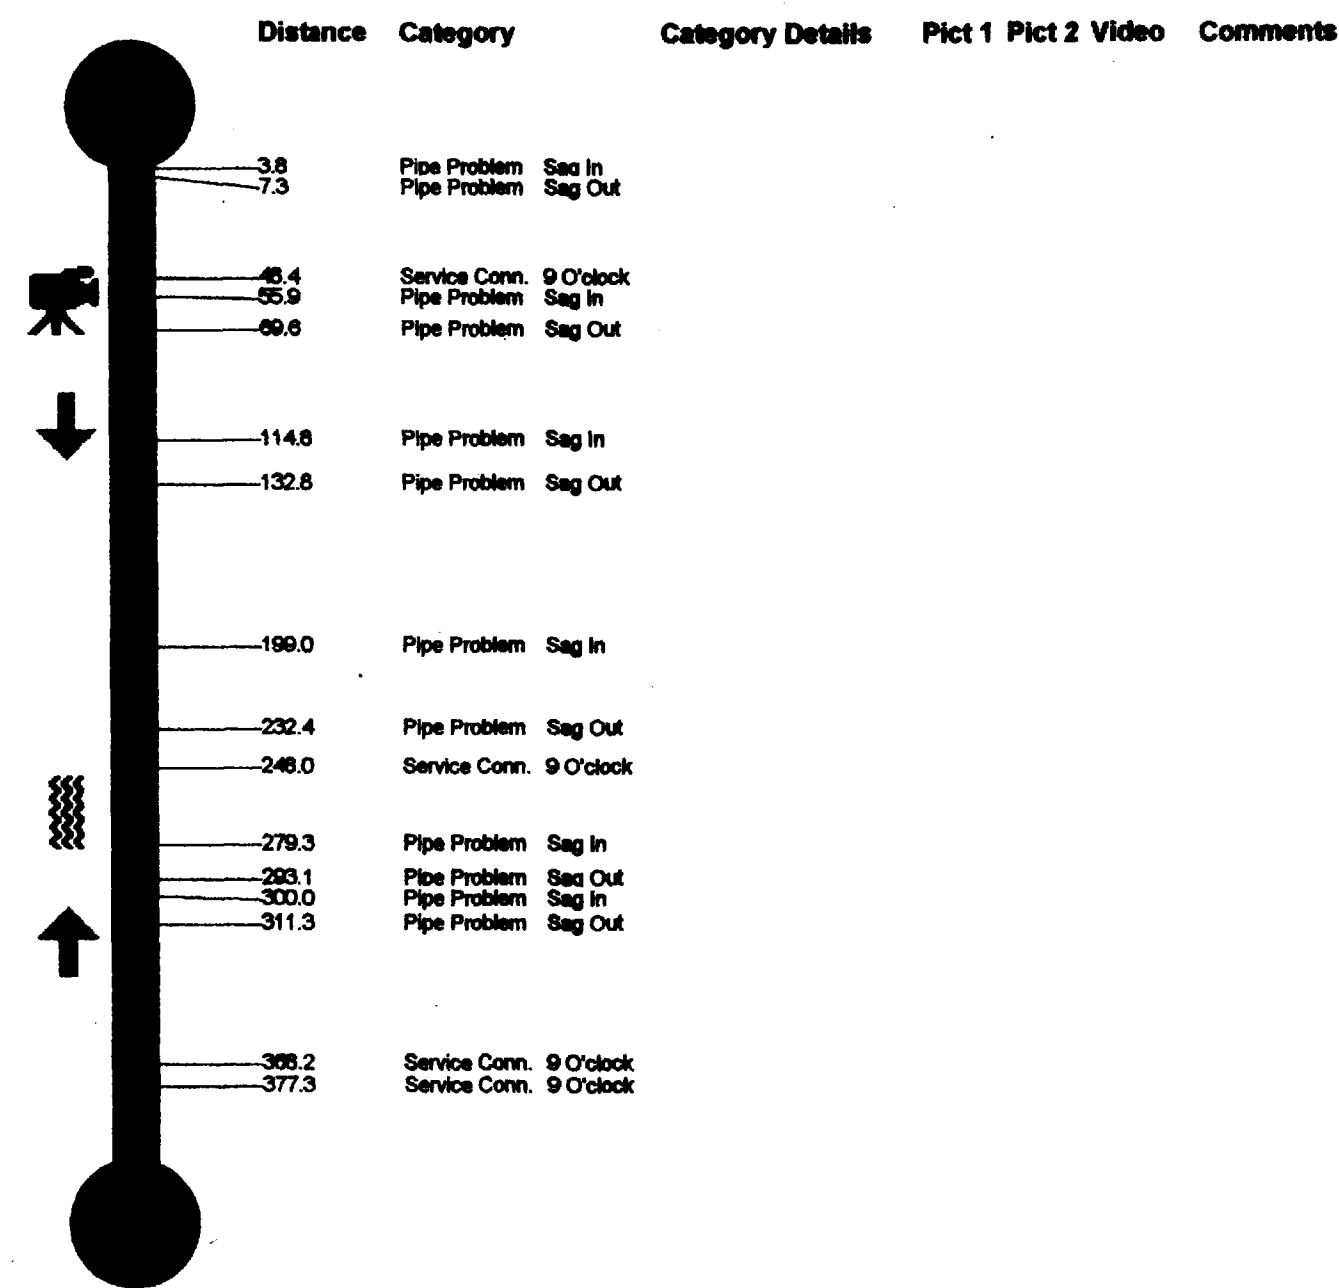


Site Data

Site Data

Project Name	Site ID	City	Street	Starting Ftg.	Date	Time	TapelD
T2 Sewer line	4	Grand Jct.	R.R.	3.0	Nov. 04 1998	03:17:33 PM	68
M.H. Start	M.H. Stop	M.H. Depth	Pipe Size(in)	Type of Pipe	Direction	Surface Condition	Final Footage
2T2	1T2	9 (ft) 10 (in)	8	PVC	Away-DS	Dirt	+8375.1

Project Name	Site ID	City	Street	Starting Ftg.	Date	Time	TapelD
T2 Sewer line	3	Grand Jct.	R.R.	3.0	Nov. 03 1998	01:57:12 PM	
M.H. Start	M.H. Stop	M.H. Depth	Pipe Size(in)	Type of Pipe	Direction	Surface Condition	Final Footage
3T2	2T2	8 (ft) 6 (in)	8	PVC	Away-DS	Dirt	+8458.0

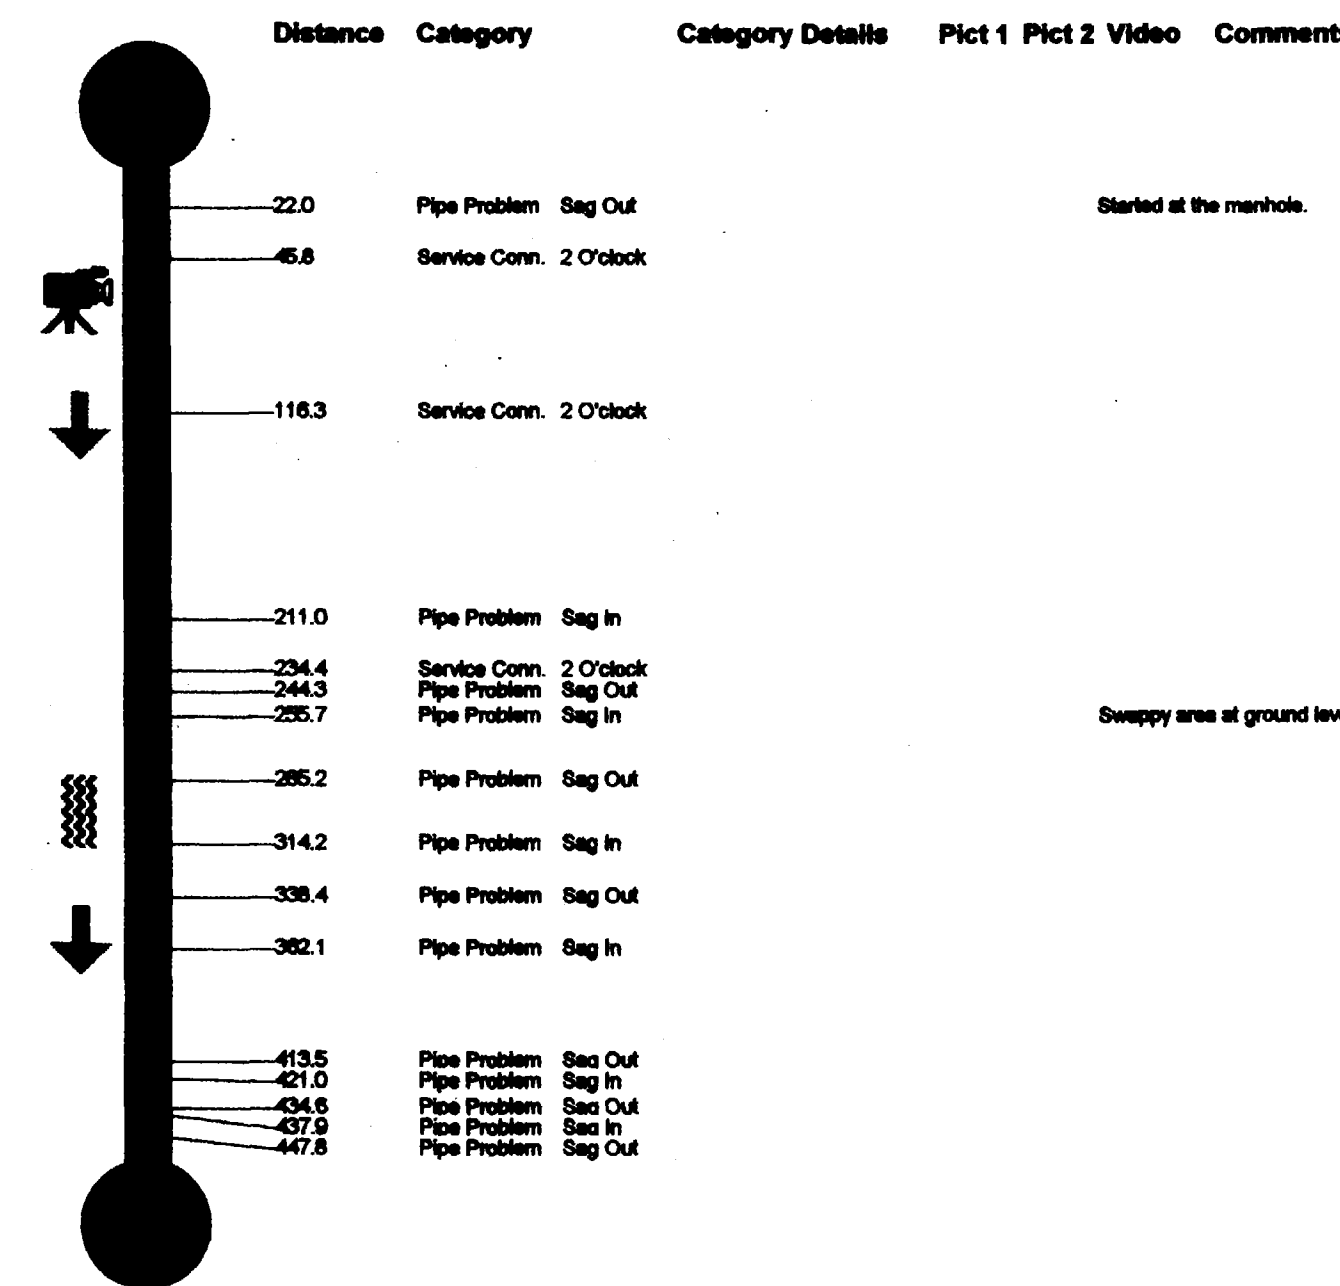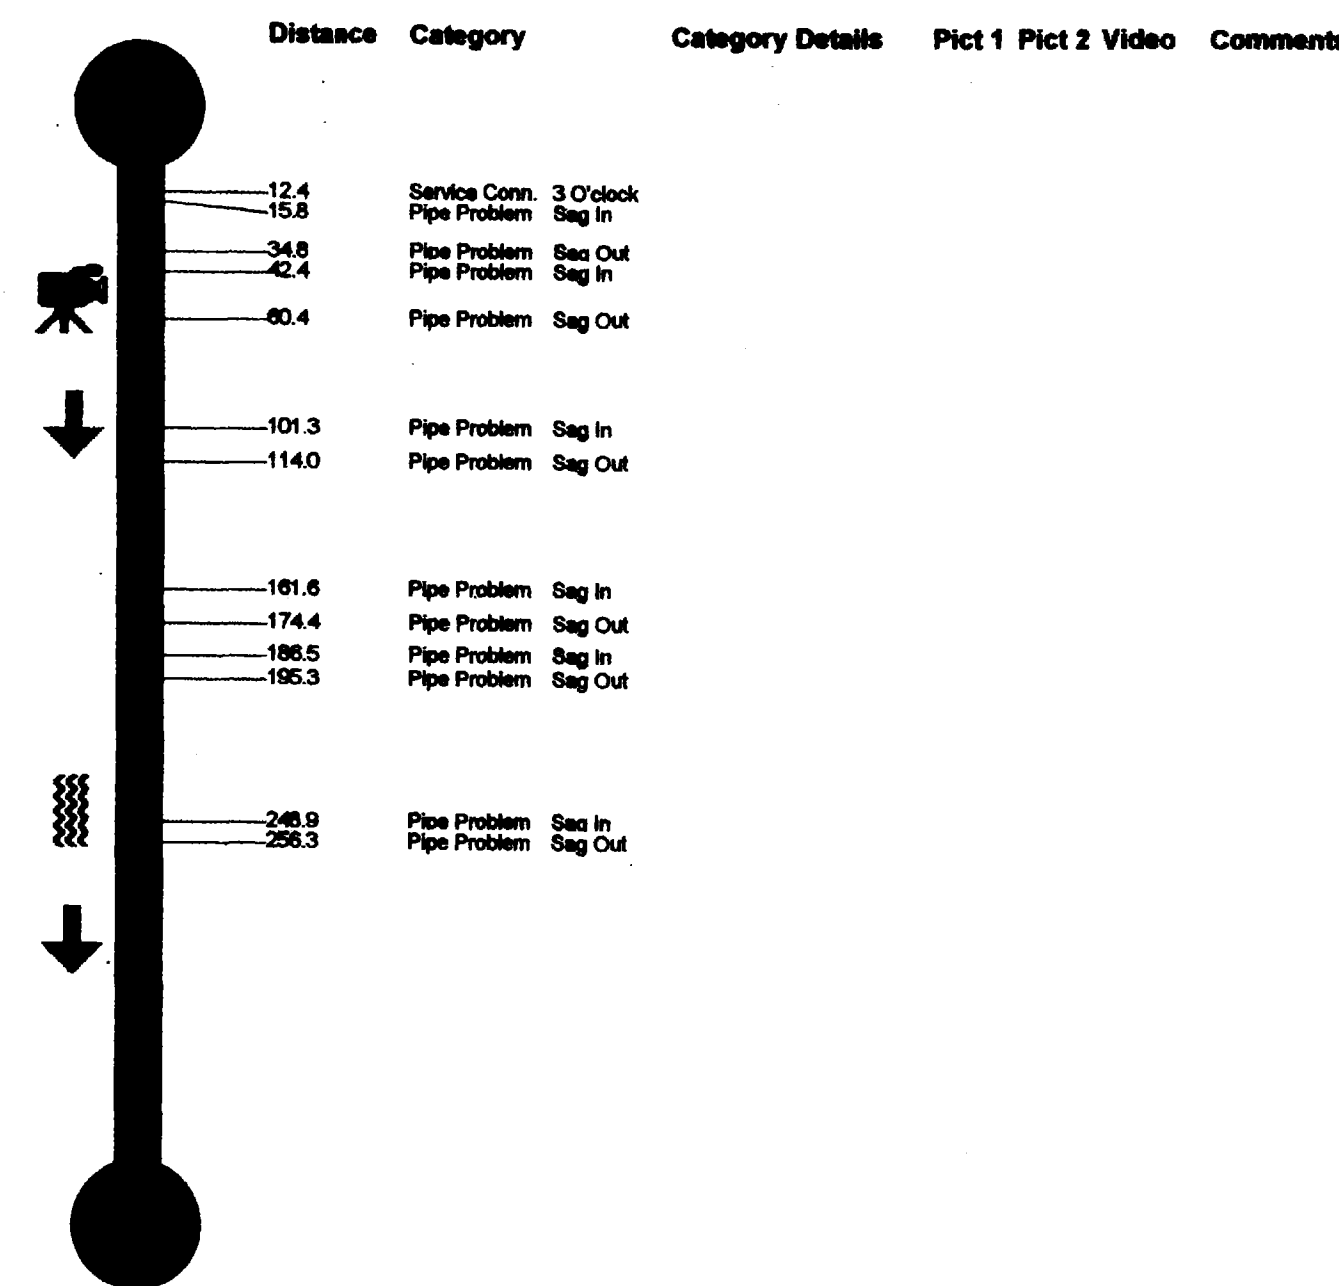



City of Grand Junction  
Persigo WWTP  
2145 River Rd.  
Grand Junction CO. 81505  
(970) 244-1487



City of Grand Junction  
Persigo WWTP  
2145 River Rd.  
Grand Junction CO. 81505  
(970) 244-1487



City of Grand Junction  
Persigo WWTP  
2145 River Rd.  
Grand Junction CO. 81505  
(970) 244-1487

Site Data




Project Name	Site ID	City	Street	Starting Ftg.	Date	Time	TapelID
F1 Sewer Line	5	Grand Jct.	6@50 Frontage 3.0		Jan. 22 1999	01:29:55 PM	68
M.H. Start	M.H. Stop	M.H. Depth	Pipe Size(in)	Type of Pipe	Direction	Surface Condition	Final Footage
2F1	1F1	5 (ft) 8 (in)	8	PVC	Away-DS	Dirt	+0266.1

Site Data

Project Name	Site ID	City	Street	Starting Ftg.	Date	Time	TapelID
F1 Sewer Line	4	Grand Jct.	6@50 Frontage 3.0		Jan. 22 1999	10:06:36 AM	68
M.H. Start	M.H. Stop	M.H. Depth	Pipe Size(in)	Type of Pipe	Direction	Surface Condition	Final Footage
3F1	2F1	9 (ft) 6 (in)	8	PVC	Away-DS	Paved Asphalt	+0332.5

Site Data

Project Name	Site ID	City	Street	Starting Ftg.	Date	Time	TapelID
F1 Sewer Line	3	Grand Jct.	6@50 Frontage 3.0		Jan. 21 1999	01:32:11 PM	68
M.H. Start	M.H. Stop	M.H. Depth	Pipe Size(in)	Type of Pipe	Direction	Surface Condition	Final Footage
4F1	3F1	4 (ft) 8 (in)	8	PVC	Away-DS	Dirt	+0242.0

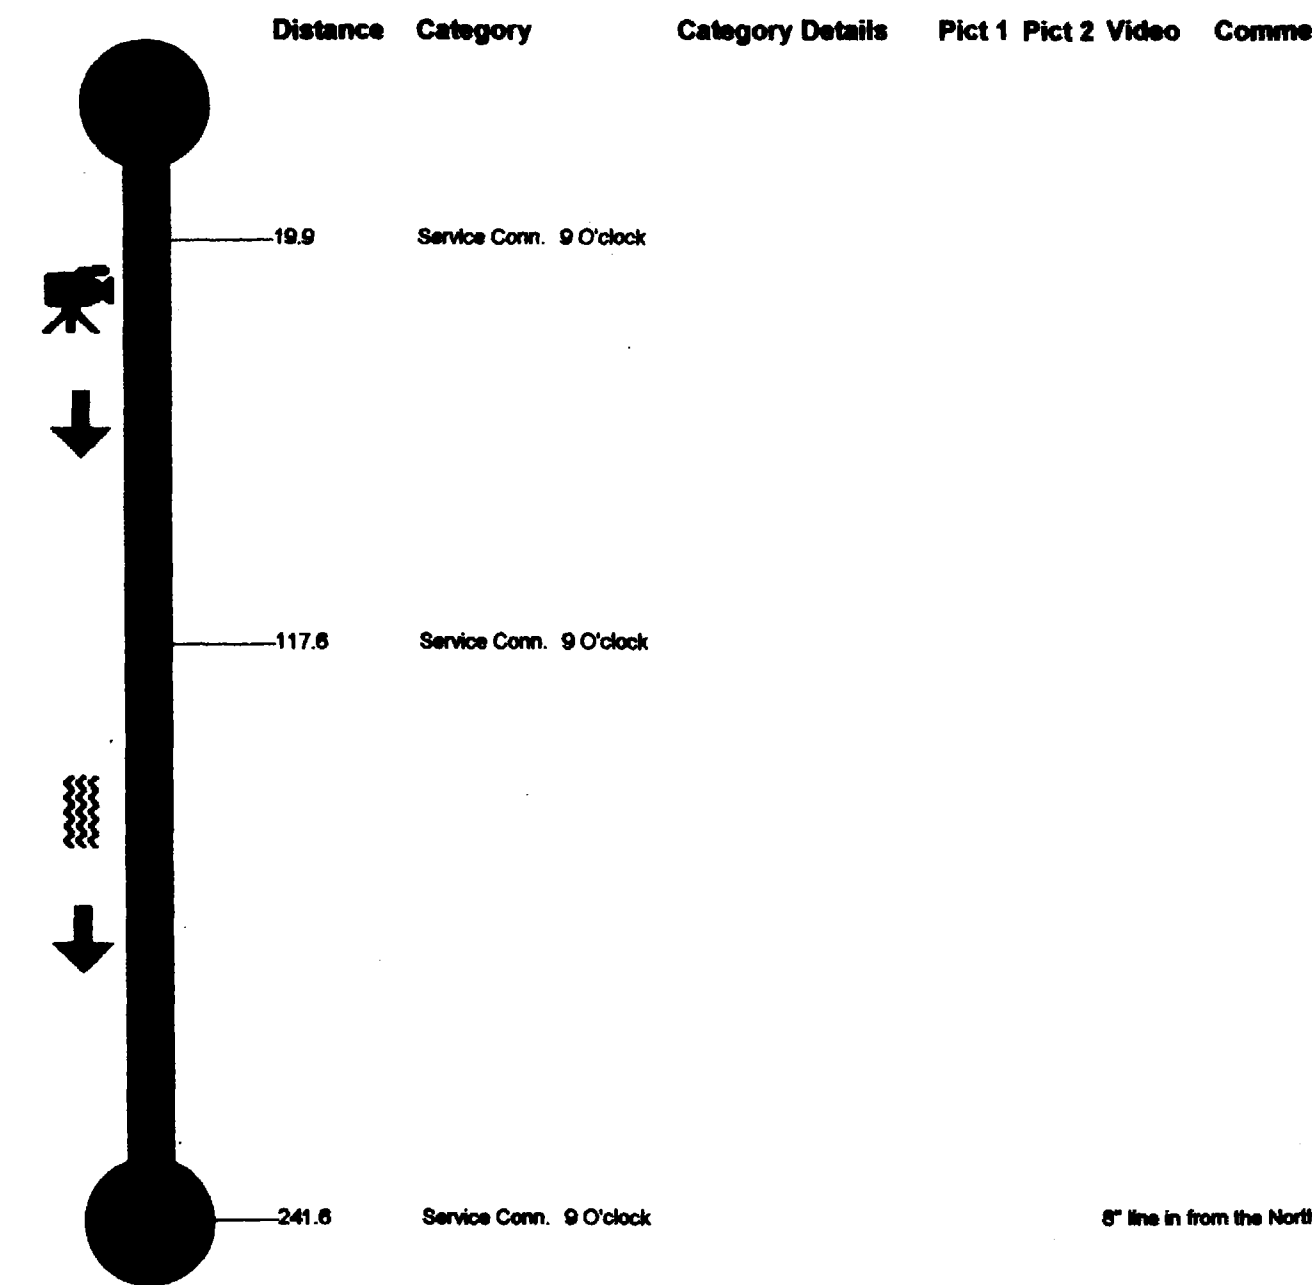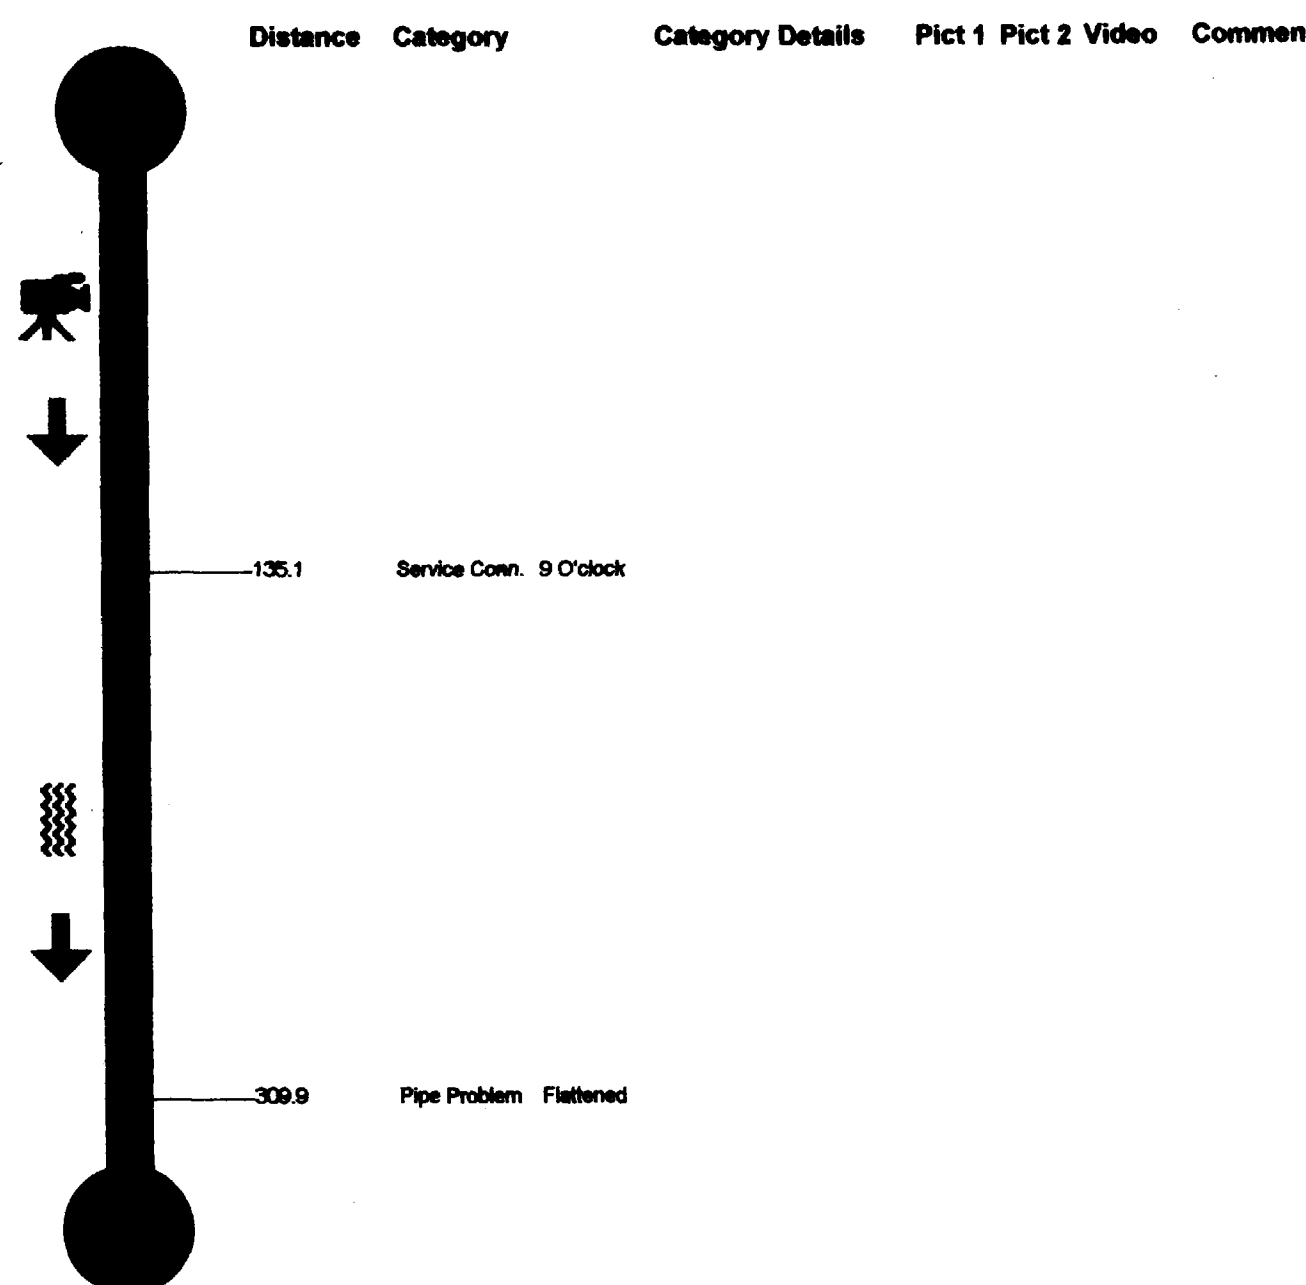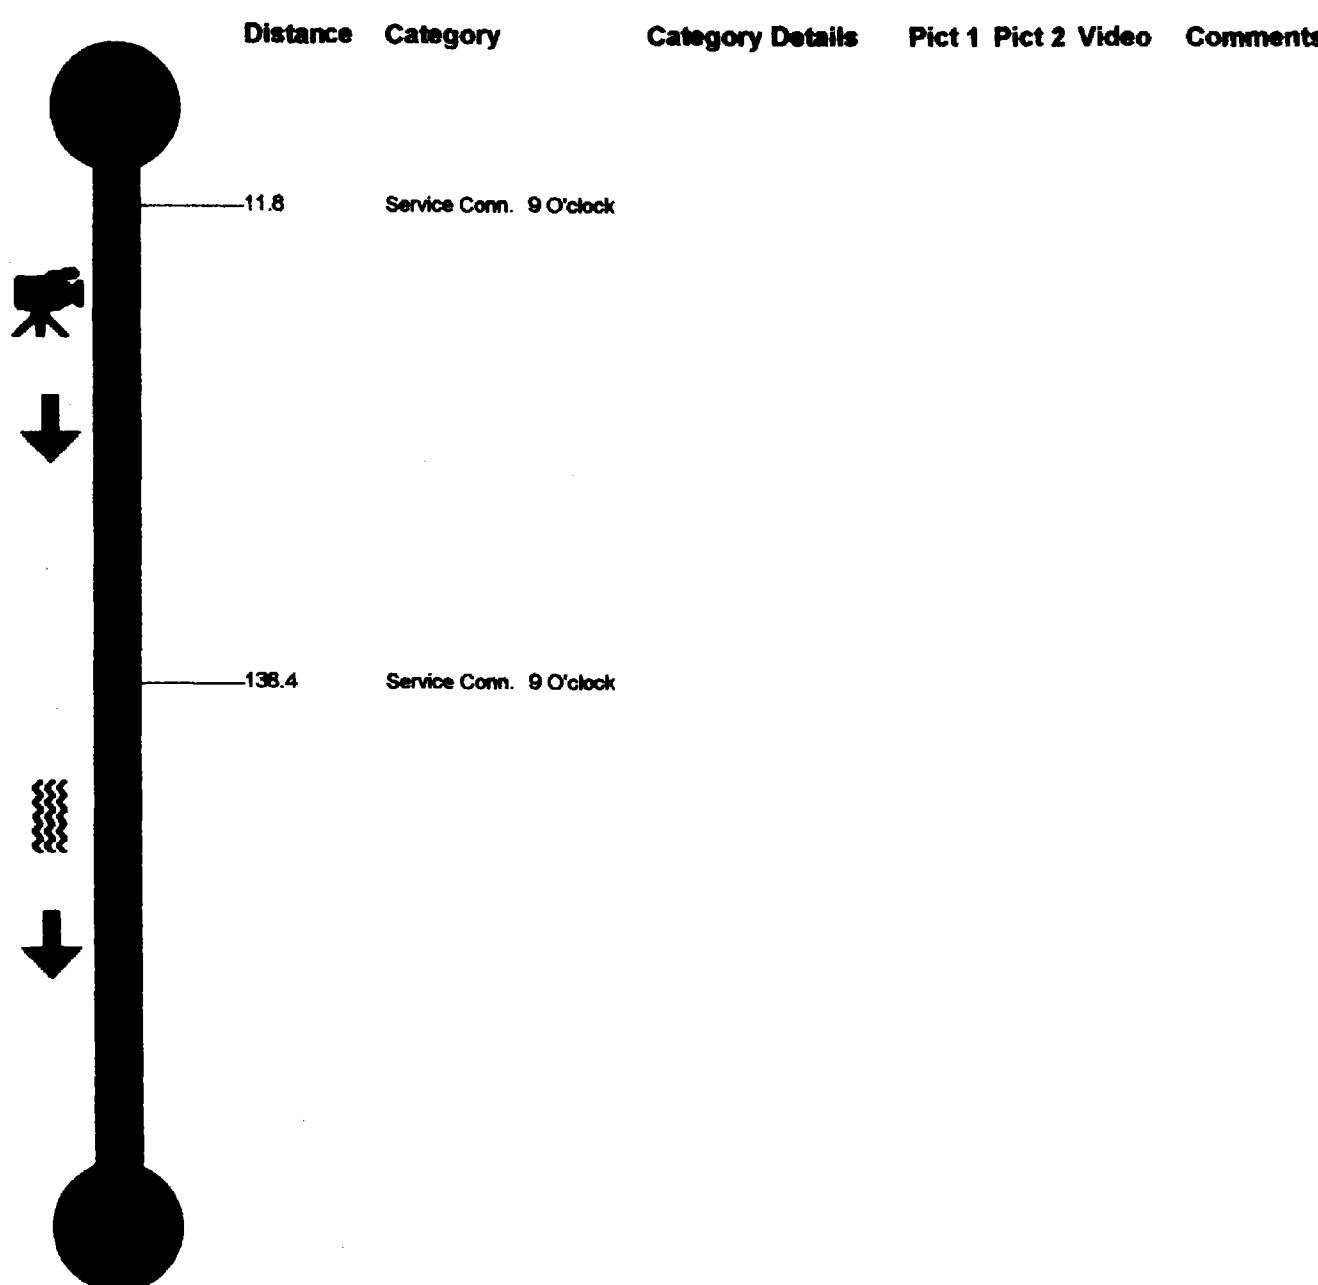

City of Grand Junction  
Persigo WWTP  
2145 River Rd.  
Grand Junction CO. 81505  
(970) 244-1487





City of Grand Junction  
Persigo WWTP  
2145 River Rd.  
Grand Junction CO. 81505  
(970) 244-1487

Site Data

Project Name	Site ID	City	Street	Starting Ftg.	Date	Time	TapelID
F1 Sewer Line	2	Grand Jct.	6@50 Frontage 3.0		Jan. 21 1999	10:35:02 AM	68
M.H. Start	M.H. Stop	M.H. Depth	Pipe Size(in)	Type of Pipe	Direction	Surface Condition	Final Footage
4F1	5F1	4 (ft) 8 (in)	8	PVC	Away-US	Dirt	+0269.5

Site Data

Project Name	Site ID	City	Street	Starting Ftg.	Date	Time	TapelID
F1 Sewer Line	1	Grand Jct.	6@50 Frontage 3.0		Jan. 19 1999	02:39:47 PM	68
M.H. Start	M.H. Stop	M.H. Depth	Pipe Size(in)	Type of Pipe	Direction	Surface Condition	Final Footage
M.L.S.F1	M.L.L.6F1	(ft) 8 (in)	8	PVC	Away-US	Dirt	+0123.6

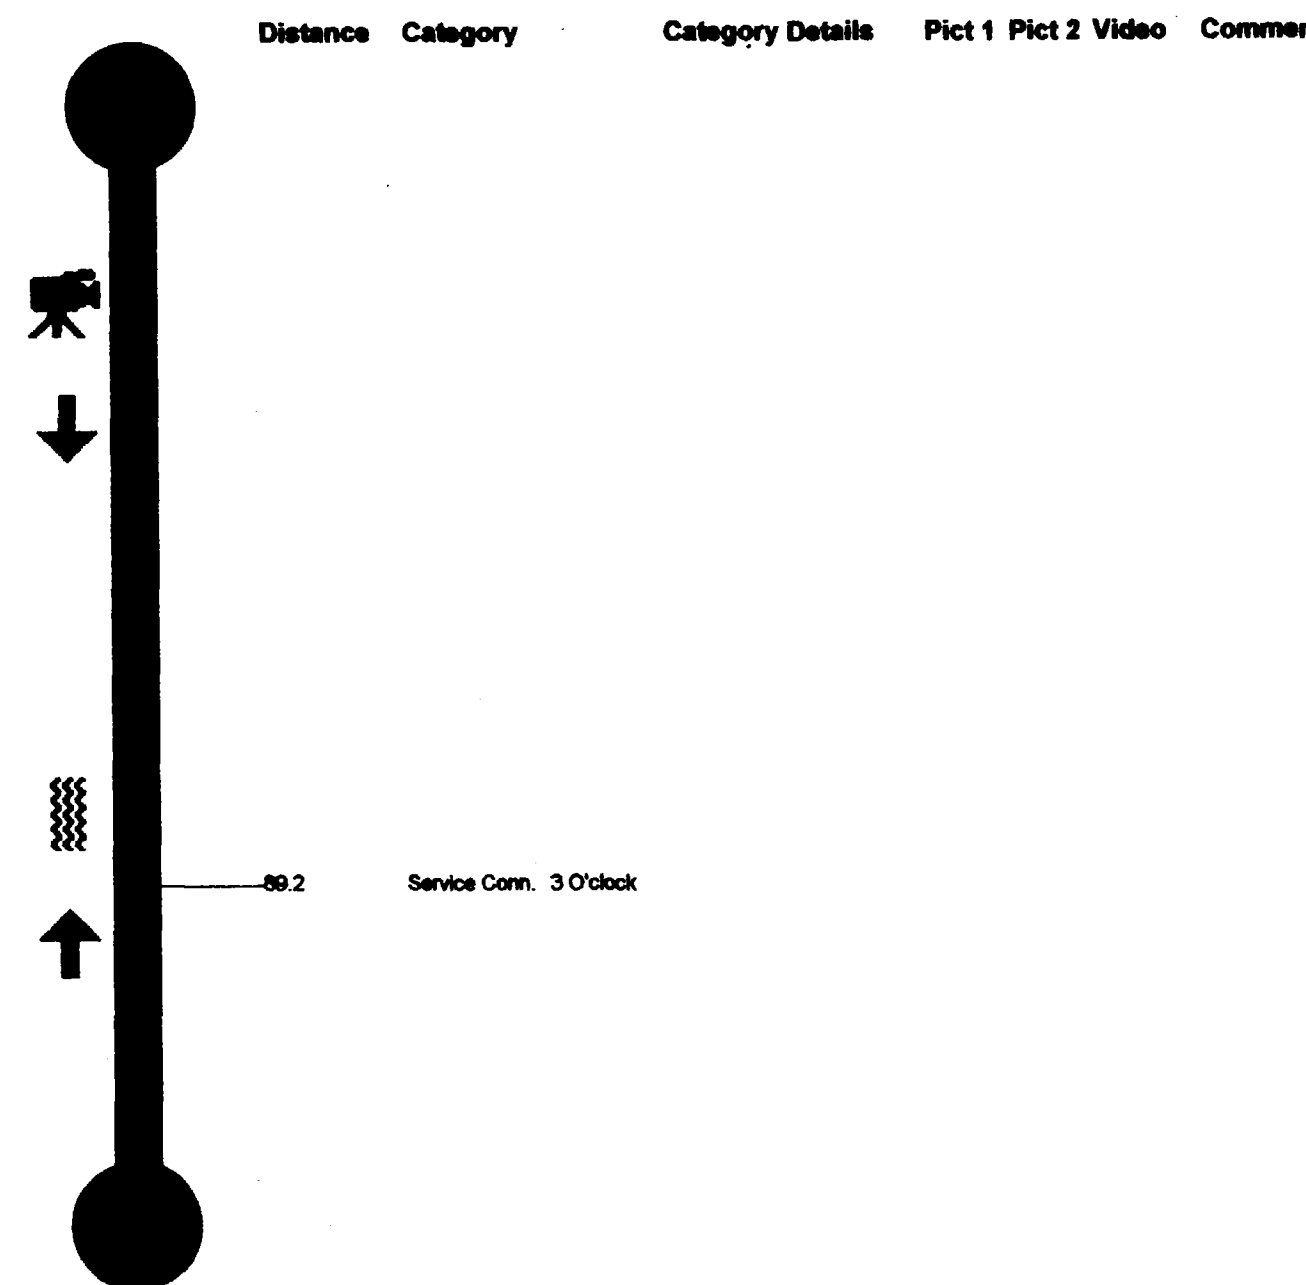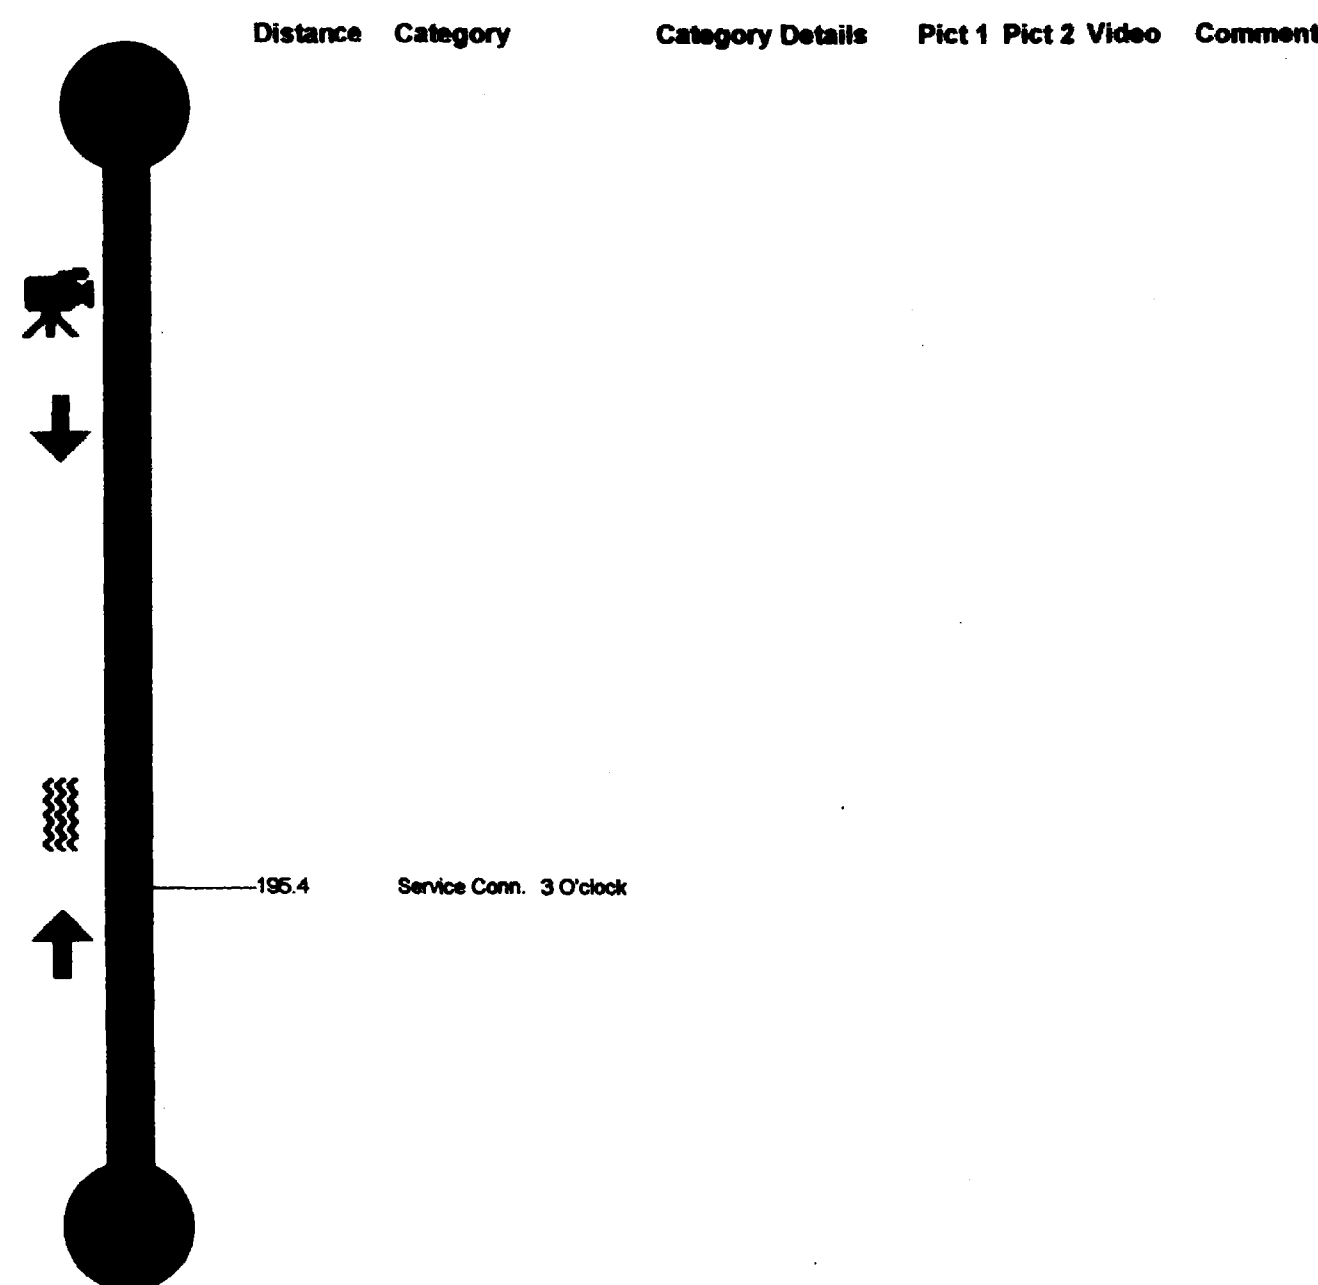

Site Data




Project Name	Site ID	City	Street	Starting Ftg.	Date	Time	TapeID
F2 Sewer Line	1	Grand Jct.	@50 Frontage 3.0		Jan. 26 1999	10:02:13 AM	68
M.H. Start	M.H. Stop	M.H. Depth	Pipe Size(in)	Type of Pipe	Direction	Surface Condition	Final Footage
6F2	7F2	7 (ft)	8 (in)	PVC	Away-US	Dirt	+8354.5

Site Data

Project Name	Site ID	City	Street	Starting Ftg.	Date	Time	TapeID
F2 Sewer Line	2	Grand Jct.	@50 Frontage 3.0		Jan. 26 1999	01:29:05 PM	68
M.H. Start	M.H. Stop	M.H. Depth	Pipe Size(in)	Type of Pipe	Direction	Surface Condition	Final Footage
6F2	5F2	7 (ft)	8 (in)	PVC	Away-DS	Dirt	+8418.2

Site Data

Project Name	Site ID	City	Street	Starting Ftg.	Date	Time	TapeID
F2 Sewer Line	3	Grand Jct.	@50 Frontage 3.0		Jan. 27 1999	01:06:20 PM	68
M.H. Start	M.H. Stop	M.H. Depth	Pipe Size(in)	Type of Pipe	Direction	Surface Condition	Final Footage
5F2	4F2	6 (ft)	3 (in)	PVC	Away-DS	Dirt	+8387.8

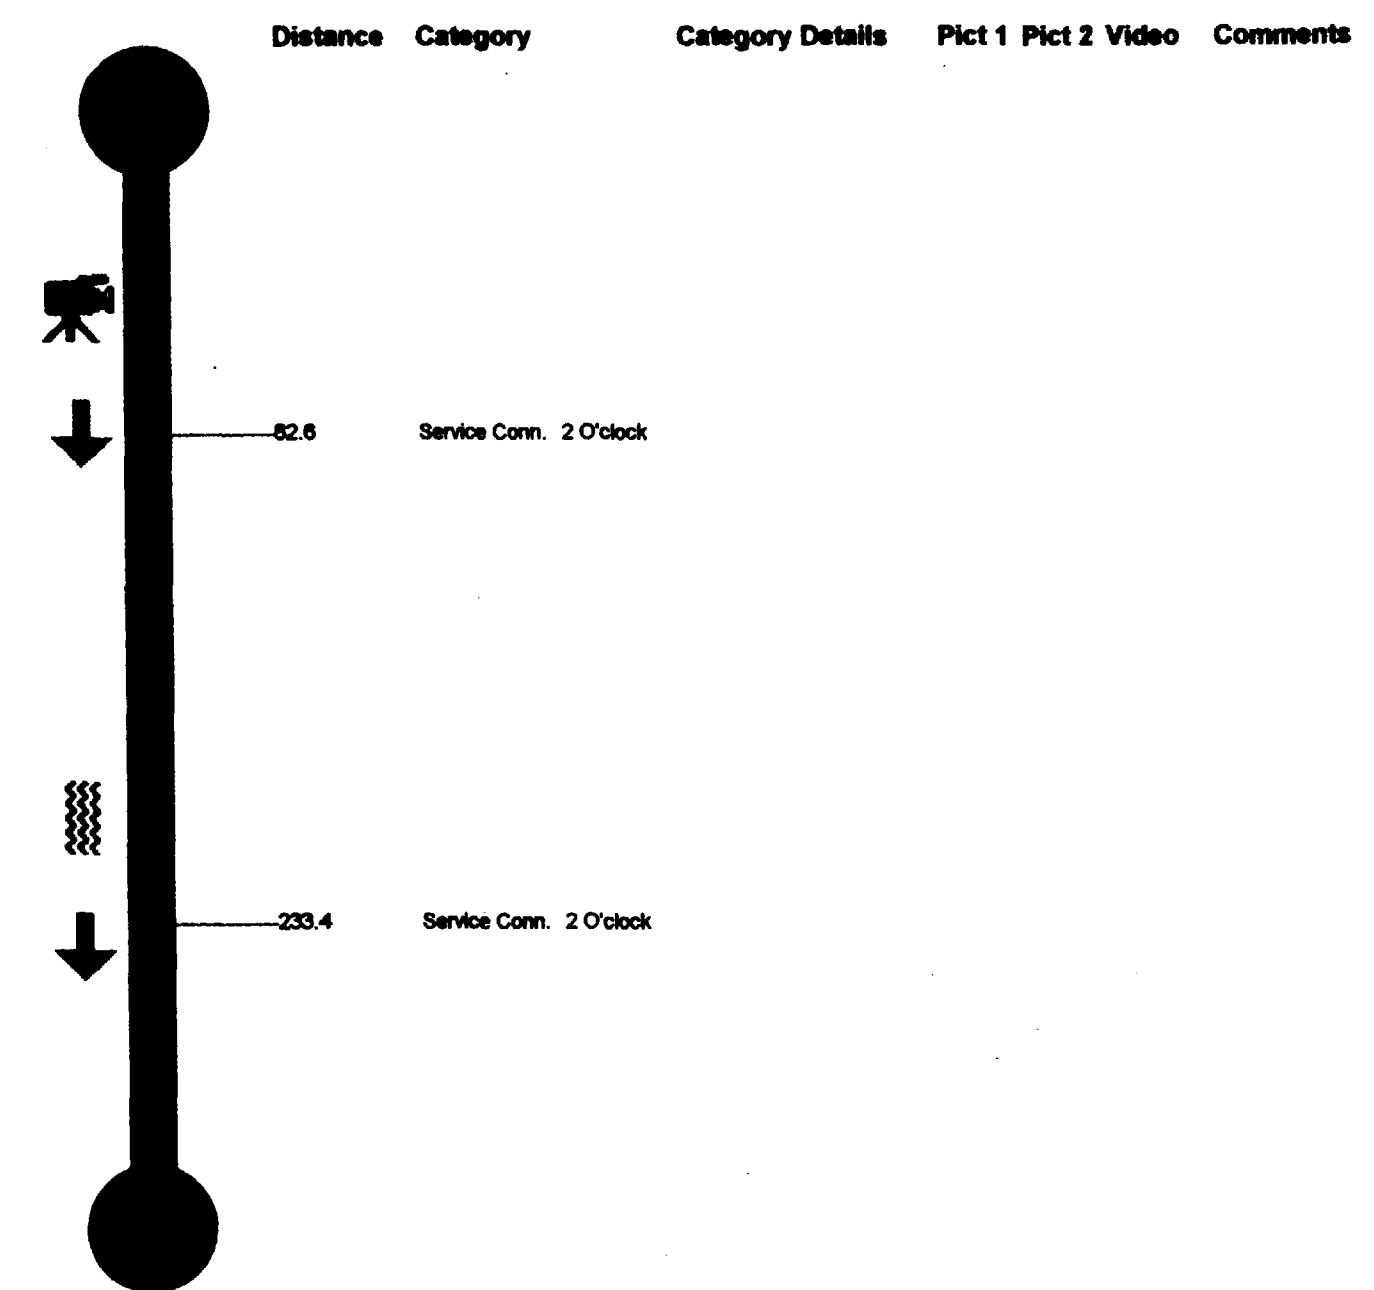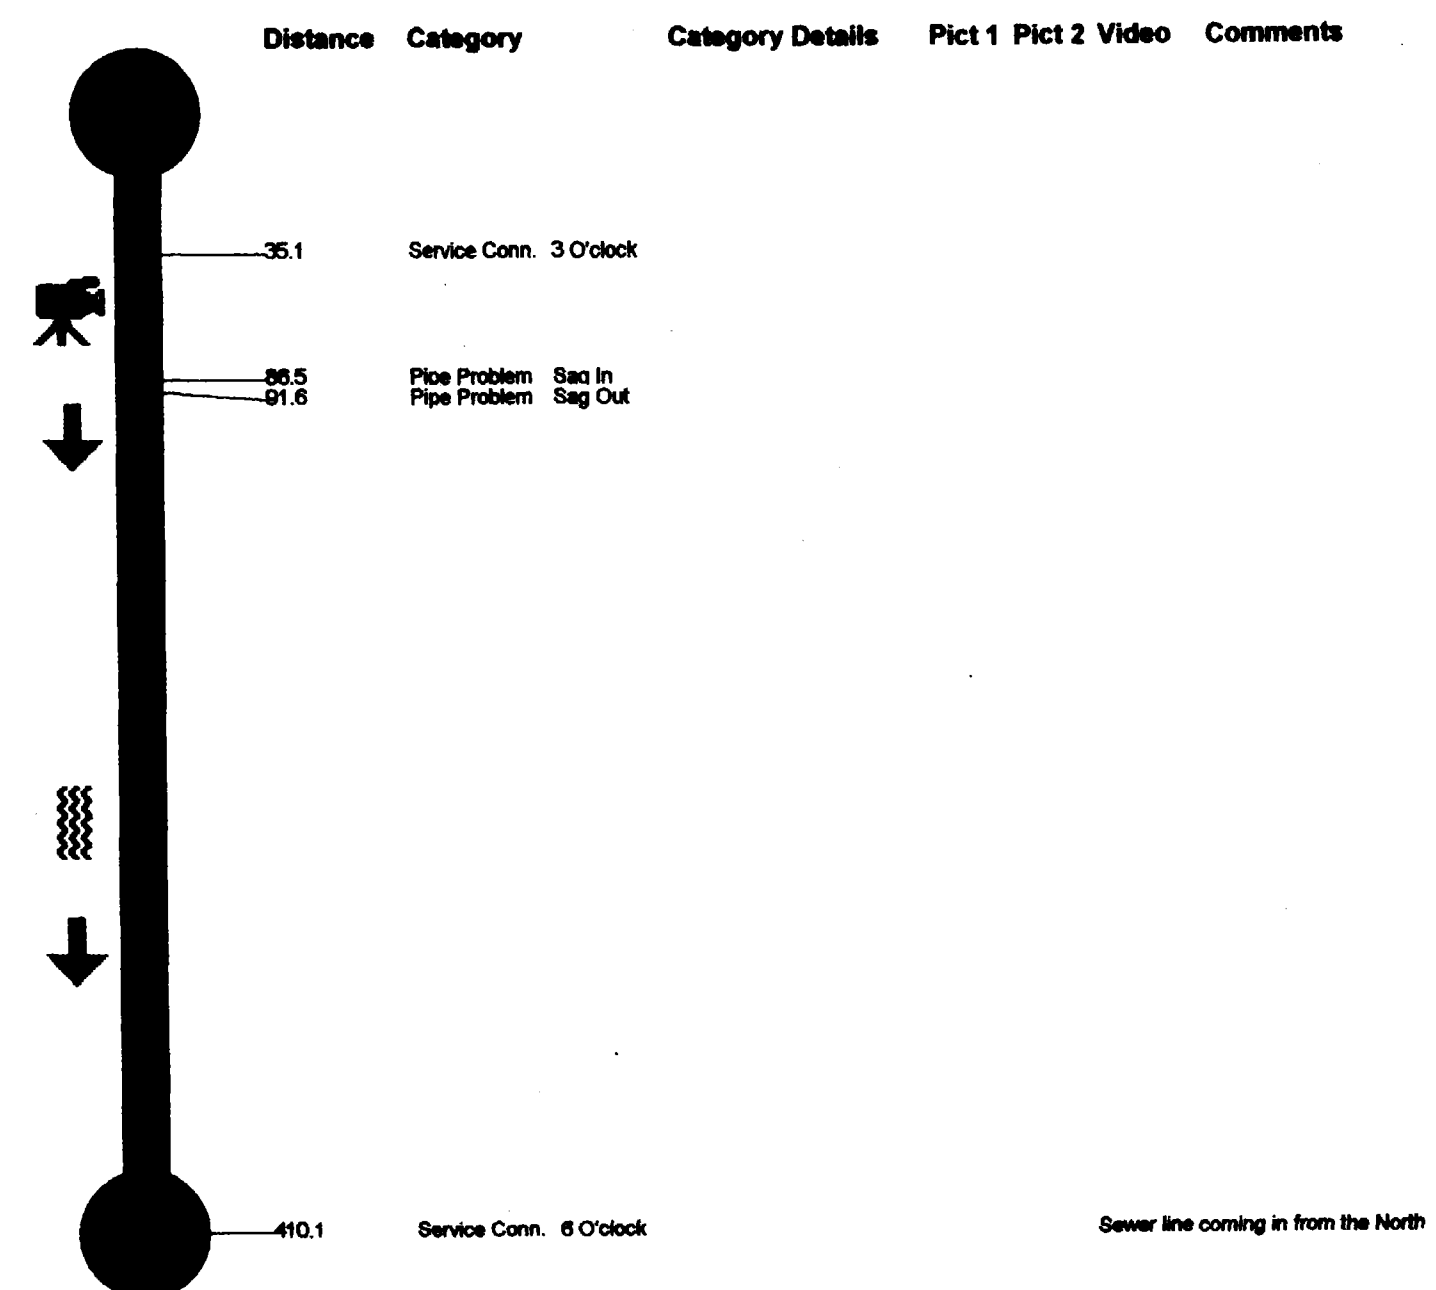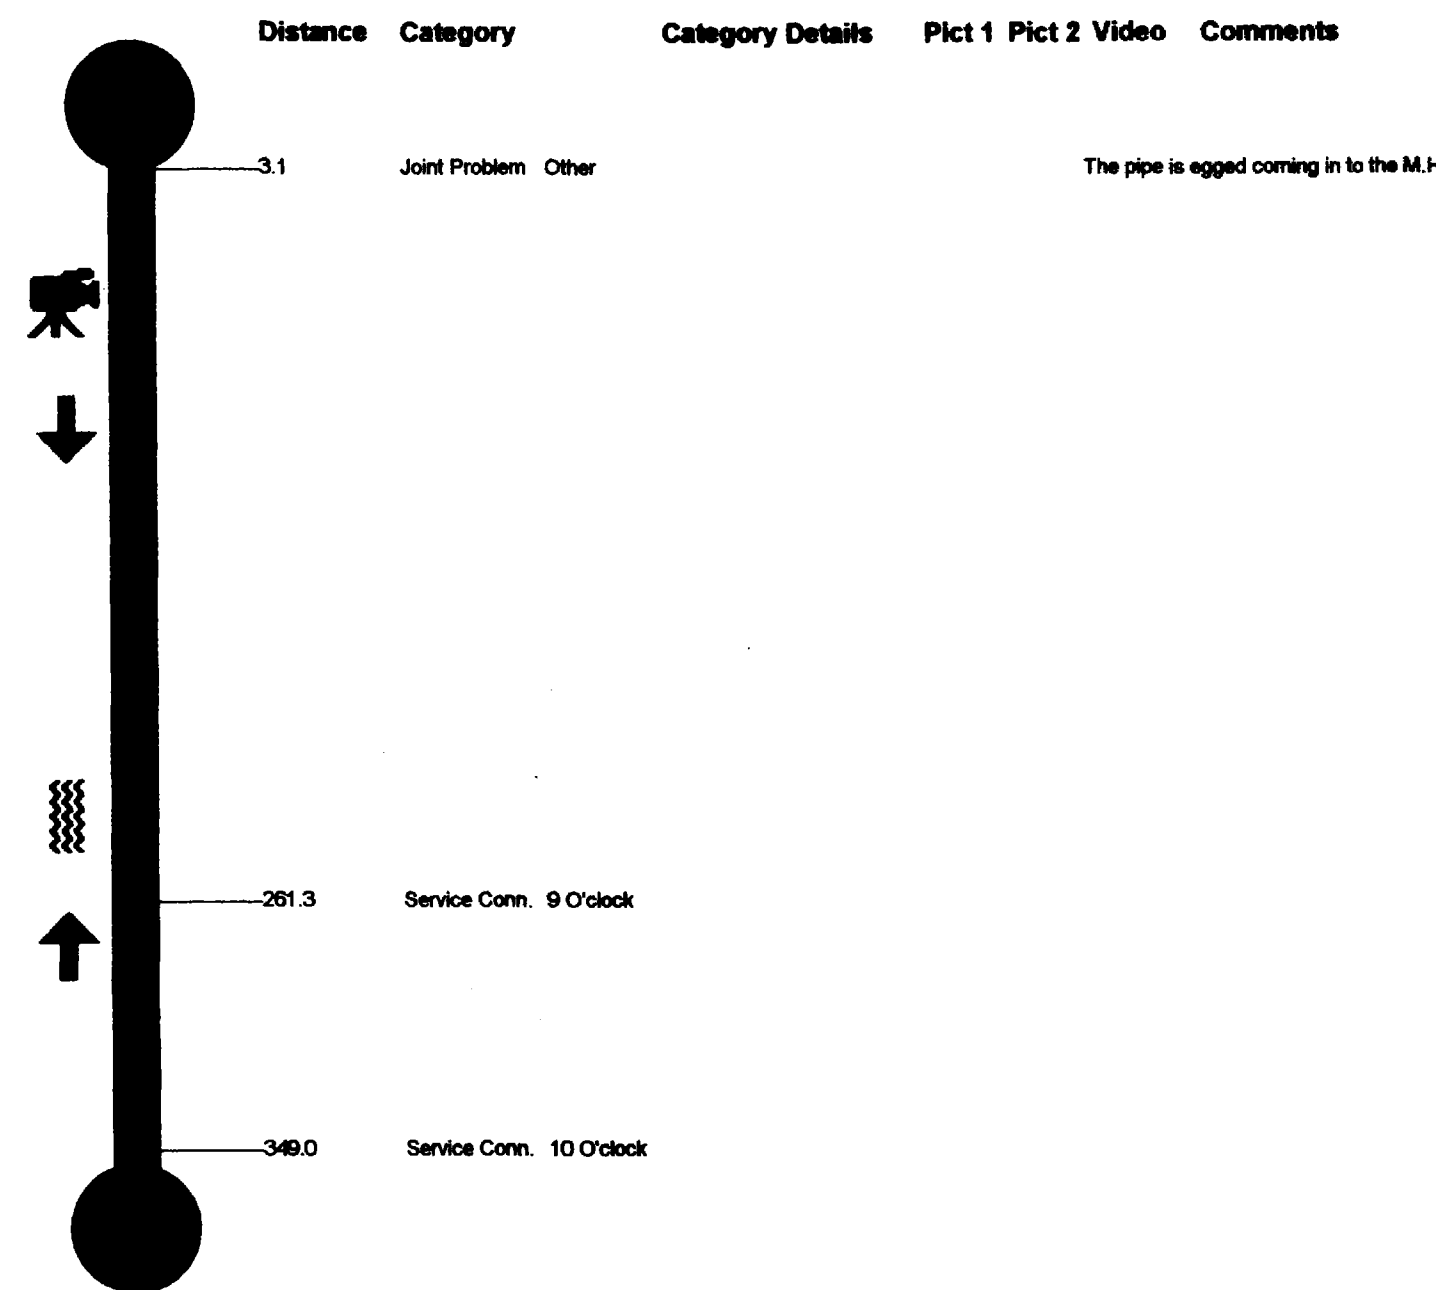

Site Data

Project Name	Site ID	City	Street	Starting Ftg.	Date	Time	TapeID
F2 Sewer Line	4	Grand Jct.	@50 Frontage 3.0		Jan. 27 1999	02:54:16 PM	68
M.H. Start	M.H. Stop	M.H. Depth	Pipe Size(in)	Type of Pipe	Direction	Surface Condition	Final Footage
4F2	2F2	6 (ft)	3 (in)	PVC	Away-DS	Grass	+8435.8

Site Data

Project Name	Site ID	City	Street	Starting Ftg.	Date	Time	TapeID
F2 Sewer Line	5	Grand Jct.	@50 Frontage 3.0		Jan. 28 1999	01:37:46 PM	68
M.H. Start	M.H. Stop	M.H. Depth	Pipe Size(in)	Type of Pipe	Direction	Surface Condition	Final Footage
2F2	1F2	5 (ft)	8 (in)	PVC	Away-DS	Dirt	+8258.8

