

TOTAL for  
Panorama  
PVC 3239'  
Cement 13,777'


TOTAL for  
Monument Village  
PVC ~~832~~  
Cement ~~3,588~~

TOTAL Footage  
For Panorama Sewer District  
28,935  
Panorama Sewer System

Blue ~~ABANDONED LINE~~ 2 miles 1010'


~~ABANDONED LINE~~ TOTAL 11,570'

Yellow: Cement TOTAL 17,365'  
3 miles 1525'

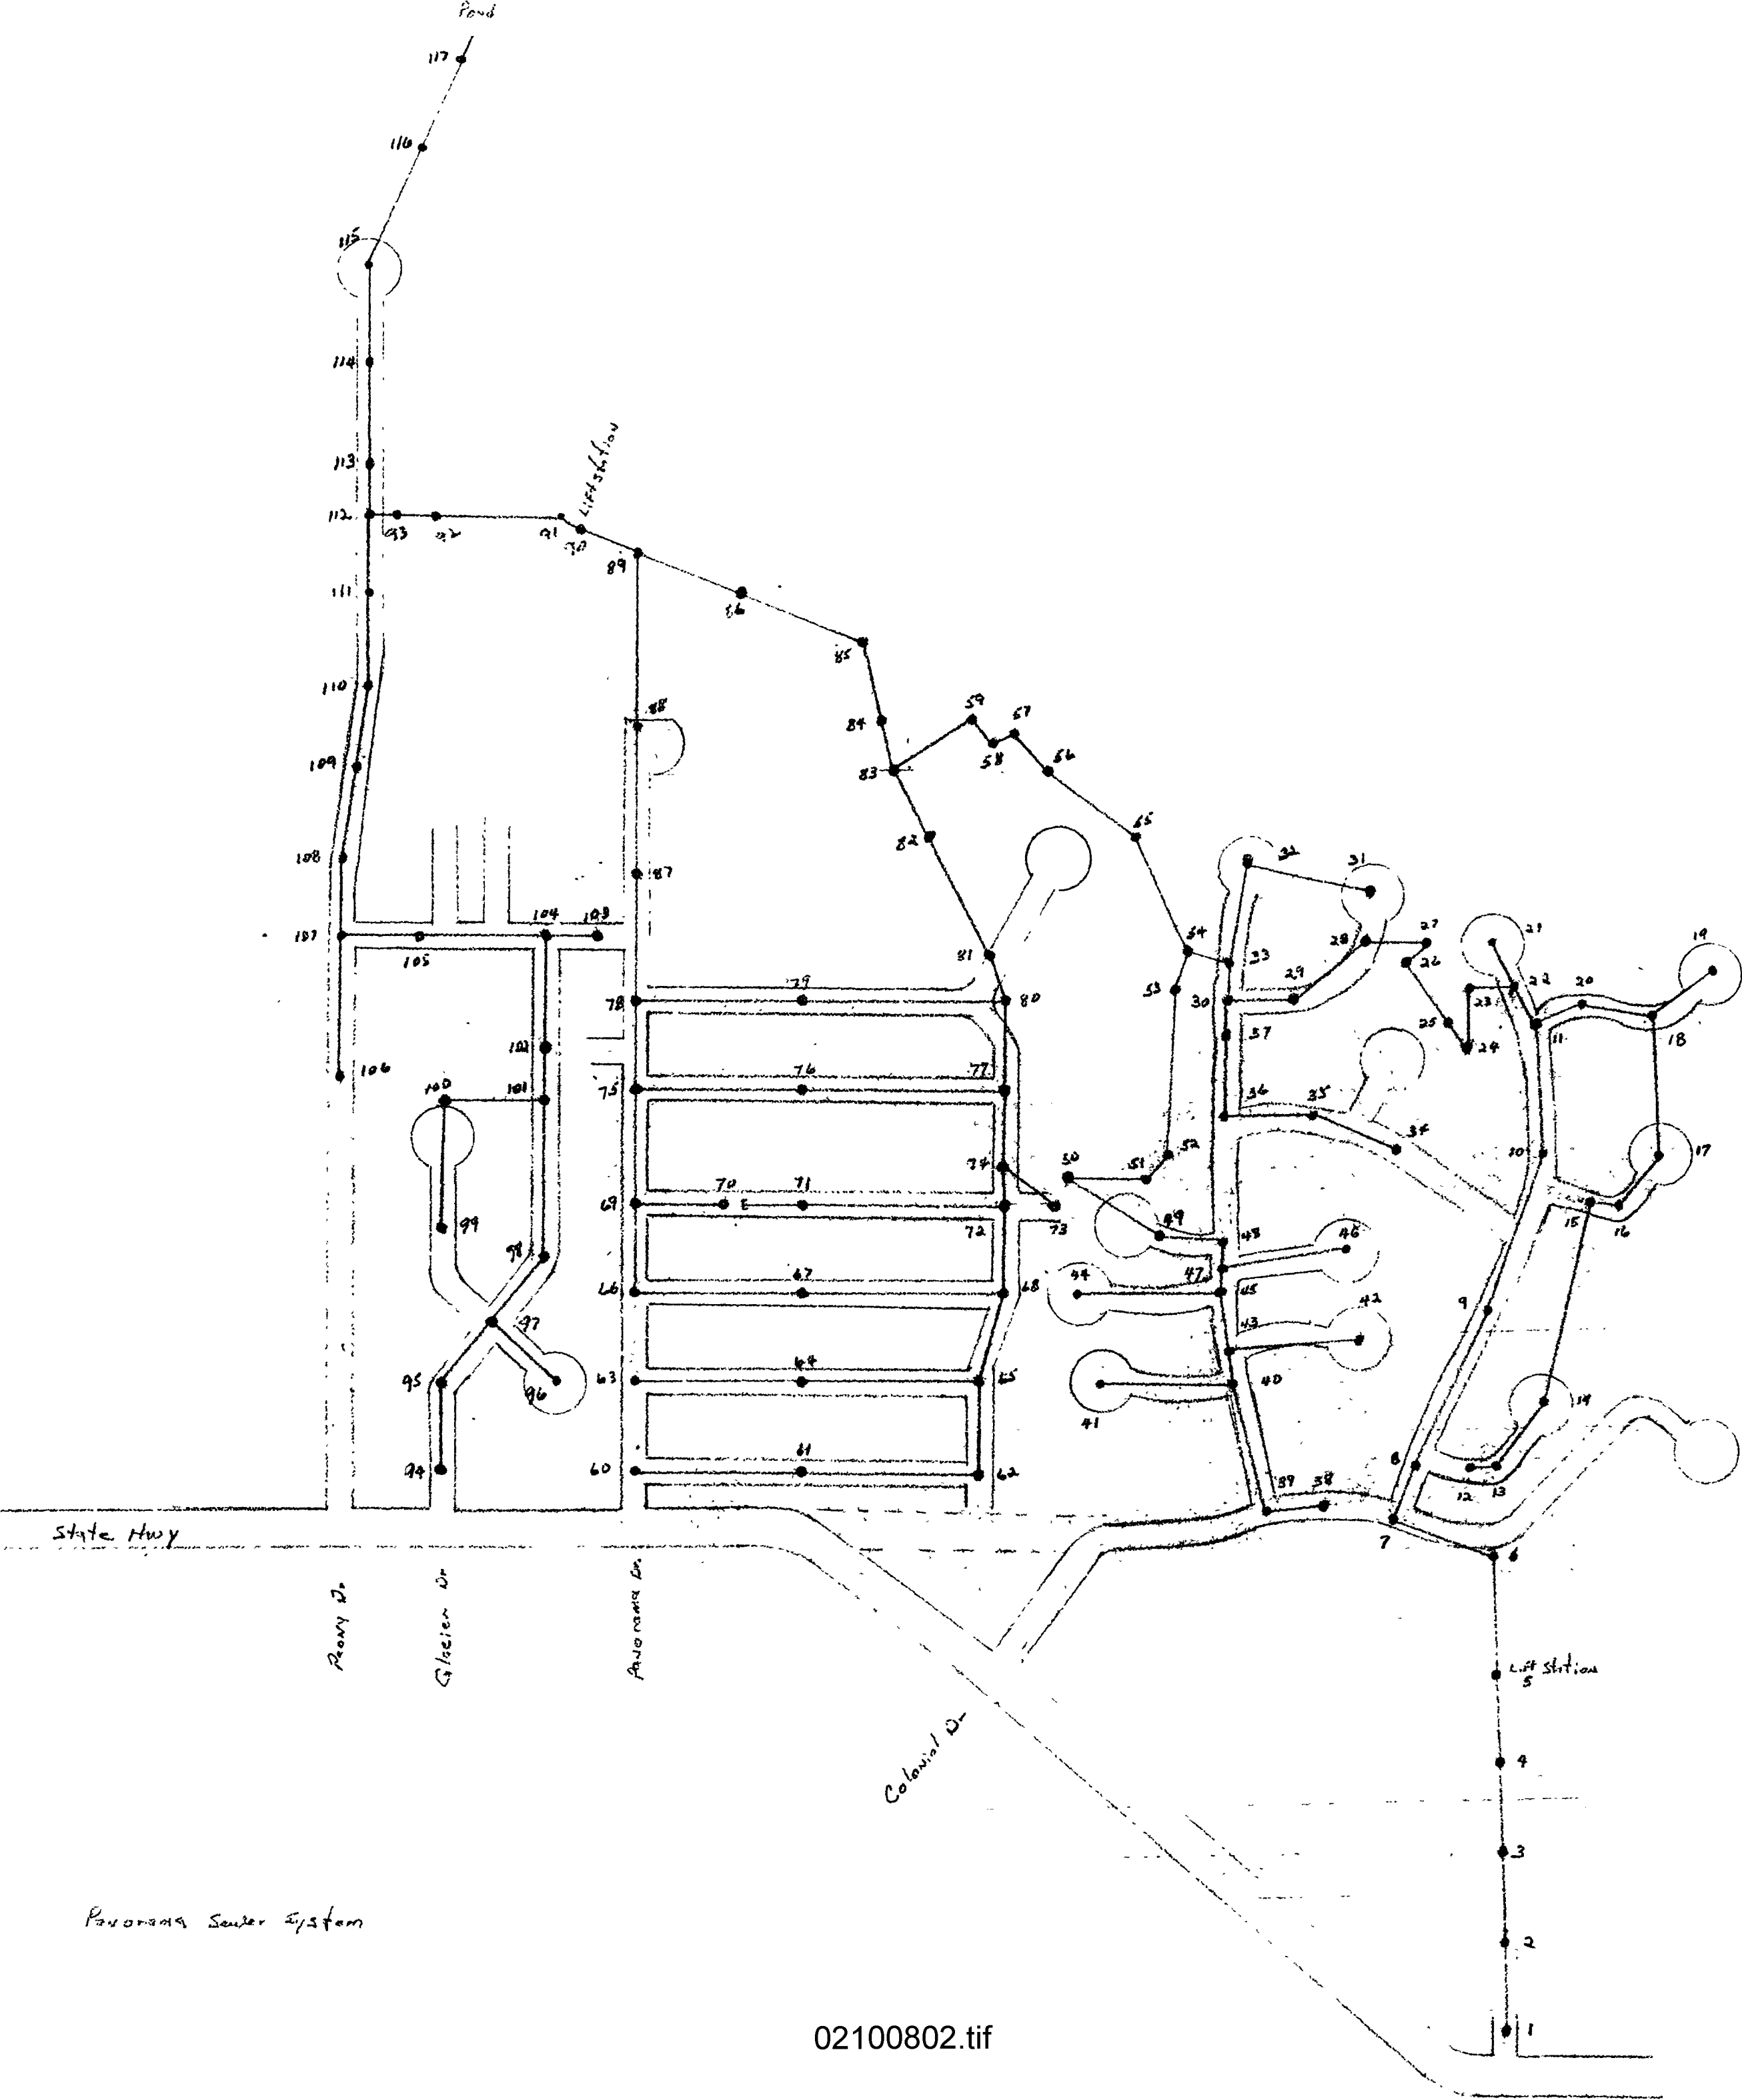

PANORAMA SEWER SYSTEM

RIVER

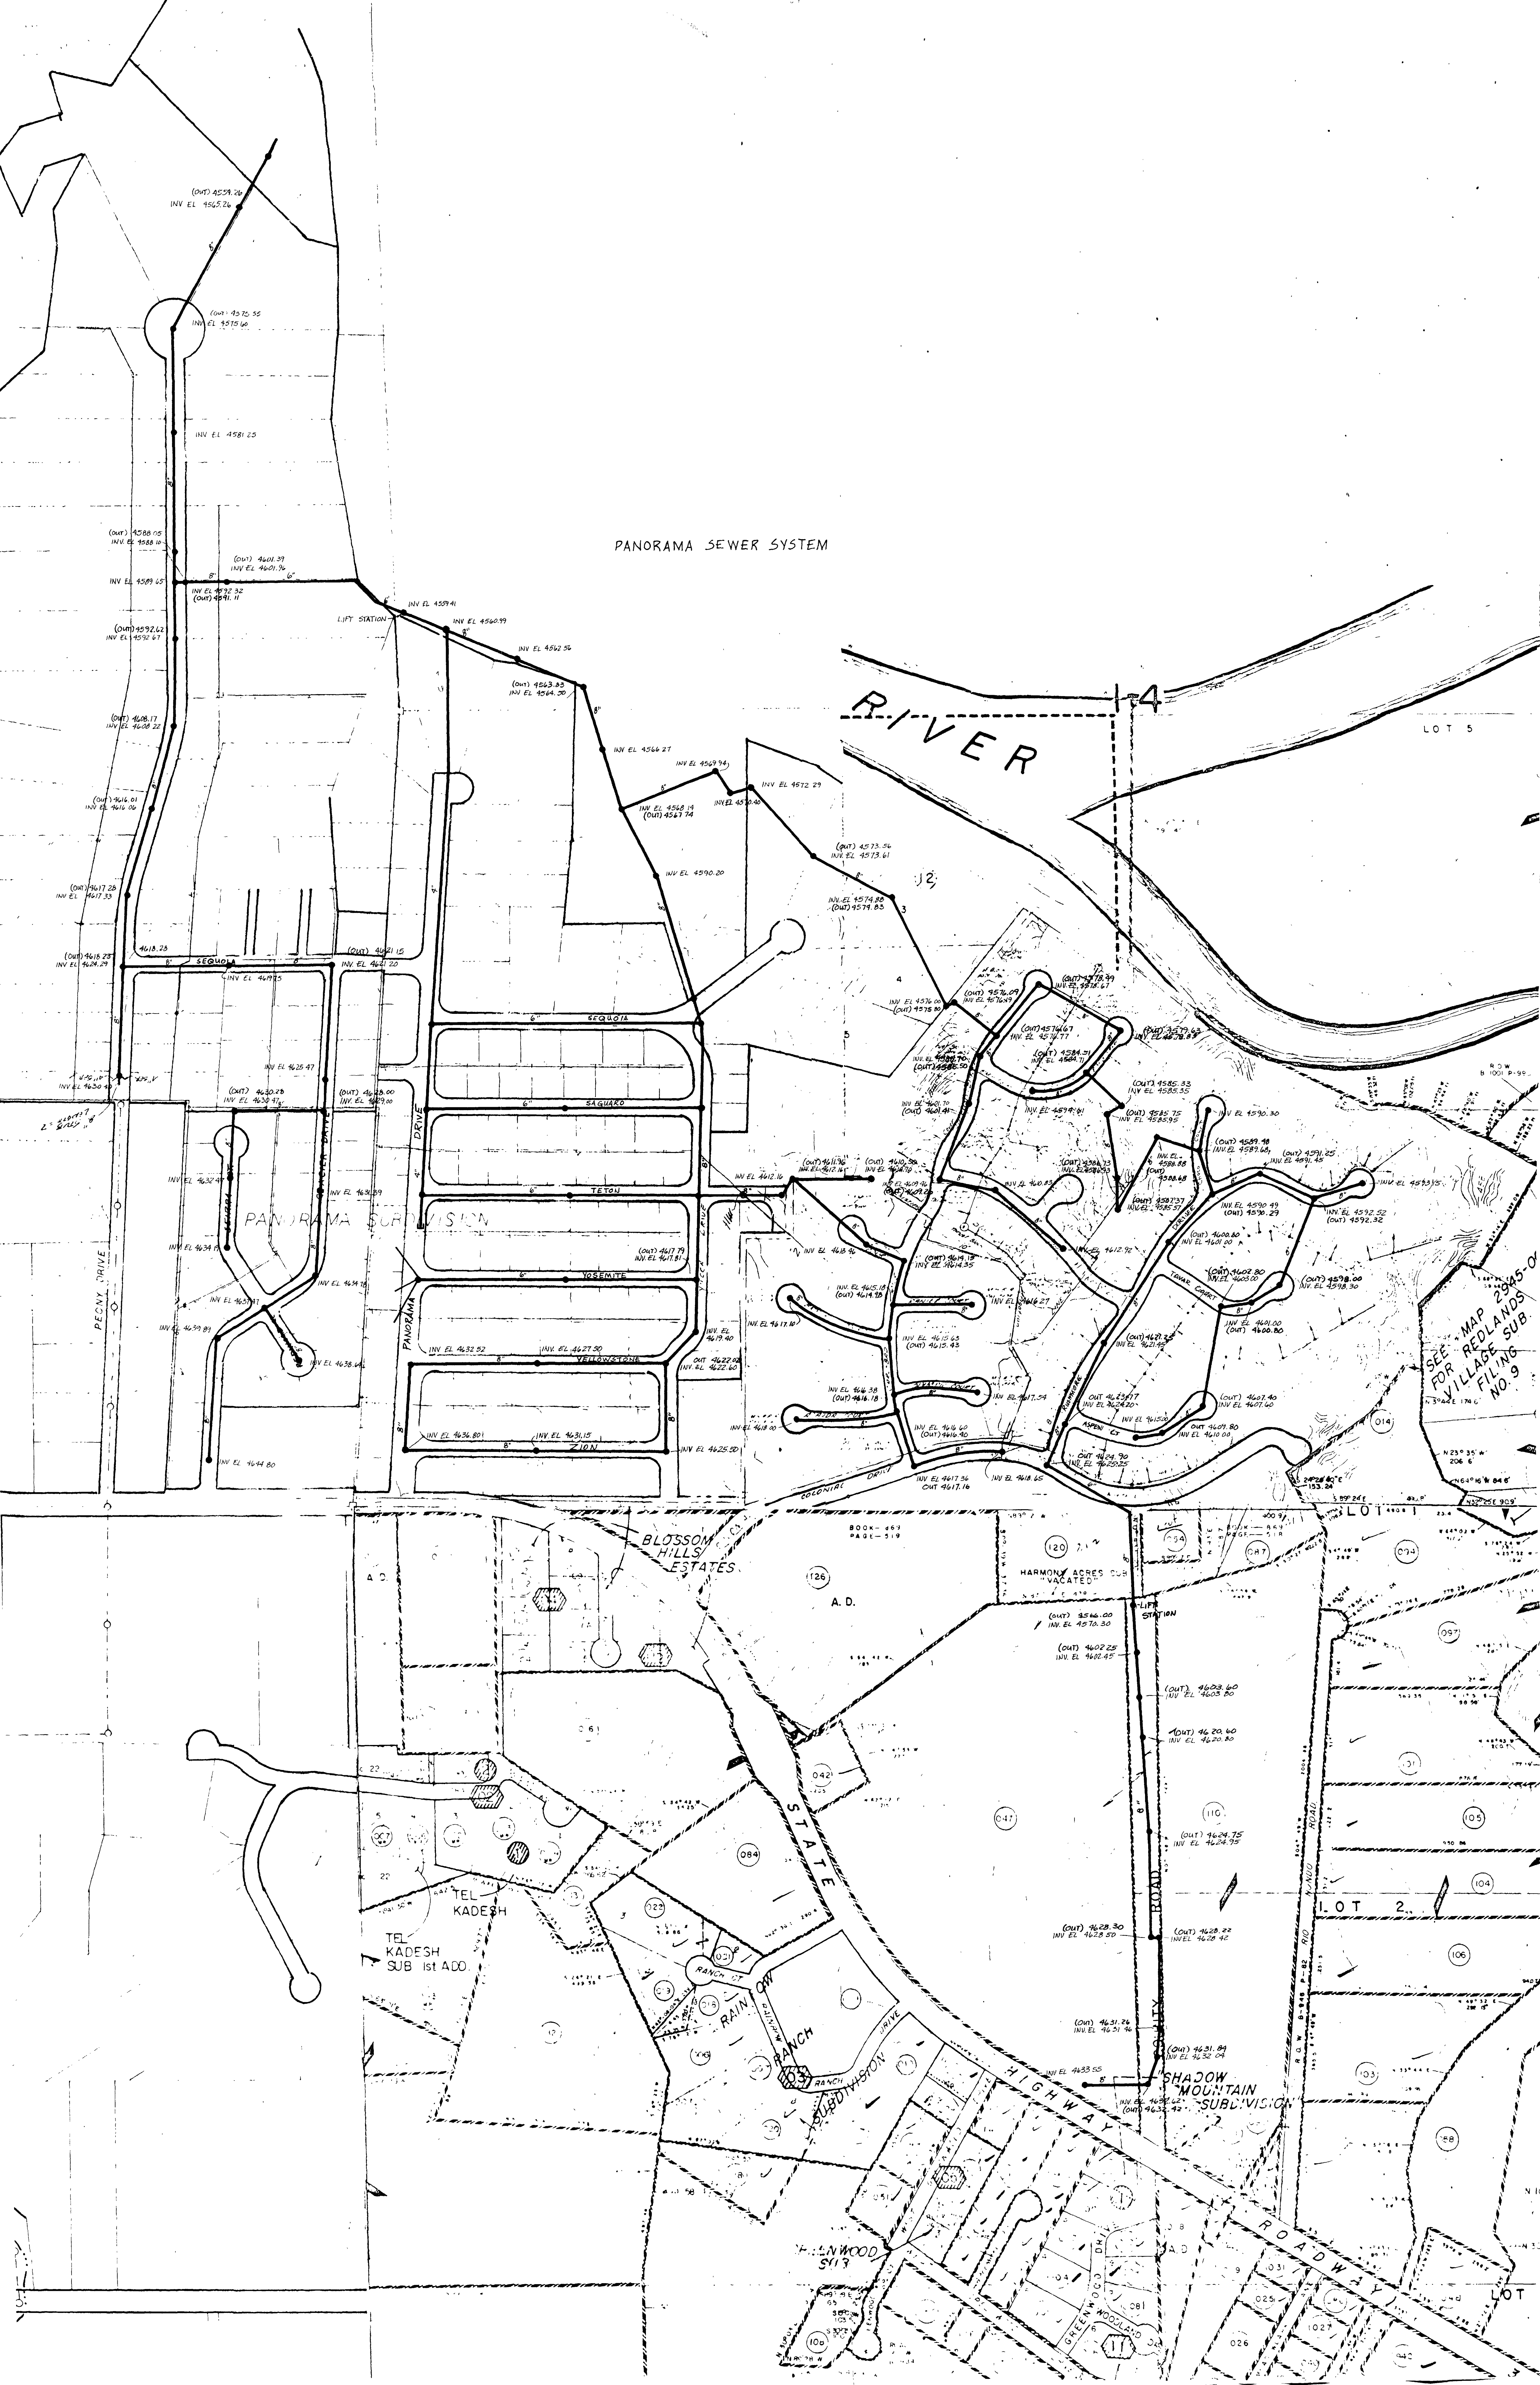

SEE MAP 23045-0 FOR REDLANDS VILLAGE SUB FILING NO. 9