


DATE	
BY	
SURVEYED	
PLOTTED	
NOTED	
NO.	

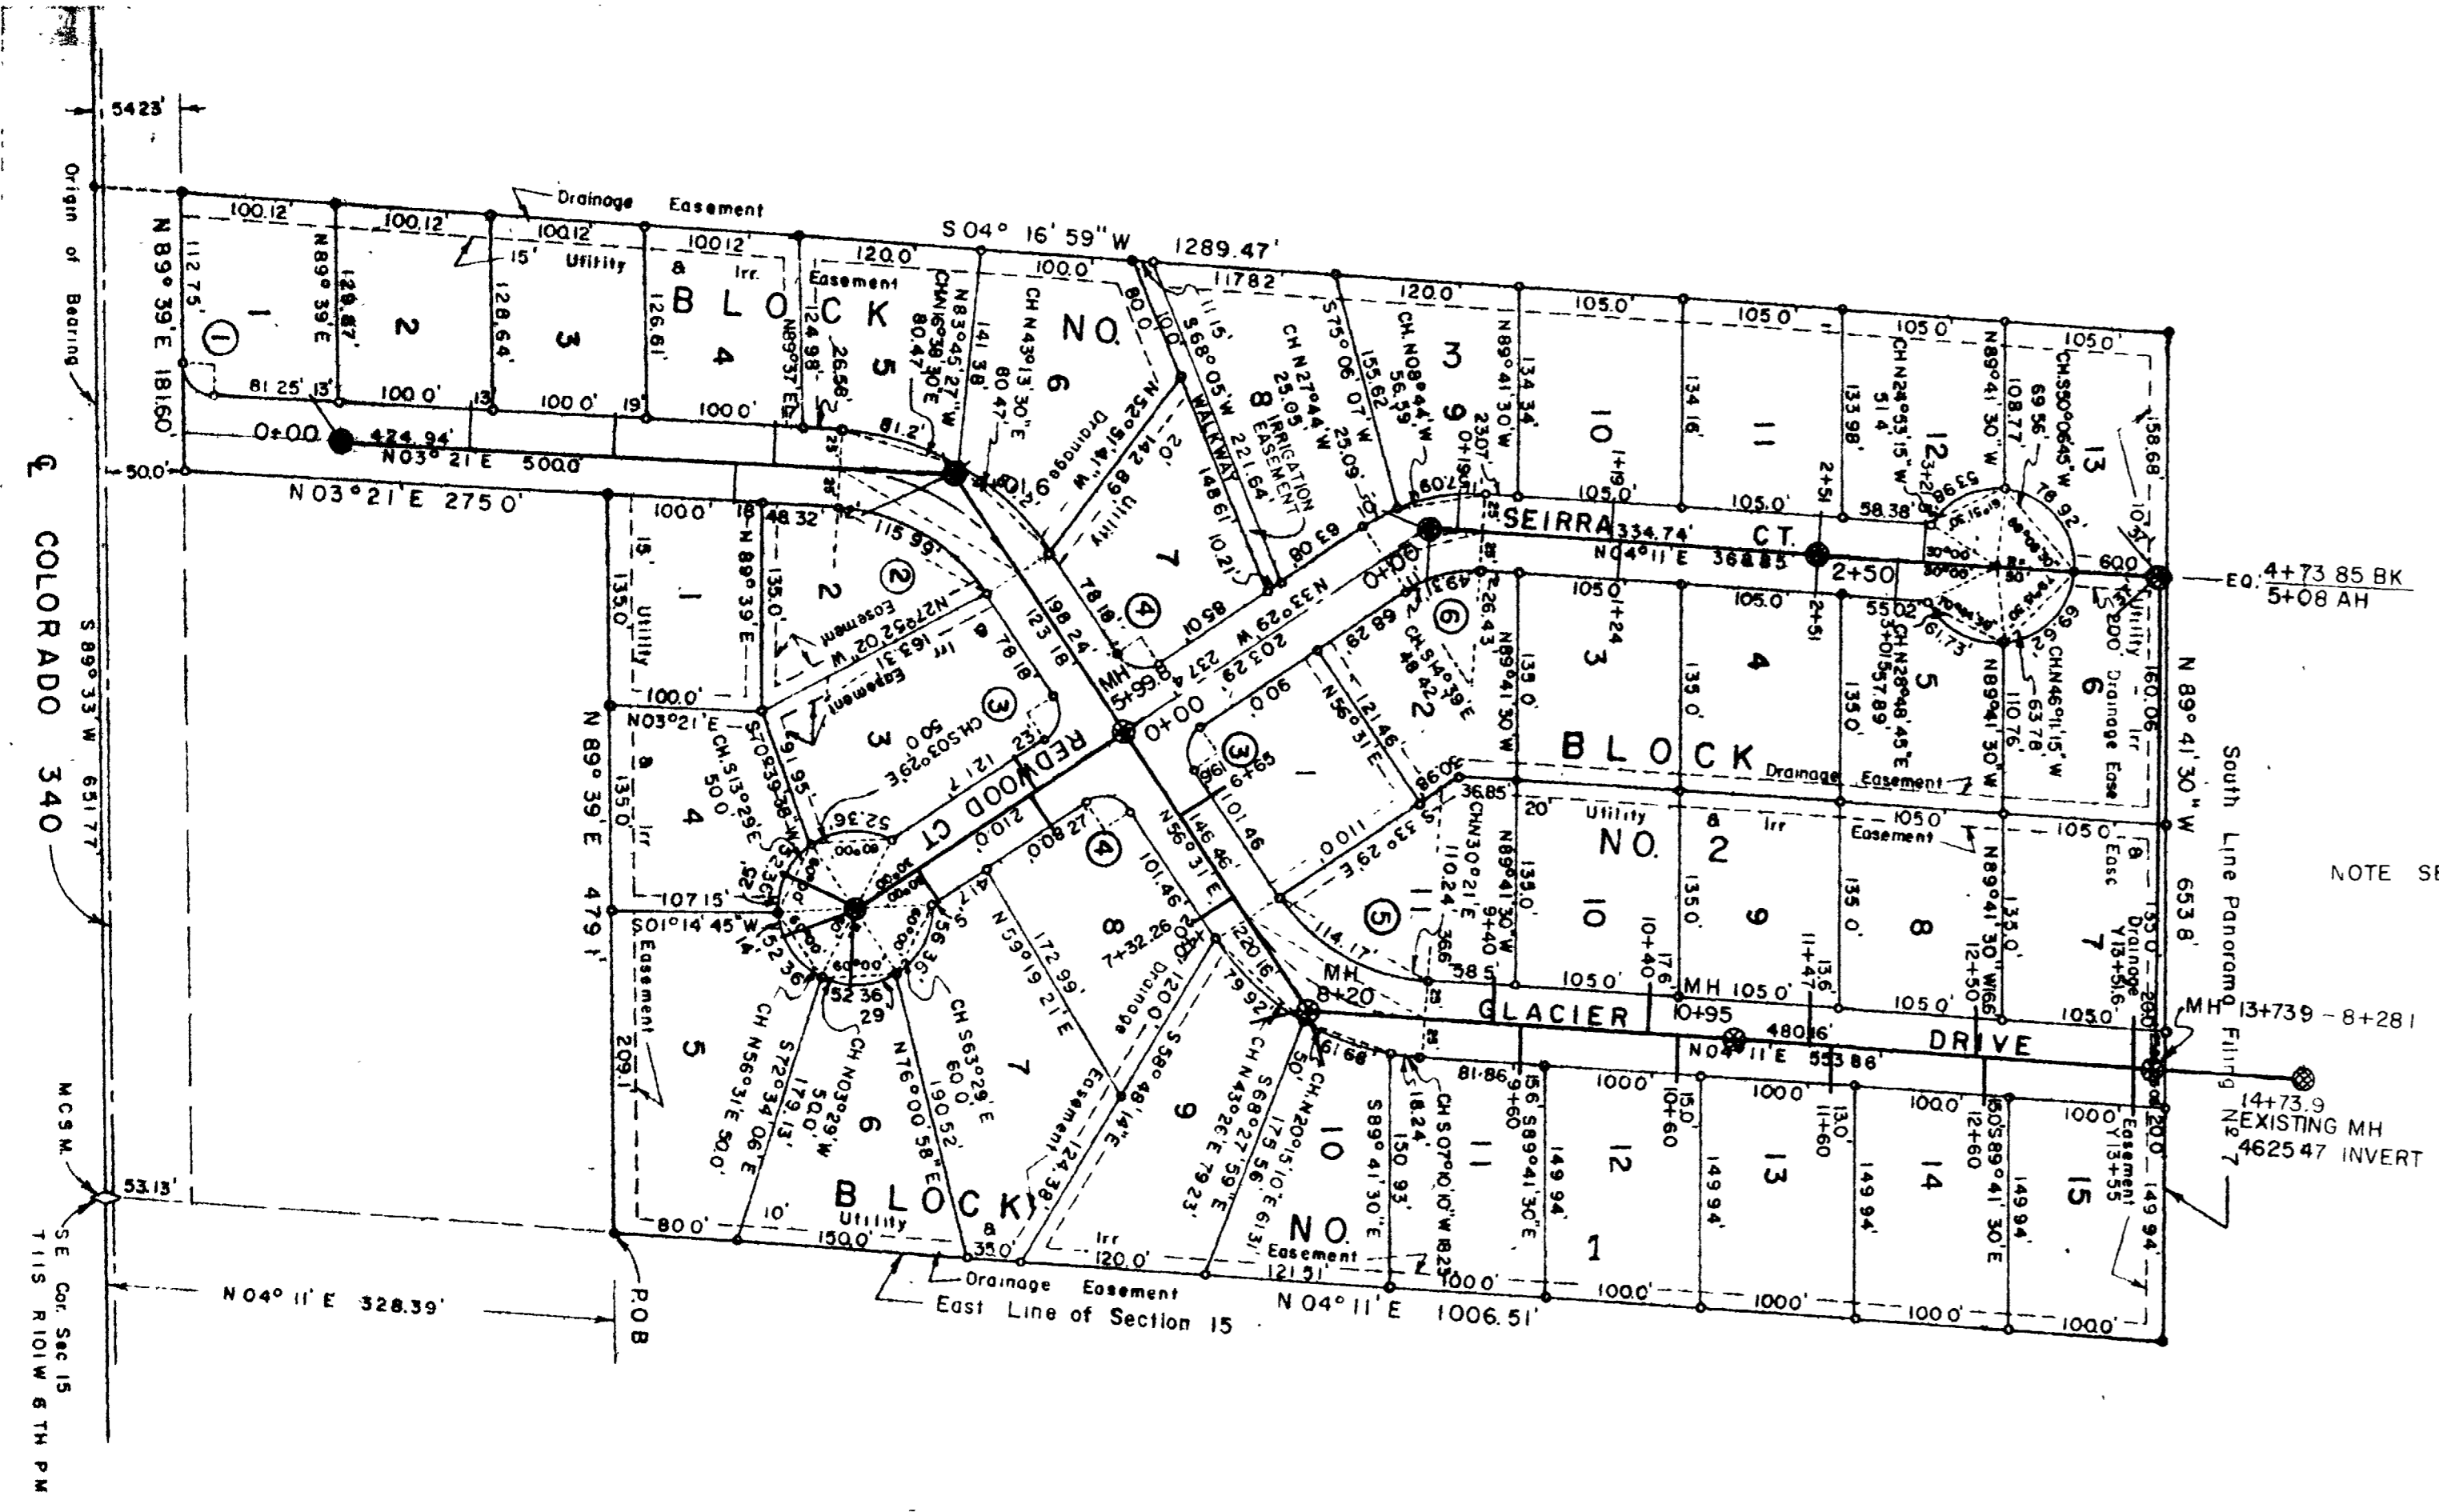


NOTE First stage inspected by Western Engineers, Inc
Second and Third stages inspected by Developer
and Panorama Improvement District


NOTE SERVICE LINES 4" MIN

PLAN
VERTICAL SCALE 1"=10.0'
HORIZONTAL SCALE 1"=100.0'


WESTERN ENGINEERS, INC
AS BUILT
SEWER
PLAN AND PROFILE
BROADWAY SUBDIVISION
MESA COUNTY, COLORADO
ENGINEER C.J.B. DRAWN R.L.S. CHECKED C.J.B.
GRAND JUNCTION, COLORADO DWG 1-126-26 11/19/74

DATE	
BY	
SURVEYED	
PLOTTED	
NOTED	
NO.	

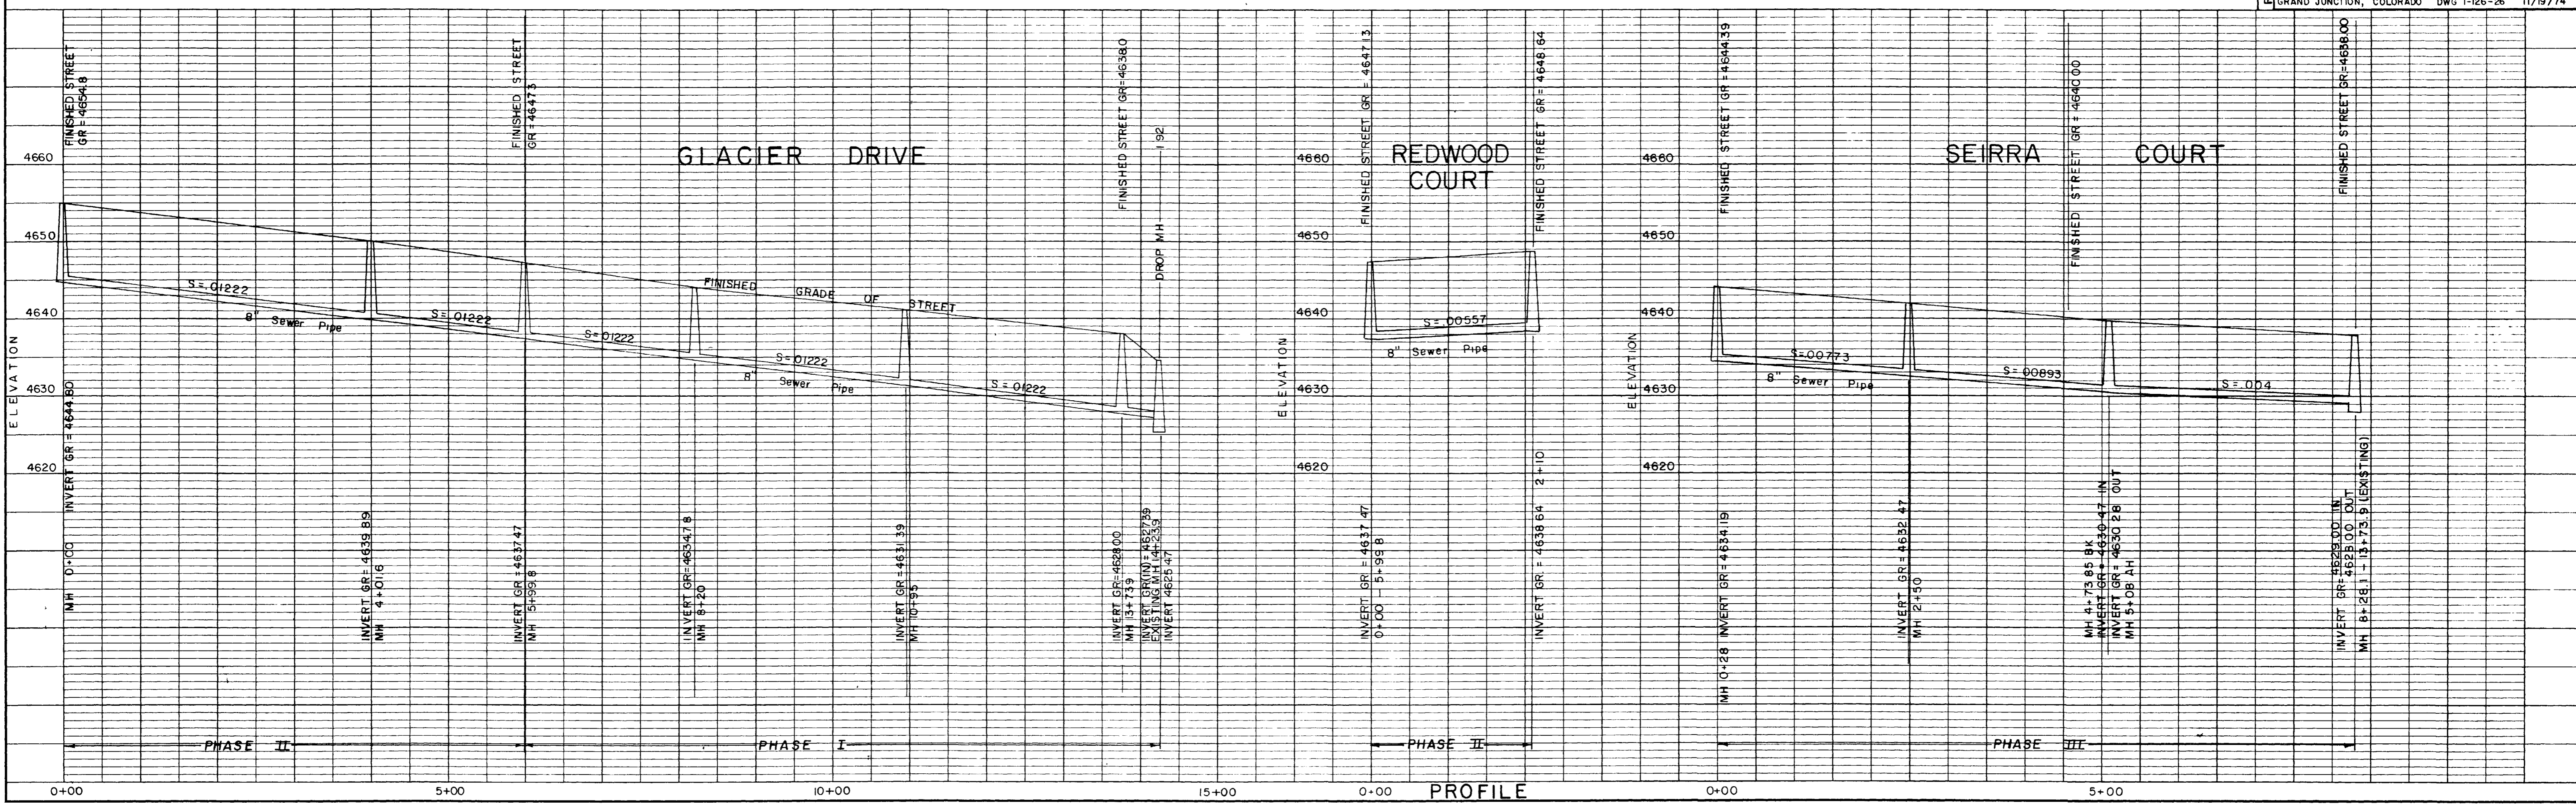

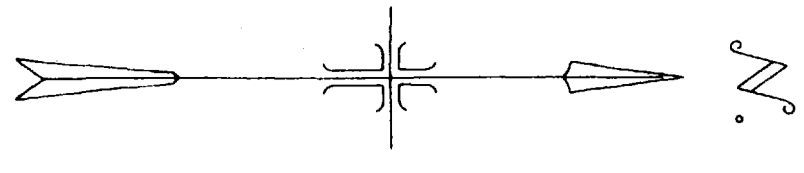

DATE	
BY	
SURVEYED	
PLOTTED	
ALIGNMENT CHECKED	
NOTE BOOK	
NO. OF MH CHECKED	
NO.	

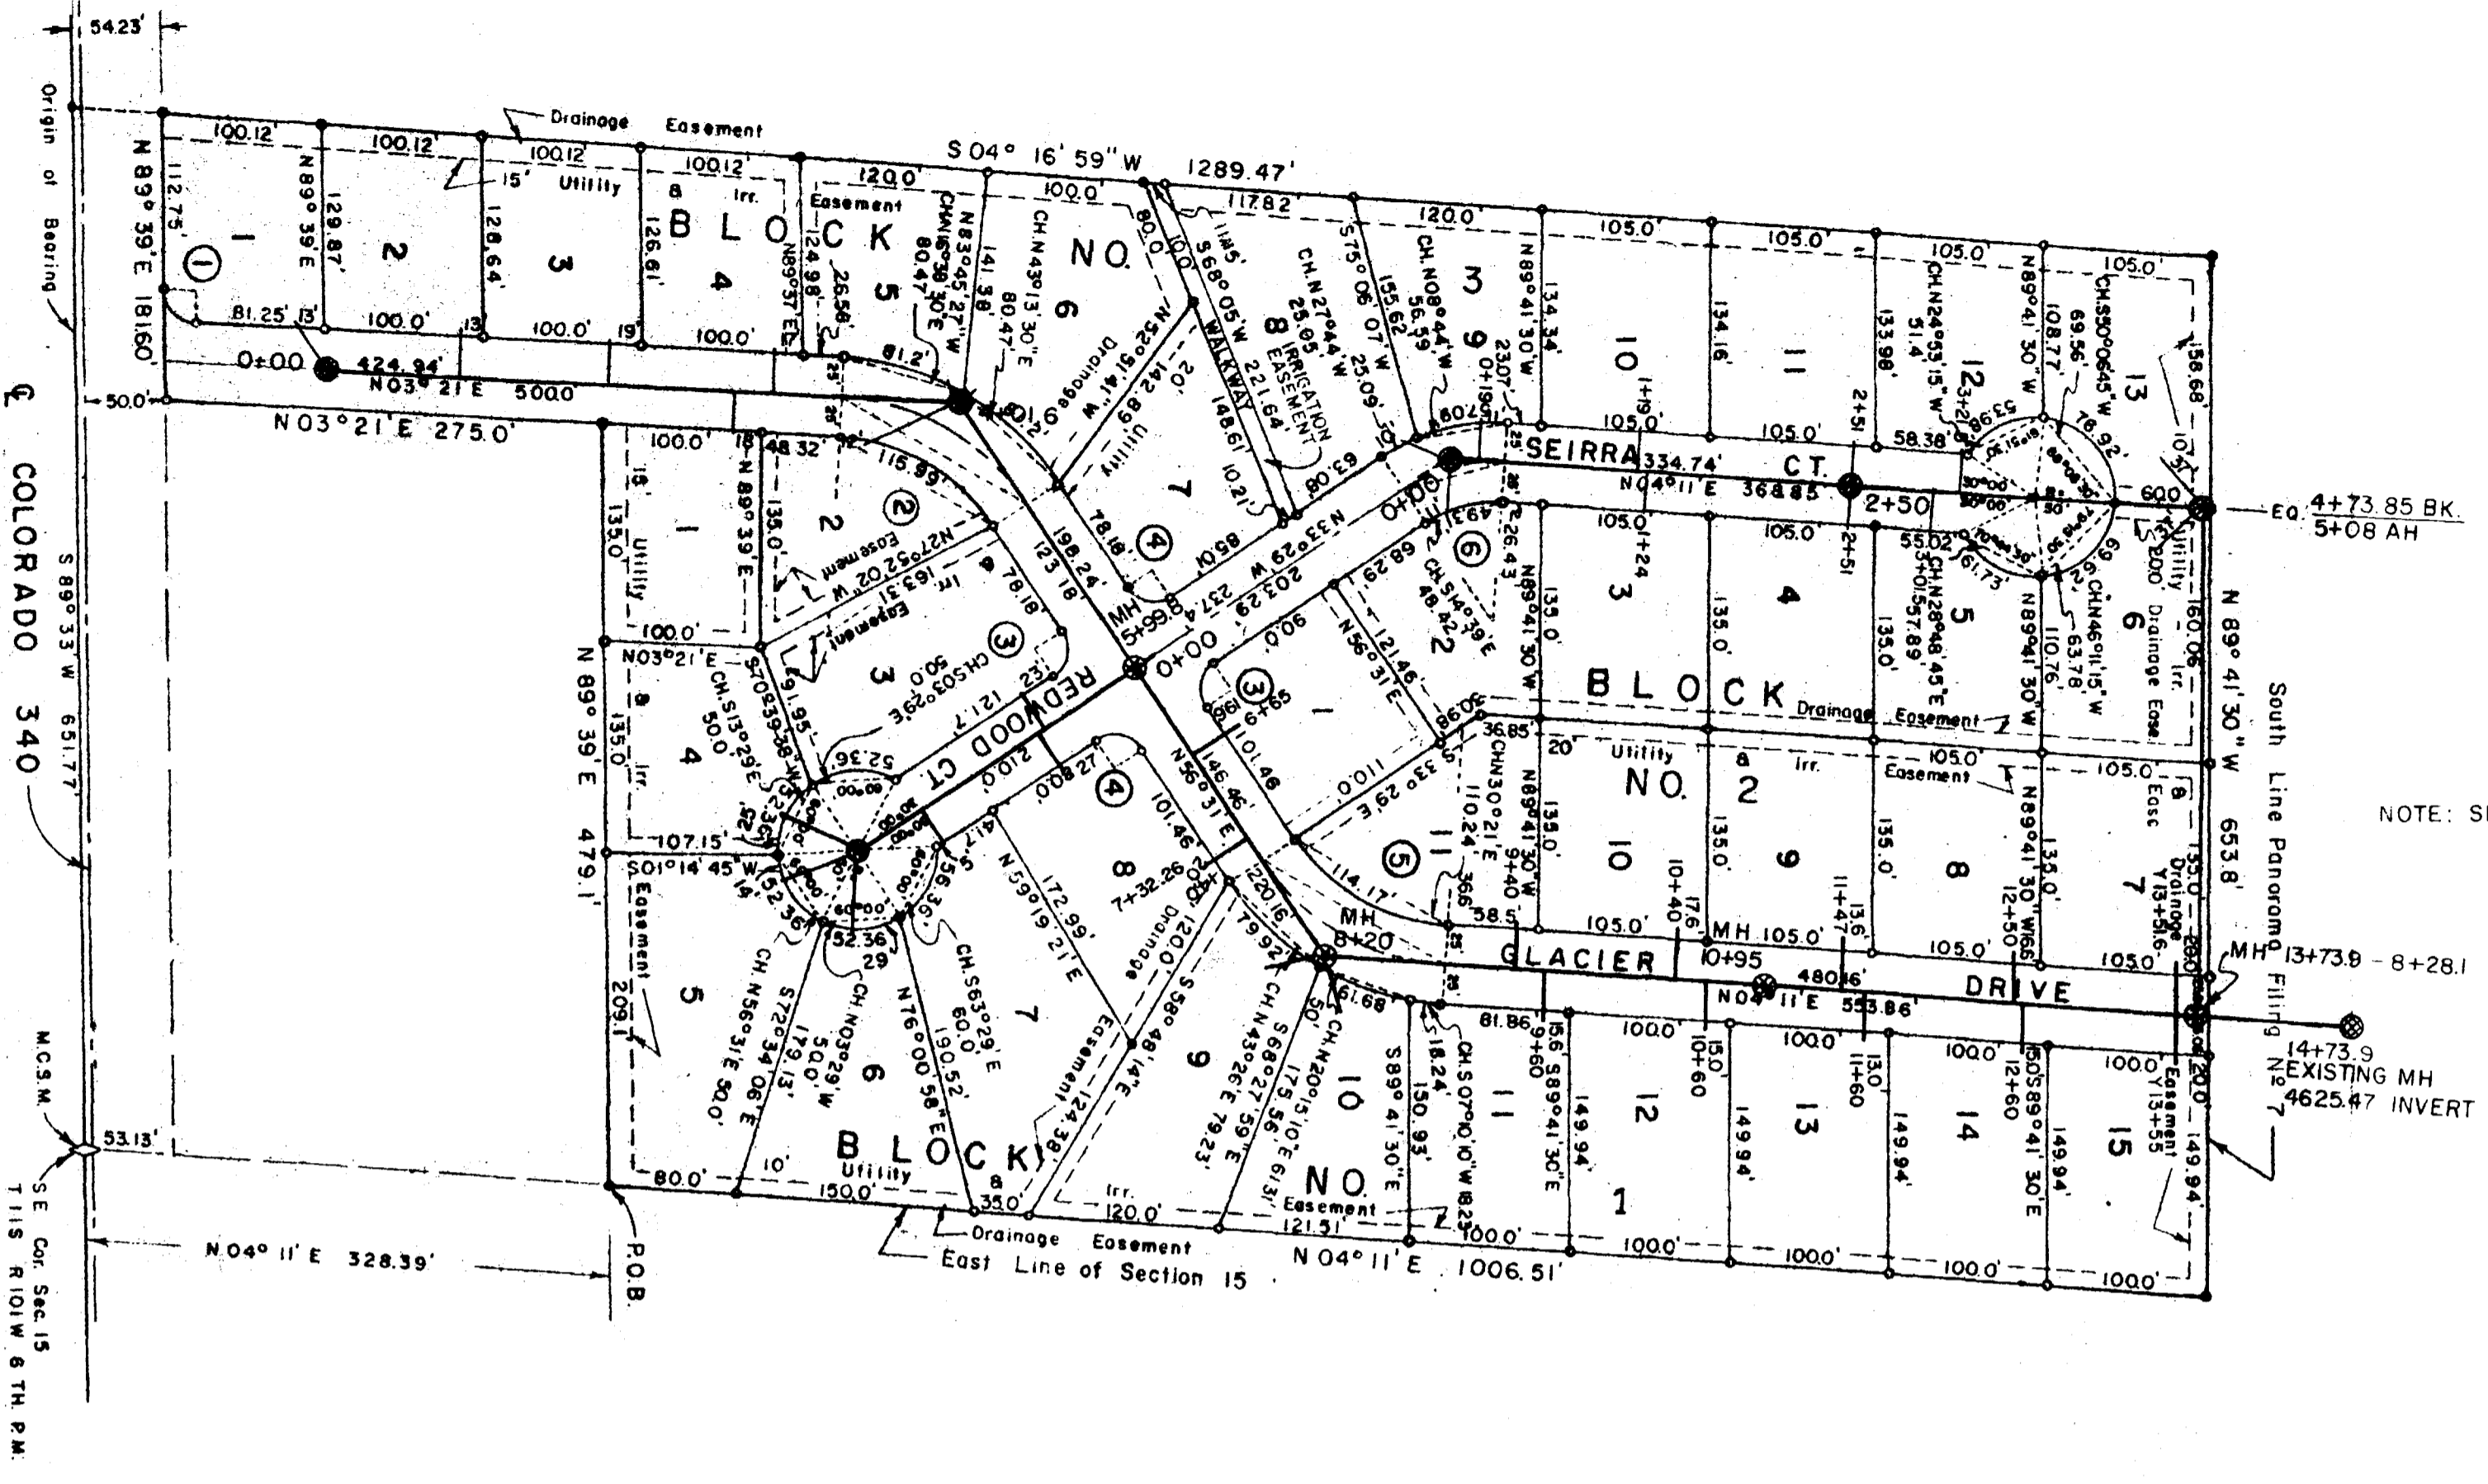

WESTERN ENGINEERS, INC.
AS BUILT
SEWER
PLAN AND PROFILE
MESA COUNTY, COLORADO
ENGINEER: C.E.B. DRAWN: B.L.S. CHECKED: S.P.B.
GRAND JUNCTION, COLORADO DWG 1-126-26 11/19/74

DATE	
BY	
SURVEYED	
PLOTTED	
GRADES CHECKED	
STRUCTURE NOTATIONS CH'KD	
NO.	

