
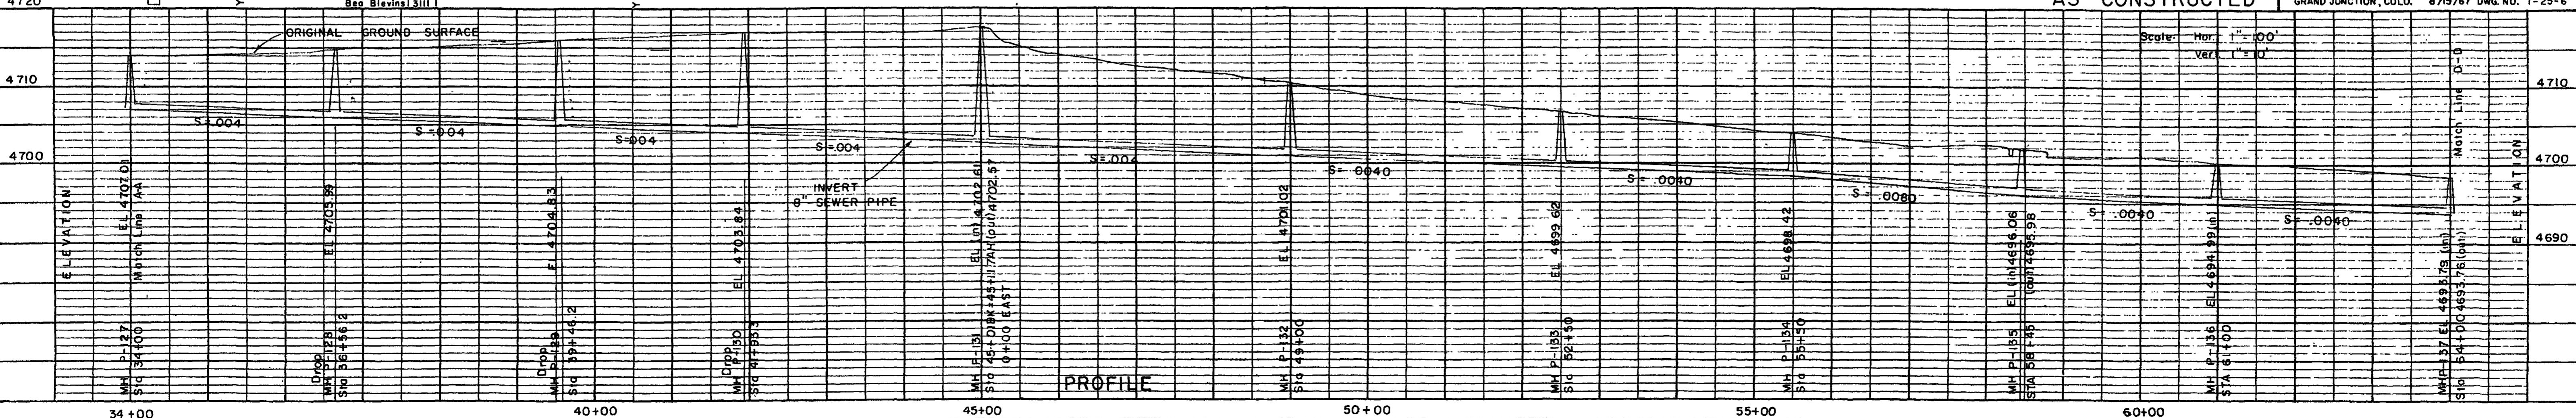
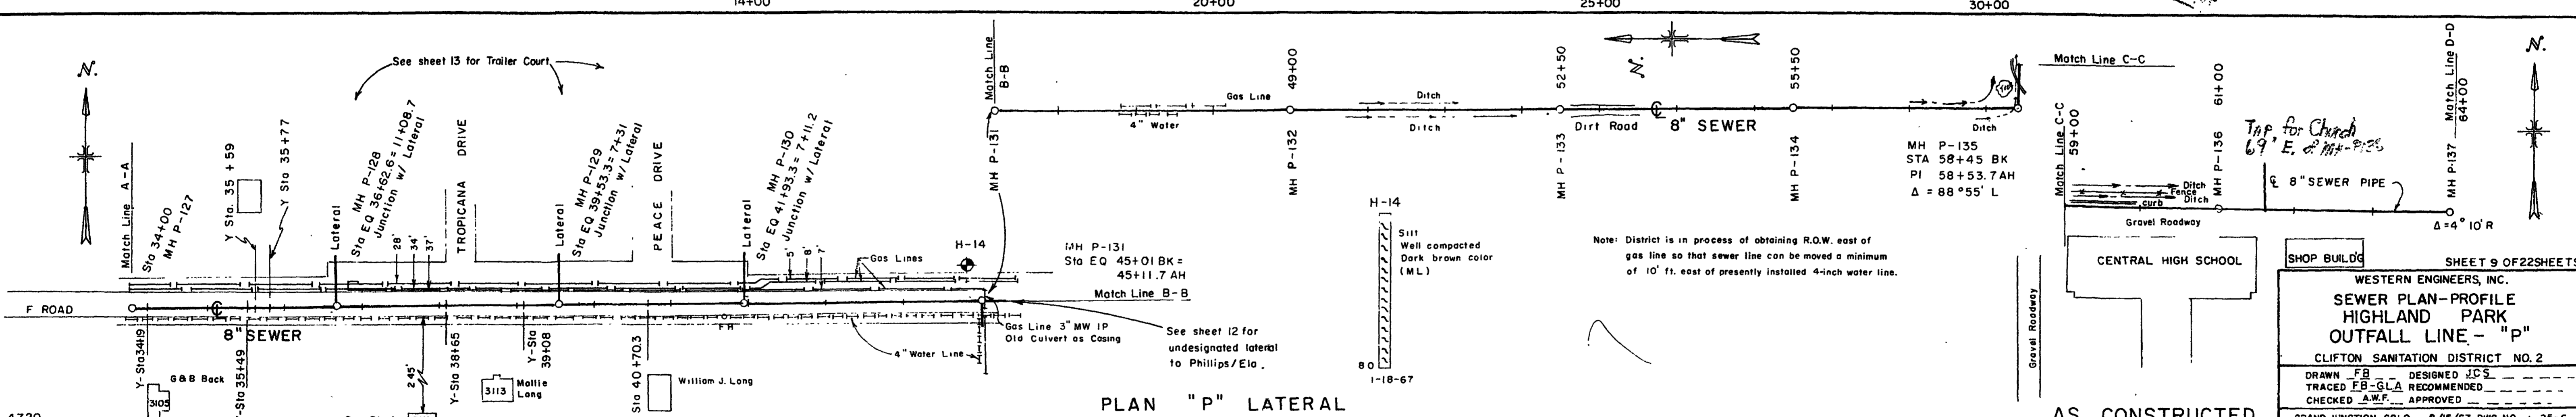
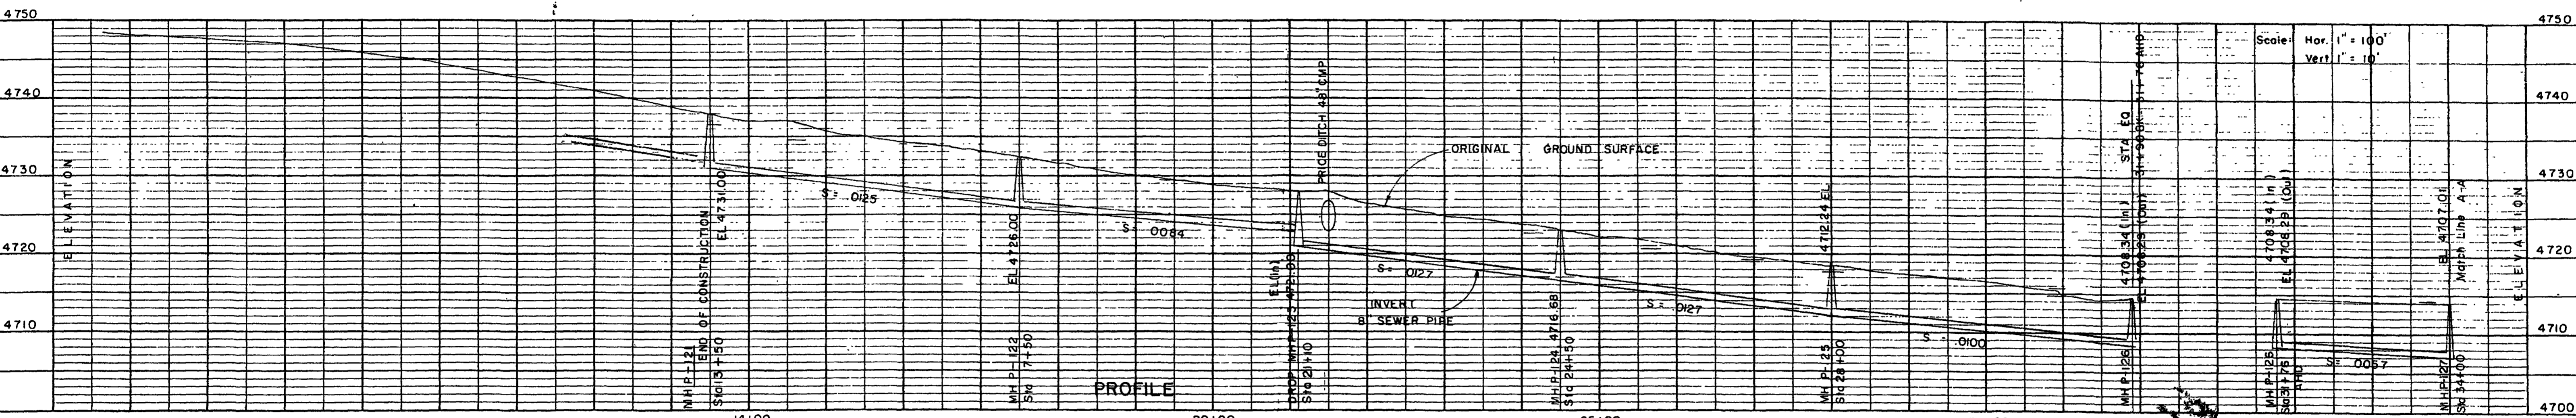


TAP for Church
69' East of
M.H. P. 136

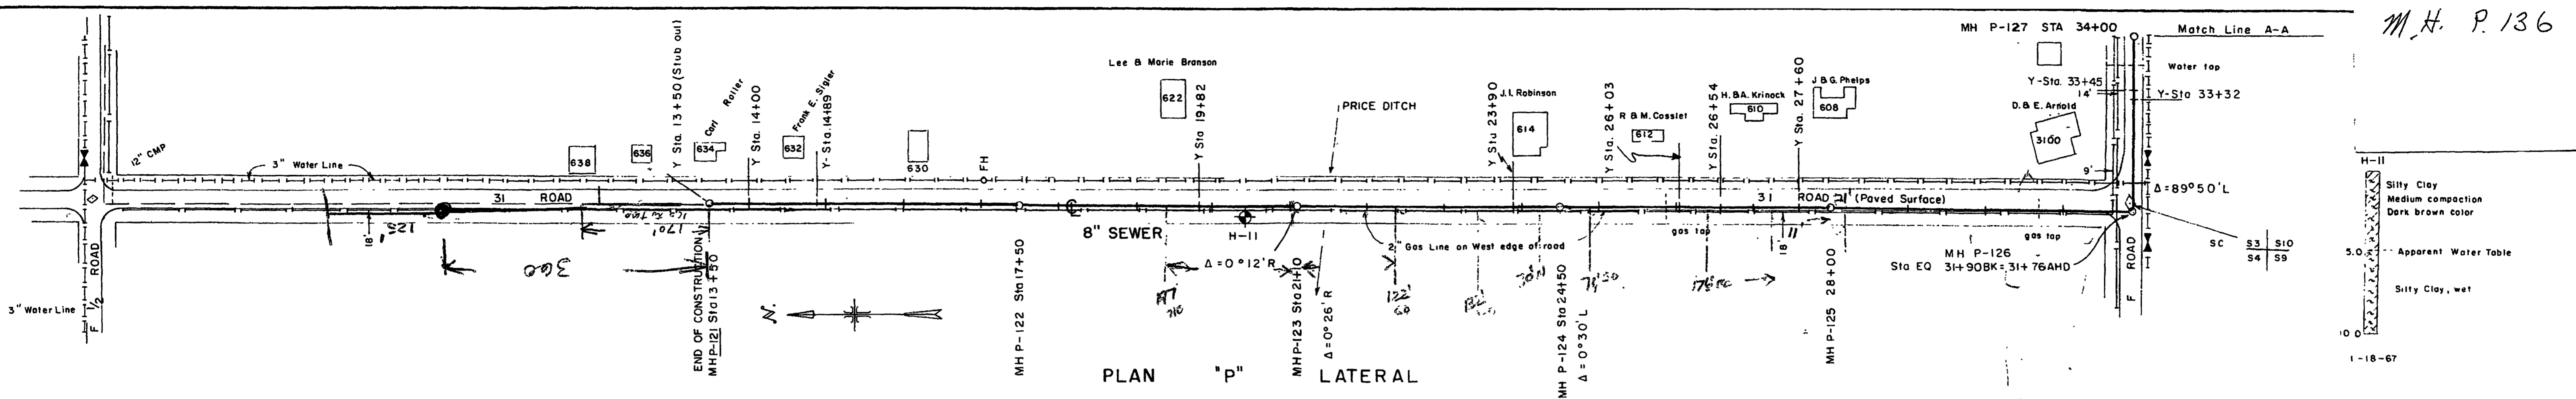

AS CONSTRUCTED

WESTERN ENGINEERS, INC.
SEWER PLAN-PROFILE
HIGHLAND PARK
OUTFALL LINE - "P"

CLIFTON SANITATION DISTRICT NO. 2
DRAWN FB DESIGNED JCS
TRACED FB-GLA RECOMMENDED
CHECKED A.W.F. APPROVED

GRAND JUNCTION, COLO. 8/15/67 DWG. NO. 1-25-6