

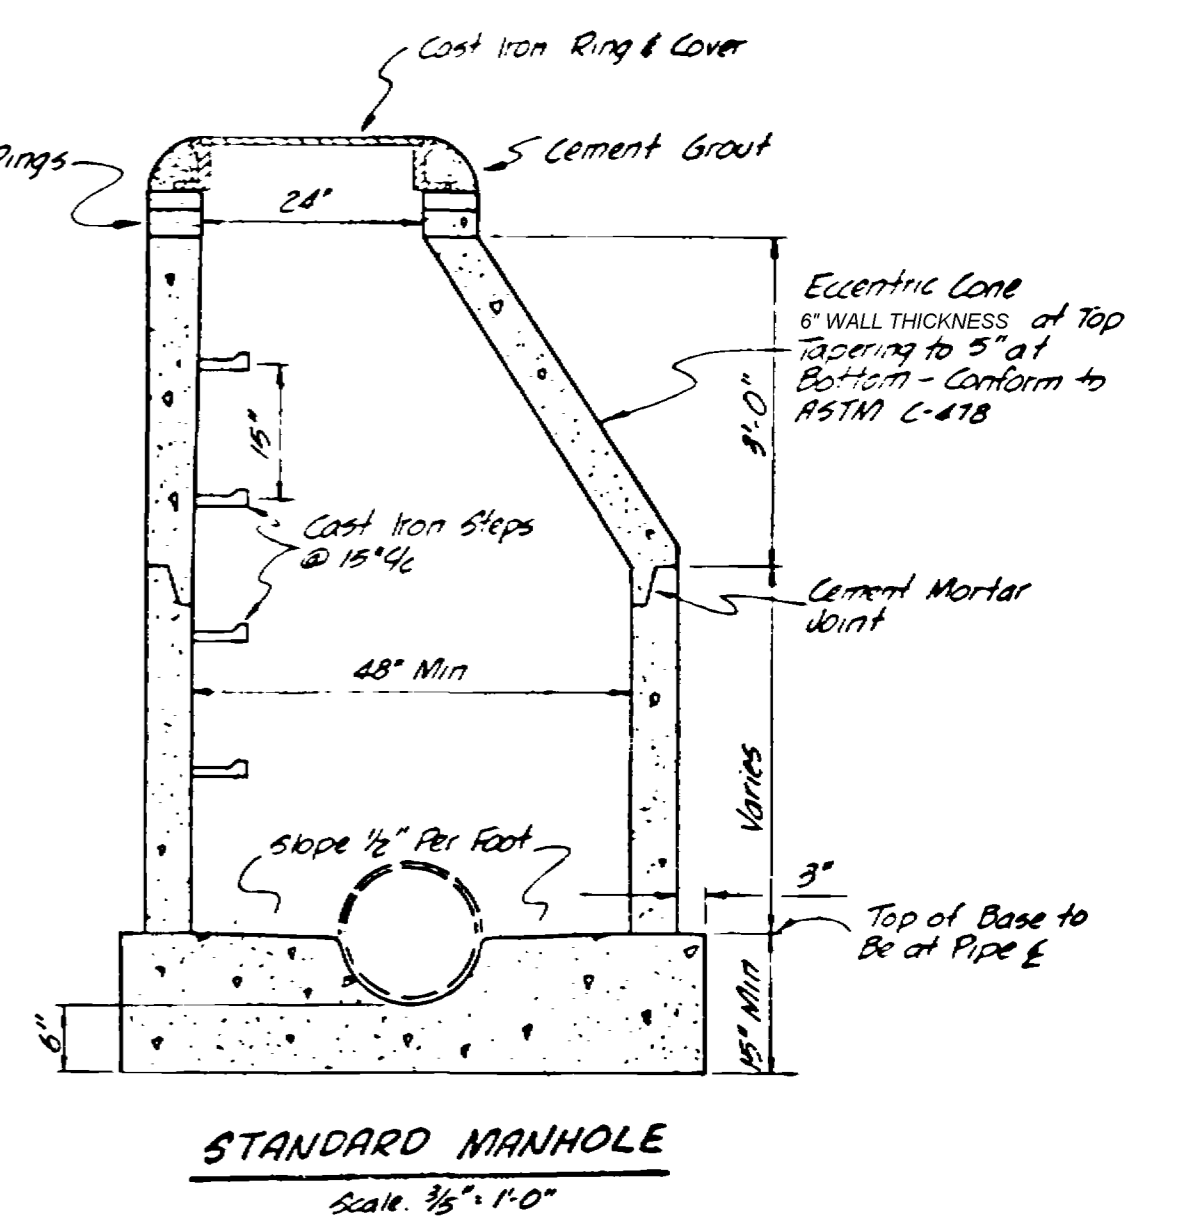
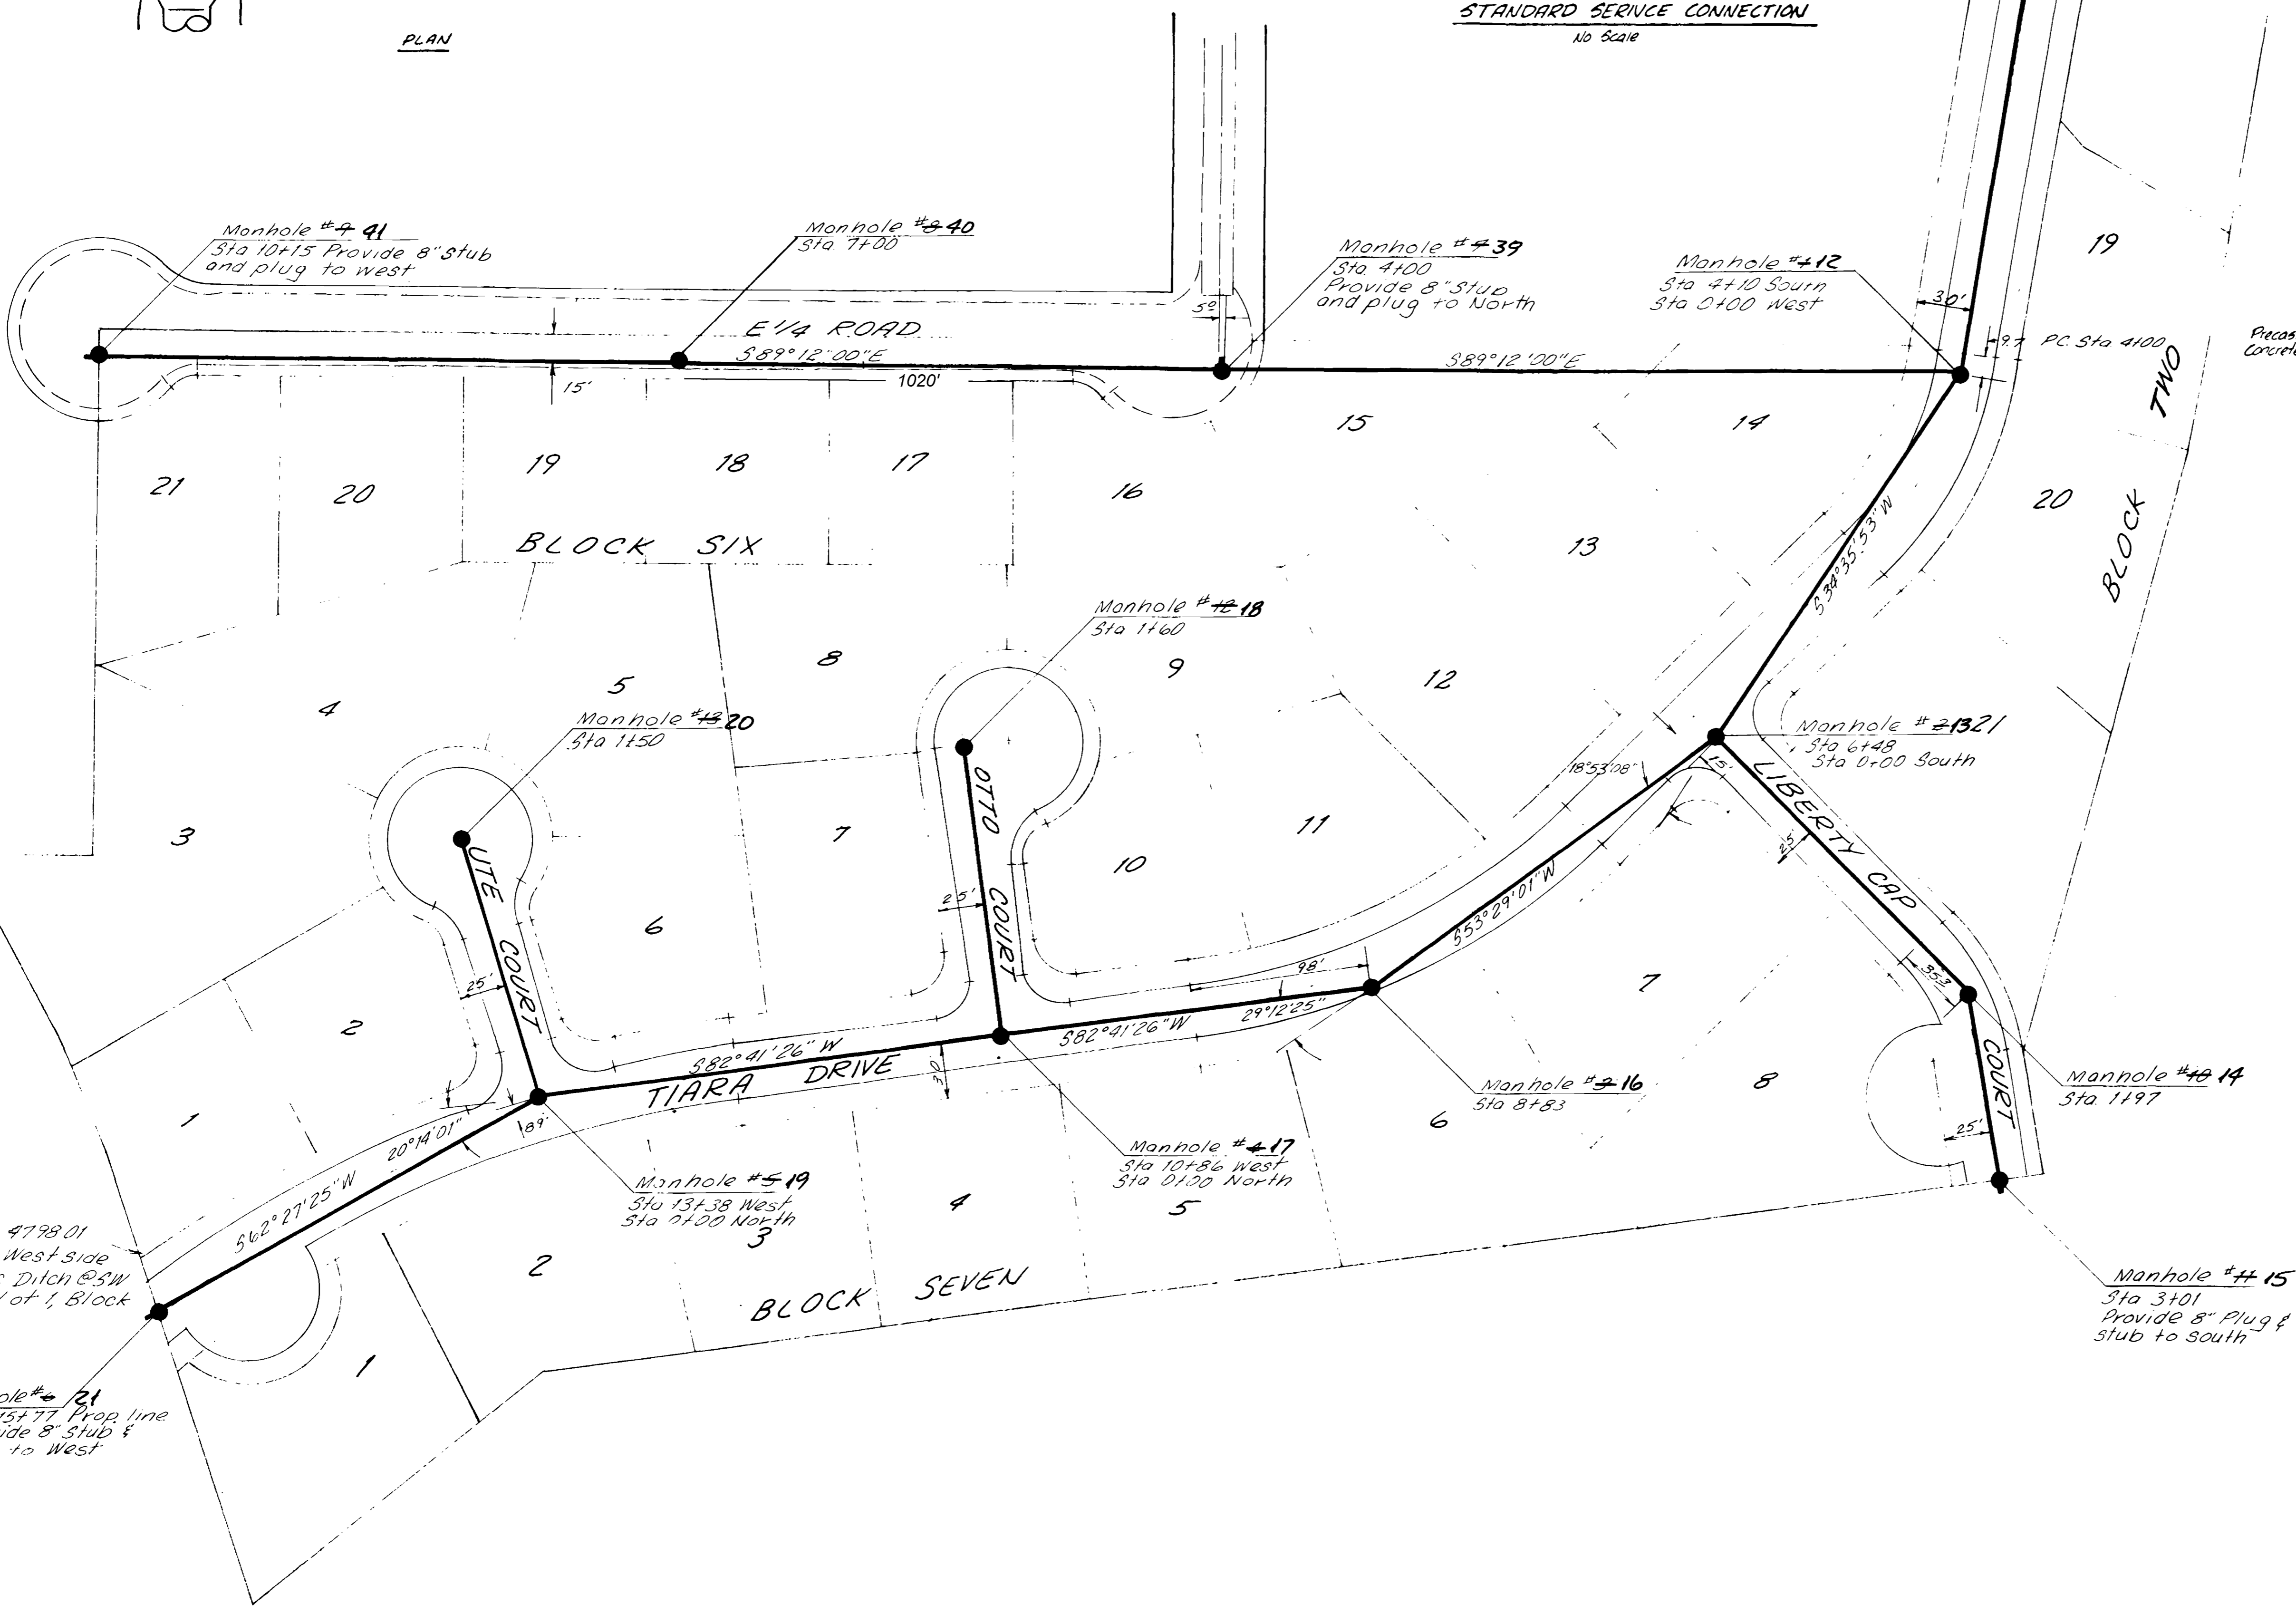


Bench Mark
Brass Cap
NE Cor. SW 1/4
Sec. 22
Elev. 4717.69

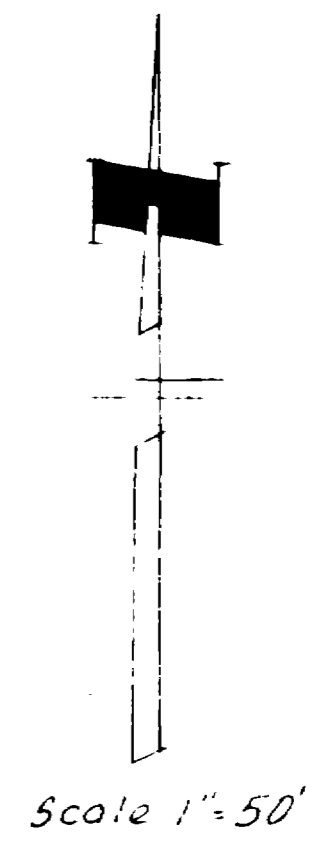

ROBERT P. GERLOFS
 DATE: MARCH 16
 SCALE: AS SHOWN
 SANITARY SEWER PLAN
 TIARA RADO SUBDIVISION
 FILING NO. TWO
 MESA COUNTY, COLORADO
 SHEET
 1
 OF 2

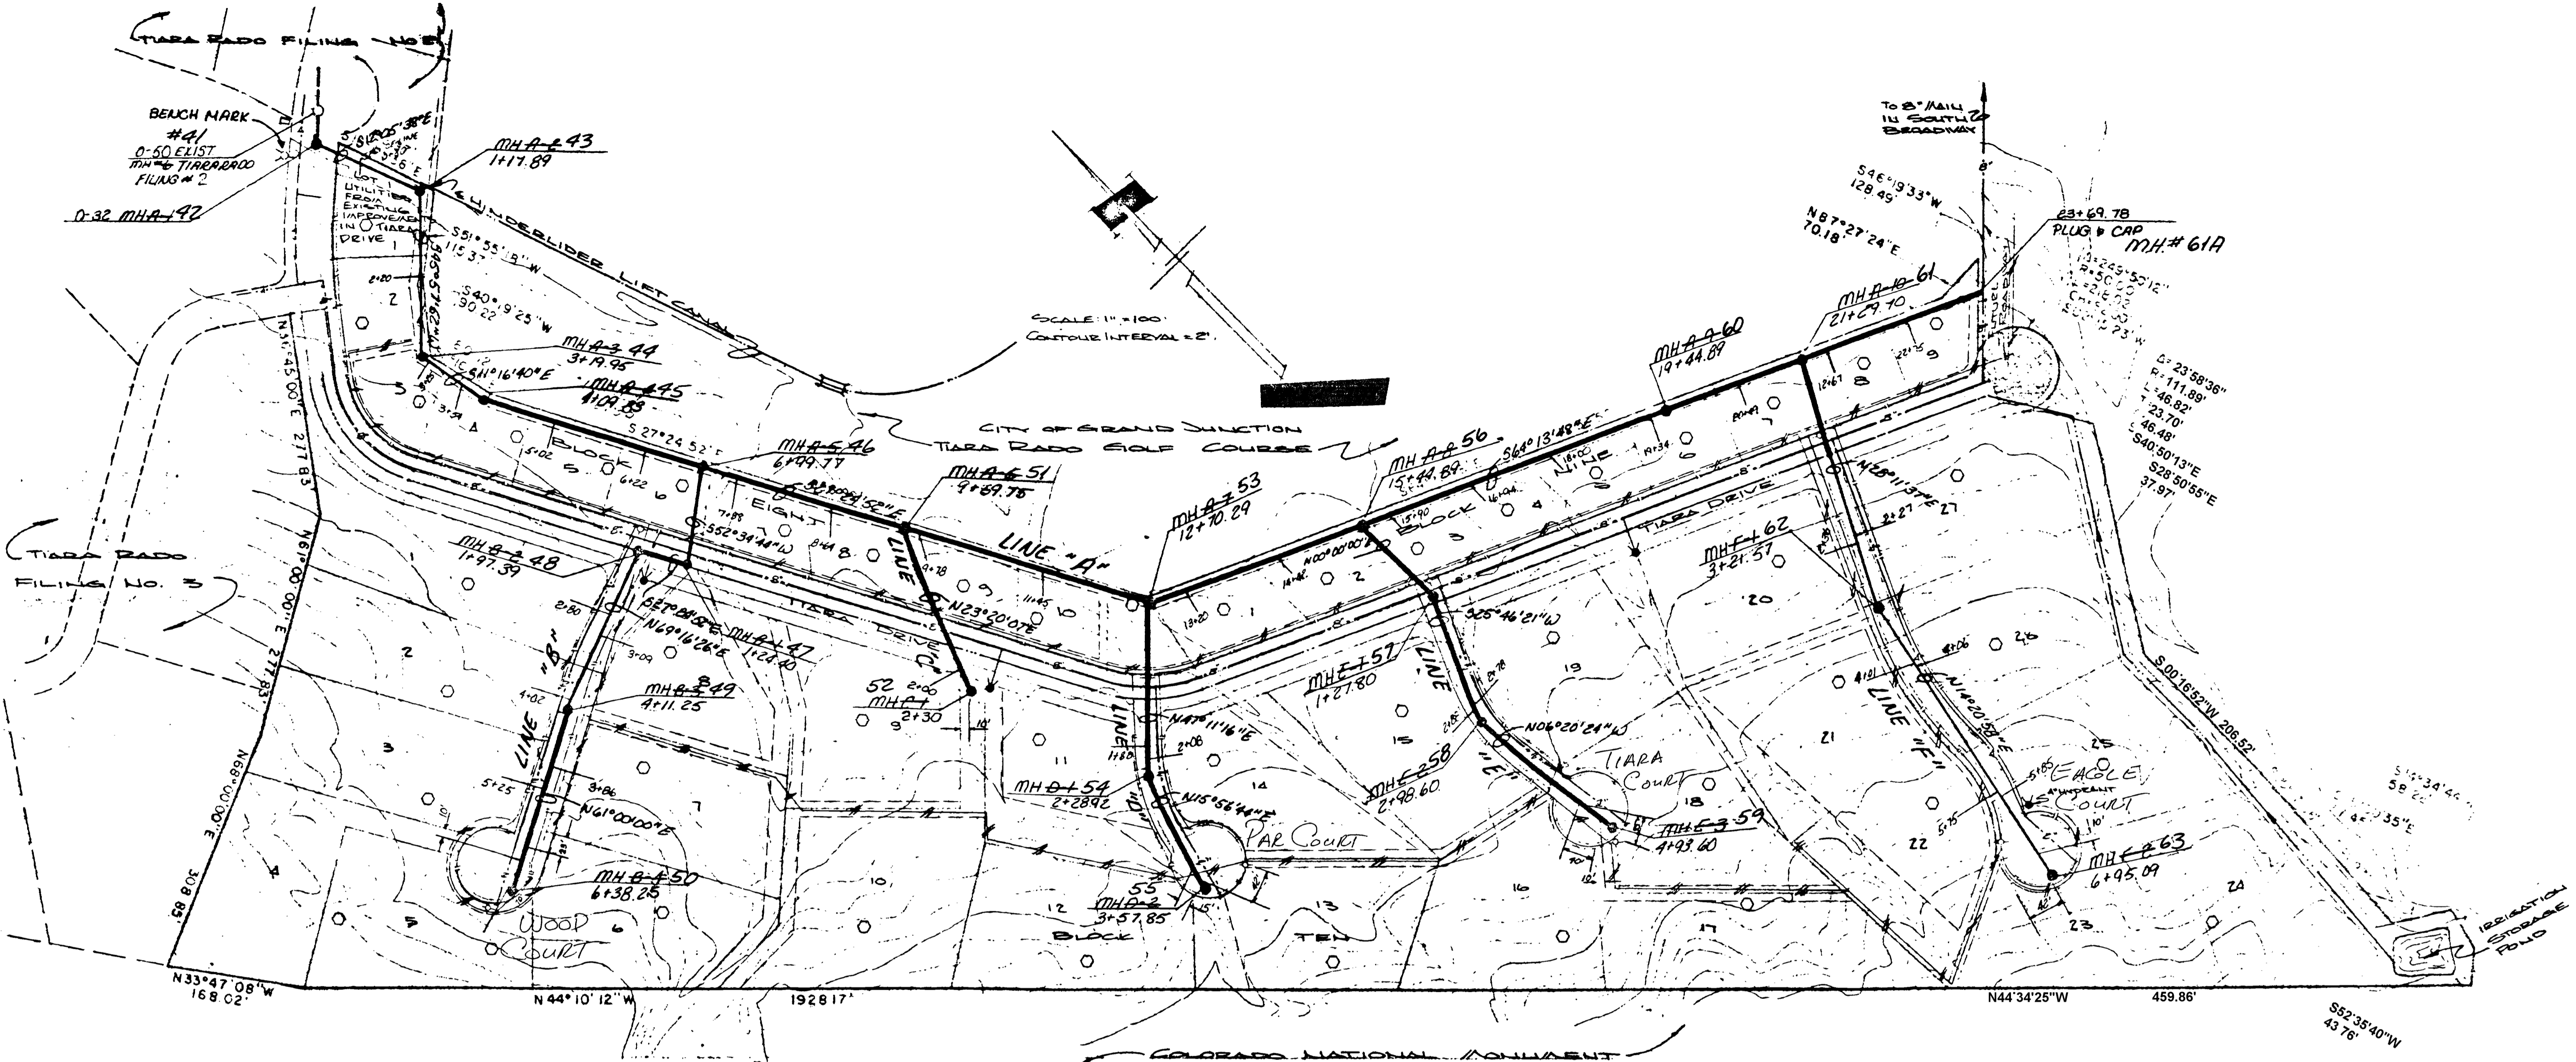

NOTES
 1. B.M. 4798 01 27 IN WEST SIDE CONC. DITCH @ S.W. COR. LOT 1, BLOCK SIX, FILING NO. TWO.
 2. ALL CONSTRUCTION TO BE DONE IN ACCORDANCE WITH CITY OF GRAND JUNCTION STANDARD SPECIFICATIONS.

SANITARY SEWER QUANTITIES
 22 STANDARD MANHOLES
 4784 L.F. 8" SANITARY SEWER LINE
 46 SERVICE CONNECTIONS