
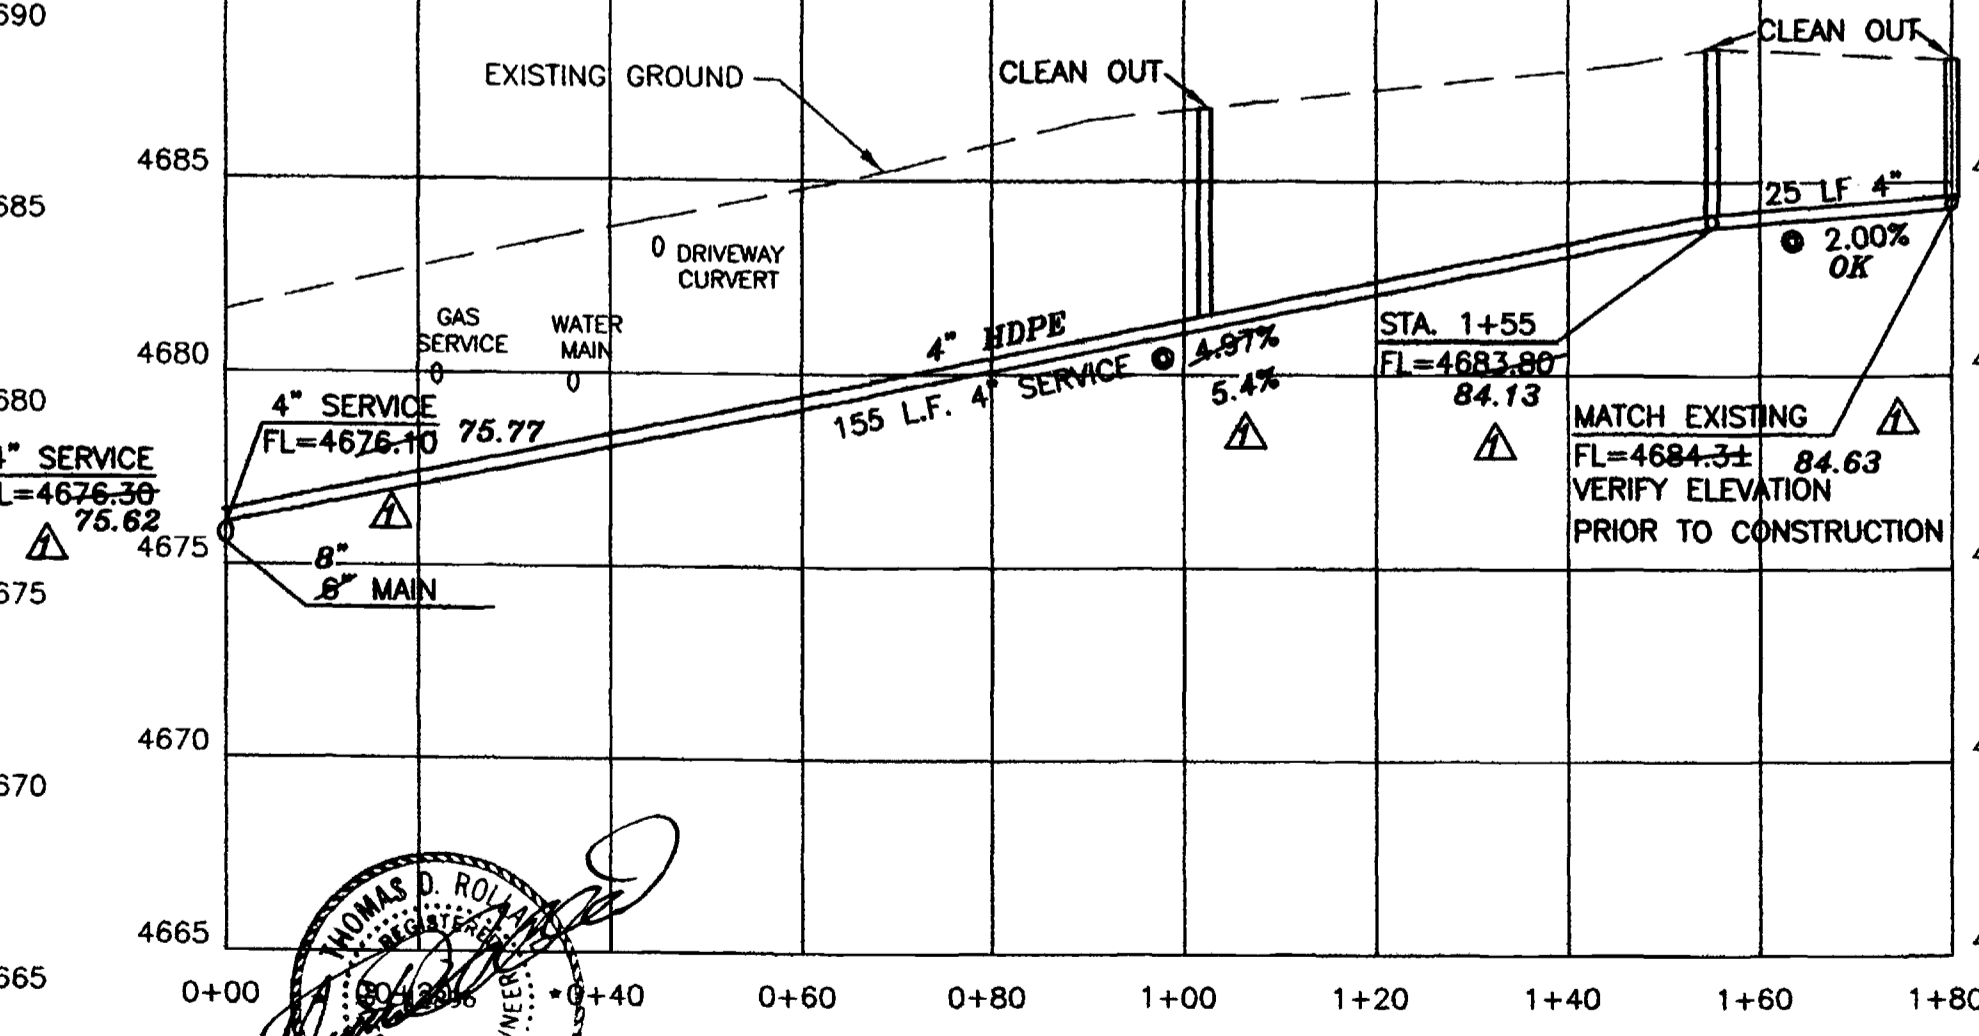
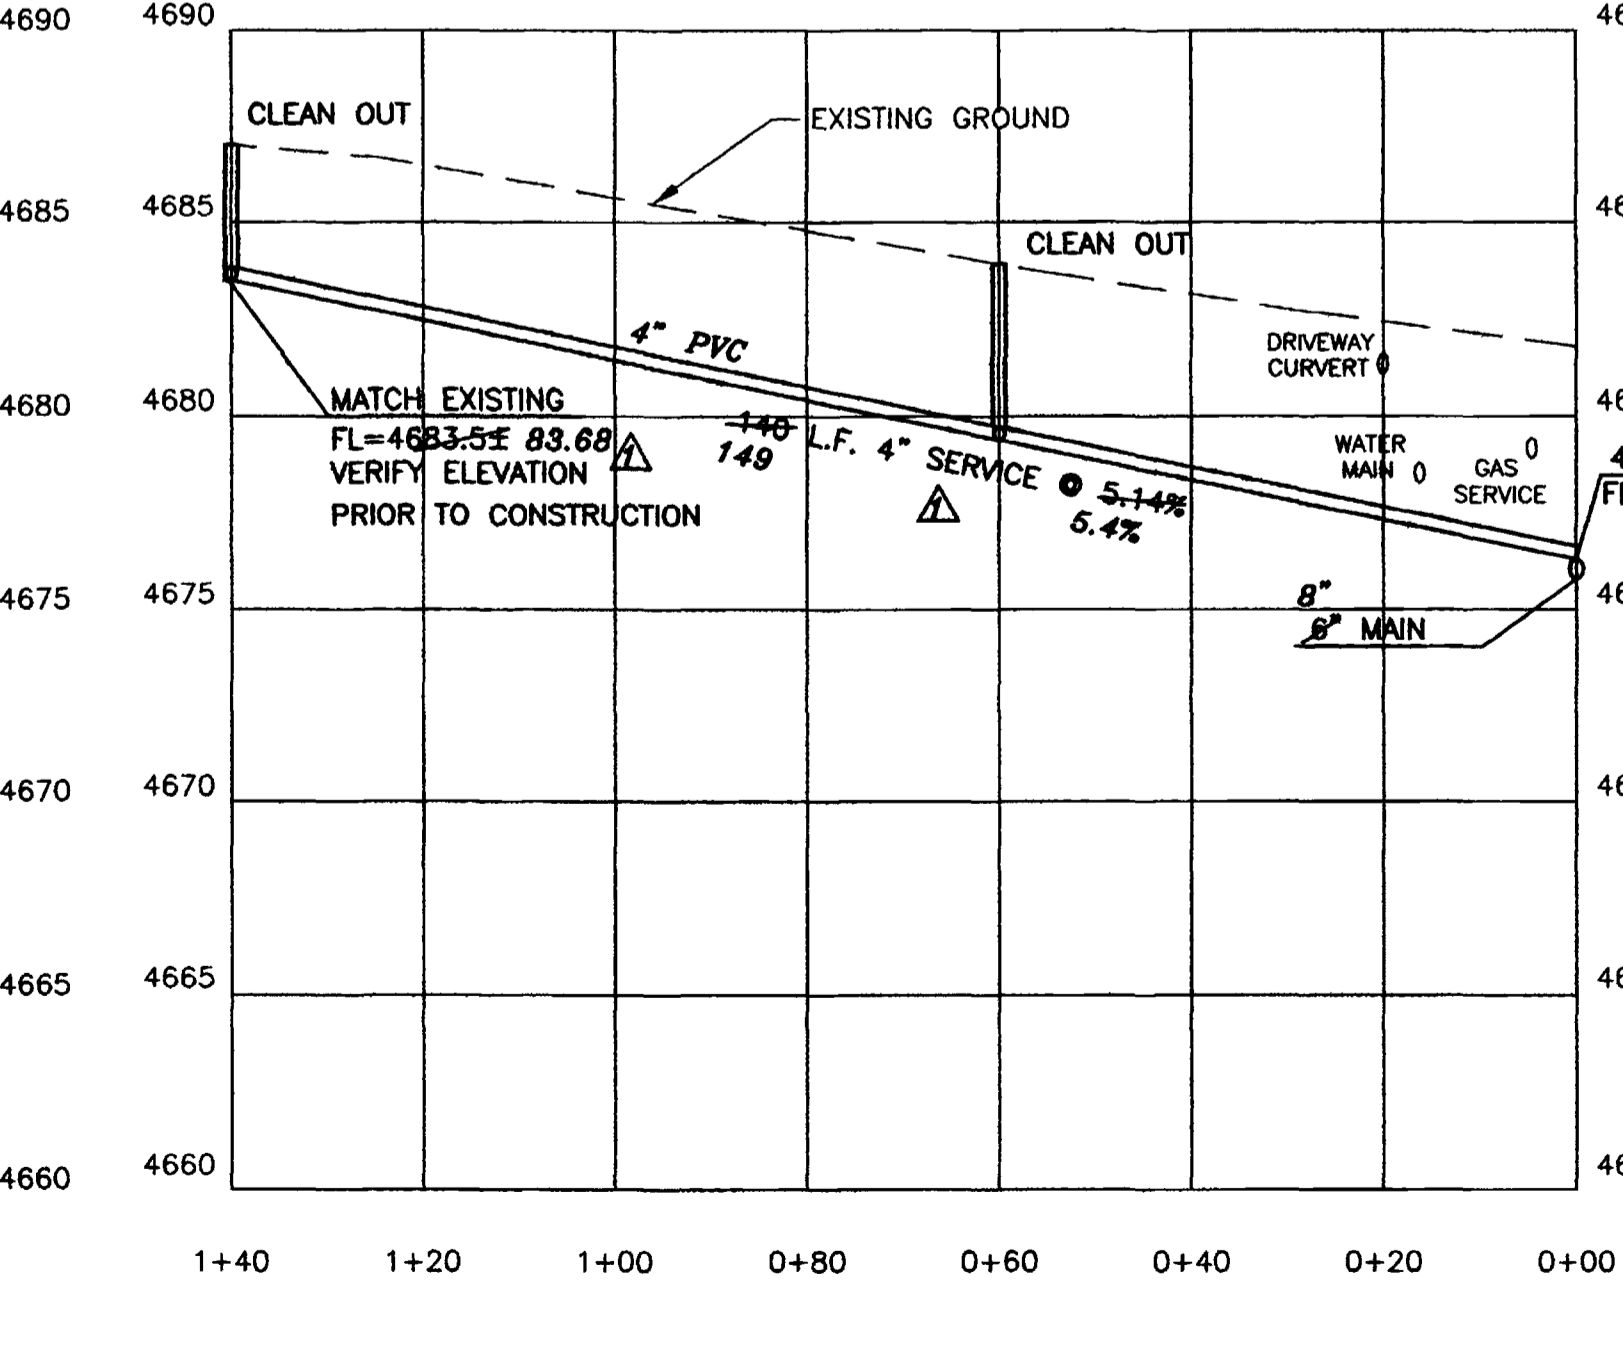


6" SEWER MAIN ROUNDHILL DRIVE

HANNA SERVICE

KLAUZER SERVICE

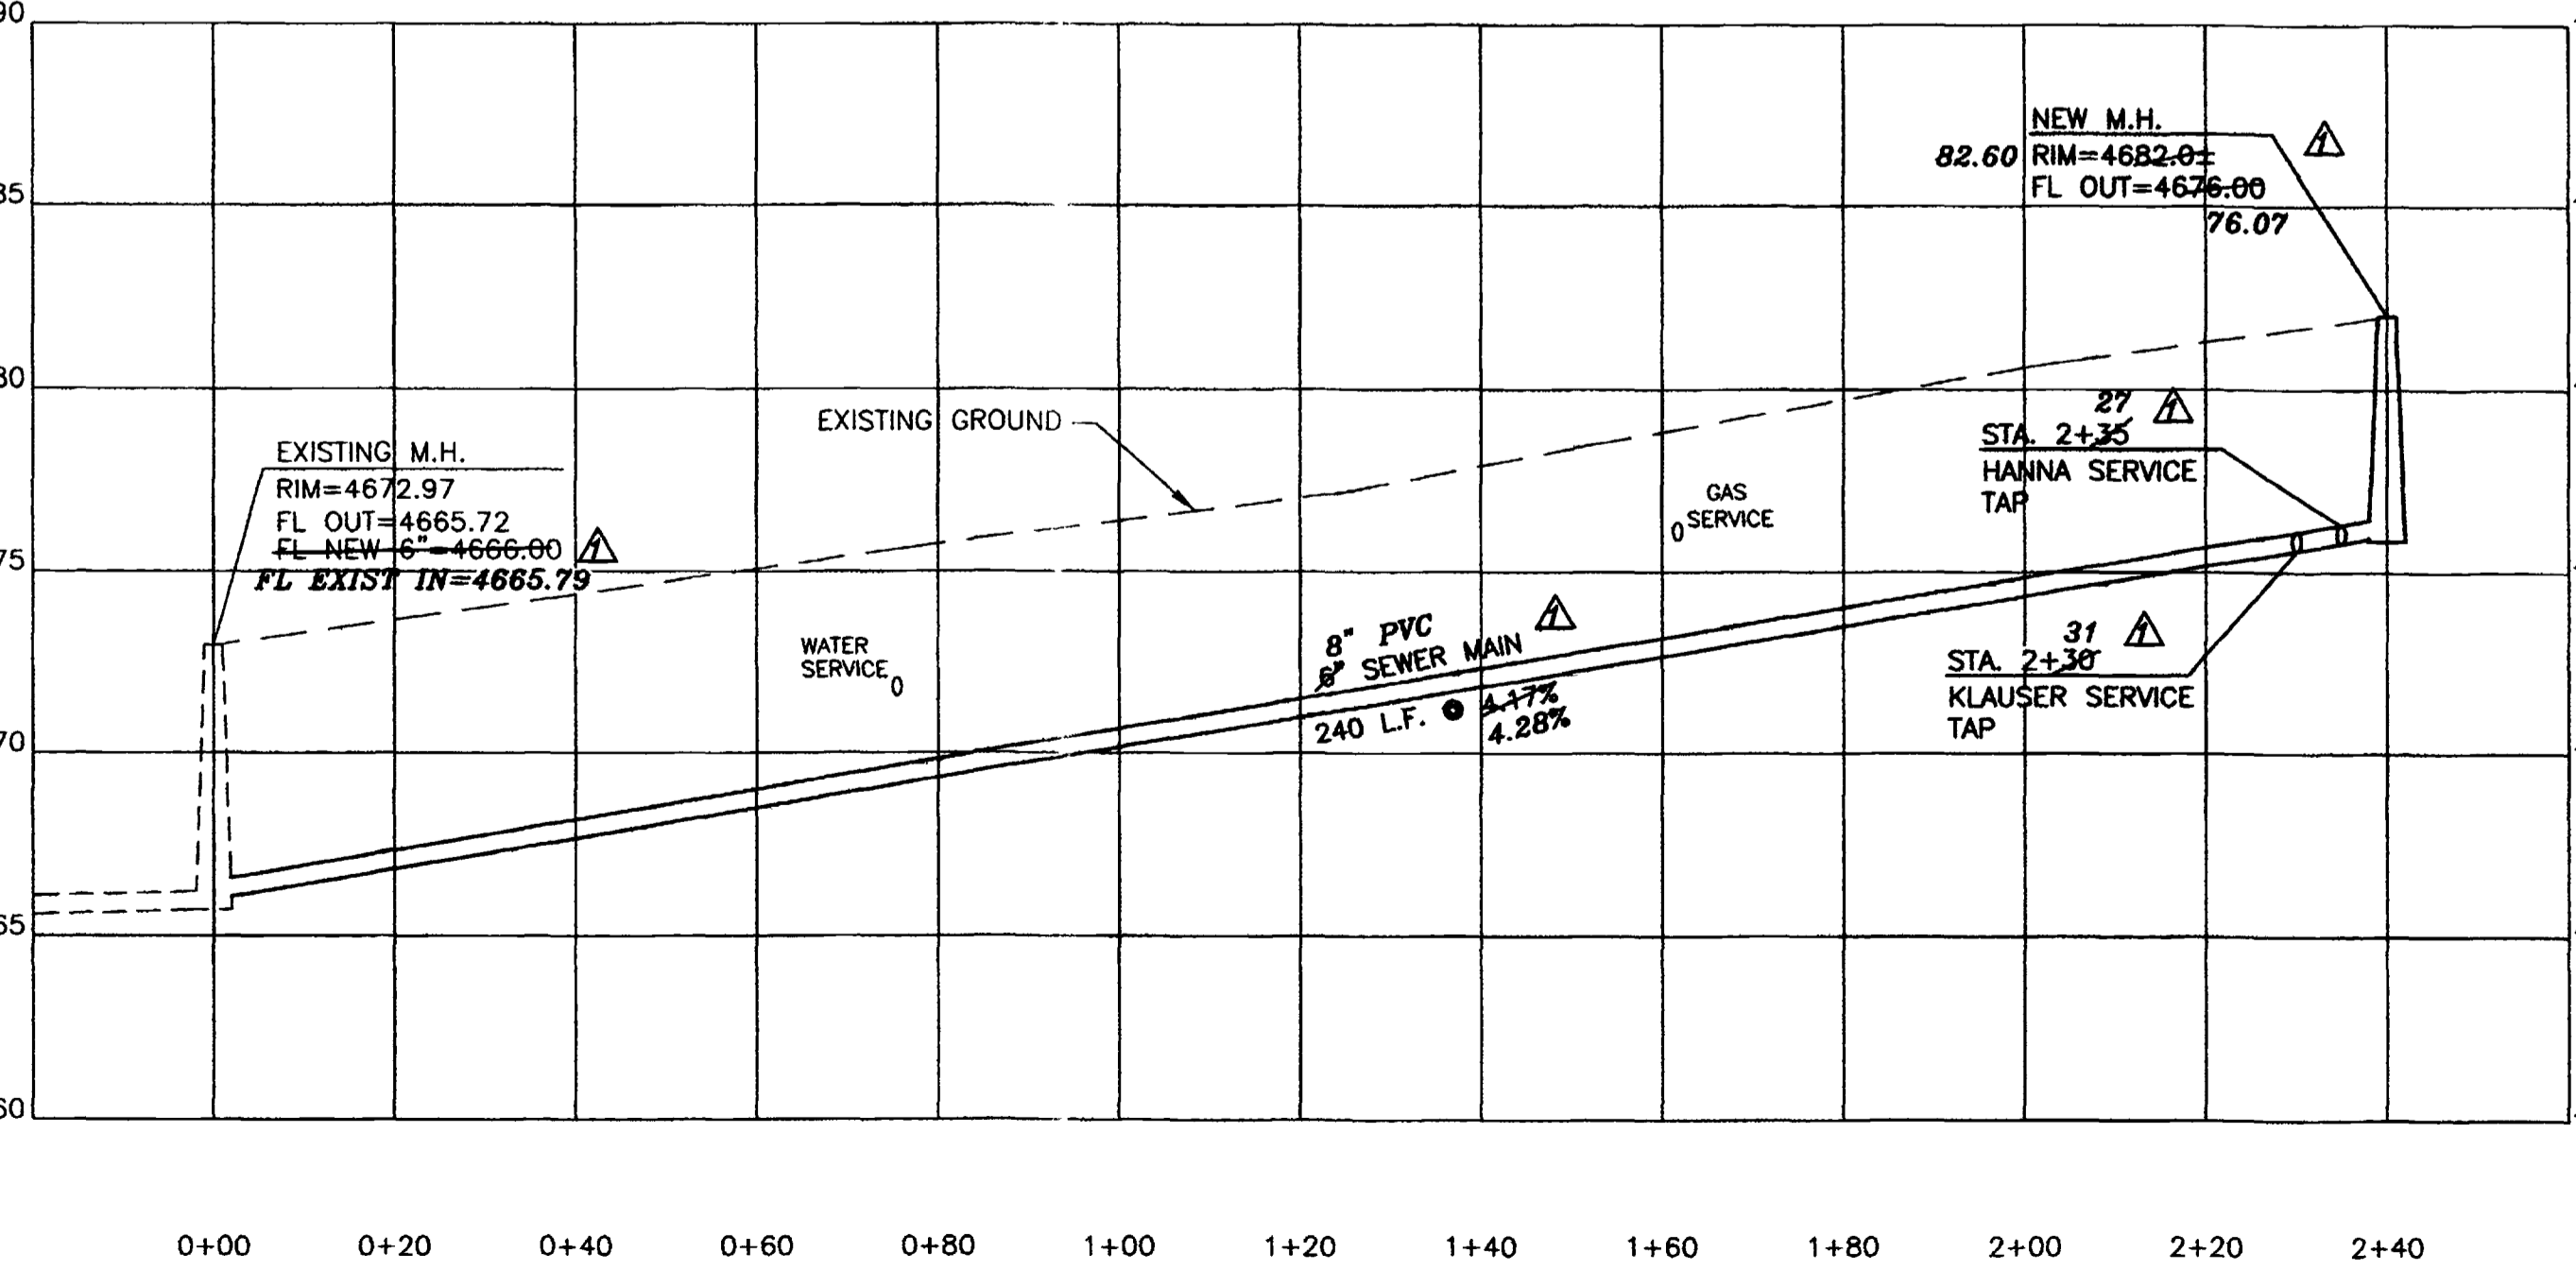


APPROVED FOR CONSTRUCTION
 CITY UTILITY ENGINEER
 DATE

ACCEPTED AS CONSTRUCTED
 CITY UTILITY ENGINEER
 DATE

AS-BUILTS

HORIZONTAL 1"=20'
 VERTICAL 1"=5'

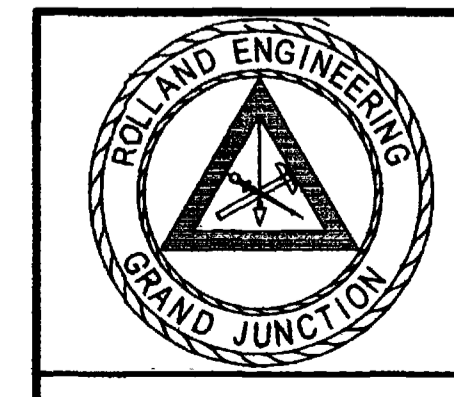

11/12/02 AS-BUILTS		LC
File Name: D:\2081\2081PP.DWG		
HANNA / KLAUZER SEWER EXTENSION		
Designed TDR	Checked TDR	Proj# 2081
Drawn LC	Date 10/14/02	Rev. 2
		Sheet 2