


BENCHMARK
 BONNET BOLT ON TOP FLANGE OF HYDRANT
 LOCATED AT EAST END OF WEST RIDGES BLVD.
 ELEVATION=4846.31
 NOTE: FOR HORIZONTAL CONTROL, SEE PLAT
 OF REDLANDS MESA FILING 1.

NOTE:
 WATER SERVICE STATION AND OFFSET LOCATIONS
 ARE SHOWN ON THE WATER PLAN/UTILITY
 COMPOSITE.

REVISED TO AS-BUILT
 CONDITIONS
 10/08/01

NOTE:
 SEWER SERVICE AS-BUILT LOCATIONS ARE BASED
 UPON SANITARY SEWER STATIONING, NOT STREET
 CENTERLINE STATIONING. AS-BUILT SEWER SERVICE
 ELEVATIONS SHOWN ARE TO TOP OF 4" PIPE.

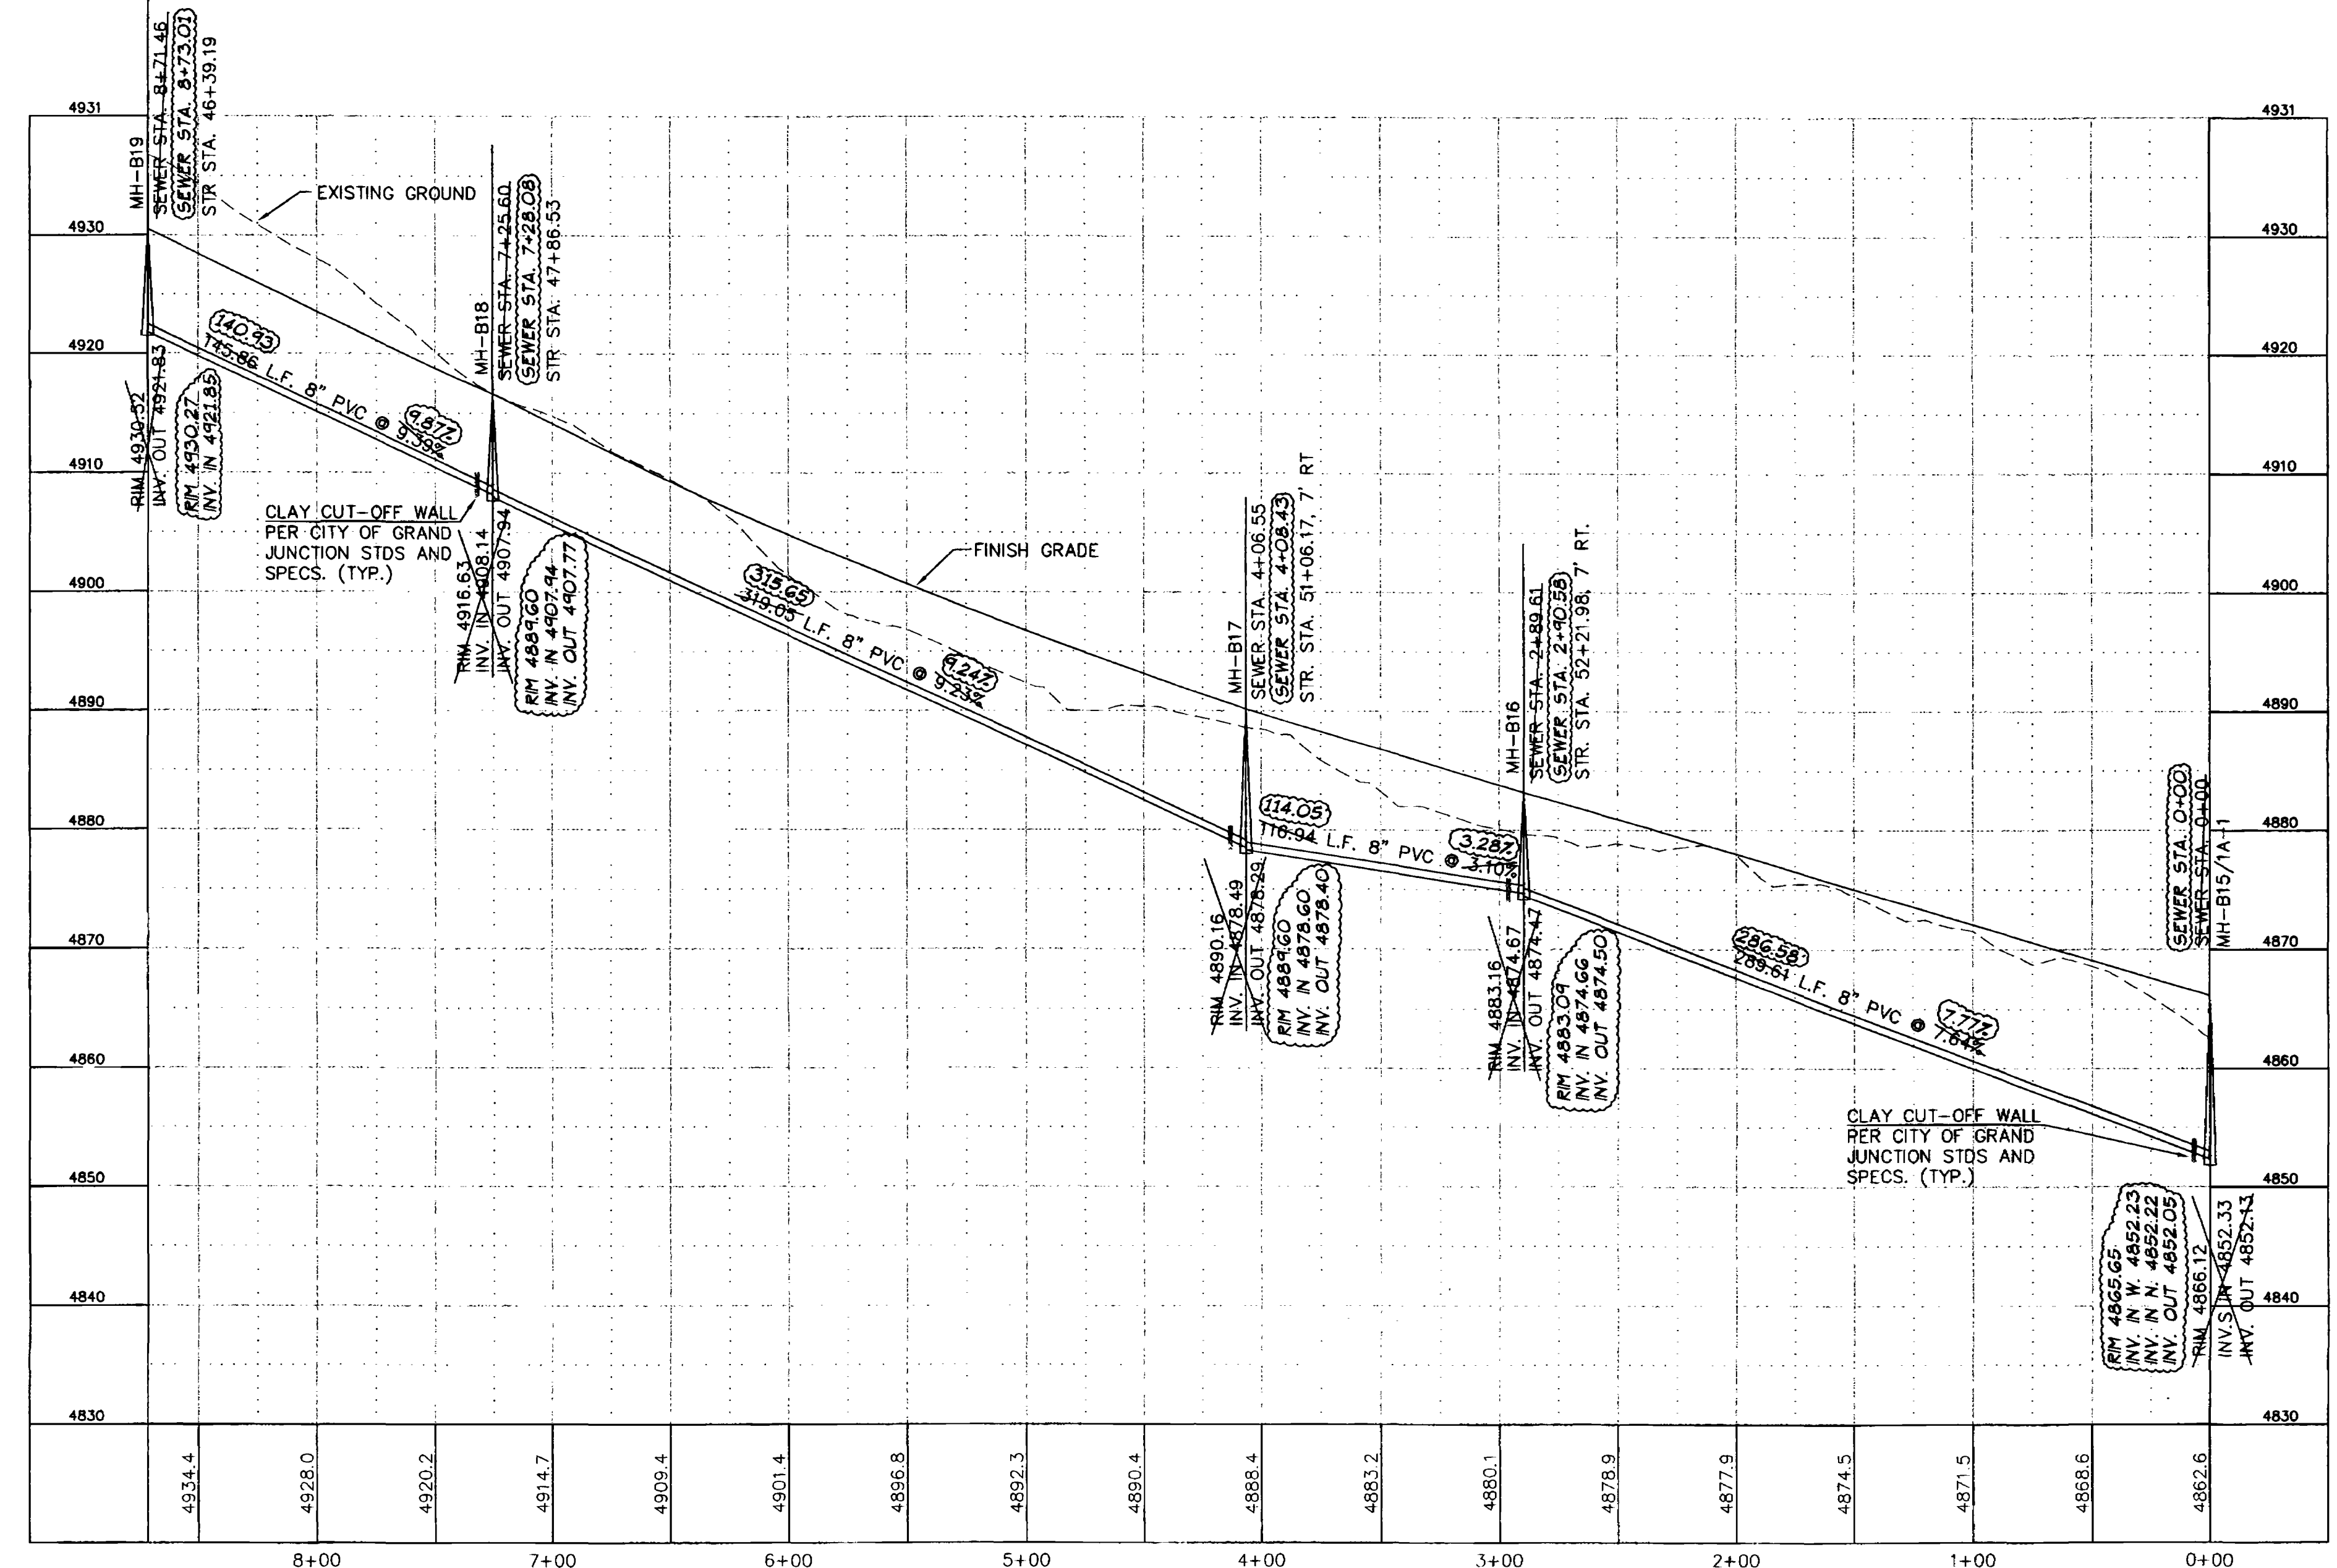

REVISION	DATE	DESCRIPTION
1	10/04/01	REVISE TO AS-BUILT CONDITIONS
2	11/27/01	REVISE TO AS-BUILT REVIEW COMMENTS

REDLANDS MESA
 RMLLC
**SANITARY SEWER (LINE-B, FUTURE)
 PLAN AND PROFILE**

THOMPSON-LANGFORD CORP.
 ENGINEERS AND LAND SURVEYORS
 529 25 1/2 RD., SUITE B210
 GRAND JUNCTION, COLORADO
 PH. (970) 243-6067
 FAX (970) 241-2845
 tlc@tlcwest.com

DATE: _____
 DRAWN BY: MWT
 CHECKED BY: DAT

DATE: 2/26/01

SCALE:
 Horiz: 1" = 50'
 Vert: 1" = 10'

Project No:
 0356-008

SHEET NO:
 1 OF 1

APPROVED FOR CONSTRUCTION

FINAL ACCEPTANCE

