


2210 DAKOTA SEWER SERVICE
 HORIZONTAL SCALE: 1" = 20'
 VERTICAL SCALE: 1" = 5'

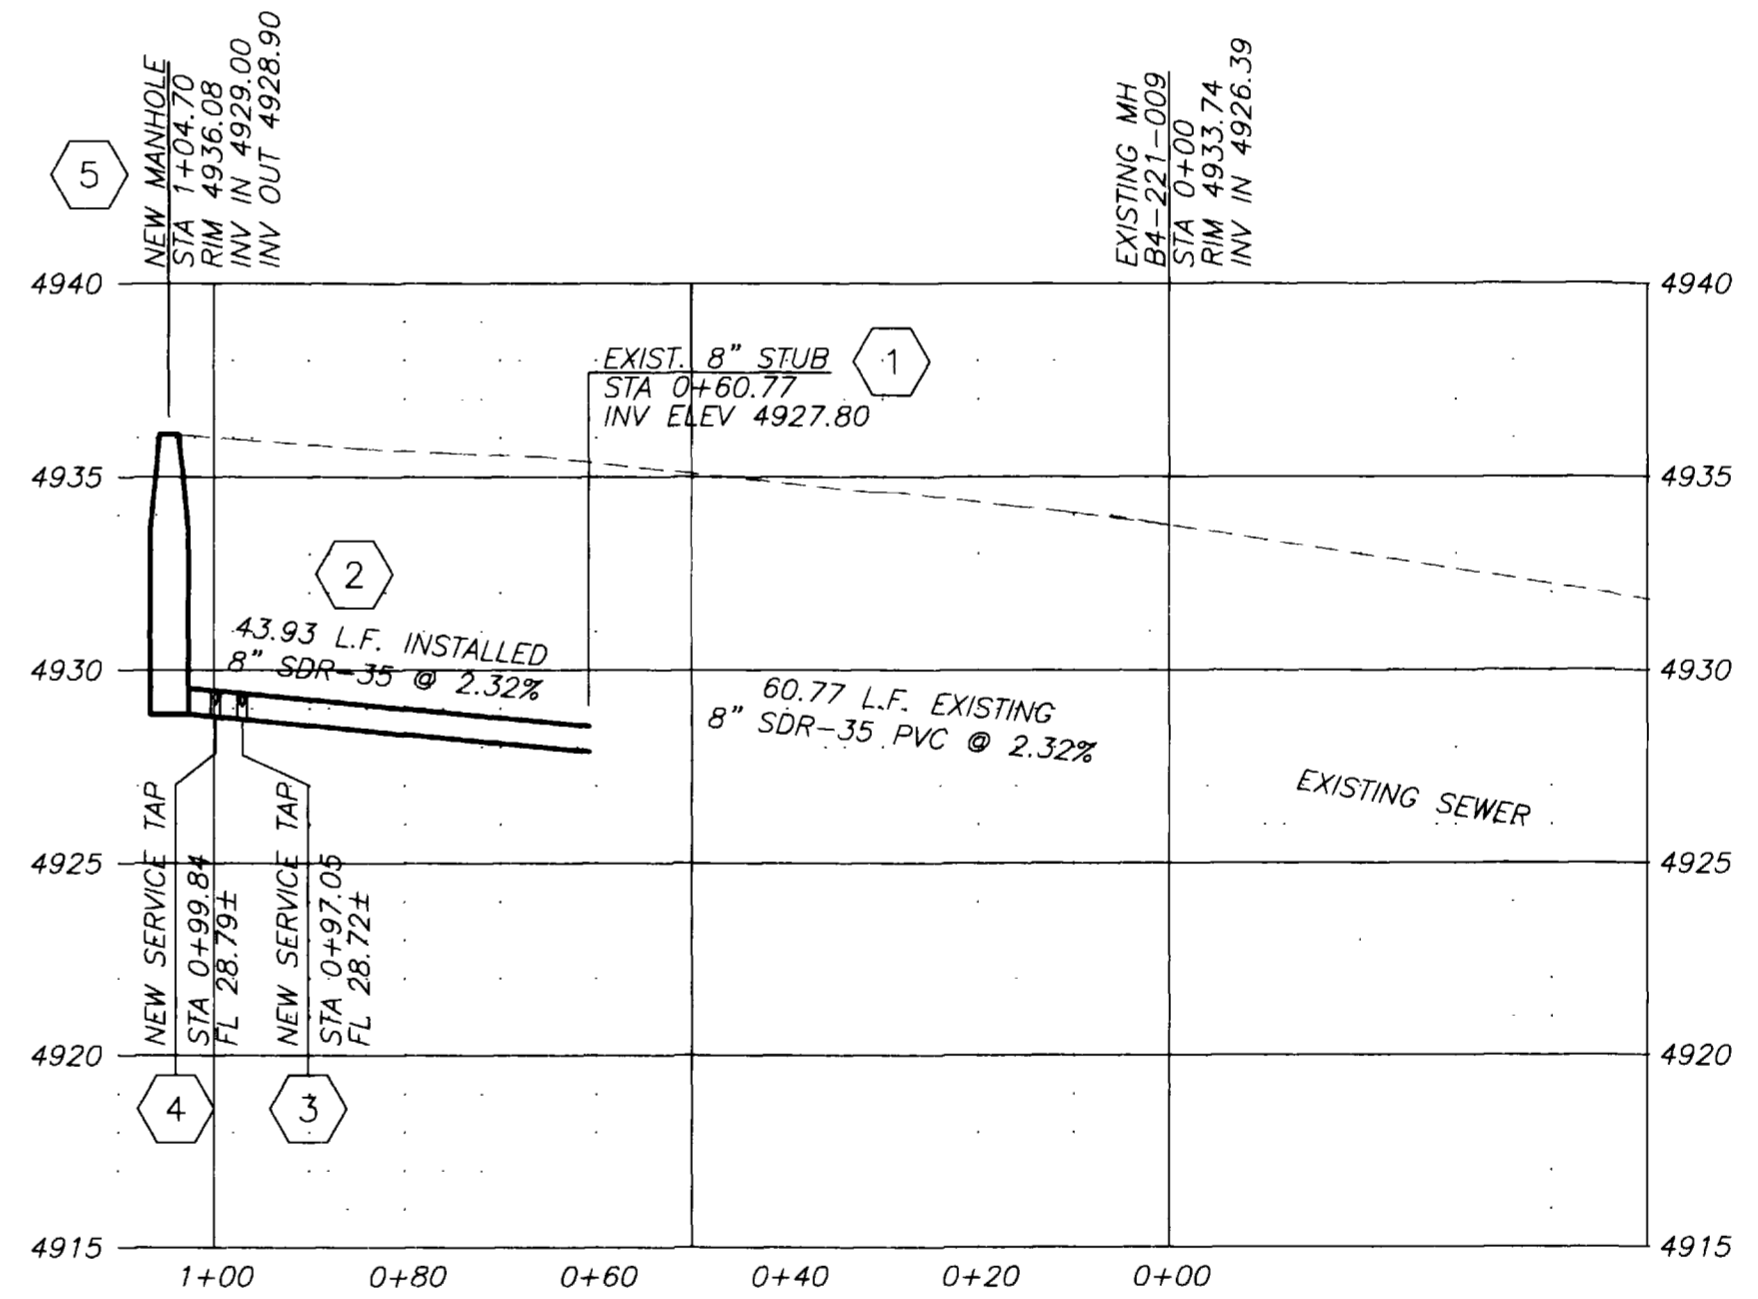

NEW DAKOTA DRIVE SEWER LINE
 HORIZONTAL SCALE: 1" = 20'
 VERTICAL SCALE: 1" = 5'

NOTE:
 LOCATION OF UTILITIES SHOWN HEREON WAS PROVIDED
 BY OTHERS. CONTRACTOR MUST VERIFY LOCATION OF
 ALL EXISTING UTILITIES PRIOR TO CONSTRUCTION.



CALL
 1-800-922-1987
 UTILITY NOTIFICATION
 CENTER OF COLORADO

ENGINEERS STATEMENT

Sharper Engineering, Inc. provides this construction Drawing of Record based on survey information, by DH Surveys, Inc. collected after installation of improvements. Sharper Engineering, Inc. only provided periodic inspection of the improvements as shown on this plan, and that to the best of our knowledge, it conforms to the Standards and Specifications of the City of Grand Junction.

Sharon E. Vayner
 Sharper Engineering, Inc. Date

**CONSTRUCTION
 DRAWING OF RECORD**

BENCHMARK:
 CITY DESIGNATED
 MH B4-221-009
 RIM ELEV = 4933.74
 CITY OF GRAND JUNCTION
 SEWER SYSTEM WEBSITE

BY:	RLC
REVISION:	AS-BUILT DRAWING
NO:	1
DATE:	10-2-03

**SANITARY SEWER
 8" MAIN EXTENSION
 2210 DAKOTA DRIVE**

**AUSTIN & AUGUSTA DESIGN
 607 SOUTH 7TH STREET
 GRAND JCT., CO 81501**

**SHARPER
 Engineering Services, Inc.**
 1950 HIGHWAY 6 & 50
 FRUITA, COLORADO 81521 (970) 858-9671

