

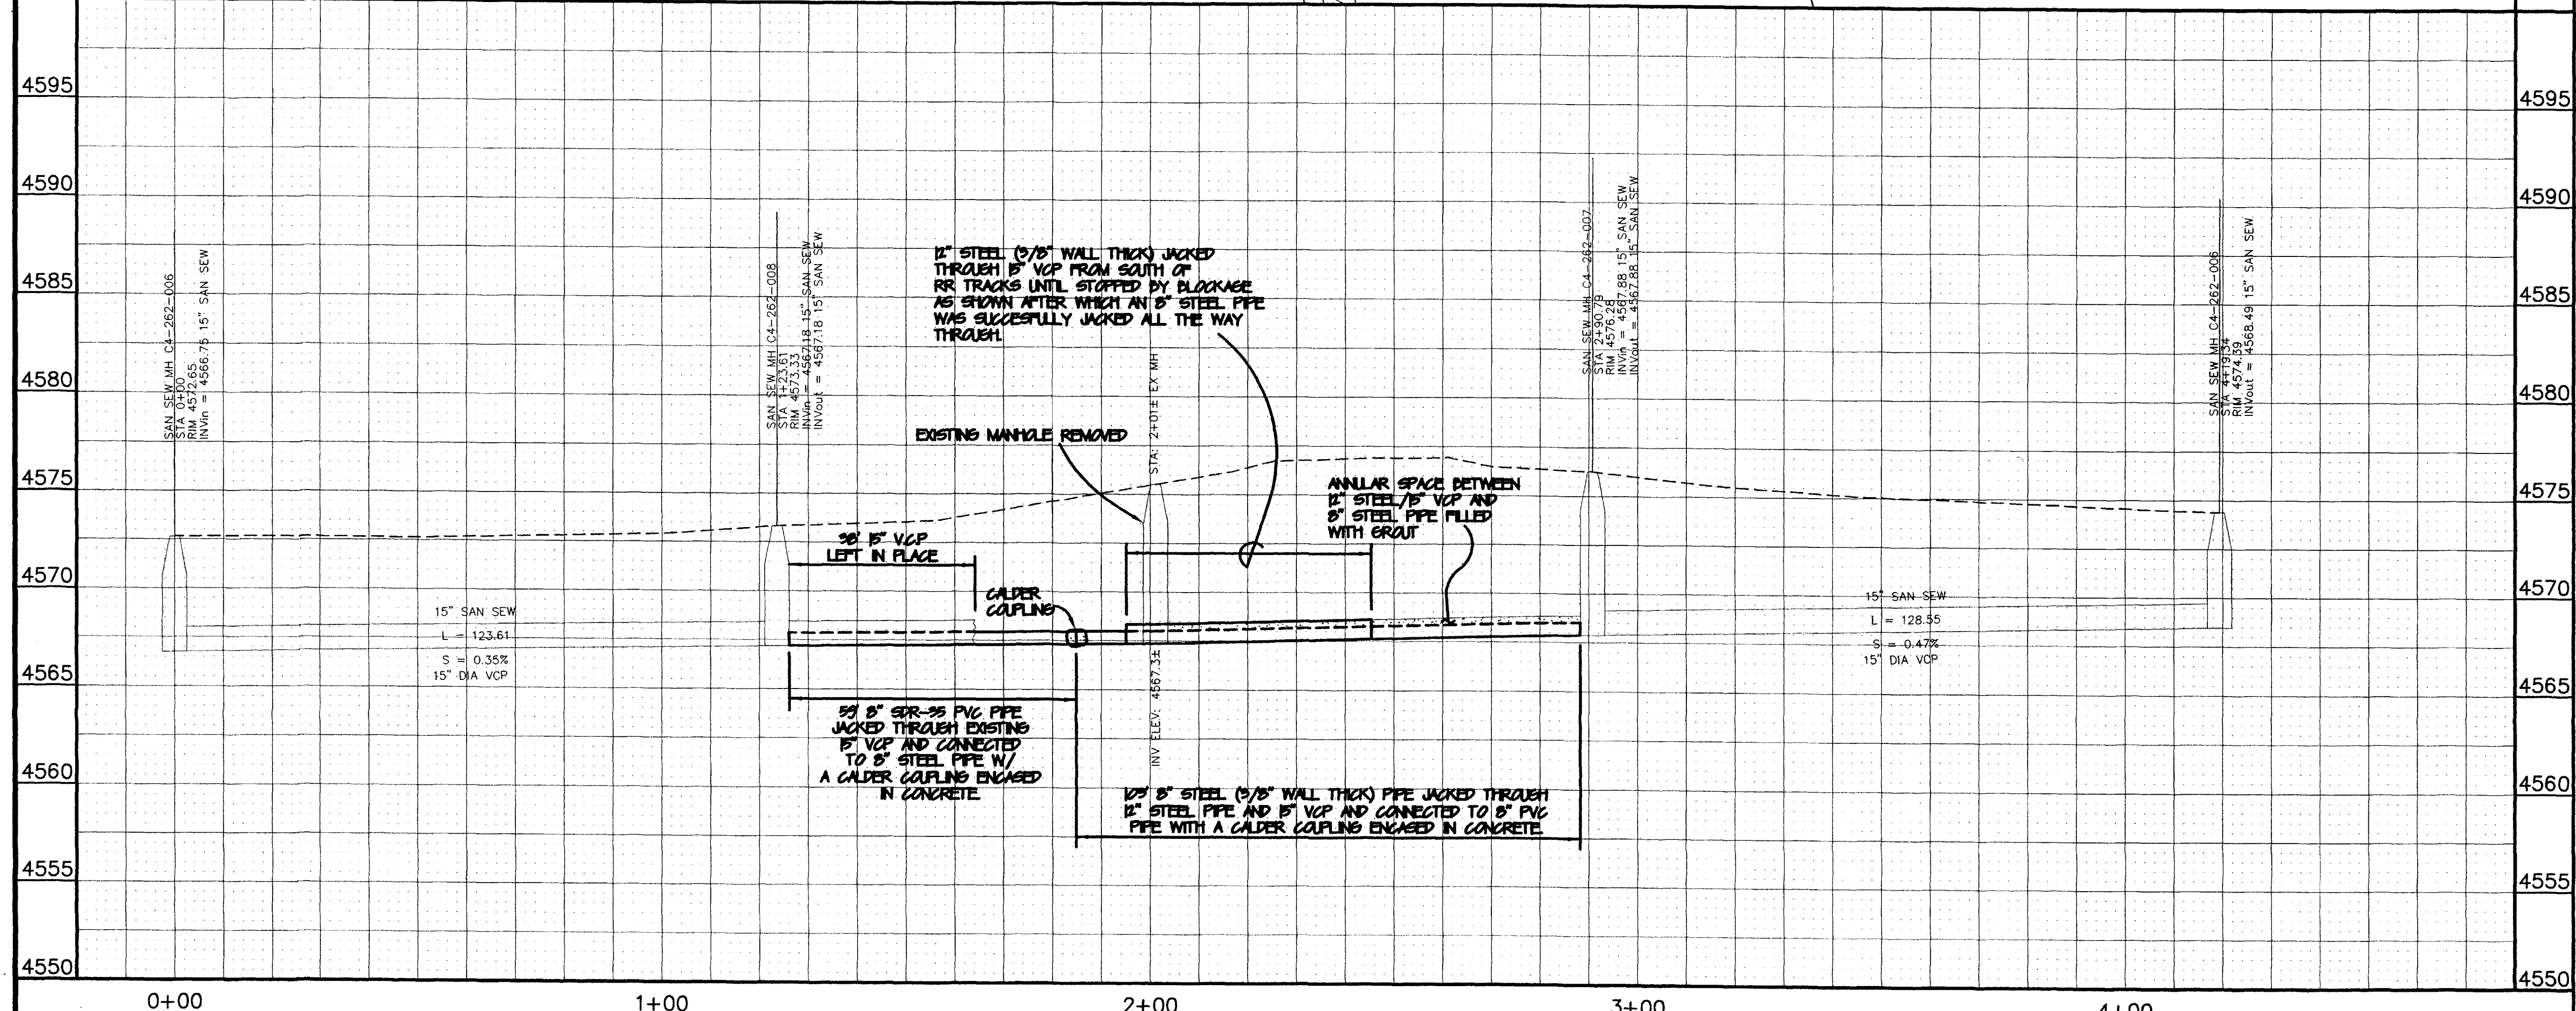


① 202.00 BID ITEM DESCRIPTION

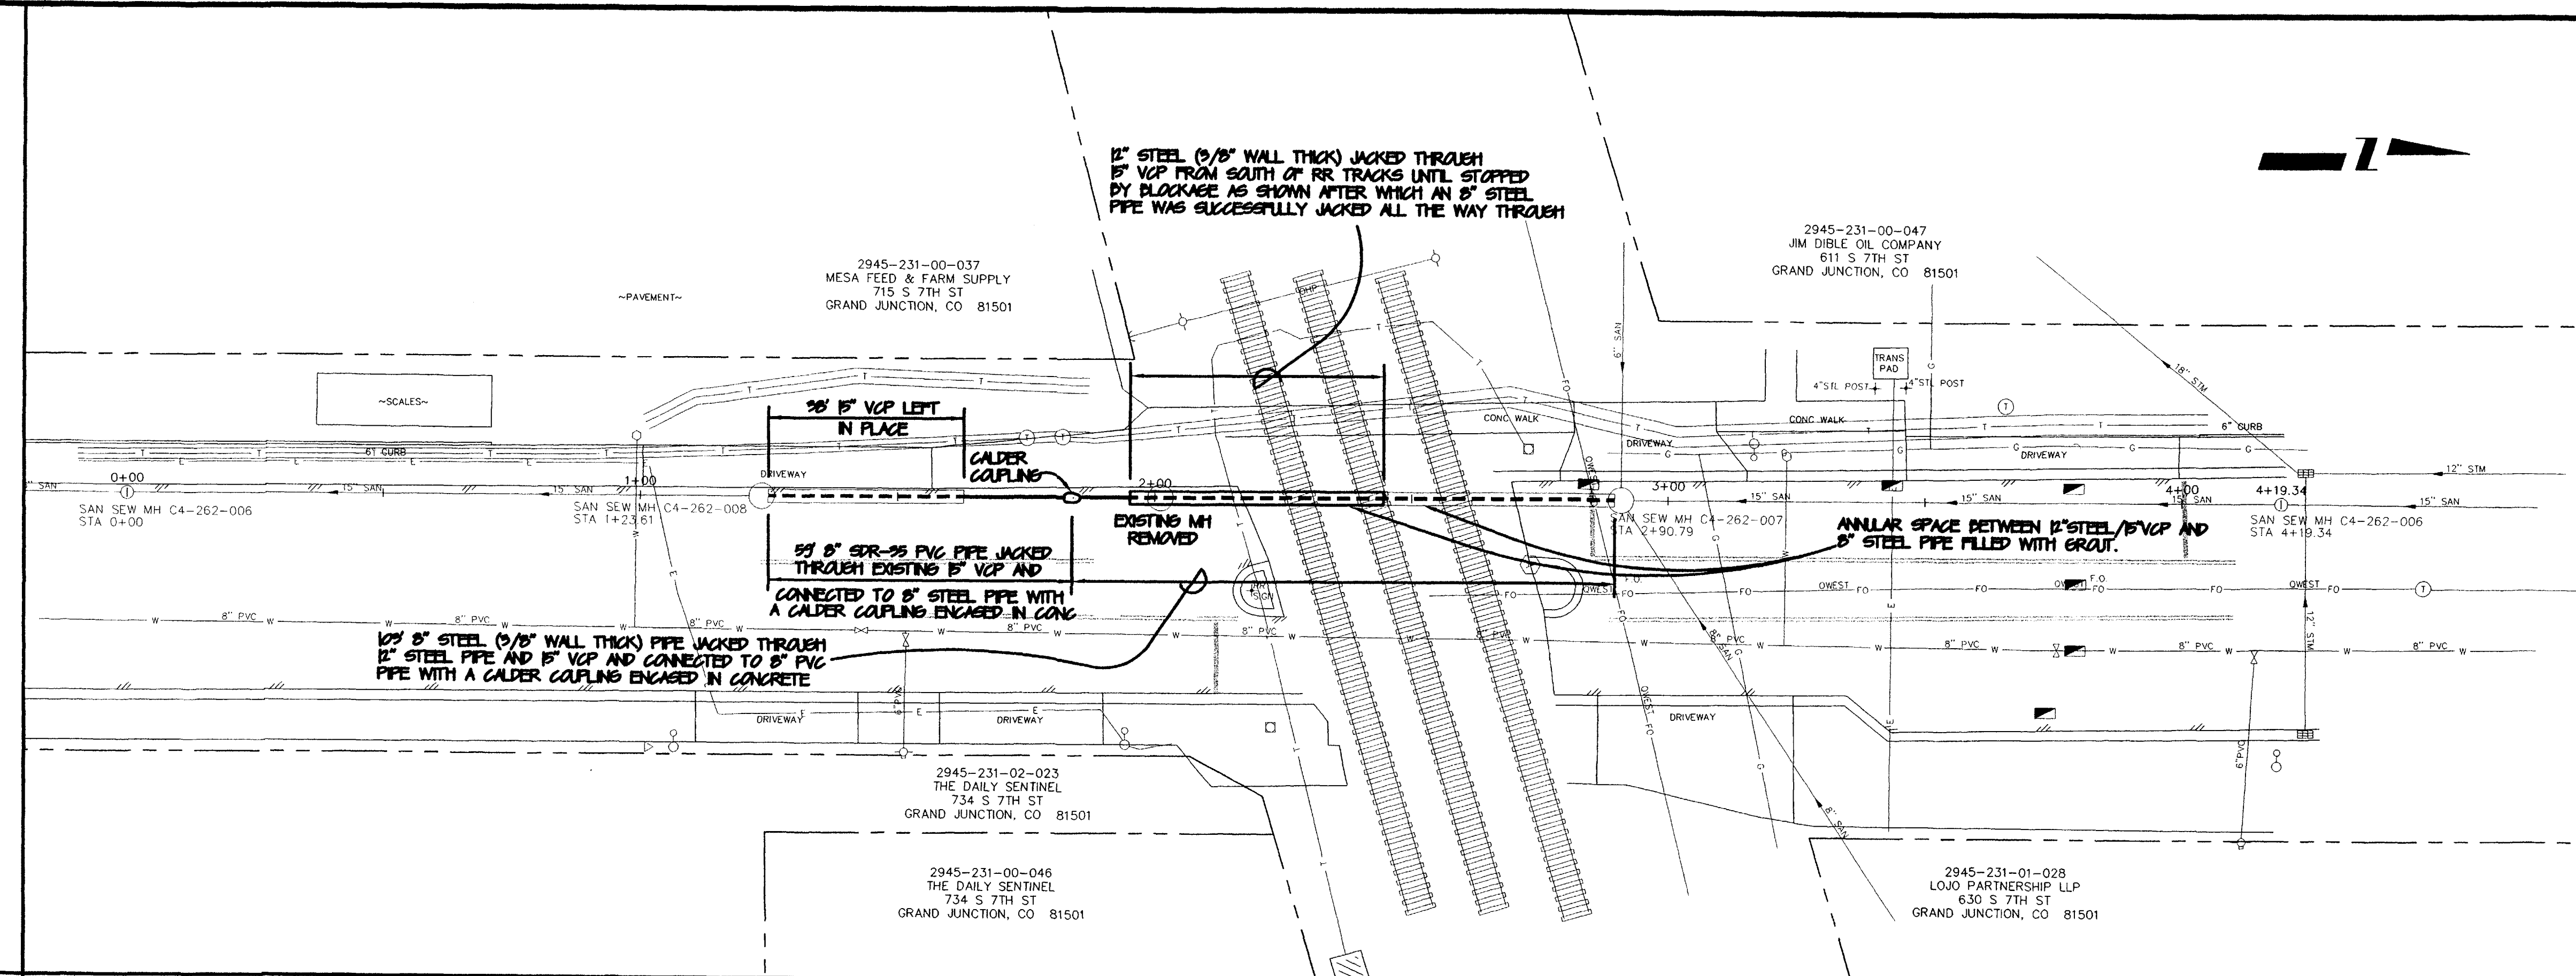

REVISION	DESCRIPTION	DATE
REVISION A	ASBUILT 5-1-2004 SEWER REPAIR	7-16-04
REVISION B		
REVISION C		
REVISION D		

DESIGNED BY: JCS DATE: 2004  
 CHECKED BY: DATE: \_\_\_\_\_  
 APPROVED BY: DATE: \_\_\_\_\_

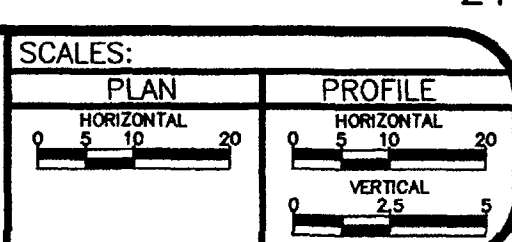

**PUBLIC WORKS  
 AND UTILITIES  
 ENGINEERING DIVISION**

**SOUTH 7TH STREET SEWER LINE REPAIR  
 SANITARY SEWER PLAN AND PROFILE**