

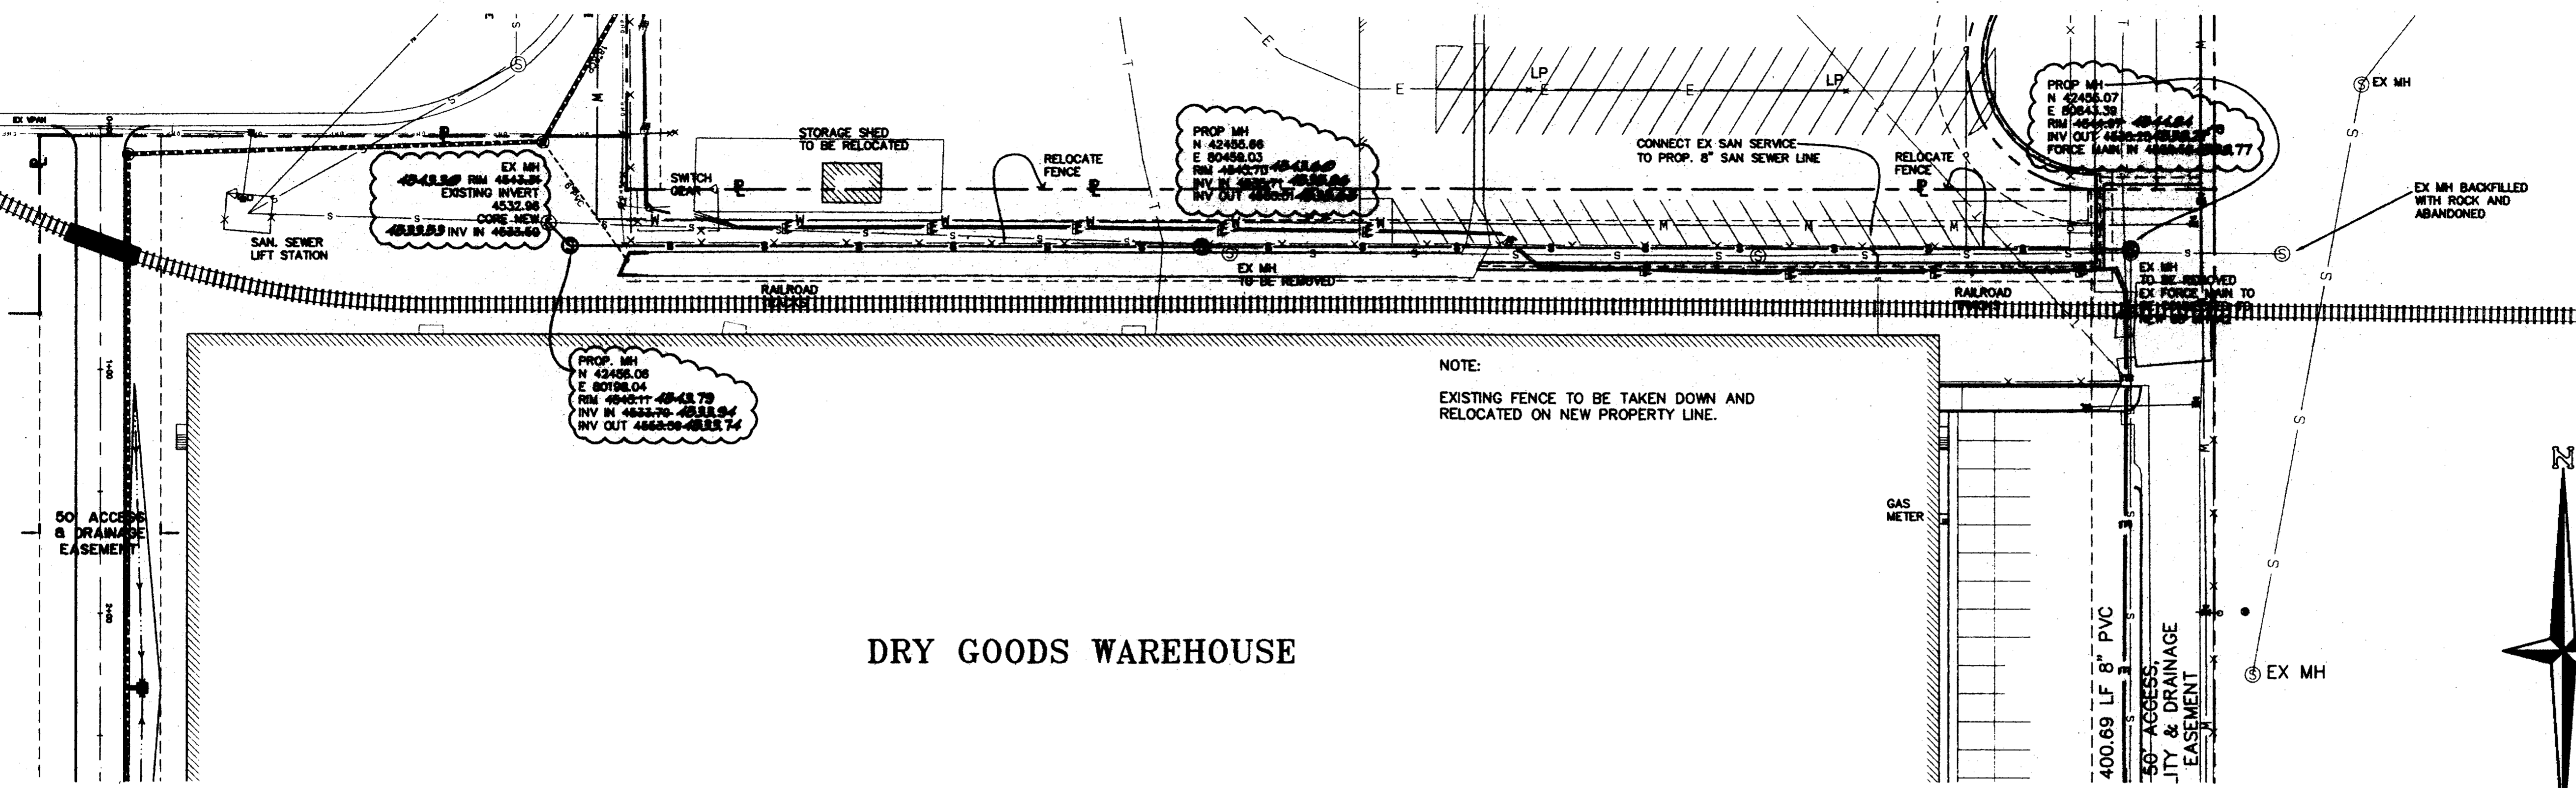


**BENCHMARK**  
 NW 1/4 CORNER, SEC 9, T1S, R3W, UTE MERIDIAN  
 NORTH OF INTERSECTION OF RIVER ROAD  
 AND BLUE HERON LANE.  
 ELEVATION 4549.26

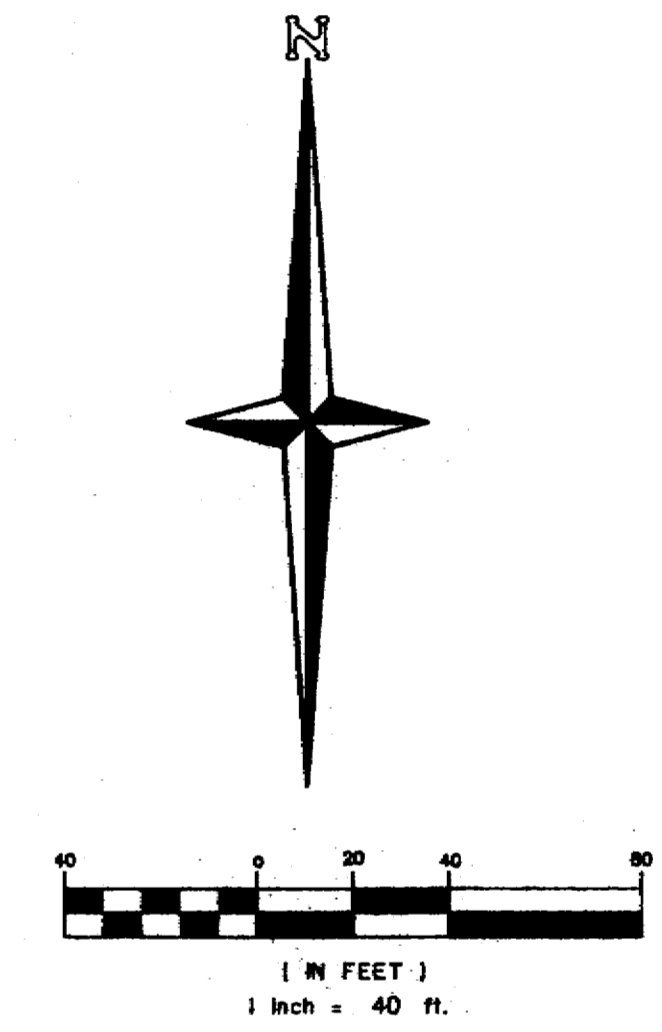

REVISED TO AS BUILT CONDITIONS ON 7/16/04  
 AS SURVEYED ON 7/16/04.  
 HORIZONTAL LOCATIONS OF SEWER SERVICE ARE  
 BASED UPON SEWER STATIONING AS SHOWN HEREON.

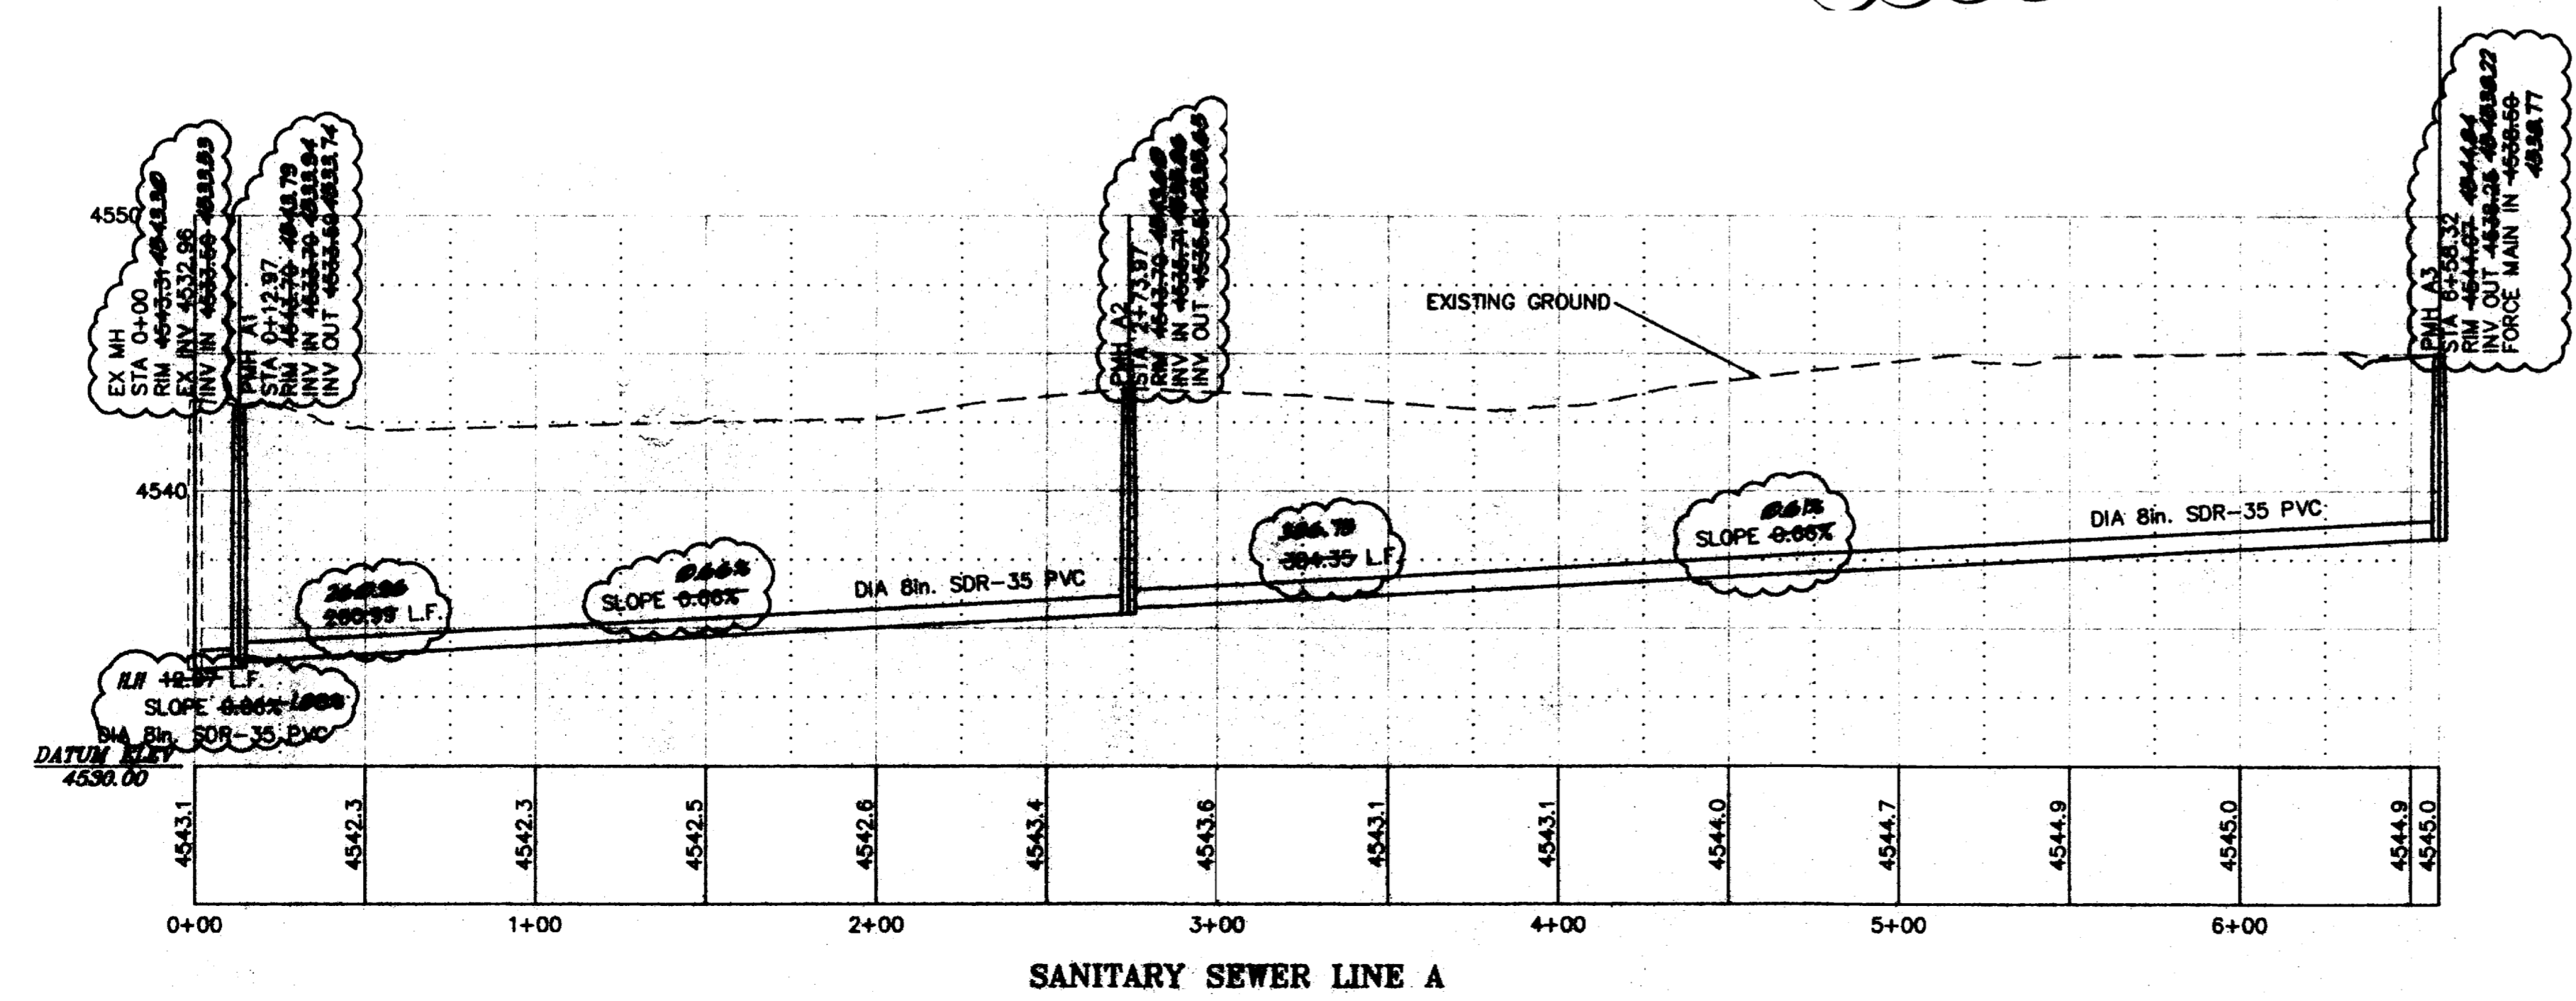

CALL UTILITY NOTIFICATION  
 CENTER OF COLORADO  
**1-800-922-1987**  
 CALL 2 BUSINESS DAYS IN ADVANCE  
 BEFORE YOU DIG, GRADE, OR EXCAVATE  
 FOR THE MARKING OF UNDERGROUND  
 MEMBER UTILITIES.

ACCEPTED FOR CONSTRUCTION FOR ONE YEAR FROM THIS DATE.  
 Acceptance of these plans does not relieve the developer, contractor, or the engineer from compliance with the City of Grand Junction Standard Specifications.

City of Grand Junction Engineering Division Representative \_\_\_\_\_ Date \_\_\_\_\_  
**ACCEPTED AS CONSTRUCTED**  
 City of Grand Junction Engineering Division Representative \_\_\_\_\_ Date \_\_\_\_\_

CD			
BY			
DESCRIPTION			
DATE			
REVISION			
GRAND JUNCTION, CO			
<b>CITY MARKET</b> SANITARY SEWER <b>WAREHOUSE - RIVER RD</b> PLAN & PROFILE <b>BRET GULLORY</b>			
<b>THOMPSON-LANGFORD CORP.</b> ENGINEERS AND LAND SURVEYORS 809 S 1/2 S. 90TH E10 GRAND JUNCTION, COLORADO PH. (970) 245-6007 FAX (970) 241-2845 tlo@tloinvest.com			
DRAWN BY:	crk	CHECKED BY:	JEL
		DATE:	7/16/04
		SCALE:	Horiz: 1" = 40' Vert: 1" = 5'
		Project No:	0605-001
		SHEET NO:	1 of 1