


AS-BUILT 8/2006

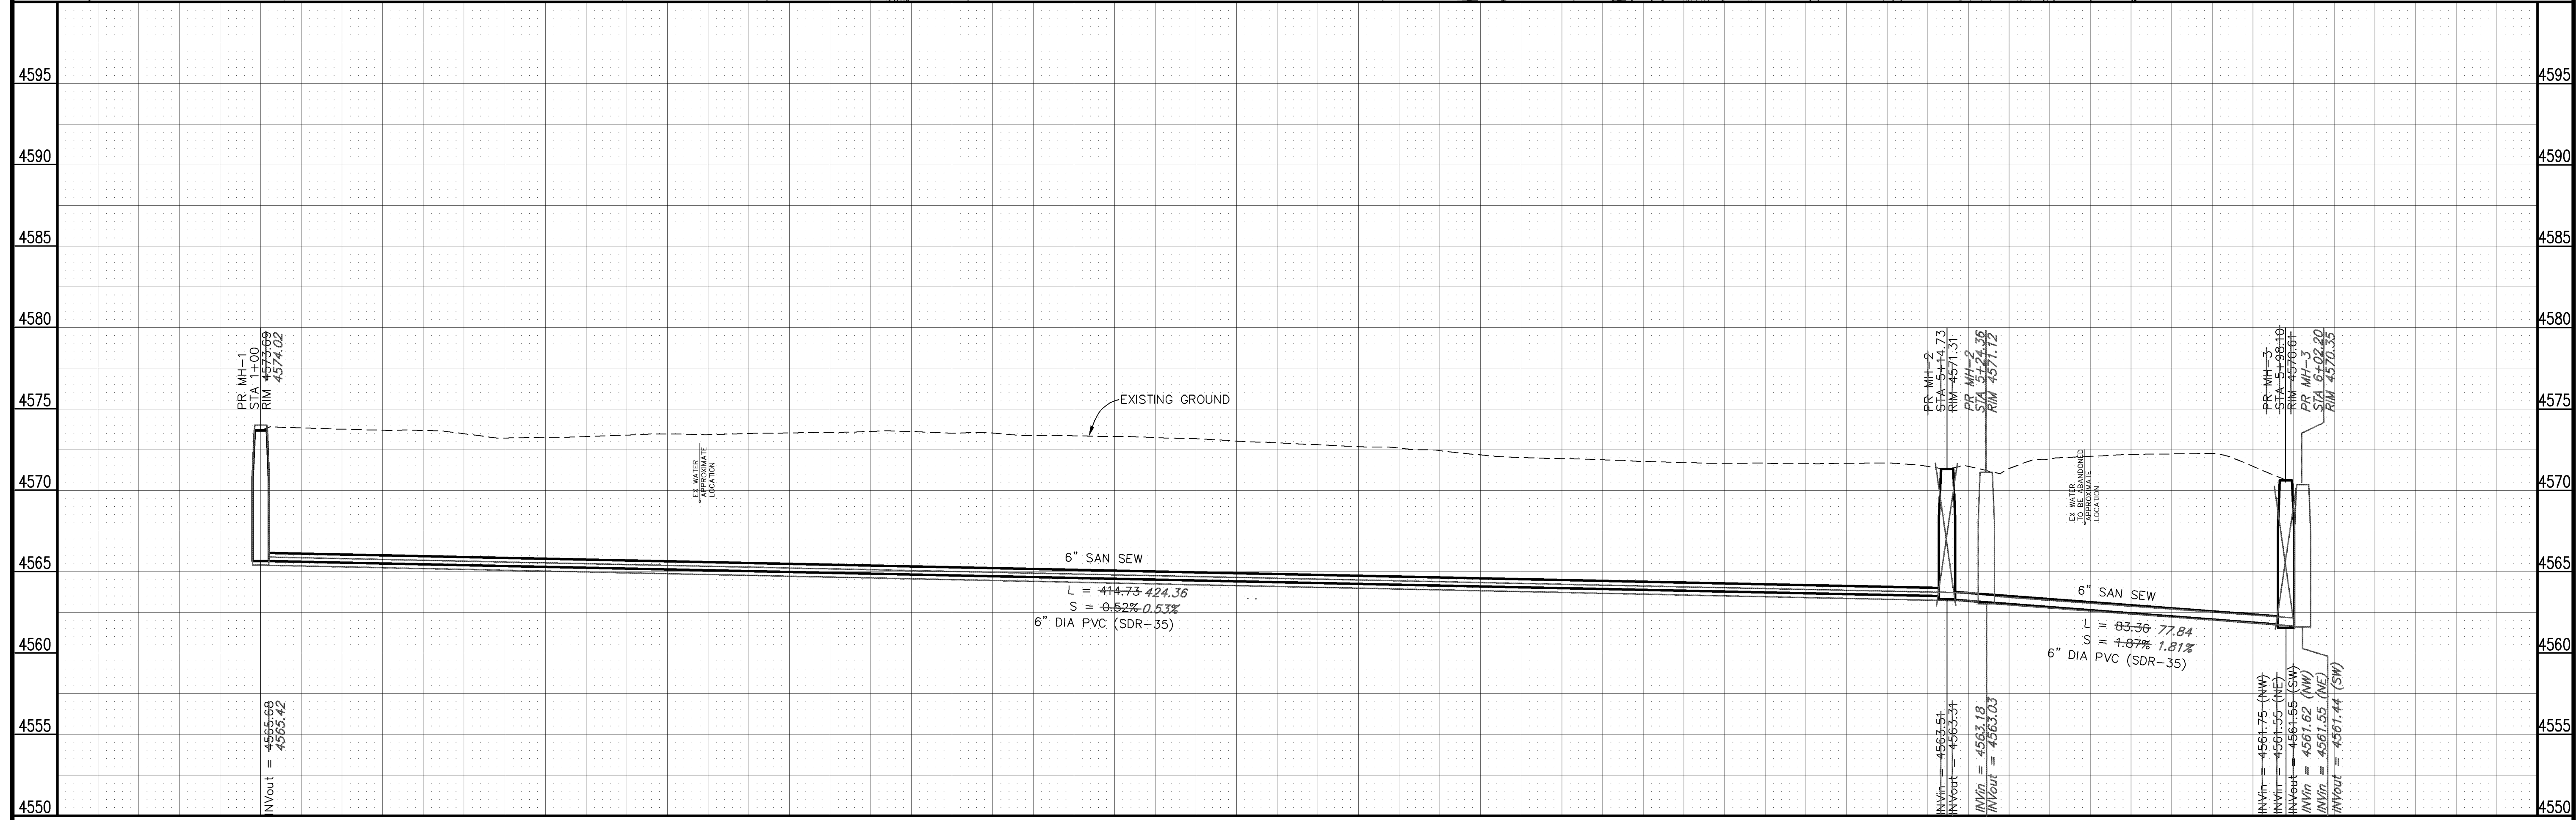

<p>REVISION Δ AS-BUILT</p> <p>REVISION Δ _____</p> <p>REVISION Δ _____</p> <p>REVISION Δ _____</p>	<p>DATE 8/8/2006</p>	<p>DRAWN BY JAH DATE 12/2005</p> <p>DESIGNED BY SBG DATE 12/2005</p> <p>CHECKED BY _____ DATE _____</p> <p>APPROVED BY _____ DATE _____</p>	<p>SCALES:</p> <p>PLAN 1" = 20'</p> <p>PROFILE 1" = 10'</p>		<p>PUBLIC WORKS AND UTILITIES ENGINEERING DIVISION</p>	<p>4th AVENUE SANITARY SEWER SANITARY SEWER PLAN AND PROFILE STA 1+00 TO STA 6+00</p>	<p>1</p>
--	----------------------	---	---	--	---	--	----------

K:\Projects\2005\4th Avenue Sanitary Sewer\AS-BUILT.dwg, 8/8/2006, 10:00 AM, JAH