


# DUCK POND PARK LIFT STATION ELIMINATION AND GRAVITY SEWER CONSTRUCTION MAY 5, 2005

AS BUILT 2007-10-17

- 1 ————— Cover Sheet
- 2 ————— Standard Abbreviations, Legend, and Symbols
- 3 ————— Summary of Approximate Quantities
- 4 ————— Survey Control Plan
- 5-9 ————— Sanitary Sewer Plan and Profiles
- 10-13 ————— Waterline Replacement Plans

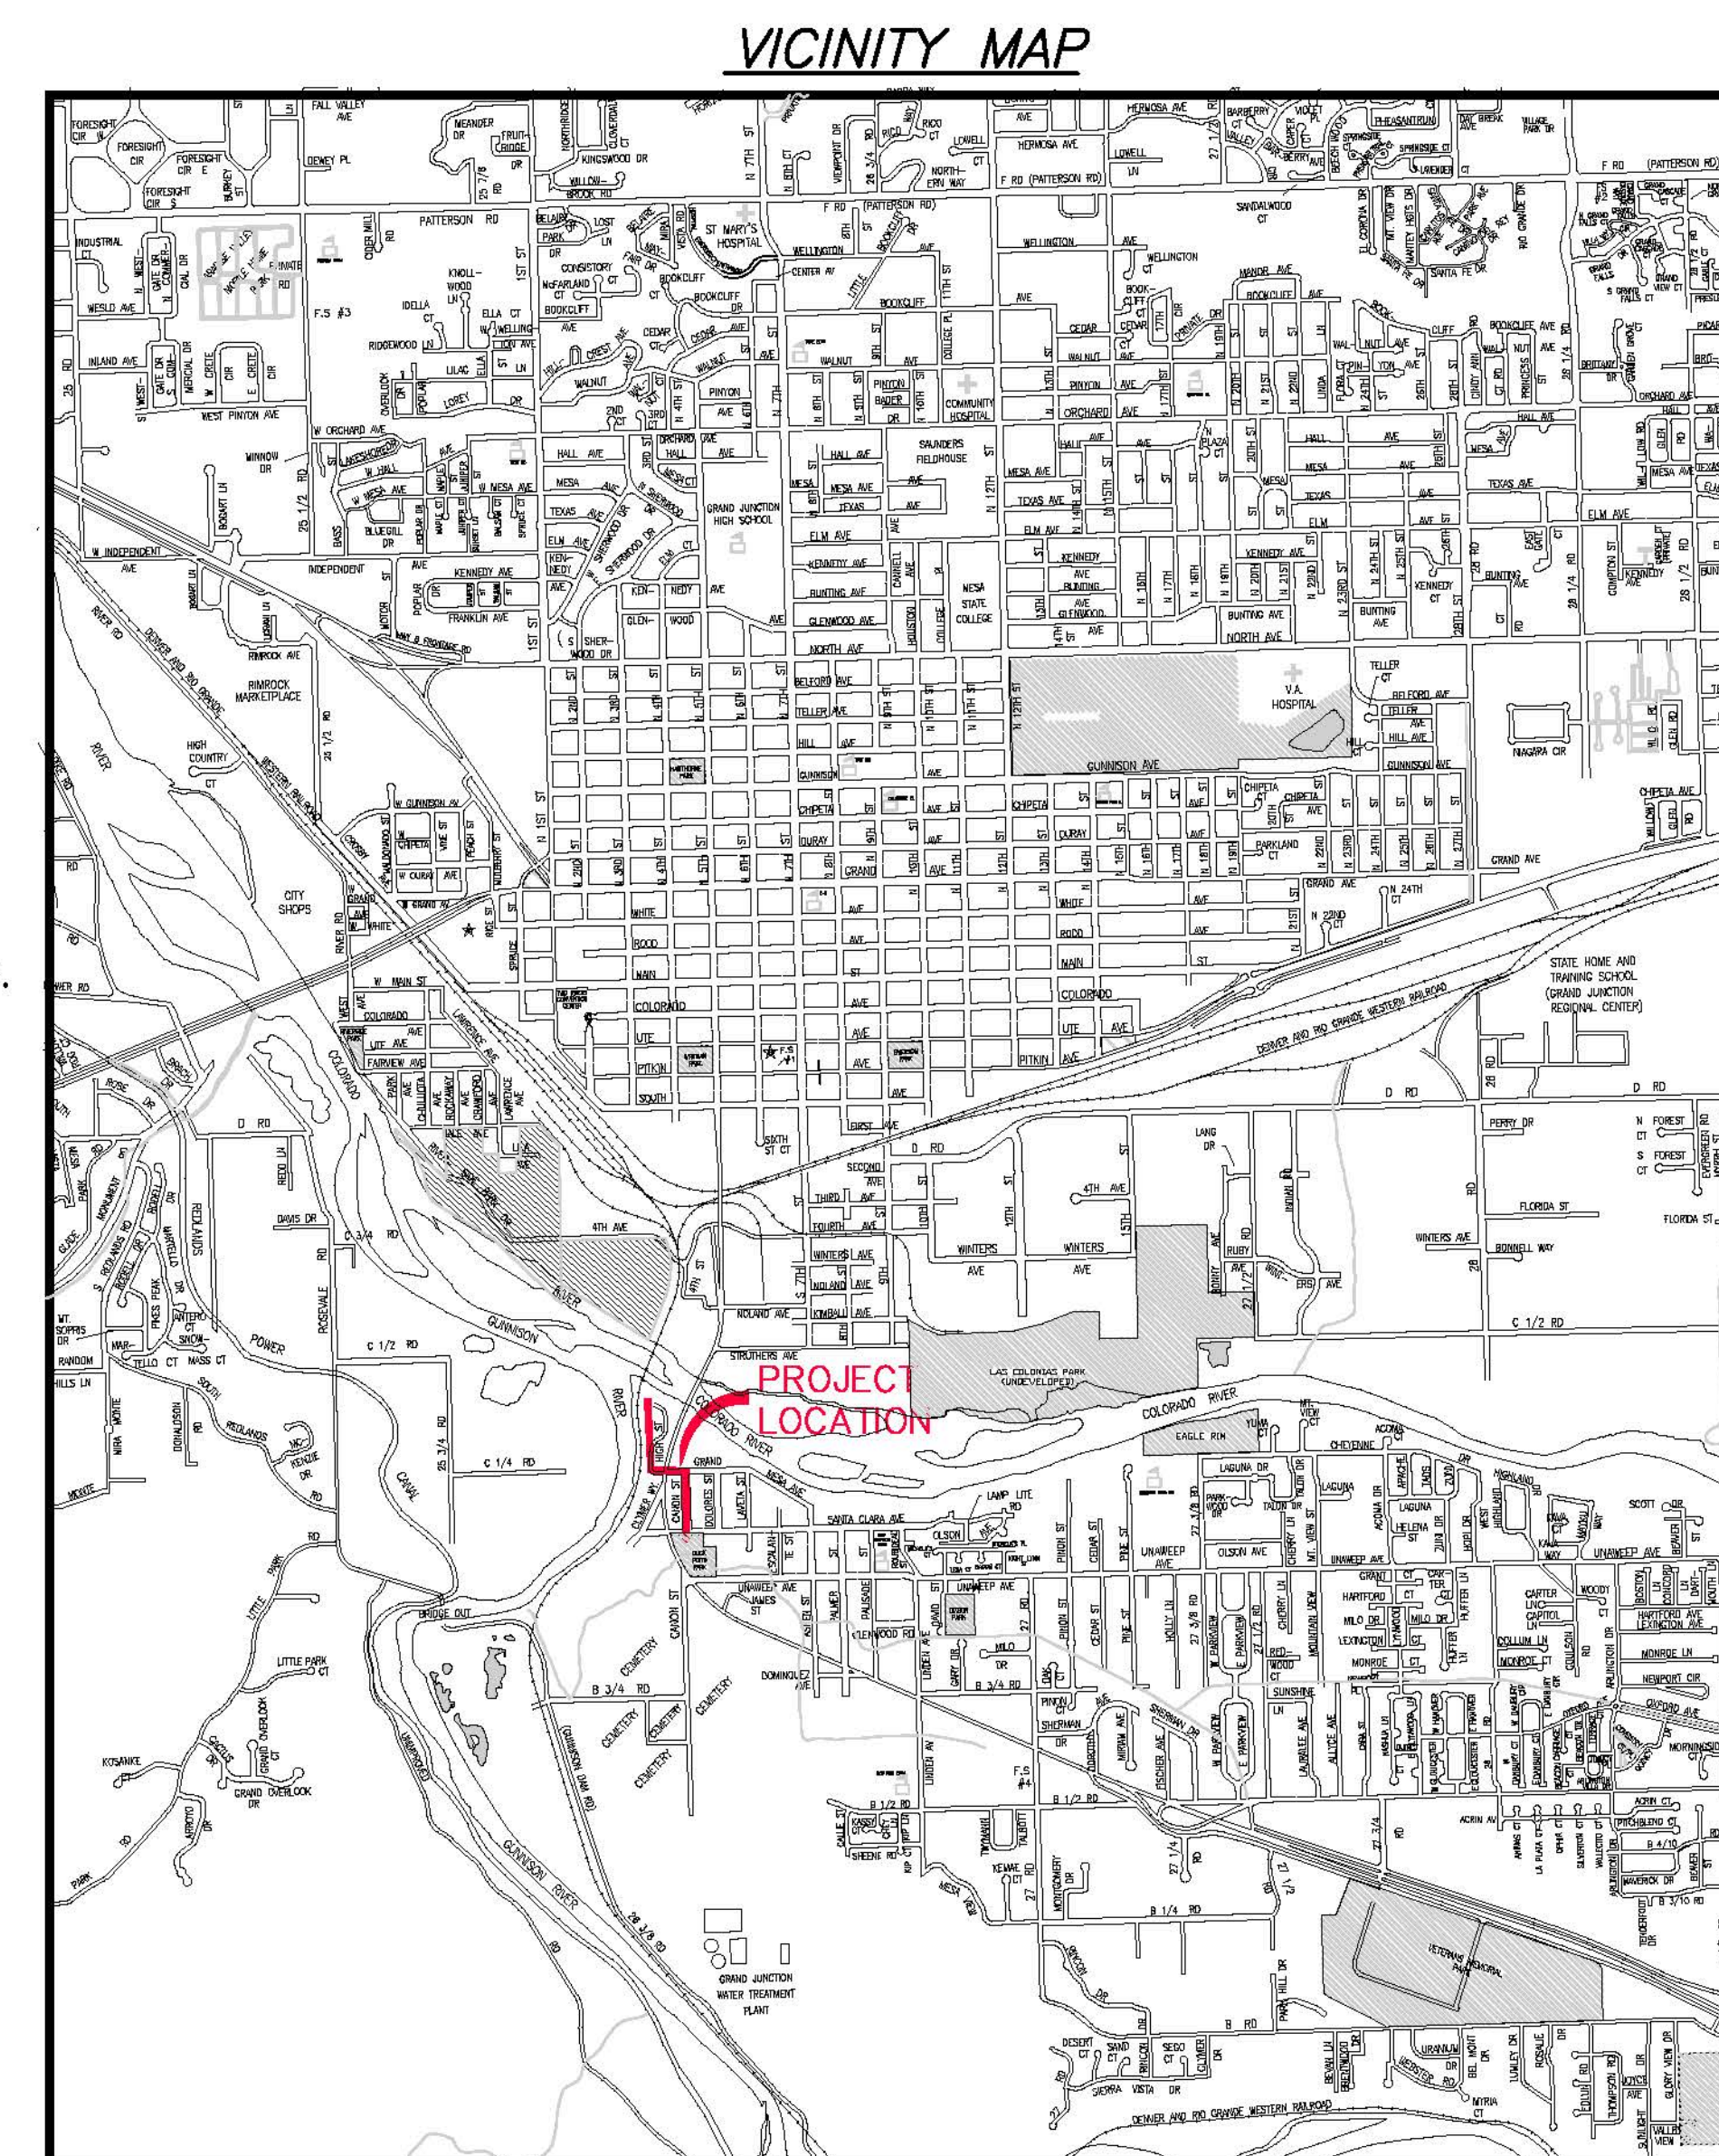

UTILITIES AND AGENCIES								
AGENCY	NAME	POSITION	ROLE	MAILING ADDRESS	STREET ADDRESS	CITY, STATE	VOICE-WK	FAX
GRAND JUNCTION, CITY OF	PAUL JAGIM	PROJECT ENGINEER	PROJECT ENGINEER	250 N. 5th STREET	250 N. 5th STREET	GRAND JCT., CO 81501	(970) 256-4023	(970) 256-4022
GRAND JUNCTION, CITY OF	BRET GUILLORY	UTILITY ENGINEER	SEWER/WATER	250 N. 5th STREET	250 N. 5th STREET	GRAND JCT., CO 81501	(970) 244-1590	(970) 256-4022
GRAND VALLEY IRRIGATION CO.	PHIL BERTRAND		IRRIGATION	688 26 ROAD	688 26 ROAD	GRAND JCT., CO 81506	(970) 242-2762	
BRESNAN	GLENN VANCIL		CABLE TV	2502 FORESIGHT CIRCLE	2502 FORESIGHT CIRCLE	GRAND JCT., CO 81504	(970) 245-8750	(970) 245-6803
U.S. WEST/QWEST	DAN WISEMAN	ENGINEER	TELEPHONE	2524 BLICKMAN ROAD	2524 BLICKMAN ROAD	GRAND JCT., CO 81504	(970) 244-4311	(970) 240-4349
UTE WATER	DARYL MOORE	ENGINEER	WATER	PO BOX 460		GRAND JCT., CO 81502	(970) 242-7491	(970) 242-9189
XCEL	STEVE LOPEZ	PROJECT MANAGER	GAS, ELECTRIC	2538 BLICKMAN ROAD	2538 BLICKMAN ROAD	GRAND JCT., CO 81504	(970) 244-2698	(970) 244-2661



*Public Works & Utilities  
Engineering Division*

DRAWING STATUS:	
<input type="radio"/>	PROGRESS
<input checked="" type="radio"/>	FINAL CONSTRUCTION DRAWINGS
<input type="radio"/>	ASBUILT
REVIEW BY	
BRET GUILLORY, UTILITY ENGINEER	DATE
AUTHORIZED FOR CONSTRUCTION	
D. PAUL JAGIM, PROJECT ENGINEER	DATE
AUTHORIZED FOR CONSTRUCTION	
MIKE MCDILL, CITY ENGINEER	DATE
ACCEPTED AS CONSTRUCTED	
CITY OF GRAND JUNCTION	DATE

**ABBREVIATIONS**

AASTHO	AMERICAN ASSOCIATION OF STATE HIGHWAY & TRANSPORTATION OFFICIALS
ABC	AGGREGATE BASE COURSE
AC	ASBESTOS CEMENT
AP	ANGLE POINT
ASB	ANCHORED STRAW BALES
ASP	ALUMINIZED STEEL PIPE
ASTM	AMERICAN SOCIETY FOR TESTING MATERIALS
AWWA	AMERICAN WATER WORKS ASSOCIATION
BC	BACK OF CURB
BF	BUTTERFLY VALVE
BOW	BACK OF WALK
BCR	BEGIN CURB RETURN
BOT	BOTTOM
BSWMP	BETTER STORM WATER MANAGEMENT PRACTICES
CH	CHORD
CAP	CORRUGATED ALUMINUM PIPE
CDOT	COLORADO DEPARTMENT OF TRANSPORTATION
CI	CAST IRON
C,G,& SW	CURB, GUTTER & SIDEWALK
CL	CENTER LINE
CL	CLEAR
CMP	CORRUGATED METAL PIPE
CO	CLEAN OUT
COMB	COMBINATION (AS IN STORM SEWER AND SANITARY SEWER)
CONC	CONCRETE
CSM	CITY SURVEY MONUMENT
CSP	CORRUGATED STEEL PIPE
CJ	COPPER
DI	DUCTILE IRON
DWY	DRIVEWAY
E	ELECTRIC
ECR	END CURB RETURN
EG	EDGE OF GUTTER
EL	ELEVATION
EP	EDGE OF PAVEMENT
EX	EXISTING
FB	FULL BODY
FC	FACE OF CURB
FG	FINISHED GRADE
F	FLOW LINE
FL	FLANGE
FM	FORCE MAIN
FO	FIBER OPTICS
FS	FAR SIDE
FTG	FOOTING
G	GAS
GB	GRADE BREAK
GM	GAS METER
GV	GATE VALVE
HBP	HOT BITUMINOUS PAVEMENT
HDPE	HIGH DENSITY POLYETHYLENE
INV	INVERT
IRR	IRRIGATION
L	LENGTH OF ARC
LC	LONG CHORD
LF	LINEAR FEET
LL	LONG ARC
LS	SHORT ARC
LT	LEFT
MB	MAILBOX
MCSM	MESA COUNTY SURVEY MONUMENT
MH	MANHOLE
MJ	MECHANICAL JOINT
MW	MILL WRAP
N/A	NOT APPLICABLE
NIC	NOT IN CONTRACT
NOP	NO ONE PERSON
NRCP	NON-REINFORCED CONCRETE PIPE
NS	NEAR SIDE
NTS	NOT TO SCALE
OHP	OVERHEAD POWER
OHT	OVERHEAD TELEPHONE
PC	POINT OF CURVATURE
PCC	POINT OF COMPOUND CURVATURE
PE	POLYETHYLENE
PERF	PERFORATED
PI	POINT OF INTERSECTION
PIP	PLASTIC IRRIGATION PIPE
POC	POINT ON CURVE
POT	POINT ON TANGENT
PR	PROPOSED
PRC	POINT OF REVERSE CURVATURE
PT	POINT OF TANGENCY
PVC	POLYVINYL CHLORIDE
R	RADIUS
RCP	REINFORCED CONCRETE PIPE
REQ'D	REQUIRED
RG	RESTRAINED GLANDS
RL	LONG RADIUS
ROW	RIGHT OF WAY
RP	RADIUS POINT
RR	RAIL ROAD
RS	SHORT RADIUS
RT	RIGHT
S	SLOPE
SAN	SANITARY
SC	SHORT CHORD
SCD	STANDARD CONTRACT DOCUMENTS
SCH	SCHEDULE
SF	SILT FENCE
SL	SECTION LINE
SSRB	STANDARD SPECIFICATIONS FOR ROAD & BRIDGE CONSTRUCTION
SSUU	STANDARD SPECIFICATIONS FOR CONSTRUCTION OF UNDERGROUND UTILITIES
STA	STATION
STL	STEEL
STM	STORM
T	TELEPHONE
TAN	LENGTH OF TANGENT
TC	TOP OF CURB
TH	TEST HOLE
TV	TELEVISION
(TYP)	TYPICAL
UU	UNDERGROUND UTILITIES
VC	VERTICAL CURVE
VCP	VITRIFIED CLAY PIPE
VPC	VERTICAL POINT OF CURVATURE
VPCC	VERTICAL POINT OF COMPOUND CURVATURE
VPRC	VERTICAL POINT OF REVERSE CURVATURE
VPI	VERTICAL POINT OF INTERSECTION
VPT	VERTICAL POINT OF TANGENCY
W	WATER
Δ	DELTA ANGLE


**LEGEND**

BSWMP DRAINAGE BASIN BOUNDARY	
BSWMP ANCHORED STRAW BALES	
BSWMP SILT FENCE	
BUILDING	
CONCRETE CURB AND GUTTER	
CONCRETE CURB, GUTTER, & SIDEWALK	
CONCRETE DITCH	
CONCRETE SIDEWALK	
CULVERT	
EARTH DITCH	
EDGE OF GRAVEL	
EDGE OF PAVEMENT	
FENCE (BARBED WIRE)	
FENCE (CHAIN LINK)	
FENCE (IRON)	
FENCE (PLASTIC)	
FENCE (TEMPORARY CONSTRUCTION)	
FENCE (WOOD)	
FENCE (WOVEN WIRE)	
GUARD RAIL	
HATCHING: INDICATES ASPHALT REMOVAL/REPLACEMENT	
HATCHING: INDICATES ABC AND/OR DECOMPOSSITIVE ROCK AS NOTED ON PLAN	
HATCHING: INDICATES SOD	
HATCHING: INDICATES CONCRETE REMOVAL/REPLACEMENT	
HATCHING: INDICATES NATIVE SEED MIX	
LINE (CENTER OF IMPROVEMENTS)	
LINE (CITY LIMITS)	
LINE (CONTROL)	
LINE (EASEMENT)	
LINE (MONUMENT/SECTION)	
LINE (PROPERTY)	
LINE (RIGHT OF WAY)	
MATCH LINE	
PIPE (IRRIGATION)	
PIPE (SIPHON)	
PROPOSED CONCRETE CURB AND GUTTER	
PROPOSED CONCRETE CURB, GUTTER, & SIDEWALK	
PROPOSED CONCRETE SIDEWALK	
PROPOSED "WET" UTILITIES (CONSTRUCTION NOTE WILL INDICATE TYPE, SIZE, AND MATERIAL OF NEW MAIN)	
ALL PROPOSED FEATURES NOT SHOWN IN LEGEND WILL BE SHOWN THE SAME AS THEIR EXISTING COUNTERPART, BUT INDICATED BY BOLDER LINETYPE	
RAIL ROAD	
RETAINING WALL	
STRIPING (CONTINUOUS WHITE)	
STRIPING (DASHED WHITE)	
STRIPING (CONTINUOUS YELLOW)	
STRIPING (DASHED YELLOW)	
TOP OF SLOPE	
CONTOUR LINES (SHOWN BETWEEN TOP & TOE)	
TOE OF SLOPE	
TRAFFIC DETECTOR LOOP	
UTILITY LINE (ABANDON) (THIS CASE A WATER LINE)	
UTILITY LINE (CABLE TV)	
UTILITY LINE (ELECTRIC)	
UTILITY LINE (FIBER OPTIC)	
UTILITY LINE (GAS)	
UTILITY LINE (HIGH VOLTAGE OVERHEAD POWER)	
UTILITY LINE (OVERHEAD POWER)	
UTILITY LINE (OVERHEAD TELEPHONE)	
UTILITY LINE (SANITARY SEWER)	
UTILITY LINE (SANITARY SEWER FORCE MAIN)	
UTILITY LINE (SANITARY SEWER SERVICE)	
UTILITY LINE (STORM SEWER)	
UTILITY LINE (STORM SEWER, PERFORATED)	
UTILITY LINE (STORM/SANITARY SEWER SEWER COMBINATION)	
UTILITY LINE (TELEPHONE)	
UTILITY LINE (WATER)	

**SYMBOLS**

BENCH MARK	
CATCH BASIN	
CLEAN OUT	
CURB STOP	
FIRE HYDRANT	
GUY WIRE ANCHOR	
HEADGATE	
IRRIGATION PUMP	
MAILBOX	
MANHOLE (ELECTRIC)	
MANHOLE (GAS)	
MANHOLE (SANITARY/STORM)	
MANHOLE (TELEPHONE)	
MANHOLE (TV)	
MANHOLE (WATER)	
METER (GAS)	
METER (WATER)	
PEDESTAL (TELEPHONE)	
PEDESTAL (TV)	
PROPERTY PIN	
PULL BOX	
REDUCER FITTING	
SIGN OR POST (SIGN TYPE NOTED)	
SPRINKLER HEAD	
STREET LIGHT	
SURVEY MONUMENT (CITY)	
SURVEY MONUMENT (TYPE NOTED)	
TEST HOLE	
TRAFFIC PAINT MARKING	
TRAFFIC SIGNAL POLE AND MAST ARM	
UTILITY POLE	
VALVE (GAS)	
VALVE (IRRIGATION)	
VALVE (WATER)	
VEGETATION (HEDGE OR BUSH)	
VEGETATION (TREE STUMP)	
VEGETATION (TREE) (CALIPER SIZE NOTED)	
WATER HYDRANT	
WEIR	
YARD LIGHT	

NORTH ARROW:

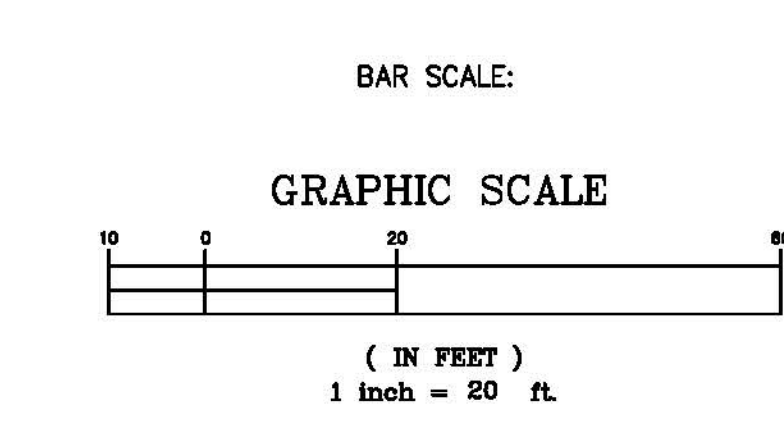

N:\Landed\proj\1\F10114 (DUCK POND SEWER IMPROV)\dwg\BASE-F10114.dwg, 2, 6/10/2008 8:59:07 AM

REVISION Δ	DESCRIPTION	DATE	DRAWN BY JCS	DATE 4-02
REVISION Δ			DESIGNED BY	DATE
REVISION Δ			CHECKED BY	DATE
REVISION Δ			APPROVED BY	DATE

SCALE	
PLAN	PROFILE
HORIZ. 1"=20'	HORIZ.
	VERT.



**PUBLIC WORKS AND UTILITIES ENGINEERING DIVISION**

**CITY OF GRAND JUNCTION STANDARD ABBREVIATIONS, LEGEND, AND SYMBOLS SHEET**

BID ALTERNATE A: OPEN TRENCH

ITEM NO.	CITY REF. NO.	CDOT/ DESCRIPTION	QUANTITY	UNITS
1	108.2	Imported Trench Backfill (including haul and disposal of unsuitable excavated material).	500	4500 TON
2	108.2	Fly Ash Fill Material.	1068	LF
3	108.2	6" Pressure Sewer Pipe (C-900, CLASS 150, DR-18, PVC).	50	LF
4	108.2	4" Gravity Sewer Pipe (SDR 35 PVC).	50	LF
5	108.2	8" Gravity Sewer Pipe (SDR 35 PVC).	145	LF
6	108.2	18" Gravity Sewer Pipe (SDR 35 PVC).	115	LF
7	108.2	24" Gravity Sewer Pipe (PVC)(SDR 35 or Profile Wall).	880	984 LF
8	108.2	24" Gravity Sewer Pipe (PVC)(SDR 35 or Profile Wall)(In Steel Casing).	1172	1068 LF
9	108.2	48" Dia. Steel Casing (Roll Plate, 1/2" wall thickness).	1068	LF
10	108.2	12" Irrigation Pipe (C-900, CLASS 150, DR-18, PVC).	35	LF
11	108.2	6" Water Main (C-900, CLASS 150, DR-18, PVC).	31	LF
12	108.2	24" Water Main (C-905, CLASS 165, DR-25, PVC).	695	LF
13	108.3	6" x 4" Sewer Service Connection.	3	EA
14	108.3	Cap Existing Water Service.	6	EA
15	108.3	6" DIP 90 degree bend.	1	EA
16	108.3	6" DIP 22 1/2 degree bend.	2	EA
17	108.3	24" DIP 90 degree bend.	1	EA
18	108.3	24" DIP 45 degree bend.	2	EA
19	108.3	24" PVC 45 degree bend.	1	EA
20	108.3	24" x 24" x 6" DIP Tee.	1	EA
21	108.3	24" x 16" Eccentric Reducer.	1	EA
22	108.3	6" Gate Valve.	1	EA
23	108.3	24" Butterfly Valve.	2	EA
24	108.4	3/4" Water Service Line (Type K Copper).	365	LF
25	108.4	24" x 3/4" Tapping Saddle.	12	EA
26	108.4	3/4" Corporation Stop.	12	EA
27	108.5	Connect to Existing Manhole (18" pipe).	1	EA
28	108.5	Connect to Existing Manhole (24" pipe).	1	EA
29	108.5	Temporary Manhole for Bypass Pumping (48" I.D.).	1	EA
30	108.5	Basic Manhole Components (48" I.D.)(Monitoring MH including 2" Sch 80 PVC Conduit).	1	EA
31	108.5	Sanitary Sewer Basic Manhole Components (48" I.D.)(Force Main Outlet).	1	EA
32	108.5	Manhole Barrel (D > 5') (48" I.D.)(Force Main Outlet).	1	LF
33	108.5	Sanitary Sewer Basic Manhole Components (60" I.D.).	8	EA
34	108.5	Manhole Barrel (D > 5') (60" I.D.).	132	LF
35	108.7	Granular Stabilization Material (Type B).	250	TON
36	201	Clearing and Grubbing.	1	LS
37	202	Abandon Manhole.	2	EA
38	202	Remove Structure/Obstruction.	1	LS
39	202	Remove Pipe.	1026	LF
40	202	Remove Valve and Return to City.	3	EA
41	202	Removal of Asphalt Pavement.	1540	SY
42	202	Abandon 18" Sanitary Sewer Pipe.	1	LS
43	202	Abandon 16" Sanitary Sewer Force Main.	1	LS
44	108.8/203	Rock Excavation.	4100	CY
45	207	Topsail (6" thick).	281	SY
46	209	Dust Abatement.	90	DAY
47	210	Reset Sprinkler System.	1	LS
48	210	Reset Post.	7	EA
49	212	Sod.	281	SY
50	304	Aggregate Base Course (Class 6)(4" thick).	1555	SY
51	304	Aggregate Base Course (Class 6)(6" thick).	1540	SY
52	401	Hot Bituminous Pavement (Grading SX, Binder Grade PG 64-22).	530	TON
53	620	Portable Sanitary Facility.	1	EA
54	625	Construction Surveying.	1	LS
55	626	Mobilization.	1	LS
56	629	Survey Monument (Complete in Place)(City Survey Monument).	1	EA
57	630	Traffic Control (Complete in Place).	1	LS
58	630	Traffic Control Plan.	1	LS
59	630	Flagging.	2000	Hour

BID ALTERNATE B: BORING

ITEM NO.	CITY REF. NO.	CDOT/ DESCRIPTION	QUANTITY	UNITS
1	108.2	Imported Trench Backfill (including haul and disposal of unsuitable excavated material).	2000	TON
2	108.2	Fly Ash Fill Material.	1680	LF
3	108.2	6" Pressure Sewer Pipe (C-900, CLASS 150, DR-18, PVC).	50	LF
4	108.2	4" Gravity Sewer Pipe (SDR 35 PVC).	50	LF
5	108.2	8" Gravity Sewer Pipe (SDR 35 PVC).	145	LF
6	108.2	18" Gravity Sewer Pipe (SDR 35 PVC).	115	LF
7	108.2	24" Gravity Sewer Pipe (PVC)(SDR 35 or Profile Wall).	372	LF
8	108.2	24" Gravity Sewer Pipe (PVC)(SDR 35 or Profile Wall)(In Steel Casing).	1680	LF
9	108.2	48" Dia. Steel Casing (Roll Plate, 1/2" wall thickness).	1680	LF
10	108.2	6" Water Main (C-900, CLASS 150, DR-18, PVC).	31	LF
11	108.2	24" Water Main (C-905, CLASS 165, DR-25, PVC).	695	LF
12	108.3	6" x 4" Sewer Service Connection.	3	EA
13	108.3	Cap Existing Water Service.	6	EA
14	108.3	6" DIP 90 degree bend.	1	EA
15	108.3	6" DIP 22 1/2 degree bend.	2	EA
16	108.3	24" DIP 90 degree bend.	1	EA
17	108.3	24" DIP 45 degree bend.	2	EA
18	108.3	24" PVC 45 degree bend.	1	EA
19	108.3	24" x 24" x 6" DIP Tee.	1	EA
20	108.3	24" x 16" Eccentric Reducer.	1	EA
21	108.3	6" Gate Valve.	1	EA
22	108.3	24" Butterfly Valve.	2	EA
23	108.4	3/4" Water Service Line (Type K Copper).	365	LF
24	108.4	24" x 3/4" Tapping Saddle.	12	EA
25	108.4	3/4" Corporation Stop.	12	EA
26	108.5	Connect to Existing Manhole (18" pipe).	1	EA
27	108.5	Connect to Existing Manhole (24" pipe).	1	EA
28	108.5	Temporary Manhole for Bypass Pumping (48" I.D.).	1	EA
29	108.5	Basic Manhole Components (48" I.D.)(Monitoring MH including 2" Sch 80 PVC Conduit).	1	EA
30	108.5	Sanitary Sewer Basic Manhole Components (48" I.D.)(Force Main Outlet).	1	EA
31	108.5	Manhole Barrel (D > 5') (48" I.D.)(Force Main Outlet).	1	LF
32	108.5	Sanitary Sewer Basic Manhole Components (60" I.D.).	8	EA
33	108.5	Manhole Barrel (D > 5') (60" I.D.).	132	LF
34	108.7	Granular Stabilization Material (Type B).	250	TON
35	201	Clearing and Grubbing.	1	LS
36	202	Abandon Manhole.	2	EA
37	202	Remove Structure/Obstruction.	1	LS
38	202	Remove Pipe.	441	LF
39	202	Remove Valve and Return to City.	3	EA
40	202	Removal of Asphalt Pavement.	1065	SY
41	202	Abandon 18" Sanitary Sewer Pipe.	1	LS
42	202	Abandon 16" Sanitary Sewer Force Main.	1	LS
43	108.8/203	Rock Excavation.	2000	CY
44	207	Topsail (6" thick).	281	SY
45	209	Dust Abatement.	60	DAY
46	210	Reset Sprinkler System.	1	LS
47	210	Reset Post.	7	EA
48	212	Sod.	281	SY
49	304	Aggregate Base Course (Class 6)(4" thick).	570	SY
50	304	Aggregate Base Course (Class 6)(6" thick).	1065	SY
51	401	Hot Bituminous Pavement (Grading SX, Binder Grade PG 64-22).	450	TON
52	620	Portable Sanitary Facility.	1	EA
53	625	Construction Surveying.	1	LS
54	626	Mobilization.	1	LS
55	629	Survey Monument (Complete in Place)(City Survey Monument).	1	EA
56	630	Traffic Control (Complete in Place).	1	LS
57	630	Traffic Control Plan.	1	LS
58	630	Flagging.	2000	Hour

CO1-1-108.2 Revised Fly Ash Fill Material. 1172 LF  
 CO1-2-108.2 42" or 48" Dia. Steel Casing (Roll Plate, 3/8" wall thickness). 1172 LF  
 CO1-3-626 Revised Mobilization. 1 LS  
 CO1-1-108.3 4" Gate Valve. 1 EA  
 CO1-2-108.3 6" Gate Valve. 5 EA  
 CO1-3-108.3 24" Butterfly Valve. 3 EA  
 CO1-4-108.3 24" DIP 90 degree bend. 1 EA  
 CO1-5-108.3 24" x 24" x 6" DIP Tee. 1 EA  
 CO1-6-108.3 6" x 6" x 6" DIP Tee. 1 EA  
 CO1-7-108.3 24" x 24" x 16" DIP Tee. 1 EA  
 CO1-8-108.3 24" x 24" x 6" DIP Tee. 1 EA  
 CO1-9-108.3 24" x 24" x 4" DIP Tee. 1 EA  
 CO1-10-108.3 24" x 24" x 24" DIP Tee. 1 EA  
 CO1-11-108.3 4" Water Main (C-900, CLASS 150, DR-18, PVC). 35 LF  
 CO1-12-108.3 Fire Hydrant. 1 EA  
 CO1-13-108.2 6" Storm Drain (C-900, CLASS 150, DR-18, PVC). 20 LF

N:\LandProc\10114 (DUCK POND SEWER IMPROV)\AS BUILT SHITS 1-13.dwg, 3, 6/10/2008 9:45:53 AM

REVISION  $\Delta$  CHANGES TO QUANTITIES - DATE 5/5/05  
 REVISION  $\Delta$  PER CHANGE ORDERS 1 & 2 -  
 DRAWN BY \_\_\_\_\_ DATE \_\_\_\_\_  
 DESIGNED BY \_\_\_\_\_ DATE \_\_\_\_\_  
 CHECKED BY \_\_\_\_\_ DATE \_\_\_\_\_  
 APPROVED BY \_\_\_\_\_ DATE \_\_\_\_\_

SCALE \_\_\_\_\_  
 N.T.S.



PUBLIC WORKS  
 AND UTILITIES  
 ENGINEERING DIVISION

DUCK POND PARK LIFT STATION  
 ELIMINATION AND GRAVITY SEWER CONSTRUCTION  
 SUMMARY OF APPROXIMATE QUANTITIES



PROJECT CONTROL DATA						
POINT	NORTHING	EASTING	STATION	OFFSET	ELEVATION	DESCRIPTION
702	30876.29	90338.28	2+82.29	38.43	4628.05	NO 5 REBAR MARKED DOE 1 AT THE EAST TOP OF BANK OF THE UNION PACIFIC RAILROAD
700	30208.76	90401.55			4629.01	GIS HINGE NAIL AT THE SOUTHWEST CORNER OF HIGH STREET
402	30209.28	90795.54	13+24.64	6.15	4629.15	CITY SURVEY MONUMENT AT THE INTERSECTION OF CANON AND GRAND MESA AVE
407	29517.07	90797.60	20+39.50	17.40	4624.08	CITY SURVEY MONUMENT AT THE INTERSECTION OF CANON AND SANTA CLARA

N:\LandPkg\F10114 (DUCK POND SEWER IMPROV)\dwg\BASE-F10114.dwg, 4, 6/10/2008 8:54:29 AM

REVISION	DESCRIPTION	DATE	DRAWN BY	DATE
REVISION			DESIGNED BY	DATE
REVISION			CHECKED BY	DATE
REVISION			APPROVED BY	DATE

SCALE  
N.T.S.



**PUBLIC WORKS  
AND UTILITIES  
ENGINEERING DIVISION**



**DUCK POND PARK LIFT STATION  
ELIMINATION AND GRAVITY SEWER CONSTRUCTION  
SURVEY CONTROL PLAN**

N:\Lamp\proj\F10114 (DUCK POND SEWER IMPROV).dwg BASE-F10114 rev 7-7-05.dwg 5, 6/10/2008 8:55:02 AM

POINT	NORTHING	EASTING	STATION	OFFSET	ELEVATION	DESCRIPTION
702	30876.29	90338.28	2+82.29	38.43	4628.05	NO 5 REBAR
700	30208.76	90401.55			4629.01	GIS HINGE NAIL
402	30209.28	90795.54	13+24.64	8.15	4629.15	CITY SURVEY MONUMENT
407	29517.07	90787.60	20+39.50	17.40	4624.08	CITY SURVEY MONUMENT


2945-233-15-001  
RANDY D. VANGUNDY C/O  
DEAN H. VANGUNDY  
P.O. BOX 4233  
GRAND JUNCTION, CO 81502

2945-233-15-004  
RANDY D. VANGUNDY  
C/O DEAN H. VANGUNDY  
P.O. BOX 4233  
GRAND JUNCTION, CO 81502

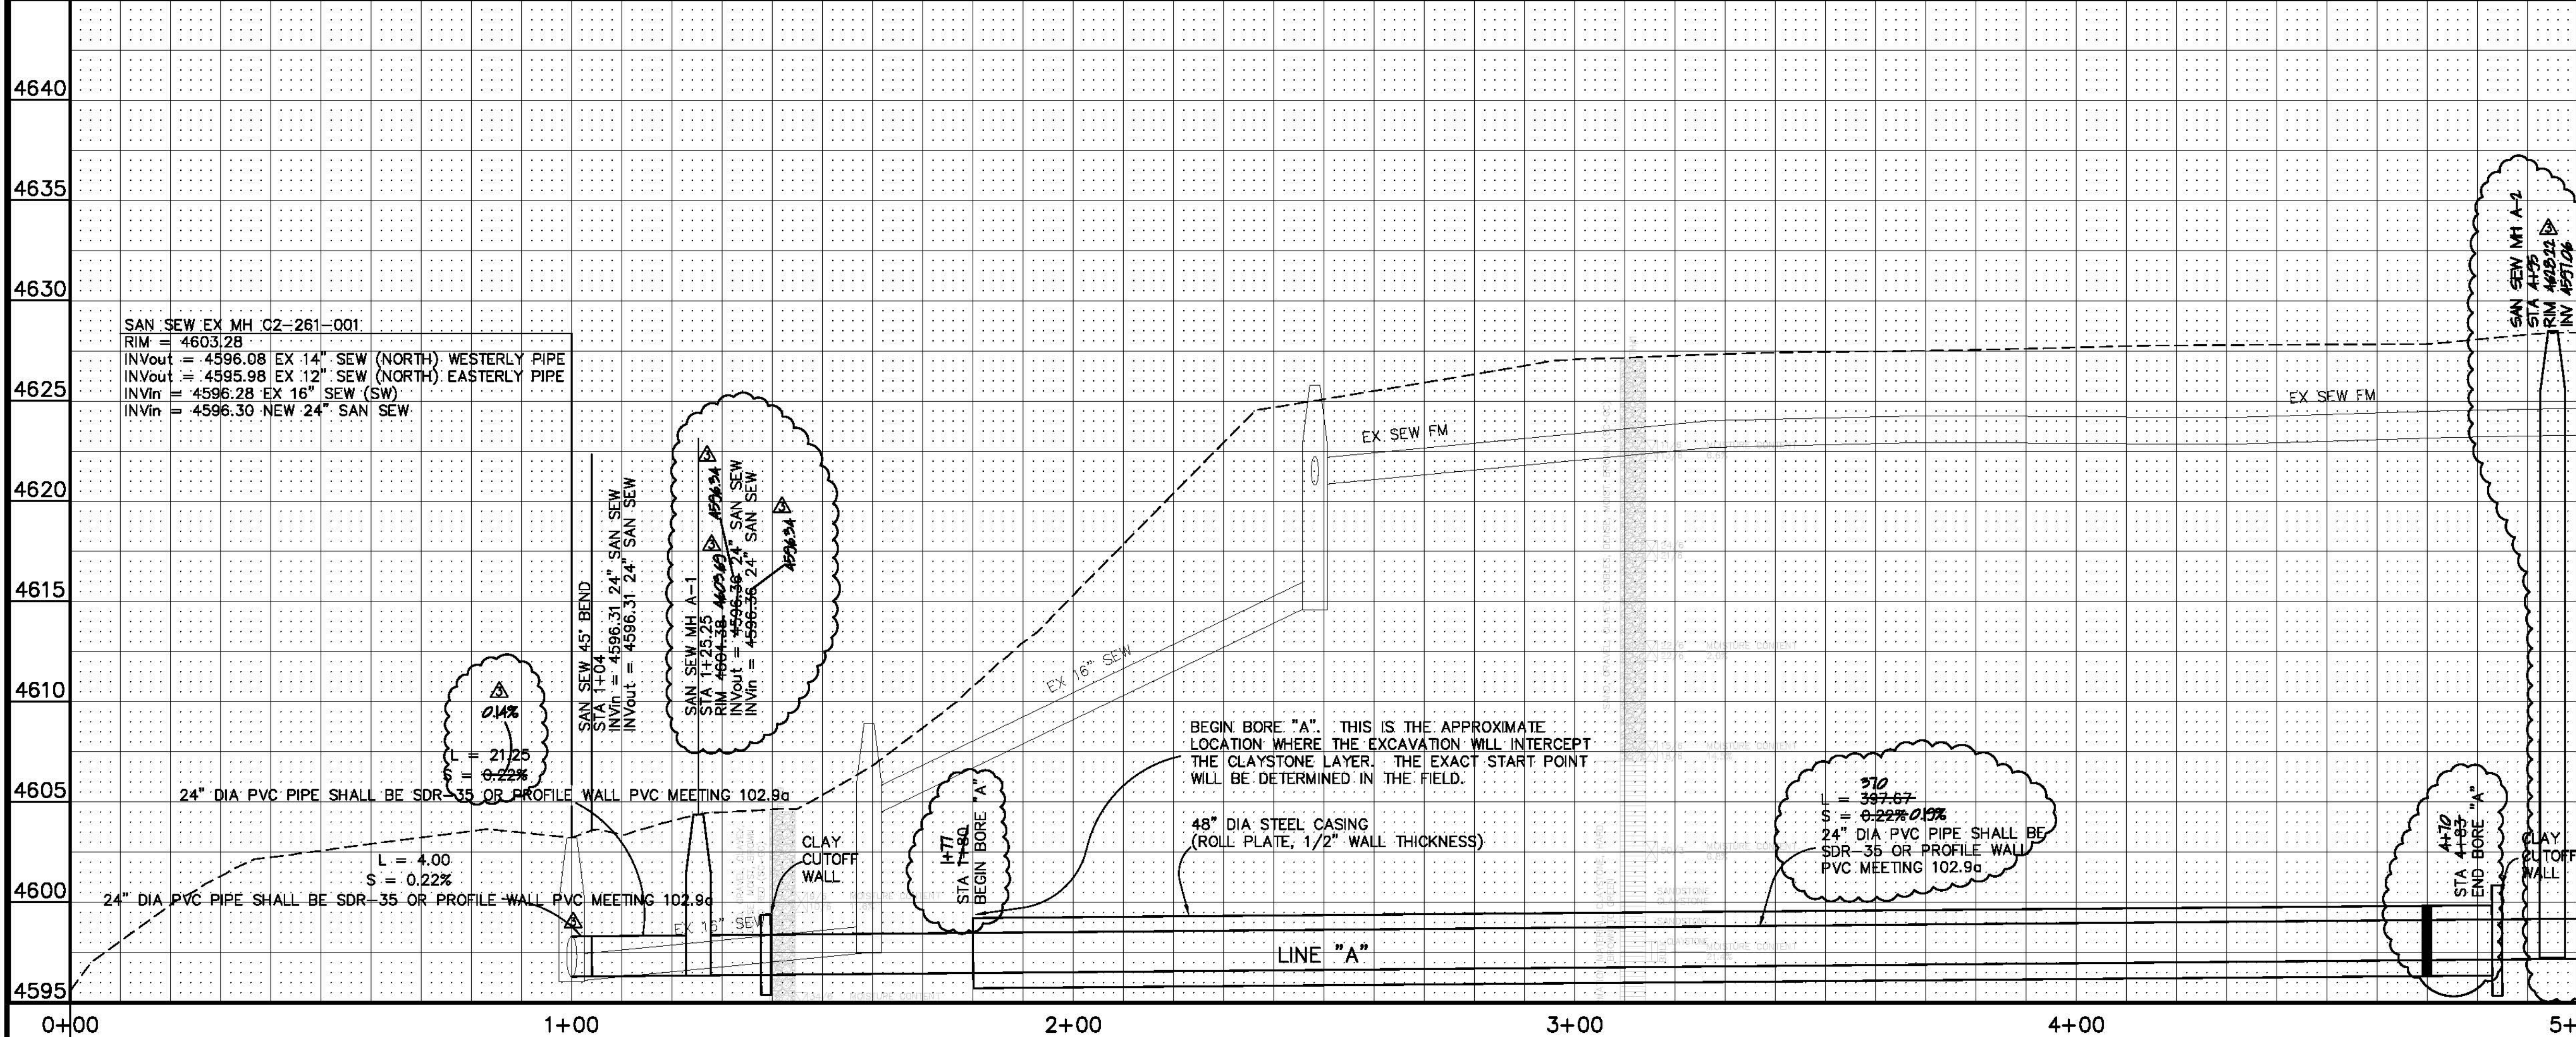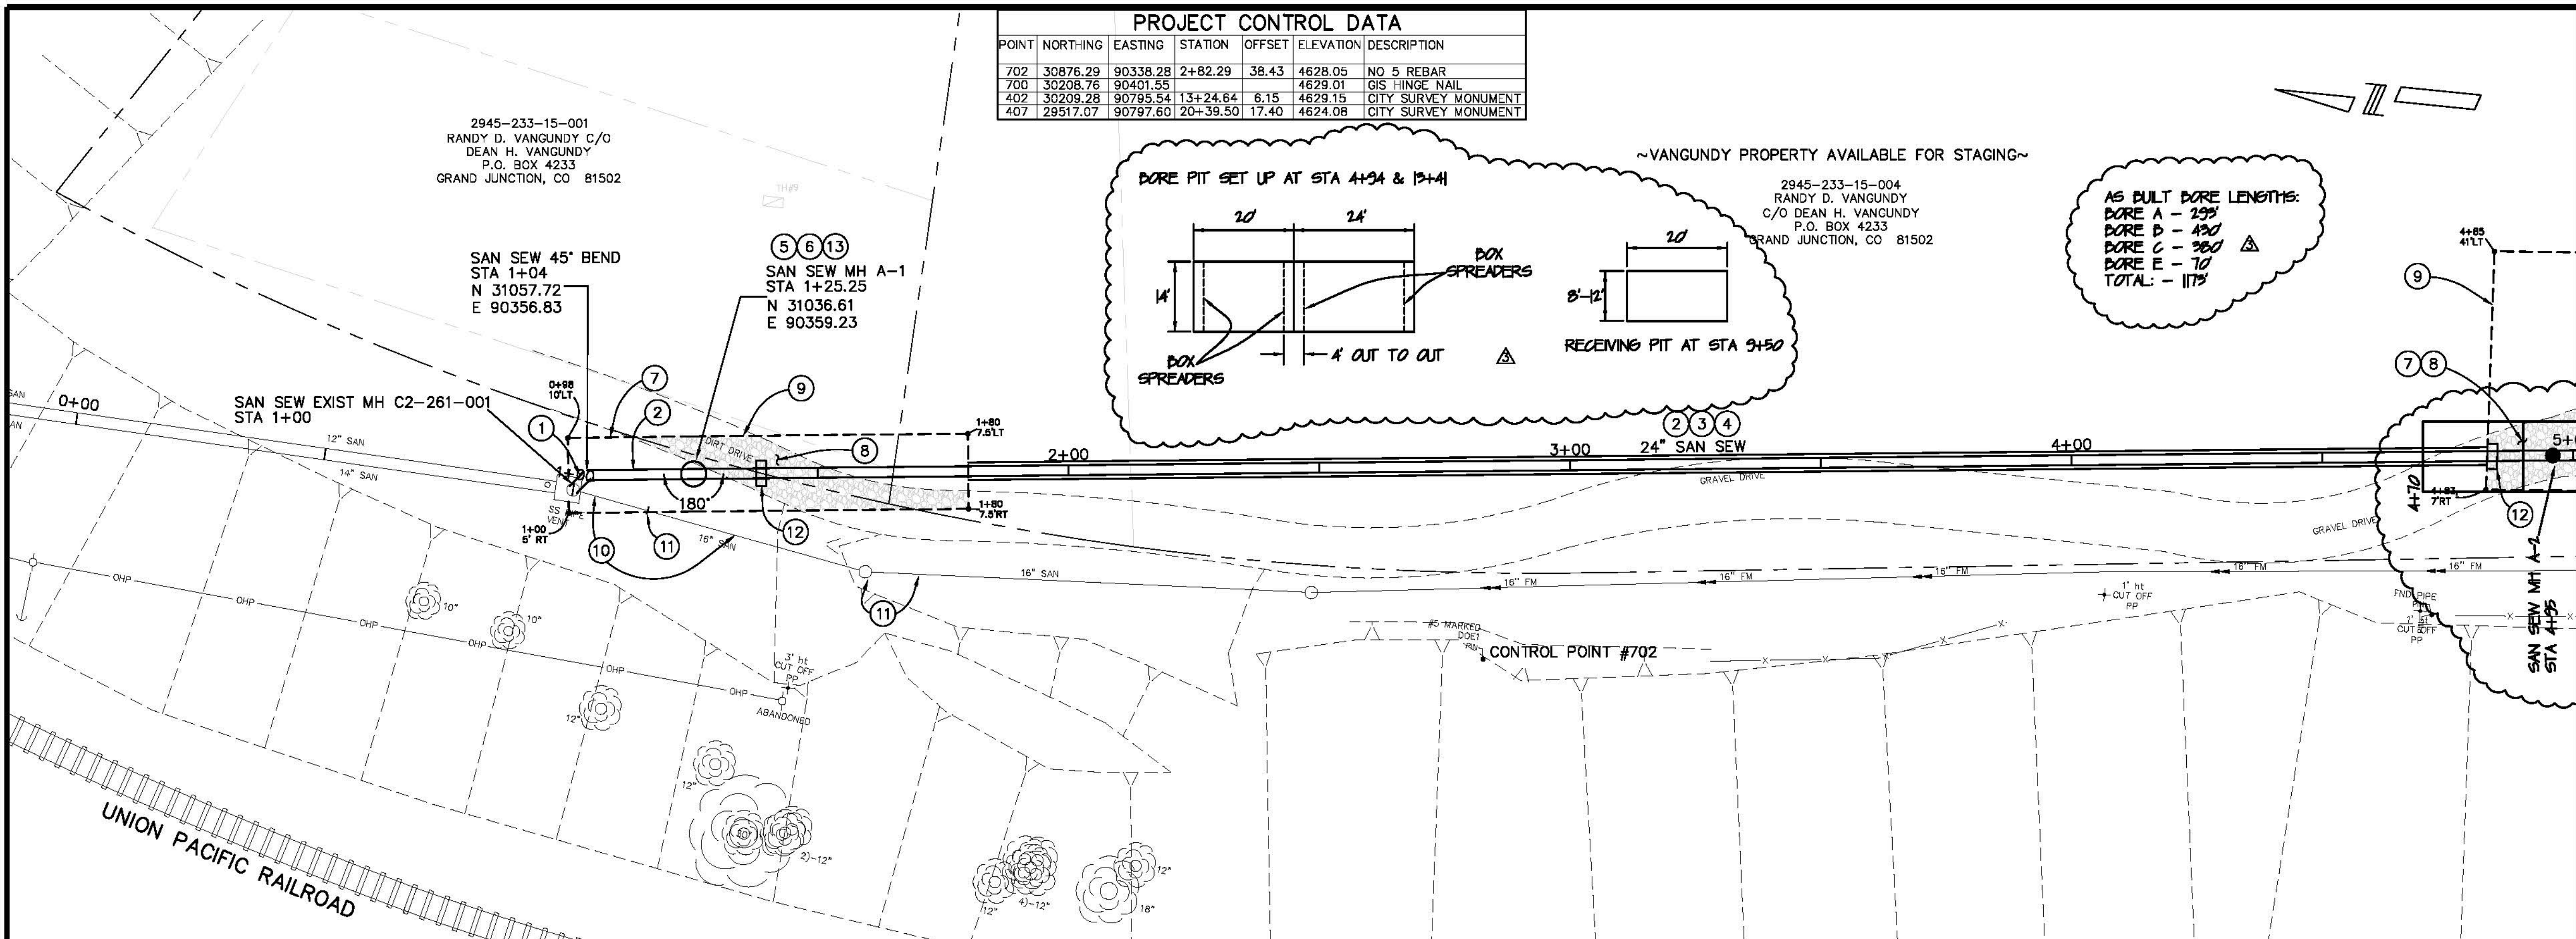

PROJECT NO. 904-F10114  
CONSTRUCTION NOTES

- 1 102.9A/102.11 - 45° BEND, 24" GRAVITY SEWER PIPE (SDR-35 PVC) CONNECT TO EXISTING MANHOLE (24" PIPE)
- 2 102.9A - 24" GRAVITY SEWER PIPE. PIPE SHALL BE SDR-35 OR PROFILE WALL PVC MEETING 102.9A.
- 3 102.9A - 48" DIA. STEEL CASING (ROLL PLATE, 1/2" WALL THICKNESS)
- 4 104.2A - INSTALL SEWER PIPE BY BORING AND JACKING. SET CARRIER PIPE TO GRADE USING CUSTOM STEEL SUPPORTS AND FILL ANNULAR SPACE WITH FLY ASH MIXTURE PER PROJECT SPECIAL PROVISIONS. SEAL ENDS OF CASING TO FACILITATE INSTALLATION OF FLY ASH MIXTURE.
- 5 102.11 - SANITARY SEWER BASIC MANHOLE COMPONENTS (60" I.D.). (SEE CITY OF GRAND JUNCTION STANDARD DETAIL SS-02).
- 6 102.11 - MANHOLE BARREL (D>5") (60" I.D.). (SEE CITY OF GRAND JUNCTION STANDARD DETAIL SS-02).
- 7 103.14 - BACKFILL EXCAVATIONS WITH NATIVE MATERIAL MEETING 103.16 EARTH BACKFILL MATERIAL.
- 8 304 - AGGREGATE BASE COURSE (CLASS 6) (4" THICK)
- 9 LIMITS OF EXCAVATION
- 10 EXISTING MANHOLE CONTAINS A BAFFLE WALL WHICH DIVERTS THE MAJORITY OF SEWER FLOWS FROM THE 16" UPSTREAM GRAVITY SEWER TO THE 14" DOWNSTREAM GRAVITY SEWER. THE BAFFLE WALL WILL NEED TO BE TEMPORARILY EXTENDED UP DURING THE CONNECTION OF THE 24" PVC TO THE EXISTING MANHOLE SO AS TO DIVERT ALL SEWER FLOWS INTO THE 14" DOWNSTREAM GRAVITY SEWER PIPE, ELIMINATE FLOWS TO THE OTHER 12" DOWNSTREAM GRAVITY SEWER PIPE, AND THEREBY FREE UP THE MANHOLE ON THE EASTERLY SIDE OF THE BAFFLE FOR WORK.
- 11 ABANDON EXISTING 16" FORCE MAIN SEWER. MARK END OF EXISTING REMAINING SEWER PIPE WITH 4 X 4 GREEN TREATED TIMBER POST. ALL MANHOLES ON FORCE MAIN SHALL REMAIN IN PLACE.
- 12 103.10 - CUTOFF WALL. THE CONTRACT UNIT PRICE FOR GRAVITY SEWER PIPE SHALL INCLUDE THE COST OF CUTOFF WALLS.
- 13 PIPE SHALL BE LAID CONTINUOUSLY THROUGH MANHOLE PROVIDING A PVC INVERT. THE CONTRACT UNIT PRICE FOR SANITARY SEWER BASIC MANHOLE SHALL INCLUDE THE COST OF PROVIDING A PVC INVERT.

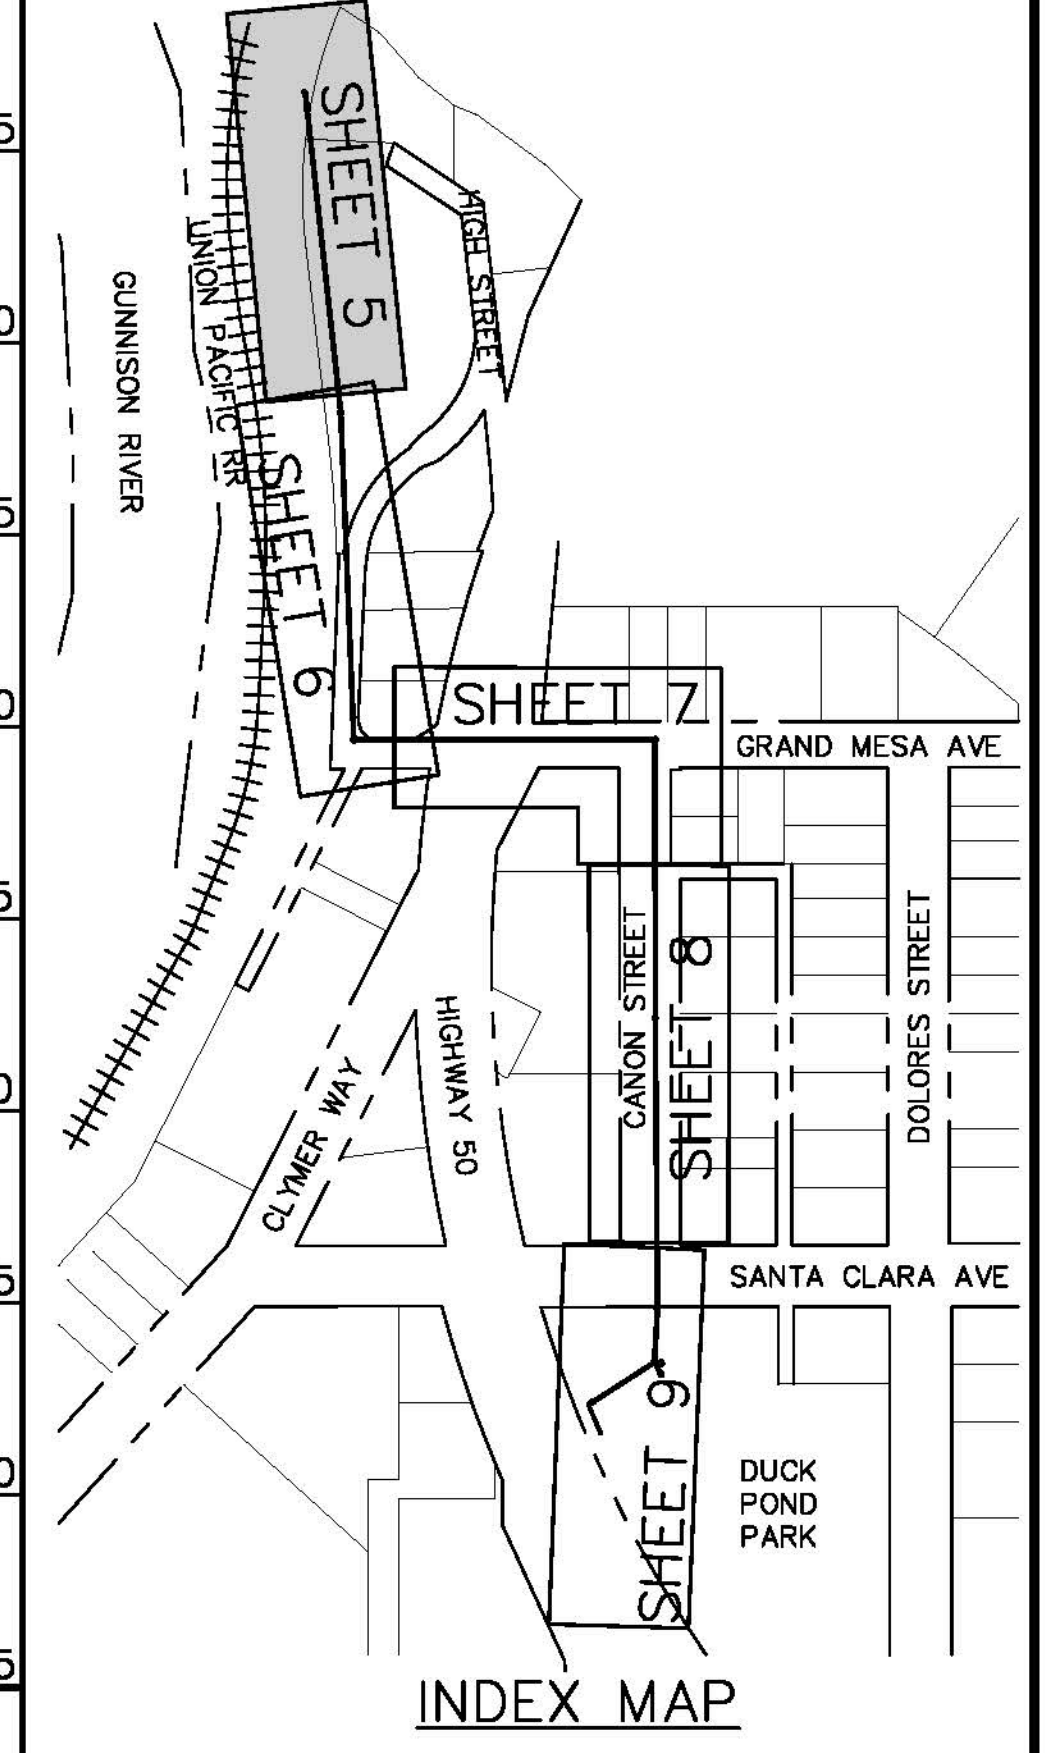


REVISION	DESCRIPTION	DATE	DRAWN BY	DATE
AS BUILT		2007-10-17	JCS	2005
DESIGNED BY				
CHECKED BY				
APPROVED BY				



**PUBLIC WORKS AND UTILITIES ENGINEERING DIVISION**

**DUCK POND PARK LIFT STATION ELIMINATION AND GRAVITY SEWER CONSTRUCTION SANITARY SEWER PLAN AND PROFILES ADJACENT TO UNION PACIFIC RAILROAD**

N:\Lands\Proj\F10114 (DUCK POND SEWER IMPROV)\dwg\BASE-F10114 rev 7-7-05.dwg, 6/10/2008 8:56:11 AM


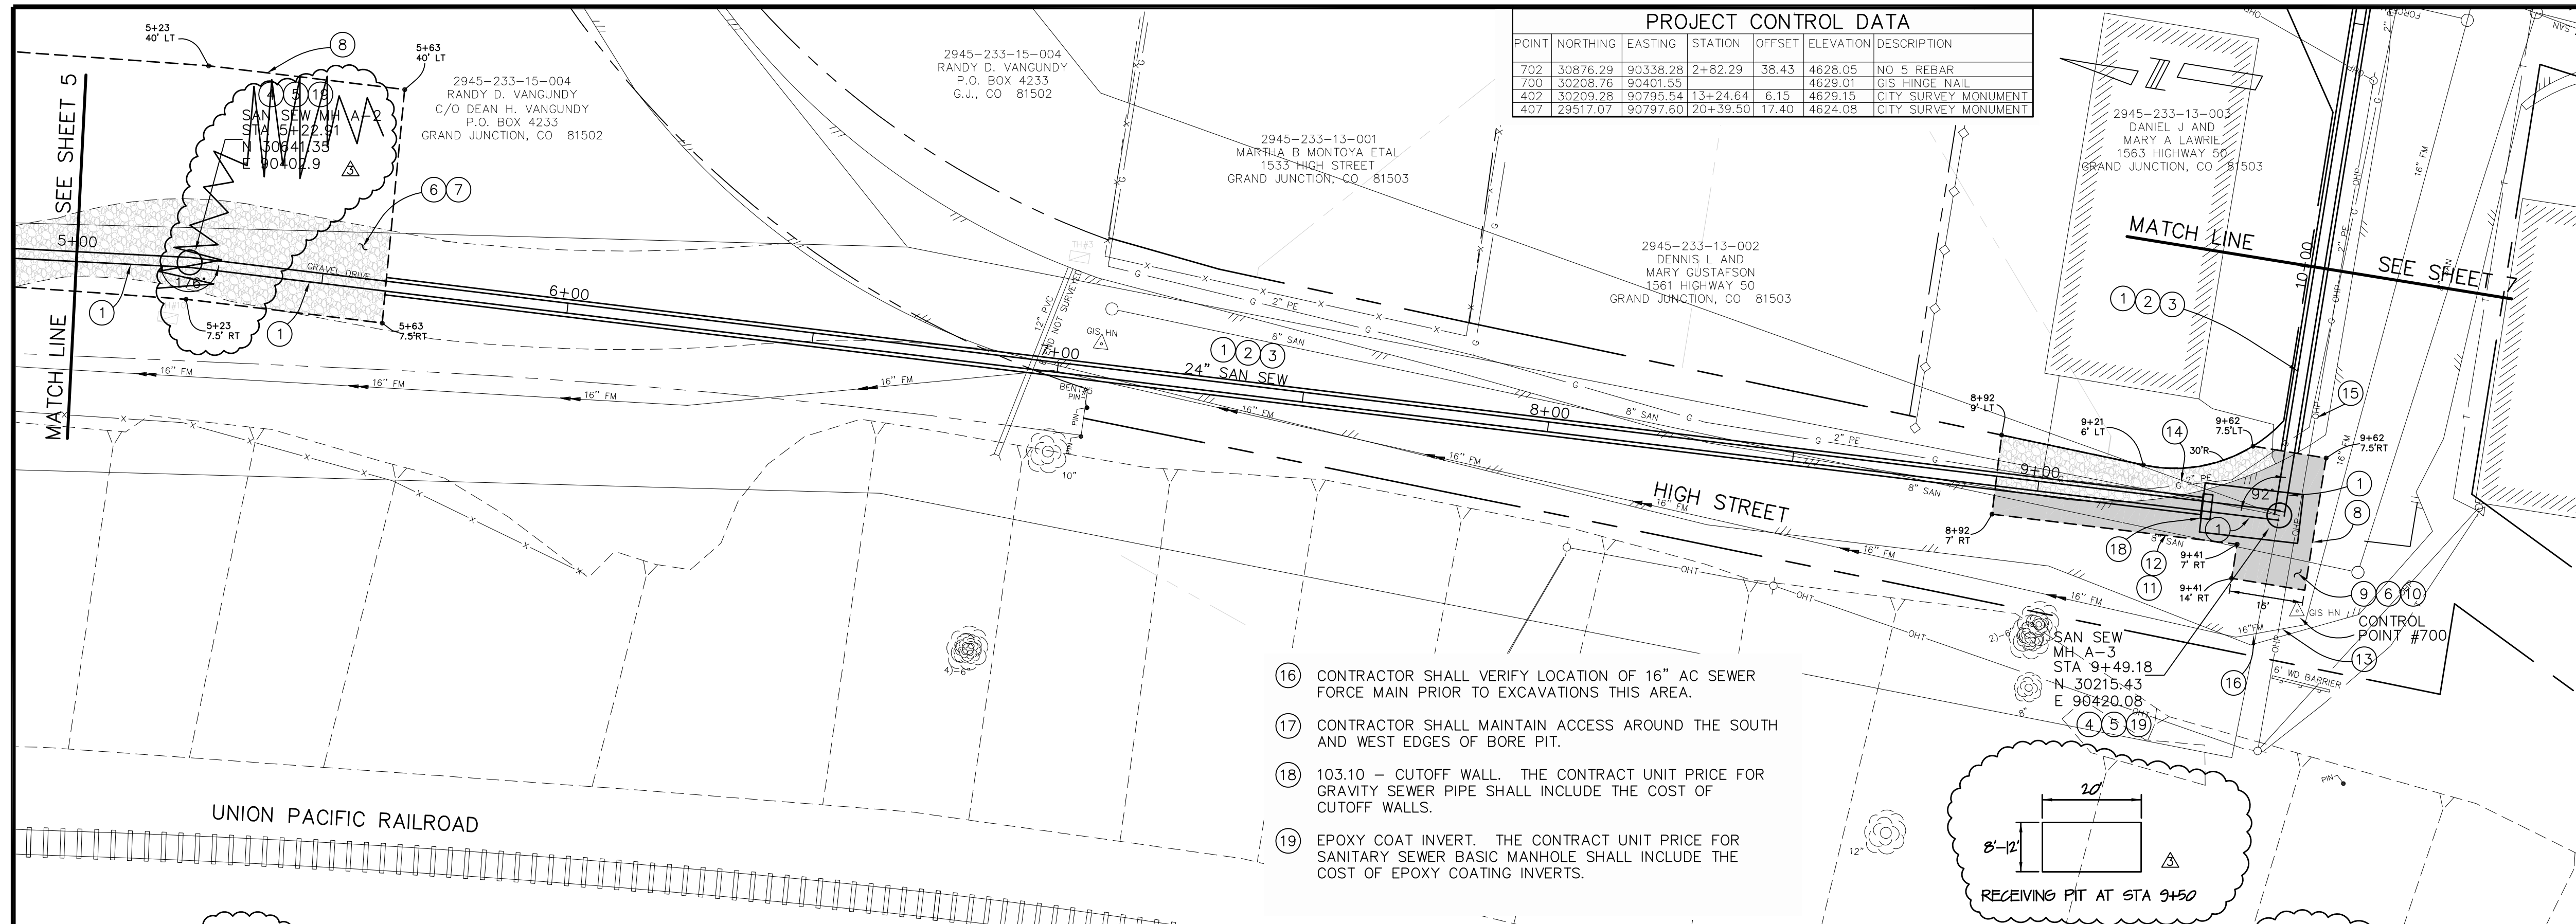


PROJECT CONTROL DATA						
POINT	NORTHING	EASTING	STATION	OFFSET	ELEVATION	DESCRIPTION
702	30876.29	90338.28	2+82.29	38.43	4628.05	NO 5 REBAR
700	30208.76	90401.55			4629.01	GIS HINGE NAIL
402	30209.28	90795.54	13+24.64	6.15	4629.15	CITY SURVEY MONUMENT
407	29517.07	90797.60	20+39.50	17.40	4624.08	CITY SURVEY MONUMENT


PROJECT NO. 904-F10114

CONSTRUCTION NOTES

- 1 102.9A - 24" GRAVITY SEWER PIPE. PIPE SHALL BE SDR-35 OR PROFILE WALL PVC MEETING 102.9A.
- 2 102.9A - 48" DIA. STEEL CASING (ROLL PLATE, 1/2" WALL THICKNESS)
- 3 104.2A - INSTALL SEWER PIPE BY BORING AND JACKING. SET CARRIER PIPE TO GRADE USING CUSTOM STEEL SUPPORTS AND FILL ANNULAR SPACE WITH FLY ASH MIXTURE PER PROJECT SPECIAL PROVISIONS. SEAL ENDS OF CASING TO FACILITATE INSTALLATION OF FLY ASH MIXTURE.
- 4 102.11 - SANITARY SEWER BASIC MANHOLE COMPONENTS (60" I.D.) (SEE CITY OF GRAND JUNCTION STANDARD DETAIL SS-02).
- 5 102.11 - MANHOLE BARREL (D>5') (60" I.D.) (SEE CITY OF GRAND JUNCTION STANDARD DETAIL SS-02).
- 6 103.14 - BACKFILL EXCAVATIONS WITH NATIVE MATERIAL MEETING 103.16 EARTH BACKFILL MATERIAL.
- 7 304 - AGGREGATE BASE COURSE (CLASS 6) (4" THICK)
- 8 LIMITS OF EXCAVATION
- 9 103.3 - ASPHALT REMOVAL: CUT AND REMOVE PAVEMENT AS SHOWN.
- 10 401-HOT BITUMINOUS PAVEMENT (3" THICK) (GRADING SX)  
304 - AGGREGATE BASE COURSE (CLASS 6) (6" THICK) (SEE CITY OF GRAND JUNCTION STANDARD DETAIL GU-03)
- 11 202 - REMOVE PIPE AS NEEDED FOR EXCAVATION.
- 12 102.9A - 8" GRAVITY SEWER PIPE (SDR-35 PVC).  
4" GRAVITY SEWER PIPE (SDR-35 PVC).  
SERVICE "Y" CONNECTION  
REPLACE SEWER MAIN AND SEWER SERVICE AS NEEDED FOR EXCAVATION OF BORE PIT. 8" SANITARY SEWER AND 4" SANITARY SEWER SERVICE TO 1563 HIGHWAY 50 SHALL REMAIN OPERATIONAL DURING CONSTRUCTION. THE COST OF CONNECTIONS TO EXISTING PIPE AND BYPASS PUMPING SEWER FLOWS WILL BE CONSIDERED INCIDENTAL AND WILL NOT BE MEASURED AND PAID FOR SEPARATELY.
- 13 PROTECT 16" AC SEWER FORCE MAIN. 16" AC SEWER FORCE MAIN SHALL REMAIN IN SERVICE DURING CONSTRUCTION.
- 14 EXISTING GAS LINE TO BE RELOCATED BY EXCEL ENERGY.
- 15 PROTECT OVERHEAD POWER LINE. OVERHEAD POWER LINE SHALL REMAIN IN SERVICE DURING CONSTRUCTION.

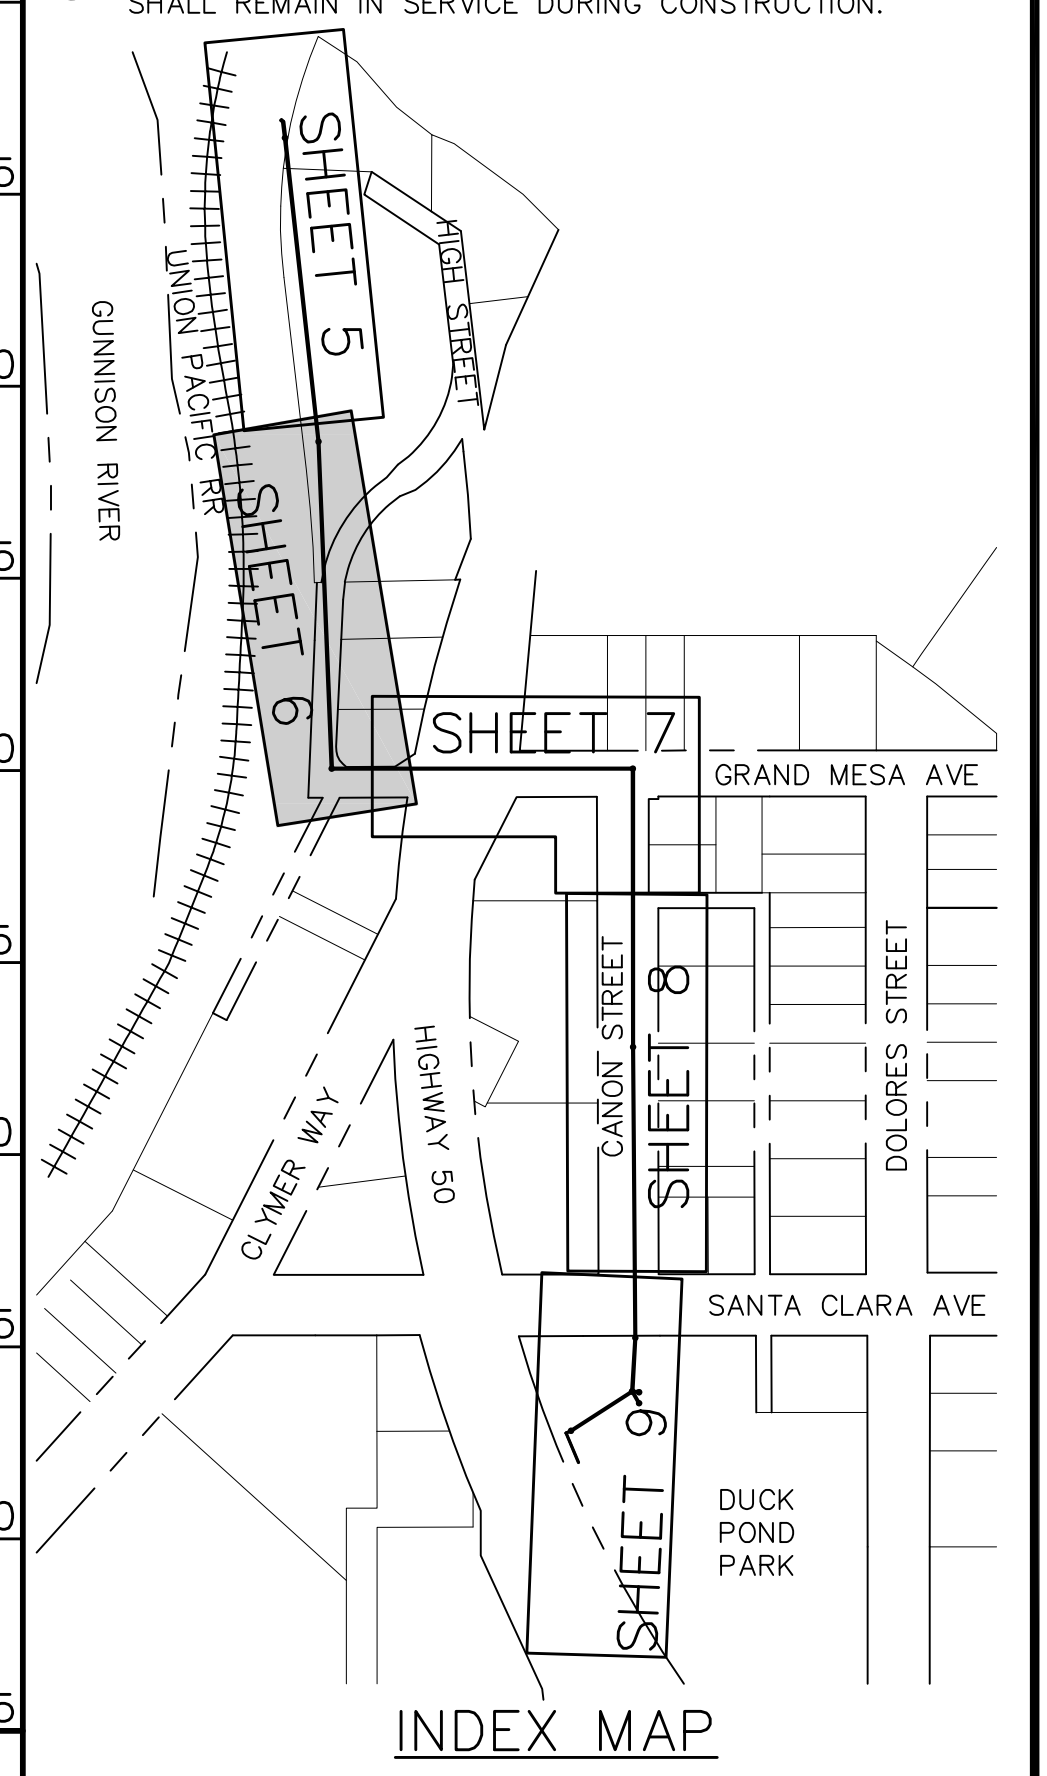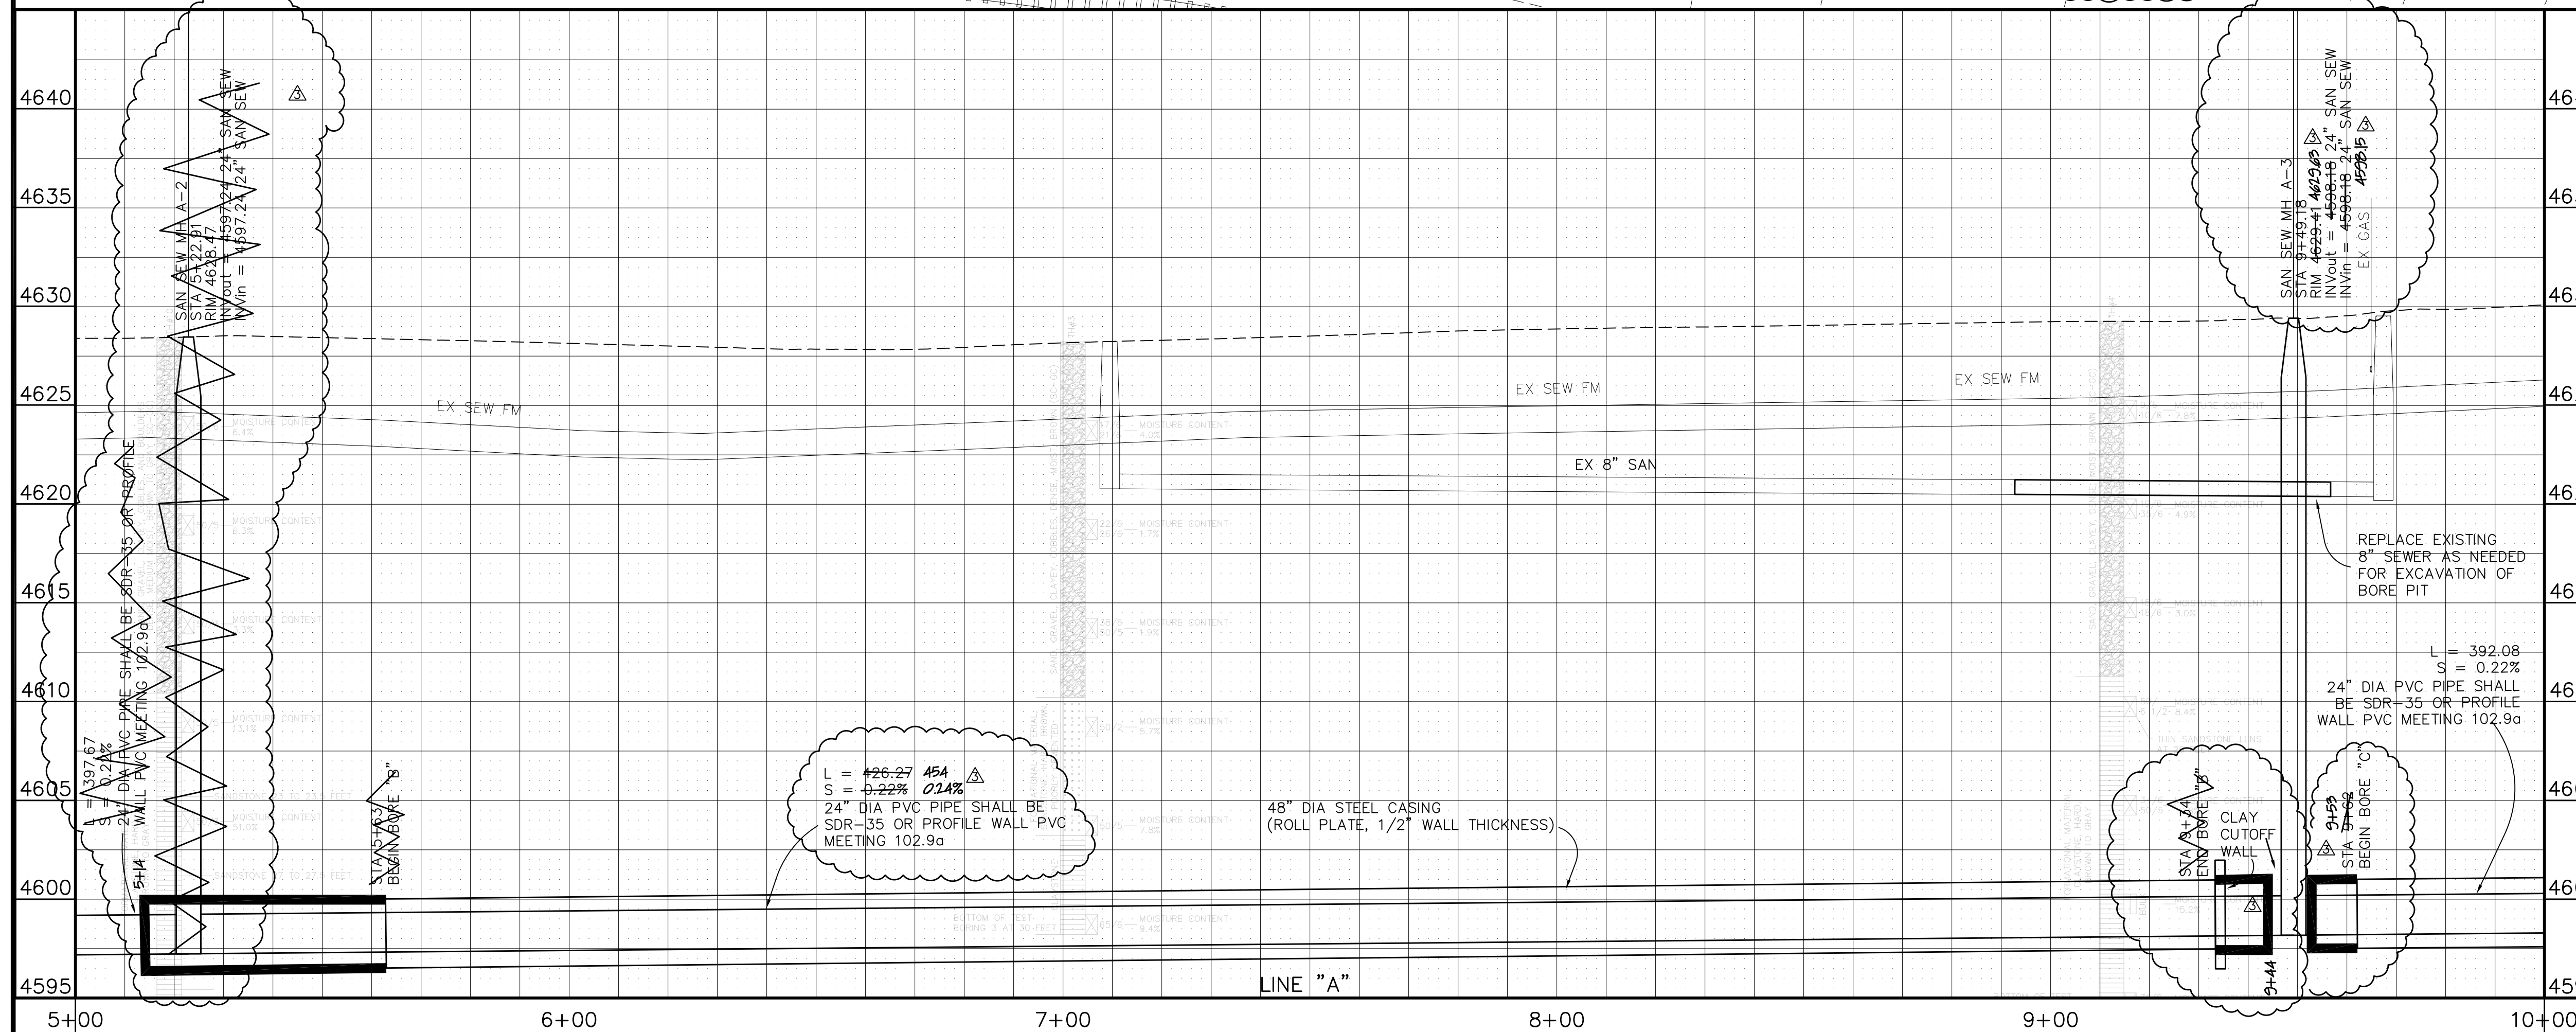

REVISION	DESCRIPTION	DATE	DRAWN BY	DATE
AS	BUILT	2007-10-17	JCS	2005

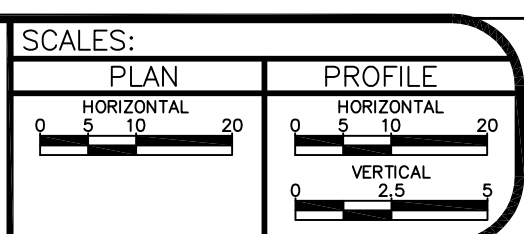

PUBLIC WORKS AND UTILITIES ENGINEERING DIVISION

DUCK POND PARK LIFT STATION ELIMINATION AND GRAVITY SEWER CONSTRUCTION SANITARY SEWER PLAN AND PROFILES HIGH STREET

CONSTRUCTION NOTES




- 1 102.9A - 24" GRAVITY SEWER PIPE. PIPE SHALL BE SDR-35 OR PROFILE WALL PVC MEETING 102.9a.
- 2 102.9A - 48" DIA. STEEL CASING (ROLL PLATE, 1/2" WALL THICKNESS)
- 3 104.2A - INSTALL SEWER PIPE BY BORING AND JACKING. SET CARRIER PIPE TO GRADE USING CUSTOM STEEL SUPPORTS AND FILL ANNUAL SPACE WITH FLY ASH MIXTURE PER PROJECT SPECIAL PROVISIONS. SEAL ENDS OF CASING TO FACILITATE INSTALLATION OF FLY ASH MIXTURE.
- 4 102.11 - SANITARY SEWER BASIC MANHOLE COMPONENTS (60" I.D.) (SEE CITY OF GRAND JUNCTION STANDARD DETAIL SS-02).
- 5 102.11 - MANHOLE BARREL (D>5') (60" I.D.) (SEE CITY OF GRAND JUNCTION STANDARD DETAIL SS-02).
- 6 103.14 - BACKFILL EXCAVATIONS WITH NATIVE MATERIAL MEETING 103.16 EARTH BACKFILL MATERIAL.
- 7 LIMITS OF EXCAVATION
- 8 103.3 - ASPHALT REMOVAL: CUT AND REMOVE PAVEMENT AS SHOWN.
- 9 401-HOT BITUMINOUS PAVEMENT (3" THICK) (GRADING SX) 304 - AGGREGATE BASE COURSE (CLASS 6) (6" THICK) (SEE CITY OF GRAND JUNCTION STANDARD DETAIL GU-03)
- 10 202 - REMOVE PIPE AS NEEDED FOR EXCAVATION.
- 11 102.9A - 8" GRAVITY SEWER PIPE (SDR-35 PVC). REPLACE AS NEEDED FOR EXCAVATION OF BORE PIT. 8" SANITARY SEWER SHALL REMAIN OPERATIONAL DURING CONSTRUCTION. THE COST OF CONNECTIONS TO EXISTING PIPE AND BYPASS PUMPING SEWER FLOWS WILL BE CONSIDERED INCIDENTAL AND WILL NOT BE MEASURED AND PAID FOR SEPARATELY.
- 12 GAS LINE RESET BY OTHERS.
- 13 LIMITS OF EXCAVATION. IF THE BORE ALTERNATE IS SELECTED, ACCESS PIT DIMENSIONS AND LOCATIONS MAY BE SELECTED BY THE CONTRACTOR BUT MUST BE WITHIN THE LIMITS OF EXCAVATION.
- 14 202 - REMOVE PIPE - ABANDONED 8" FORCE MAIN TO BE REMOVED AS NEEDED FOR EXCAVATION.
- 15 304 - AGGREGATE BASE COURSE (CLASS 6) (4" THICK)
- 16 SEE SHEET 10 FOR WATER LINE REPLACEMENT
- 17 EXISTING GAS LINE TO BE RELOCATED BY XCEL ENERGY TO THIS PROPOSED LOCATION.

BID ALTERNATE:

- A: 1(18)  
- OR -  
B: 1(23)

PROJECT CONTROL DATA

POINT	NORTHING	EASTING	STATION	OFFSET	ELEVATION	DESCRIPTION
702	30876.29	90338.28	2+R2.29	38.43	4628.05	NO 5 REBAR
700	30208.76	90407.55			4629.01	CIS HINGE NAIL
402	30209.28	90795.54	13+24.64	6.15	4629.15	CITY SURVEY MONUMENT
407	29517.07	90797.60	20+39.50	17.40	4624.08	CITY SURVEY MONUMENT

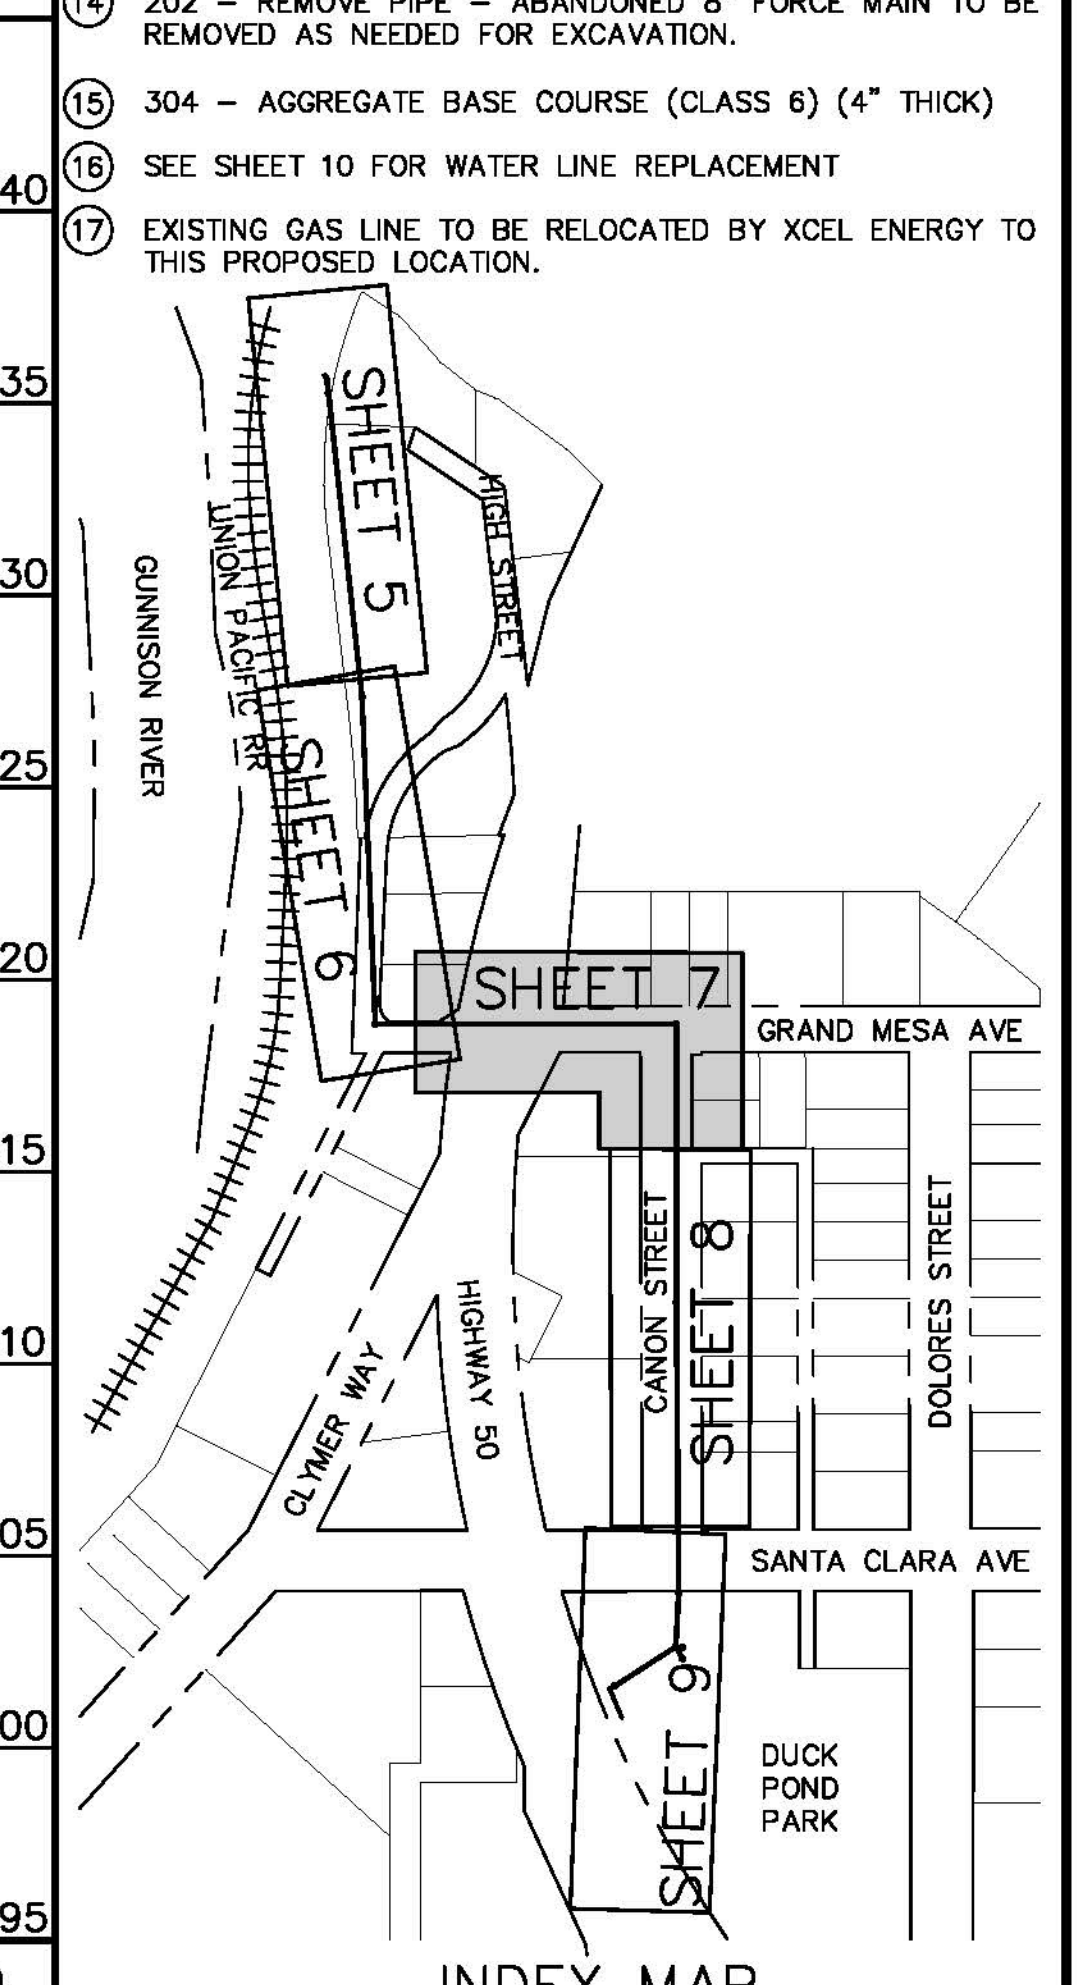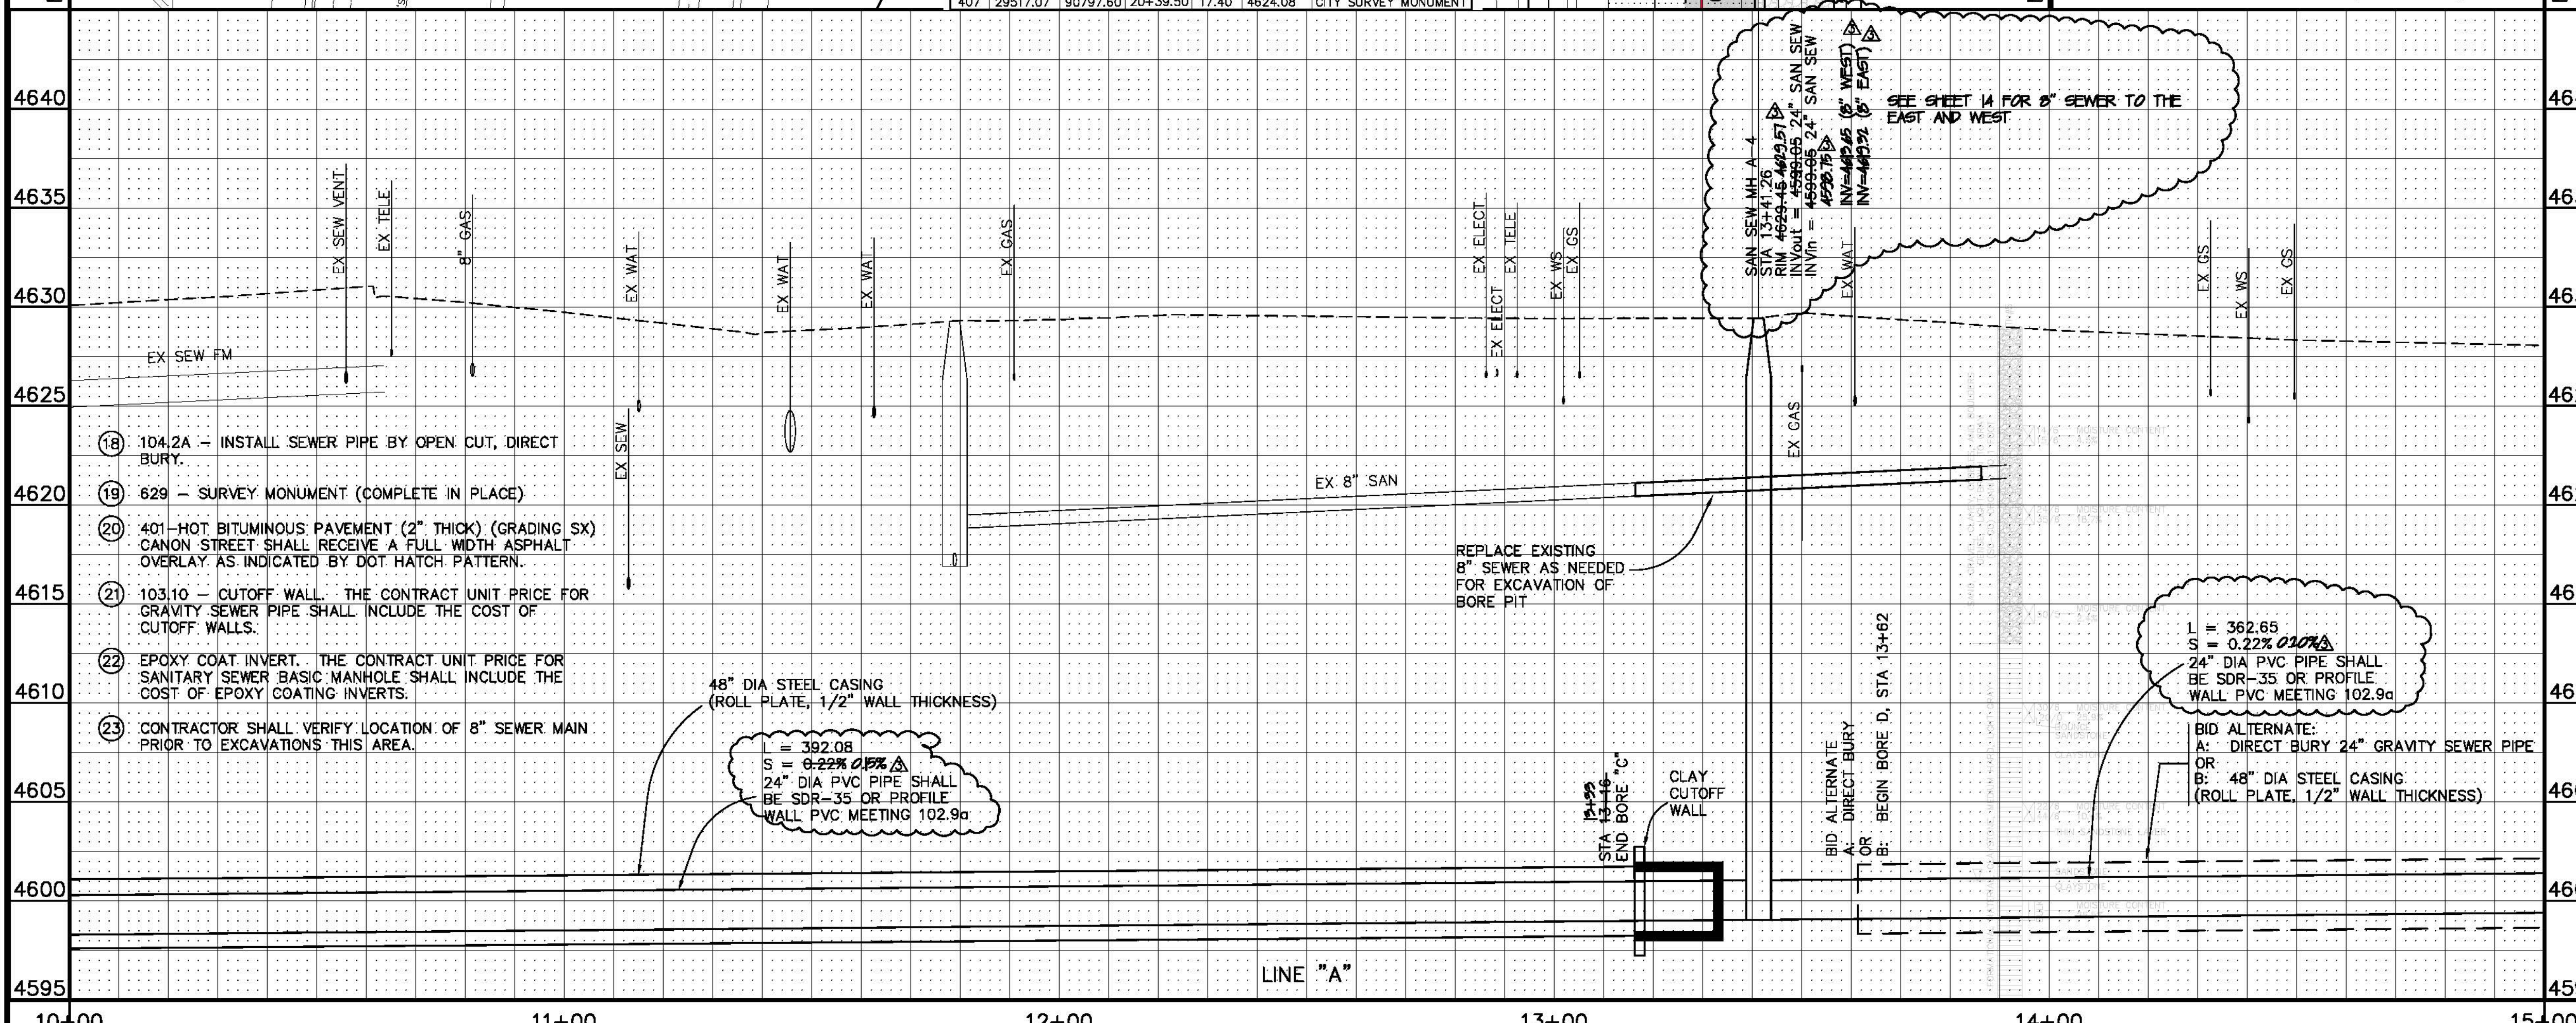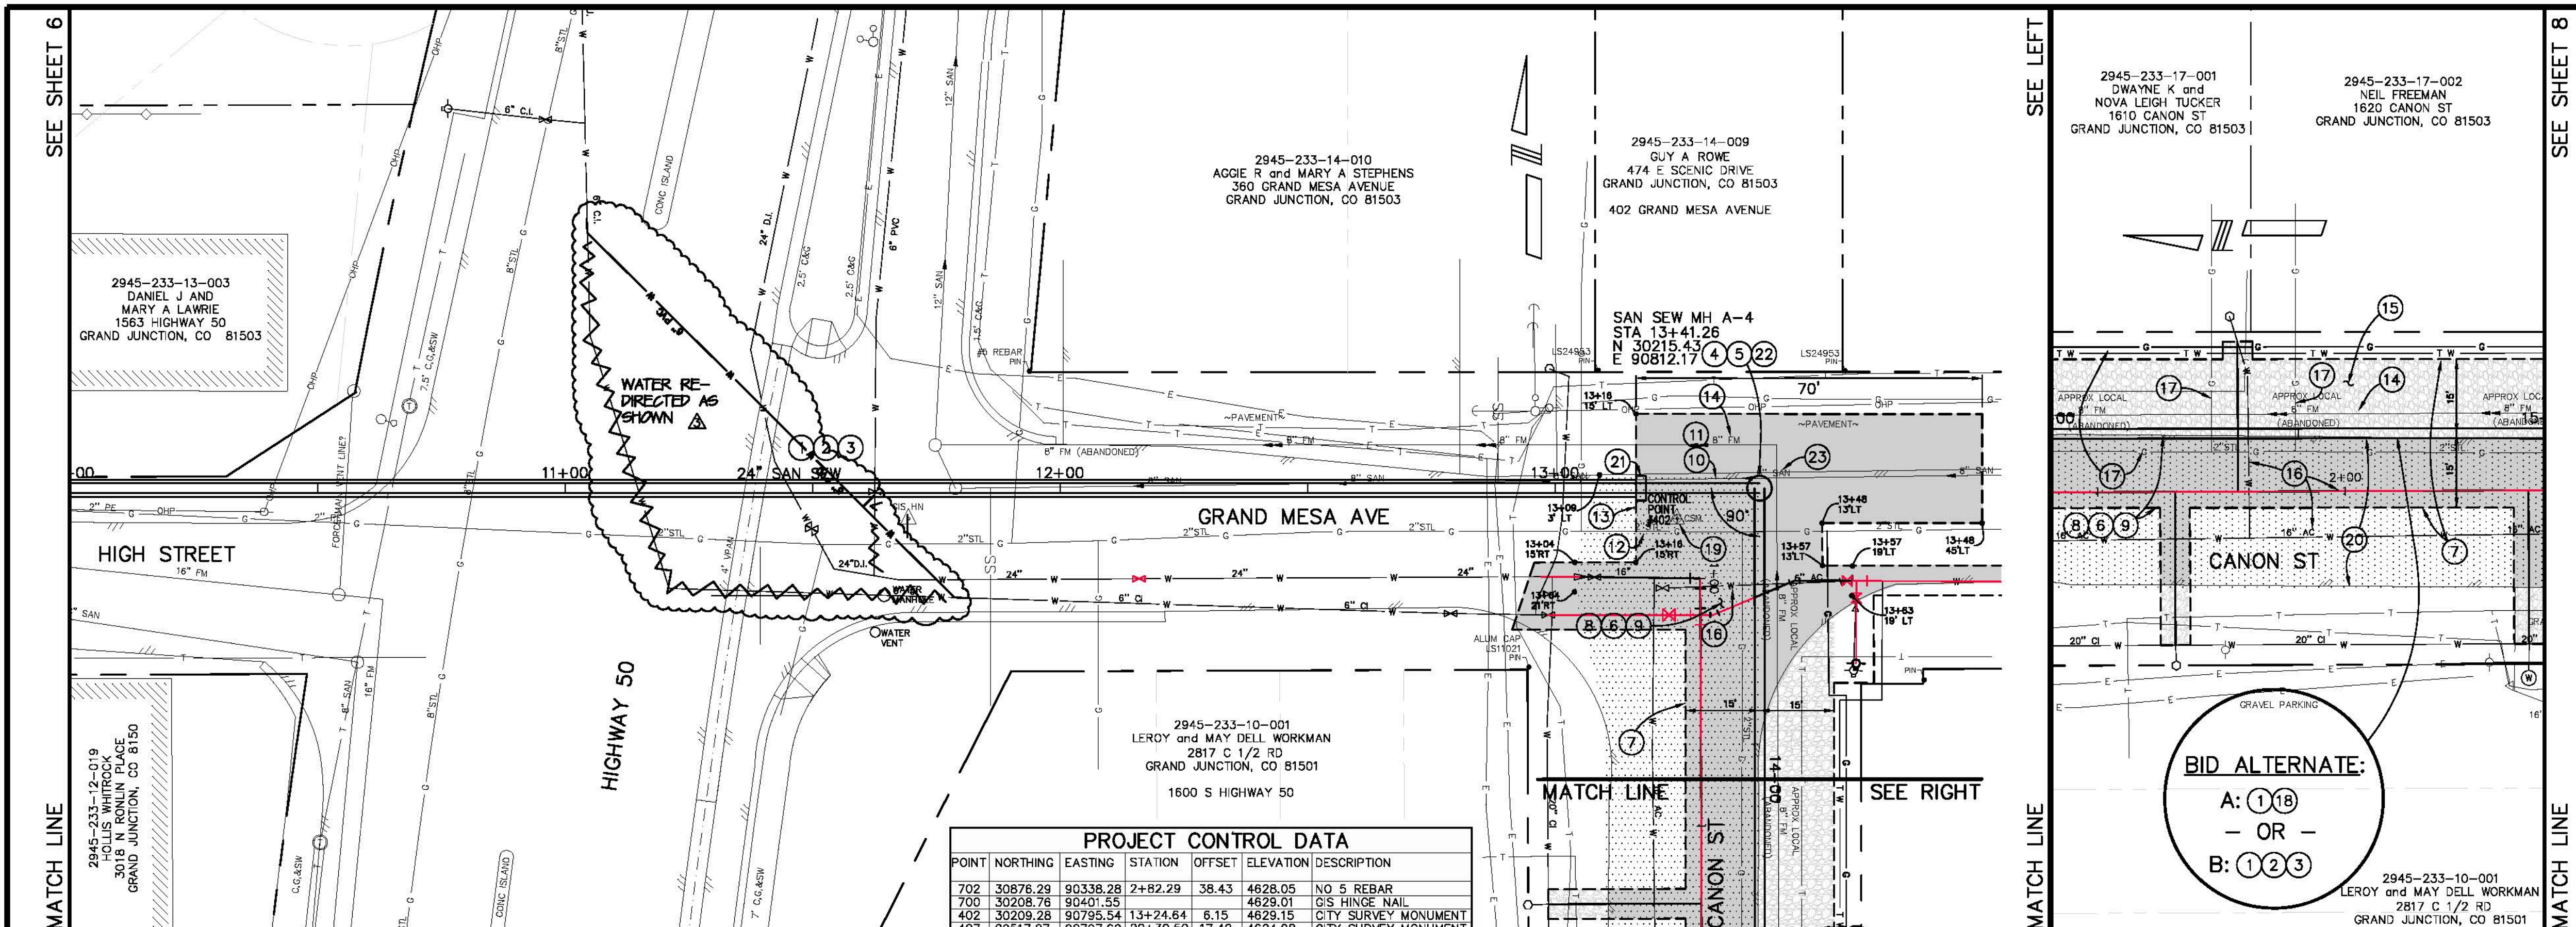

REVISION	DESCRIPTION	DATE	DRAWN BY	DATE
△			JCS	2005
△	AS BUILT	2007-10-15		

DESIGNED BY	DATE	CHECKED BY	DATE	APPROVED BY	DATE

SCALES:  
 PLAN: 1" = 20'  
 PROFILE: HORIZONTAL 1" = 20', VERTICAL 1" = 2'



PUBLIC WORKS AND UTILITIES ENGINEERING DIVISION

DUCK POND PARK LIFT STATION ELIMINATION AND GRAVITY SEWER CONSTRUCTION SANITARY SEWER PLAN AND PROFILES HIGH ST, GRAND MESA AVE, AND CANON ST

N:\Lamp\proj\F10114 (DUCK POND SEWER IMPROV).dwg 10/10/2008 8:57:19 AM

CONSTRUCTION NOTES

- ① 102.9A - 24" GRAVITY SEWER PIPE. PIPE SHALL BE SDR-35 OR PROFILE WALL PVC MEETING 102.9a.
- ② 102.9A - 48" DIA. STEEL CASING (ROLL PLATE, 1/2" WALL THICKNESS)
- ③ 104.2A - INSTALL SEWER PIPE BY BORING AND JACKING. SET CARRIER PIPE TO GRADE USING CUSTOM STEEL SUPPORTS AND FILL ANNULAR SPACE WITH FLY ASH MIXTURE PER PROJECT SPECIAL PROVISIONS. SEAL ENDS OF CASING TO FACILITATE INSTALLATION OF FLY ASH MIXTURE.
- ④ 102.11 - SANITARY SEWER BASIC MANHOLE COMPONENTS (60" I.D.) (SEE CITY OF GRAND JUNCTION STANDARD DETAIL SS-02).
- ⑤ 102.11 - MANHOLE BARREL (D>5') (60" I.D.) (SEE CITY OF GRAND JUNCTION STANDARD DETAIL SS-02).
- ⑥ 103.14 - BACKFILL EXCAVATIONS WITH NATIVE MATERIAL MEETING 103.16 EARTH BACKFILL MATERIAL.
- ⑦ LIMITS OF EXCAVATION
- ⑧ 103.3 - ASPHALT REMOVAL: CUT AND REMOVE PAVEMENT AS SHOWN.
- ⑨ 401-HOT BITUMINOUS PAVEMENT (3" THICK) (GRADING SX) 304 - AGGREGATE BASE COURSE (CLASS 6) (6" THICK) (SEE CITY OF GRAND JUNCTION STANDARD DETAIL GU-03)
- ⑩ LIMITS OF EXCAVATION. IF THE BORE ALTERNATE IS SELECTED, ACCESS PIT DIMENSIONS AND LOCATIONS MAY BE SELECTED BY THE CONTRACTOR BUT MUST BE WITHIN THE LIMITS OF EXCAVATION.
- ⑪ 202 - REMOVE PIPE - ABANDONED 8" FORCE MAIN TO BE REMOVED AS NEEDED FOR EXCAVATION.
- ⑫ 304 - AGGREGATE BASE COURSE (CLASS 6) (4" THICK)
- ⑬ EXISTING GAS LINE TO BE RELOCATED BY XCEL ENERGY TO THIS PROPOSED LOCATION.
- ⑭ 104.2A - INSTALL SEWER PIPE BY OPEN CUT, DIRECT BURY.
- ⑮ SEE SHEET 10 FOR WATER LINE REPLACEMENT
- ⑯ 202 - REMOVE PIPE AS NEEDED FOR EXCAVATION.
- ⑰ 103.10 - CUTOFF WALL. THE CONTRACT UNIT PRICE FOR GRAVITY SEWER PIPE SHALL INCLUDE THE COST OF CUTOFF WALLS.

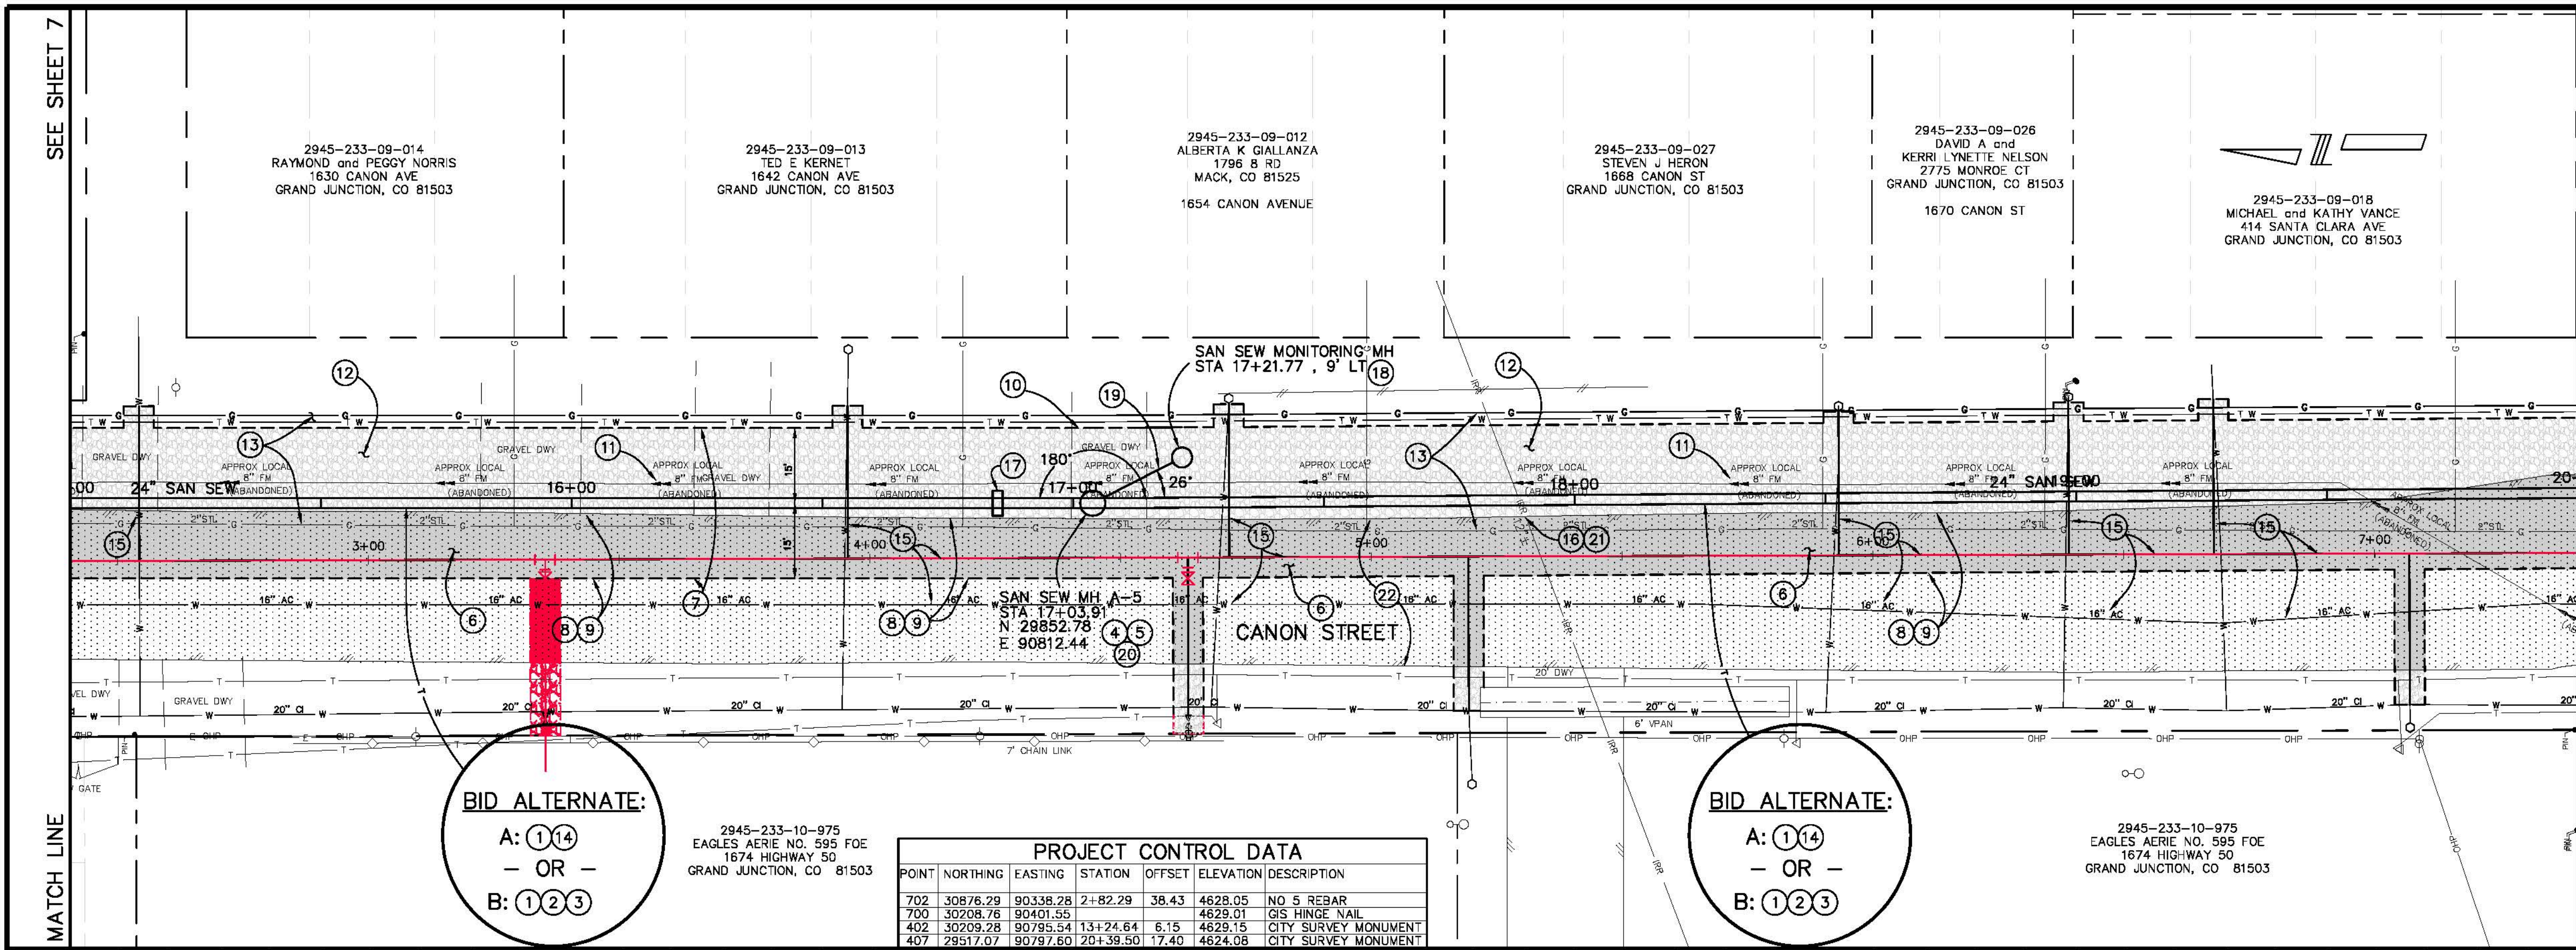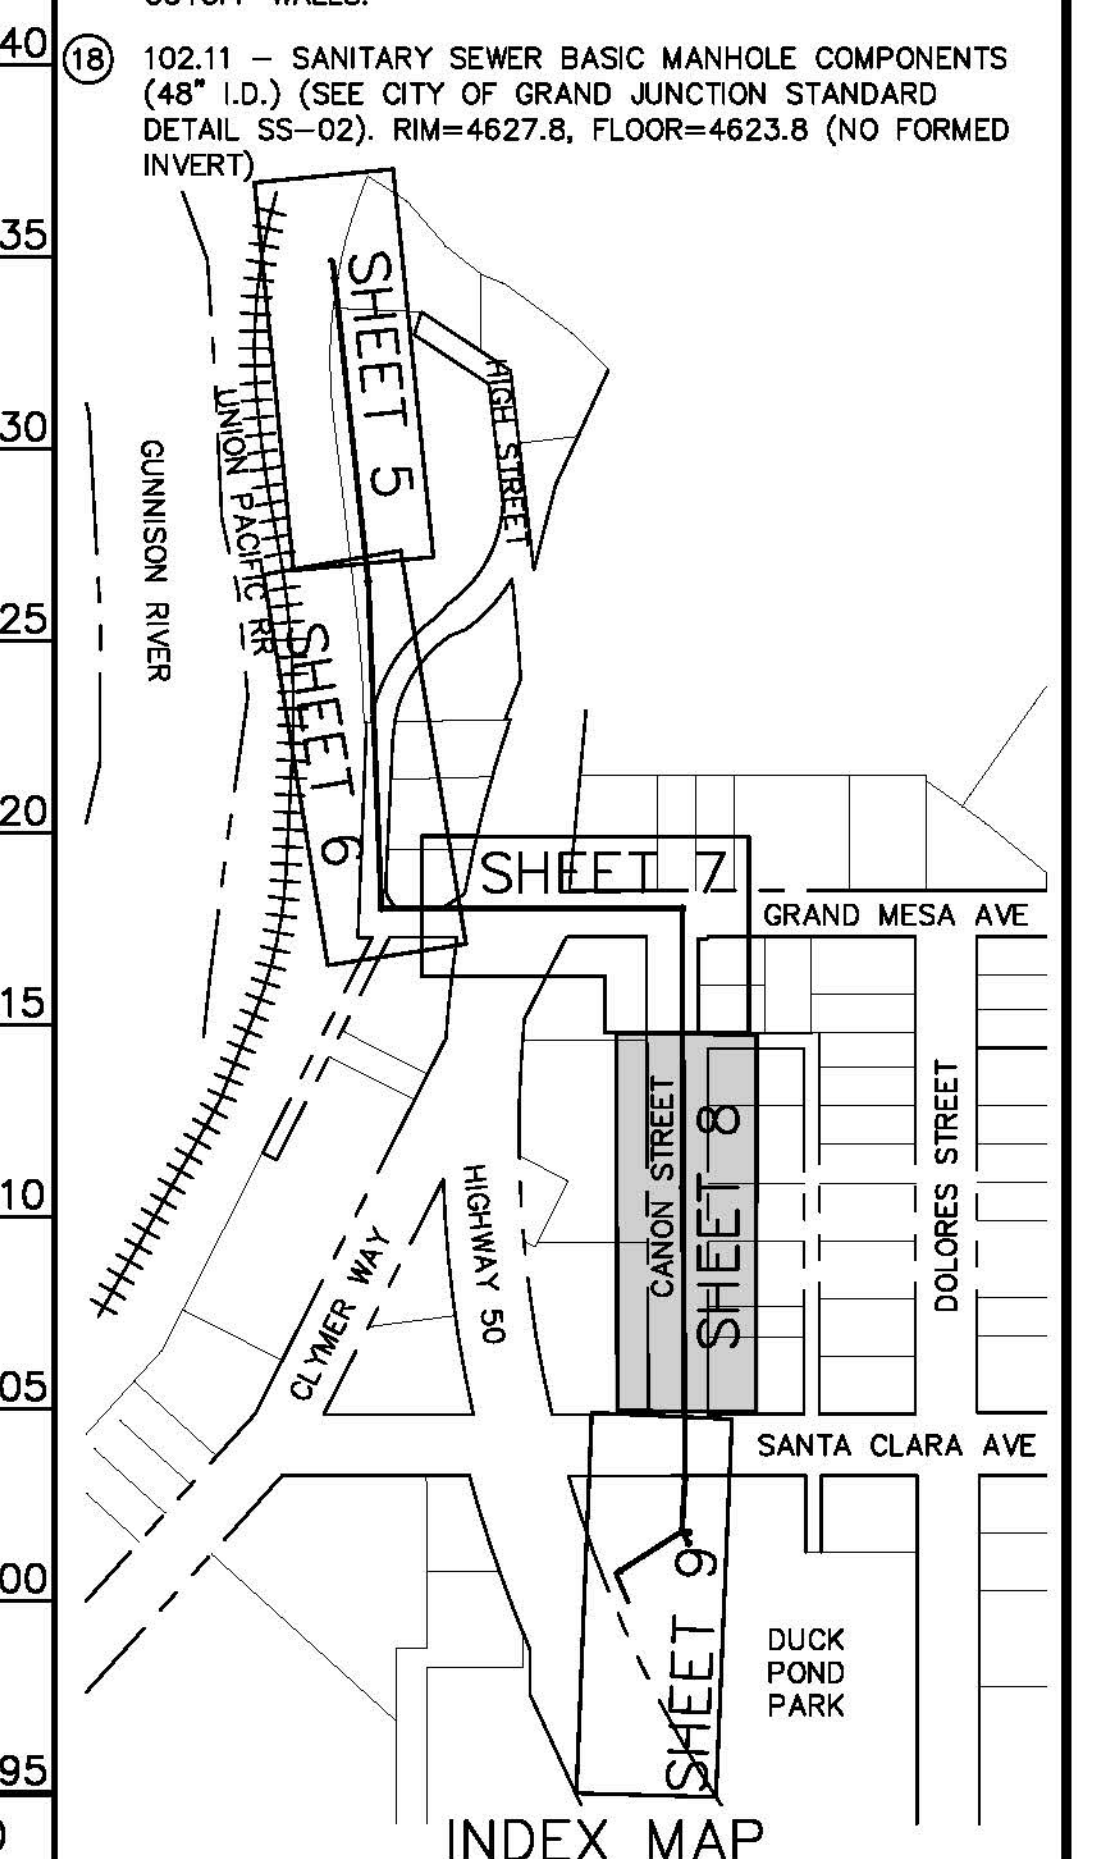


**PROJECT CONTROL DATA**

POINT	NORTHING	EASTING	STATION	OFFSET	ELEVATION	DESCRIPTION
702	30876.29	90338.28	2+82.29	38.43	4628.05	NO 5 REBAR
700	30208.76	90401.55			4629.01	GIS HINGE NAIL
402	30209.28	90795.54	13+24.64	6.15	4629.15	CITY SURVEY MONUMENT
407	29517.07	90797.60	20+39.50	17.40	4624.08	CITY SURVEY MONUMENT

**BID ALTERNATE:**  
A: ①⑭  
- OR -  
B: ①②③

**BID ALTERNATE:**  
A: ①⑭  
- OR -  
B: ①②③

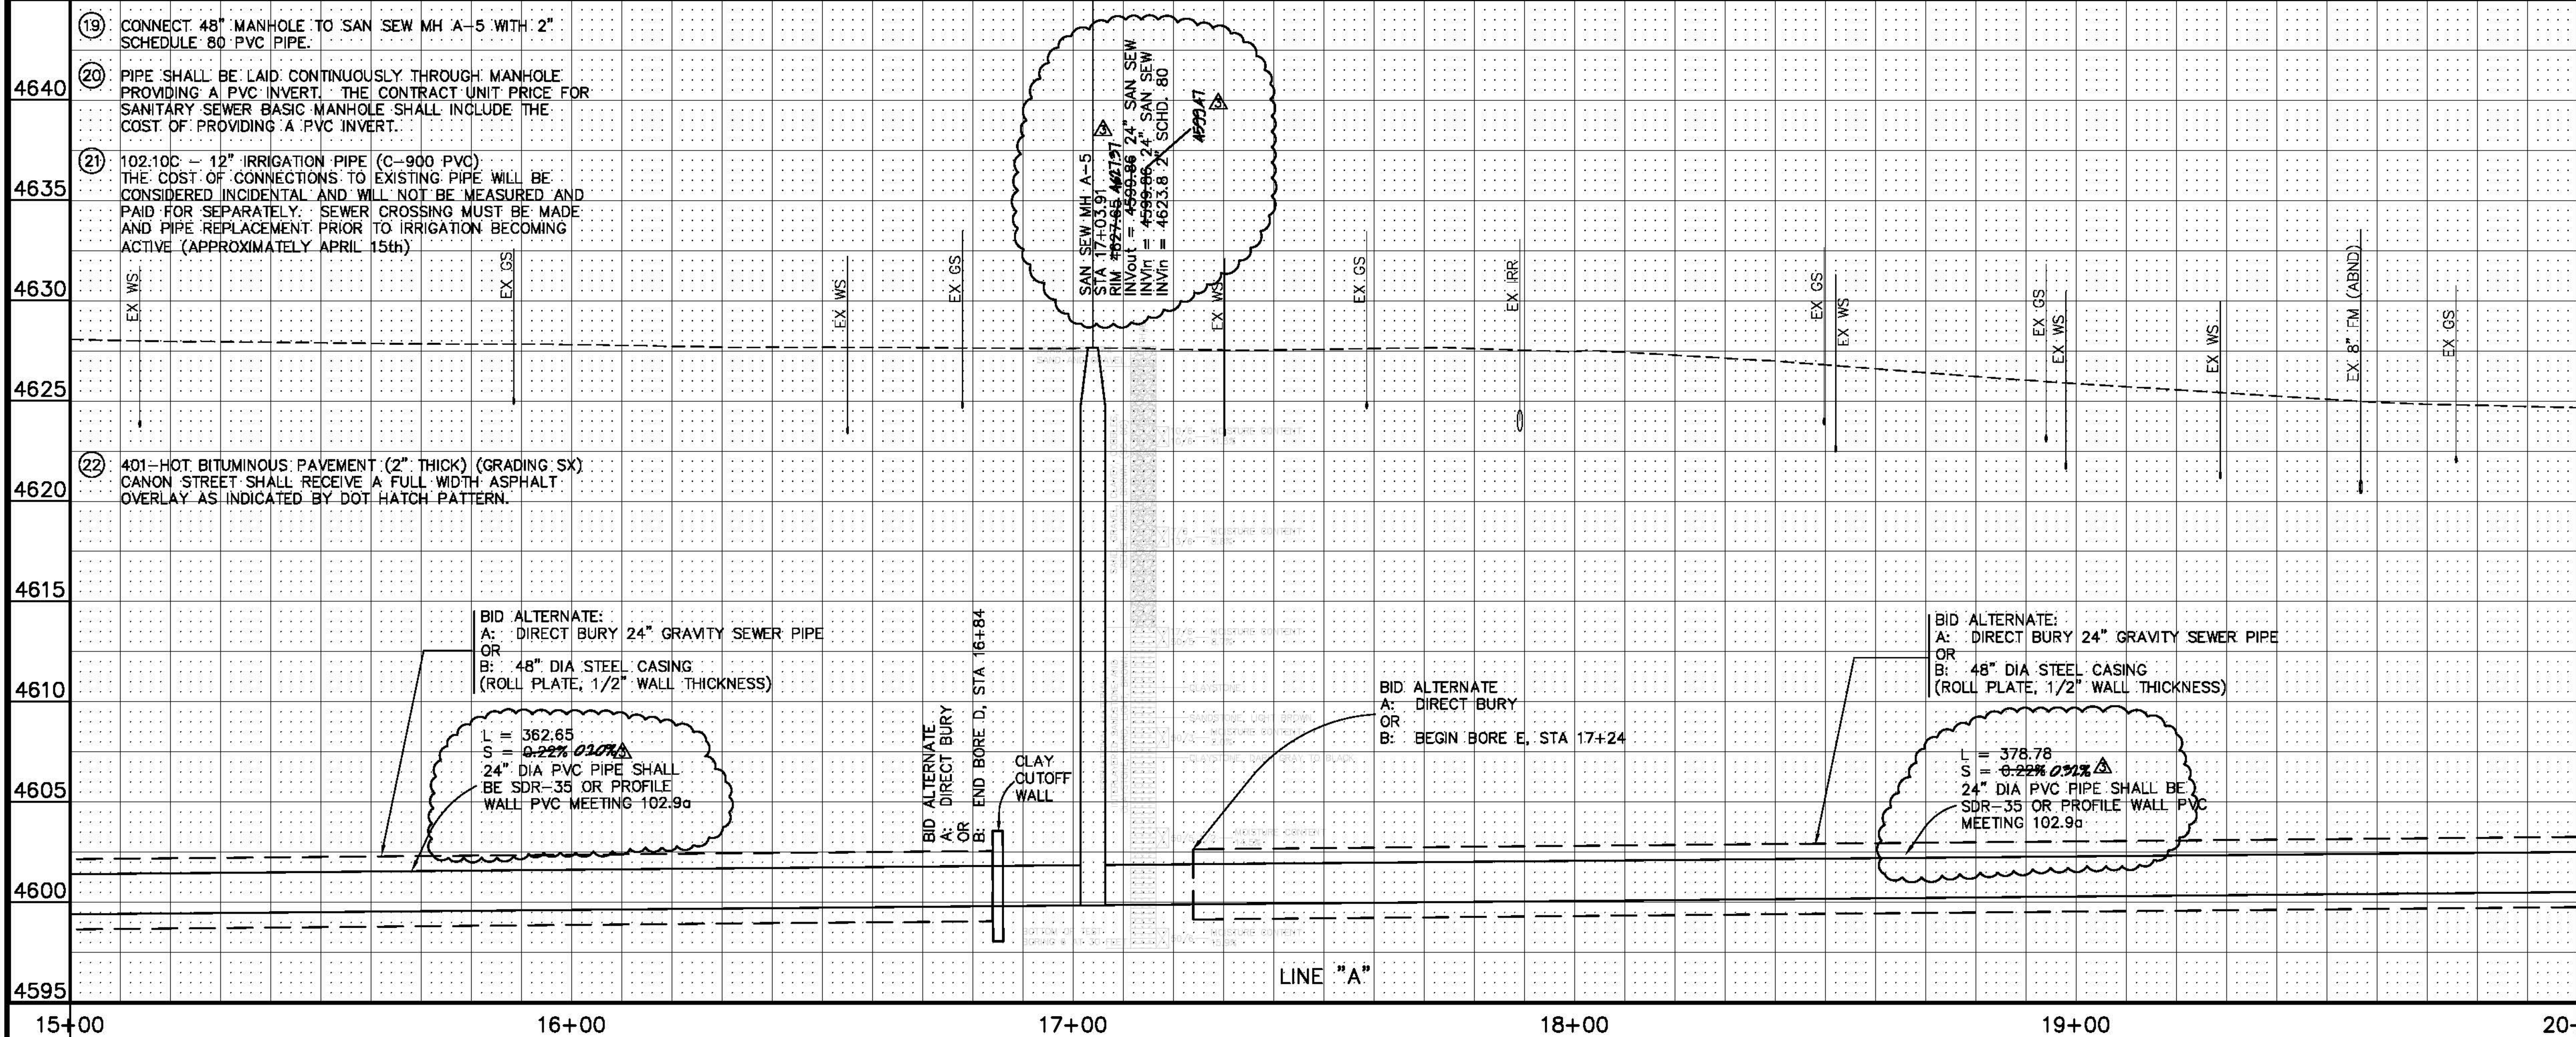

**BID ALTERNATE:**  
A: DIRECT BURY 24" GRAVITY SEWER PIPE  
OR  
B: 48" DIA STEEL CASING (ROLL PLATE, 1/2" WALL THICKNESS)

L = 362.65  
S = 0.22% 0.10%

24" DIA PVC PIPE SHALL BE SDR-35 OR PROFILE WALL PVC MEETING 102.9a


**BID ALTERNATE:**  
A: DIRECT BURY 24" GRAVITY SEWER PIPE  
OR  
B: 48" DIA STEEL CASING (ROLL PLATE, 1/2" WALL THICKNESS)

L = 378.78  
S = 0.22% 0.10%

24" DIA PVC PIPE SHALL BE SDR-35 OR PROFILE WALL PVC MEETING 102.9a

REVISION	DATE	DESCRIPTION
AS BUILT	2007-10-11	
△		
△		
△		

DESIGNED BY	JCS	DATE	2005
CHECKED BY		DATE	
APPROVED BY		DATE	

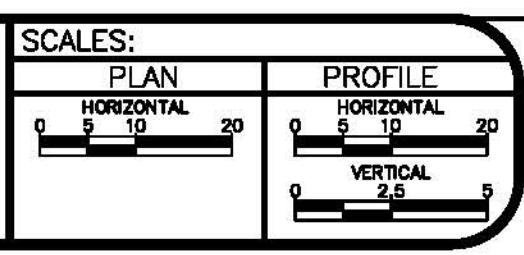


**PUBLIC WORKS AND UTILITIES ENGINEERING DIVISION**

**DUCK POND PARK LIFT STATION ELIMINATION AND GRAVITY SEWER CONSTRUCTION SANITARY SEWER PLAN AND PROFILES CANON STREET**

N:\Lamp\proj\F10114 (DUCK POND SEWER IMPROV)\DWG\BASE-F10114 rev 7-7-05.dwg, 8, 6/10/2008 8:58:07 AM



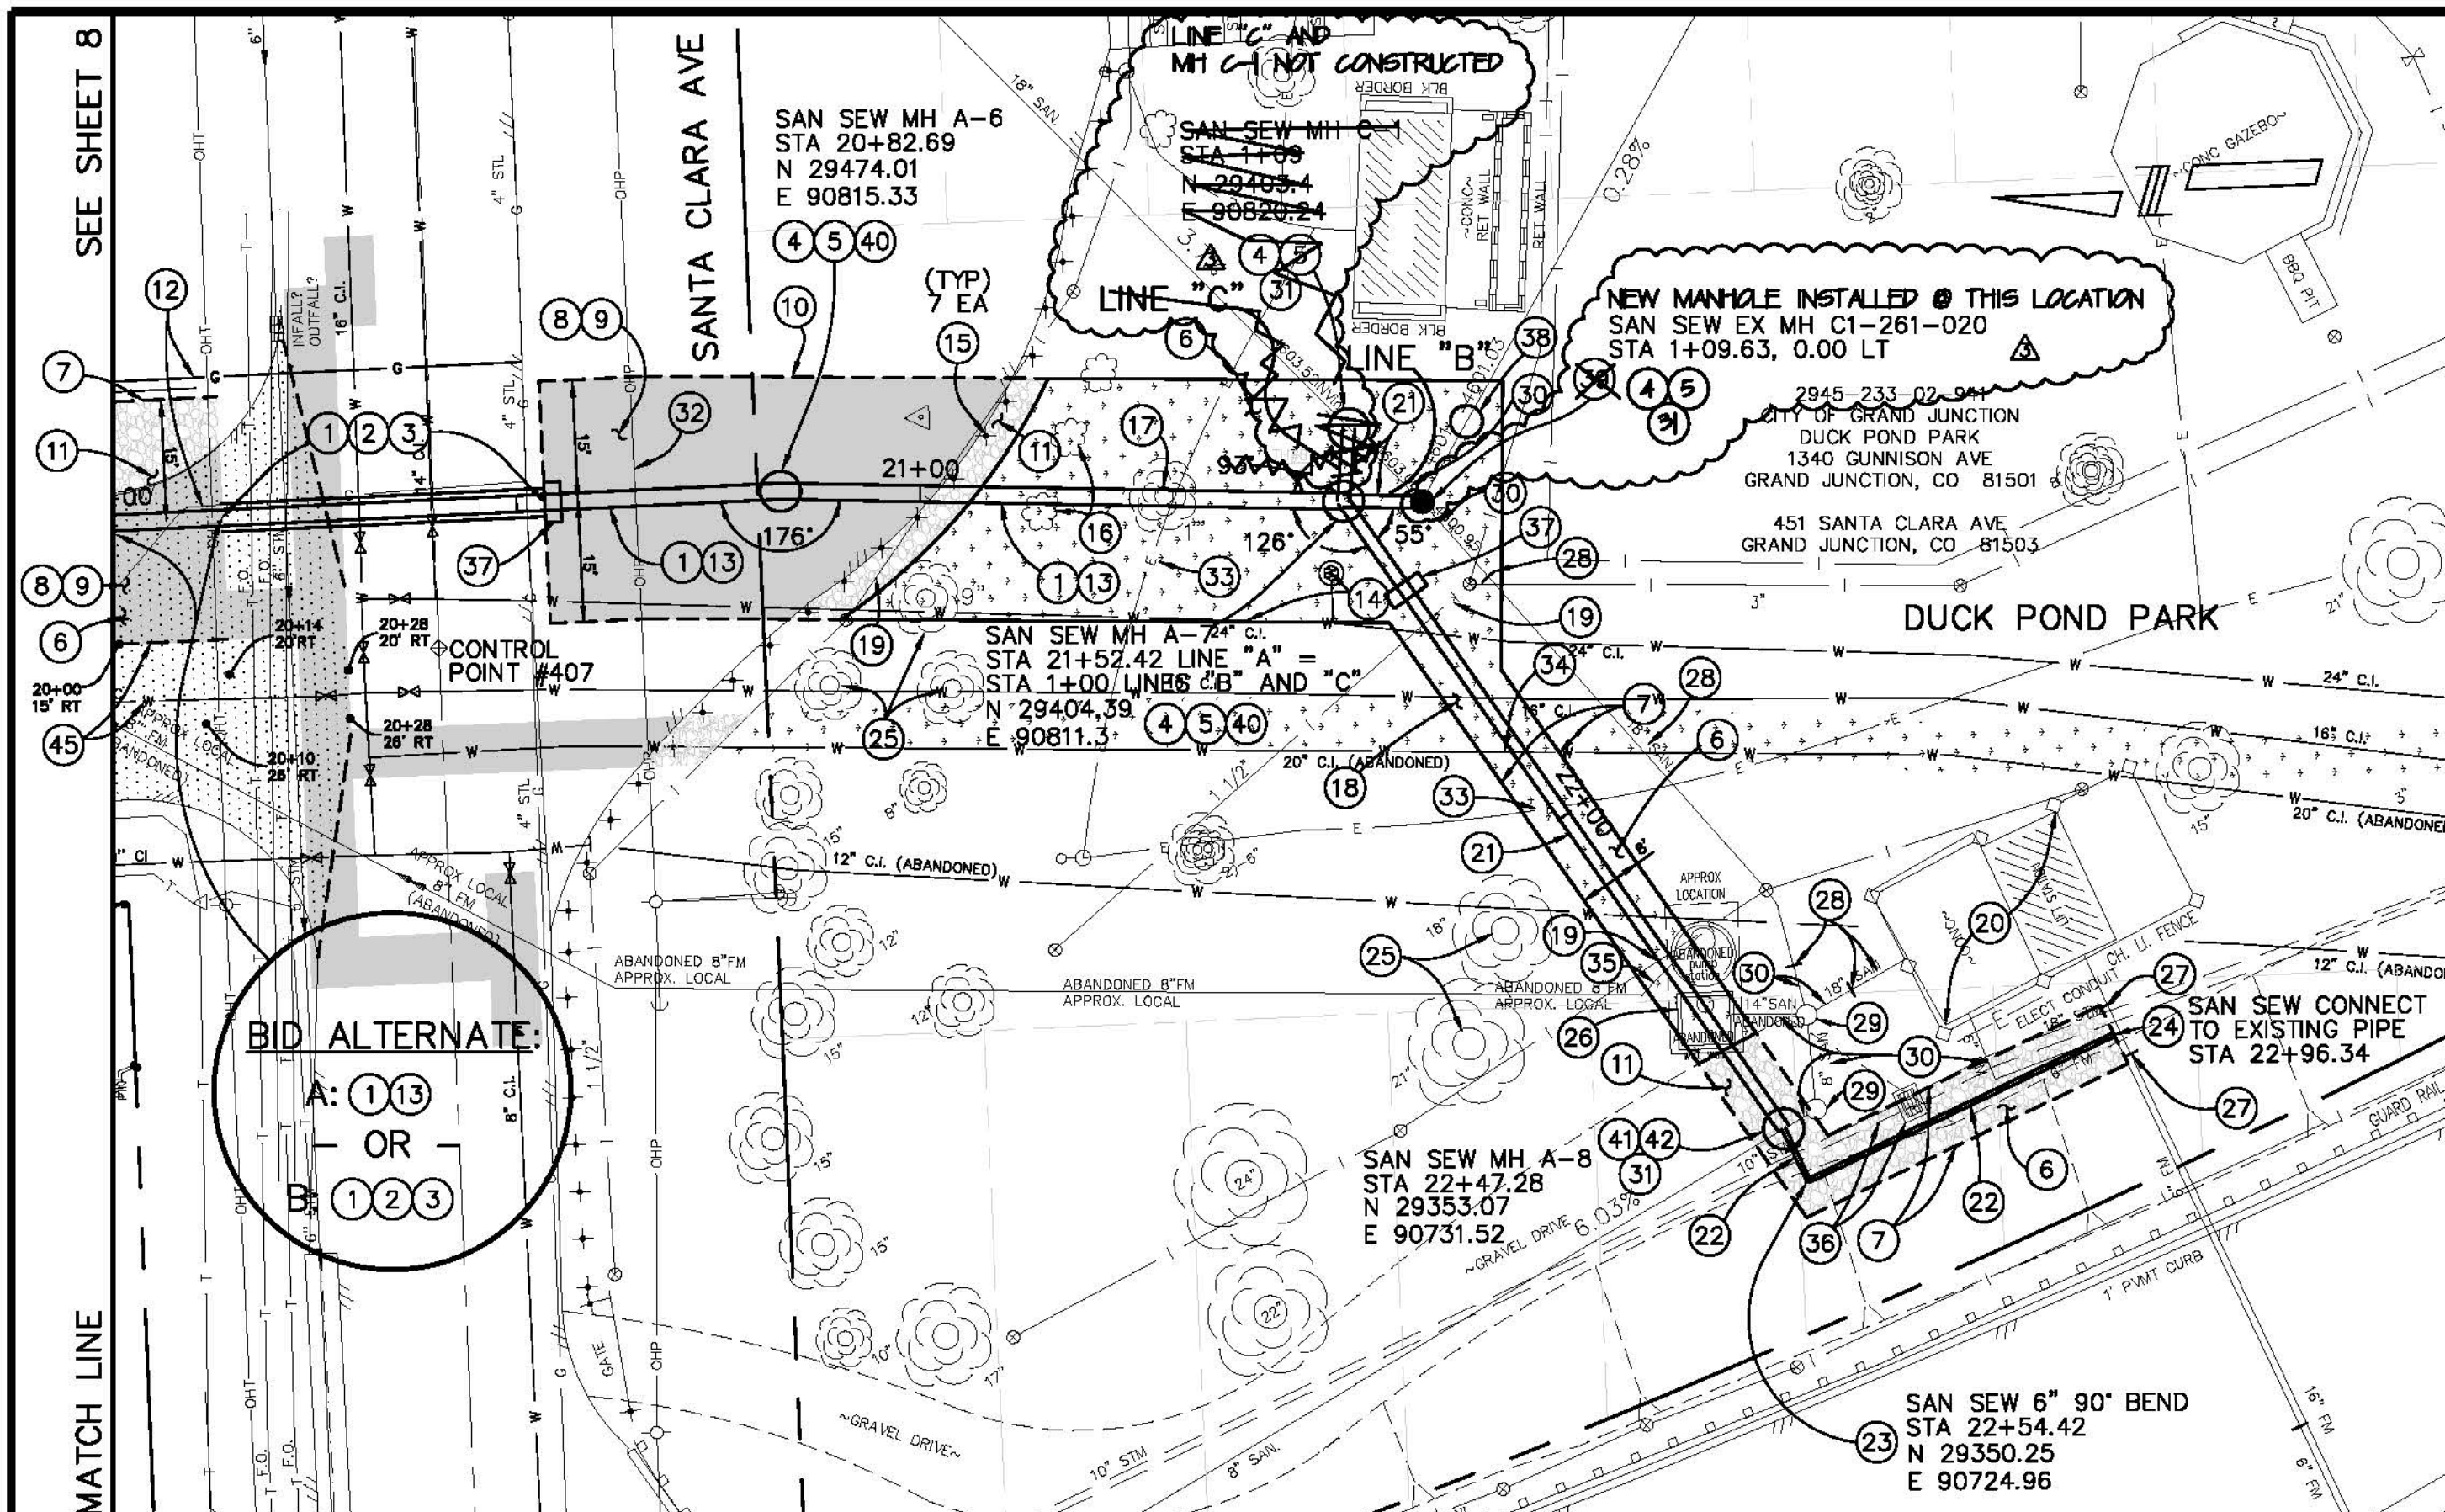



- 1 102.9A - 24" GRAVITY SEWER PIPE. PIPE SHALL BE SDR-35 OR PROFILE WALL PVC MEETING 102.9a.
- 2 102.9A - 48" DIA. STEEL CASING (ROLL PLATE, 1/2" WALL THICKNESS)
- 3 104.2A - INSTALL SEWER PIPE BY BORING AND JACKING. SET CARRIER PIPE TO GRADE USING CUSTOM STEEL SUPPORTS AND FILL ANNUAL SPACE WITH FLY ASH MIXTURE PER PROJECT SPECIAL PROVISIONS. SEAL ENDS OF CASING TO FACILITATE INSTALLATION OF FLY ASH MIXTURE.
- 4 102.11 - SANITARY SEWER BASIC MANHOLE COMPONENTS (60" I.D.) (SEE CITY OF GRAND JUNCTION STANDARD DETAIL SS-02).
- 5 102.11 - MANHOLE BARREL (D>5') (60" I.D.) (SEE CITY OF GRAND JUNCTION STANDARD DETAIL SS-02).
- 6 103.14 - BACKFILL EXCAVATIONS WITH NATIVE MATERIAL MEETING 103.16 EARTH BACKFILL MATERIAL.
- 7 LIMITS OF EXCAVATION
- 8 103.3 - ASPHALT REMOVAL: CUT AND REMOVE PAVEMENT AS SHOWN.
- 9 401-HOT BITUMINOUS PAVEMENT (3" THICK) (GRADING SX) 304 - AGGREGATE BASE COURSE (CLASS 6) (6" THICK) (SEE CITY OF GRAND JUNCTION STANDARD DETAIL GU-03)
- 10 LIMITS OF EXCAVATION. IF THE BORE ALTERNATE IS SELECTED, ACCESS PIT DIMENSIONS AND LOCATIONS MAY BE SELECTED BY THE CONTRACTOR BUT MUST BE WITHIN THE LIMITS OF EXCAVATION.
- 11 304 - AGGREGATE BASE COURSE (CLASS 6) (4" THICK)
- 12 EXISTING GAS LINE TO BE RELOCATED BY XCEL ENERGY TO THIS PROPOSED LOCATION.
- 13 104.2A - INSTALL SEWER PIPE BY OPEN CUT, DIRECT BURY.
- 14 PROTECT & SUPPORT WATER LINE AND MANHOLE. WATER LINE AND MANHOLE SHALL REMAIN IN SERVICE DURING CONSTRUCTION.
- 15 210 - RESET POST
- 16 202 - REMOVE BUSH
- 17 TREE WILL BE REMOVED BY OTHERS.

- 18 207/212 - TOPSOIL, 6" THICK, AND SOD.
- 19 210 - RESET SPRINKLER SYSTEM.
- 20 202 - REMOVE STRUCTURE/OBSTRUCTIONS. REMOVE REMAINING STRUCTURE AFTER CITY HAS COMPLETED SALVAGE OF EQUIPMENT AND MATERIALS. REMOVE CONCRETE TO A DEPTH OF 4' BELOW EXISTING GRADE.
- 21 102.9A - 18" GRAVITY SEWER PIPE (SDR-35 PVC). BACKFILL TRENCH WITH NATIVE MATERIALS MEETING 103.16 EARTH BACKFILL MATERIAL.
- 22 102.9B - 6" PRESSURE SEWER PIPE (C-900, CLASS 150, DR-18, PVC).
- 23 102.9B - 90° D.I.P. BEND.
- 24 102 - CONNECT NEW 6" PRESSURE SEWER PIPE TO EXISTING PIPE. THE CONTRACT UNIT PRICE FOR 6" PRESSURE SEWER PIPE SHALL INCLUDE THE COST OF CONNECTIONS TO EXISTING PIPE.
- 25 PROTECT TREE
- 26 202 - REMOVE STRUCTURE/OBSTRUCTIONS. REMOVE REMAINING PORTION OF ABANDON WET WELL AS NEEDED FOR EXCAVATION. ABANDON WET WELL AND PUMP STATION HAS ALREADY BEEN REMOVED TO APPROXIMATELY 4' BELOW EXISTING GRADE.
- 27 202 - ABANDON EXISTING 16" FORCE MAIN SEWER PIPE. POUR CONCRETE PLUGS AT EACH END AND ABANDON IN PLACE.
- 28 202 - ABANDON EXISTING 18" SANITARY SEWER PIPE. POUR CONCRETE PLUGS AT EACH END AND ABANDON IN PLACE.
- 29 202 - ABANDON EXISTING MANHOLE. PLUG INLET AND OUTLET PIPES WITH CONCRETE. REMOVE RING AND COVER AND DELIVER TO CITY SHOPS. REMOVE AND DISPOSE OF CONE SECTION. FILL REMAINING BARREL SECTION WITH FLOW FILL MATERIAL.
- 30 202 - REMOVE PIPE. REMOVE EXISTING 8" SANITARY SEWER, 18" SANITARY SEWER, 14" SANITARY SEWER AND/OR 6" FORCE MAIN AS SHOWN.
- 31 CONNECT MANHOLE TO EXISTING PIPE. THE CONTRACT UNIT PRICE FOR THESE MANHOLES SHALL INCLUDE THE COST OF CONNECTIONS TO EXISTING PIPE.


- PROJECT NO. 904-F10114
- 32 PROTECT OVERHEAD POWER LINE. OVERHEAD POWER LINE SHALL REMAIN IN SERVICE DURING CONSTRUCTION.
  - 33 PROTECT UNDERGROUND ELECTRIC LINE. ELECTRIC LINE SHALL REMAIN IN SERVICE DURING CONSTRUCTION.
  - 34 REMOVE PIPE. REMOVE EXISTING ABANDONED WATER LINE AND PLUG REMAINING ENDS OF PIPE AT TRENCH EDGE WITH CONCRETE.
  - 35 REMOVE PIPE. REMOVE EXISTING ABANDONED SEWER FORCE MAIN AND PLUG REMAINING ENDS OF PIPE AT TRENCH EDGE WITH CONCRETE.
  - 36 PROTECT STORM DRAIN LINE AND INLET. STORM DRAIN LINE AND INLET SHALL REMAIN IN SERVICE DURING CONSTRUCTION.
  - 37 103.10 - CUTOFF WALL. THE CONTRACT UNIT PRICE FOR GRAVITY SEWER PIPE SHALL INCLUDE THE COST OF CUTOFF WALLS.
  - 38 102.11 - TEMPORARY SANITARY SEWER MANHOLE FOR BYPASS PUMPING OPERATIONS. (48" I.D.) MANHOLE SHALL HAVE A POURED IN PLACE BASE. CARE SHALL BE TAKEN TO NOT FLOAT THE EXISTING LINE WHEN THE MANHOLE BASE IS POURED. "O" RING GASKETS OR OTHER APPROVED WATER STOPS ARE TO BE PLACED AROUND THE INLET AND OUTLET PIPES TO ENSURE A WATER TIGHT SEAL AT THE MH BASE. THE TOP HALF OF THE EXISTING PIPE SHALL BE CUT TO PROVIDE FOR A NEW INVERT. CARE SHOULD BE TAKEN AT THE TIME OF THE CUT TO NOT ALLOW THE EXISTING PIPE TO SAG BY MEANS OF BRACING AND TO CONTROL ALL LIVE SEWAGE NOT ALLOWING DEBRIS FROM WORK TO ENTER THE PIPE OUT. MANHOLE HEIGHT SHALL BE LIMITED TO 1 BARREL SECTION. CONTRACTOR SHALL PLACE A FLAT TOP LID WITH NO ACCESS HOLE ON TOP OF BARREL SECTION PRIOR TO BACKFILLING.
  - 39 102 - CONNECT TO EXISTING MANHOLE (18" PIPE)
  - 40 EPOXY COAT INVERT. THE CONTRACT UNIT PRICE FOR SANITARY SEWER BASIC MANHOLE SHALL INCLUDE THE COST OF EPOXY COATING INVERTS.
  - 41 102.11 - SANITARY SEWER BASIC MANHOLE COMPONENTS (48" I.D.) (FORCE MAIN OUTLET) (SEE PROJECT SPECIAL PROVISIONS)
  - 42 102.11 - MANHOLE BARREL (D>5') (48" I.D.) (FORCE MAIN OUTLET) (SEE PROJECT SPECIAL PROVISIONS)
- CONTRACTOR SHALL COORDINATE THE RELOCATION OF THE EXISTING ELECTRICAL SERVICE TO THE PARK RESTROOMS WITH THE PROJECT ENGINEER.
- 43 401-HOT BITUMINOUS PAVEMENT (2" THICK) (GRADING SX) CANON STREET SHALL RECEIVE A FULL WIDTH ASPHALT OVERLAY AS INDICATED BY DOT HATCH PATTERN.
  - 44 SEE SHEET 10 FOR WATER LINE REPLACEMENT

**PROJECT CONTROL DATA**

POINT	NORTHING	EASTING	STATION	OFFSET	ELEVATION	DESCRIPTION
702	30676.29	90338.28	2+82.29	38.43	4628.05	NO 5 REBAR
700	30228.76	90401.55			4629.01	CIS HINGE NAIL
402	30209.28	90795.54	13+24.64	6.15	4629.15	CITY SURVEY MONUMENT
407	29517.07	90797.60	20+39.50	17.40	4624.08	CITY SURVEY MONUMENT

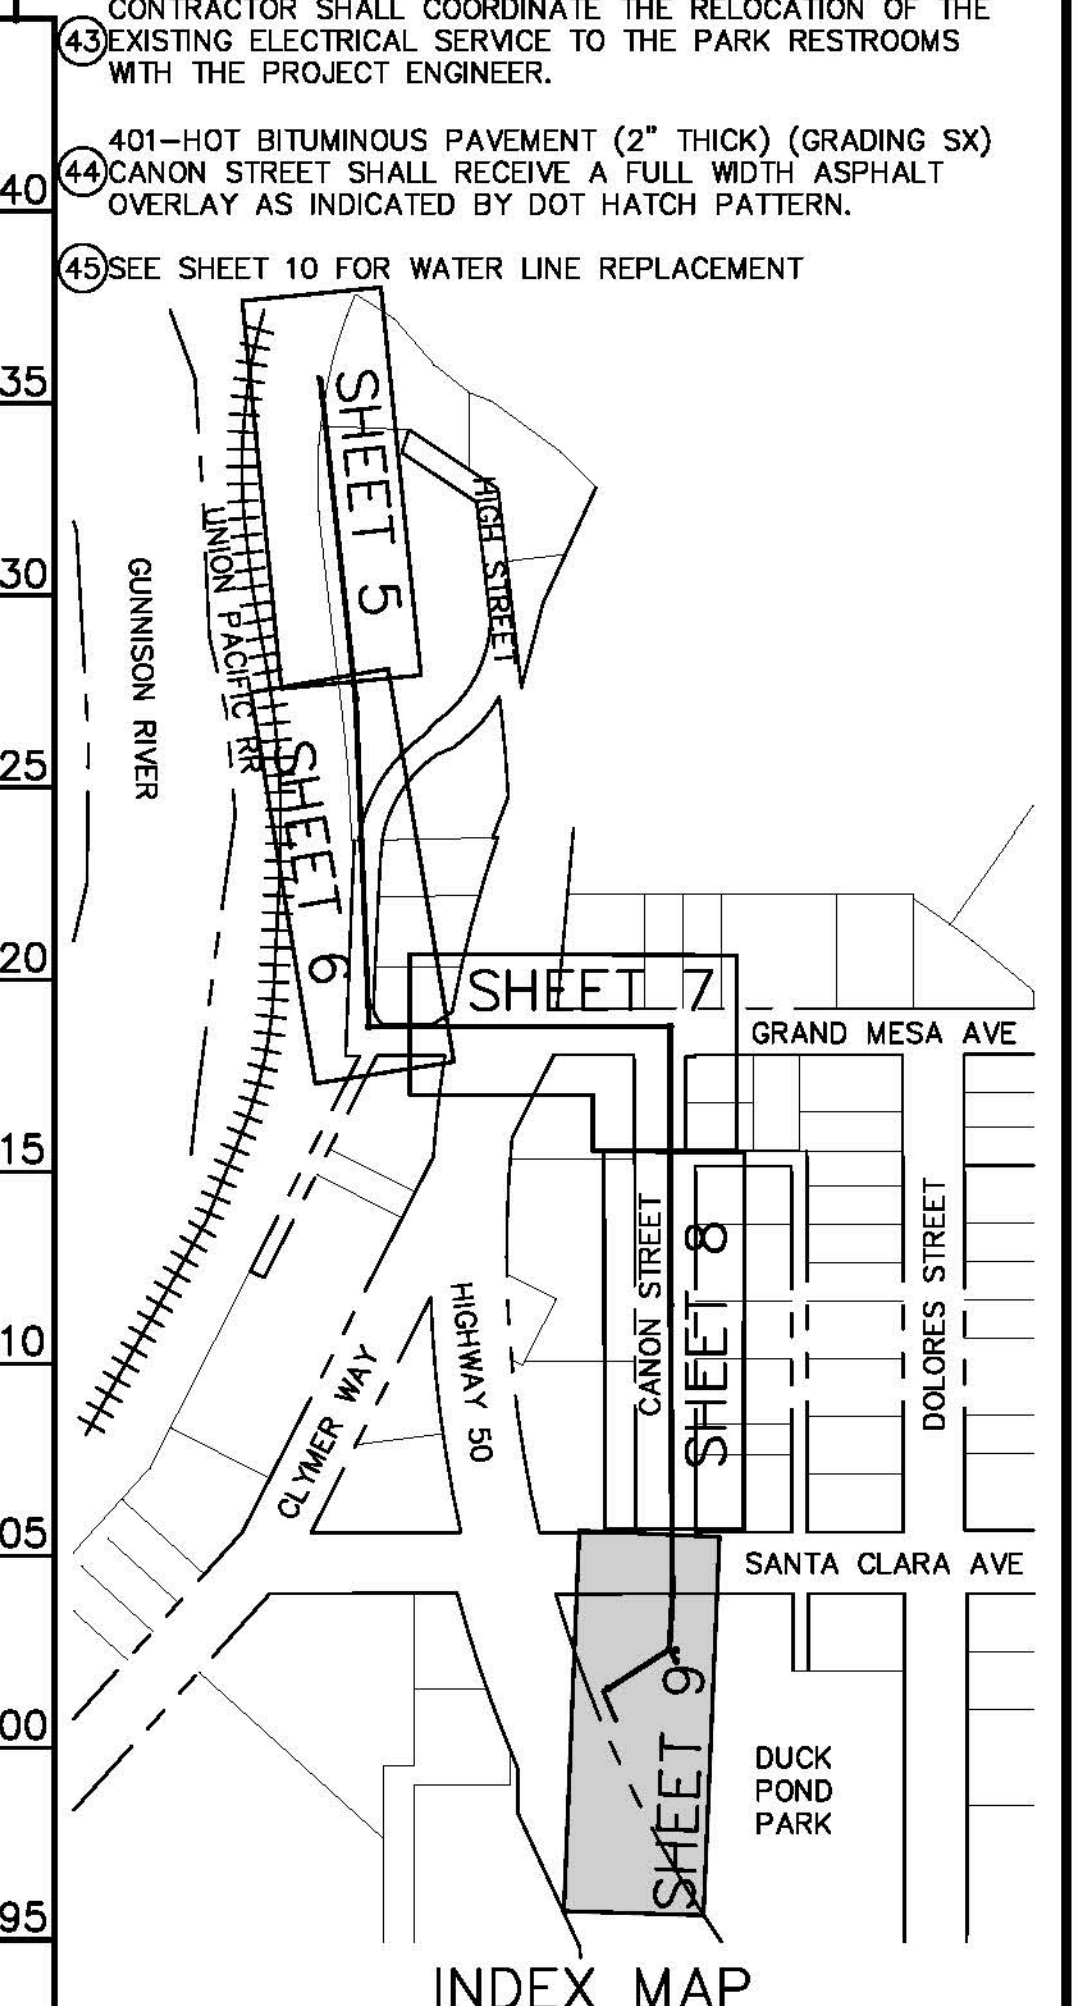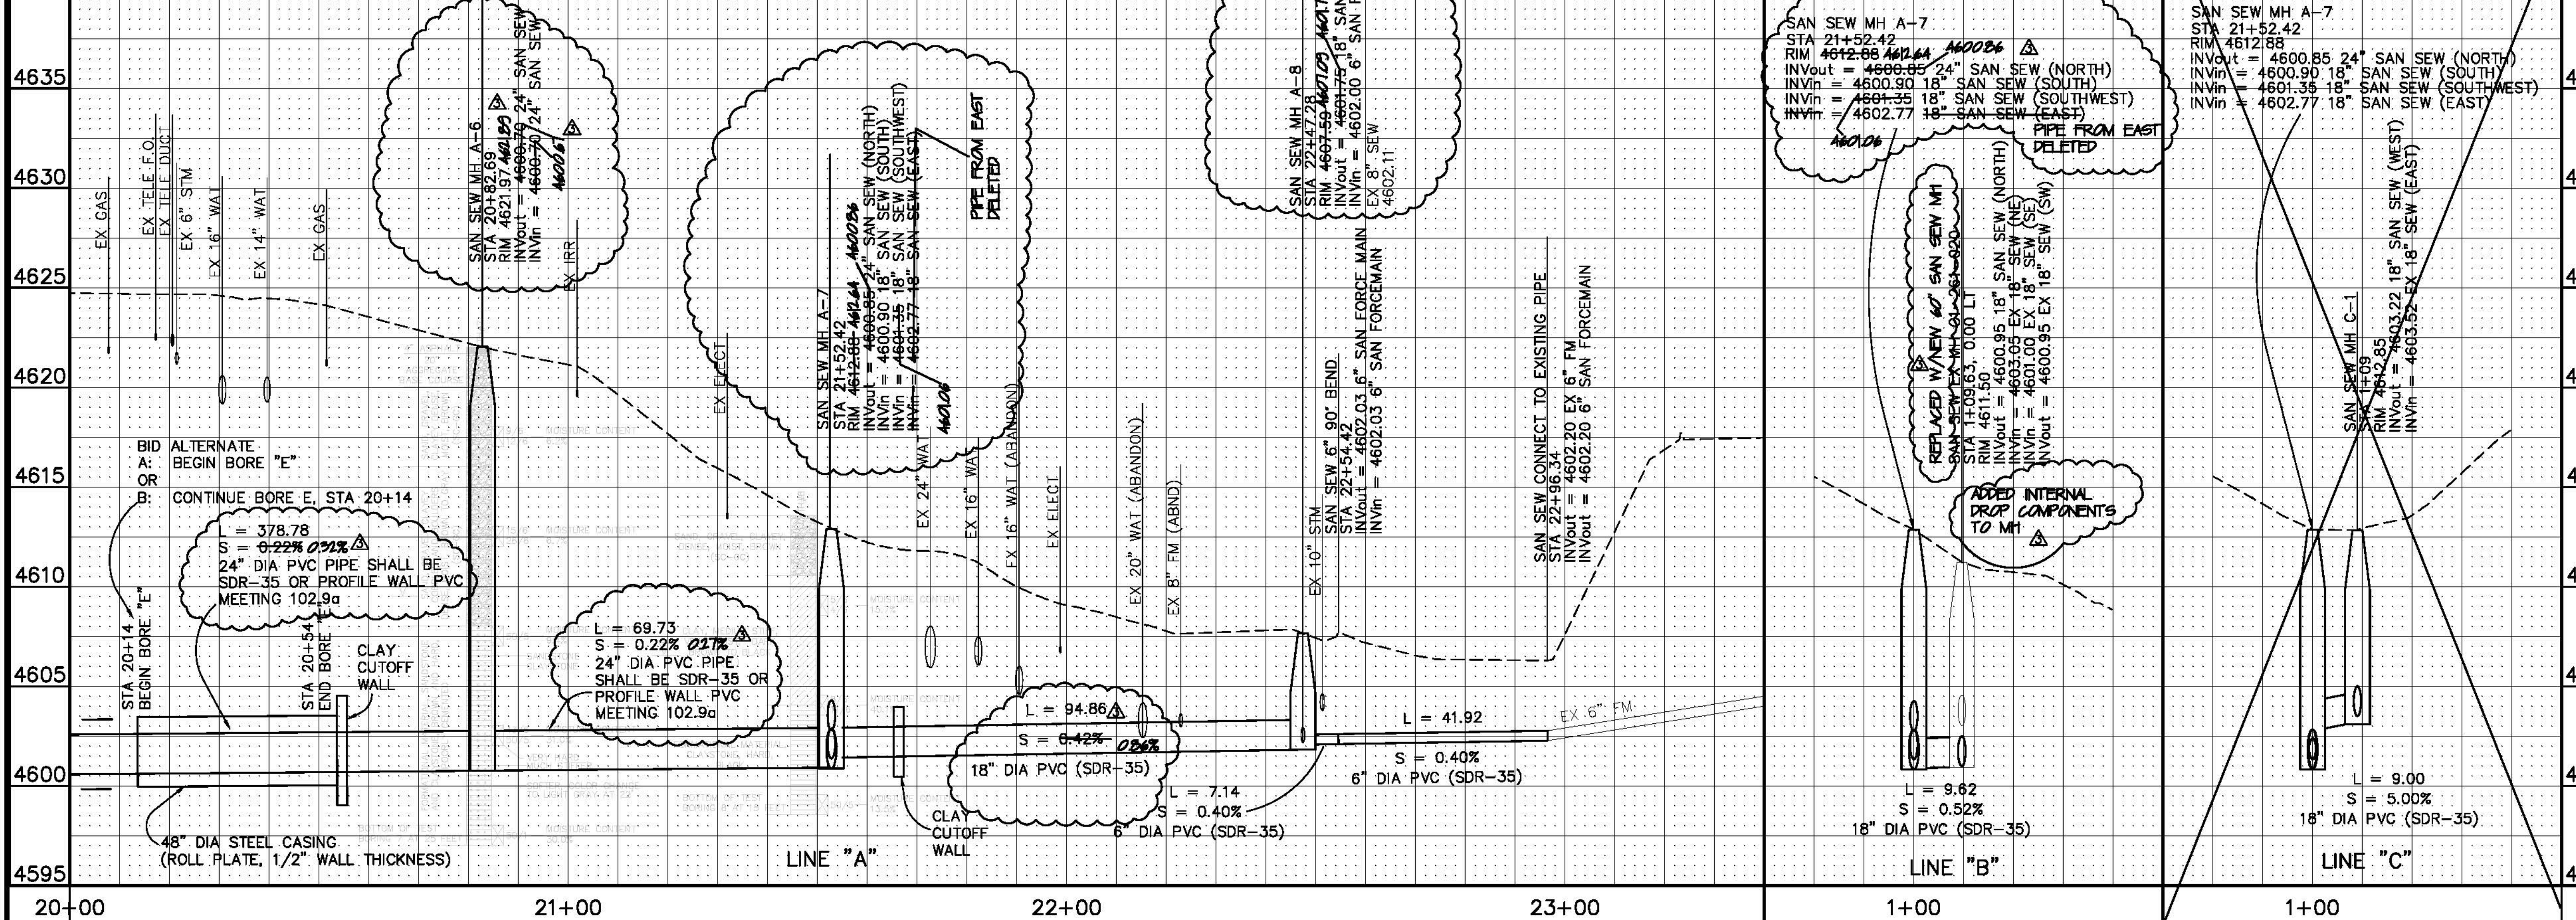


REVISION	DESCRIPTION	DATE	DRAWN BY	DATE
AS BUILT		2007-10-15	JCS	2005
DESIGNED BY				
CHECKED BY				
APPROVED BY				

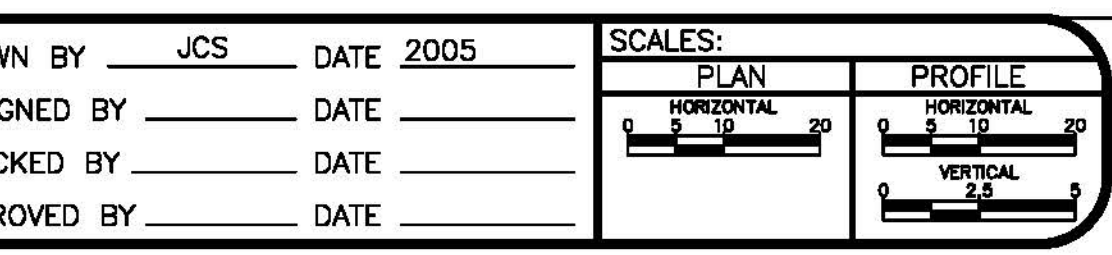

**PUBLIC WORKS AND UTILITIES ENGINEERING DIVISION**

**DUCK POND PARK LIFT STATION ELIMINATION AND GRAVITY SEWER CONSTRUCTION SANITARY SEWER PLAN AND PROFILES CANON STREET / DUCK POND PARK**

N:\Lamp\proj\1\F10114 (DUCK POND SEWER IMPROV).dwg\BASE-F10114 rev 7-7-05.dwg, 10, 6/10/2008 8:59:55 AM

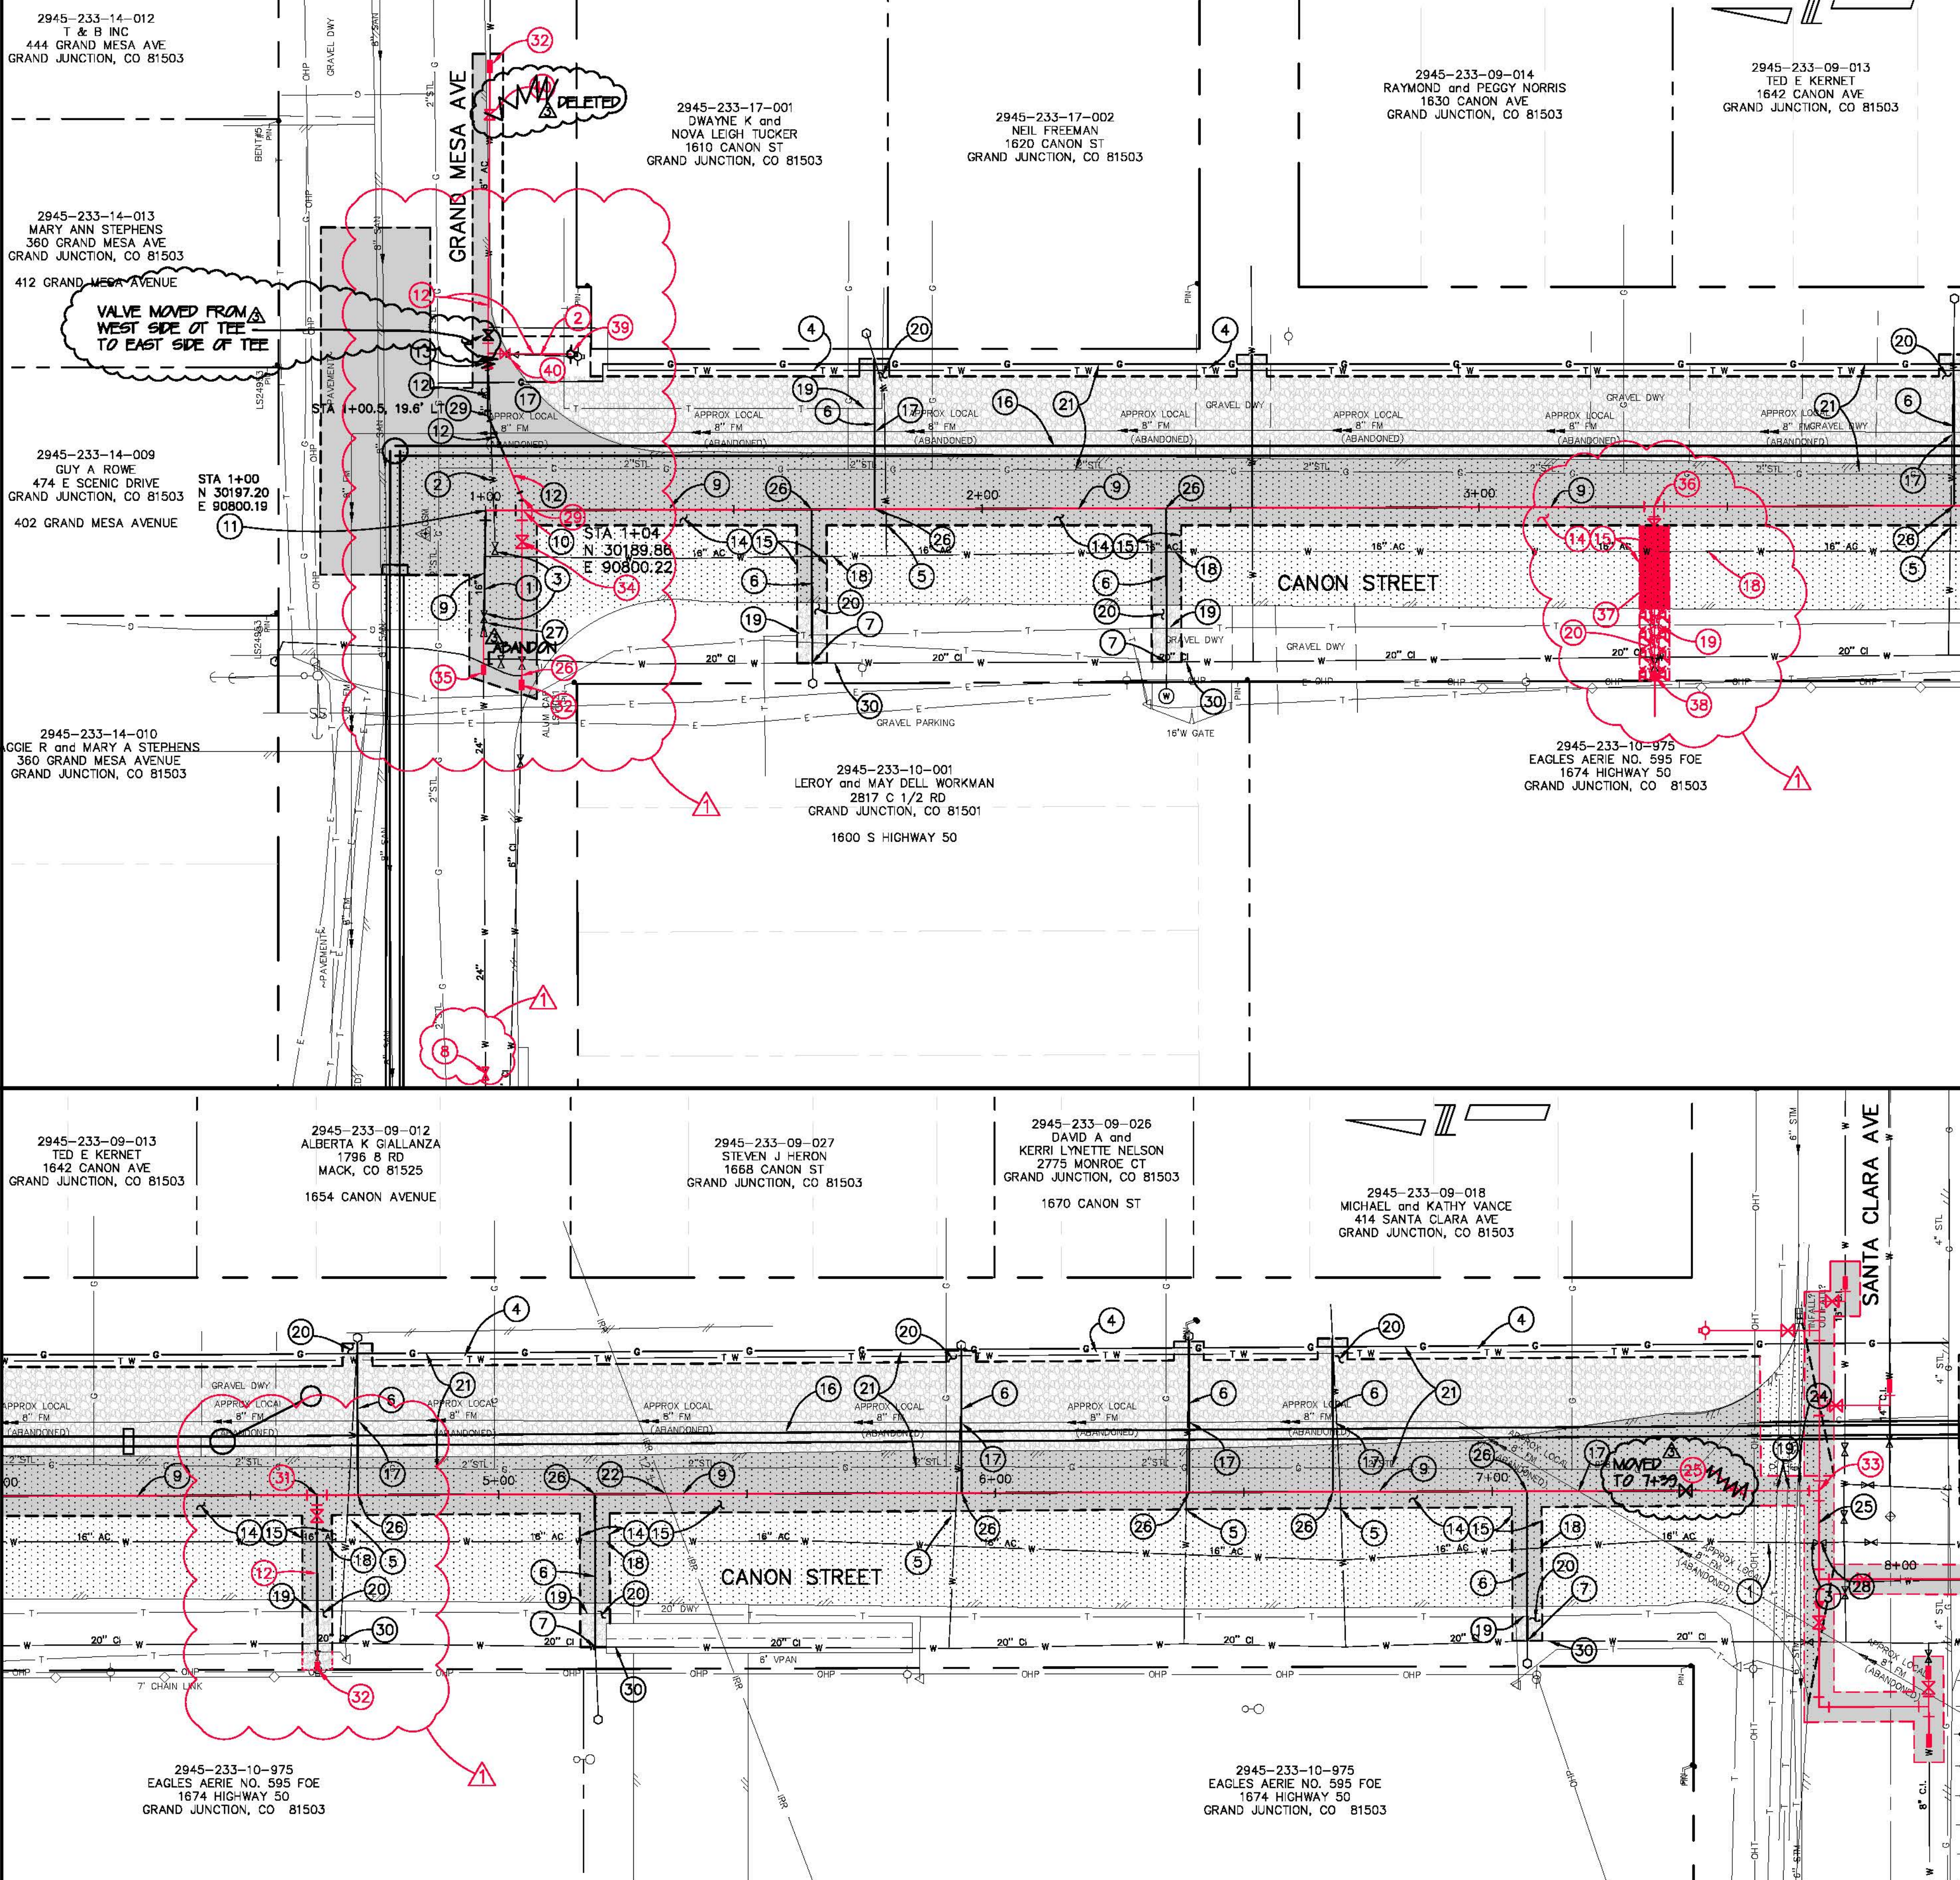

SEE BELOW  
MATCH LINE


- CONSTRUCTION NOTES**
- 202 - REMOVE EXISTING 16" AC WATERLINE.
  - 202 - REMOVE EXISTING 6" AC WATERLINE.
  - 202 - REMOVE EXISTING WATER VALVE AND RETURN TO CITY SHOPS.
  - CITY CREWS WILL BE PROVIDING WATER SERVICE THROUGH A TEMPORARY WATER LINE FOR THE RESIDENCES ON THE EAST SIDE OF CANON.
  - 202 - CAP EXISTING WATER SERVICE. WATER SERVICE WILL BE CAPPED OFF AT THE WEST EDGE OF TRENCH. REMOVE EXISTING WATER SERVICE AS NEEDED TO FACILITATE WATER CONSTRUCTION. THE CONTRACT UNIT PRICE FOR WATER LINE SHALL INCLUDE THE COST OF REMOVING EXISTING WATER SERVICE.
  - 104 - EXTEND WATER SERVICE FROM METER PIT FOR SERVICES ON THE EAST SIDE OF CANON AND FROM THE EXISTING WATER LINE FOR SERVICES ON THE WEST SIDE OF CANON AS NEEDED TO CONNECT TO THE CORP STOP ON THE NEW WATER LINE. THERE WILL BE NO SEPARATE PAY FOR EXCAVATIONS TO COMPLETE WORK AFTER WATER MAIN TESTING.
  - TURN OF CORP STOP AT EXISTING WATER LINE. THE CONTRACT UNIT PRICE FOR WATER LINE SHALL INCLUDE THE COST OF TURNING OFF CORP STOPS AS NEEDED.
  - FURNISH AND INSTALL 24" BUTTERFLY VALVE. CONNECT VALVE TO EXISTING 24" DIP WATER MAIN (MJ BY MJ). THE CONTRACT UNIT PRICE FOR THE 24" BUTTERFLY VALVE SHALL INCLUDE THE COST OF ALL CONNECTIONS.
  - 104 - FURNISH AND INSTALL 24" C-905, CLASS 165, DR25, PVC WATERLINE. TRENCH BACKFILL SHALL MEET THE REQUIREMENTS OF CITY SPECIFICATION 103.15, 103.16, AND TYPICAL TRENCH DETAIL GU-03.
  - 104 - FURNISH AND INSTALL A 24" X 24" X 6" X 6" DIP CROSS. CONNECT (MJ BY MJ) TO 24" PVC. (MJ BY MJ) TO 6" PVC. THE CONTRACT UNIT PRICE FOR 24" X 24" X 6" X 6" DIP CROSS SHALL INCLUDE THE COST OF ALL CONNECTIONS. RESTRAIN ALL JOINTS ON THE 24" PVC AND 6" PVC WATER LINES WITHIN 55' OF THE CROSS. (REFER TO PAGE W-07 OF THE STANDARD CONTRACT DOCUMENTS)
  - 104 - FURNISH AND INSTALL A 24" - 90° DIP BEND, CONNECT (MJ BY MJ) TO 24" PVC. PLACE CONCRETE THRUST BLOCK AT 90° BEND TO RESTRAIN 24" PVC WATER MAIN. THE CONTRACT UNIT PRICE FOR 24" - 90° DIP BEND SHALL INCLUDE THE COST OF ALL CONNECTIONS. (REFER TO PAGE W-07 OF THE STANDARD CONTRACT DOCUMENTS)
  - 104 - FURNISH AND INSTALL 6" C-900, CLASS 150, DR18, PVC WATERLINE. ALL JOINTS SHALL HAVE JOINT RESTRAINT.
  - FURNISH AND INSTALL 6" GATE VALVE AND 6" X 6" X 6" DIP TEE. ALL CONNECTIONS SHALL BE RESTRAINED. THE CONTRACT UNIT PRICE FOR THE 6" GATE VALVE AND 6" X 6" X 6" DIP TEE SHALL INCLUDE THE COST OF ALL CONNECTIONS.
  - 103.3 - ASPHALT REMOVAL: CUT AND REMOVE PAVEMENT AS SHOWN.
  - 401 - HOT BITUMINOUS PAVEMENT (3" THICK) (GRADING SX) 304 - AGGREGATE BASE COURSE (CLASS 6) (6" THICK) (SEE CITY OF GRAND JUNCTION STANDARD DETAIL GU-03)
  - SEE SHEETS 7, 8, AND 9 FOR SEWER LINE CONSTRUCTION.
  - 202 - REMOVE PIPE - ABANDONED 8" FORCE MAIN TO BE REMOVED AS NEEDED TO FACILITATE WATER INSTALLATION.
  - AFTER CITY CREWS HAVE ESTABLISHED TEMPORARY WATER SERVICES THE EXISTING 16" AC WATER LINE WILL BE TAKEN OUT OF SERVICE.
  - PROTECT UNDERGROUND TELEPHONE LINE. TELEPHONE LINE SHALL REMAIN IN SERVICE DURING CONSTRUCTION.
  - 304 - AGGREGATE BASE COURSE (CLASS 6) (4" THICK)
  - EXISTING GAS LINE TO BE RELOCATED BY XCEL ENERGY TO THIS PROPOSED LOCATION. PROTECT NEW GAS LINE. NEW GAS LINE SHALL REMAIN IN SERVICE DURING CONSTRUCTION. ABANDON GAS LINE MAY BE REMOVED AS NEEDED TO FACILITATE WATER CONSTRUCTION.
  - PROTECT IRRIGATION PIPE. IRRIGATION PIPE SHALL REMAIN IN SERVICE DURING CONSTRUCTION.
  - NOT USED
  - 202 - REMOVE 6" STORM DRAIN PIPE AS NEEDED FOR EXCAVATION. 102.106 - 6" STORM DRAIN (C-900 PVC). THE COST OF CONNECTIONS TO EXISTING PIPE SHALL BE CONSIDERED INCIDENTAL AND WILL NOT BE MEASURED AND PAID FOR SEPARATELY.
  - FURNISH AND INSTALL 24" BUTTERFLY VALVE. CONNECT VALVE TO 24" PVC WATER MAIN (MJ BY MJ). THE CONTRACT UNIT PRICE FOR THE 24" BUTTERFLY VALVE SHALL INCLUDE THE COST OF ALL CONNECTIONS.
  - FURNISH AND INSTALL A TAPPING SADDLE AND CORP. STOP.
  - 27 202 - REMOVE EXISTING 24" X 16" REDUCER. THE CONTRACT UNIT PRICE FOR REMOVING 16" AC WATERLINE SHALL INCLUDE THE COST OF REMOVING THIS REDUCER.
  - 104 - FURNISH AND INSTALL A 24" X 24" X 16" DIP TEE. CONNECT 16" LEG OF TEE (SOUTH) TO SOLID SLEEVE AND SOLID SLEEVE TO EXISTING 16" CI WATER MAIN. CONNECT 24" LEG (EAST) TO 24" PVC WATER MAIN (MJ BY MJ). CONNECT 24" LEG OF TEE (WEST) TO RESTRAINED CAP. RESTRAIN ALL JOINTS ON THE 24" PVC WATER LINE WITHIN 135' OF THE TEE. PLACE CONCRETE THRUST BLOCK NORTH OF TEE TO RESTRAIN EXISTING 16" AC WATER LINE. THE CONTRACT UNIT PRICE FOR 24" X 24" X 16" DIP TEE SHALL INCLUDE THE COST OF SOLID SLEEVE, RESTRAINED CAP, AND CONNECTIONS TO PIPE.
  - 104 - FURNISH AND INSTALL A 6" - 22 1/2" DIP BEND, CONNECT (MJ BY MJ) TO 6" PVC WATER MAIN. THE CONTRACT UNIT PRICE FOR BENDS SHALL INCLUDE THE COST OF ALL CONNECTIONS (REFER TO PAGES W-07 OF THE STANDARD CONTRACT DOCUMENTS)
  - PROTECT EXISTING 20" CI WATER MAIN IN PLACE. WATER MAIN SHALL REMAIN IN SERVICE DURING CONSTRUCTION.
  - 104 - FURNISH AND INSTALL A 24" X 24" X 6" DIP TEE. CONNECT (MJ BY MJ) TO 24" PVC AND 6" PVC. FURNISH AND INSTALL 6" GATE VALVE. CONNECT (MJ BY MJ) TO 6" PVC. THE CONTRACT UNIT PRICE FOR TEE AND VALVE SHALL INCLUDE THE COST FOR ALL CONNECTIONS. RESTRAIN ALL JOINTS ON THE 24" AND 6" PVC WATER LINES WITHIN 18' OF THE TEE. (REFER TO PAGE W-07 OF THE STANDARD CONTRACT DOCUMENTS)
  - 104 - FURNISH AND INSTALL SOLID SLEEVE OR DRESSER COUPLING (HIGH MAX). CONNECT EXISTING 6" AC WATER LINE TO NEW 6" PVC WATER LINE USING DRESSER. CONNECT EXISTING 6" CI WATER LINE TO NEW 6" PVC WATER LINE USING SOLID SLEEVE. THE CONTRACT UNIT PRICE FOR 6" WATERLINE SHALL INCLUDE THE COST OF SOLID SLEEVE OR DRESSER AND CONNECTIONS TO EXISTING PIPE.
  - 104 - FURNISH AND INSTALL A 24" X 24" X 24" DIP TEE. CONNECT THE WEST AND NORTH LEGS OF THE TEE TO 24" PVC WATER MAIN (MJ BY MJ). CONNECT SOUTH LEG OF TEE TO RESTRAINED CAP. THE CONTRACT UNIT PRICE FOR 24" X 24" X 24" DIP TEE SHALL INCLUDE THE COST OF RESTRAINED CAP AND CONNECTIONS TO PIPE. SEE SHEET 11
  - 104 - FURNISH AND INSTALL 6" GATE VALVE. CONNECT (MJ BY MJ) TO 6" PVC WATER LINE. THE CONTRACT UNIT PRICE FOR 6" VALVE SHALL INCLUDE COST FOR ALL CONNECTIONS.
  - 104 - FURNISH AND INSTALL SOLID SLEEVE. CONNECT EXISTING 24" DIP WATER LINE TO NEW 24" PVC WATER LINE ON THE WEST SIDE OF THE EXISTING 24" X 24" X 20" TEE. THE CONTRACT UNIT PRICE FOR 24" WATERLINE SHALL INCLUDE THE COST OF SOLID SLEEVE AND CONNECTIONS TO EXISTING PIPE.
  - 104 - FURNISH AND INSTALL A 24" X 24" X 4" DIP TEE. CONNECT (MJ BY MJ) TO 24" PVC AND 4" PVC. FURNISH AND INSTALL 4" GATE VALVE. CONNECT (MJ BY MJ) TO 4" PVC. THE CONTRACT UNIT PRICE FOR TEE AND VALVE SHALL INCLUDE THE COST FOR ALL CONNECTIONS. RESTRAIN ALL JOINTS ON THE 24" AND 4" PVC WATER LINES WITHIN 18' OF THE TEE. (REFER TO PAGE W-07 OF THE STANDARD CONTRACT DOCUMENTS).
  - 104 - FURNISH AND INSTALL 4" C-900, CLASS 150, DR18, PVC WATERLINE. ALL JOINTS SHALL HAVE JOINT RESTRAINT.
  - 104 - FURNISH AND INSTALL SOLID SLEEVE. CONNECT EXISTING 4" PVC FIRE LINE TO NEW 4" PVC WATER LINE. THE CONTRACT UNIT PRICE FOR 4" WATER LINE SHALL INCLUDE THE COST OF SOLID SLEEVE AND CONNECTIONS TO EXISTING PIPE.
  - 202/104 - REMOVE EXISTING HYDRANT AND RETURN TO CITY SHOPS. FURNISH AND INSTALL FIRE HYDRANT.
  - 104 - FURNISH AND INSTALL 6" GATE VALVE. CONNECT VALVE TO 6" PVC WATER MAIN (MJ BY MJ). THE CONTRACT UNIT PRICE FOR 6" GATE VALVE SHALL INCLUDE THE COST OF ALL CONNECTIONS.

REVISION	DESCRIPTION	DATE	DRAWN BY	DATE	SCALE:
REVISION A	CHANGES TO DESIGN AND CONST. NOTES	4/14/05	JCS	2005	
REVISION B	CHANGES TO DESIGN AND CONST. NOTES	7/13/05			
REVISION C	AS BUILT	2007-10-15			
REVISION D					

CITY OF **Grand Junction** COLORADO


**PUBLIC WORKS AND UTILITIES ENGINEERING DIVISION**

**DUCK POND PARK LIFT STATION ELIMINATION AND GRAVITY SEWER CONSTRUCTION WATER LINE REPLACEMENT PLANS CANON STREET**

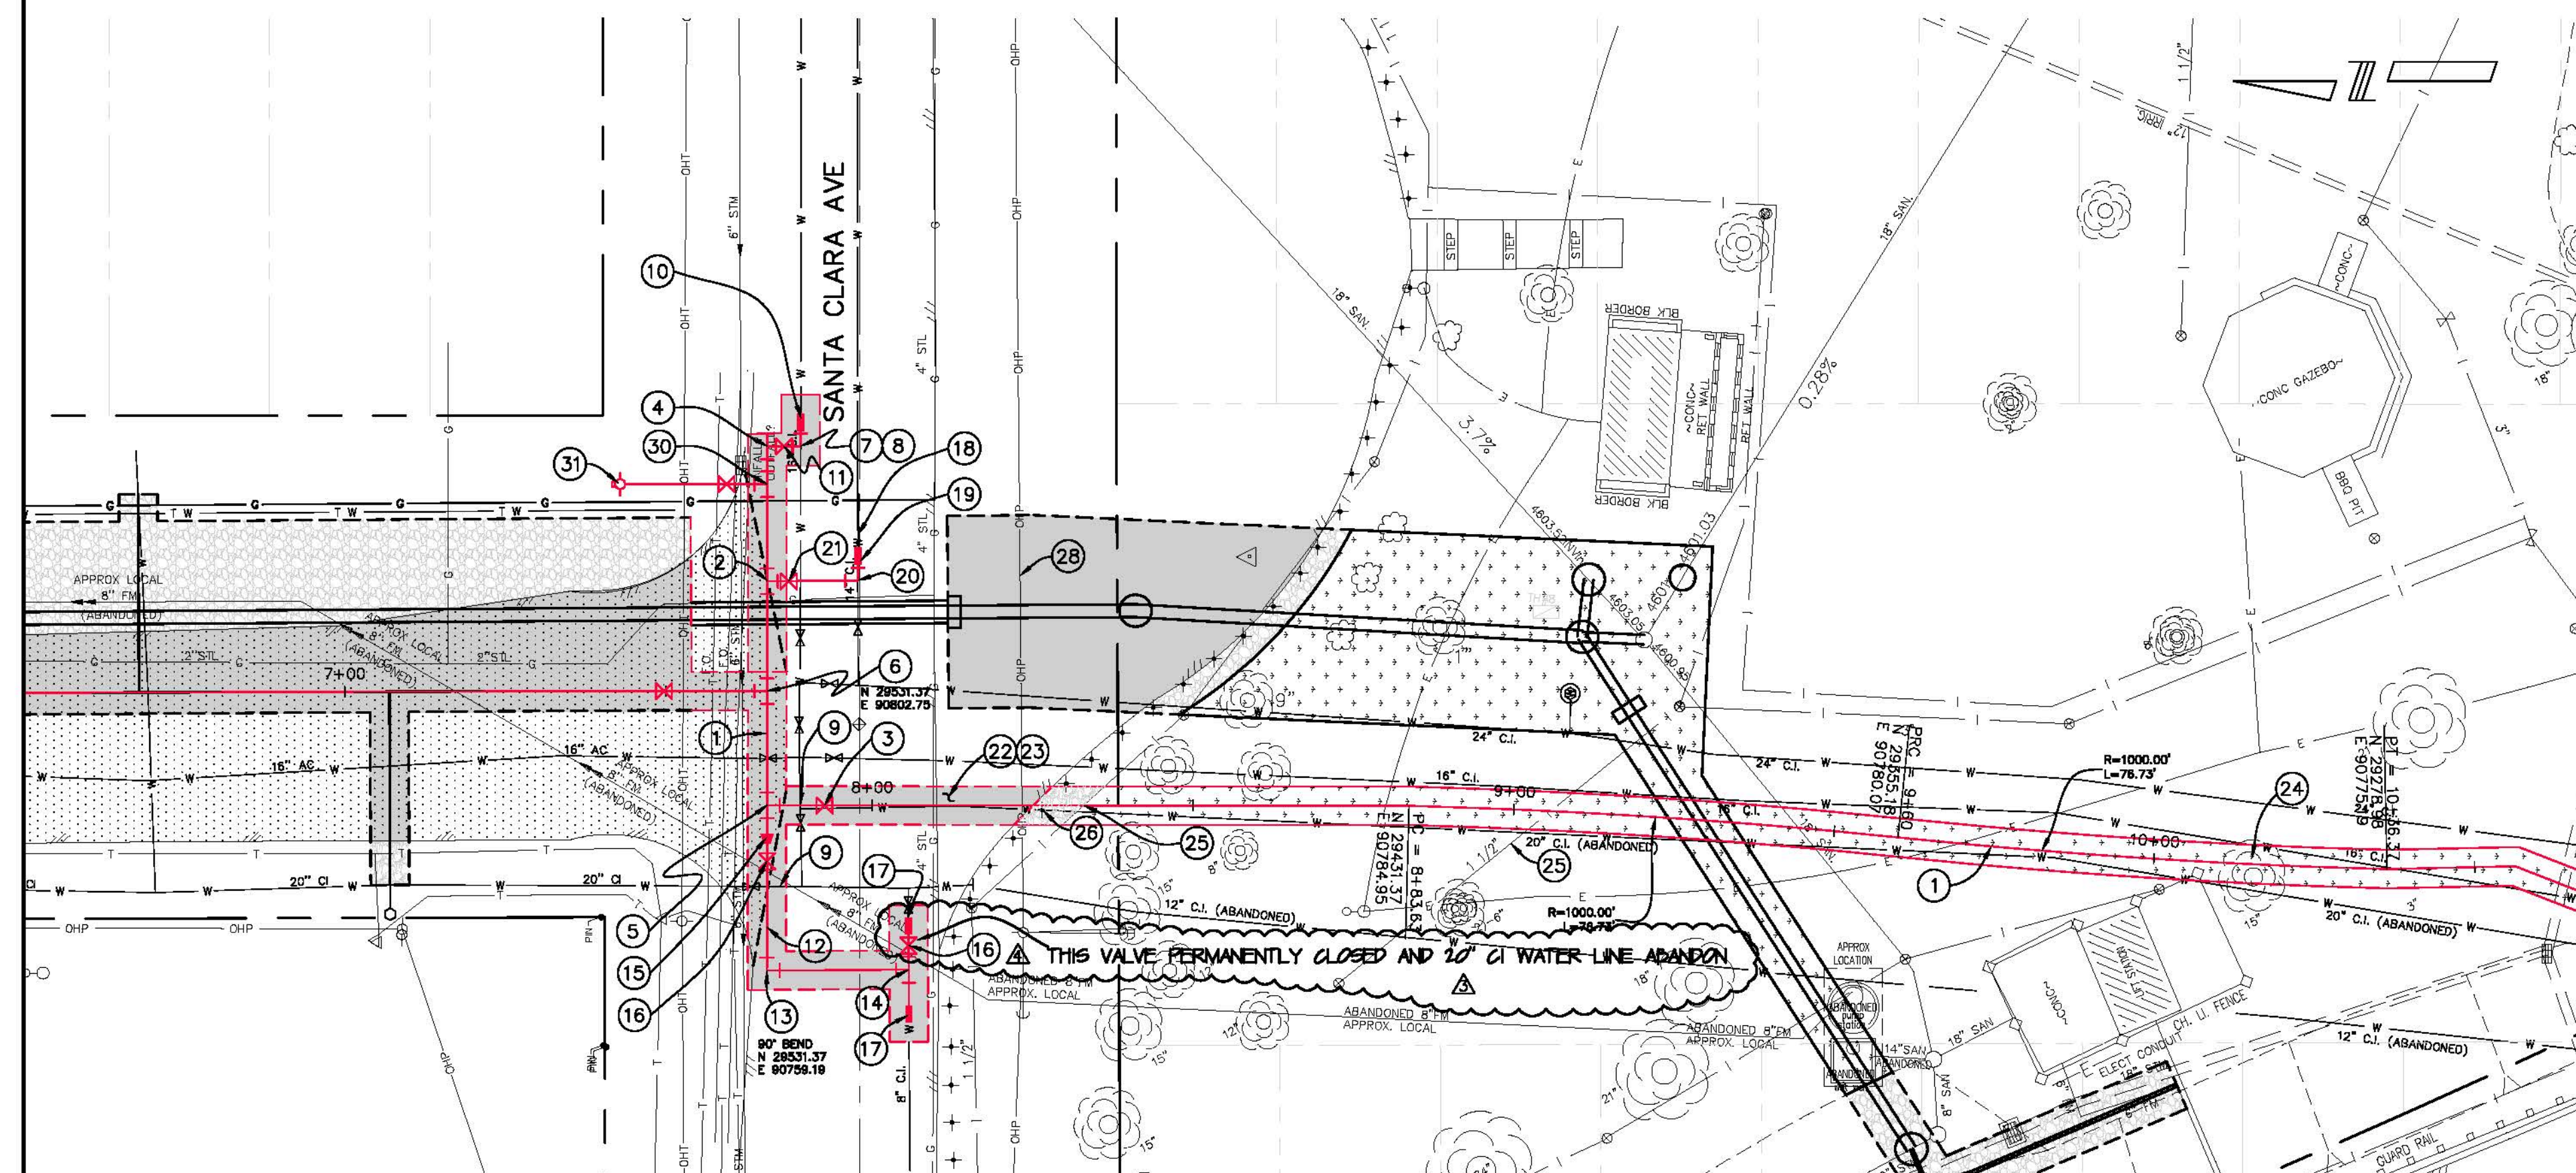

PROJECT CONTROL DATA

POINT	NORTHING	EASTING	STATION	OFFSET	ELEVATION	DESCRIPTION
702	30876.29	90338.28	2+82.29	38.43	4628.05	NO 5 REBAR
700	30208.76	90491.54			4628.01	GIS HINGE NAIL
402	30209.28	90795.54	13+24.64	6.15	4629.15	CITY SURVEY MONUMENT
407	29517.07	90797.60	20+39.50	17.40	4624.08	CITY SURVEY MONUMENT

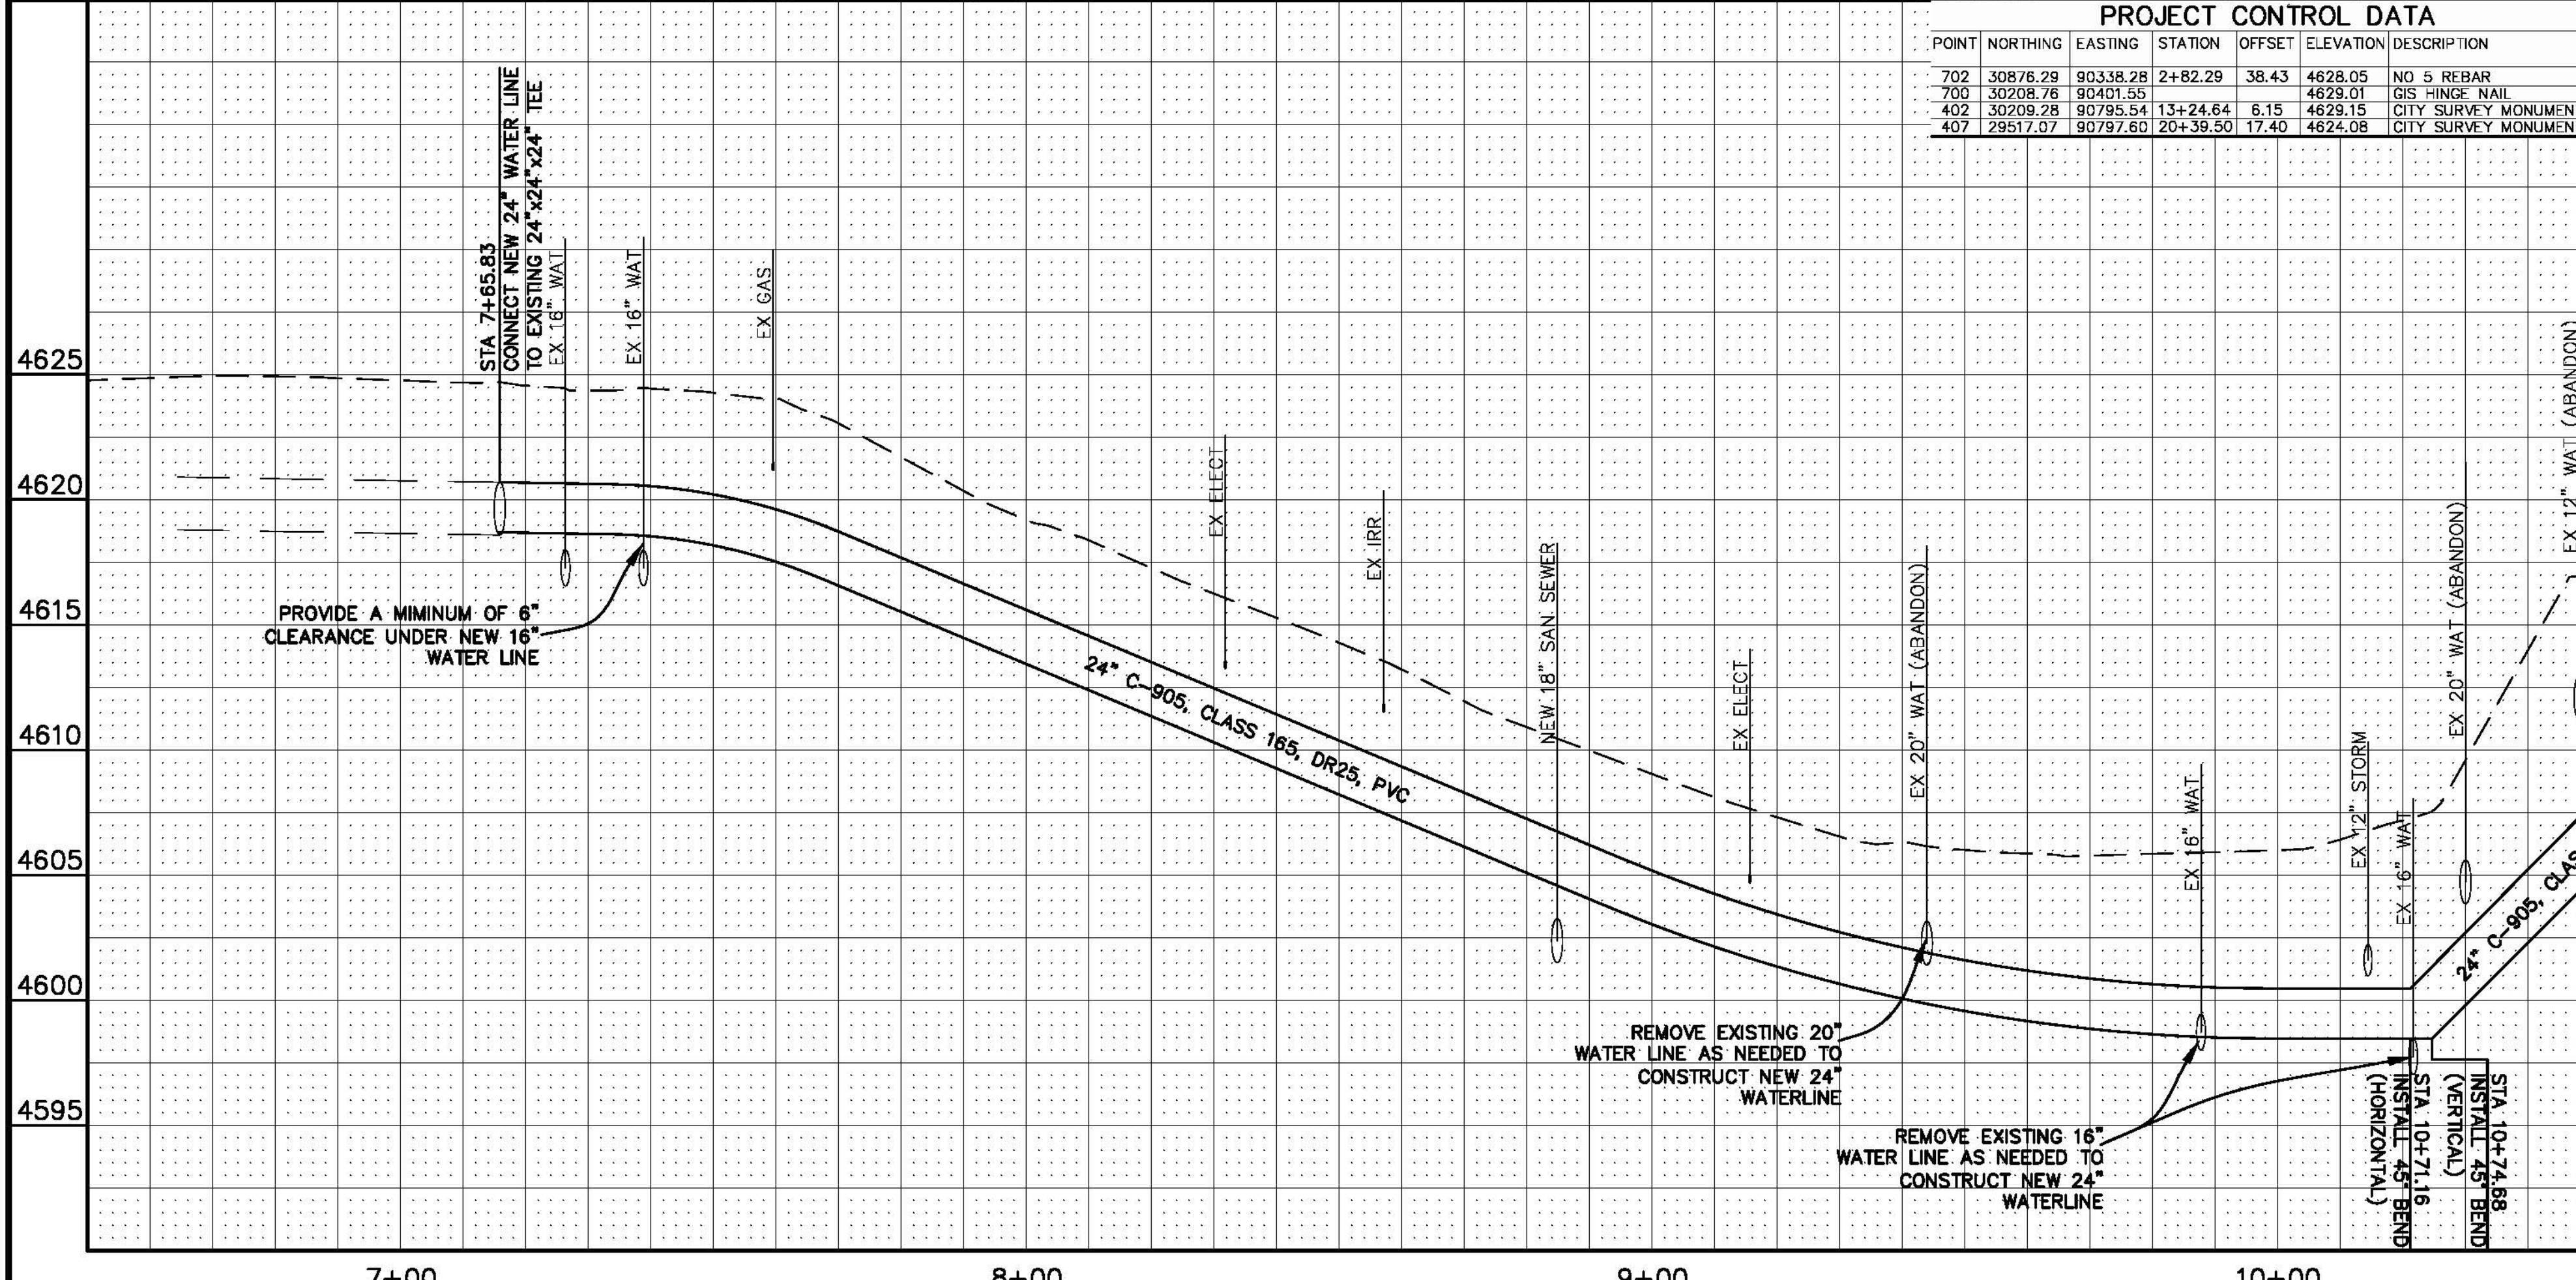

- 1 104 - FURNISH AND INSTALL 24" C-905, CLASS 165, DR25, PVC WATERLINE. TRENCH BACKFILL SHALL MEET THE REQUIREMENTS OF CITY SPECIFICATION 103.15, 103.16, AND TYPICAL TRENCH DETAIL GU-03.
- 2 104 - FURNISH AND INSTALL A 24"x24"x14" DIP TEE, CONNECT (MJ BY MJ) TO 14" AND 24" PVC, PLACE CONCRETE THRUST BLOCK AT TEE TO RESTRAIN 24" PVC WATER MAIN. THE CONTRACT UNIT PRICE FOR 24"x24"x14" DIP TEE SHALL INCLUDE THE COST OF ALL CONNECTIONS. (REFER TO PAGE W-07 OF THE STANDARD CONTRACT DOCUMENTS)
- 3 FURNISH AND INSTALL 24" BUTTERFLY VALVE. CONNECT VALVE TO 24" PVC WATER MAIN (MJ BY MJ). THE CONTRACT UNIT PRICE FOR THE 24" BUTTERFLY VALVE SHALL INCLUDE THE COST OF ALL CONNECTIONS.
- 4 104 - FURNISH AND INSTALL A 24" X 24" X 16" DIP TEE. CONNECT 16" LEG OF TEE (SOUTH) TO 16" BUTTERFLY VALVE. CONNECT 24" LEG TO 24" PVC WATER MAIN (MJ BY MJ). CONNECT 24" LEG (EAST) TO RESTRAINED CAP. RESTRAIN ALL JOINTS ON THE 24" PVC WATER LINE WITHIN 40' OF THE TEE. PLACE CONCRETE THRUST BLOCK NORTH OF TEE TO RESTRAIN EXISTING 16" CI WATER LINE. THE CONTRACT UNIT PRICE FOR 24" X 24" X 16" DIP TEE SHALL INCLUDE THE COST OF, RESTRAINED CAP, AND CONNECTIONS TO PIPE.
- 5 104 - FURNISH AND INSTALL A 24"x24"x24" DIP TEE. CONNECT EAST AND SOUTH LEGS OF THE TEE TO 24" PVC WATER MAIN (MJ BY MJ). CONNECT WEST LEG TO 24"x8" DIP REDUCER. RESTRAIN ALL JOINTS ON THE 24" PVC WATER LINE FROM WATER LINE STA. 6+42 TO STA. 9+10 (268 L.F.) AND THE 24" WATER MAIN GOING EAST ON SANTA CLARA (40 L.F.). PLACE CONCRETE THRUST BLOCK NORTH OF THE TEE. THE CONTRACT UNIT PRICE FOR THE 24"x24"x24" DIP TEE SHALL INCLUDE THE COST OF ALL CONNECTIONS.
- 6 104 - FURNISH AND INSTALL A 24" X 24" X 24" DIP TEE. CONNECT ALL LEGS OF THE TEE TO 24" PVC WATER MAIN (MJ BY MJ). PLACE CONCRETE THRUST BLOCK SOUTH OF TEE. THE CONTRACT UNIT PRICE FOR 24" X 24" X 24" DIP TEE SHALL INCLUDE THE COST OF CONNECTIONS TO PIPE.
- 7 104 - FURNISH AND INSTALL 16" C-905, CLASS 165, DR25, PVC WATERLINE. ALL JOINTS SHALL HAVE JOINT RESTRAINT.
- 8 104 - FURNISH AND INSTALL A 16" 90° DIP BEND, CONNECT (MJ BY MJ) TO 16" PVC, PLACE CONCRETE THRUST BLOCK AT 90° BEND TO RESTRAIN 16" PVC WATER MAIN. THE CONTRACT UNIT PRICE FOR 16" 90° DIP BEND SHALL INCLUDE THE COST OF ALL CONNECTIONS (REFER TO PAGES W-07 OF THE STANDARD CONTRACT DOCUMENTS)
- 9 PROTECT EXISTING 20" CI WATER MAIN IN PLACE. WATER MAIN SHALL REMAIN IN SERVICE DURING CONSTRUCTION.
- 10 104 - FURNISH AND INSTALL SOLID SLEEVE. CONNECT EXISTING 16" CI WATER LINE TO NEW 16" PVC WATER LINE USING SOLID SLEEVE. THE CONTRACT UNIT PRICE FOR 16" WATERLINE SHALL INCLUDE THE COST OF SOLID SLEEVE AND CONNECTIONS TO EXISTING PIPE.
- 11 104 - FURNISH AND INSTALL 16" BUTTERFLY VALVE. CONNECT VALVE TO 16" PVC WATER MAIN (MJ BY MJ). THE CONTRACT UNIT PRICE FOR 16" BUTTERFLY VALVE SHALL INCLUDE THE COST OF ALL CONNECTIONS.
- 12 104 - FURNISH AND INSTALL 8" C-900, CLASS 150, DR18, PVC WATERLINE. ALL JOINTS SHALL HAVE JOINT RESTRAINT.
- 13 104 - FURNISH AND INSTALL A 8" - 90° DIP BEND, CONNECT (MJ BY MJ) TO 8" PVC, PLACE CONCRETE THRUST BLOCK AT 90° BEND TO RESTRAIN 8" PVC WATER MAIN. THE CONTRACT UNIT PRICE FOR 8" - 90° DIP BEND SHALL INCLUDE THE COST OF ALL CONNECTIONS. (REFER TO PAGE W-07 OF THE STANDARD CONTRACT DOCUMENTS)
- 14 104 - FURNISH AND INSTALL A 8"x8"x8" DIP TEE. CONNECT ALL LEGS OF THE TEE TO 8" PVC WATER MAIN, (MJ BY MJ). PLACE CONCRETE THRUST BLOCK SOUTH OF TEE. THE CONTRACT UNIT PRICE FOR 8"x8"x8" DIP TEE SHALL INCLUDE THE COST OF CONNECTIONS TO PIPE.
- 15 104 - FURNISH AND INSTALL A 24"x8" DIP REDUCER, CONNECT (MJ BY MJ) TO 24"x24"x24" DIP TEE AND 8" GATE VALVE. THE CONTRACT UNIT PRICE FOR 8"x8"x8" DIP TEE SHALL INCLUDE THE COST OF CONNECTIONS TO PIPE.
- 16 104 - FURNISH AND INSTALL 8" GATE VALVE. CONNECT VALVE TO 8" PVC WATER MAIN (MJ BY MJ). THE CONTRACT UNIT PRICE FOR 8" GATE VALVE SHALL INCLUDE THE COST OF ALL CONNECTIONS.
- 17 104 - FURNISH AND INSTALL SOLID SLEEVE. CONNECT EXISTING 8" CI WATER LINE TO NEW 8" PVC WATER LINE USING SOLID SLEEVE. THE CONTRACT UNIT PRICE FOR 8" WATERLINE SHALL INCLUDE THE COST OF SOLID SLEEVE AND CONNECTIONS TO EXISTING PIPE.
- 18 104 - FURNISH AND INSTALL 14" C-905, CLASS 165, DR25, PVC WATERLINE. ALL JOINTS SHALL HAVE JOINT RESTRAINT.
- 19 104 - FURNISH AND INSTALL SOLID SLEEVE. CONNECT EXISTING 14" PVC WATER LINE TO NEW 14" PVC WATER LINE. THE CONTRACT UNIT PRICE FOR 14" WATER LINE SHALL INCLUDE THE COST OF SOLID SLEEVE AND CONNECTIONS TO EXISTING PIPE.
- 20 104 - FURNISH AND INSTALL A 14" 90° DIP BEND, CONNECT (MJ BY MJ) TO 14" PVC, PLACE CONCRETE THRUST BLOCK AT 90° BEND TO RESTRAIN 14" PVC WATER MAIN. THE CONTRACT UNIT PRICE FOR 14" 90° DIP BEND SHALL INCLUDE THE COST OF ALL CONNECTIONS (REFER TO PAGES W-07 OF THE STANDARD CONTRACT DOCUMENTS)
- 21 104 - FURNISH AND INSTALL 14" BUTTERFLY VALVE. CONNECT VALVE TO 14" PVC WATER MAIN (MJ BY MJ). THE CONTRACT UNIT PRICE FOR 14" BUTTERFLY VALVE SHALL INCLUDE THE COST OF ALL CONNECTIONS.
- 22 103.3 - ASPHALT REMOVAL: CUT AND REMOVE PAVEMENT AS SHOWN.
- 23 401-HOT BITUMINOUS PAVEMENT (3" THICK) (GRADING SX) 304 - AGGREGATE BASE COURSE (CLASS 6) (6" THICK) (SEE CITY OF GRAND JUNCTION STANDARD DETAIL GU-03)
- 24 202 - REMOVE TREE
- 25 210 - RESET SPRINKLER SYSTEM.
- 26 210 - RESET POST
- 27 210 - RESET GUARDRAIL AS NEEDED FOR WATER LINE CONSTRUCTION AND PAVEMENT RESTORATION.
- 28 PROTECT OVERHEAD POWER LINE. OVERHEAD POWER LINE SHALL REMAIN IN SERVICE DURING CONSTRUCTION.
- 29 PROTECT UNDERGROUND ELECTRIC LINE. ELECTRIC LINE SHALL REMAIN IN SERVICE DURING CONSTRUCTION.
- 30 FURNISH AND INSTALL 6" GATE VALVE AND 24" X 24" X 6" DIP TEE. ALL CONNECTIONS SHALL BE RESTRAINED. THE CONTRACT UNIT PRICE FOR THE 6" GATE VALVE AND 24" X 24" X 6" DIP TEE SHALL INCLUDE THE COST OF ALL CONNECTIONS.
- 31 FURNISH AND INSTALL FIRE HYDRANT ASSEMBLY.


N:\Lamp\proj\F10114 (DUCK POND SEWER IMPROV).dwg BASE-F10114 rev 7-7-05.dwg, II, 6/10/2008 9:01:36 AM

REVISION	DESCRIPTION	DATE	DRAWN BY	JCS	DATE	2005	SCALE:
REVISION	NEW DRAWING FOR CONTINUATION OF	7/13/05	DESIGNED BY		DATE		
REVISION	NEW 24" WATER LINE IN CANON STREET		CHECKED BY		DATE		
REVISION	ADDITIONAL EXISTING TOPO	7/27/05	APPROVED BY		DATE		
REVISION	AS BUILT	1007-10-15					



**PUBLIC WORKS AND UTILITIES ENGINEERING DIVISION**

**DUCK POND PARK LIFT STATION ELIMINATION AND GRAVITY SEWER CONSTRUCTION WATER LINE REPLACEMENT PLANS CANON STREET**

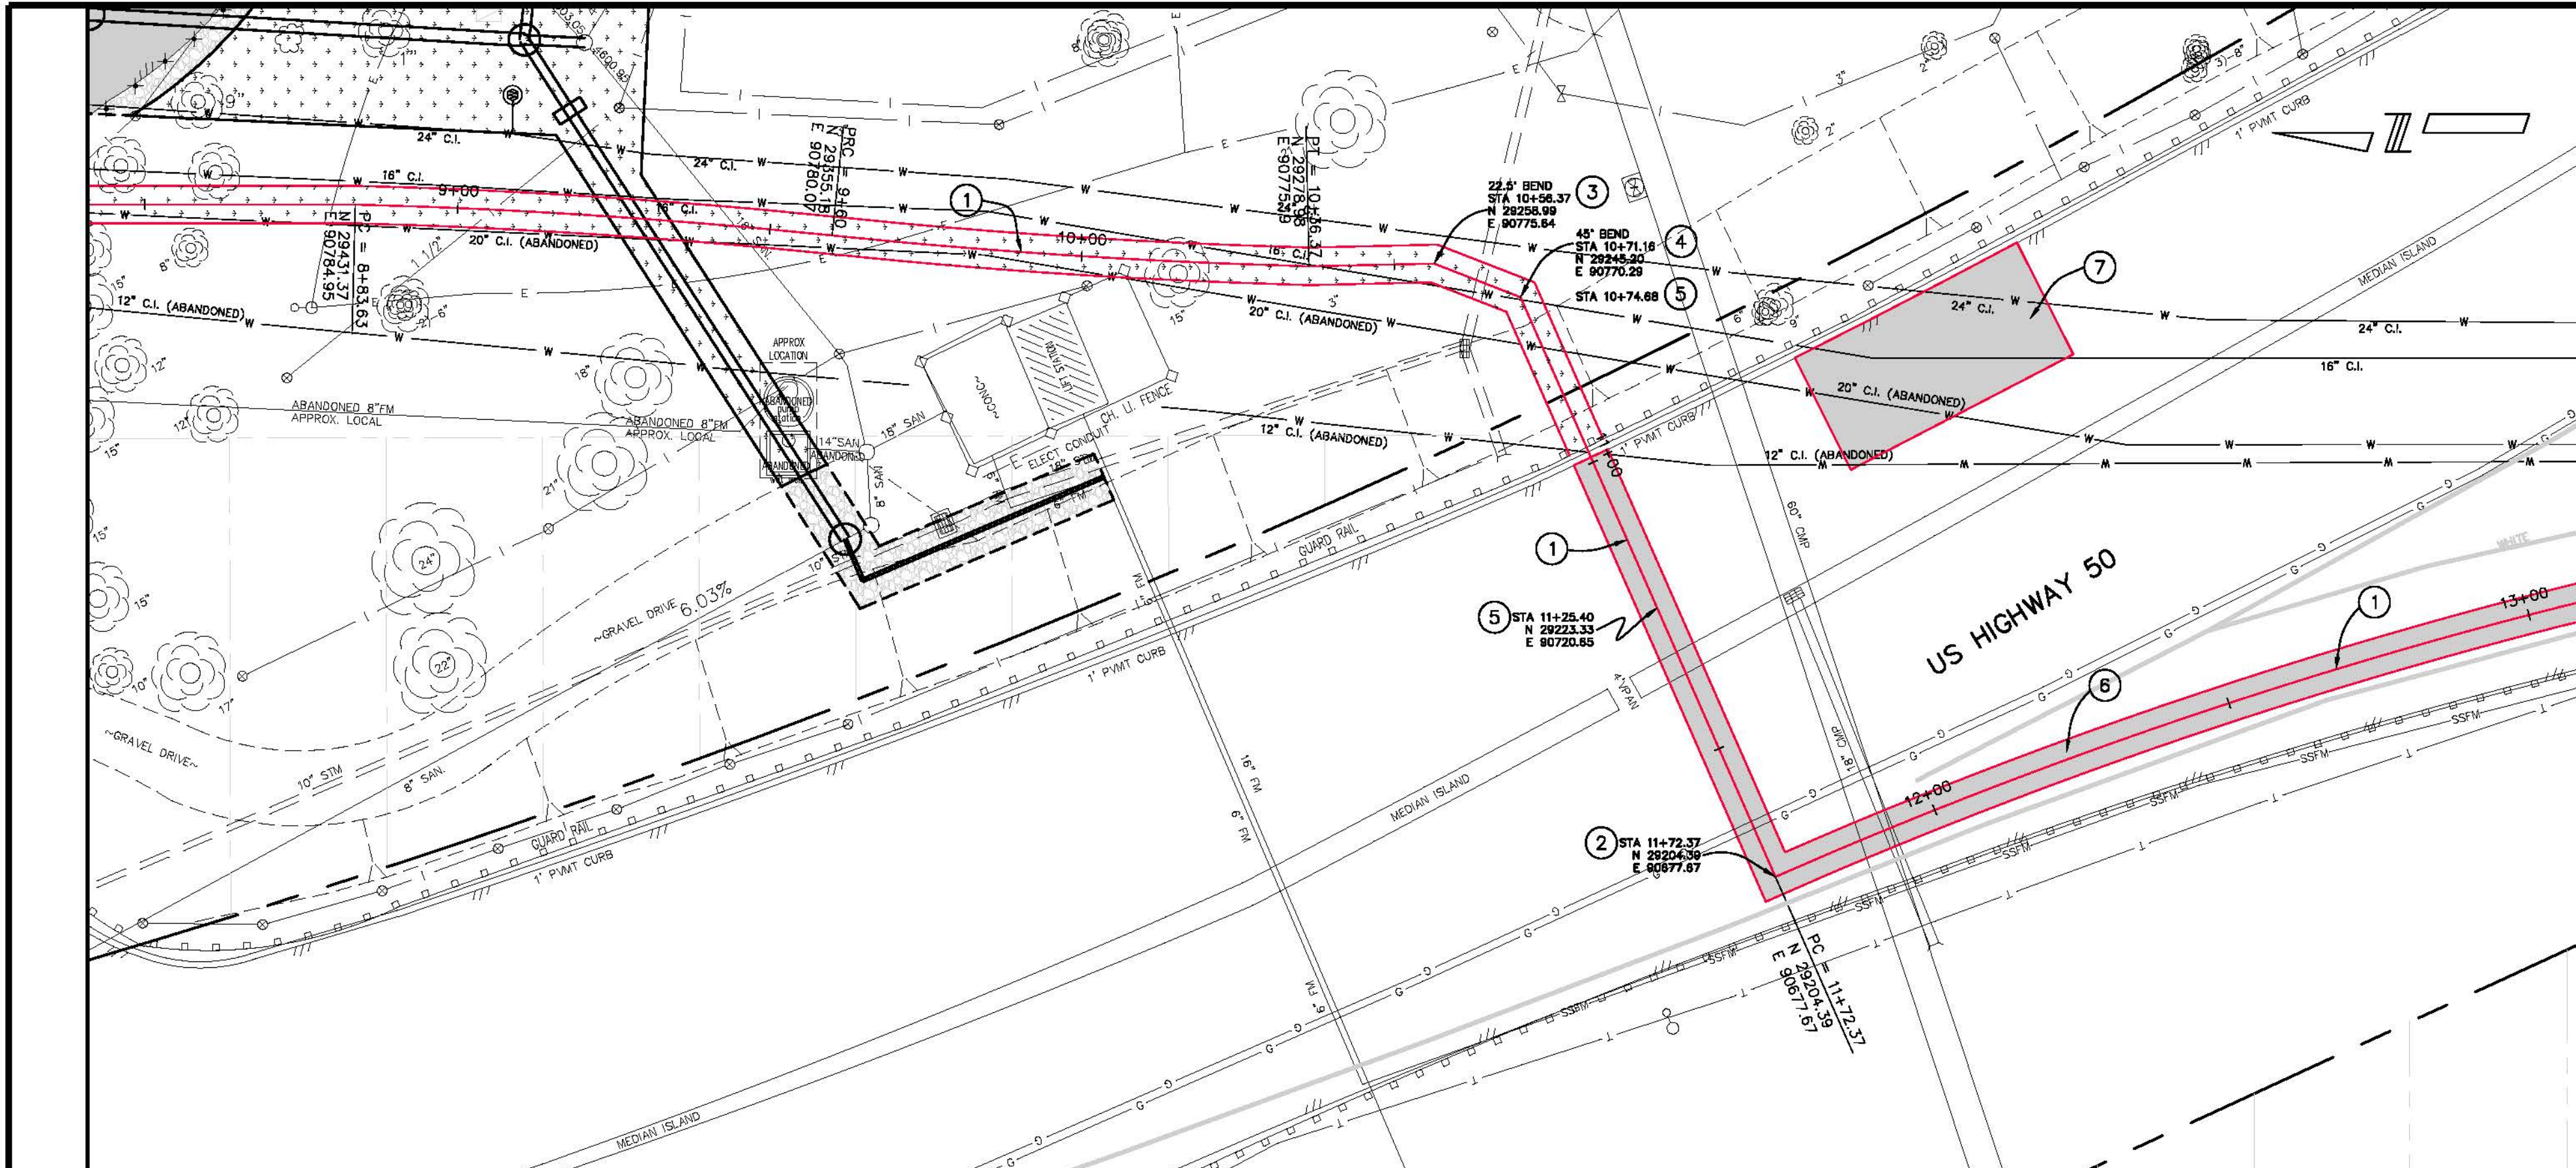


SEE BELOW

- ① 104 - FURNISH AND INSTALL 24" C-905, CLASS 165, DR25, PVC WATERLINE.  
 ADDITIONAL REQUIREMENTS WHEN WATER LINE IS INSTALLED WITHIN CDOT ROW: (WATER LINE STA. 10+88 TO STA. 14+50)  
 MINIMUM COVER TO TOP OF PIPE SHALL BE 54" (FINISHED GRADE TO TOP OF PIPE).  
 206 - STRUCTURAL BACKFILL (FLOW-FILL)  
 THE TOP 36" OF BACKFILL MATERIAL (FROM BOTTOM OF ASPHALT) SHALL BE FLOWFILL. FLOWFILL WILL BE PAID FOR SEPARATELY. THE PAID QUANTITY FOR FLOWFILL WILL HAVE A MAXIMUM WIDTH OF 6 FEET AND MAXIMUM DEPTH OF 36".  
 TRAFFIC CONTROL PLAN MUST BE REVIEWED AND APPROVED BY CDOT PRIOR TO ISSUING PERMIT AND START OF WORK. REQUIREMENTS AS LISTED ON ATTACHED PAGE 2 OF UTILITY PERMIT APPLICATION.  
 NO CONSTRUCTION ACTIVITY OR LANE CLOSURES (OTHER THAN TRAFFIC CONTROL SETUP) MAY OCCUR OUTSIDE OF 9 PM TO 6 AM.  
 FINAL PAVEMENT SURFACE MUST BE IN PLACE BEFORE LANES CAN RE-OPENED.  
 ONE LANE OF TRAFFIC IN EACH DIRECTION WILL BE MAINTAINED DURING THE WORK. FLAGGERS WILL BE REQUIRED IF NEEDED TO DIRECT TRAFFIC.
- ② 104 - FURNISH AND INSTALL A 24" - 90° DIP BEND, CONNECT (MJ BY MJ) TO 24" PVC, PLACE CONCRETE THRUST BLOCK AT 90° BEND TO RESTRAIN 24" PVC WATER MAIN. THE CONTRACT UNIT PRICE FOR 24" - 90° DIP BEND SHALL INCLUDE THE COST OF ALL CONNECTIONS. (REFER TO PAGE W-07 OF THE STANDARD CONTRACT DOCUMENTS)
- ③ 104 - FURNISH AND INSTALL A 24" - 22 1/2° DIP BEND, CONNECT (MJ BY MJ) TO 24" PVC WATER MAIN. PLACE CONCRETE THRUST BLOCK AT 22 1/2° BEND. THE CONTRACT UNIT PRICE FOR BENDS SHALL INCLUDE THE COST OF ALL CONNECTIONS (REFER TO PAGES W-07 OF THE STANDARD CONTRACT DOCUMENTS)
- ④ 104 - FURNISH AND INSTALL A 24" - 45° DIP BEND (HORIZONTAL). THE CONTRACT UNIT PRICE FOR BENDS SHALL INCLUDE THE COST OF ALL CONNECTIONS (REFER TO PAGES W-07 OF THE STANDARD CONTRACT DOCUMENTS)
- ⑤ 104 - FURNISH AND INSTALL A 24" - 45° DIP BEND (VERTICAL). THE CONTRACT UNIT PRICE FOR BENDS SHALL INCLUDE THE COST OF ALL CONNECTIONS (REFER TO PAGES W-07 OF THE STANDARD CONTRACT DOCUMENTS)
- ⑥ ASPHALT REMOVAL AND T-TOP PATCH WITHIN CDOT ROW:  
 103.3 - ASPHALT REMOVAL: CUT AND REMOVE PAVEMENT 6' WIDE AS SHOWN. MILL (2" THICK) AND REMOVE ASPHALT PAVEMENT FOR AN ADDITIONAL 2 FEET ON BOTH SIDES OF THE FULL DEPTH REMOVAL. 2 FEET IS THE MINIMUM WIDTH. WIDTH OF MILL SHALL BE GREATER THAN 2 FEET IF NECESSARY TO KEEP JOINT OUT OF WHEEL PATH.  
 401-HOT BITUMINOUS PAVEMENT (6" THICK) (GRADING SX) (BINDER GRADE PG 64-22). HBP SHALL BE PLACED ON FLOWFILL BACKFILL MATERIAL.
- ⑦ REPAIR PAVEMENT DAMAGED BY WATER LINE LEAK.  
 103.3 - ASPHALT REMOVAL: CUT AND REMOVE PAVEMENT AS SHOWN, OR AS DIRECTED BY CITY.  
 304.08 - SUBGRADE STABILIZATION (CLASS 6 ABC) (CIP). SUBGRADE STABILIZATION SHALL BE A MINIMUM OF 12" IN DEPTH. DEPTH MAY BE INCREASED AS DIRECTED BY CITY TO REMOVE SATURATED SUBGRADE.  
 401-HOT BITUMINOUS PAVEMENT (6" THICK) (GRADING SX) (BINDER GRADE PG 64-22).

PROJECT CONTROL DATA

POINT	NORTHING	EASTING	STATION	OFFSET	ELEVATION	DESCRIPTION
702	30876.29	90338.28	2+82.29	38.43	4628.05	NO 5 REBAR
700	30208.76	90401.55			4629.01	CIS HINGE NAIL
402	30209.28	90795.54	13+24.64	6.15	4629.15	CITY SURVEY MONUMENT
407	29517.07	90797.80	20+39.50	17.40	4624.08	CITY SURVEY MONUMENT

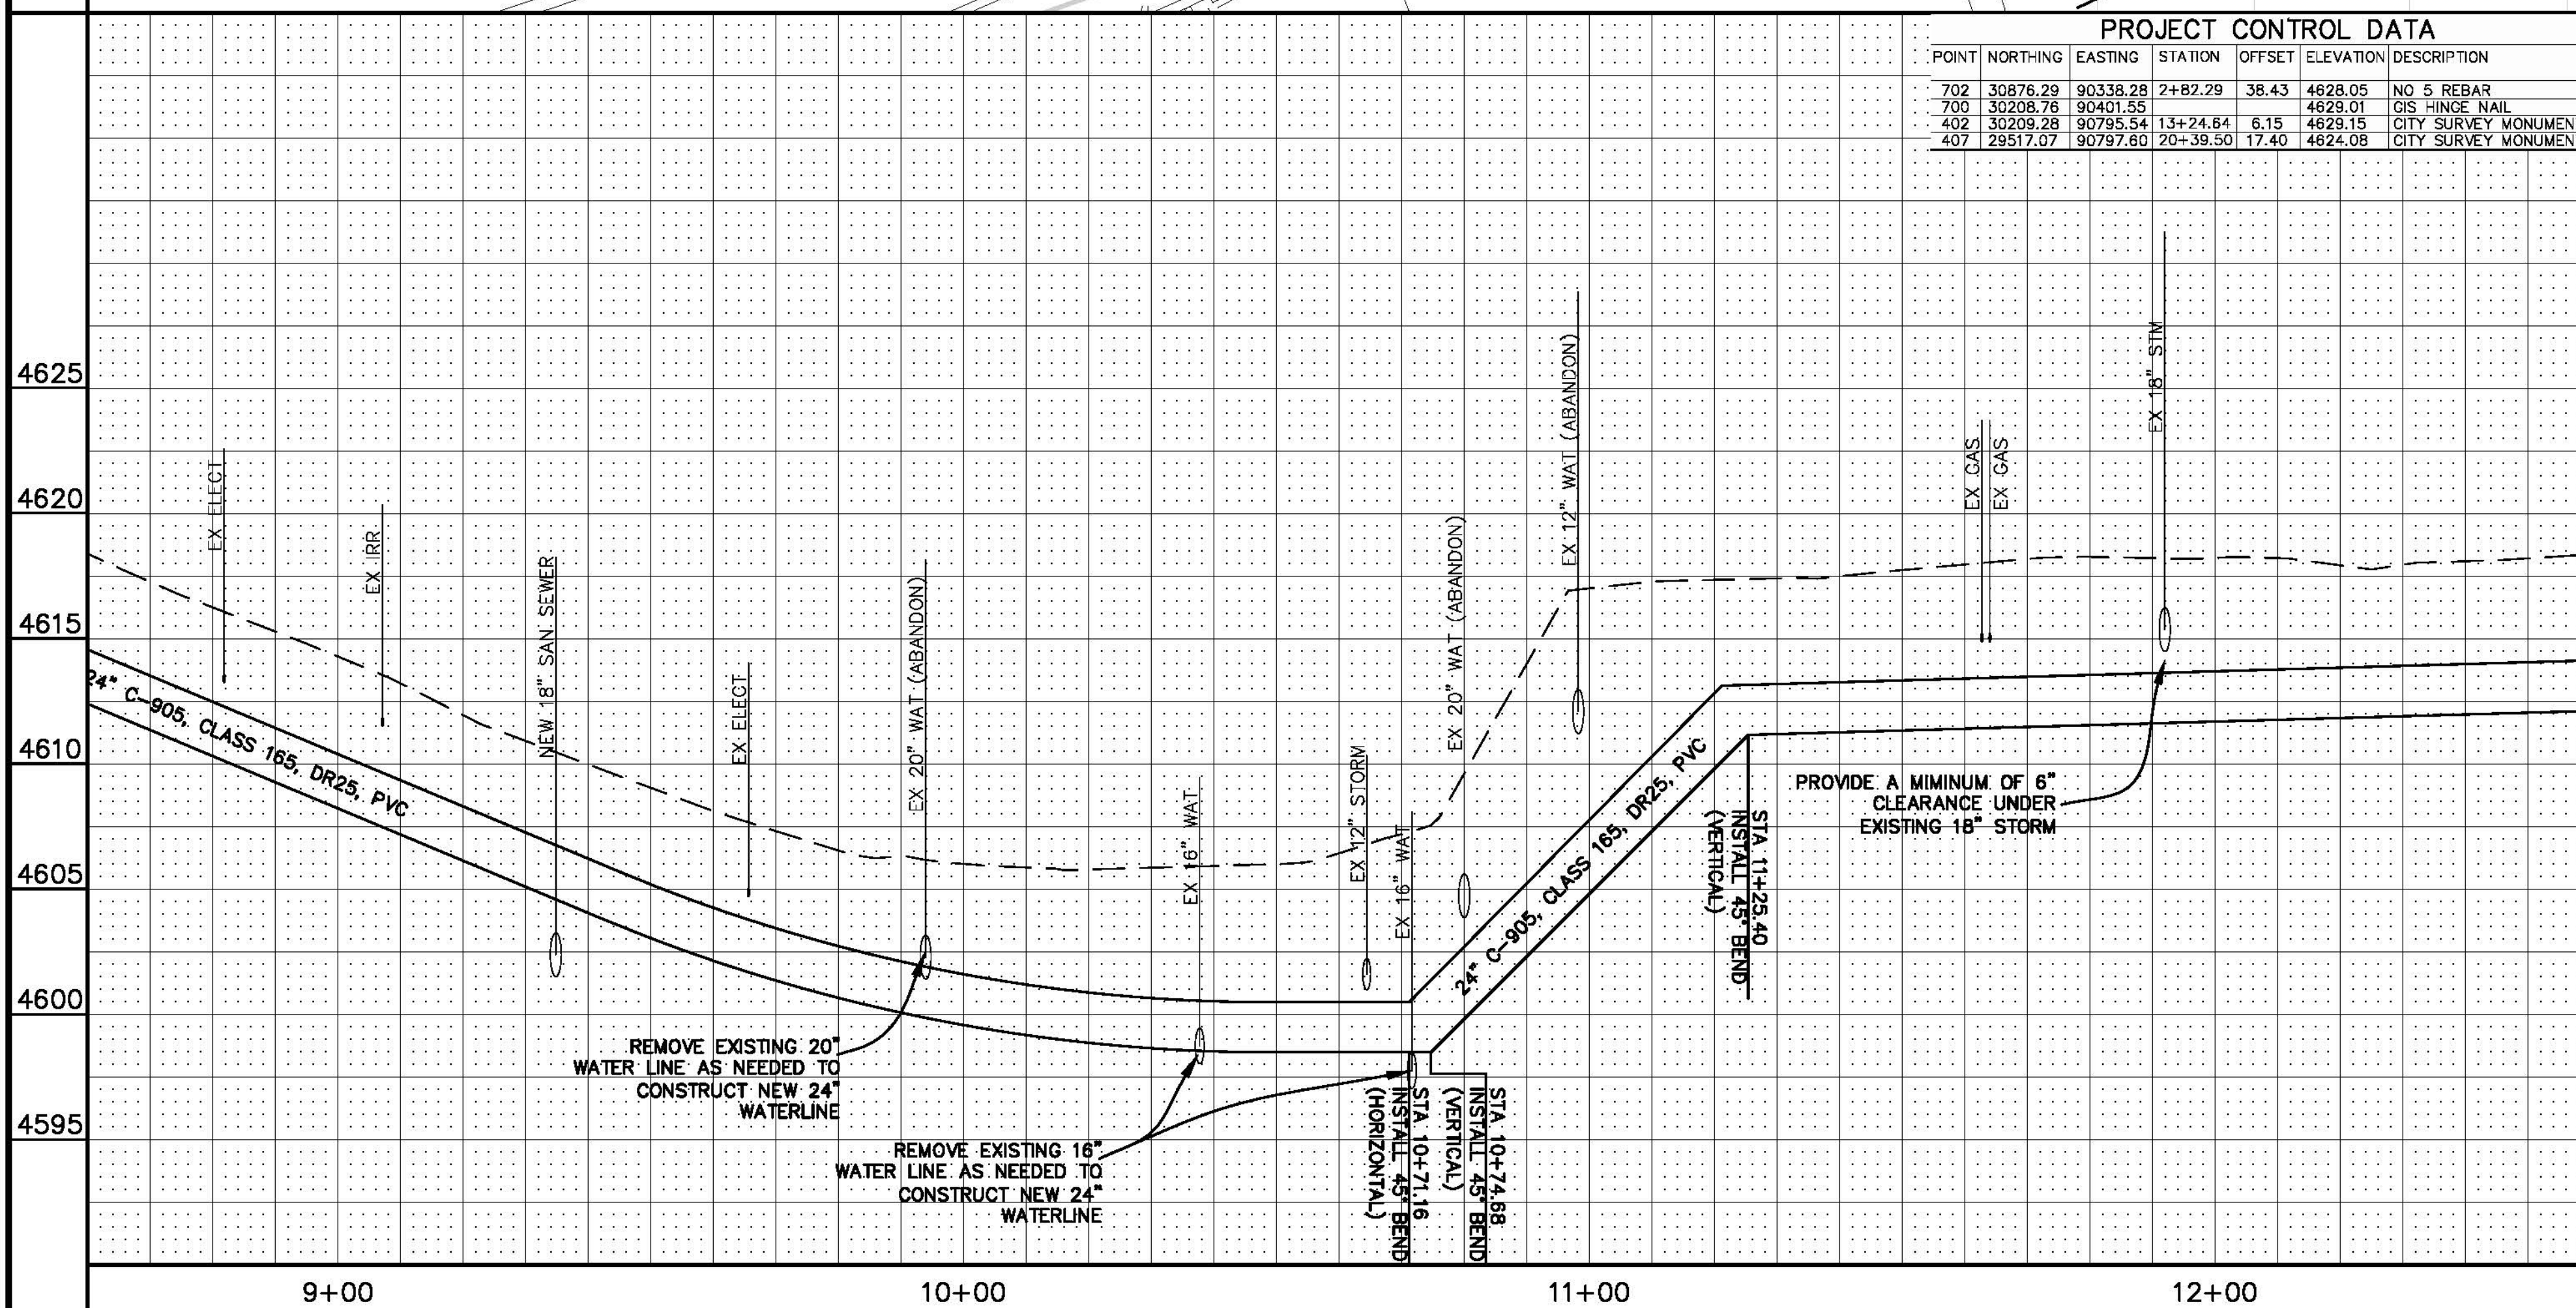

MATCH LINE

REVISION	DESCRIPTION	DATE
REVISION A	NEW DRAWING FOR CONTINUATION OF	7/13/05
REVISION B	NEW 24in WATER LINE IN CANON STREET	7/27/05
REVISION C	ADDITIONAL EXISTING TOPO	1007-10-15
REVISION D	AS BUILT	

DRAWN BY	JCS	DATE	2005
DESIGNED BY		DATE	
CHECKED BY		DATE	
APPROVED BY		DATE	

SCALE:

**CITY OF Grand Junction COLORADO**


**PUBLIC WORKS AND UTILITIES ENGINEERING DIVISION**

**DUCK POND PARK LIFT STATION ELIMINATION AND GRAVITY SEWER CONSTRUCTION WATER LINE REPLACEMENT PLANS CANON STREET**

N:\Lamp\proj\F10114 (DUCK POND SEWER IMPROV).dwg BASE-F10114 rev 7-7-05.dwg, 11, 6/10/2008 9:02:09 AM



N:\Land\Proj\101014 (DUCK POND SEWER IMPROV).dwg 16-13-06 intercept sewer going north across highway bridge.dwg, PLAN AND PROFILE, 6/10/2008 9:05:08 AM

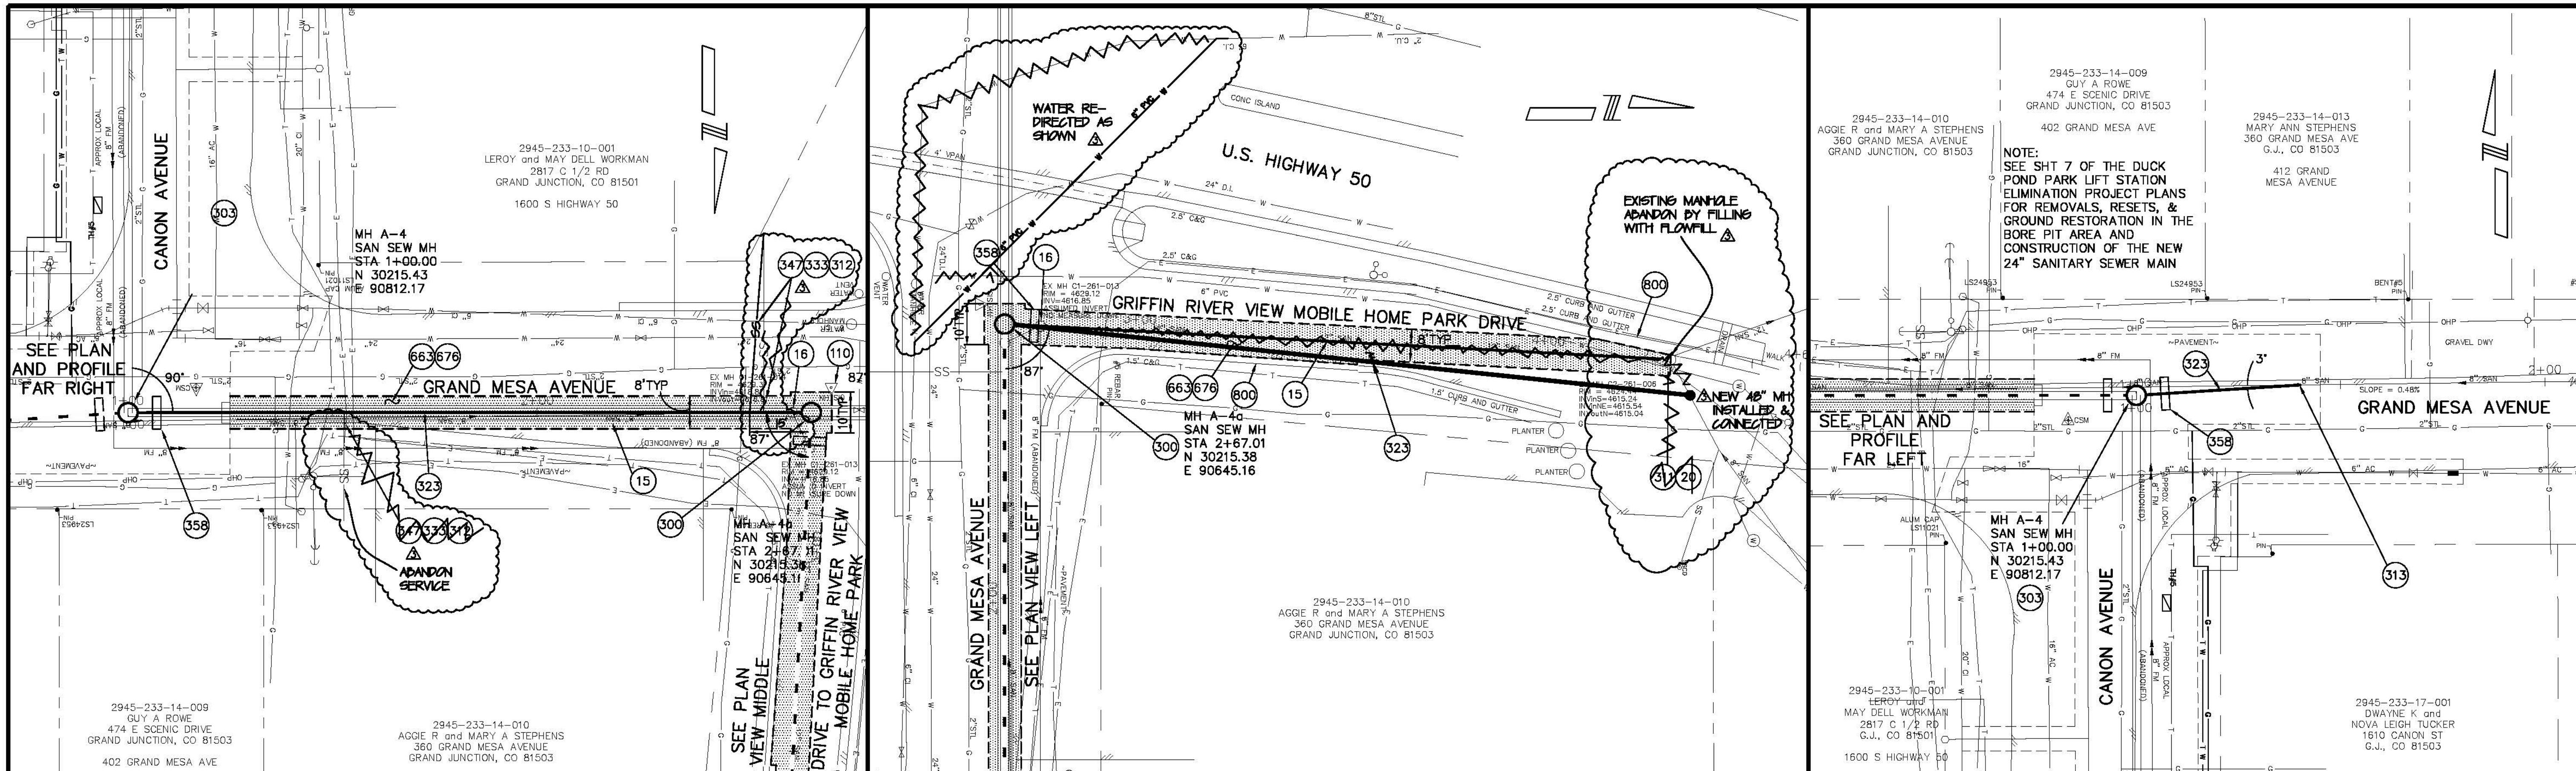

**CONSTRUCTION NOTES**      **CONSTRUCTION NOTES CONTINUED**      **CONSTRUCTION NOTES CONTINUED**

15)	202 - REMOVAL OF PIPE AS SHOWN; (SIZE AND TYPE AS SHOWN ON PLAN).	300	102.11/108.5 - SANITARY SEWER BASIC MANHOLE (48" I.D.). INCLUDES CONNECTION OF ADJACENT SEWER LINE, FORMING INVERTS AND ADJUSTING TO FINAL GRADE. (SEE CITY OF GRAND JUNCTION STANDARD DETAIL SS-02).	311	102.11/108.5 - CONNECT TO EXISTING MANHOLE ( 8" PIPE). (SEE CITY OF GRAND JUNCTION STANDA DETAIL SS-08).	4640	
16)	202 - REMOVAL OF MANHOLE. CONTRACTOR SHALL SALVAGE RING AND COVER AND DELIVER TO CITY SHOPS.	303	102.11/108.5 - SANITARY SEWER DROP MANHOLE (60" I.D.). CONTRACTOR SHALL USE AN INSIDE DROP SYSTEM (RELINER/DURAN INC. OR ENGINEER APPROVED EQUAL) WITH TYPE "B" DROP BOWLS HAVING 8" OUTLETS, 8" DIA SDR-35 PVC DROPS, AND STAINLESS STEEL ADJUSTABLE PIPE BRACKETS FOR BOTH EAST AND WEST INVERTS IN. INCLUDES MANHOLE COATING AS PER 102.11. (SEE MANUFACTURER'S RECOMMENDATIONS AND SPECIFICATIONS FOR INSIDE DROP SYSTEMS).	312	102.11/108.5 - CONNECT TO EXISTING PIPE ( 4" SEWER SERVICE PIPE).	4635	
20)	202 - ABANDON PIPE. ABANDON 12" SEWER TO NW AFTER CONNECTION TO NEW SEWER HAS BEEN MADE. ABANDON EXISTING SEWER BY RECONFIGURING MH INVERT AND PLUGGING EXISTING LINE WITH CONCRETE.	358	MH A-4c SAN SEW MH STA 2+67.01 RIM = 4616.85 INVERT = 4616.85 DEPTH = 0.00'	313	102.11/108.5 - CONNECT TO EXISTING PIPE ( 8" PIPE). DEFLECT PIPE AT NEW JOINT AS NEEDED TO TIE INTO MH. A-4.	4630	
110)	629 - REFERENCE AND RESET SURVEY MONUMENT.	358	MH A-4 SAN SEW MH STA 1+00.00 RIM = 4629.54 INVERT = 4619.60 DEPTH = 90.94'	323	102.9/108.2 - 8" GRAVITY SEWER PIPE (SDR 35 PVC) INCLUDES TYPE A BEDDING AND HAUNCHING MATERIAL AND BACKFILL OF TRENCH WITH NATIVE MATERIALS MEETING 103.16 EARTH BACKFILL MATERIAL.	4625	
		358	MH A-4 SAN SEW MH STA 1+40.07 RIM = 4619.80 INVERT = 4619.80 DEPTH = 0.00'	333	102.9/108.2 - 4" SEWER SERVICE PIPE (SDR 35 PVC) INCLUDES TYPE A BEDDING AND HAUNCHING MATERIAL. BACKFILL OF TRENCH WITH NATIVE MATERIALS MEETING 103.16 EARTH BACKFILL MATERIAL.	4620	
		358	MH A-4 SAN SEW MH STA 1+40.07 RIM = 4619.80 INVERT = 4619.80 DEPTH = 0.00'	347	102.9/108.5 - 8" x 4" SEWER SERVICE TAP. FULL BODY WYE (SEE STD. DETAIL SS-06).	4615	
		358	MH A-4 SAN SEW MH STA 1+00.00 RIM = 4629.54 INVERT = 4619.60 DEPTH = 90.94'	358	103 - CLAY CUT-OFF WALL (INCIDENTAL TO SEW INSTALLATION PAY ITEM)	4610	
		358	MH A-4 SAN SEW MH STA 1+00.00 RIM = 4629.54 INVERT = 4619.60 DEPTH = 90.94'	663	304 - AGGREGATE BASE COURSE (CLASS 6) (6" THICK)	4610	
		358	MH A-4 SAN SEW MH STA 1+00.00 RIM = 4629.54 INVERT = 4619.60 DEPTH = 90.94'	676	401.08 - HOT BITUMINOUS PAVEMENT (3" THICK) (GRADING SX, BINDER GRADE PG 64-22) (TWO 1/2 LIFTS)	4605	
		358	MH A-4 SAN SEW MH STA 1+00.00 RIM = 4629.54 INVERT = 4619.60 DEPTH = 90.94'	800	PROTECT CONCRETE FEATURE IN PLACE AS SHOWN.	4600	
		358	MH A-4 SAN SEW MH STA 1+00.00 RIM = 4629.54 INVERT = 4619.60 DEPTH = 90.94'			4595	

1+00      2+00      3+00      4+00      4595      1+00      2+00

REVISION $\Delta$ AS BUILT REVISION $\Delta$ REVISION $\Delta$ REVISION $\Delta$	DESCRIPTION DATE 10-10-15 DRAWN BY JCS DESIGNED BY CHECKED BY APPROVED BY	DATE 2006 DATE DATE DATE	SCALES: PLAN HORIZONTAL 1" = 20' PROFILE VERTICAL 1" = 2'	CITY OF <b>Grand Junction</b> COLORADO	PUBLIC WORKS AND UTILITIES ENGINEERING DIVISION	INTERCEPT FOR SEWER CROSSING COLORADO RIVER AT HWY 50 BRIDGE SANITARY SEWER PLAN AND PROFILES	14 X
---	--	-----------------------------------	---	--	---	---	---------