



Purchasing Division

ADDENDUM NO. 1

DATE: October 10, 2019
FROM: City of Grand Junction Purchasing Division
TO: All Offerors
RE: 2019 Fire Training Facility – Burn Slab IFB-4707-19-DH

Offerors responding to the above referenced solicitation are hereby instructed that the requirements have been clarified, modified, superseded and supplemented as to this date as hereinafter described.

Please make note of the following clarifications:

1. Please see attached revised sheets 5 & 6 for this project.



The original solicitation for the project noted above is amended as noted.

All other conditions of subject remain the same.

Respectfully,

A handwritten signature in black ink, appearing to read "Duane Hoff Jr.", written in a cursive style.

Duane Hoff Jr., Senior Buyer
City of Grand Junction, Colorado

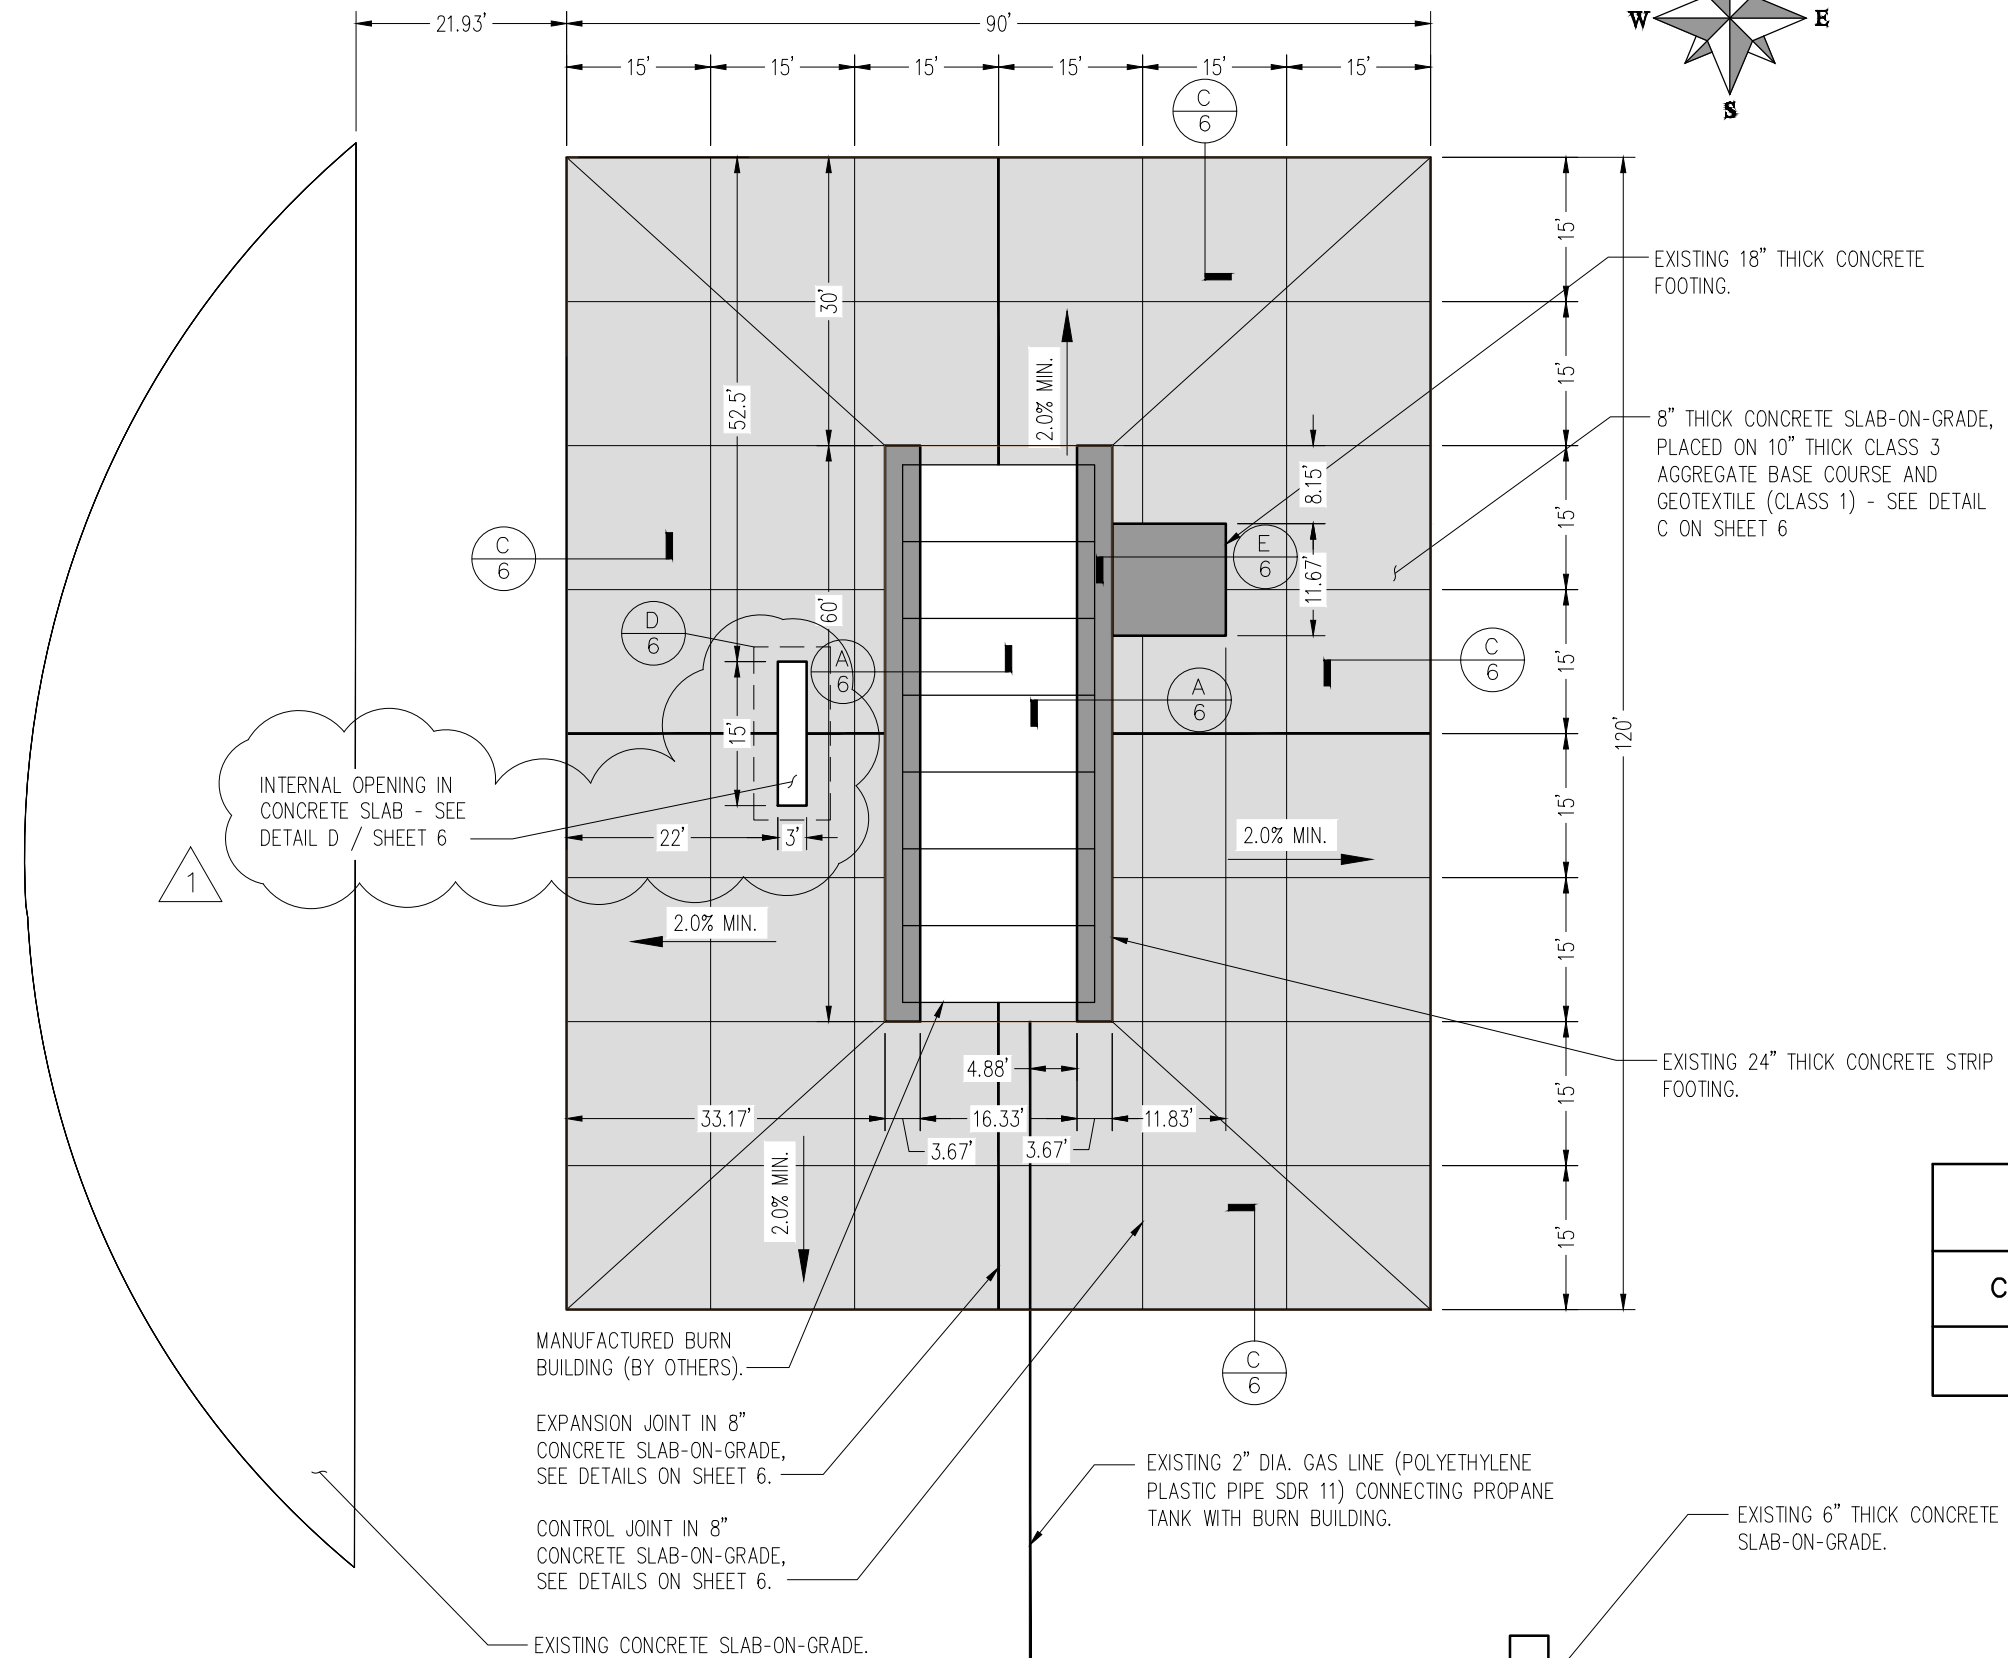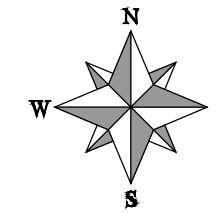


EARTH QUANTITIES	
CUT (CY)	FILL (CY)
56.4	1.9

REVISION	DESCRIPTION	DATE	DRAWN BY	DATE	SCALES: PLAN & PROFILE
REVISION Δ			KA	9/24/2019	HORIZONTAL: 1" = 20'
REVISION Δ			KA	9/24/2019	0 5 10 20
REVISION Δ			XXX	201X	VERTICAL: 1" = 10'
REVISION Δ			XXX	201X	0 2.5 5 10




**PUBLIC WORKS
ENGINEERING DIVISION**


**GJFD FIRE TRAINING FACILITY – BURN SLAB
PLAN
BURN SLAB**

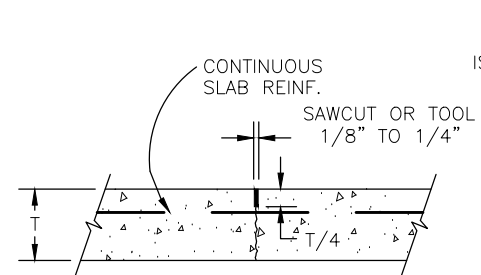


CONTRACTION JOINT

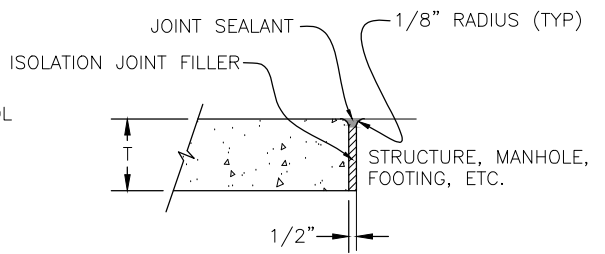

UNDOWELED ISOLATION JOINT

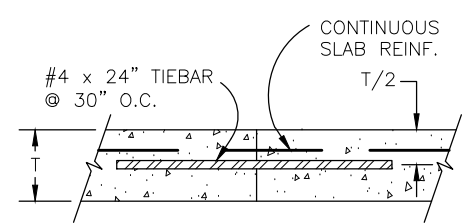

EMERGENCY CONSTRUCTION JOINT

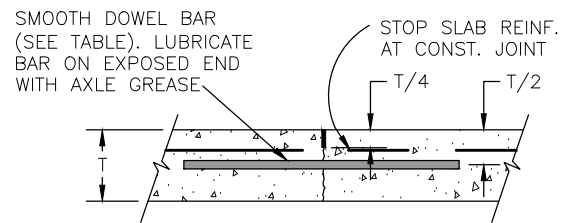


PLANNED CONSTRUCTION JOINT

DOWEL SIZE FOR JOINED REINFORCED PAVEMENTS AND CONSTRUCTION JOINTS		
SLAB THICK.(T) INCHES	DOWEL DIAMETER INCHES	TOTAL DOWEL LENGTH INCHES
6.0 to 6.9	3/4	16
7.0 to 8.0	1	16


ALL DOWELS SPACED AT 12" CENTERS

- NOTES**
1. ALL EXPANSION AND ISOLATION JOINTS SHALL BE SEALED PER DETAILS ON THIS SHEET.
 2. ALL HANDTOOLED JOINTS SHALL BE FINISHED WITH A 1/4" OR SMALLER RADIUS.
 3. SEE SECTION 705.01 OF THE CDOT S.S.F.R.B. FOR APPROVED JOINT SEALANTS.
 4. MAKE A WATERTIGHT SEAL BETWEEN THE DOWEL BAR AND THE EXPANSION CAP WITH A RUBBER O-RING.

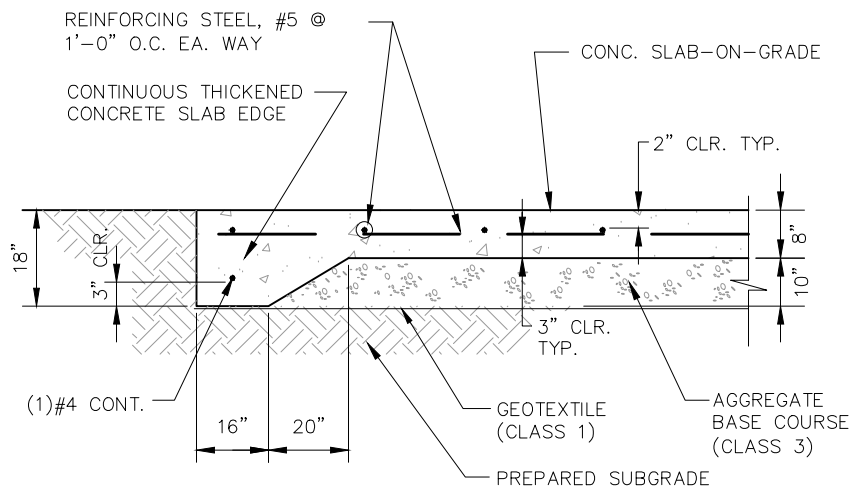


NOTE: REFER TO FOUNDATION PLAN FOR SLAB SLOPE AND CONTROL/CONSTRUCTION JOINT LOCATIONS.

C TYPICAL SLAB-ON-GRADE EDGE DETAIL
SCALE: 1/2"=1'-0"

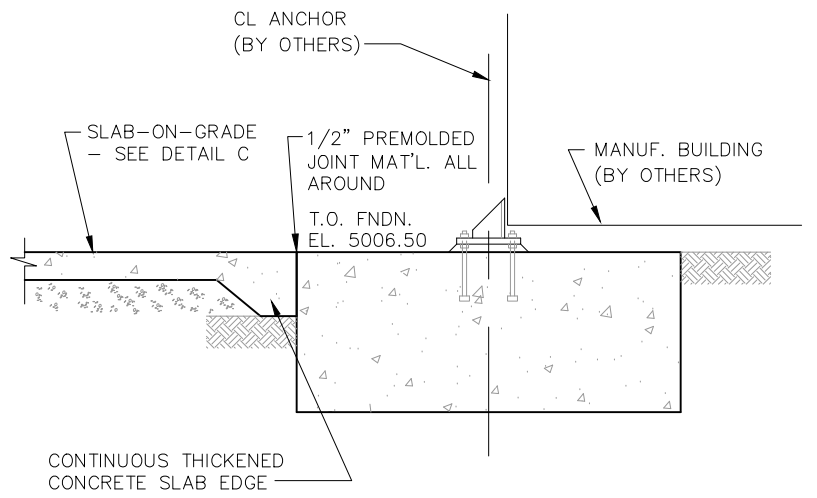


A TYPICAL MANUFACTURED BUILDING CONCRETE STRIP FOOTING DETAIL
SCALE: 1/2"=1'-0"

JOINT DETAILS FOR CONCRETE PAVEMENT

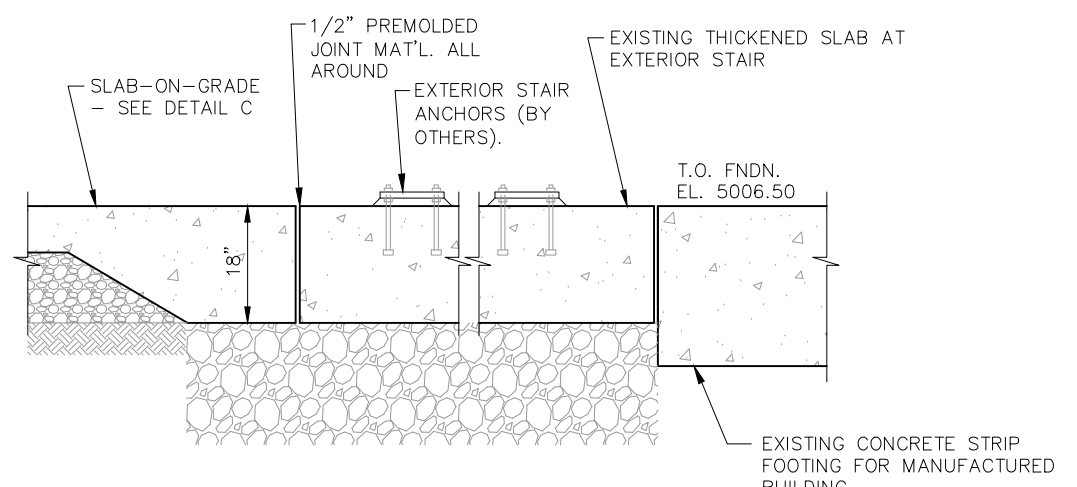

E TYPICAL EXTERIOR STAIR CONCRETE THICKENED SLAB DETAIL
SCALE: 1/2"=1'-0"

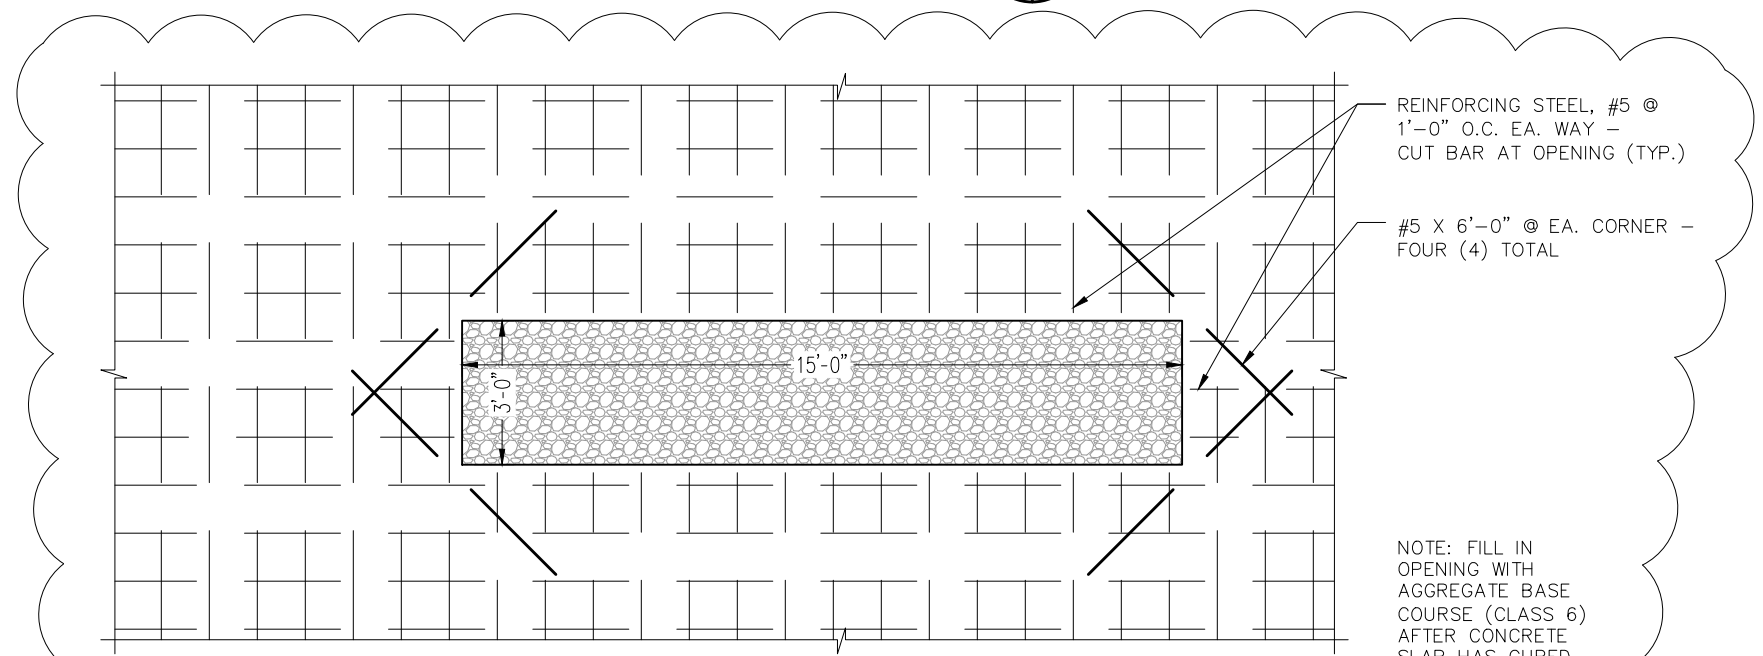

D INTERNAL OPENING IN CONCRETE SLAB
SCALE: 1/4"=1'-0"

NOTE: FILL IN OPENING WITH AGGREGATE BASE COURSE (CLASS 6) AFTER CONCRETE SLAB HAS CURED FOR 7 DAYS.

REVISION	DESCRIPTION	DATE	DRAWN BY	DATE	SCALES: PLAN & PROFILE
REVISION			KA	9/24/2019	HORIZONTAL: 1" =
REVISION			KA	9/24/2019	VERTICAL: 1" =
REVISION			XXX	201X	
REVISION			XXX	201X	



PUBLIC WORKS ENGINEERING DIVISION

GJFD FIRE TRAINING FACILITY - BURN SLAB DETAILS BURN SLAB